

STATE OF HAWAII

DEPARTMENT OF TRANSPORTATION

HIGHWAYS DIVISION HONOLULU, HAWAII


"AS-BUILT"

PLANS FOR

KUIHELANI HIGHWAY PAVEMENT PREVENTIVE MAINTENANCE

HONOAPIILANI HIGHWAY TO PUUNENE AVENUE FEDERAL-AID PROJECT NO. NH-0380(11)

DISTRICT OF WAILUKU ISLAND OF MAUI

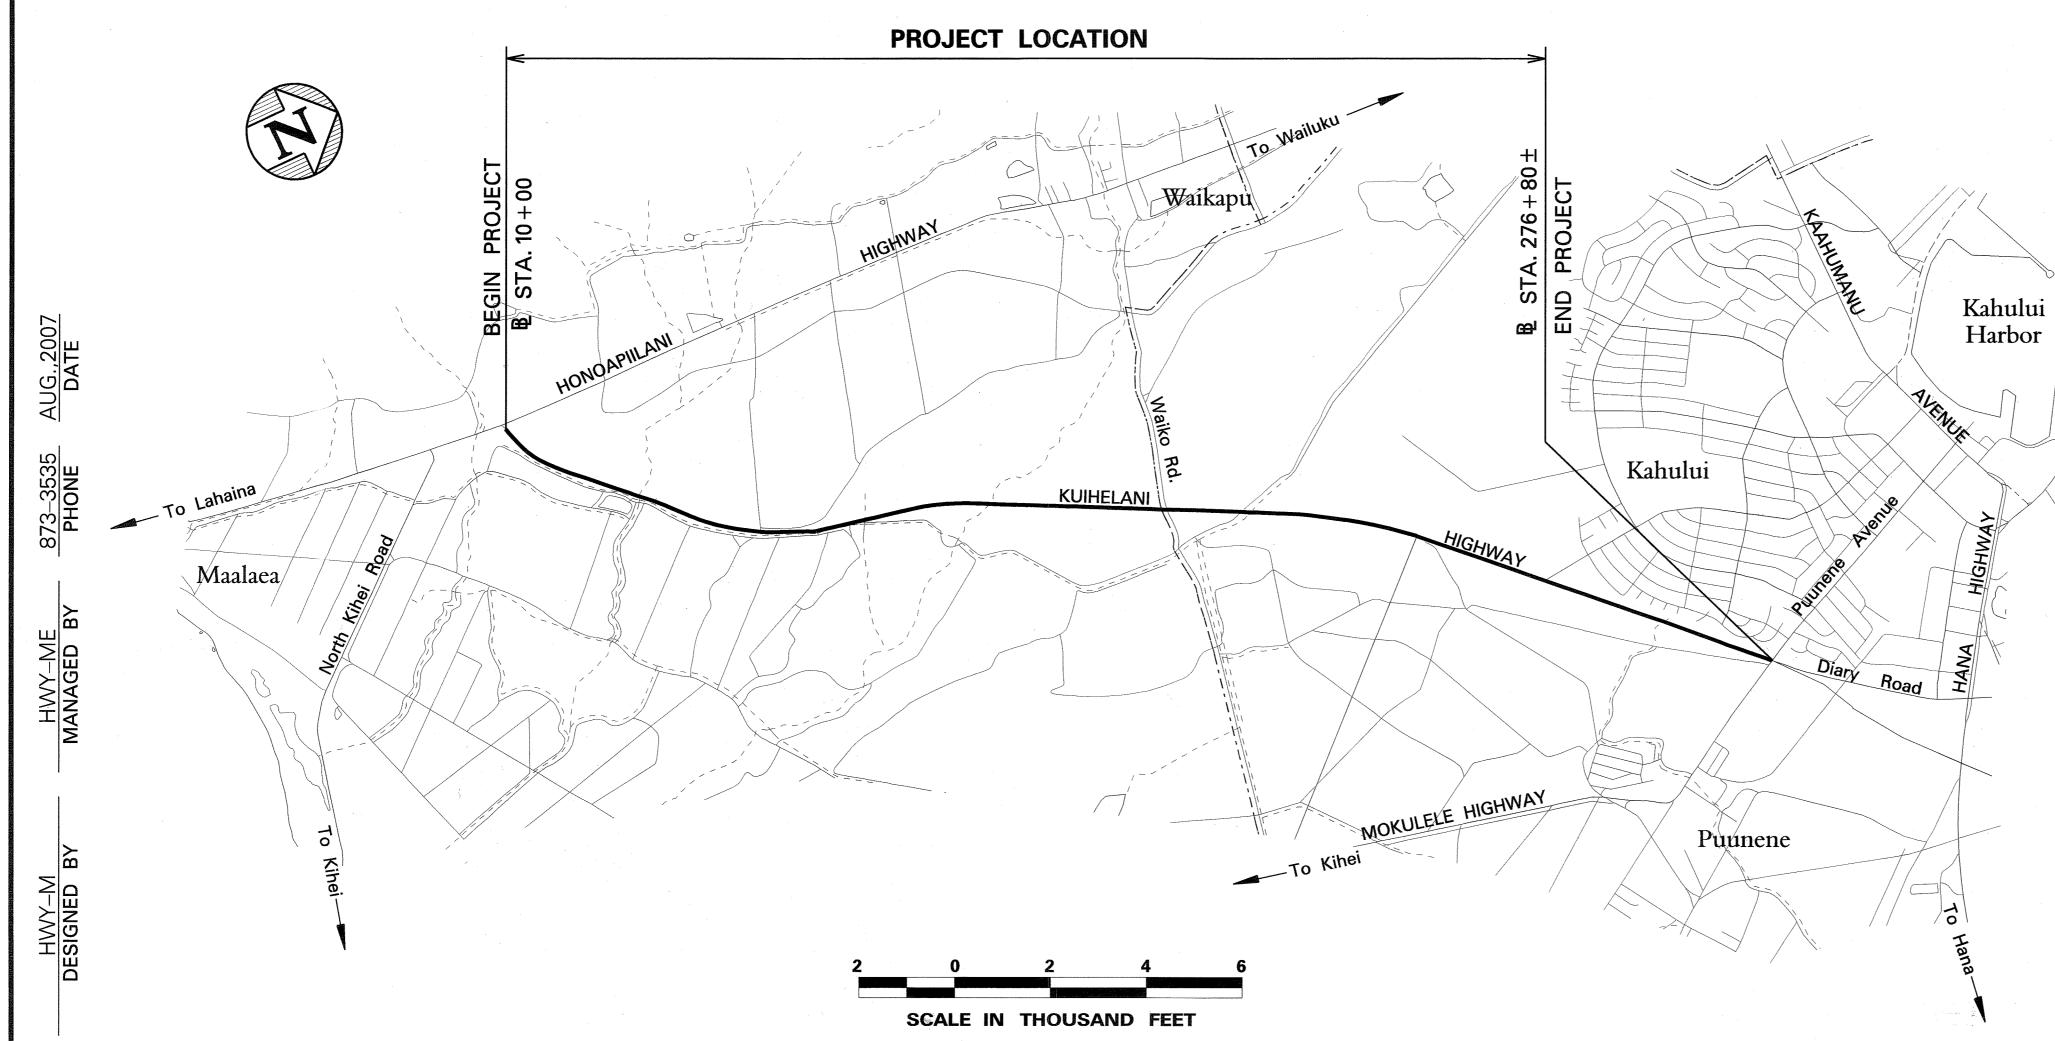

Honokohau

Kapalua

Kapalua

Kapalua

Kanalui

Bay

Kaliua

FED. ROAD DIST. NO.

---- FEDERAL AID PROJECTS PREVIOUSLY CONSTRUCTED OR UNDER CONSTRUCTION

MILE POST $6.00\pm$ TO MILE POST $0.96\pm$

CHANGES MADE DURING CONSTRUCTION HAVE BEEN INCORPORATED ON THESE PLANS EXCEPT CHANGES IN THE ORIGINAL THEORETICAL QUANTITIES. FOR ACTUAL QUANTITIES, REFER TO PROJECT LEDGER AND/OR COMPUTATION BOOK.

Sharlas Shibras Balas G/4/1/ RESIDENT ENGINEER DATE

SCALE IN MILES

FISCAL SHEET YEAR NO.

33

2007

PROJ. NO.

NH-0380(11)

DESIGN DESIGNATION	HONOAPIILANI HWY. TO WAIKO RD.	WAIKO RD. TO MAUI LANI GOLF COURSE ENTRANCE	MAUI LANI GOLF COURSE ENTRANCE TO PUUNENE AVE.
ADT (2007)	14,900	17,800	18,700
ADT (2017)	17,700	21,100	22,300
DHV	1,420	1,690	1,780
K	8.0	8.0	8.0
D	55/45	55/45	55/45
T	5.0	5.0	5.0
T24	6.0	6.0	5.0

DEPARTMENT OF TRANSPORTATION
STATE OF HAWAII

APPROVED:

DIR. OF TRANSPORTATION

DATE