



FED. ROAD DIST. NO.	STATE	FED. AID PROJ. NO.	FISCAL YEAR	SHEET NO.	TOTAL SHEETS
HAWAII	HAW.	NH-0380(013)	2015	ADD.7	44

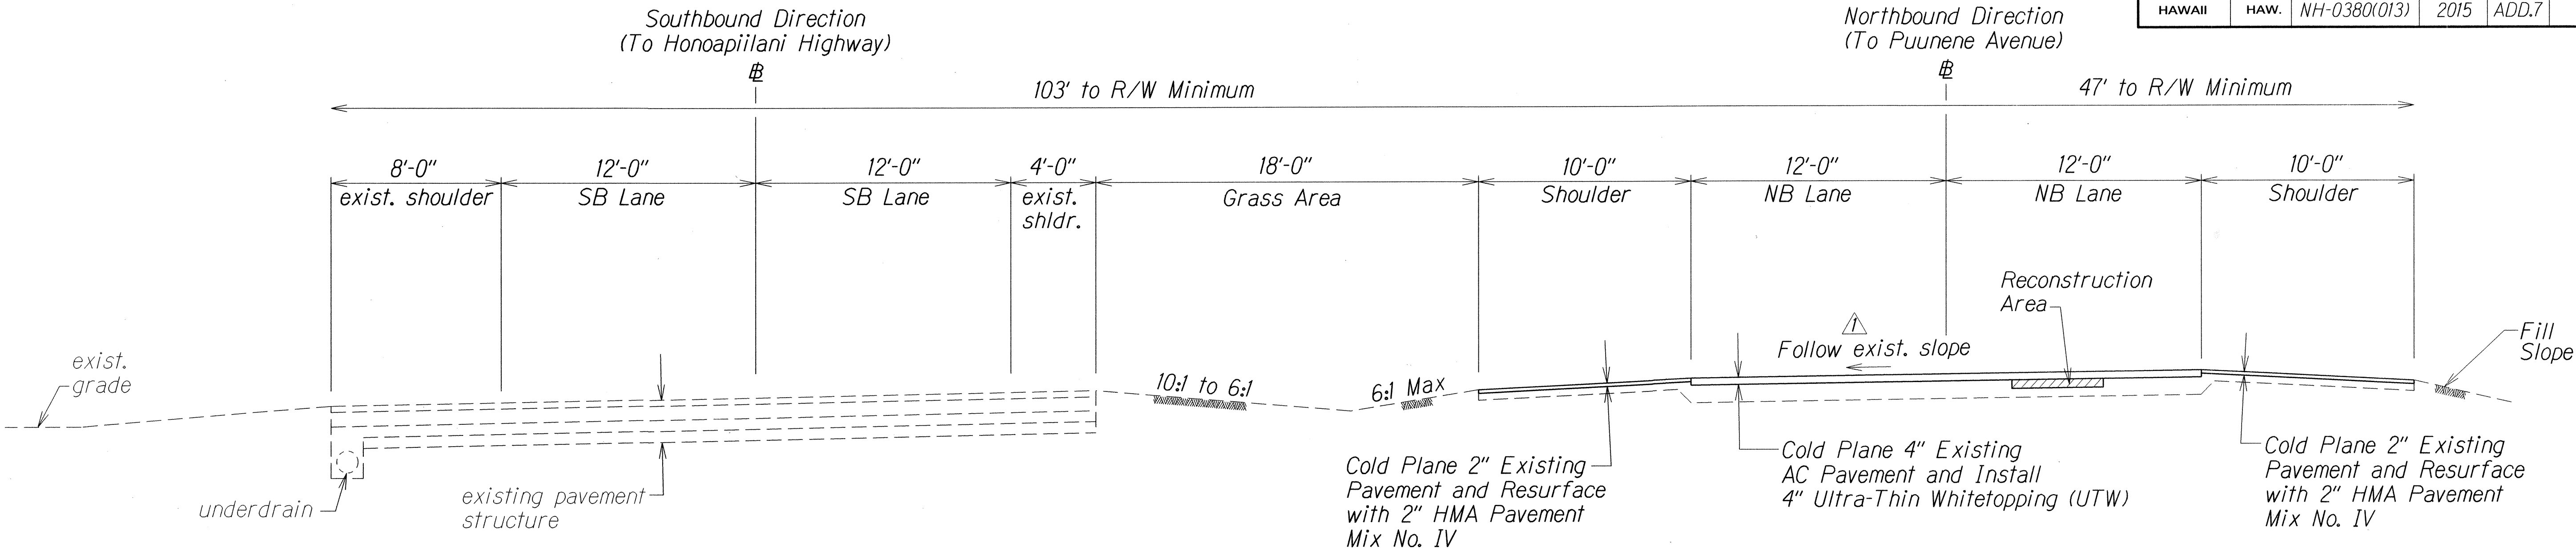

TYPICAL SECTION ON TANGENT DIVIDED HIGHWAY
Scale: 1/4" = 1'-0"

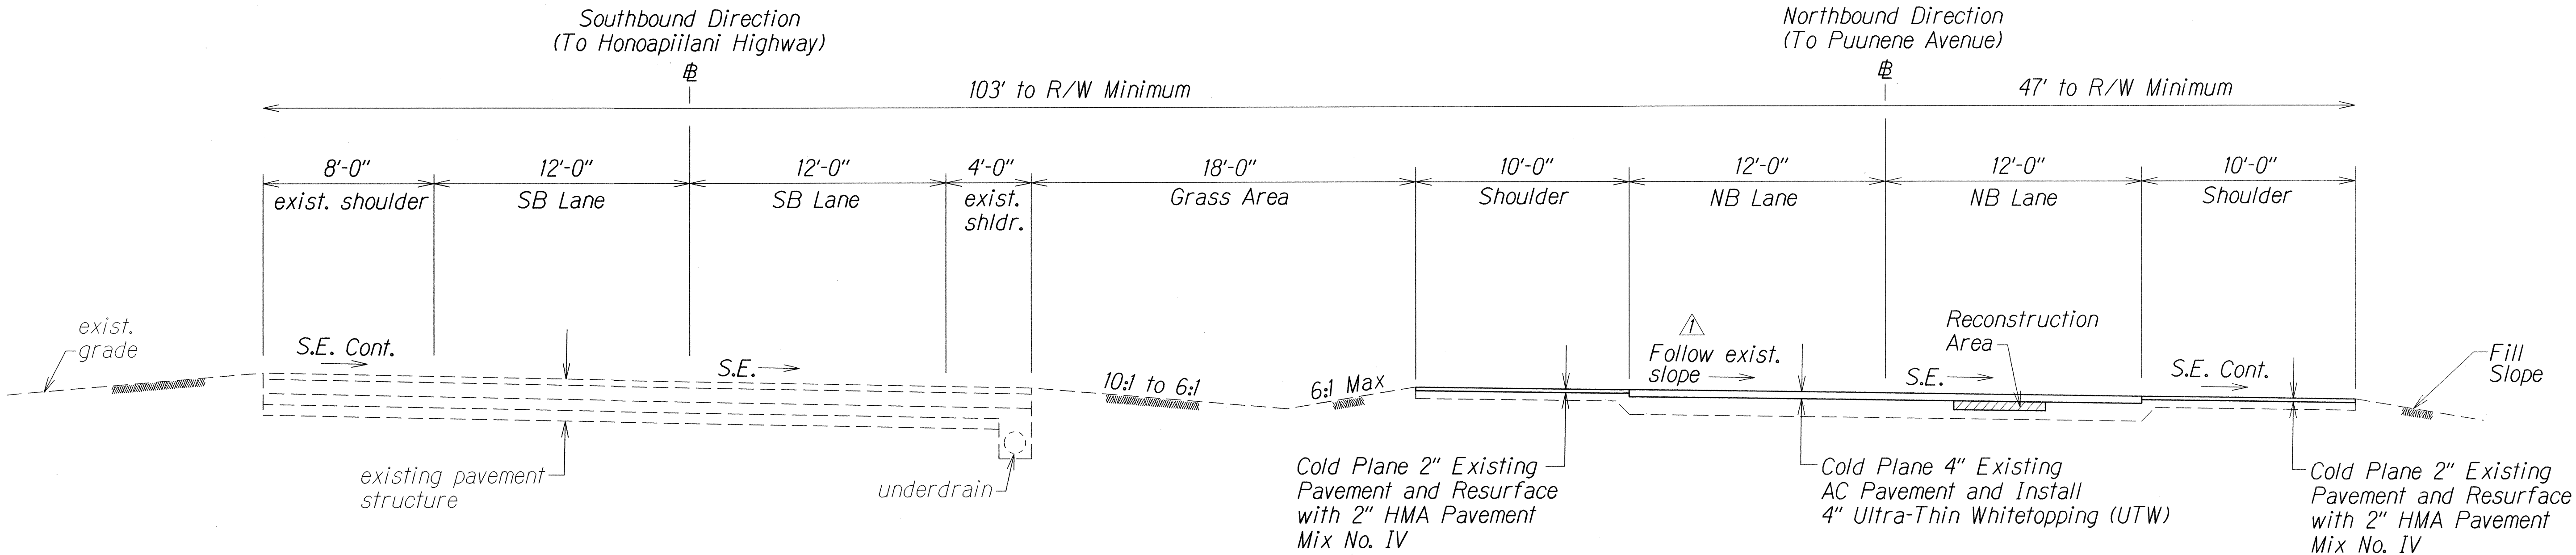

TYPICAL SECTION ON CURVE DIVIDED HIGHWAY
Scale: 1/4" = 1'-0"

ORIGINAL PLAN	SURVEY PLOTTED BY	DATE
NOTE BOOK	DRAWN BY	May 1992
DESIGNED BY	CHECKED BY	
NOTED BY		

5-29-15 Add note regarding slopes.

DATE REVISION

STATE OF HAWAII DEPARTMENT OF TRANSPORTATION HIGHWAYS DIVISION	
TYPICAL SECTIONS & DETAILS	
KUIHELANI HIGHWAY RESURFACING Honoapiilani Highway to Puunene Avenue Federal-Aid Project No. NH-0380(013)	
Scale: As Shown	Date: March, 2015
SHEET No. 1 OF 5 SHEETS	

