

Patricia Choy

W:\10226-01\Civil\CADD\Site\DWGS\DRIVE\_w\10226-01\Civil\CADD\Site\DWGS\Y1 Cross Sections.dwg


14:29:50

January 11, 2019

NOTES:







1. Elevations Shown on Roadway Sections are at  $\frac{P}{L}$ .
2. Slopes Based on Grade Control Line.

| STATE | PROJECT         | SHEET NO. |
|-------|-----------------|-----------|
| HI    | HI STP SR 30(1) | Y1        |

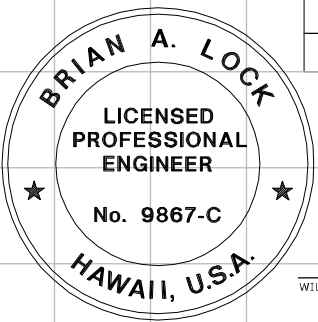

THIS WORK WAS PREPARED BY ME OR UNDER MY SUPERVISION.

WILSON OKAMOTO CORPORATION      APRIL 30, 2020  
LIC. EXP. DATE

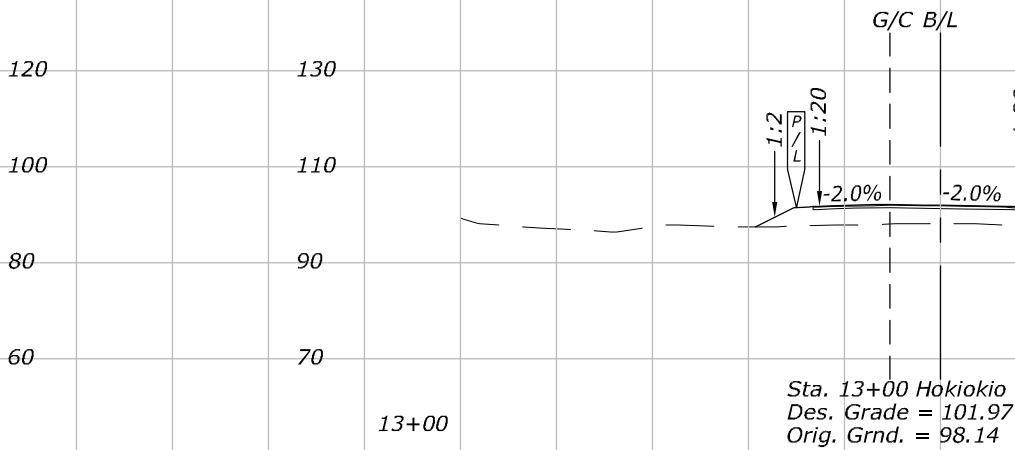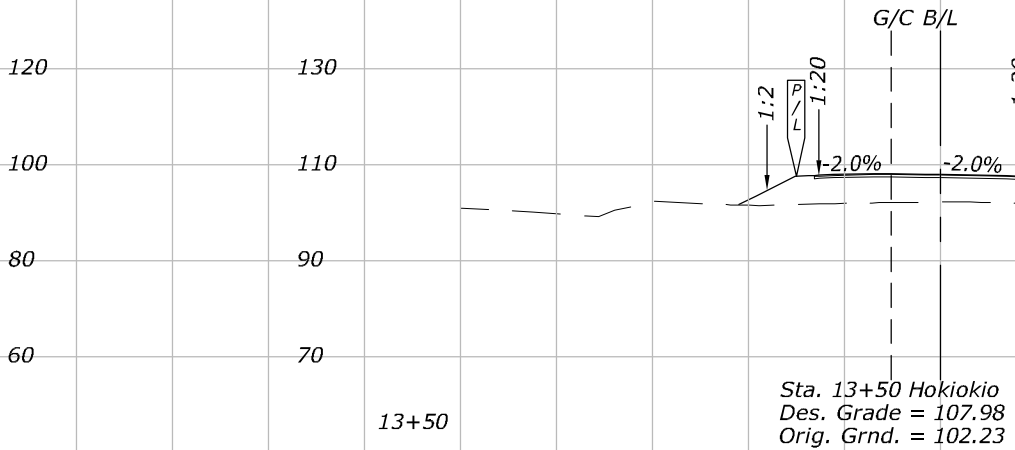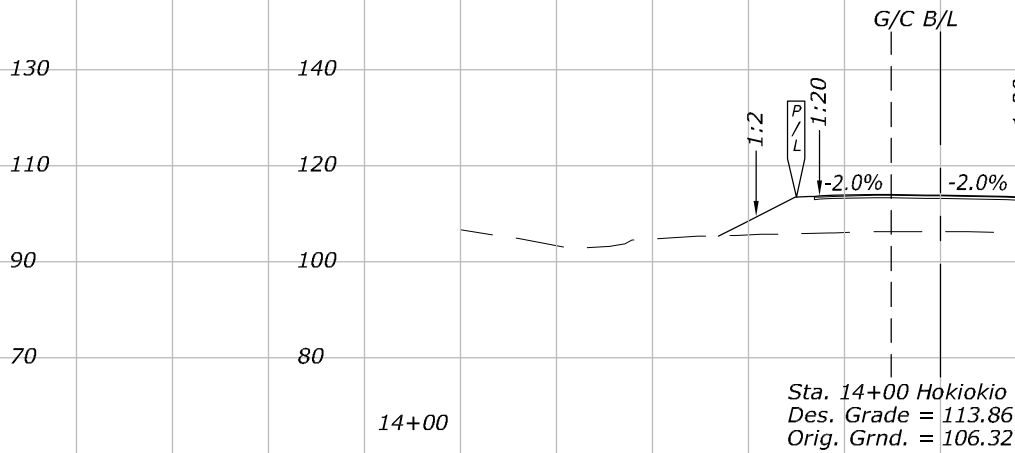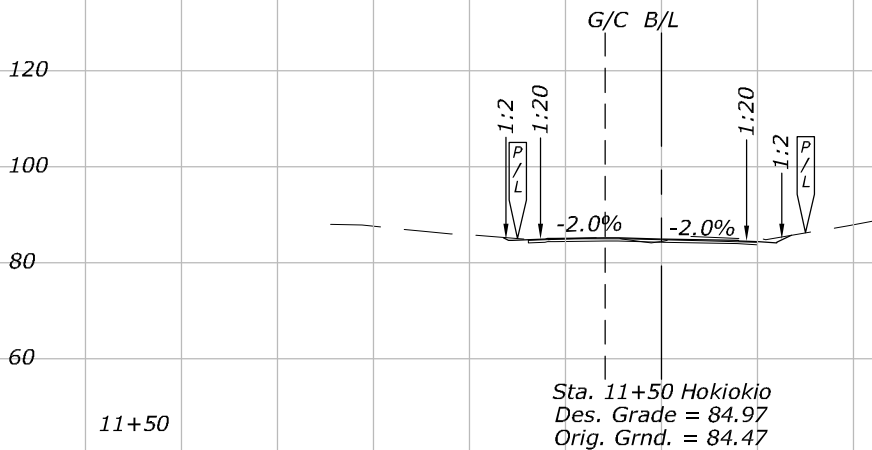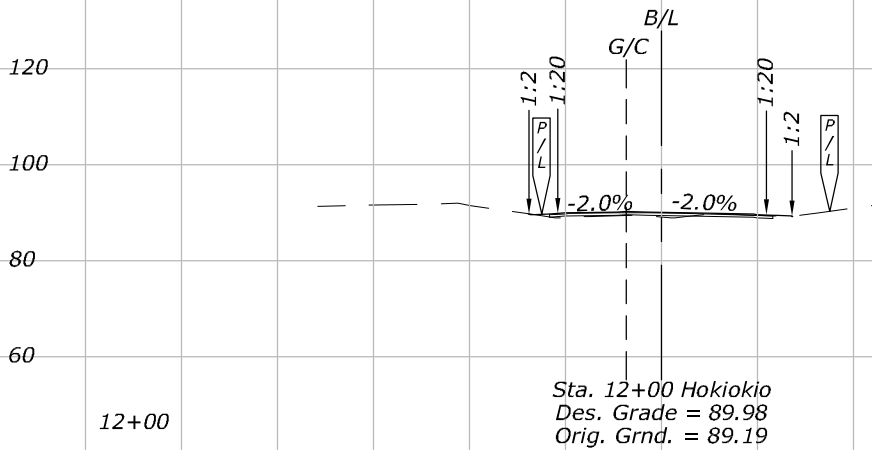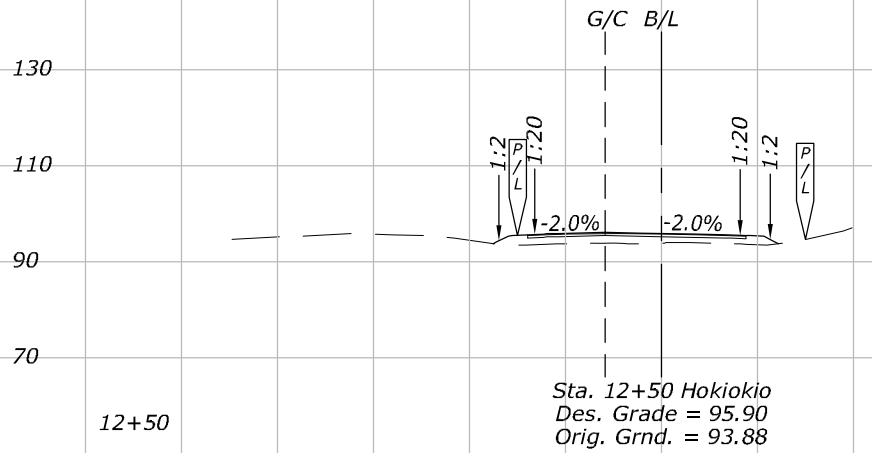

HOKIOKIO CROSS SECTIONS 11+50 TO 14+00

Patricia Choy

W:\10226-01\Civil\CADD\Site\AS-BUILT\DWGS\DRIVE\_w\10226-01\Civil\CADD\Site\DWGS\Y2 Cross Sections.dwg


14:29:27

January 11, 2019

NOTES:



1. Elevations Shown on Roadway Sections are at  $\frac{P}{L}$ .
2. Slopes Based on Grade Control Line.

| STATE | PROJECT         | SHEET NO. |
|-------|-----------------|-----------|
| HI    | HI STP SR 30(1) | Y2        |

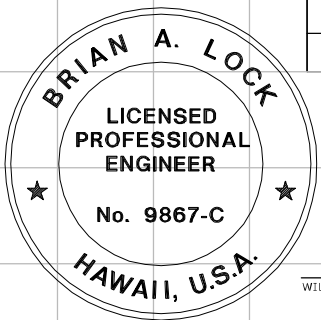

THIS WORK WAS PREPARED BY ME OR UNDER MY SUPERVISION.

WILSON OKAMOTO CORPORATION  
APRIL 30, 2020  
LIC. EXP. DATE

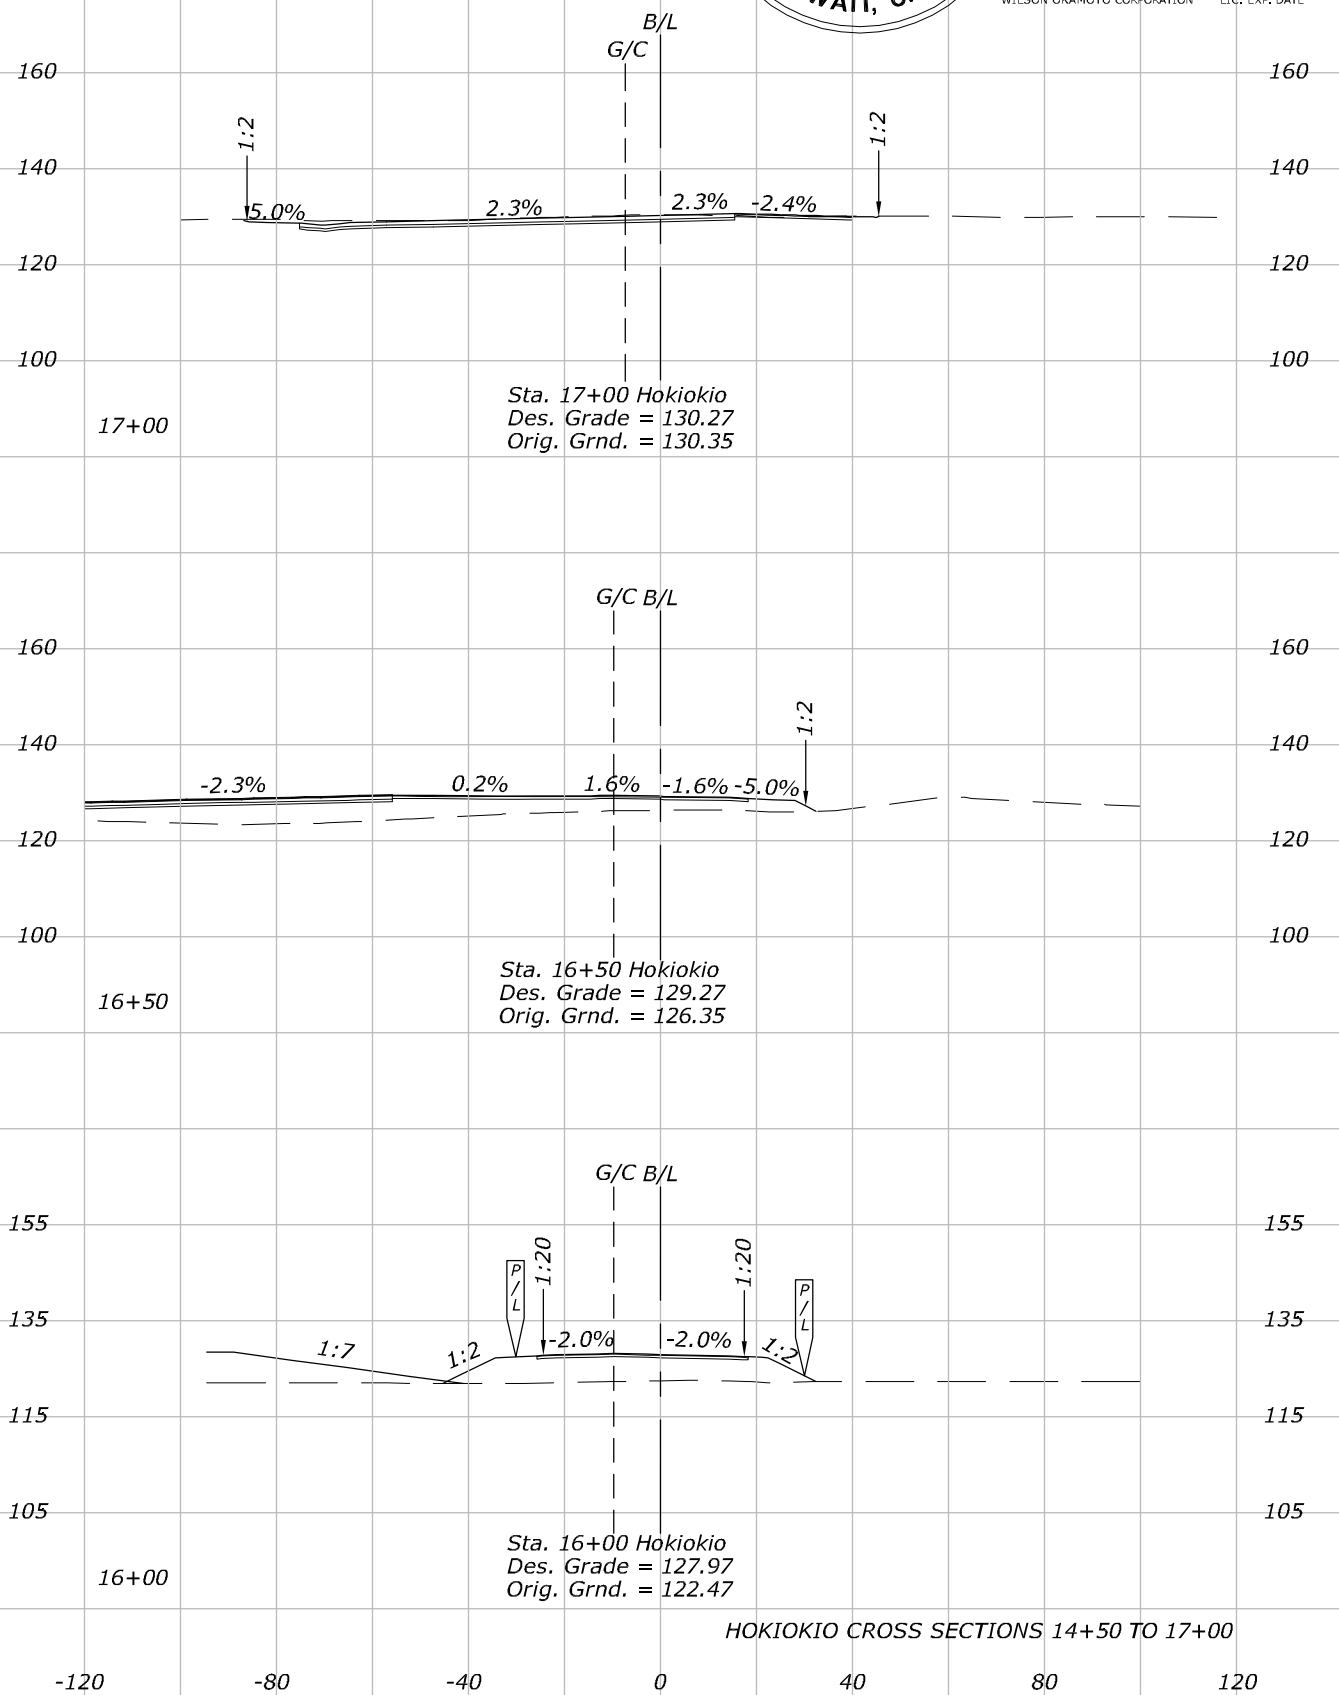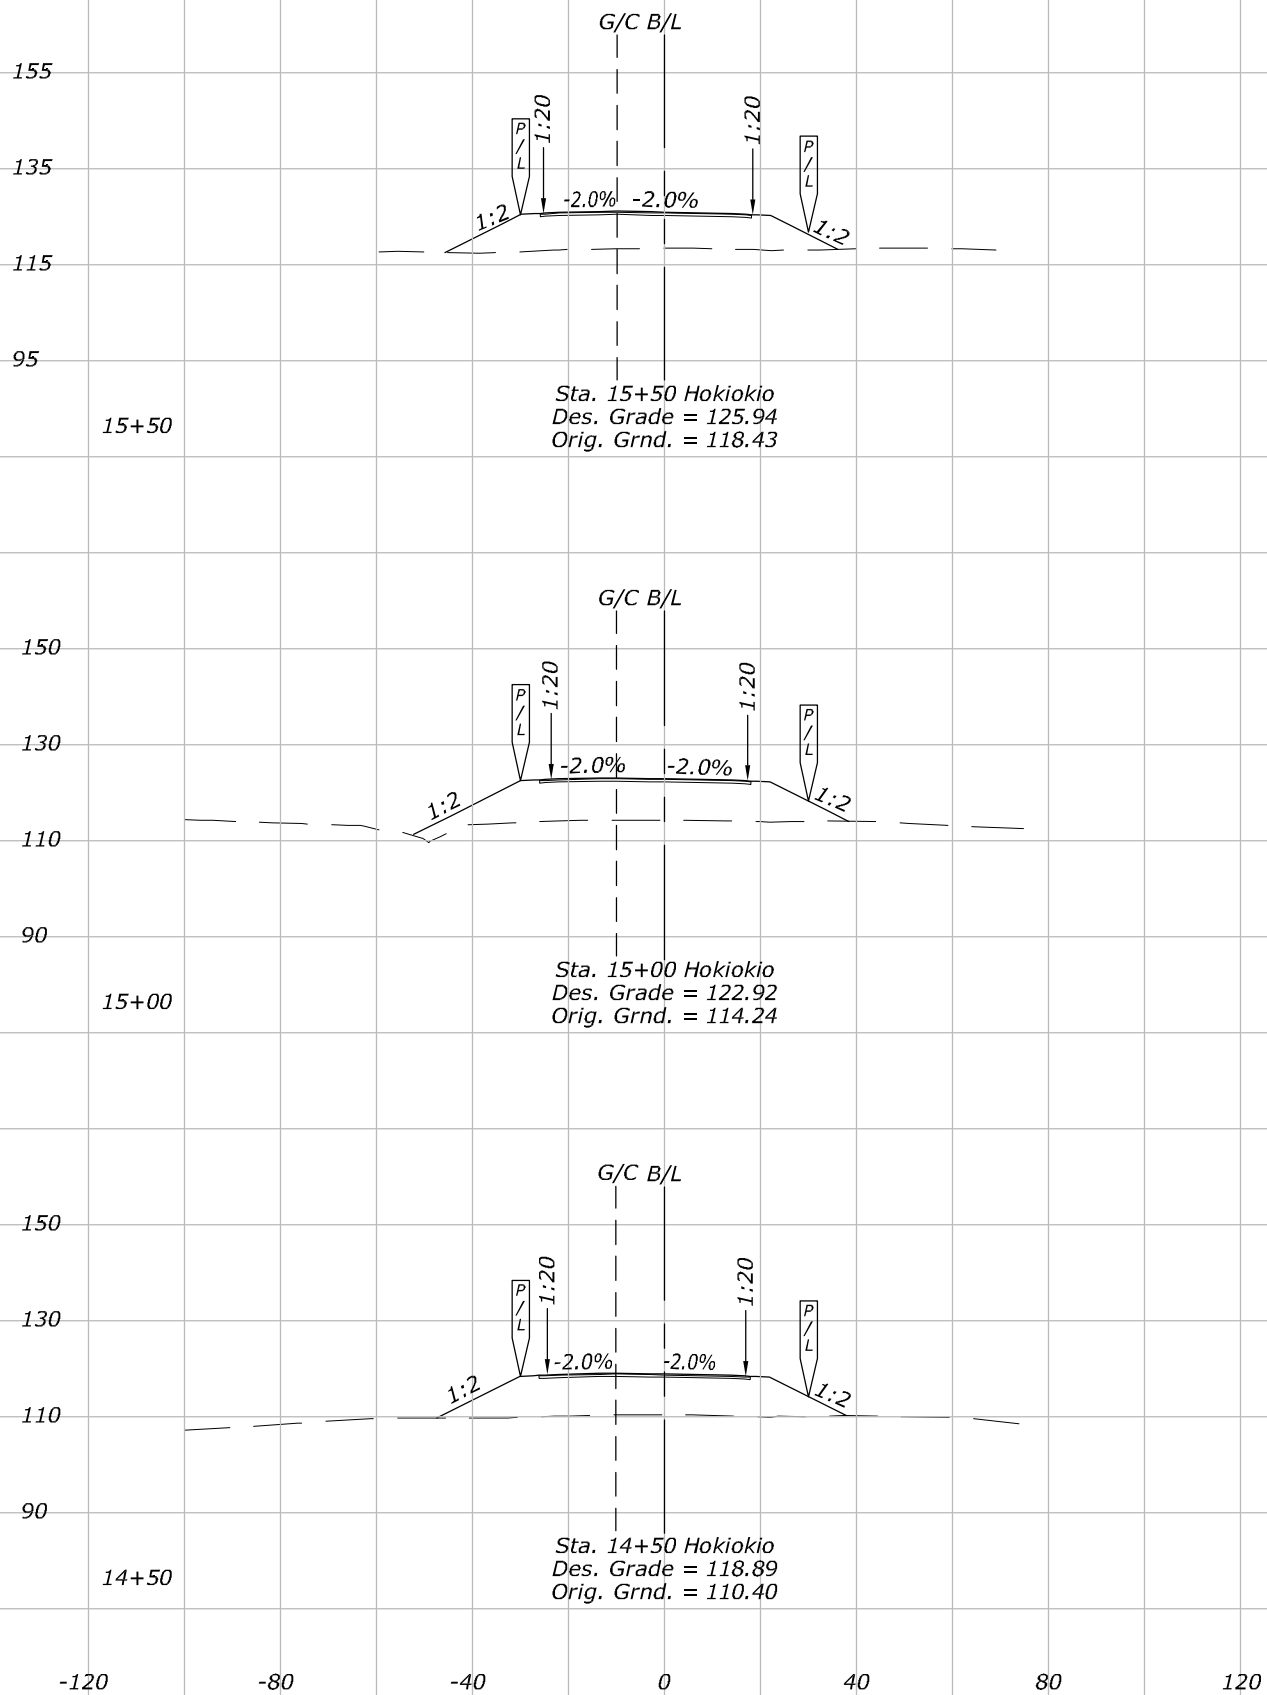

HOKIOKIO CROSS SECTIONS 14+50 TO 17+00

Patricia Choy


W:\102226-01\Civil\CADD\Site\DWGS\DRIVE - w\102226-01\Civil\CADD\Site\DWGS\Y3 Cross Sections.dwg

14:29:02

January 11, 2019

NOTES:



- Elevations Shown on Roadway Sections are at  $\frac{P}{L}$ .
- Slopes Based on Grade Control Line.

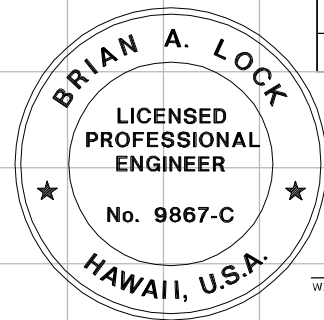

| STATE | PROJECT         | SHEET NO. |
|-------|-----------------|-----------|
| HI    | HI STP SR 30(1) | Y3        |

THIS WORK WAS PREPARED BY ME  
OR UNDER MY SUPERVISION.

WILSON OKAMOTO CORPORATION  
APRIL 30, 2020  
LIC. EXP. DATE

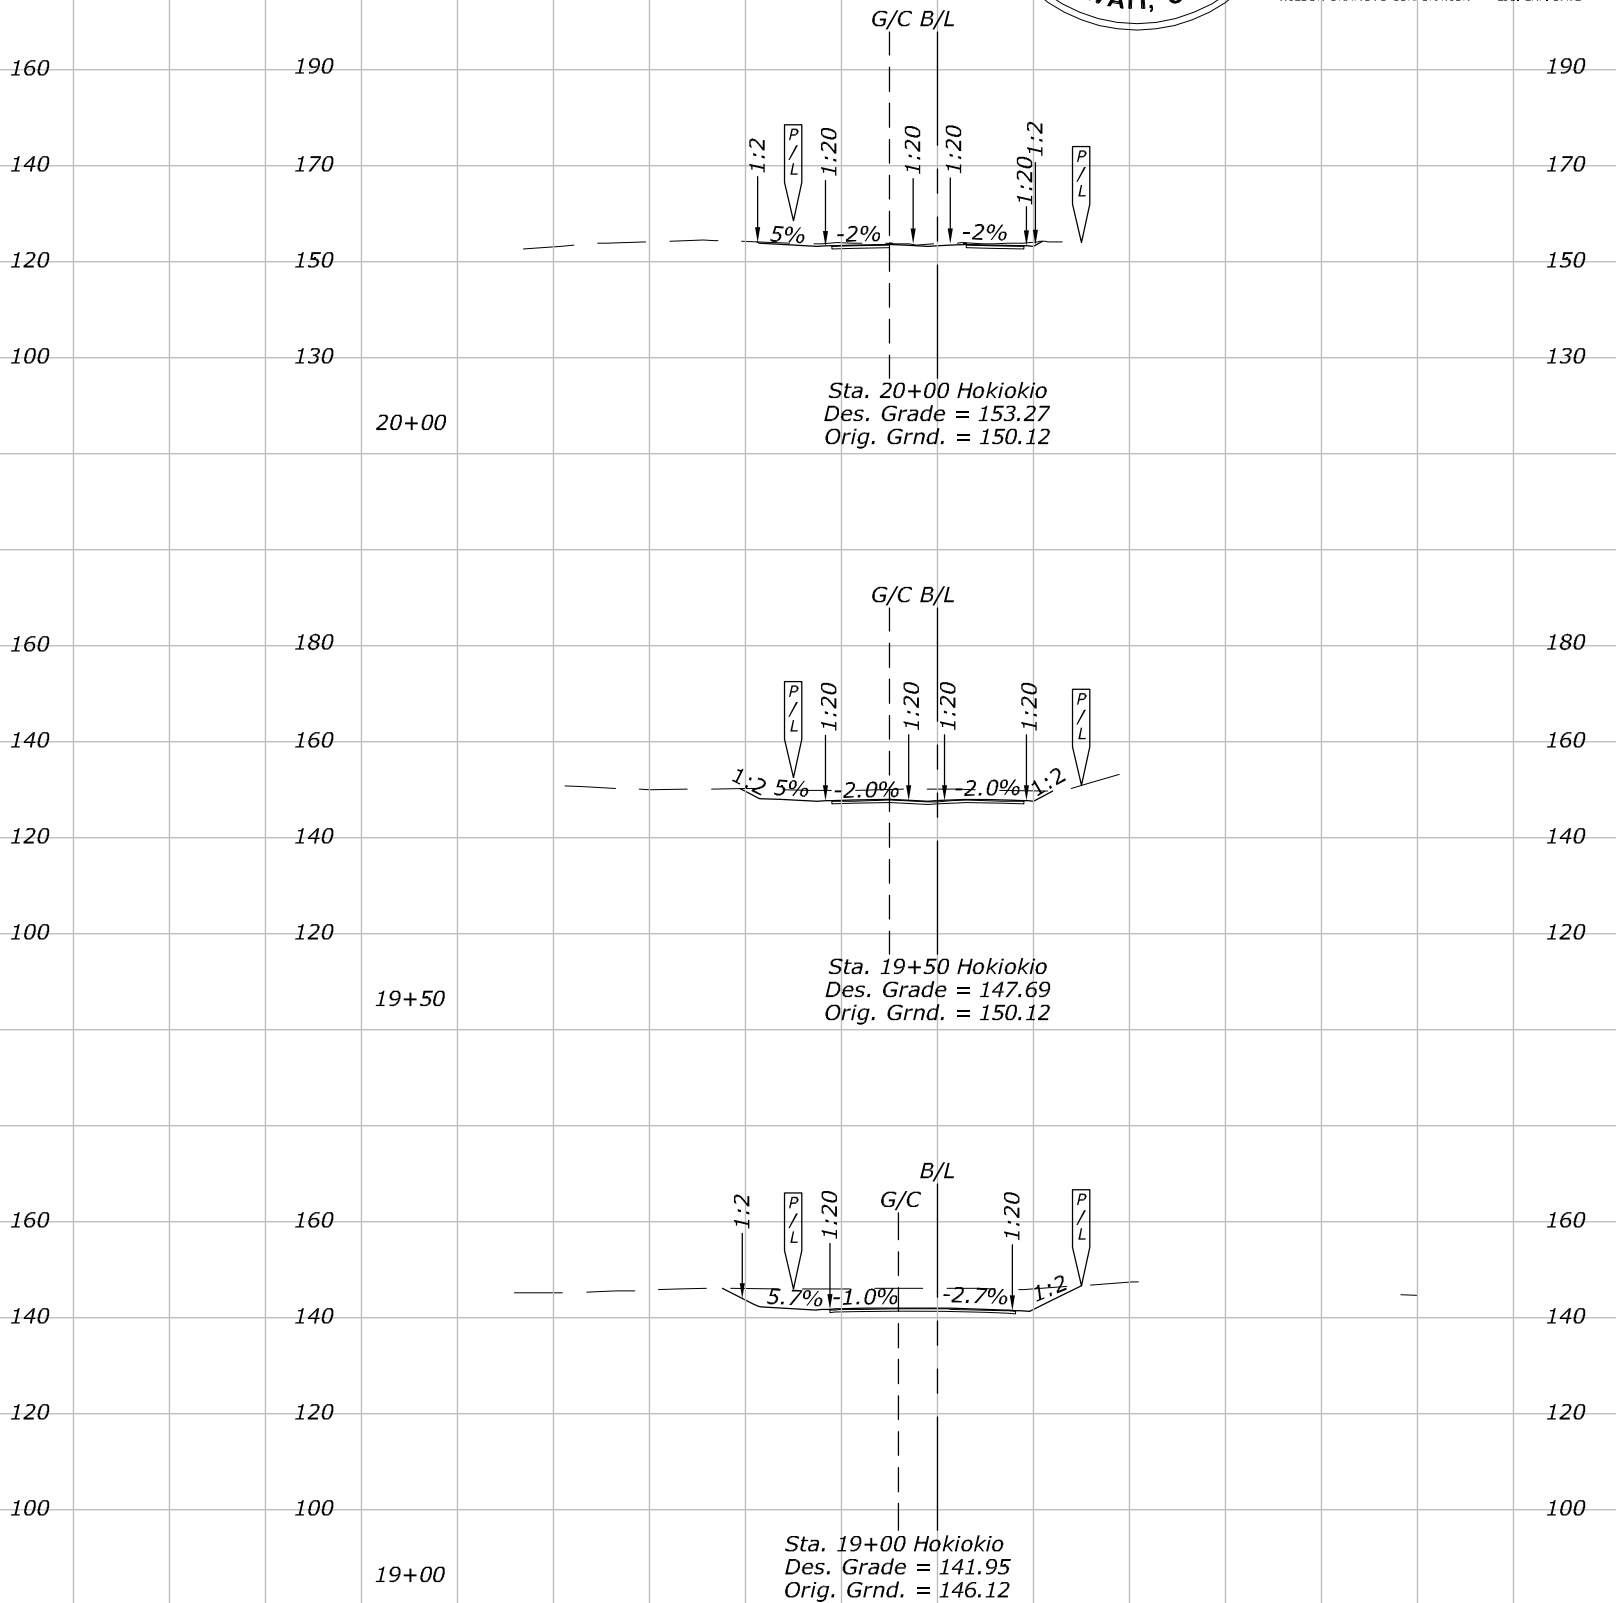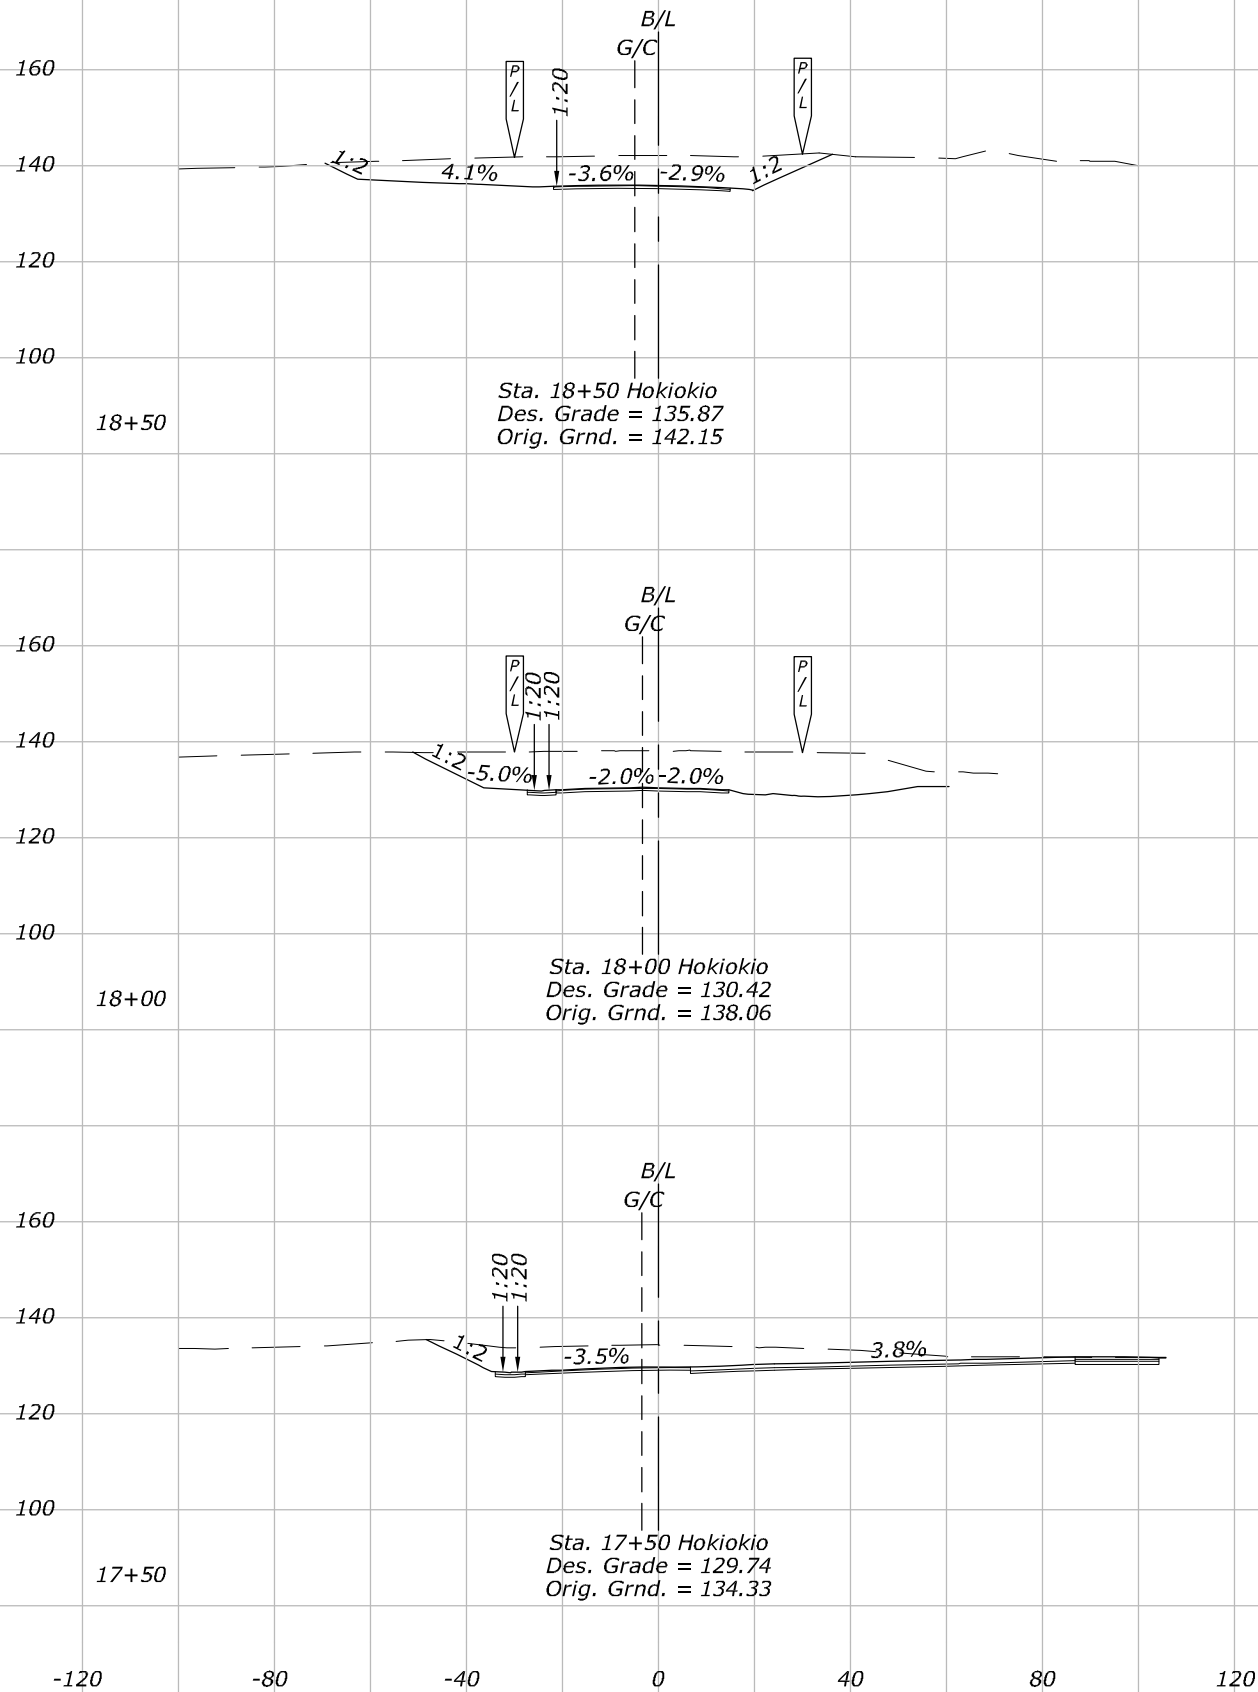

HOKIOKIO CROSS SECTIONS 17+50 TO 20+00

Patricia Choy


W:\10226-01\Civil\CADD\Site\AS-BUILT\DWGS\DRIVE - w\10226-01\Civil\CADD\Site\DWGS\Y4 Cross Sections.dwg

14:28:41


January 11, 2019

NOTES:

- 1. Elevations Shown on Roadway Sections are at  $\frac{P}{L}$ .
- 2. Slopes Based on Grade Control Line.

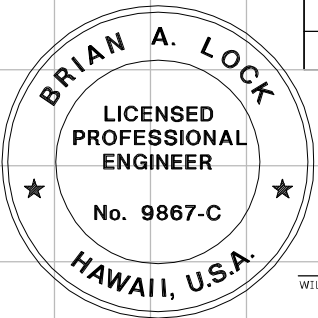

| STATE                                                 | PROJECT         | SHEET NO.                        |
|-------------------------------------------------------|-----------------|----------------------------------|
| HI                                                    | HI STP SR 30(1) | Y4                               |
| THIS WORK WAS PREPARED BY ME OR UNDER MY SUPERVISION. |                 |                                  |
| WILSON OKAMOTO CORPORATION                            |                 | APRIL 30, 2020<br>LIC. EXP. DATE |

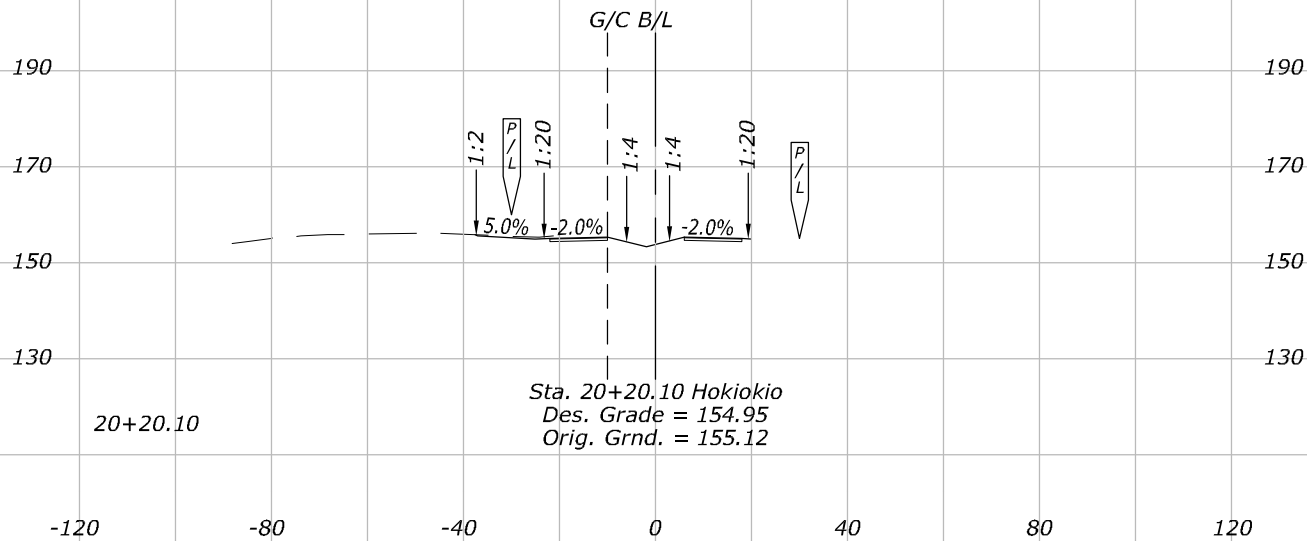

HOKIOKIO CROSS SECTIONS 20+20.10

Patricia Choy

W:\10226-01\Civil\CADD\Site\DWGS\DRIVE\_w\10226-01\Civil\CADD\Site\DWGS\Y5 Cross Sections.dwg


14:28:22

January 11, 2019

NOTES:


1. Elevations Shown on Roadway  
Sections are at 5'.

| STATE | PROJECT         | SHEET NO. |
|-------|-----------------|-----------|
| HI    | HI STP SR 30(1) | Y5        |

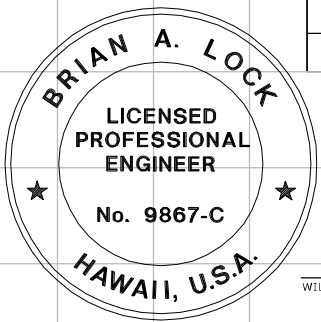

THIS WORK WAS PREPARED BY ME  
OR UNDER MY SUPERVISION.

WILSON OKAMOTO CORPORATION  
APRIL 30, 2020  
LIC. EXP. DATE

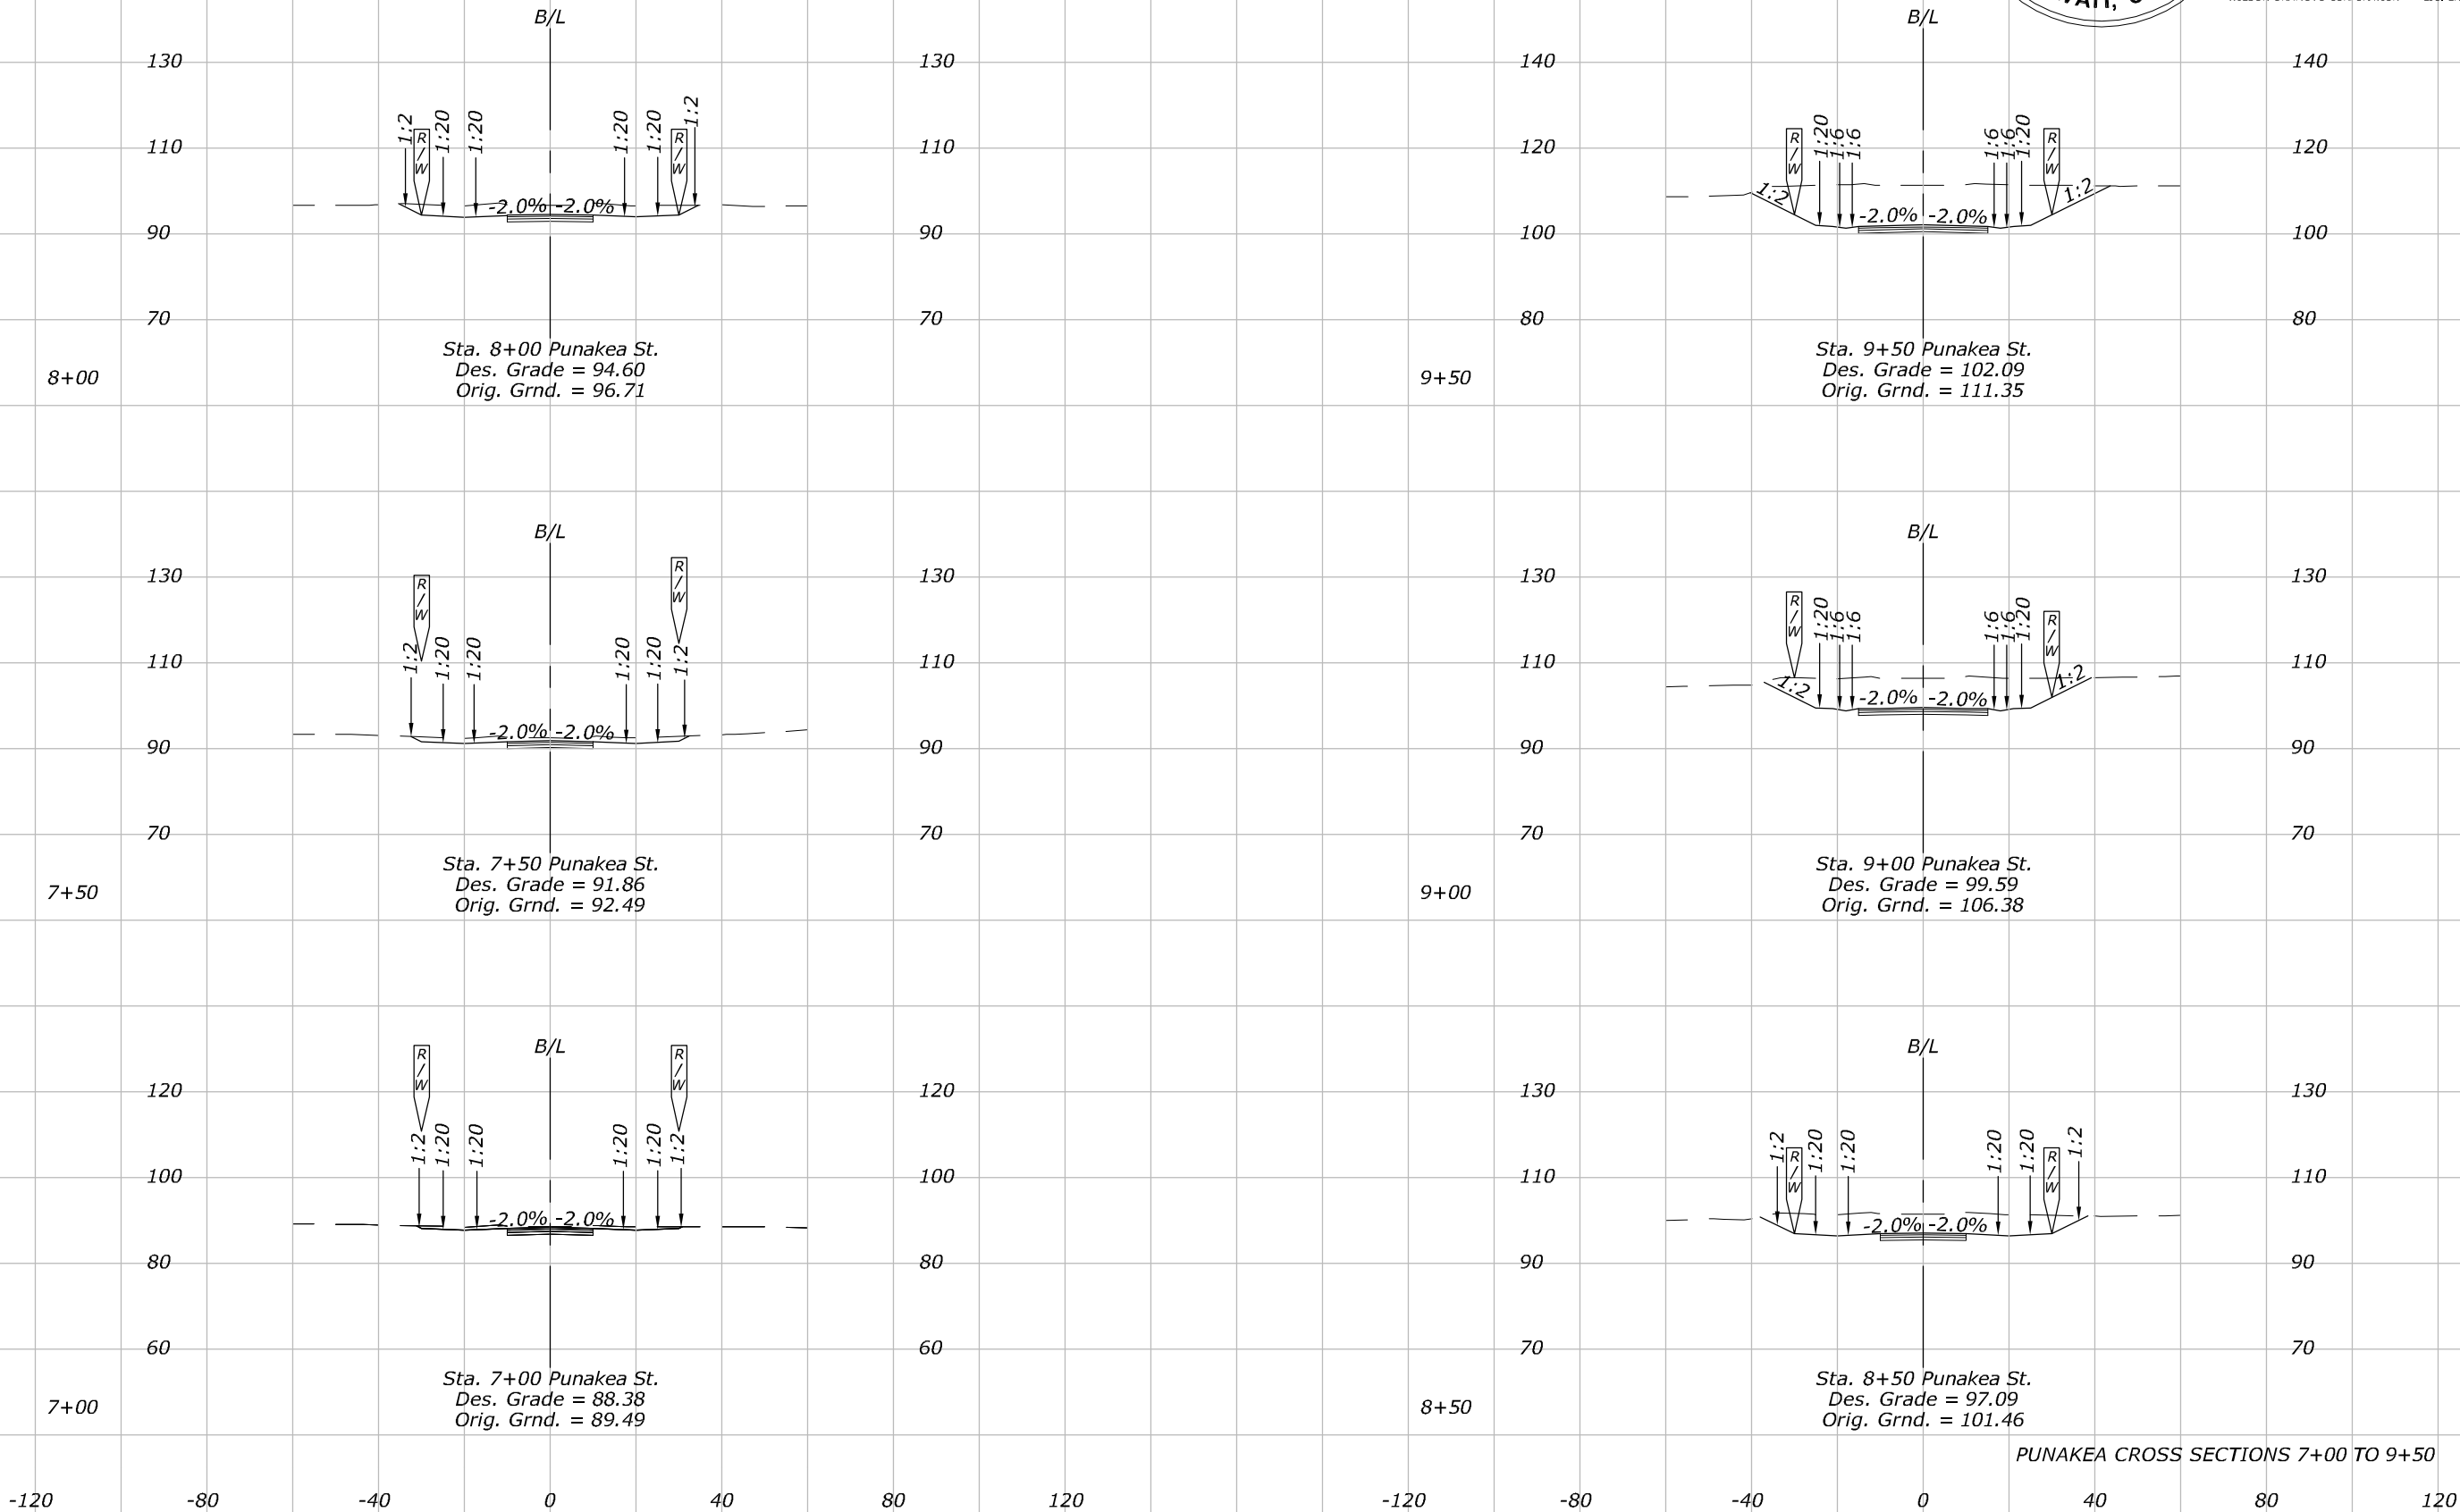

Patricia Choy

W:\10226-01\Civil\CADD\Site\DWGS\Y6 Cross Sections.dwg


14:27:40

January 11, 2019

NOTES:







1. Elevations Shown on Roadway  
Sections are at 5'.

| STATE | PROJECT         | SHEET NO. |
|-------|-----------------|-----------|
| HI    | HI STP SR 30(1) | Y6        |

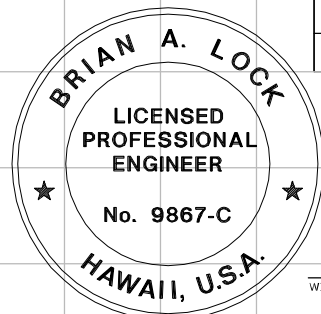

THIS WORK WAS PREPARED BY ME  
OR UNDER MY SUPERVISION.

WILSON OKAMOTO CORPORATION  
APRIL 30, 2020  
LIC. EXP. DATE

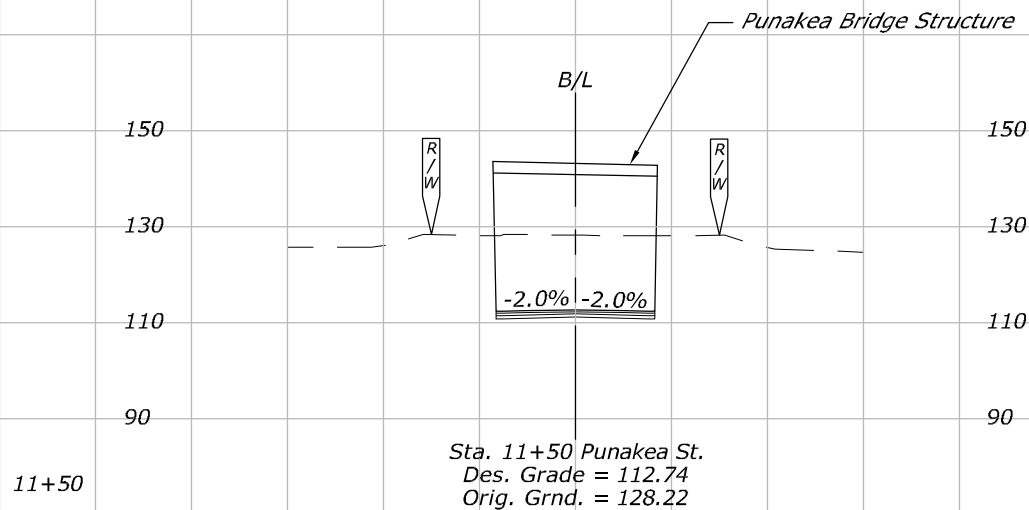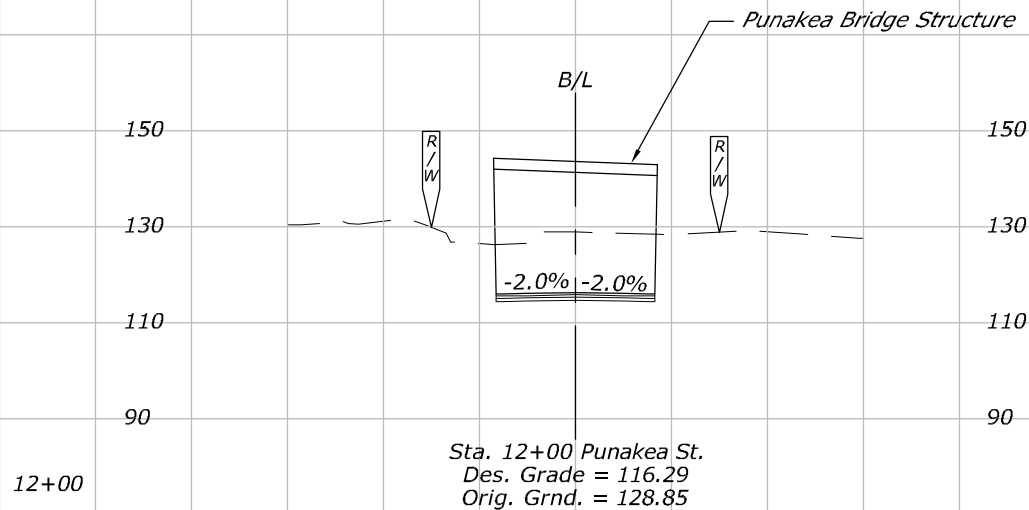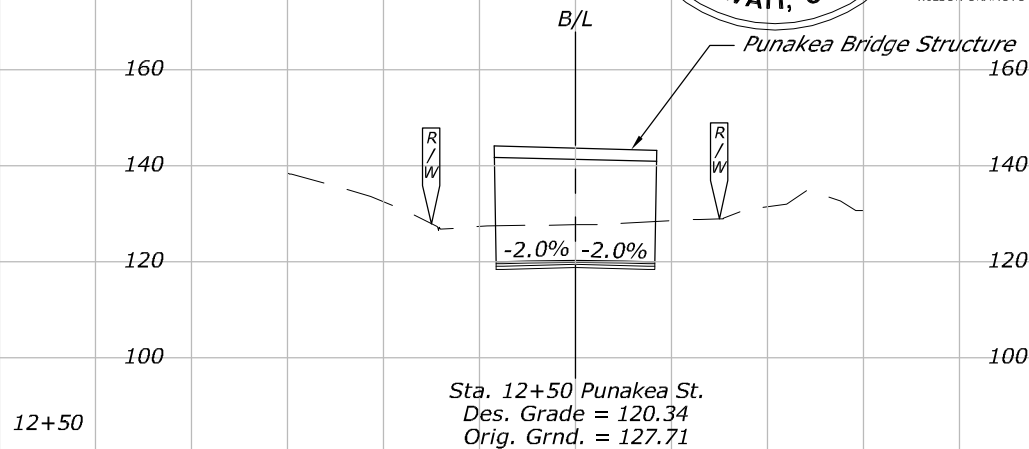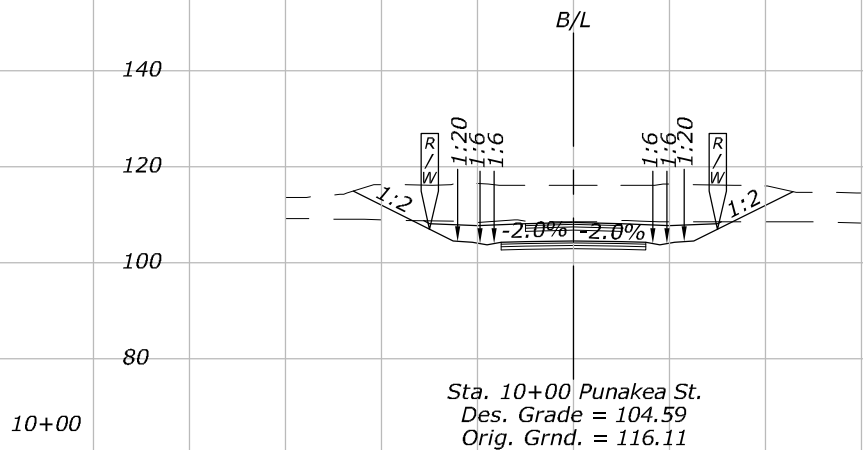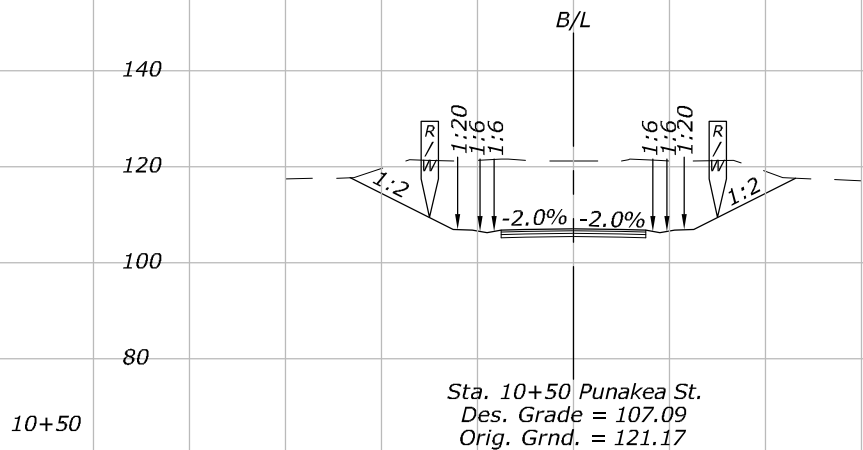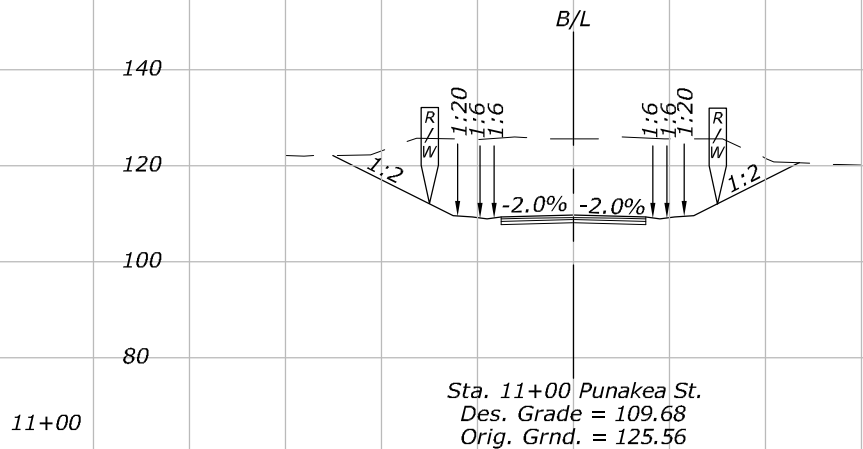

PUNAKEA CROSS SECTIONS 10+00 TO 12+50

Patricia Choy

W:\10226-01\Civil\CADD\Site\AS-BUILT\DWGS\DRIVE - w\10226-01\Civil\CADD\Site\DWGS\Y7 Cross Sections.dwg



14:27:10

January 11, 2019

NOTES:

1. Elevations Shown on Roadway  
Sections are at 5'.

| STATE | PROJECT         | SHEET NO. |
|-------|-----------------|-----------|
| HI    | HI STP SR 30(1) | Y7        |

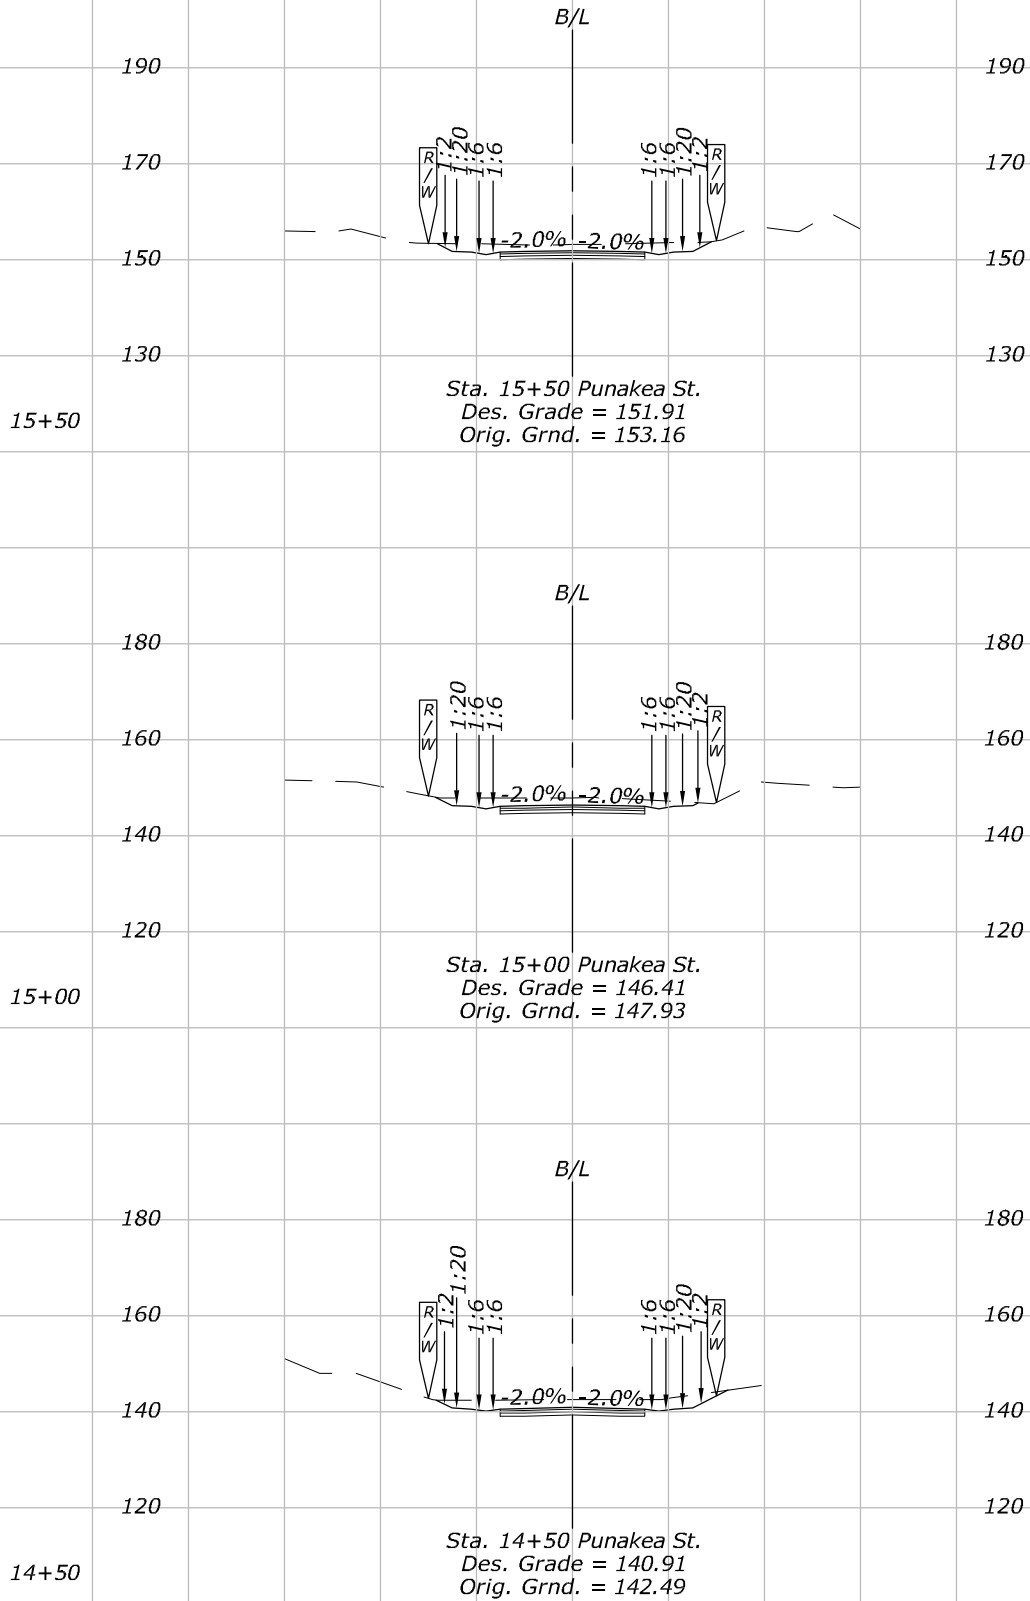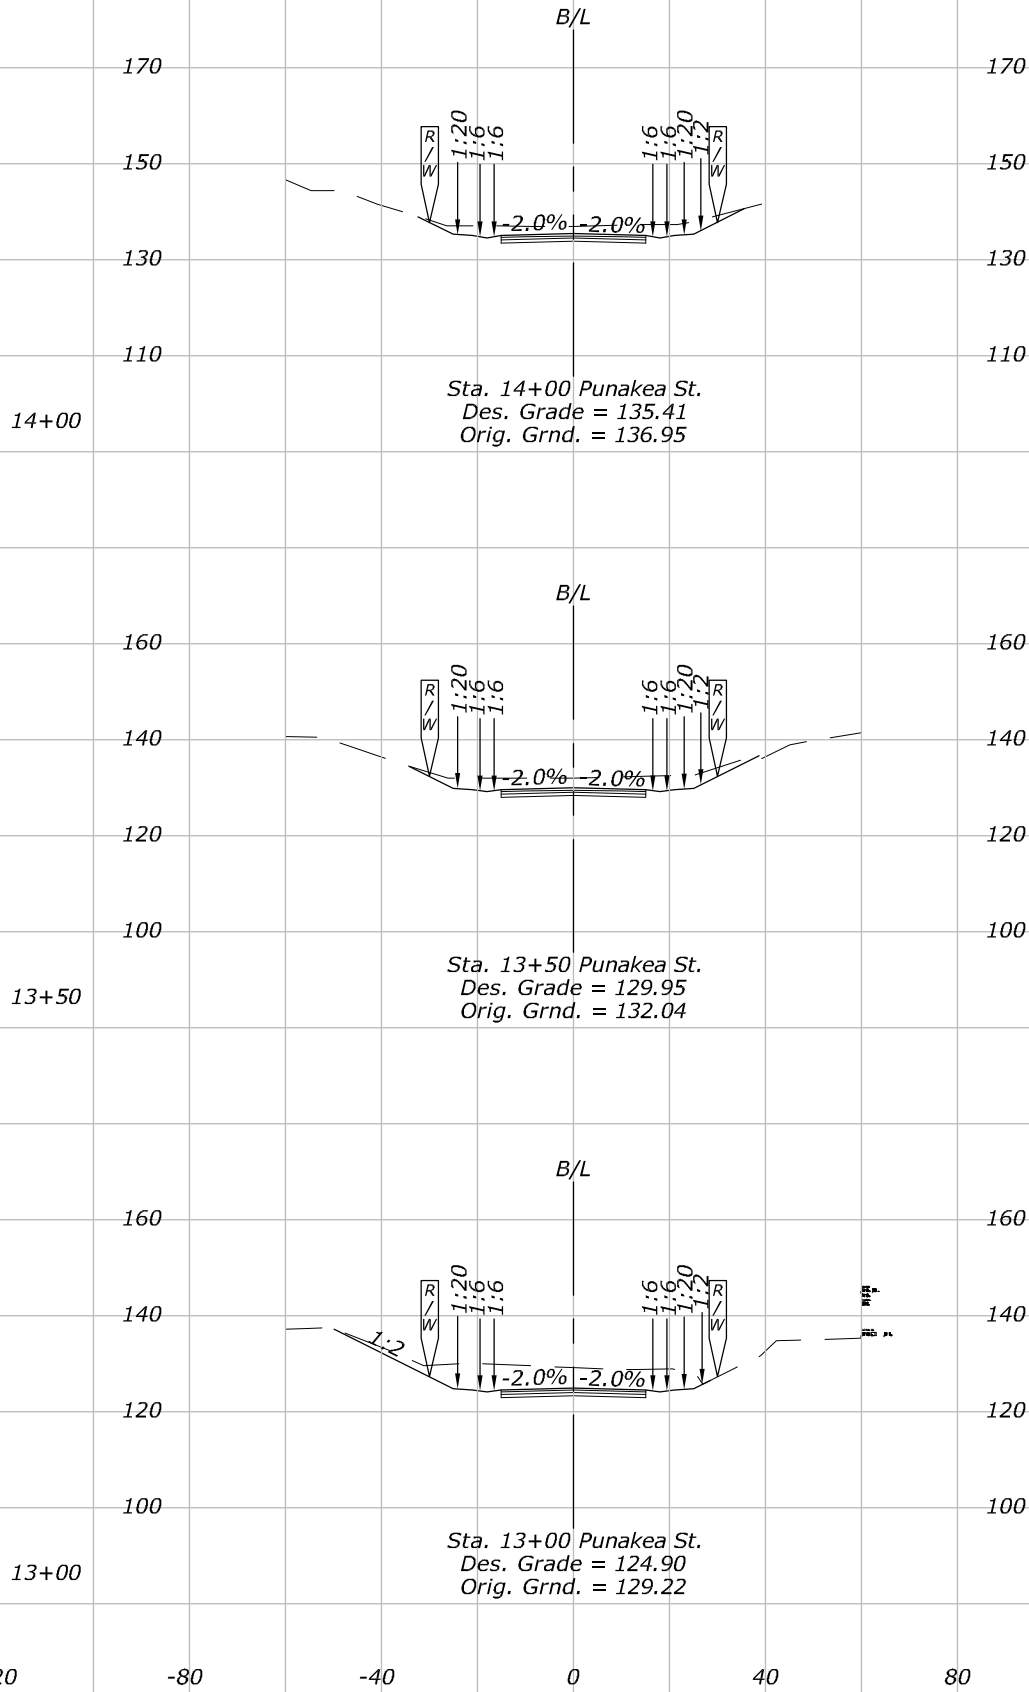

PUNAKEA CROSS SECTIONS 13+00 TO 15+50

Patricia Choy


W:\10226-01\Civil\CADD\Site\DWGS\Y8 Cross Sections.dwg

14:26:39





January 11, 2019

NOTES:

1. Elevations Shown on Roadway  
Sections are at 10'.

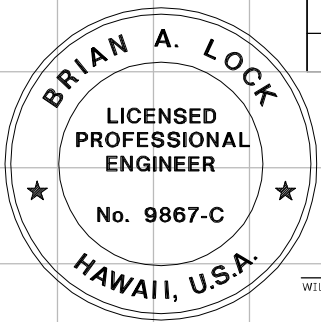

| STATE                                                    | PROJECT         | SHEET NO.                        |
|----------------------------------------------------------|-----------------|----------------------------------|
| HI                                                       | HI STP SR 30(1) | Y8                               |
| THIS WORK WAS PREPARED BY ME<br>OR UNDER MY SUPERVISION. |                 | APRIL 30, 2020<br>LIC. EXP. DATE |
| WILSON OKAMOTO CORPORATION                               |                 |                                  |

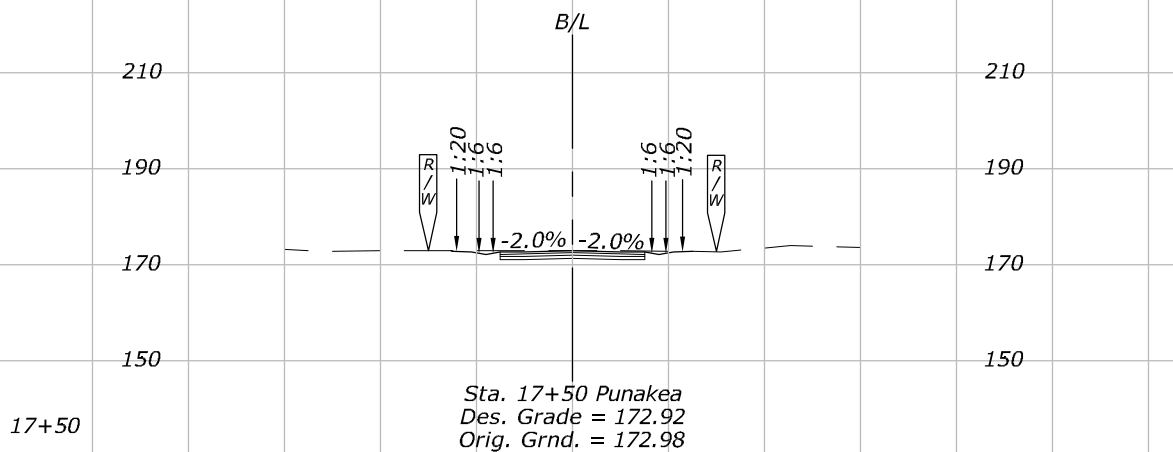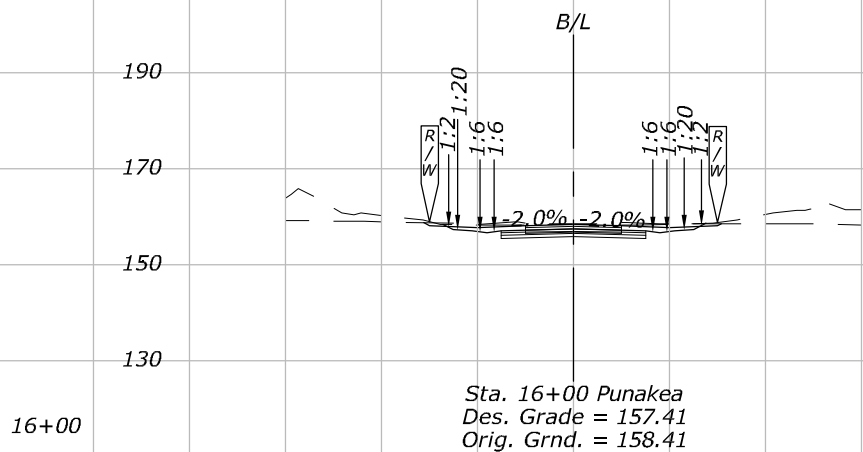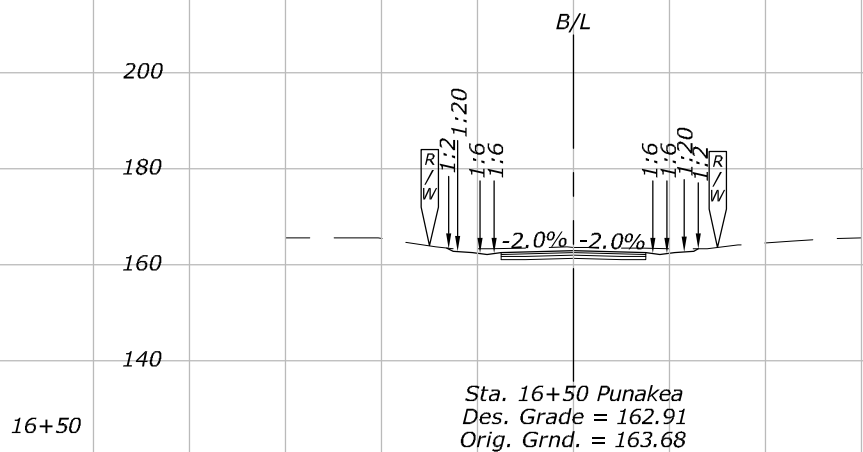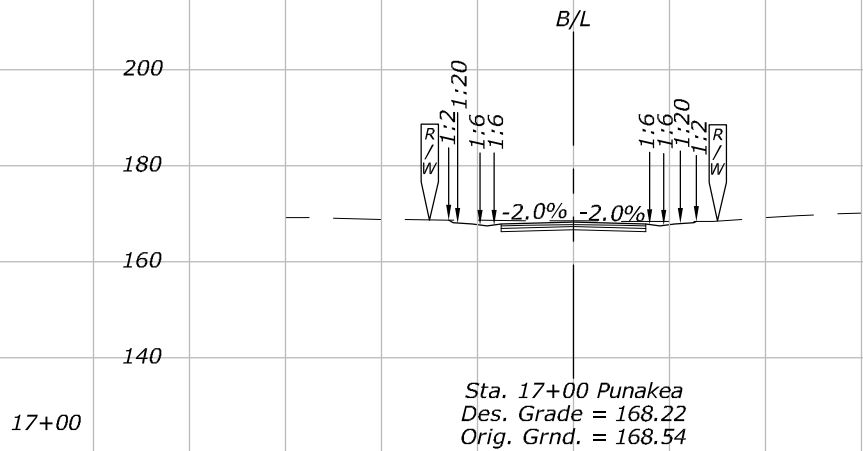

PUNAKEA CROSS SECTIONS 16+00 TO 17+50

Patricia Choy

W:\10226-01\Civil\CADD\Site\DWGS\DRIVE - w\10226-01\Civil\CADD\Site\DWGS\Y9 Cross Sections.dwg


14:26:07

January 11, 2019

NOTES:

1. Elevations Shown on Roadway  
Sections are at 5'.


| STATE | PROJECT         | SHEET NO. |
|-------|-----------------|-----------|
| HI    | HI STP SR 30(1) | Y9        |

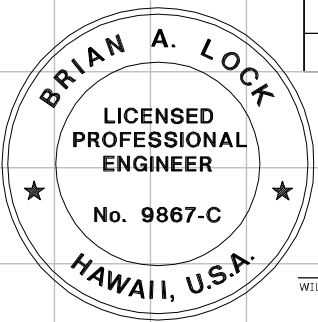


THIS WORK WAS PREPARED BY ME  
OR UNDER MY SUPERVISION.

WILSON OKAMOTO CORPORATION  
APRIL 30, 2020  
LIC. EXP. DATE


1+50

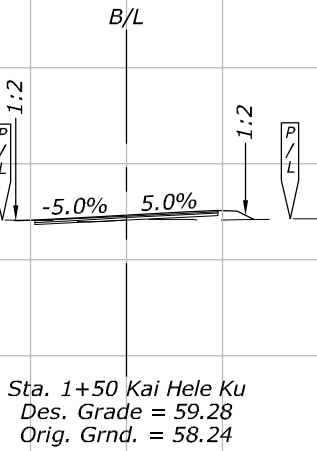


3+00

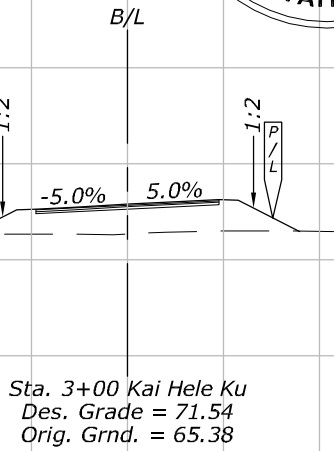


1+00

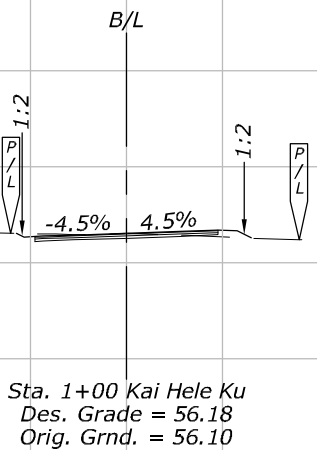


2+50

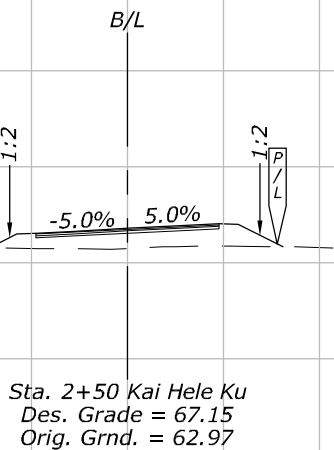

0+50

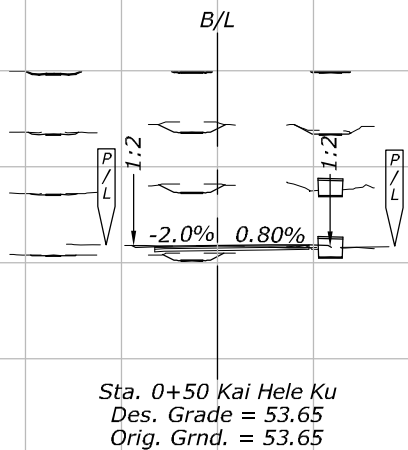

2+00

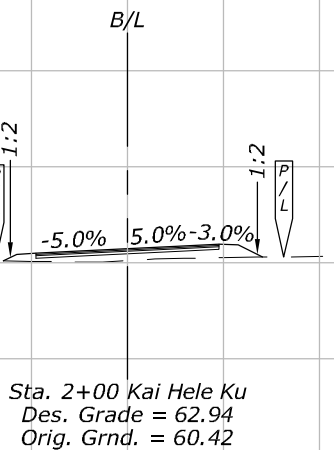

KAI HELE KU CROSS SECTIONS 0+50 TO 3+00

Patricia Choy

W:\10226-01\Civil\CADD\Site\AS-BUILT\DWGS\DRIVE\_w\10226-01\Civil\CADD\Site\DWGS\Y10 Cross Sections.dwg


14:20:22

January 11, 2019

NOTES:



1. Elevations Shown on Roadway  
Sections are at 10'.

| STATE | PROJECT         | SHEET NO. |
|-------|-----------------|-----------|
| HI    | HI STP SR 30(1) | Y10       |

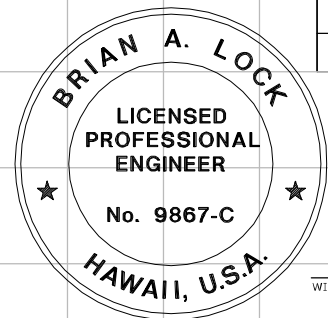

THIS WORK WAS PREPARED BY ME  
OR UNDER MY SUPERVISION.

WILSON OKAMOTO CORPORATION  
APRIL 30, 2020  
LIC. EXP. DATE

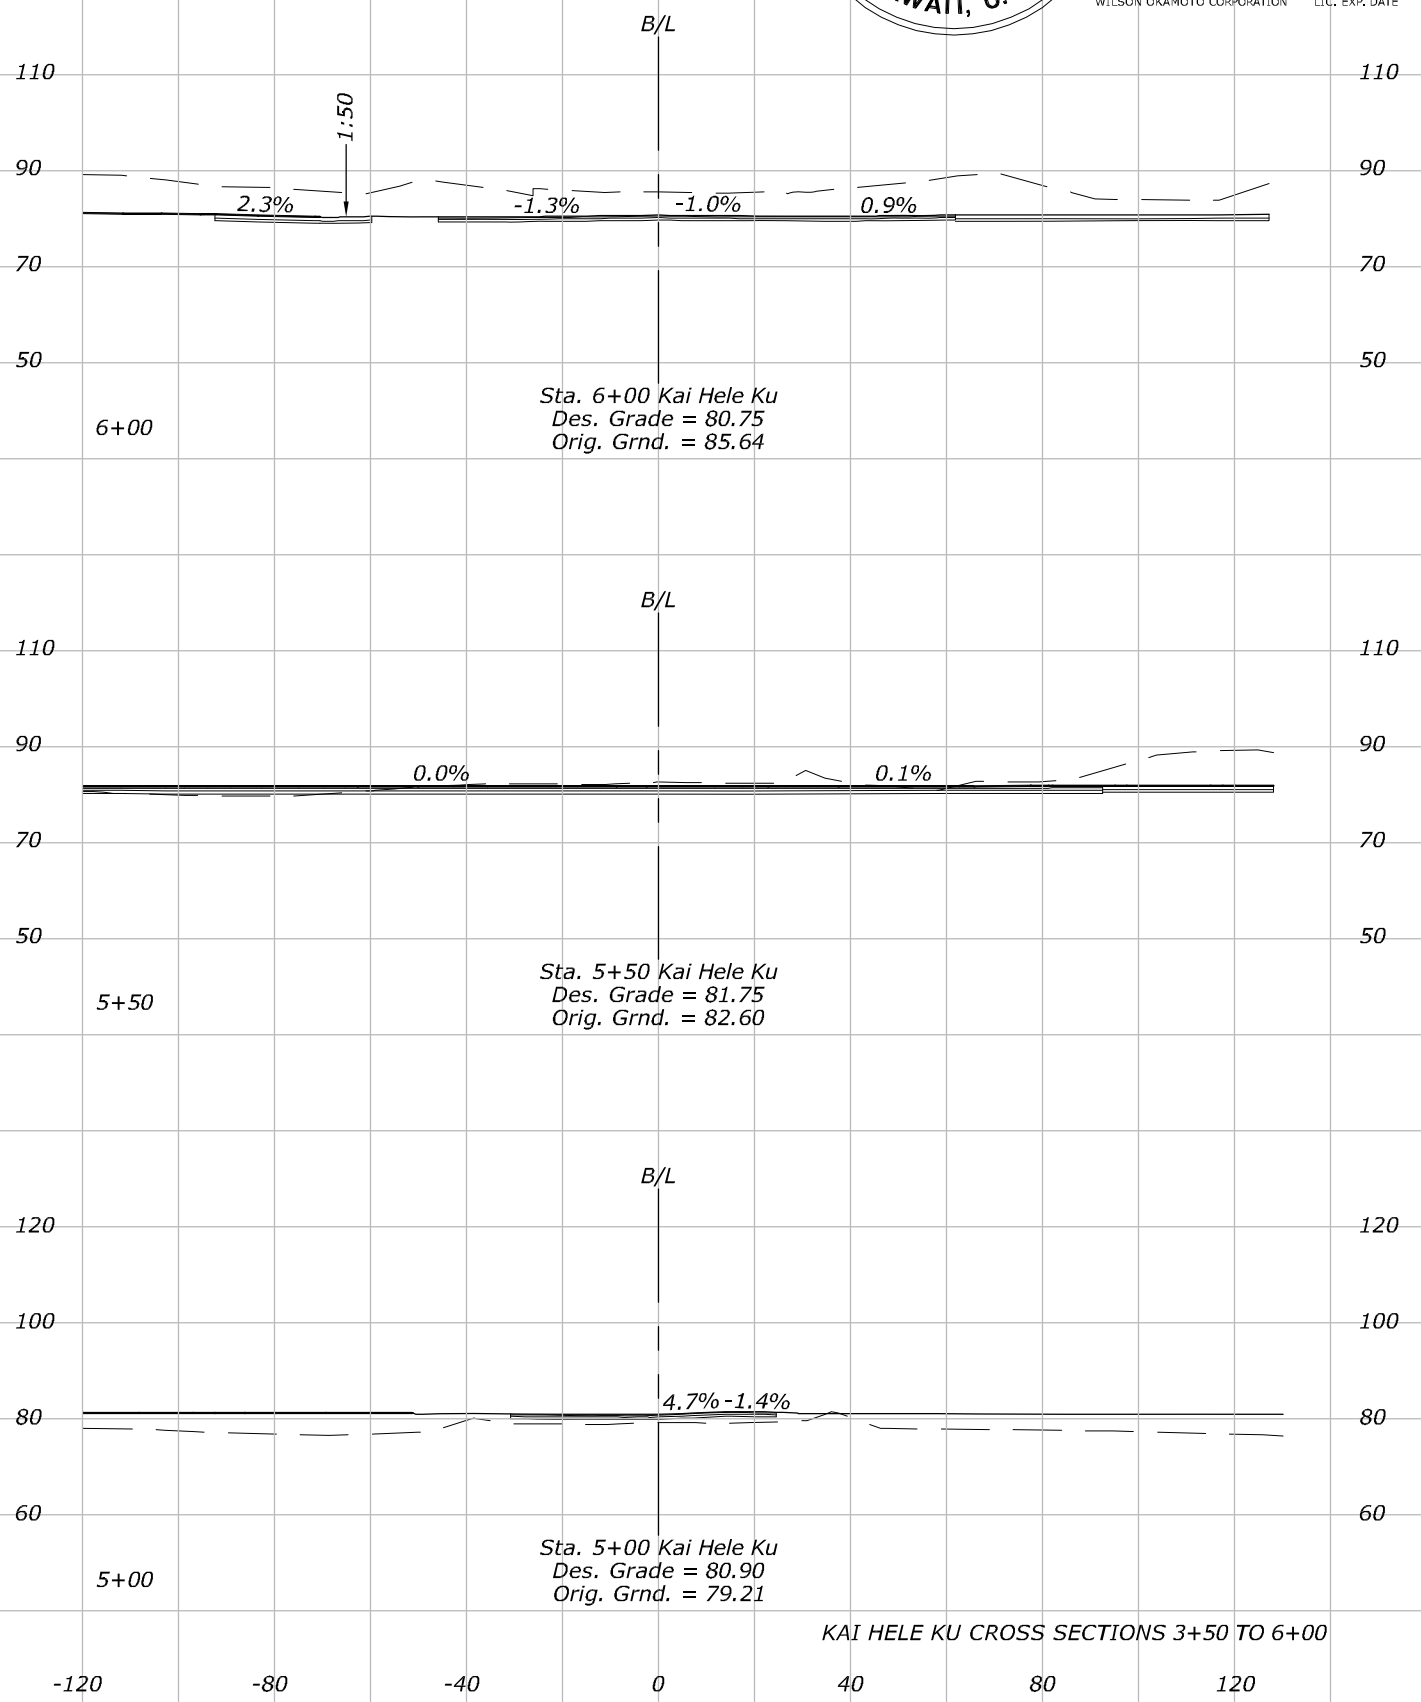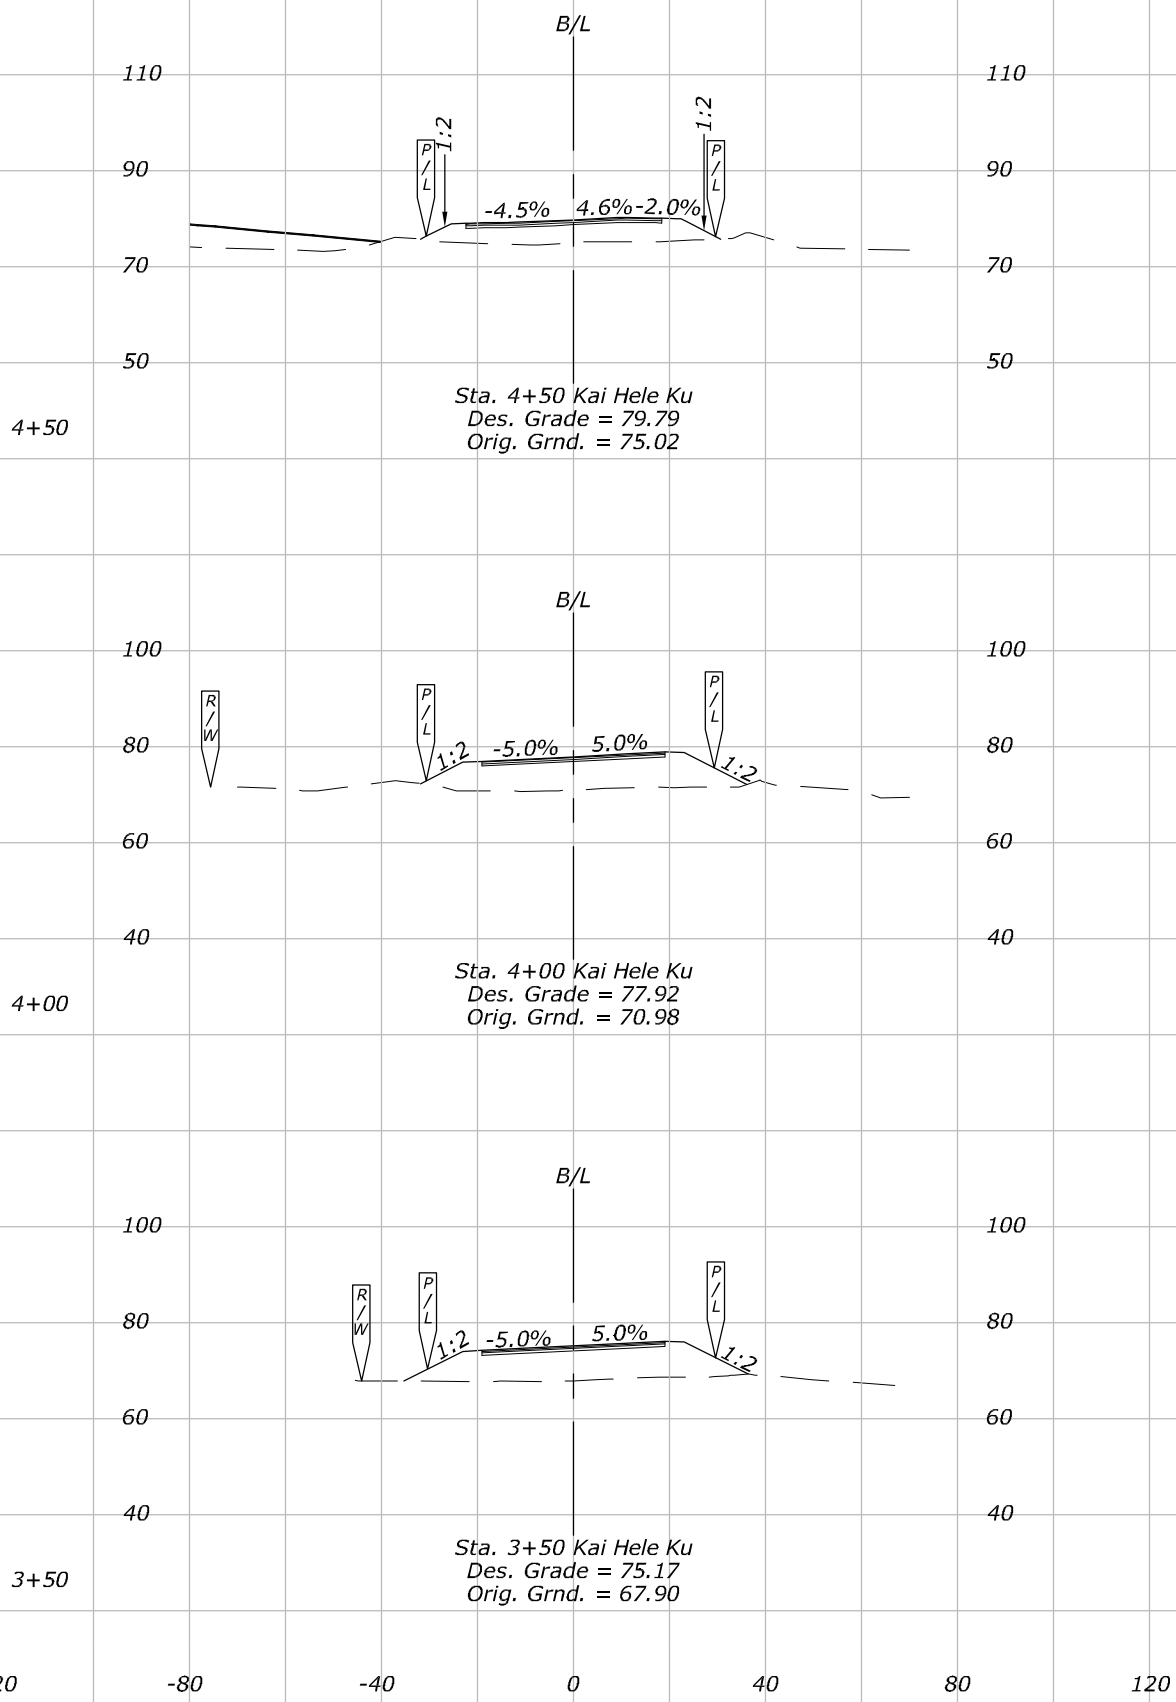

KAI HELE KU CROSS SECTIONS 3+50 TO 6+00

Patricia Choy

W:\102226-01\Civil\CADD\Site\DWGS\DRIVE\_w\102226-01\Civil\CADD\Site\DWGS\Y11 Cross Sections.dwg


14:21:09

January 11, 2019







NOTES:

1. Elevations Shown on Roadway  
Sections are at 5'.

| STATE | PROJECT         | SHEET NO. |
|-------|-----------------|-----------|
| HI    | HI STP SR 30(1) | Y11       |

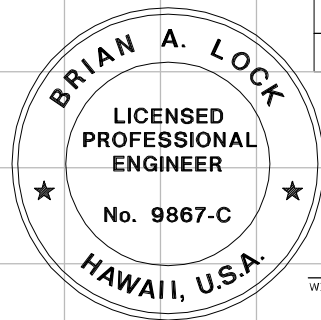

THIS WORK WAS PREPARED BY ME  
OR UNDER MY SUPERVISION.  
WILSON OKAMOTO CORPORATION  
APRIL 30, 2020  
LIC. EXP. DATE

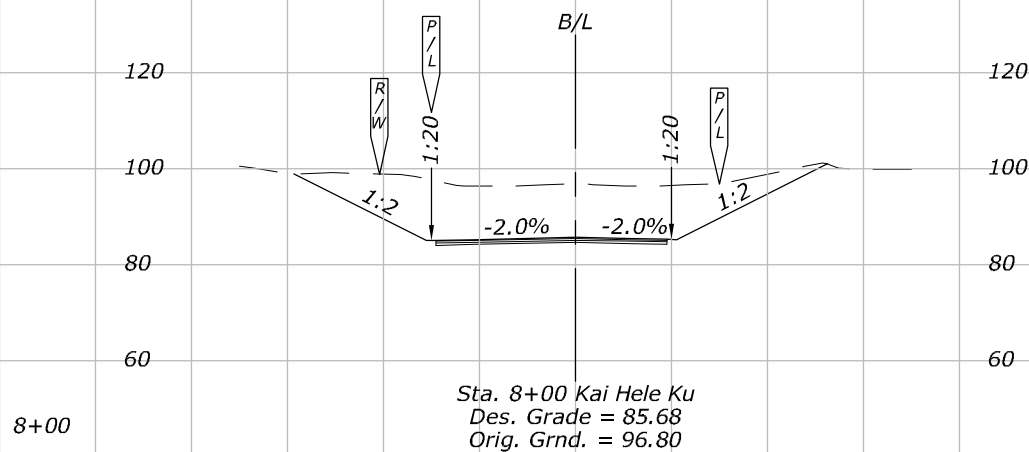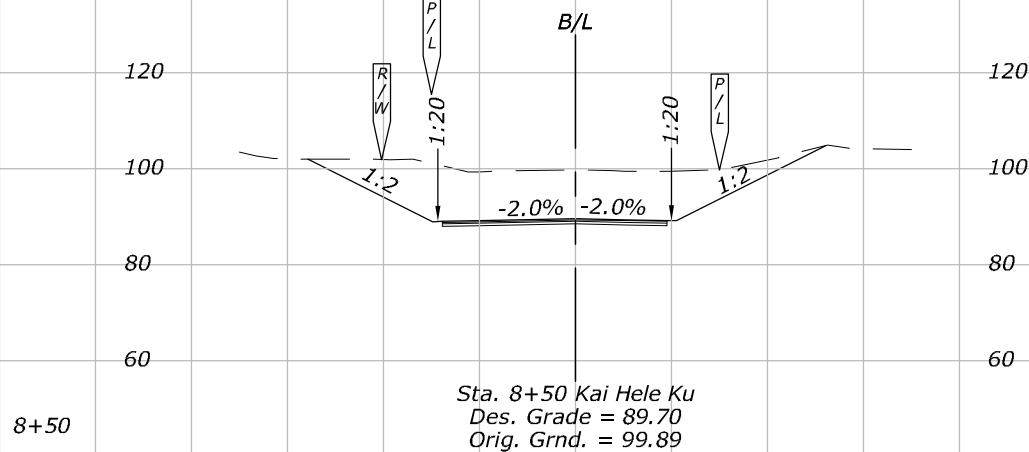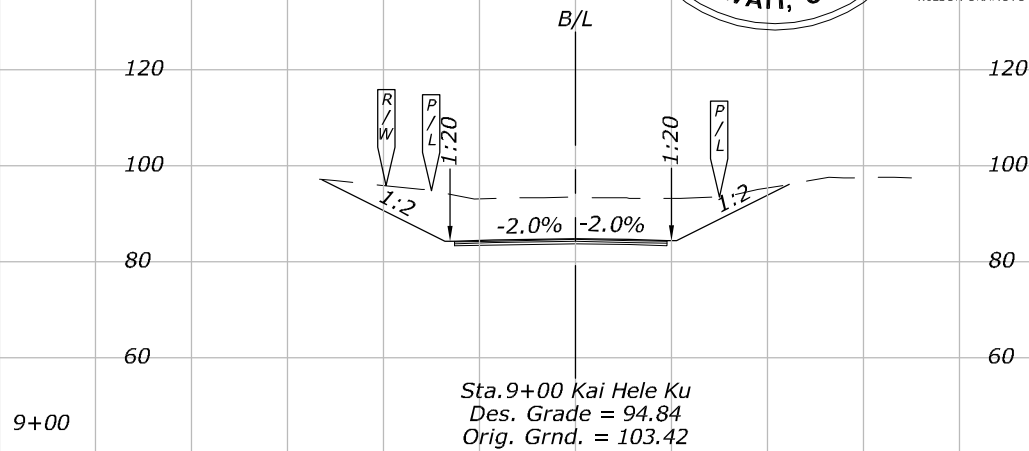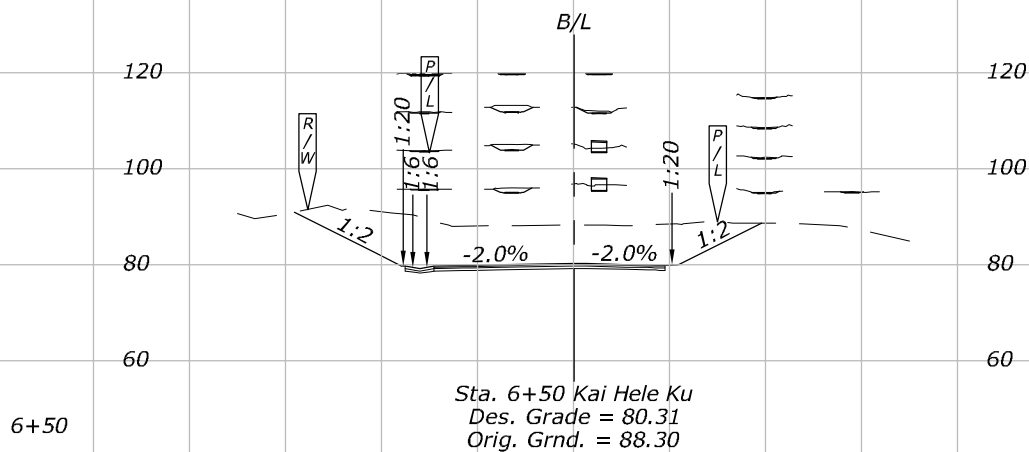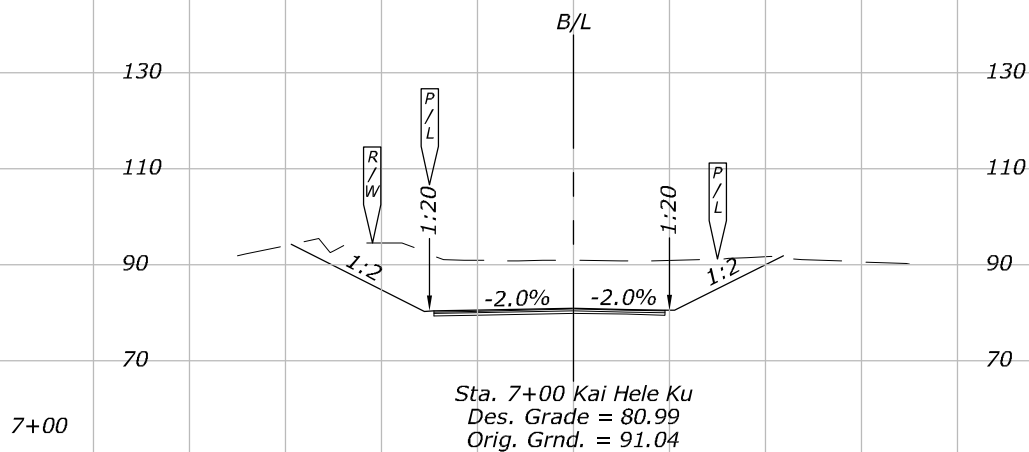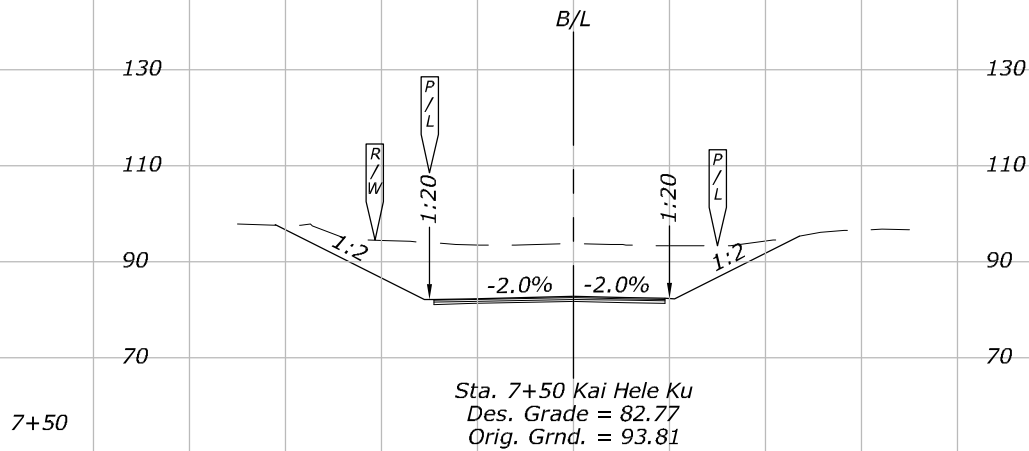

KAI HELE KU CROSS SECTIONS 6+50 TO 9+00

Patricia Choy

W:\10226-01\Civil\CADD\Site\DWGS\DRIVE - w\10226-01\Civil\CADD\Site\DWGS\Y12 Cross Sections.dwg


14:21:56

January 11, 2019

NOTES:



1. Elevations Shown on Roadway  
Sections are at 10'.

| STATE | PROJECT         | SHEET NO. |
|-------|-----------------|-----------|
| HI    | HI STP SR 30(1) | Y12       |

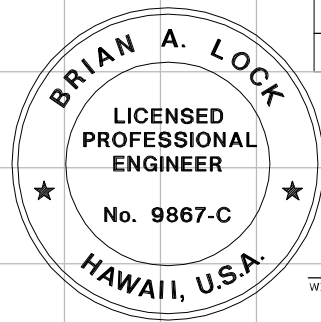

THIS WORK WAS PREPARED BY ME  
OR UNDER MY SUPERVISION.

WILSON OKAMOTO CORPORATION  
APRIL 30, 2020  
LIC. EXP. DATE

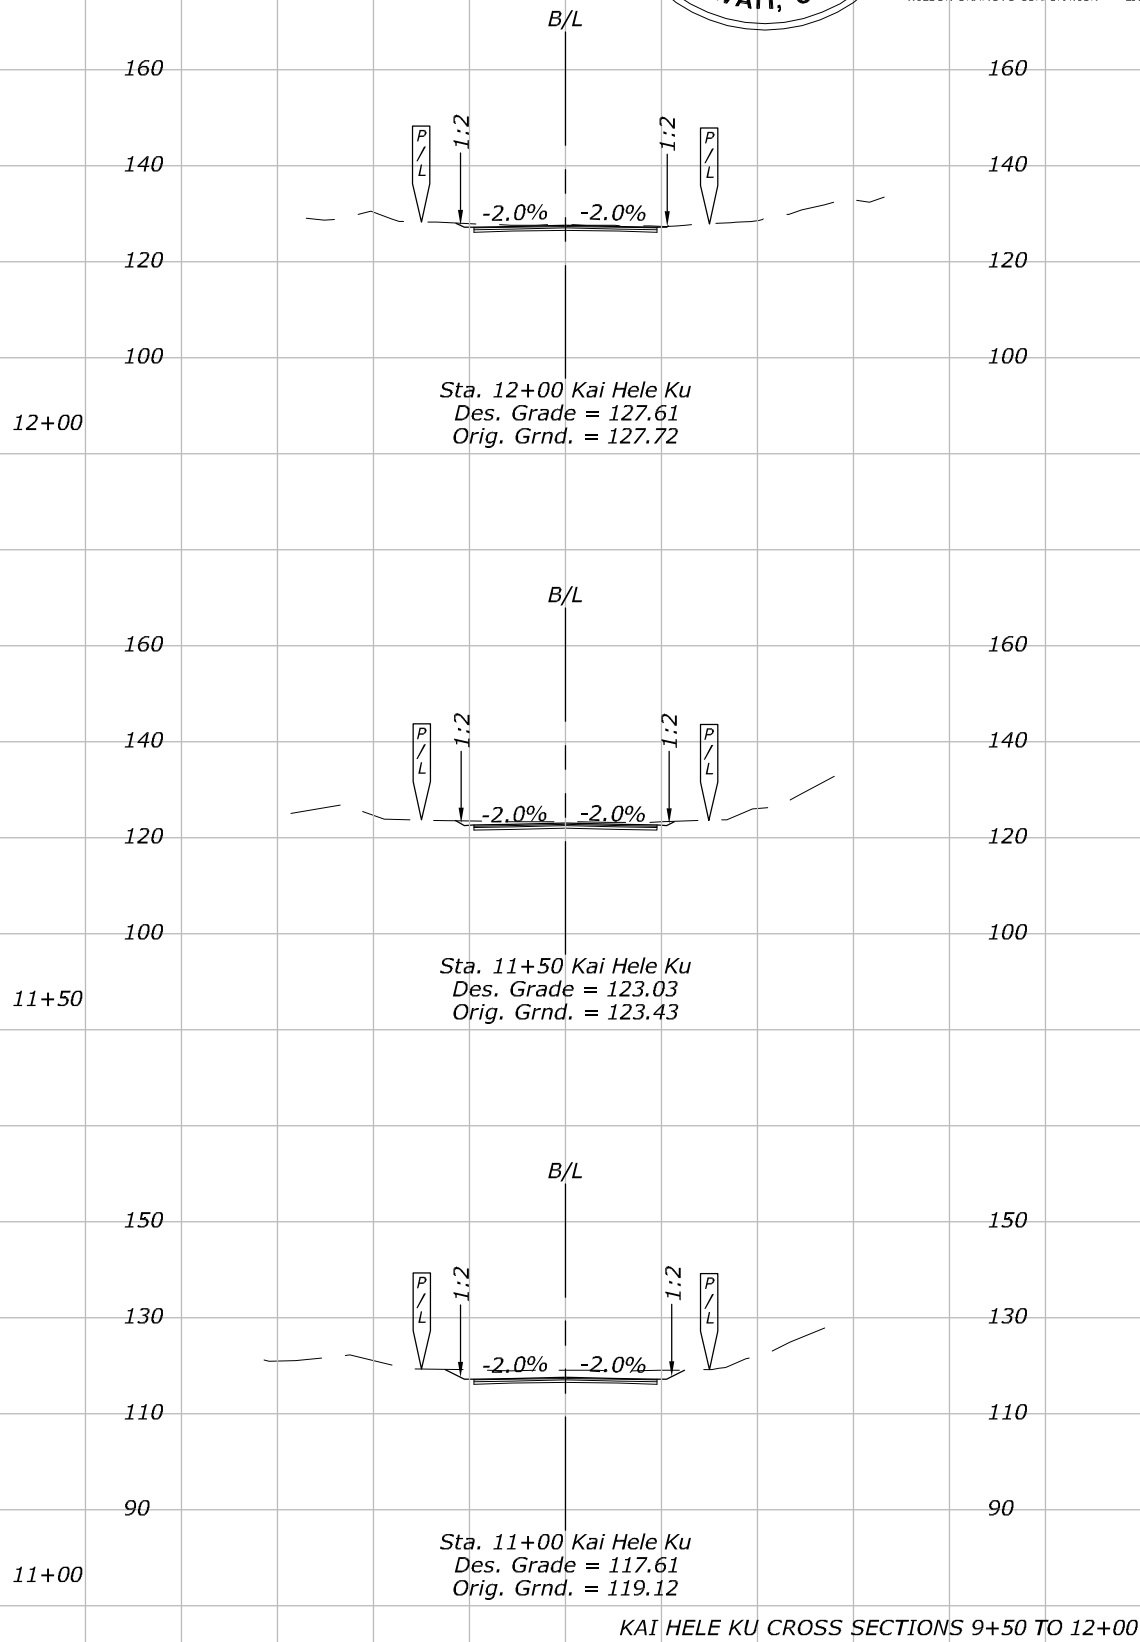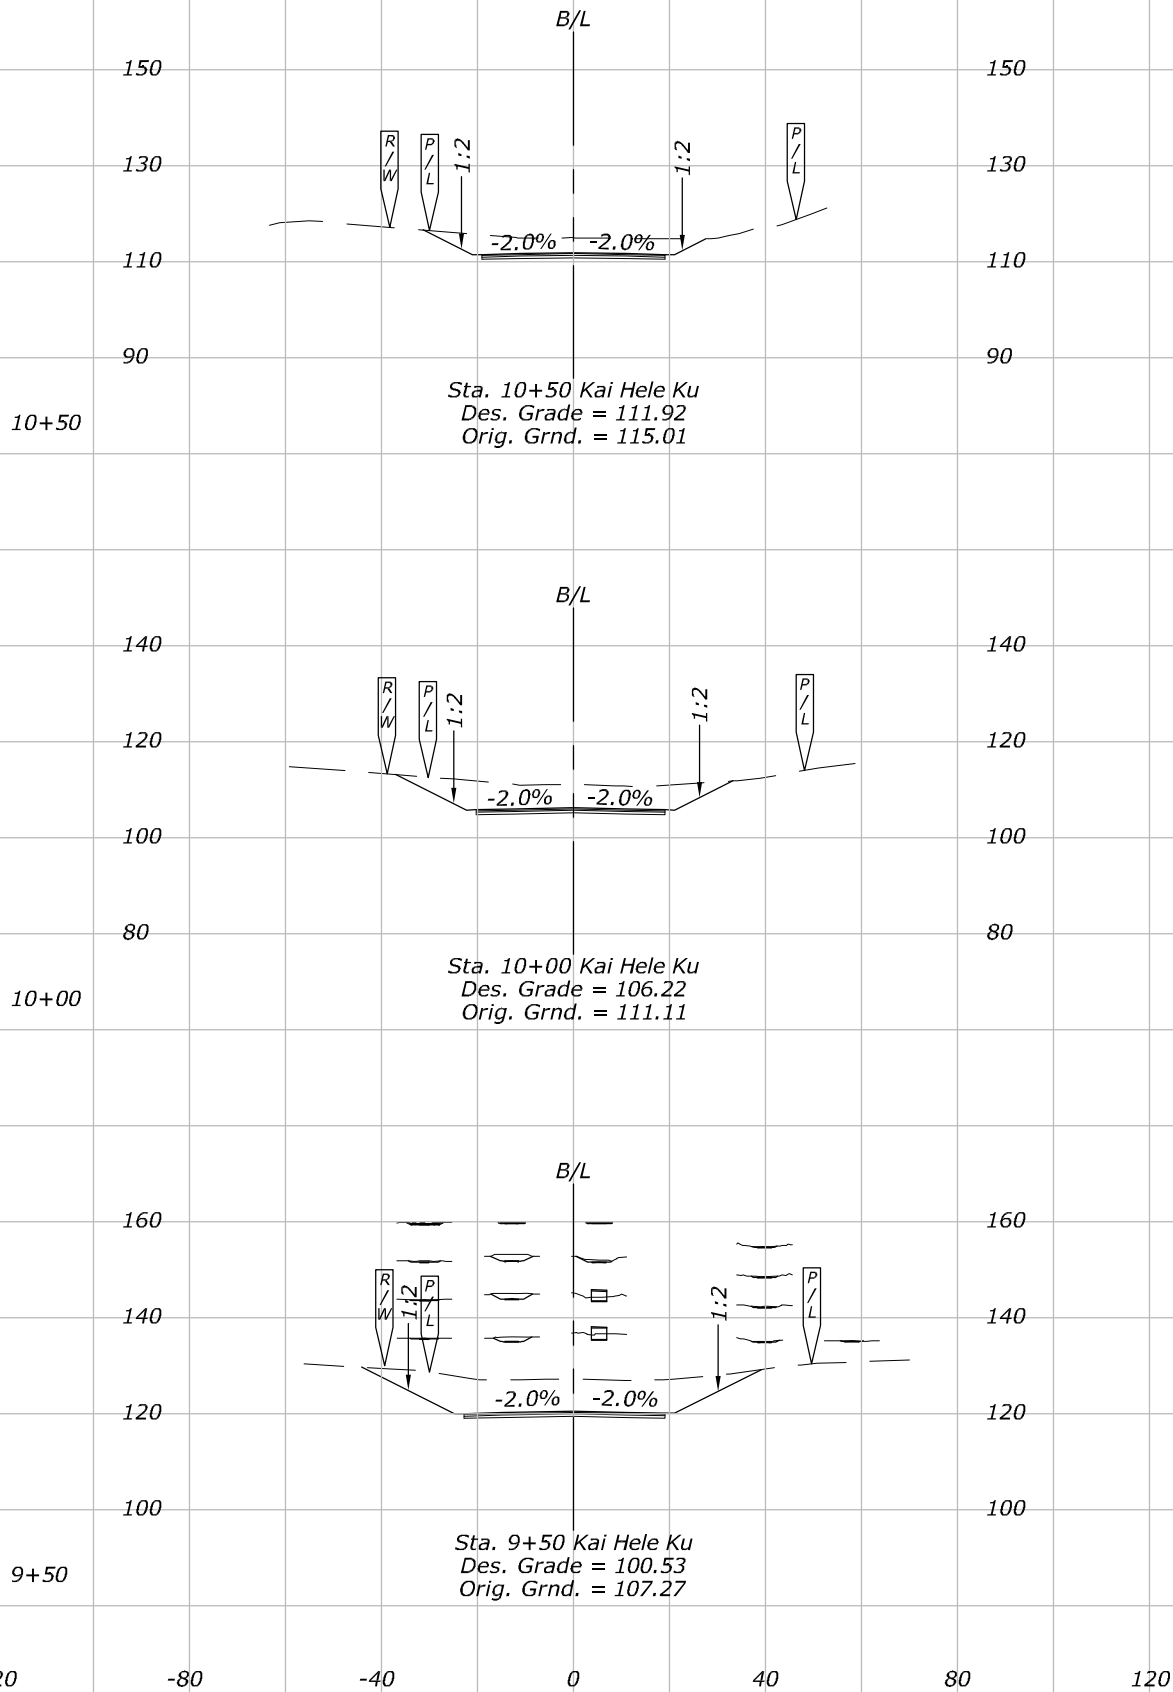

Patricia Choy

W:\10226-01\Civil\CADD\Site\DWGS\DRIVE - w\10226-01\Civil\CADD\Site\DWGS\Y13 Cross Sections.dwg


14:22:36

January 11, 2019



NOTES:

1. Elevations Shown on Roadway  
Sections are at 5'.

| STATE | PROJECT         | SHEET NO. |
|-------|-----------------|-----------|
| HI    | HI STP SR 30(1) | Y13       |

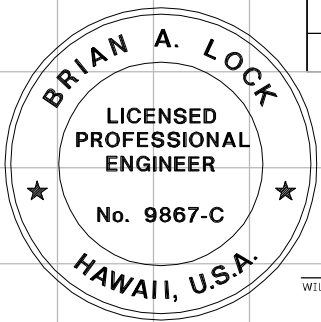

THIS WORK WAS PREPARED BY ME  
OR UNDER MY SUPERVISION.  
WILSON OKAMOTO CORPORATION  
APRIL 30, 2020  
LIC. EXP. DATE

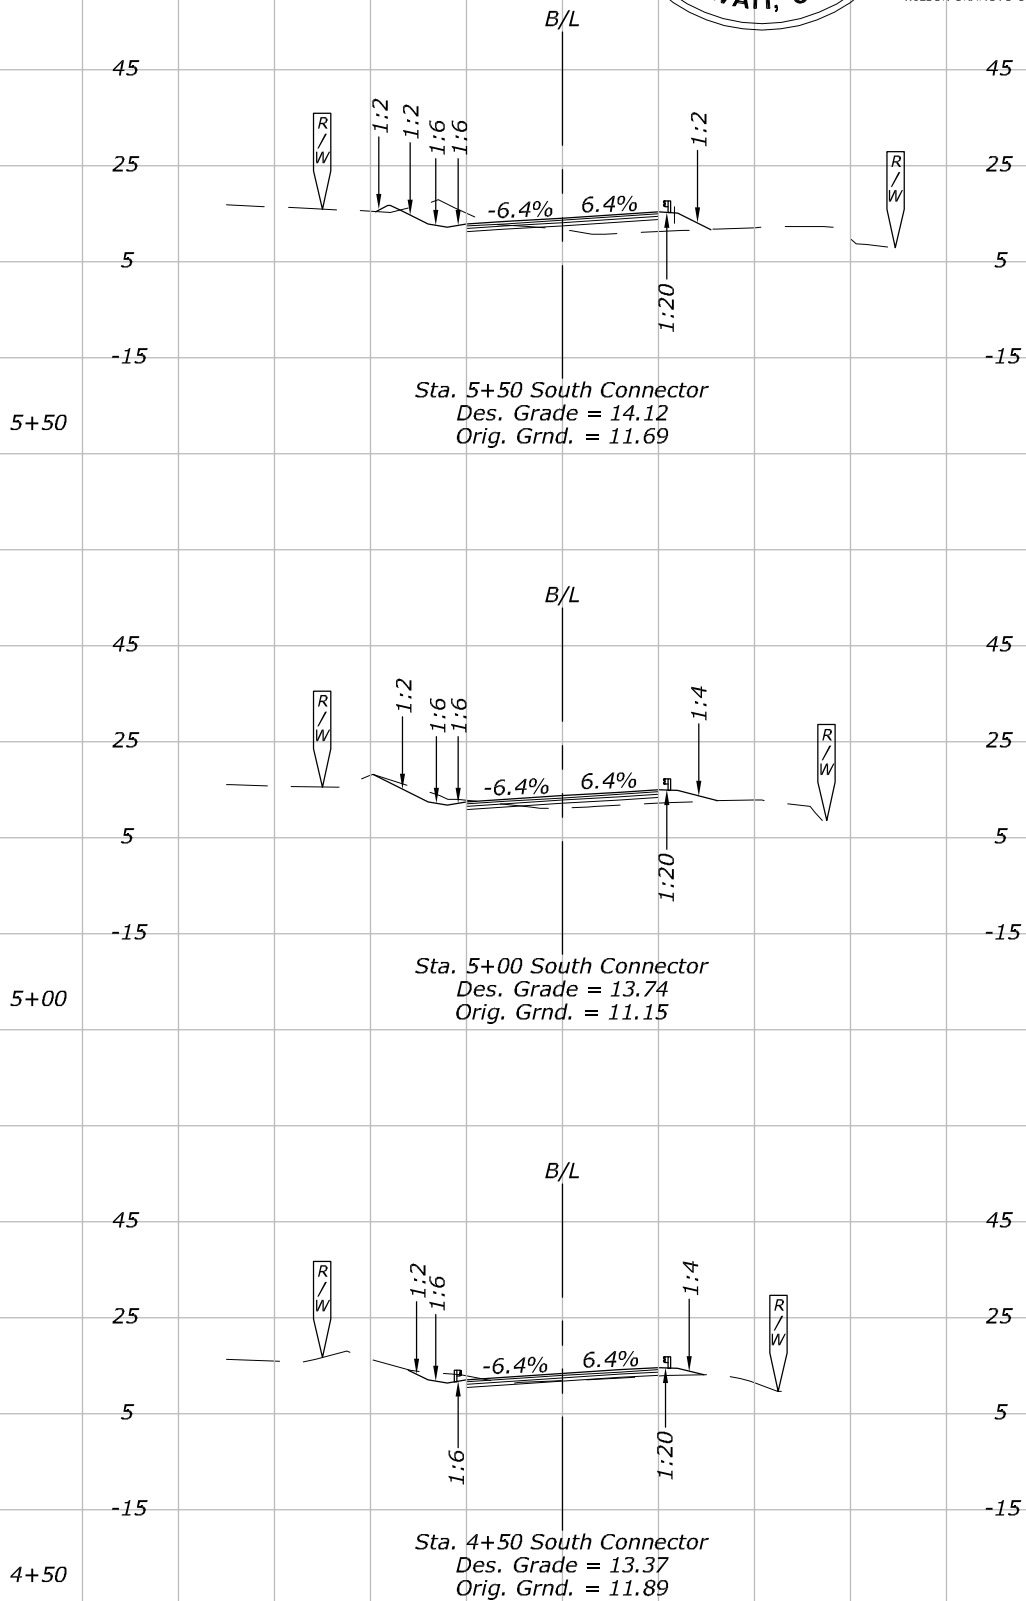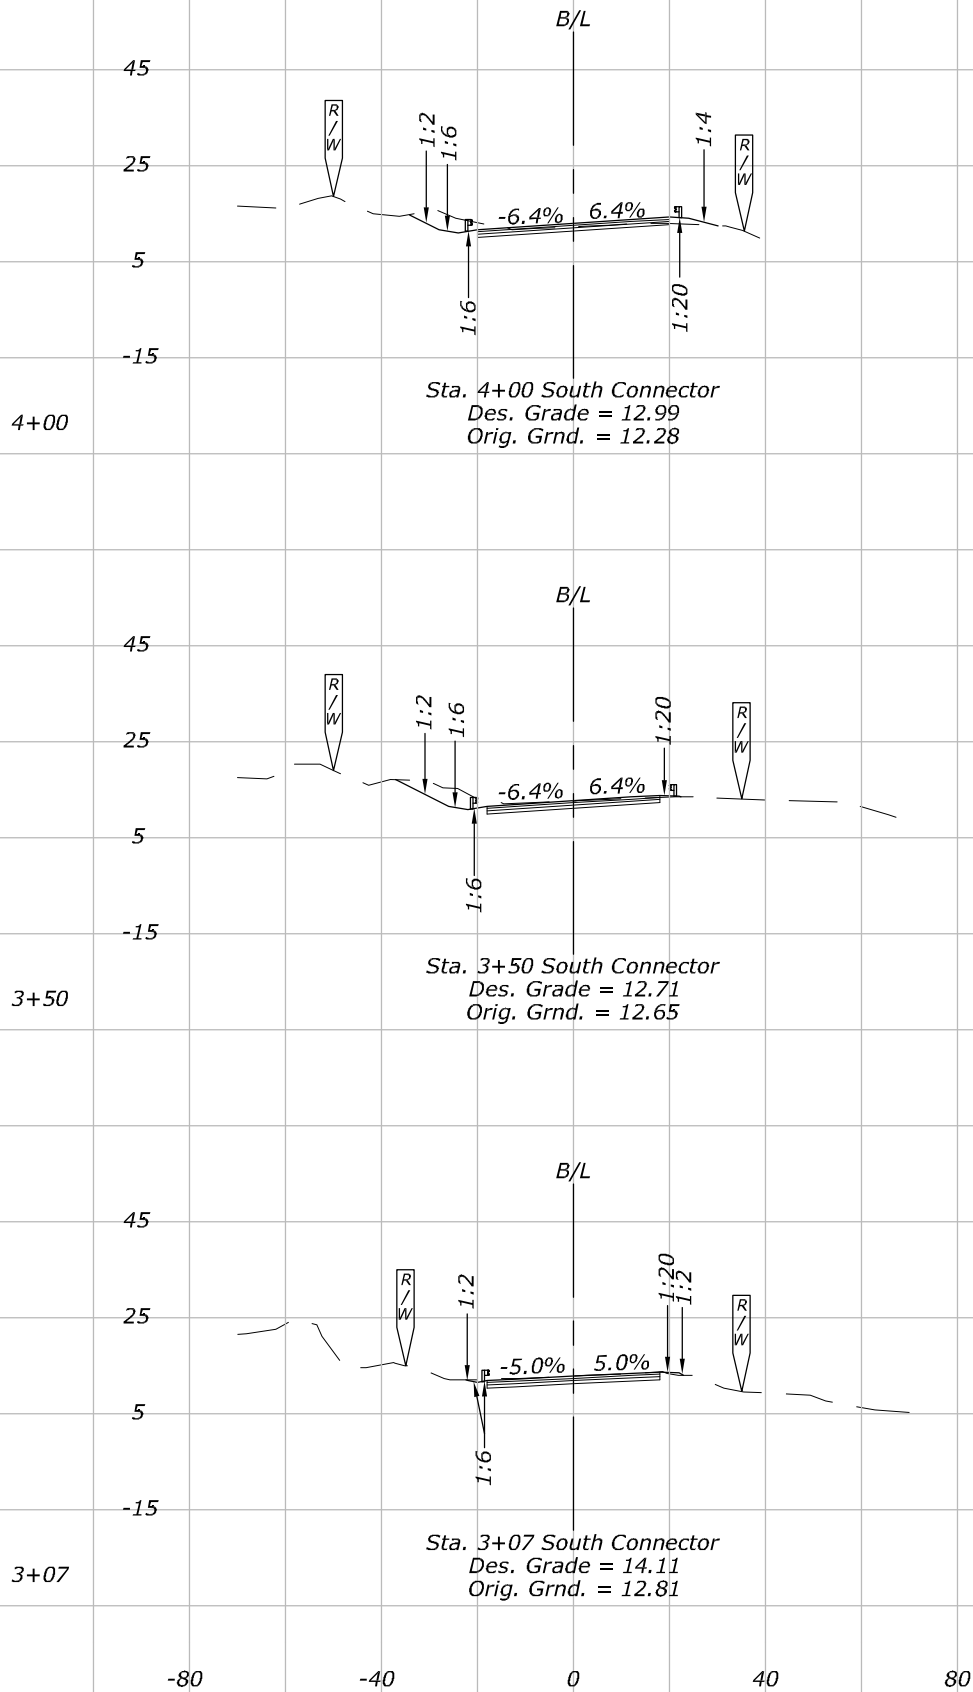

SOUTH CONNECTOR CROSS SECTIONS 3+00 TO 5+50

Patricia Choy

W:\10226-01\Civil\CADD\Site\AS-BUILT\DWGS\DRIVE - w\10226-01\Civil\CADD\Site\DWGS\Y14 Cross Sections.dwg


14:23:10

January 11, 2019

NOTES:



1. Elevations Shown on Roadway  
Sections are at 5'.

| STATE | PROJECT         | SHEET NO. |
|-------|-----------------|-----------|
| HI    | HI STP SR 30(1) | Y14       |

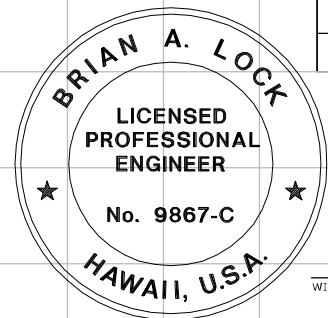

THIS WORK WAS PREPARED BY ME  
OR UNDER MY SUPERVISION.

WILSON OKAMOTO CORPORATION  
APRIL 30, 2020  
LIC. EXP. DATE

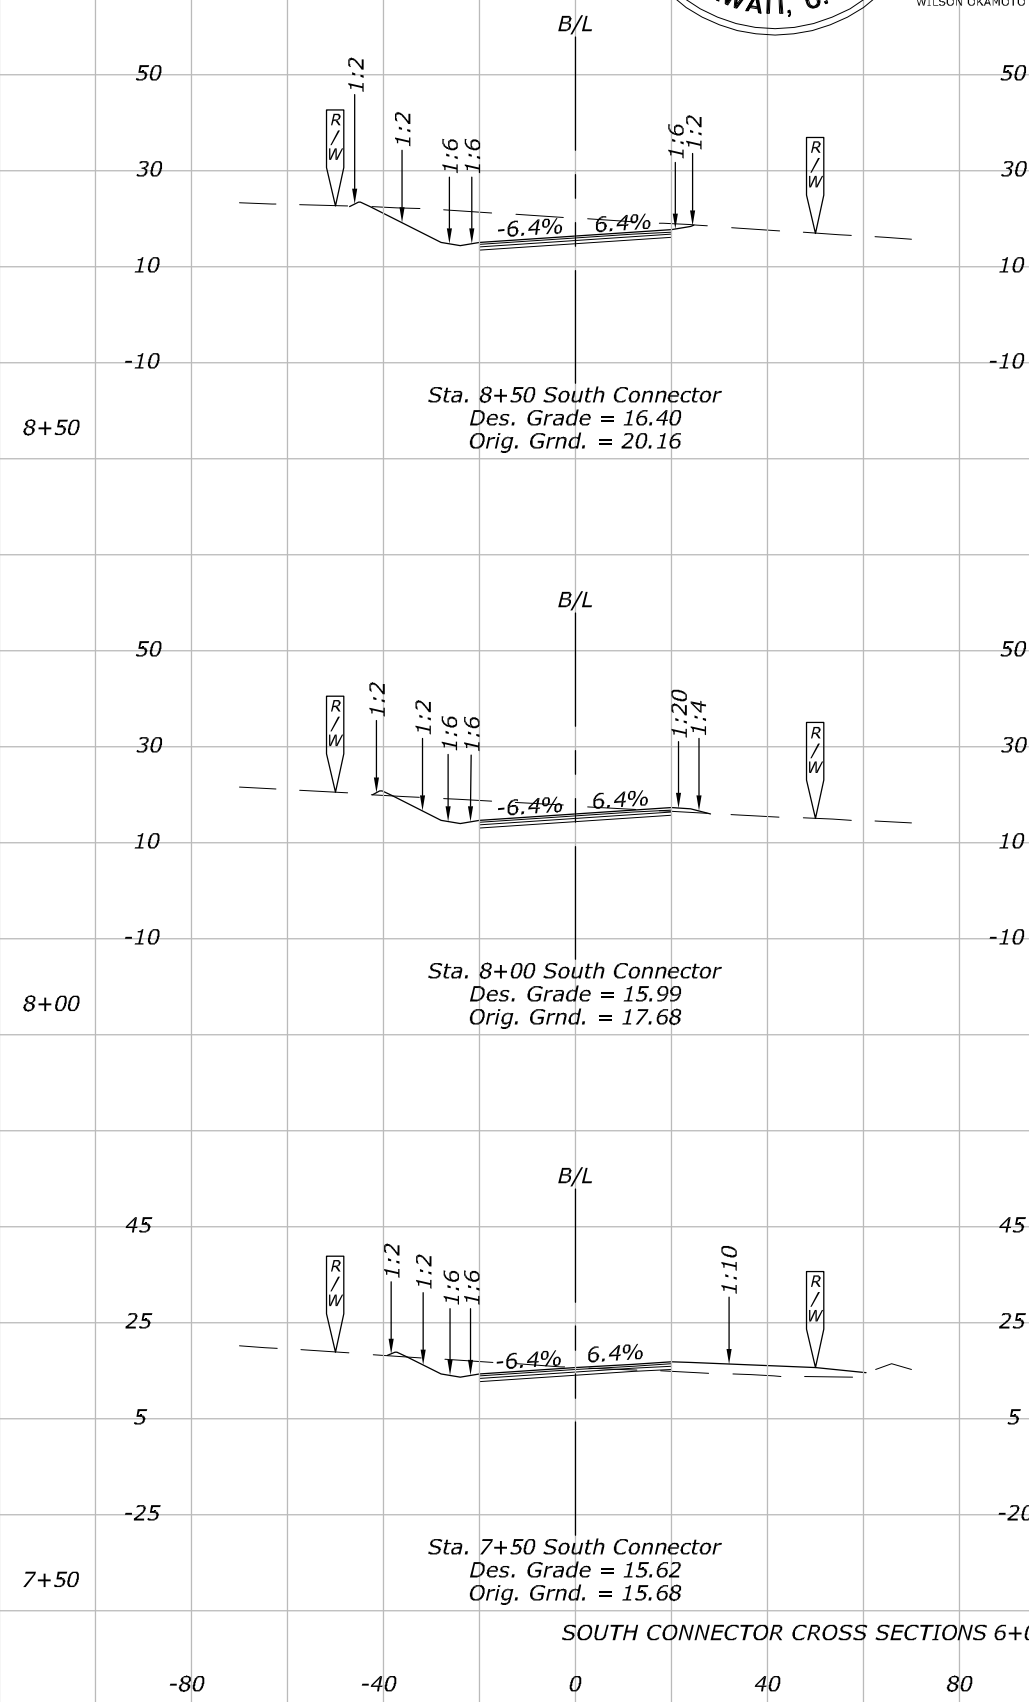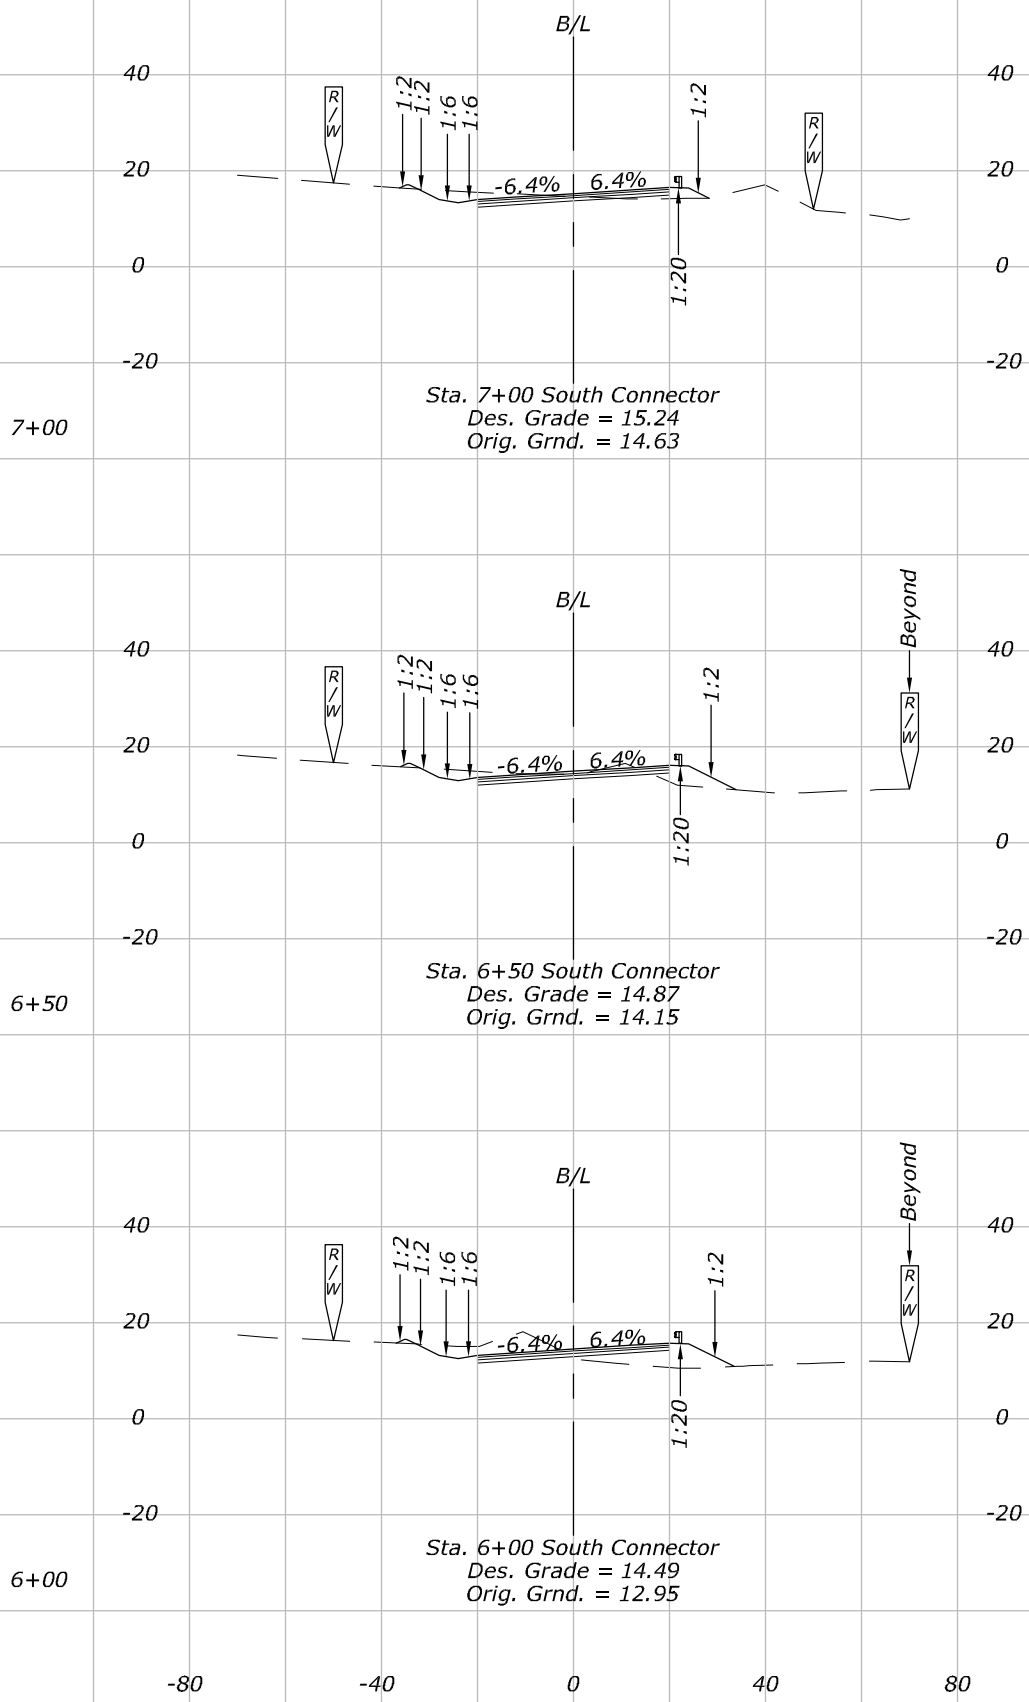

SOUTH CONNECTOR CROSS SECTIONS 6+00 TO 8+50

Patricia Choy

W:\102226-01\Civil\CADD\Site\DWGS\DRIVE\_w\102226-01\Civil\CADD\Site\DWGS\Y15 Cross Sections.dwg


14:23:52

January 11, 2019



NOTES:

1. Elevations Shown on Roadway  
Sections are at 5'.

| STATE | PROJECT         | SHEET NO. |
|-------|-----------------|-----------|
| HI    | HI STP SR 30(1) | Y15       |

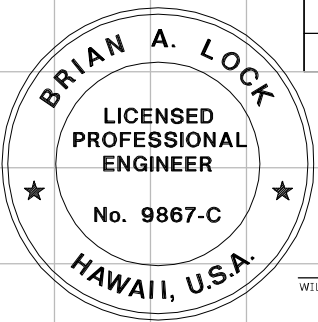

THIS WORK WAS PREPARED BY ME  
OR UNDER MY SUPERVISION.  
WILSON OKAMOTO CORPORATION  
APRIL 30, 2020  
LIC. EXP. DATE

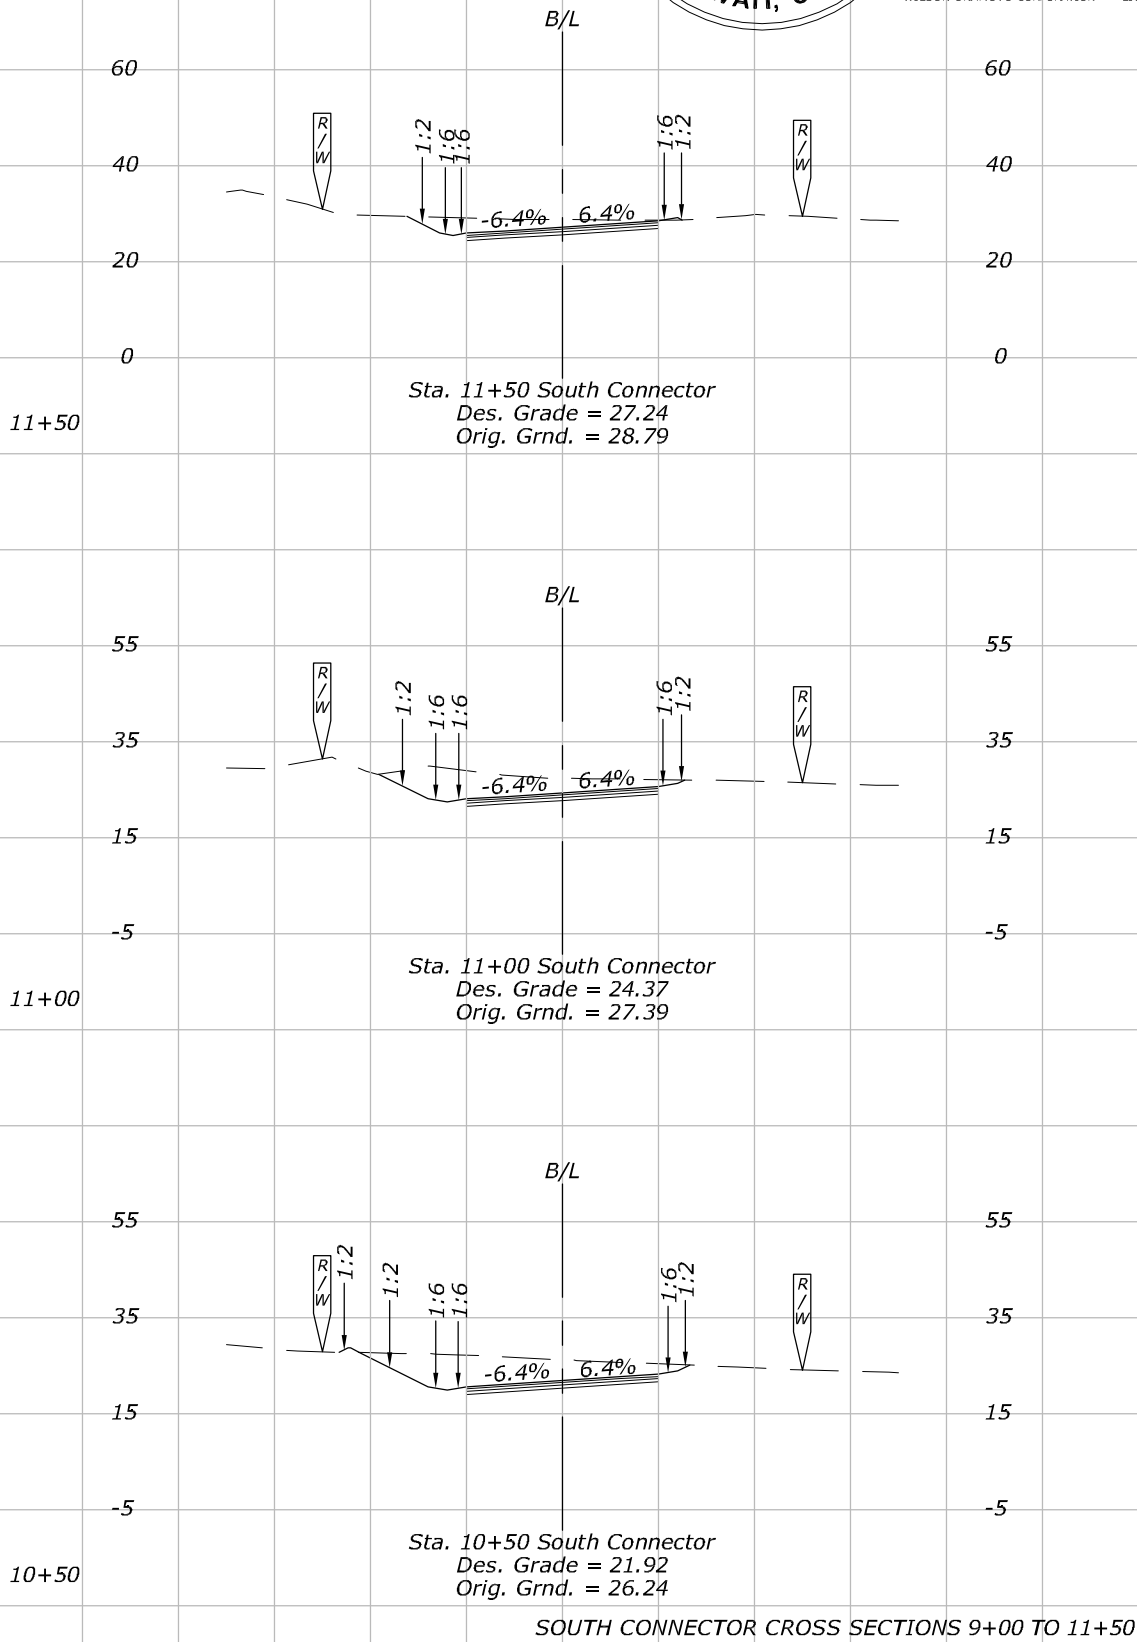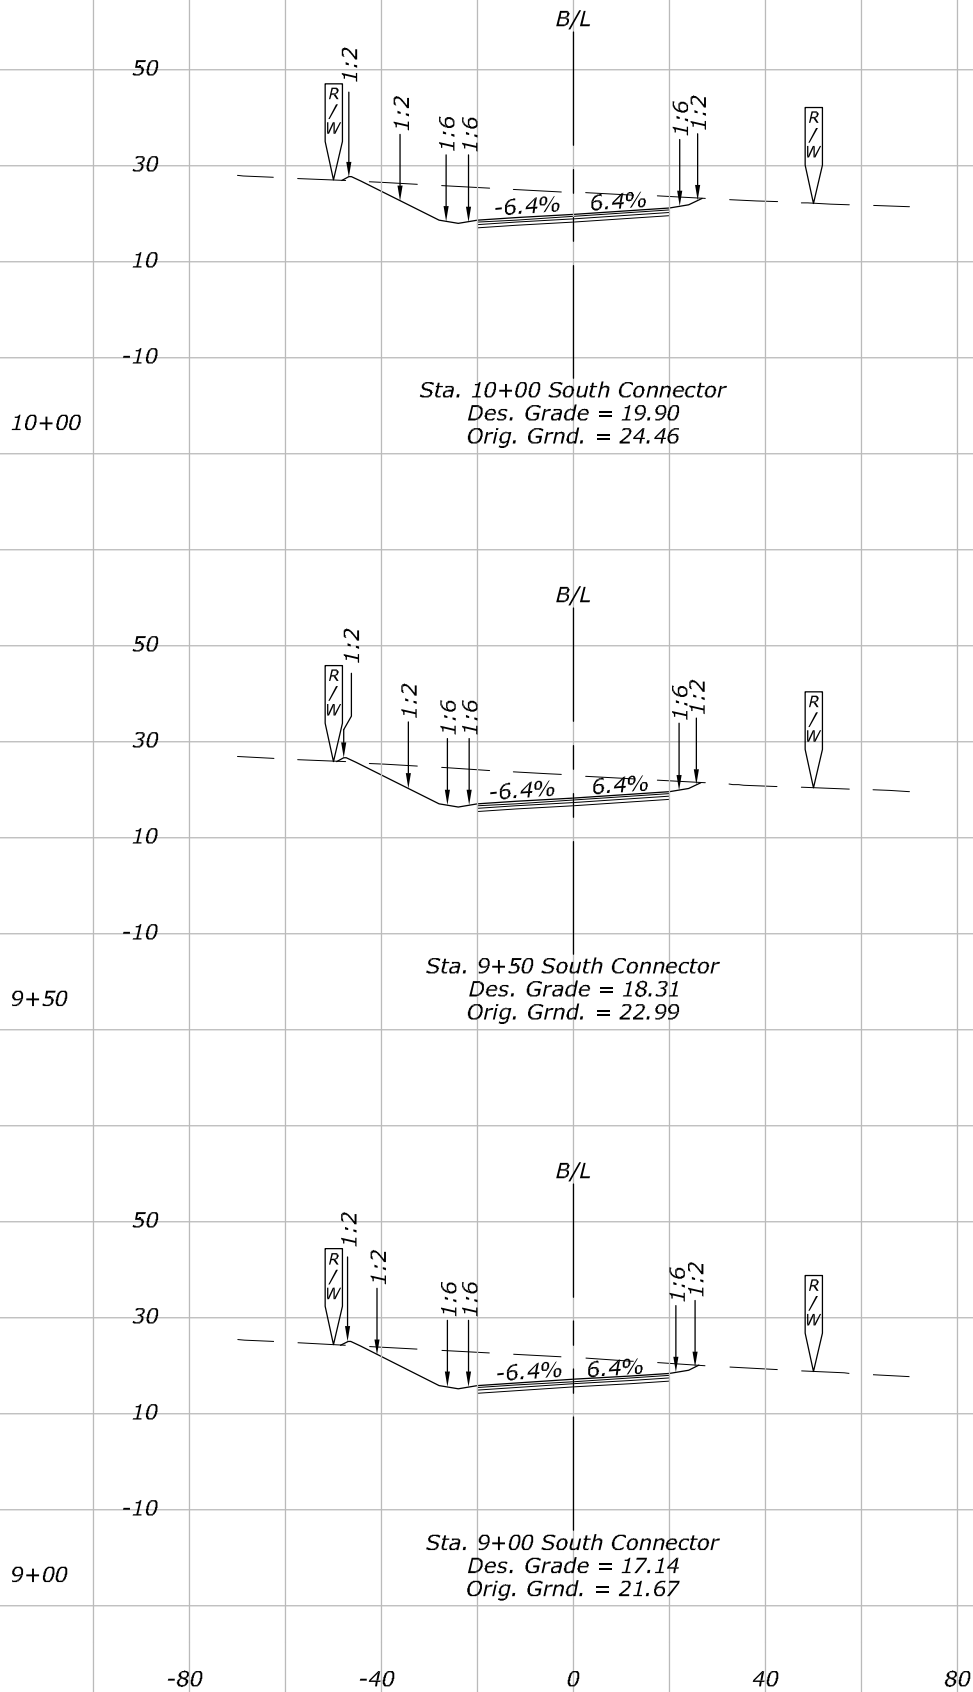

Patricia Choy

W:\10226-01\Civil\CADD\Site\AS-BUILT\DWGS\DRIVE\_w\10226-01\Civil\CADD\Site\DWGS\Y16 Cross Sections.dwg


14:24:39

January 11, 2019



NOTES:

1. Elevations Shown on Roadway  
Sections are at 5'.

| STATE | PROJECT         | SHEET NO. |
|-------|-----------------|-----------|
| HI    | HI STP SR 30(1) | Y16       |

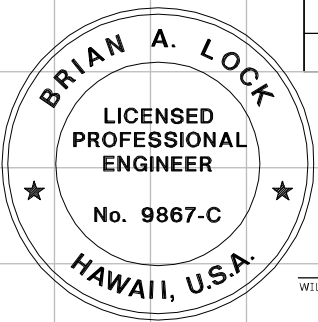

THIS WORK WAS PREPARED BY ME  
OR UNDER MY SUPERVISION.  
WILSON OKAMOTO CORPORATION  
APRIL 30, 2020  
LIC. EXP. DATE

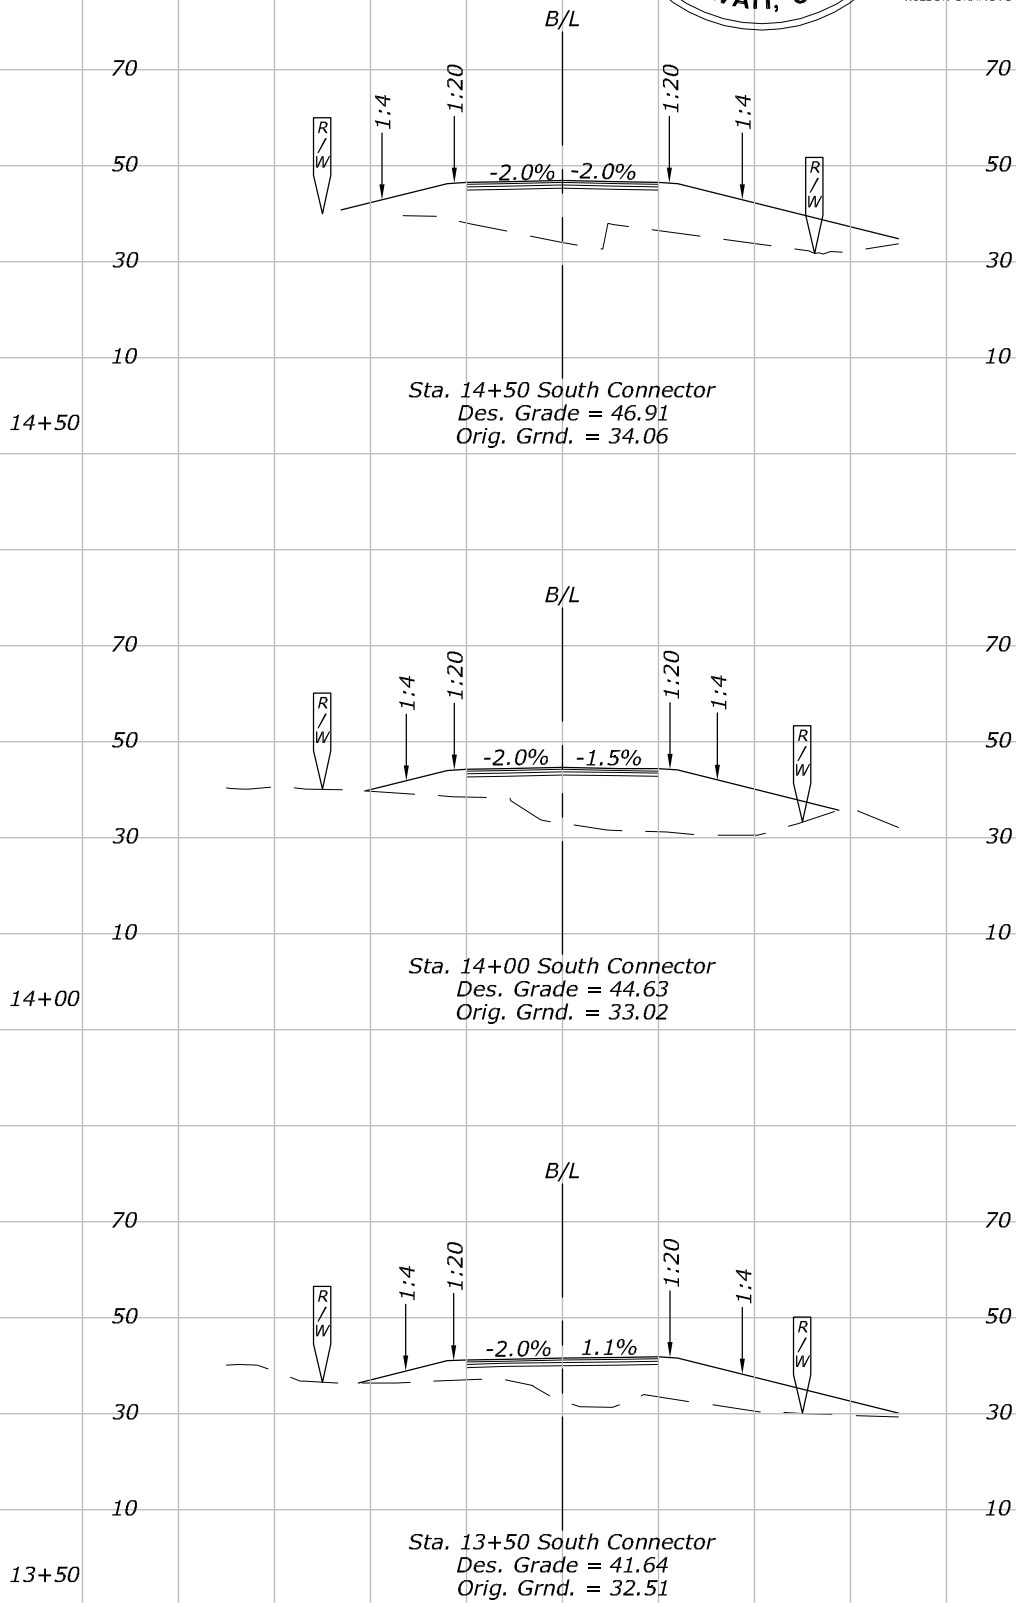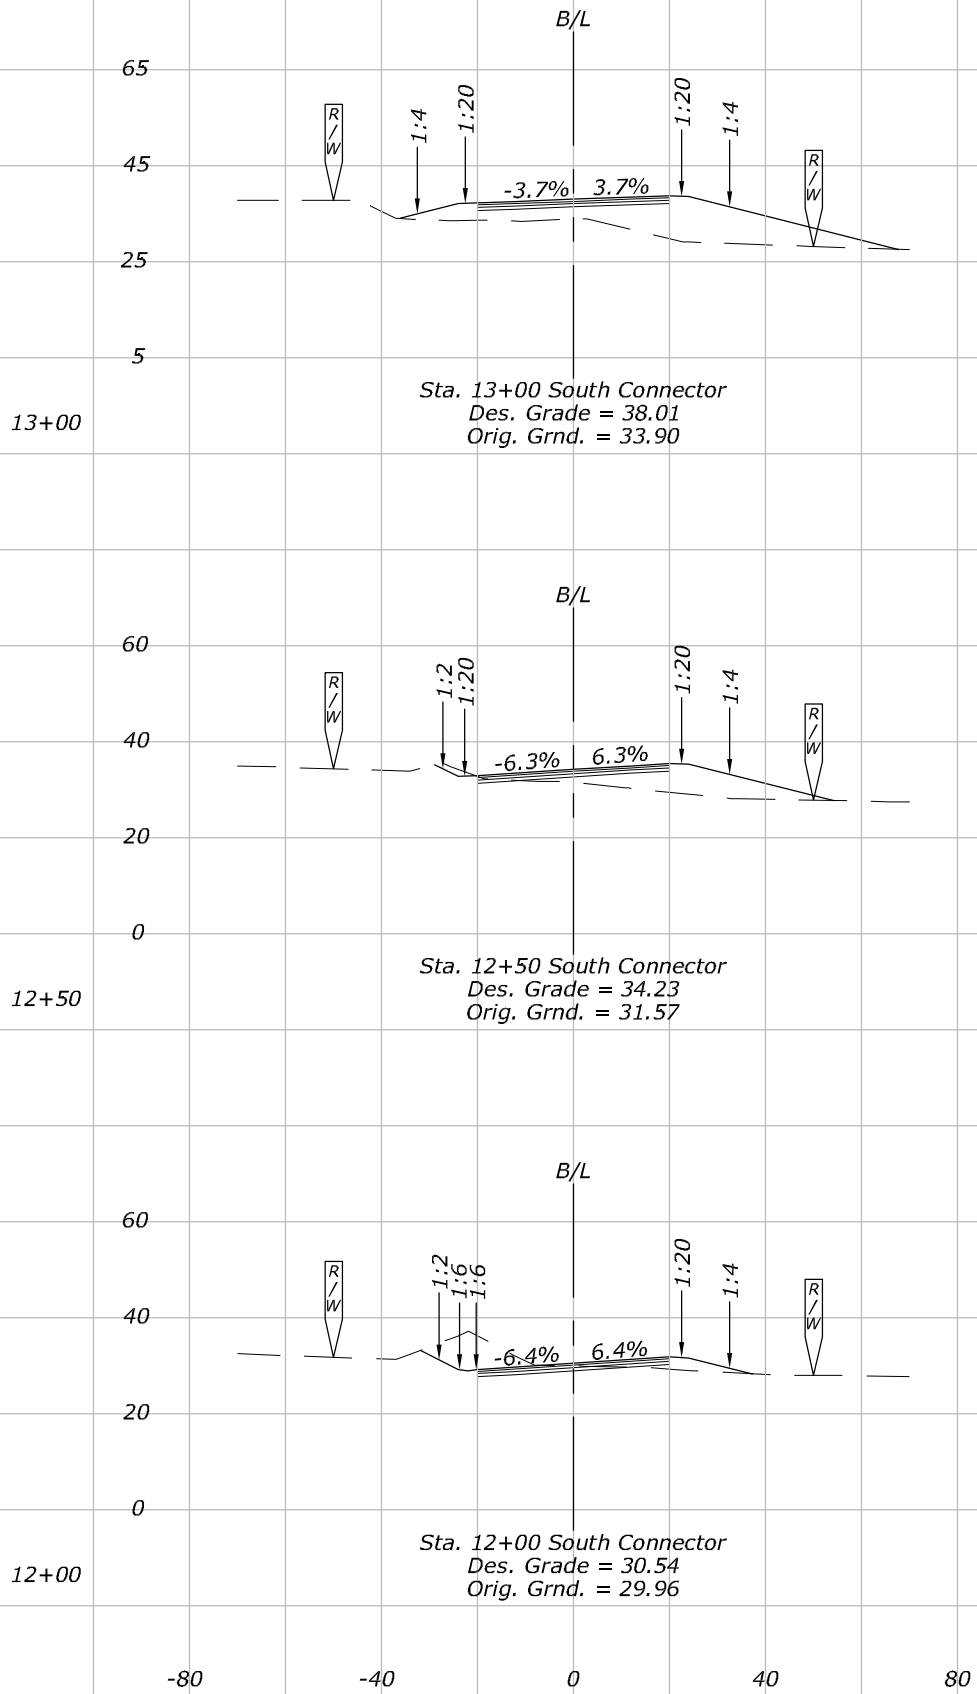

SOUTH CONNECTOR CROSS SECTIONS 12+00 TO 14+50

Patricia Choy

W:\10226-01\Civil\CADD\Site\AS-BUILT\DWGS\DRIVE\_w\10226-01\Civil\CADD\Site\DWGS\Y17 Cross Sections.dwg


14:25:08

January 11, 2019

NOTES:


1. Elevations Shown on Roadway  
Sections are at 10'.

| STATE | PROJECT         | SHEET NO. |
|-------|-----------------|-----------|
| HI    | HI STP SR 30(1) | Y17       |

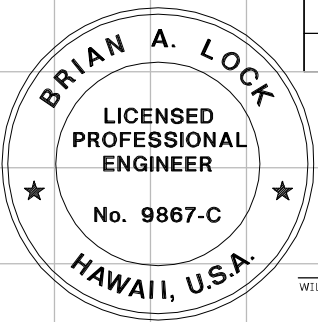

THIS WORK WAS PREPARED BY ME  
OR UNDER MY SUPERVISION.

WILSON OKAMOTO CORPORATION      APRIL 30, 2020  
LIC. EXP. DATE

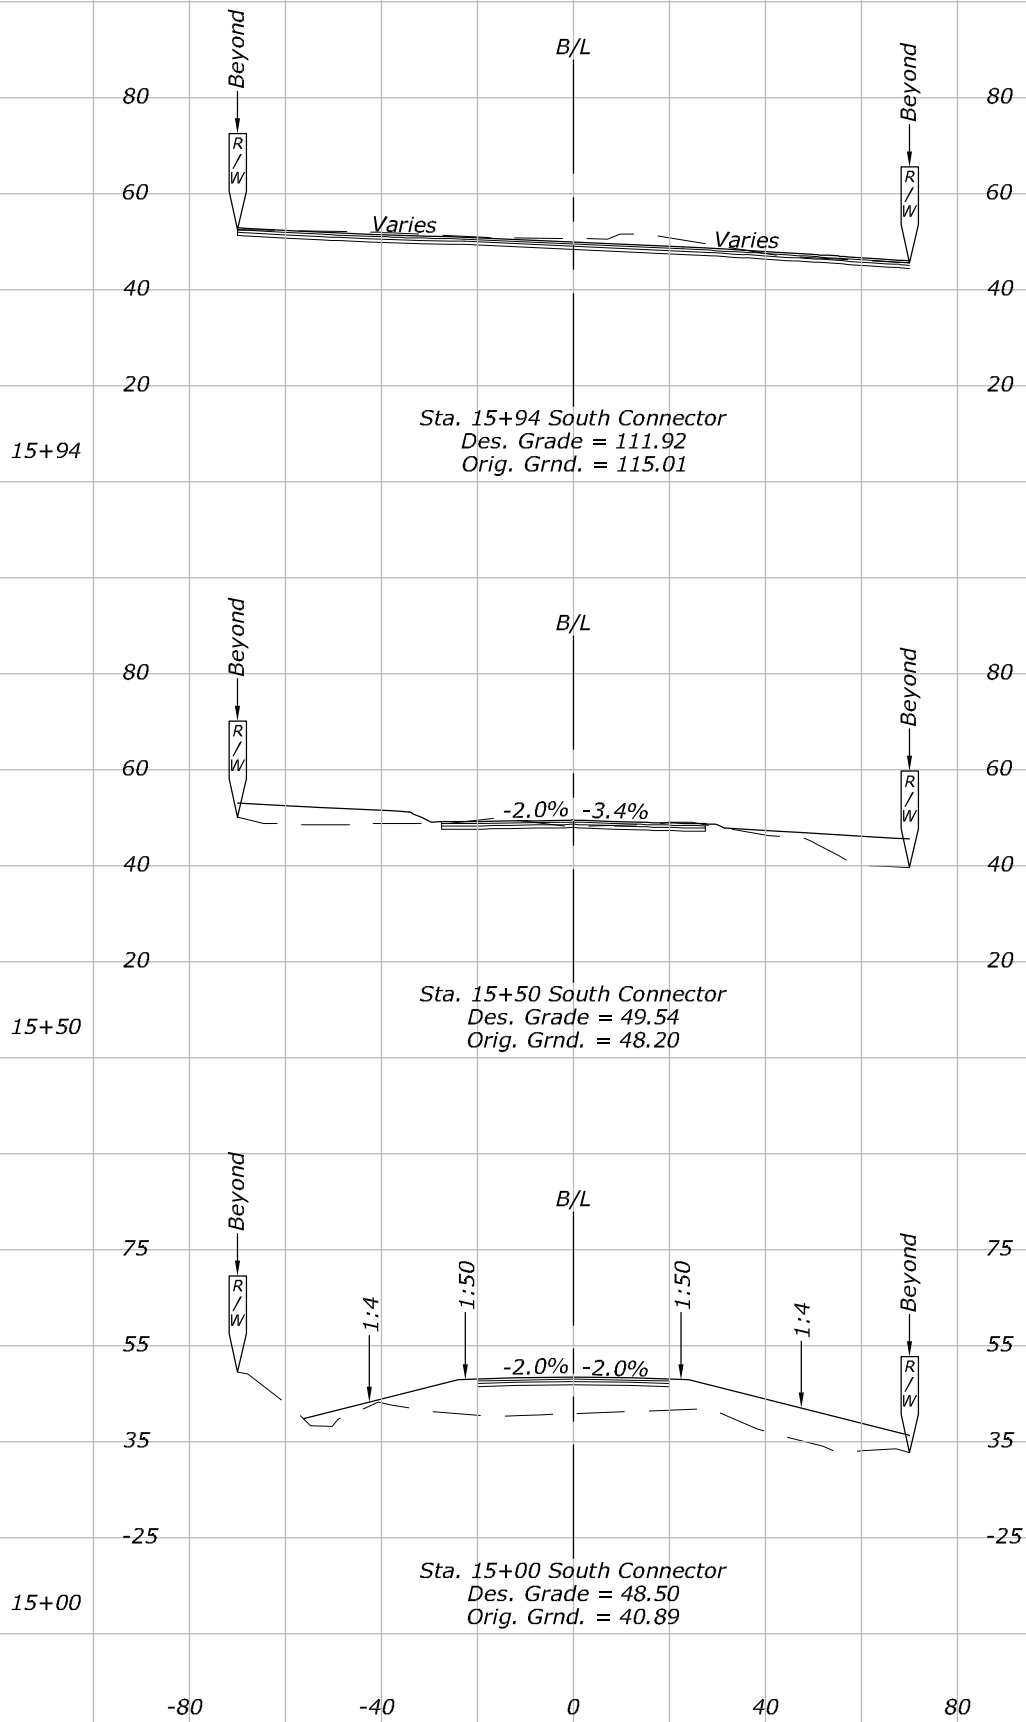

SOUTH CONNECTOR CROSS SECTIONS 15+00 TO 15+94