

Patricia Choy

W:\102226-01\Civil\CADD\Site\DWGS\X1 Cross Sections.dwg


12:58:43

January 11, 2019

NOTES:


1. Elevations Shown on Roadway
Sections are at 5'.

STATE	PROJECT	SHEET NO.
HI	HI STP SR 30(1)	X1

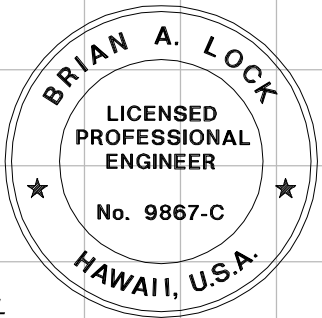

THIS WORK WAS PREPARED BY ME
OR UNDER MY SUPERVISION.

WILSON OKAMOTO CORPORATION
APRIL 30, 2020
LIC. EXP. DATE

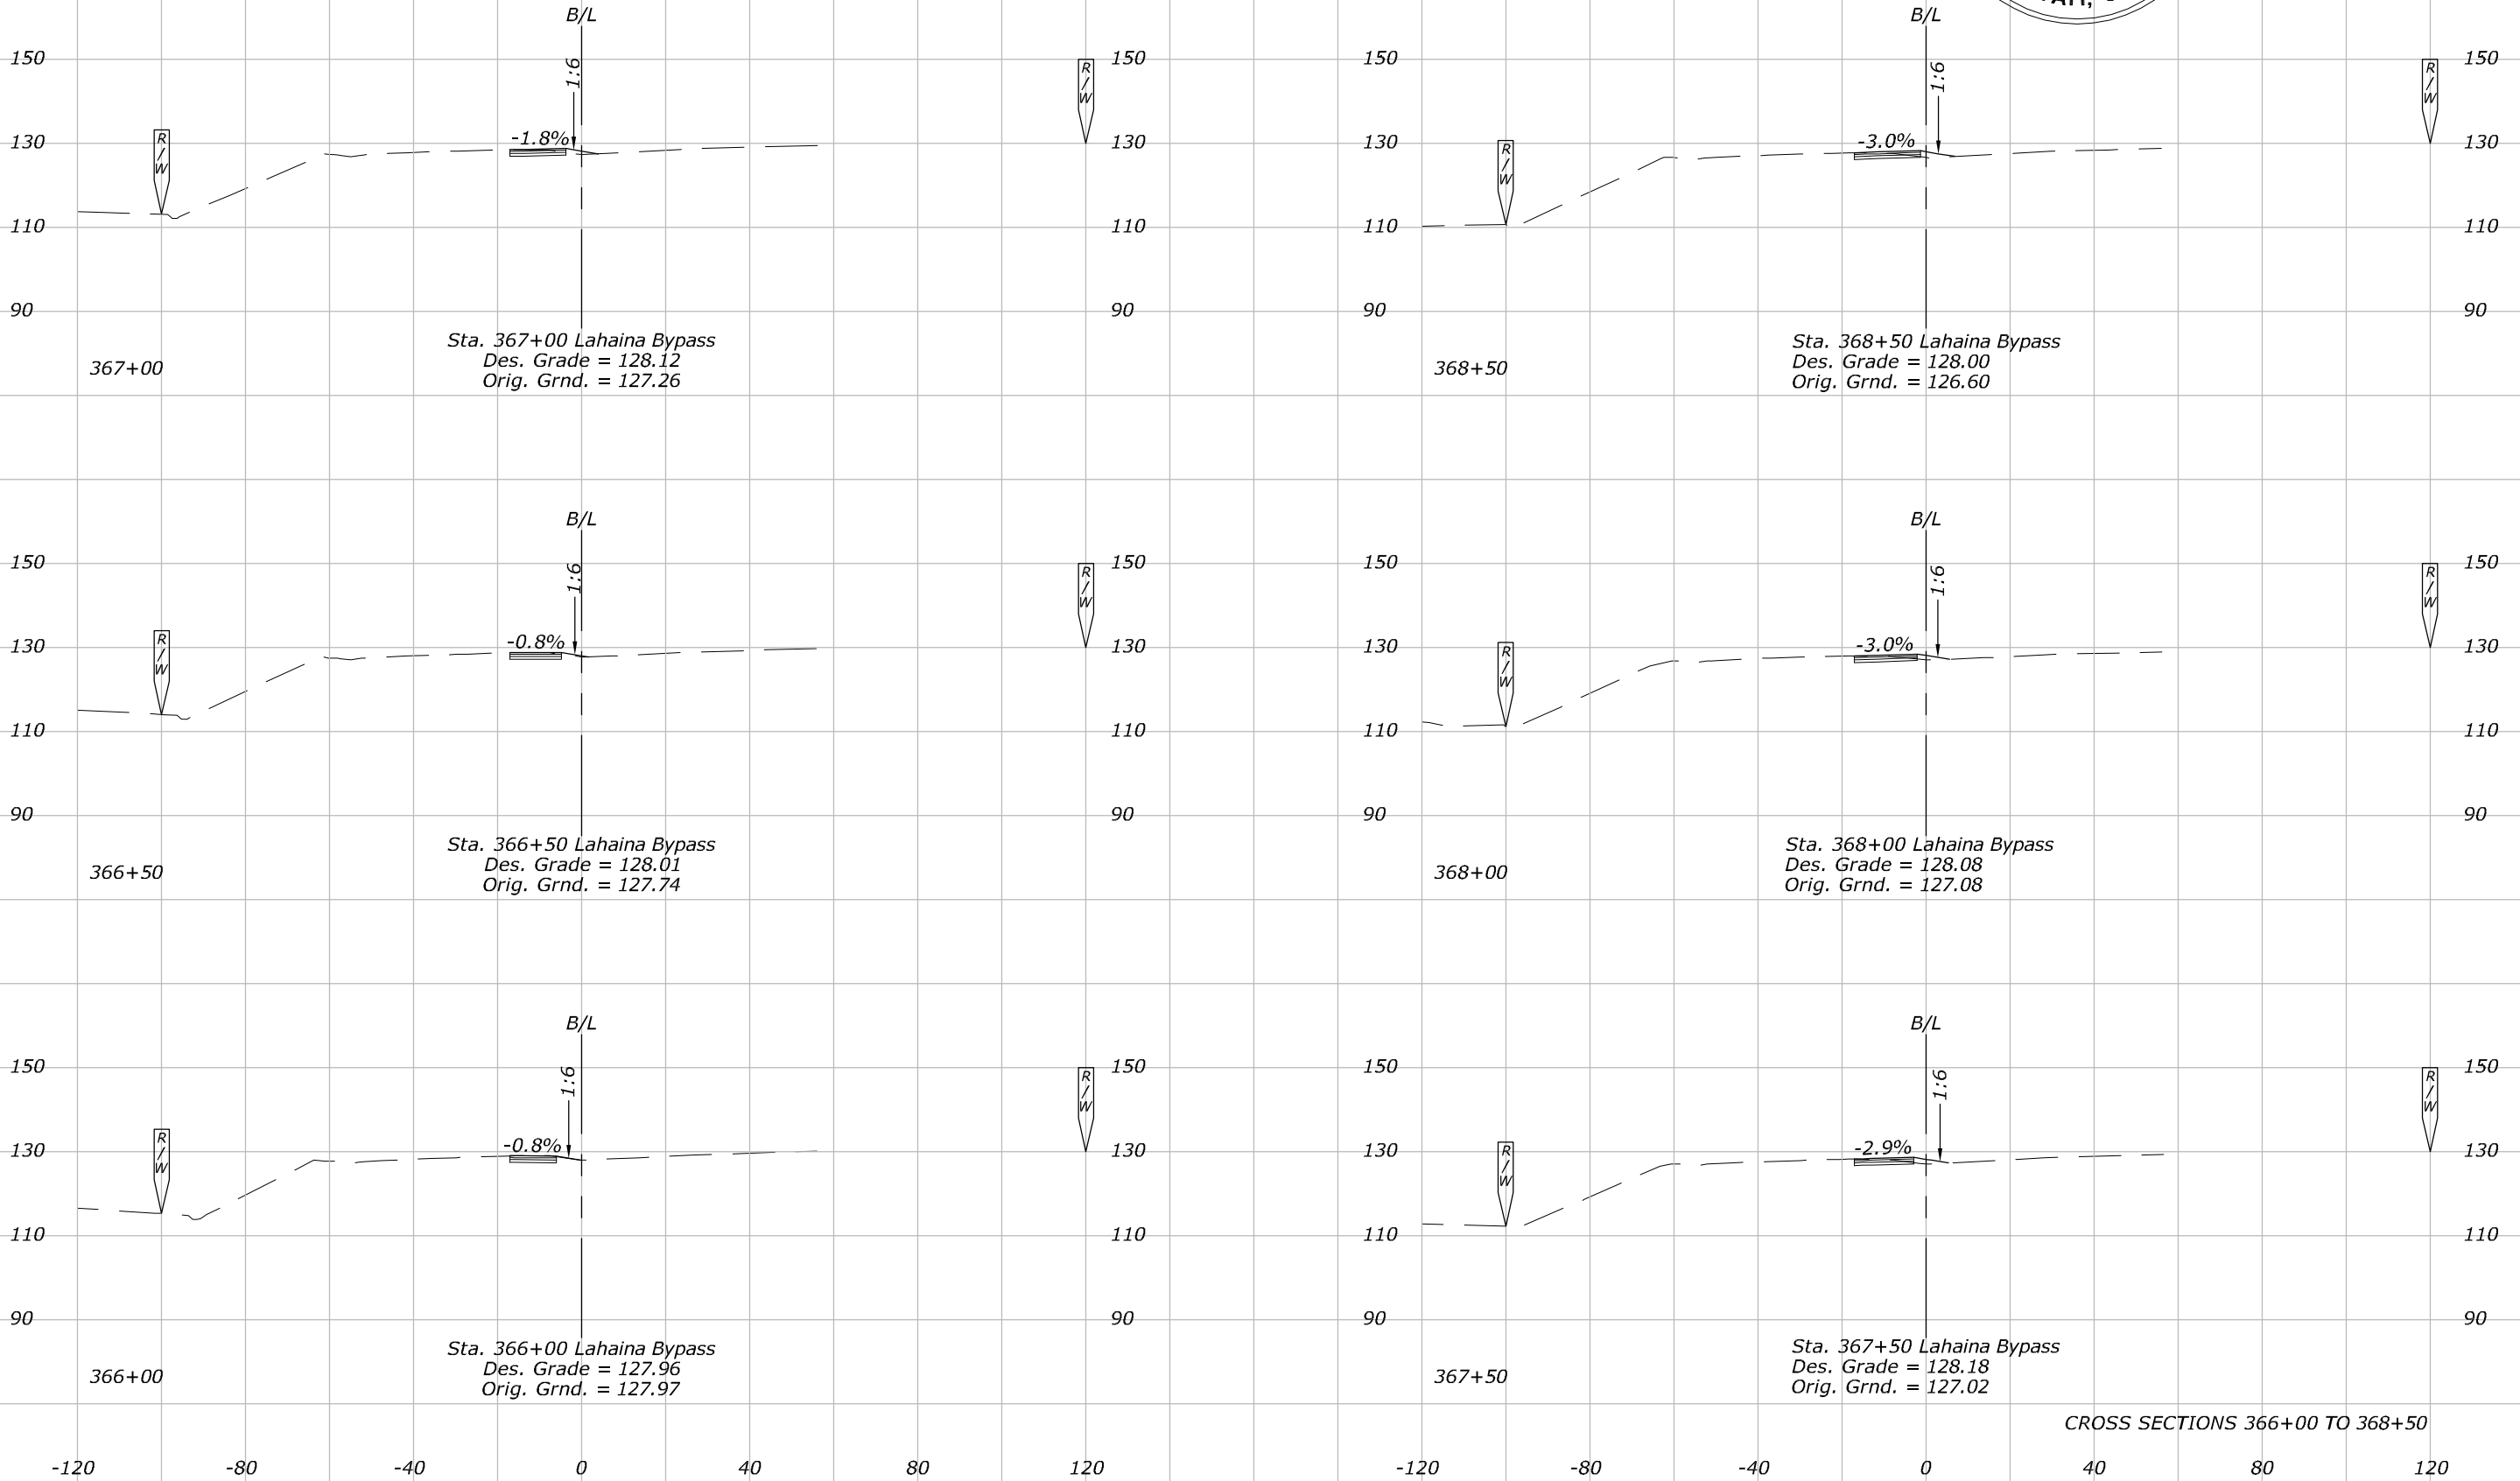

CROSS SECTIONS 366+00 TO 368+50

Patricia Choy

W:\10226-01\Civil\CADD\Site\DWGS\X2 Cross Sections.dwg


12:58:28

January 11, 2019

NOTES:







1. Elevations Shown on Roadway
Sections are at 10'.

STATE	PROJECT	SHEET NO.
HI	HI STP SR 30(1)	X2

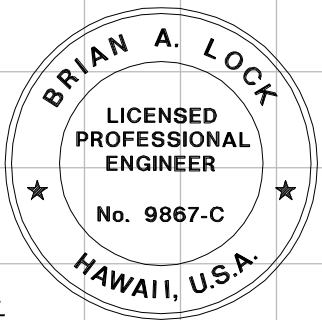

THIS WORK WAS PREPARED BY ME
OR UNDER MY SUPERVISION.

WILSON OKAMOTO CORPORATION
APRIL 30, 2020
LIC. EXP. DATE

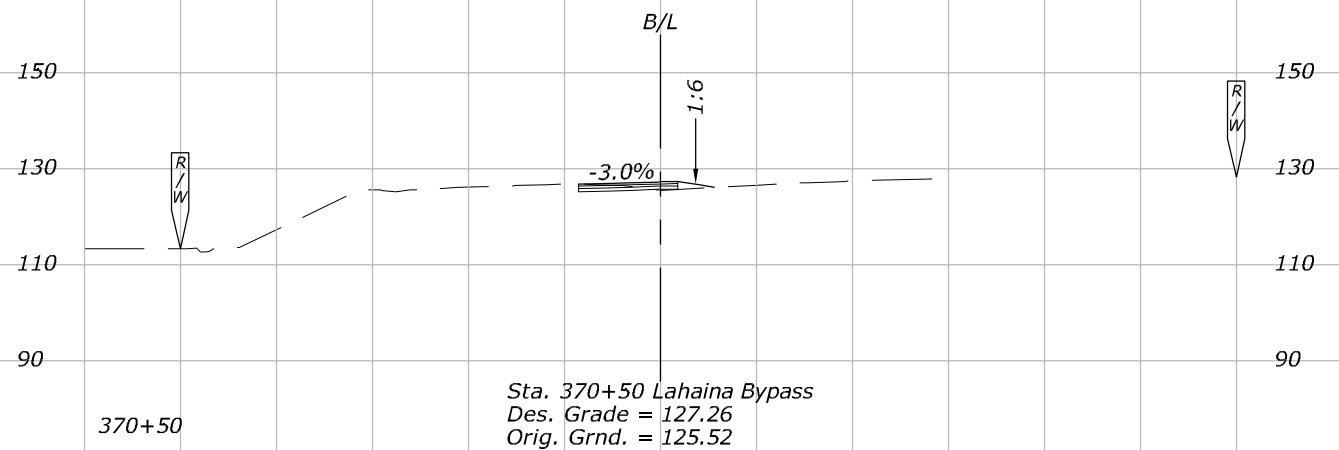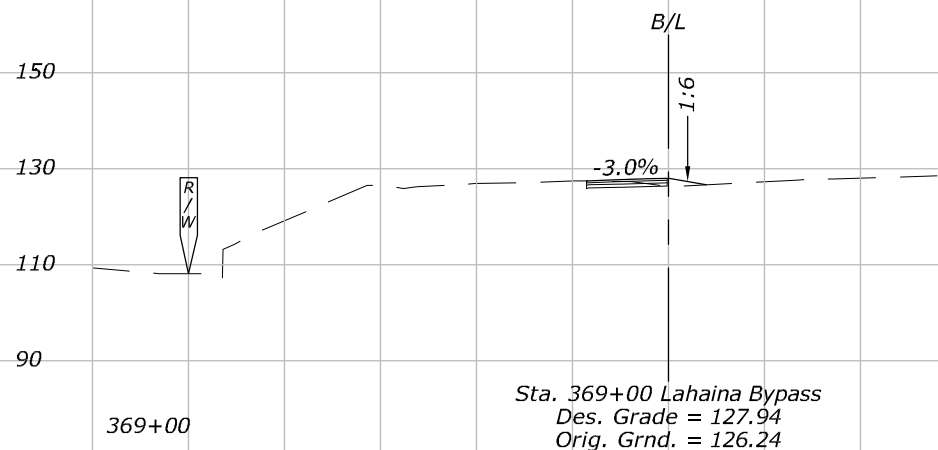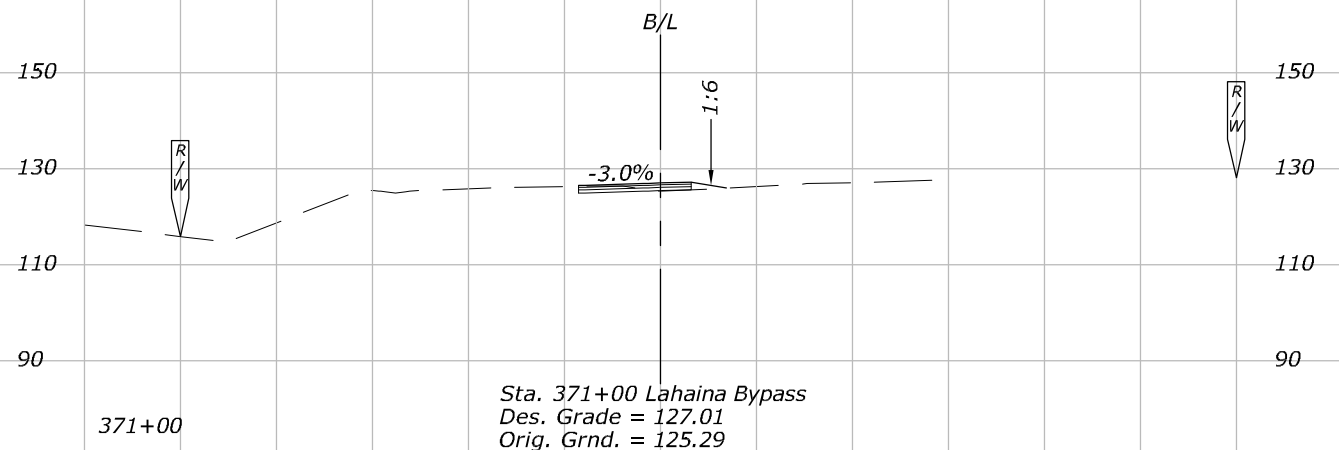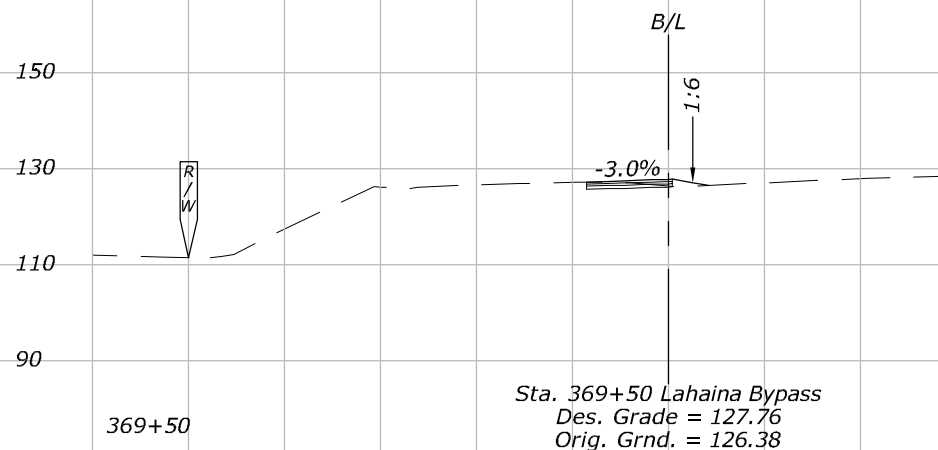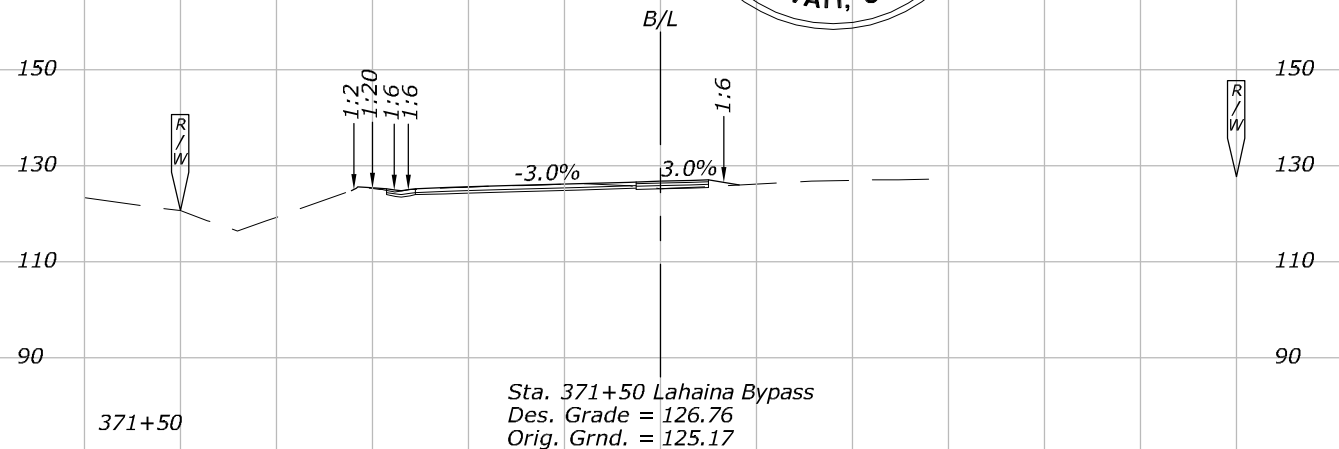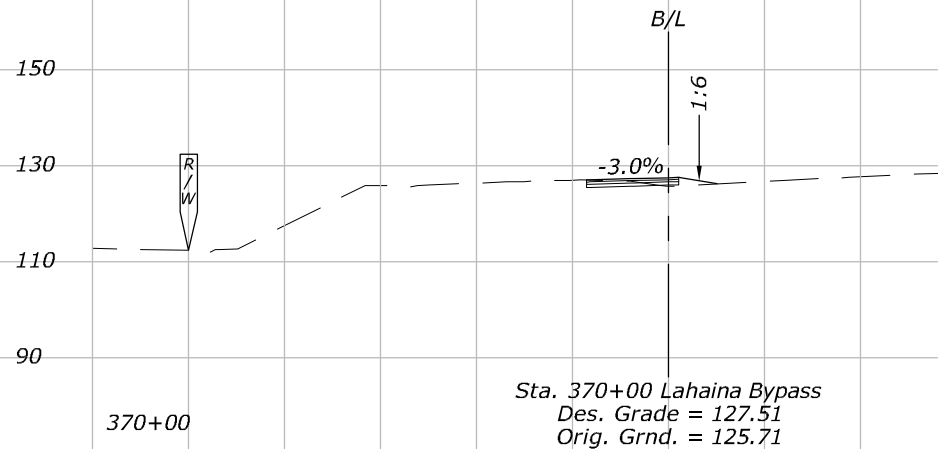

CROSS SECTIONS 369+00 TO 371+50

Patricia Choy

W:\102226-01\Civil\CADD\Site\DWGS\X3 Cross Sections.dwg


12:58:12

January 11, 2019

NOTES:







1. Elevations Shown on Roadway
Sections are at 10'.

STATE	PROJECT	SHEET NO.
HI	HI STP SR 30(1)	X3

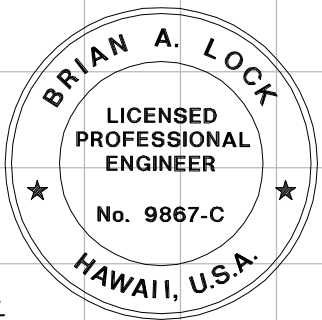

THIS WORK WAS PREPARED BY ME
OR UNDER MY SUPERVISION.

WILSON OKAMOTO CORPORATION
APRIL 30, 2020
LIC. EXP. DATE

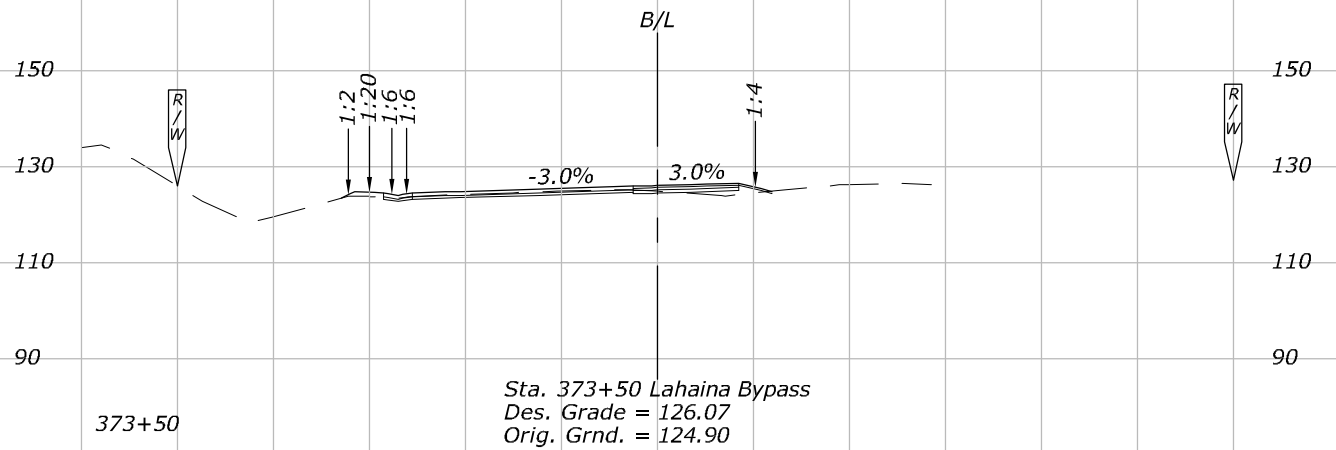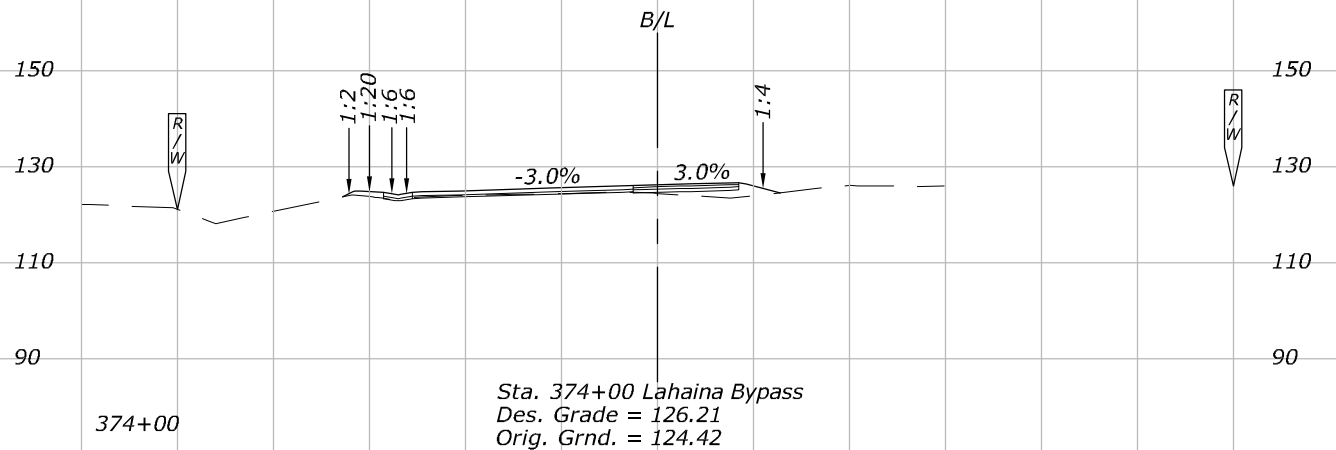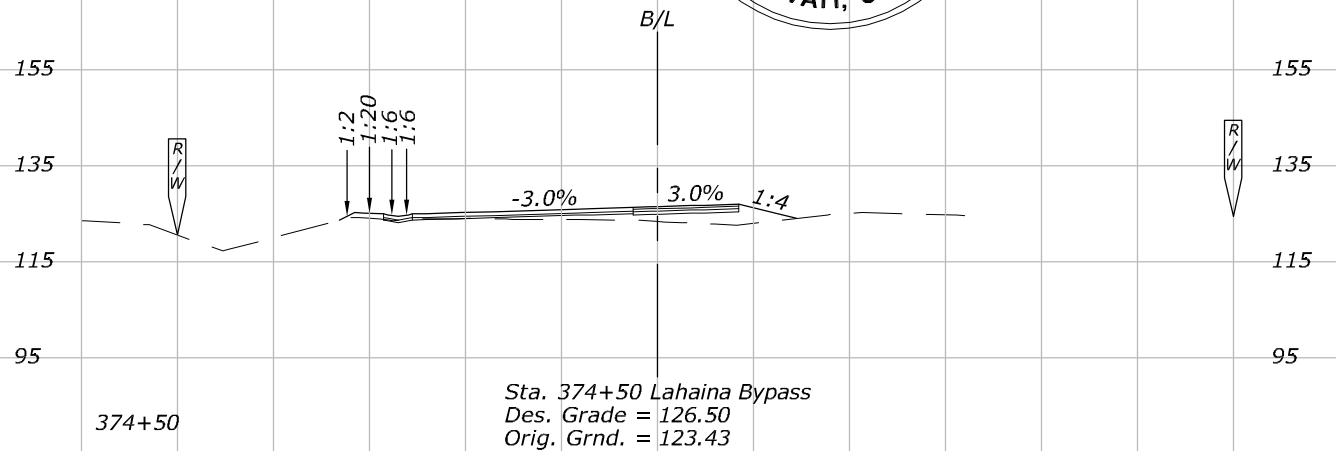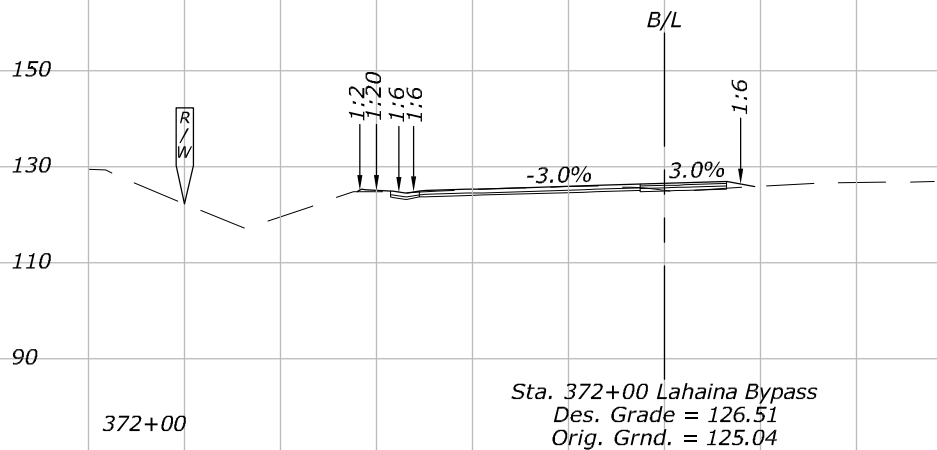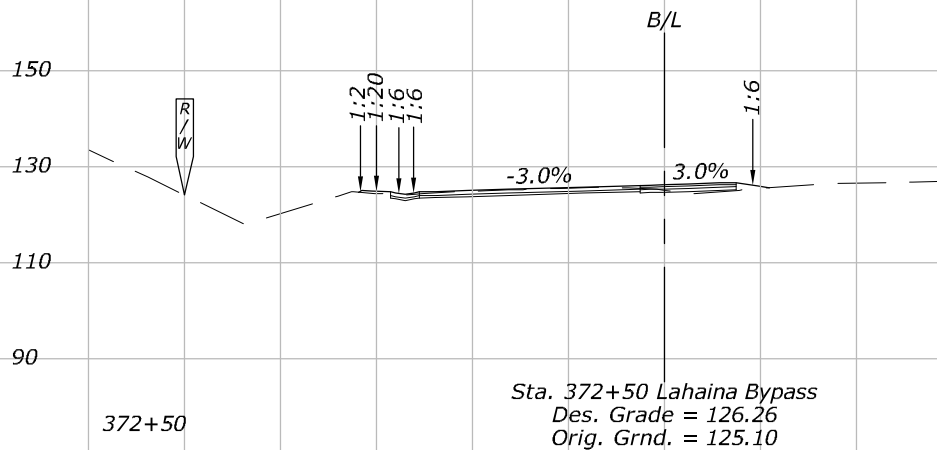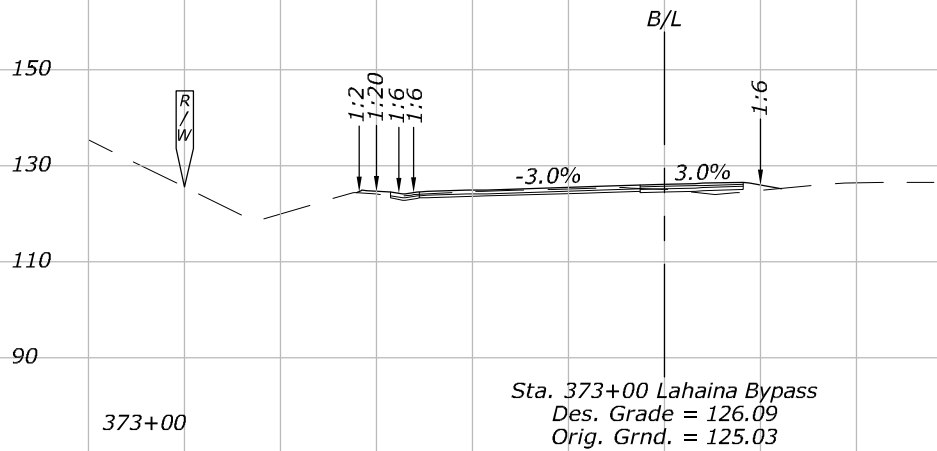

CROSS SECTIONS 372+00 TO 374+50

Patricia Choy

W:\102226-01\Civil\CADD\Site\DWGS\DRIVE_w\102226-01\Civil\CADD\Site\DWGS\X4 Cross Sections.dwg


12:57:50

January 11, 2019

NOTES:




1. Elevations Shown on Roadway
Sections are at 5'.

STATE	PROJECT	SHEET NO.
HI	HI STP SR 30(1)	X4

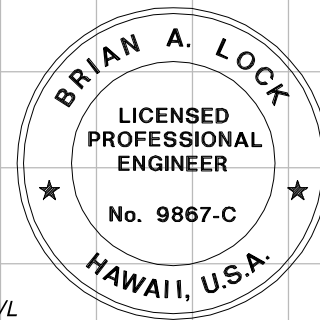

THIS WORK WAS PREPARED BY ME
OR UNDER MY SUPERVISION.

WILSON OKAMOTO CORPORATION
APRIL 30, 2020
LIC. EXP. DATE

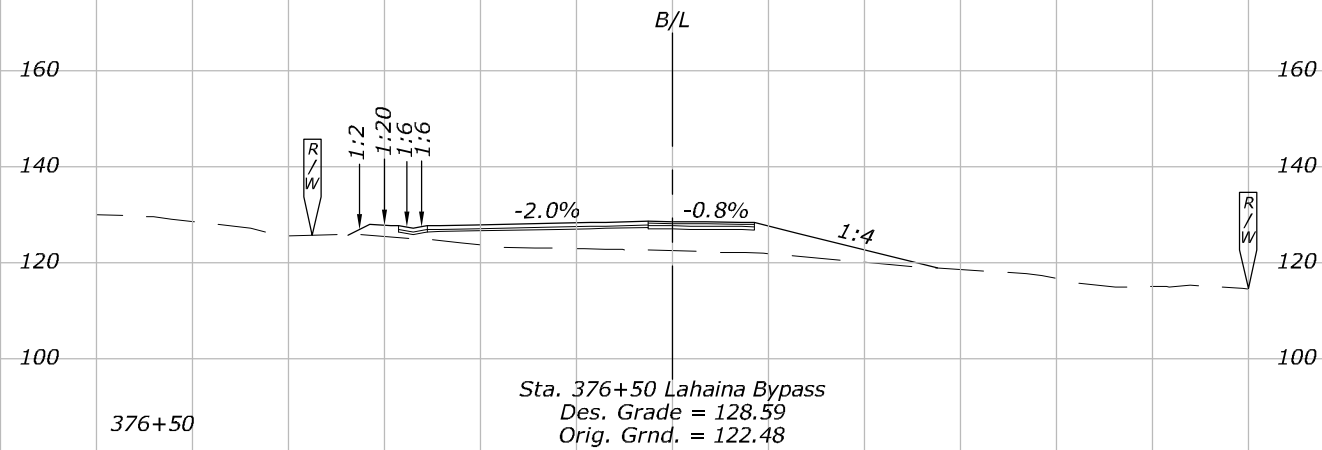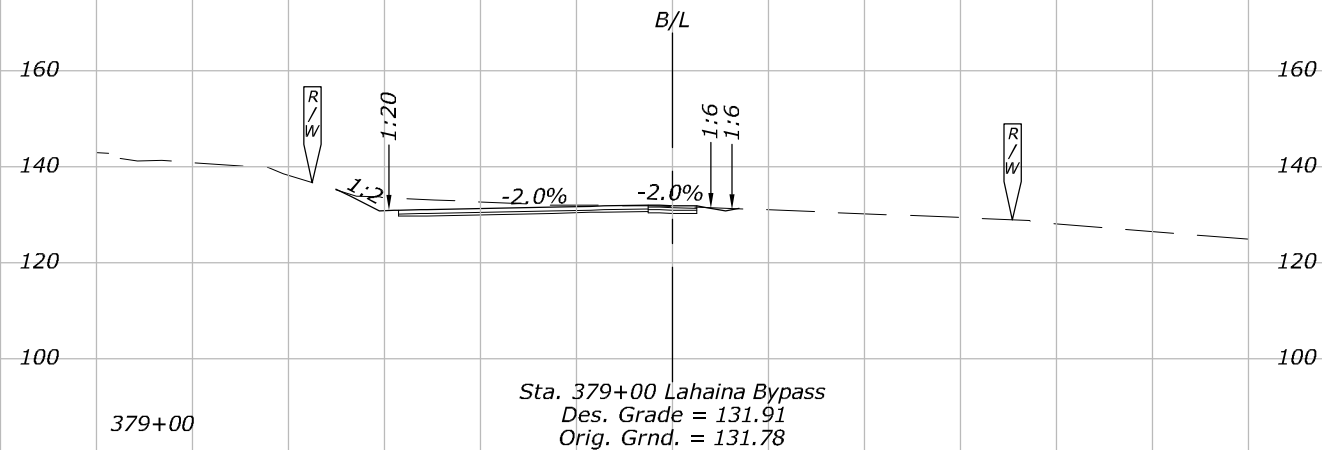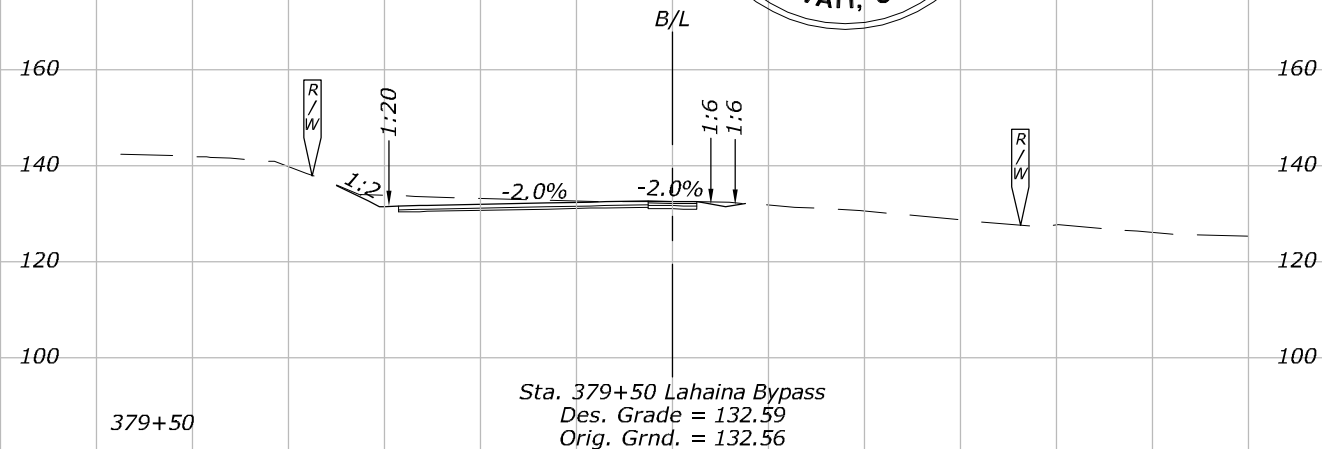

CROSS SECTIONS 375+00 TO 379+50

Patricia Choy

W:\102226-01\Civil\CADD\Site\DWGS\DRIVE - w\102226-01\Civil\CADD\Site\DWGS\X5 Cross Sections.dwg


12:57:26

January 11, 2019

NOTES:



1. Elevations Shown on Roadway
Sections are at 5'.

STATE	PROJECT	SHEET NO.
HI	HI STP SR 30(1)	X5

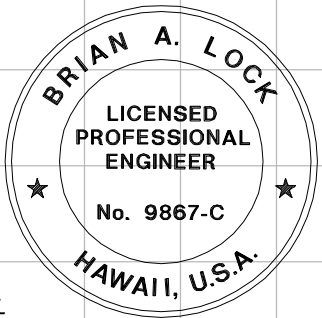

THIS WORK WAS PREPARED BY ME
OR UNDER MY SUPERVISION.

WILSON OKAMOTO CORPORATION
APRIL 30, 2020
LIC. EXP. DATE

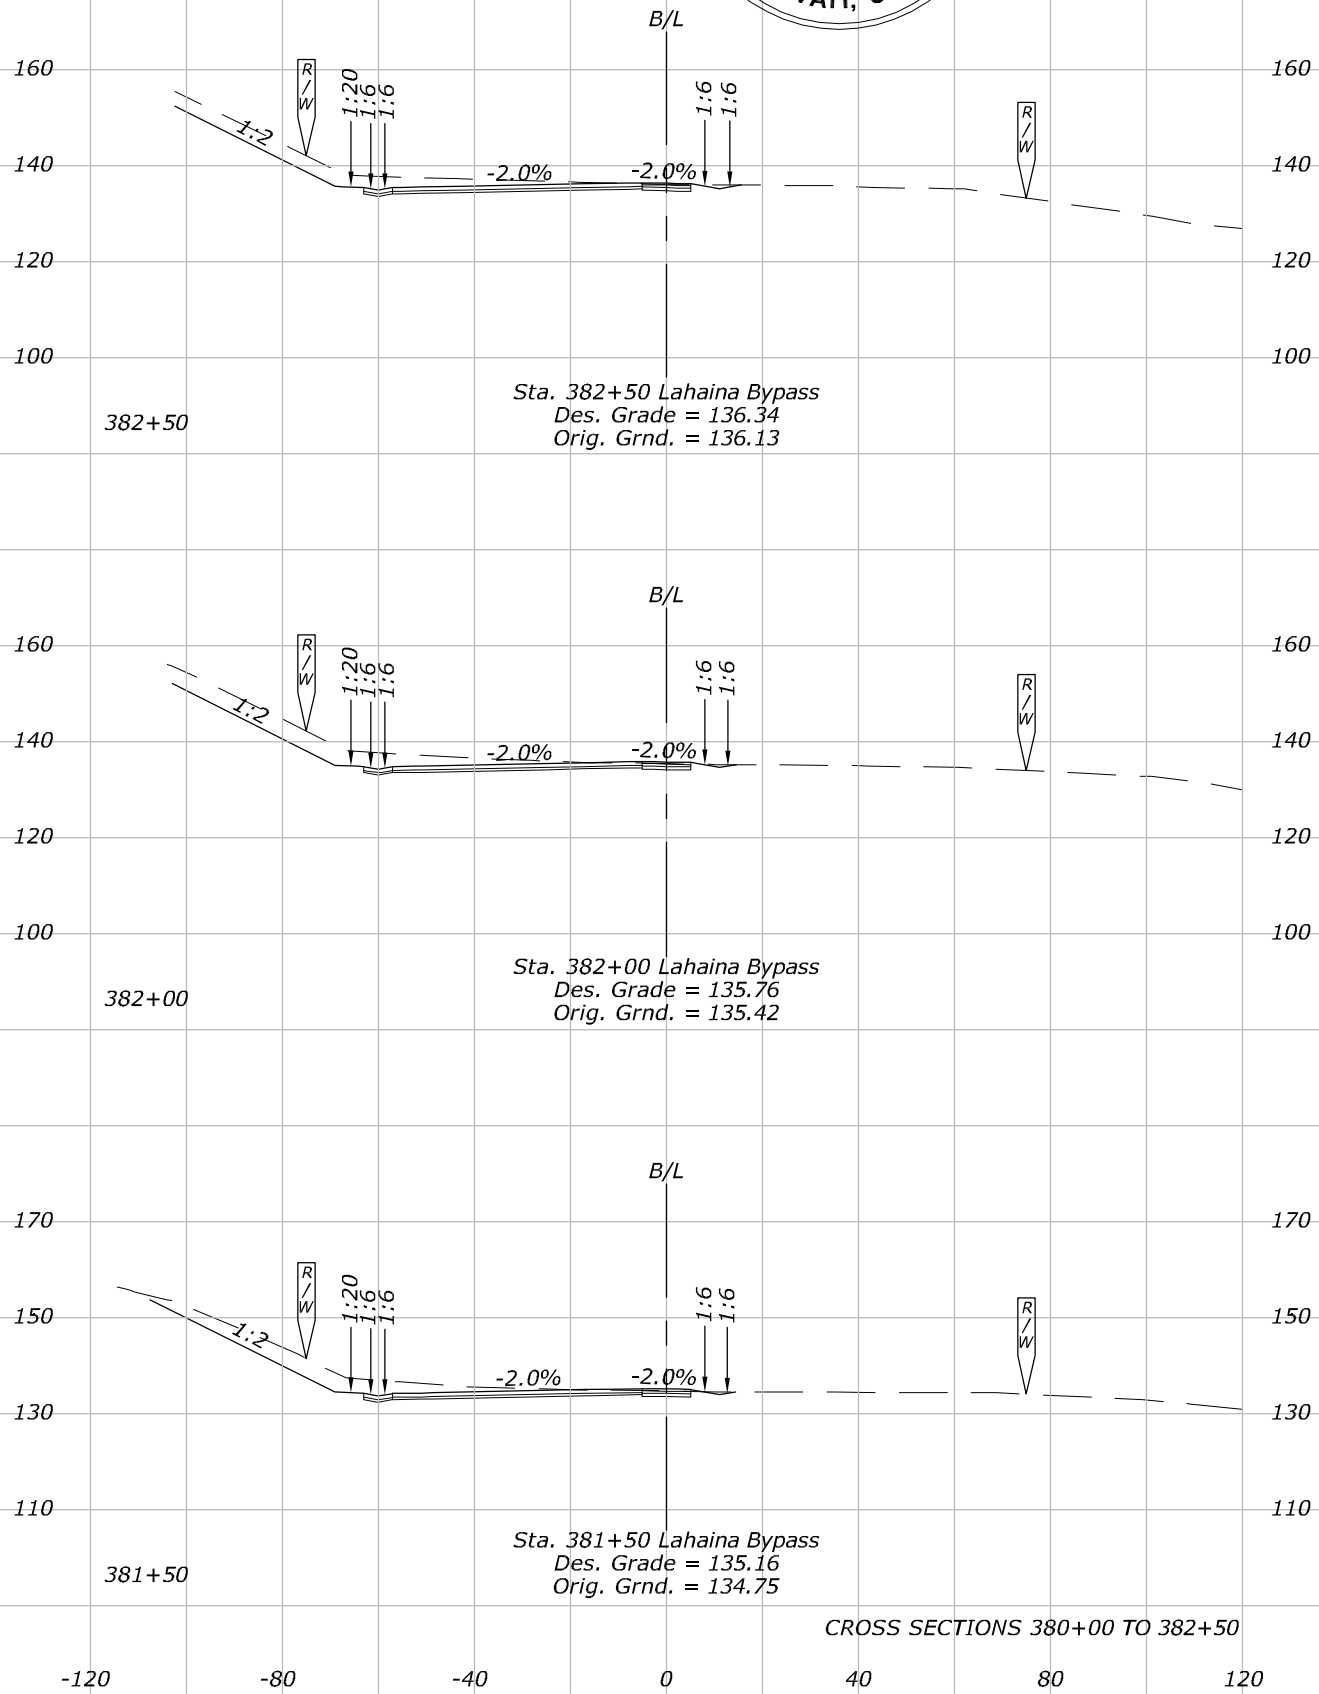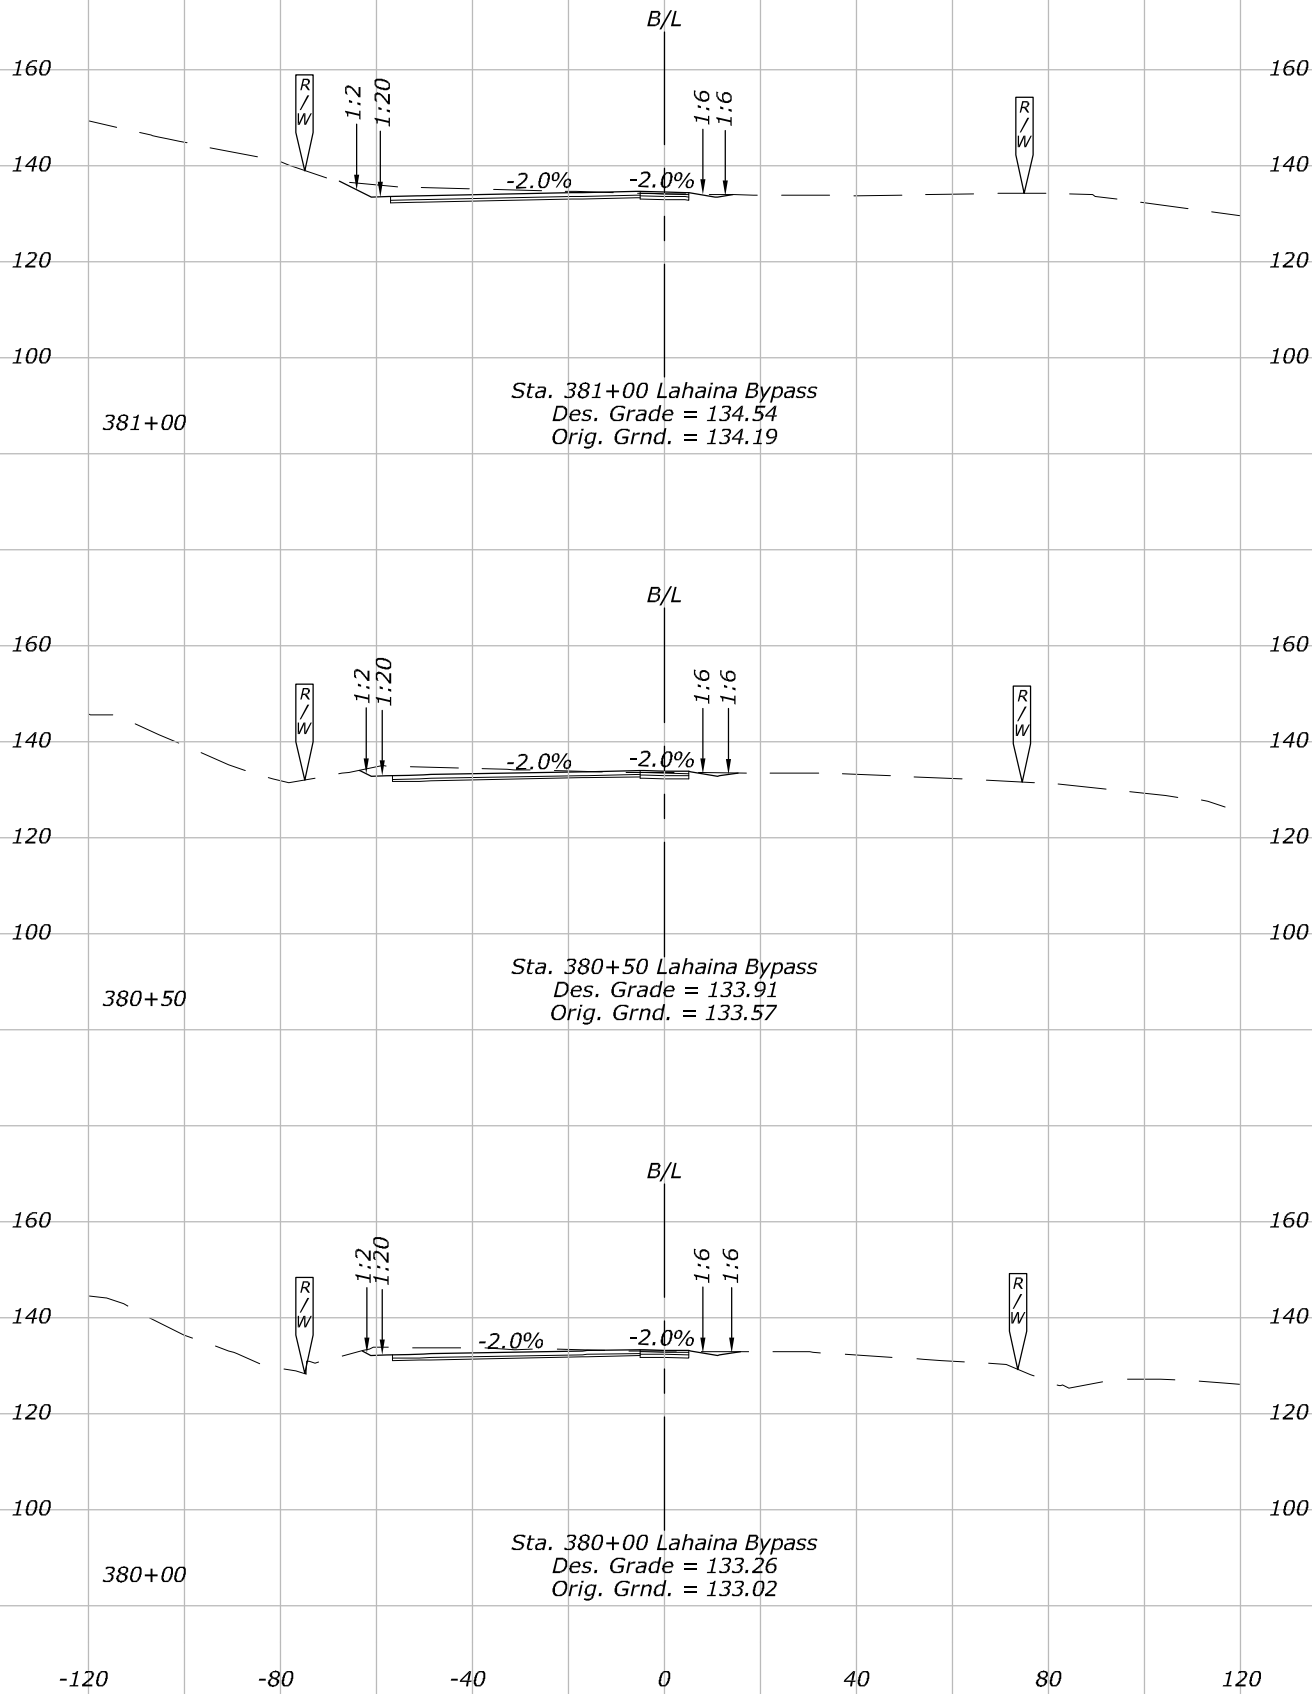

CROSS SECTIONS 380+00 TO 382+50

Patricia Choy

W:\102226-01\Civil\CADD\Site\DWGS\X6 Cross Sections.dwg


12:57:13

January 11, 2019

NOTES:



1. Elevations Shown on Roadway
Sections are at 10'.

STATE	PROJECT	SHEET NO.
HI	HI STP SR 30(1)	X6

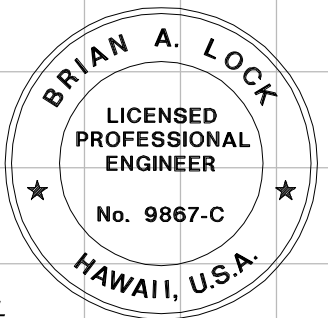

THIS WORK WAS PREPARED BY ME
OR UNDER MY SUPERVISION.

WILSON OKAMOTO CORPORATION
APRIL 30, 2020
LIC. EXP. DATE

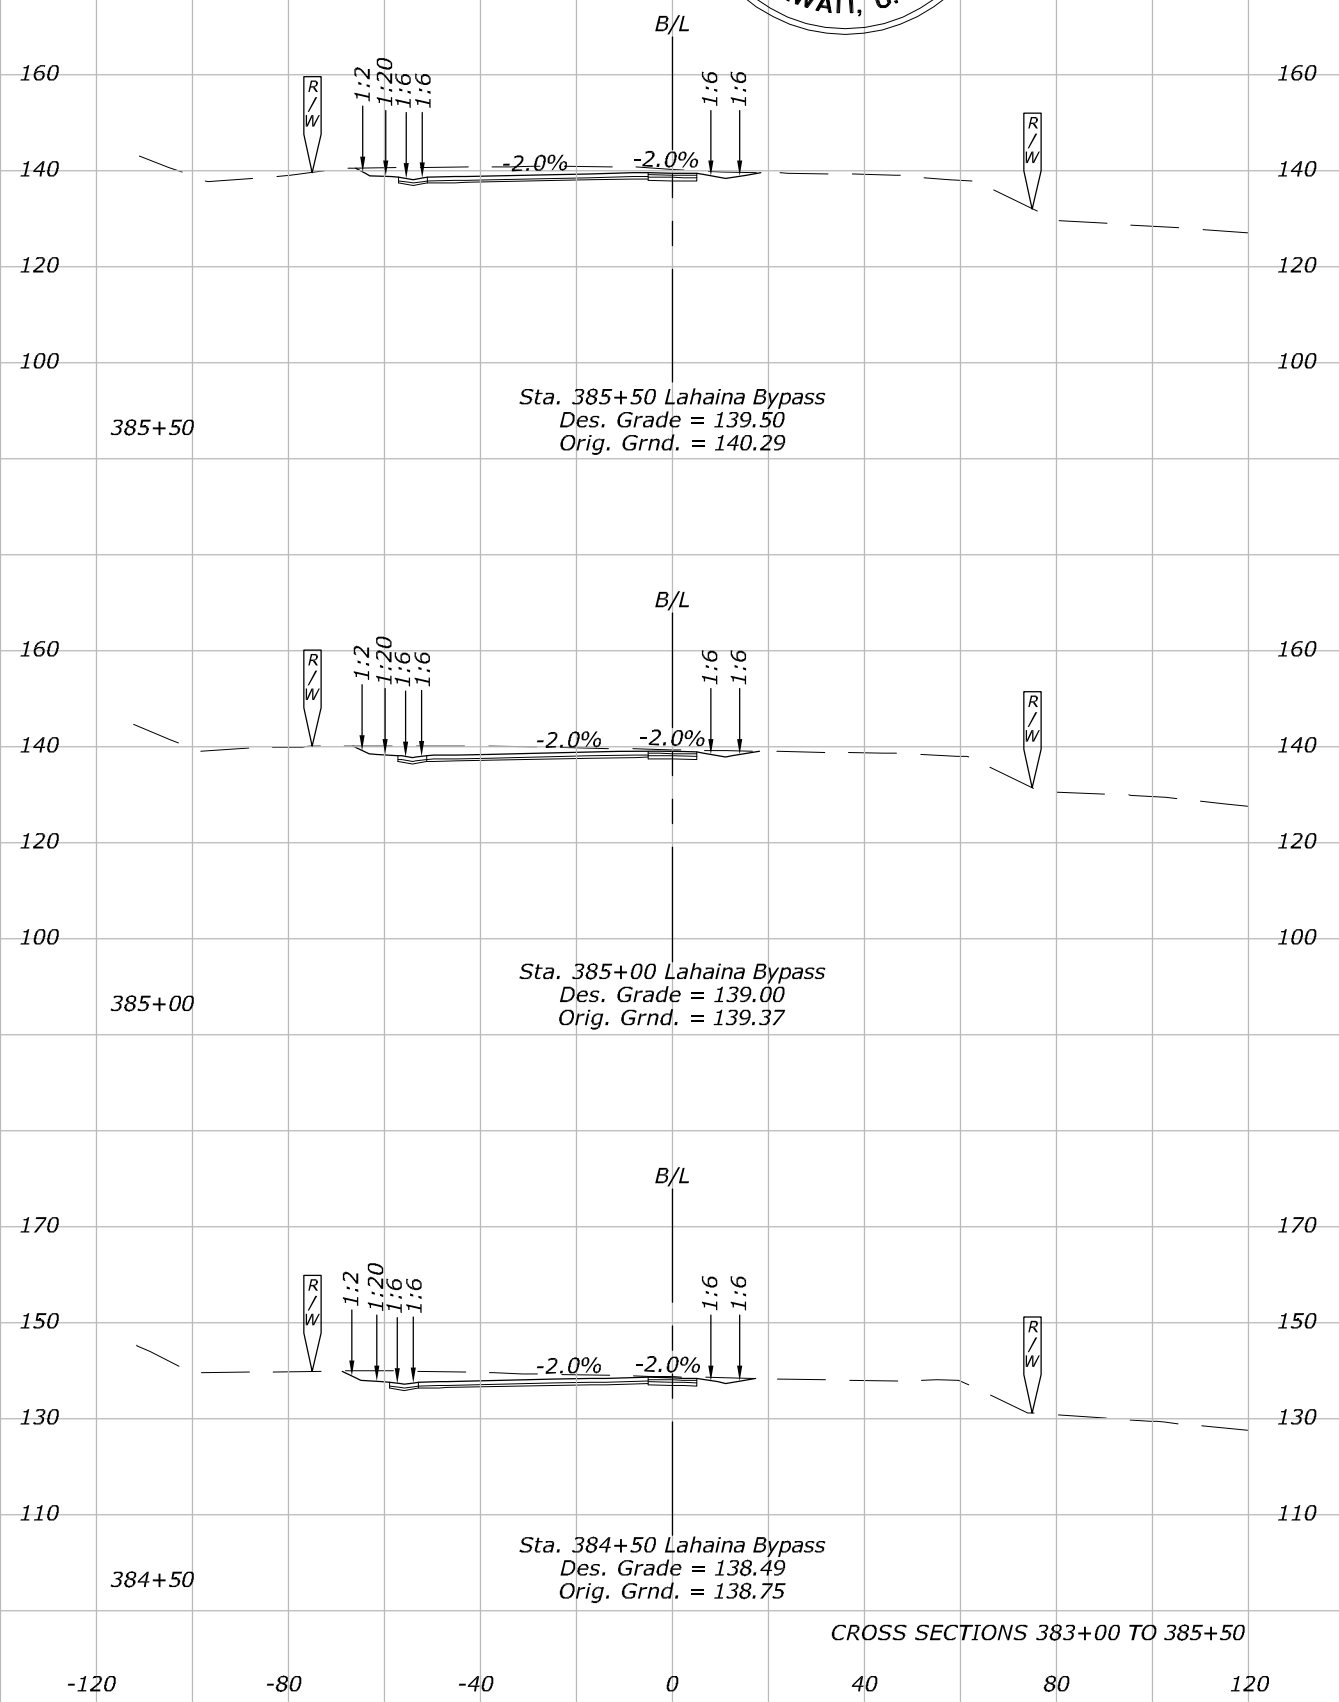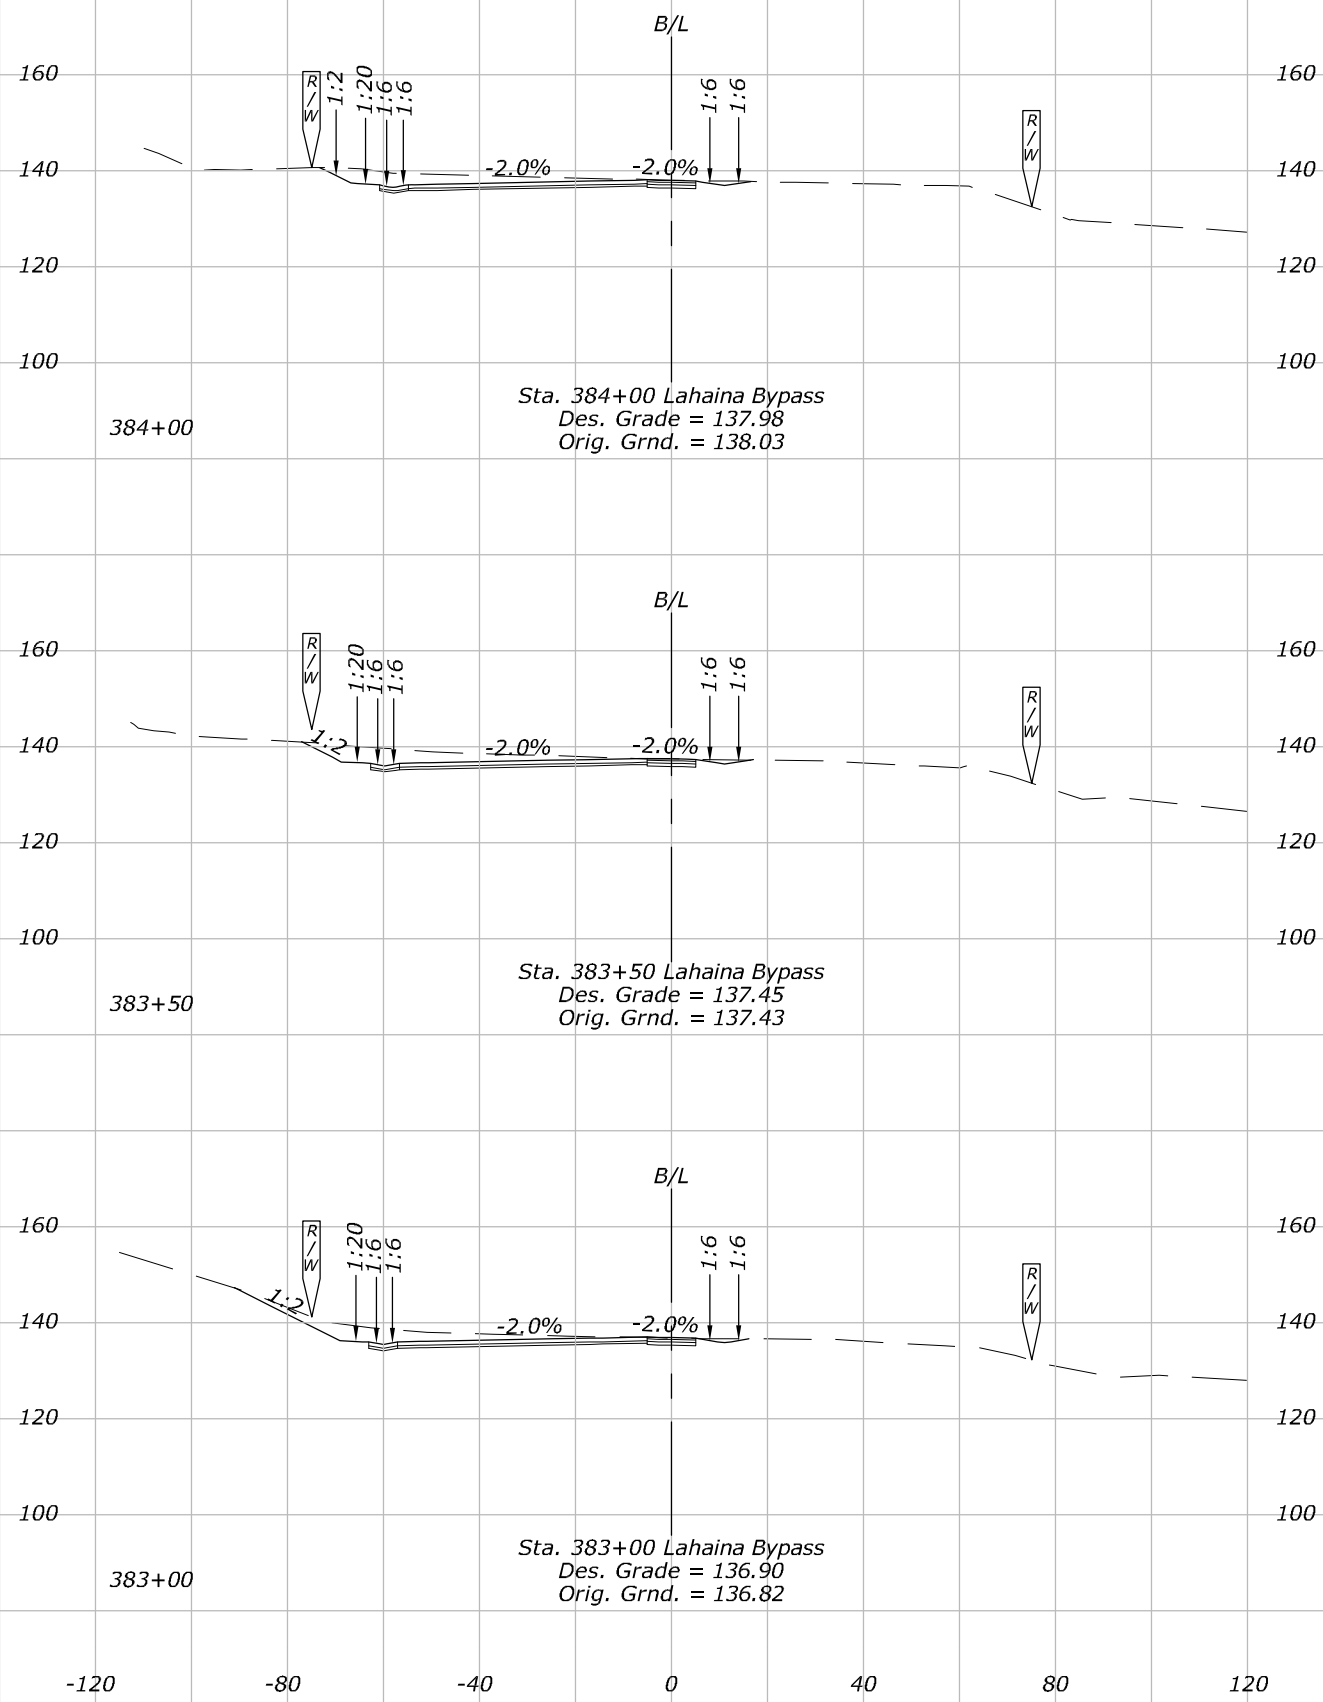

CROSS SECTIONS 383+00 TO 385+50

Patricia Choy

W:\10226-01\Civil\CADD\Site\AS-BUILTS\DWGS\DRIVE_w\10226-01\Civil\CADD\Site\DWGS\X7 Cross Sections.dwg


14:10:57

January 11, 2019

NOTES:



1. Elevations Shown on Roadway
Sections are at 5'.

STATE	PROJECT	SHEET NO.
HI	HI STP SR 30(1)	X7

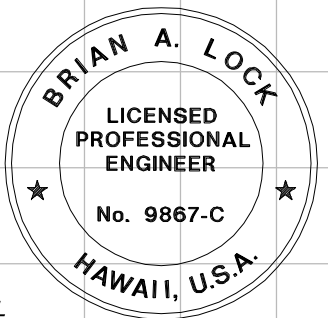

THIS WORK WAS PREPARED BY ME
OR UNDER MY SUPERVISION.

WILSON OKAMOTO CORPORATION
APRIL 30, 2020
LIC. EXP. DATE

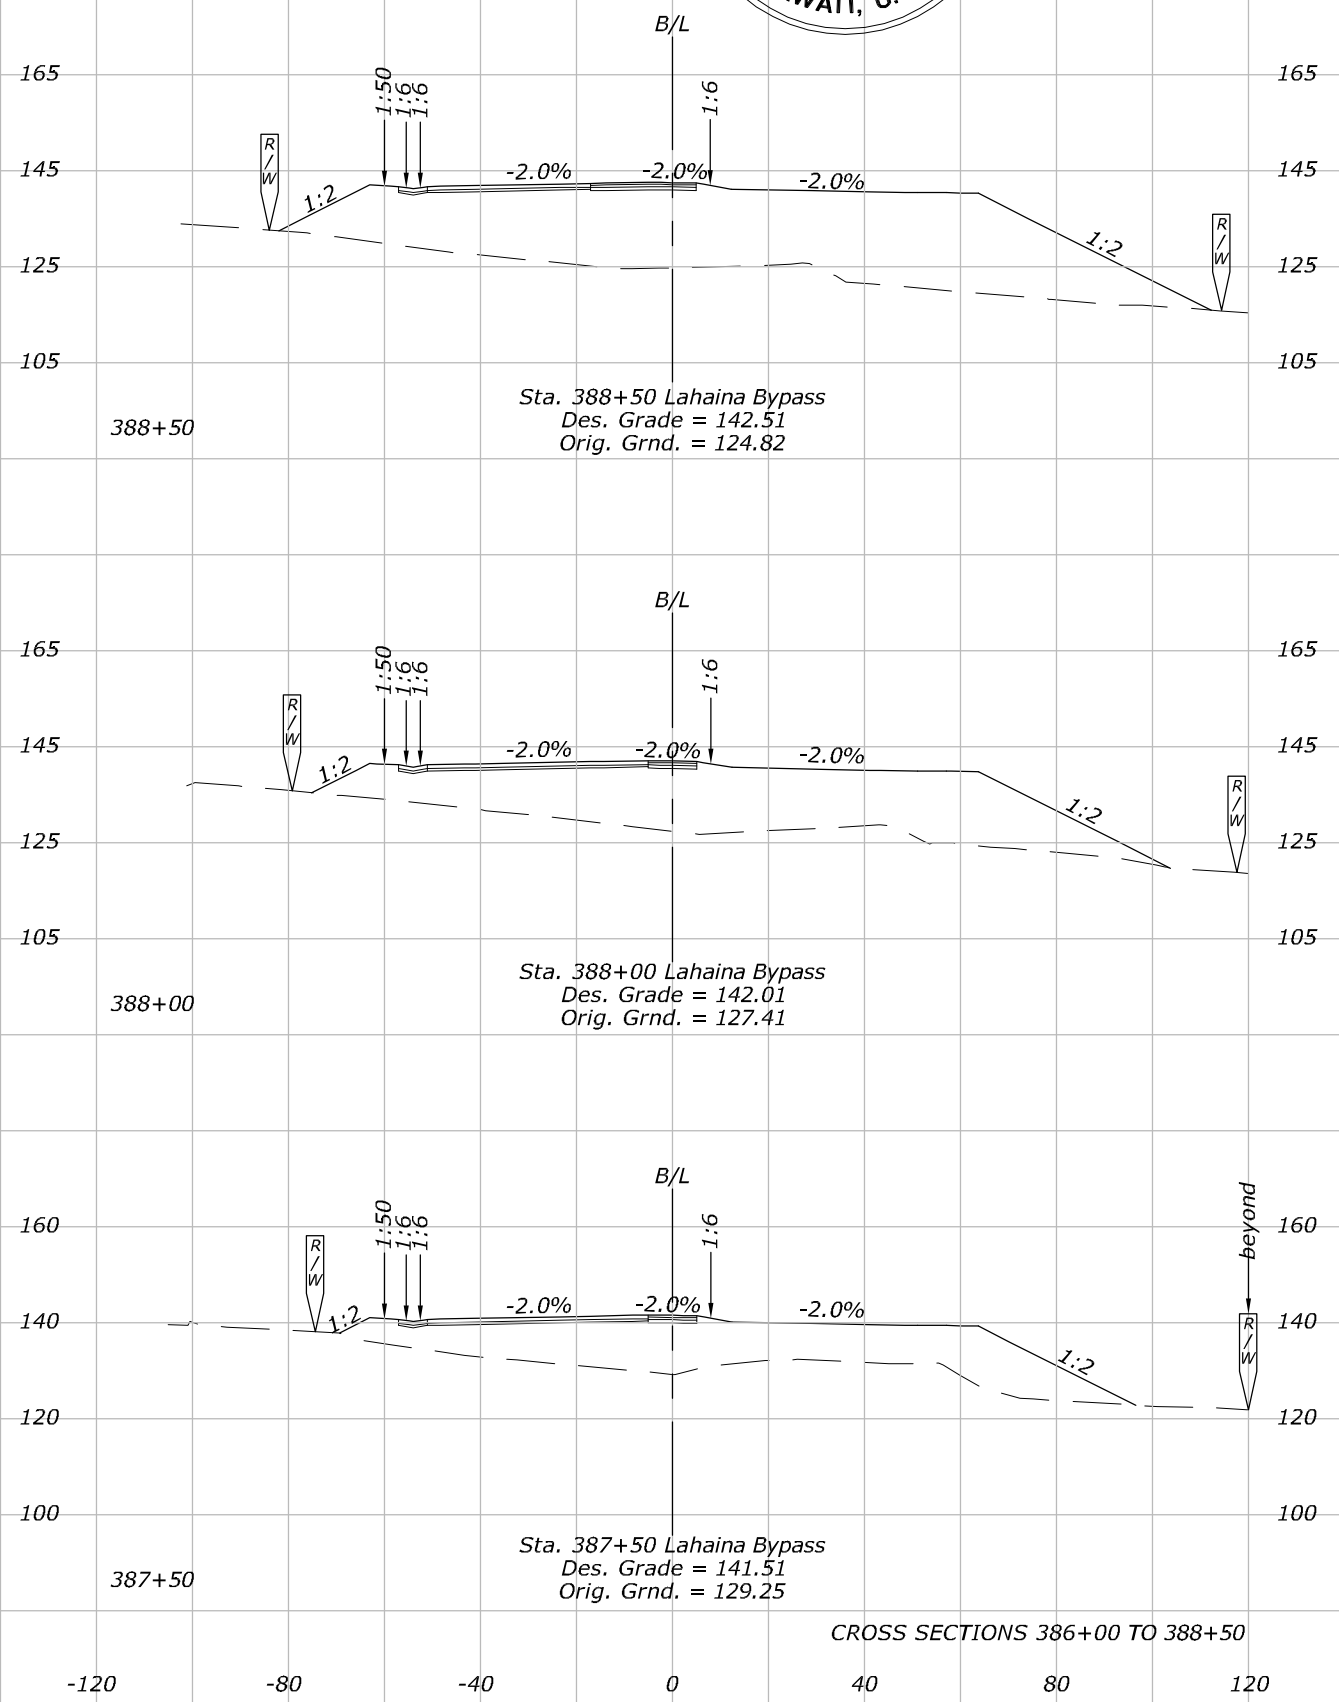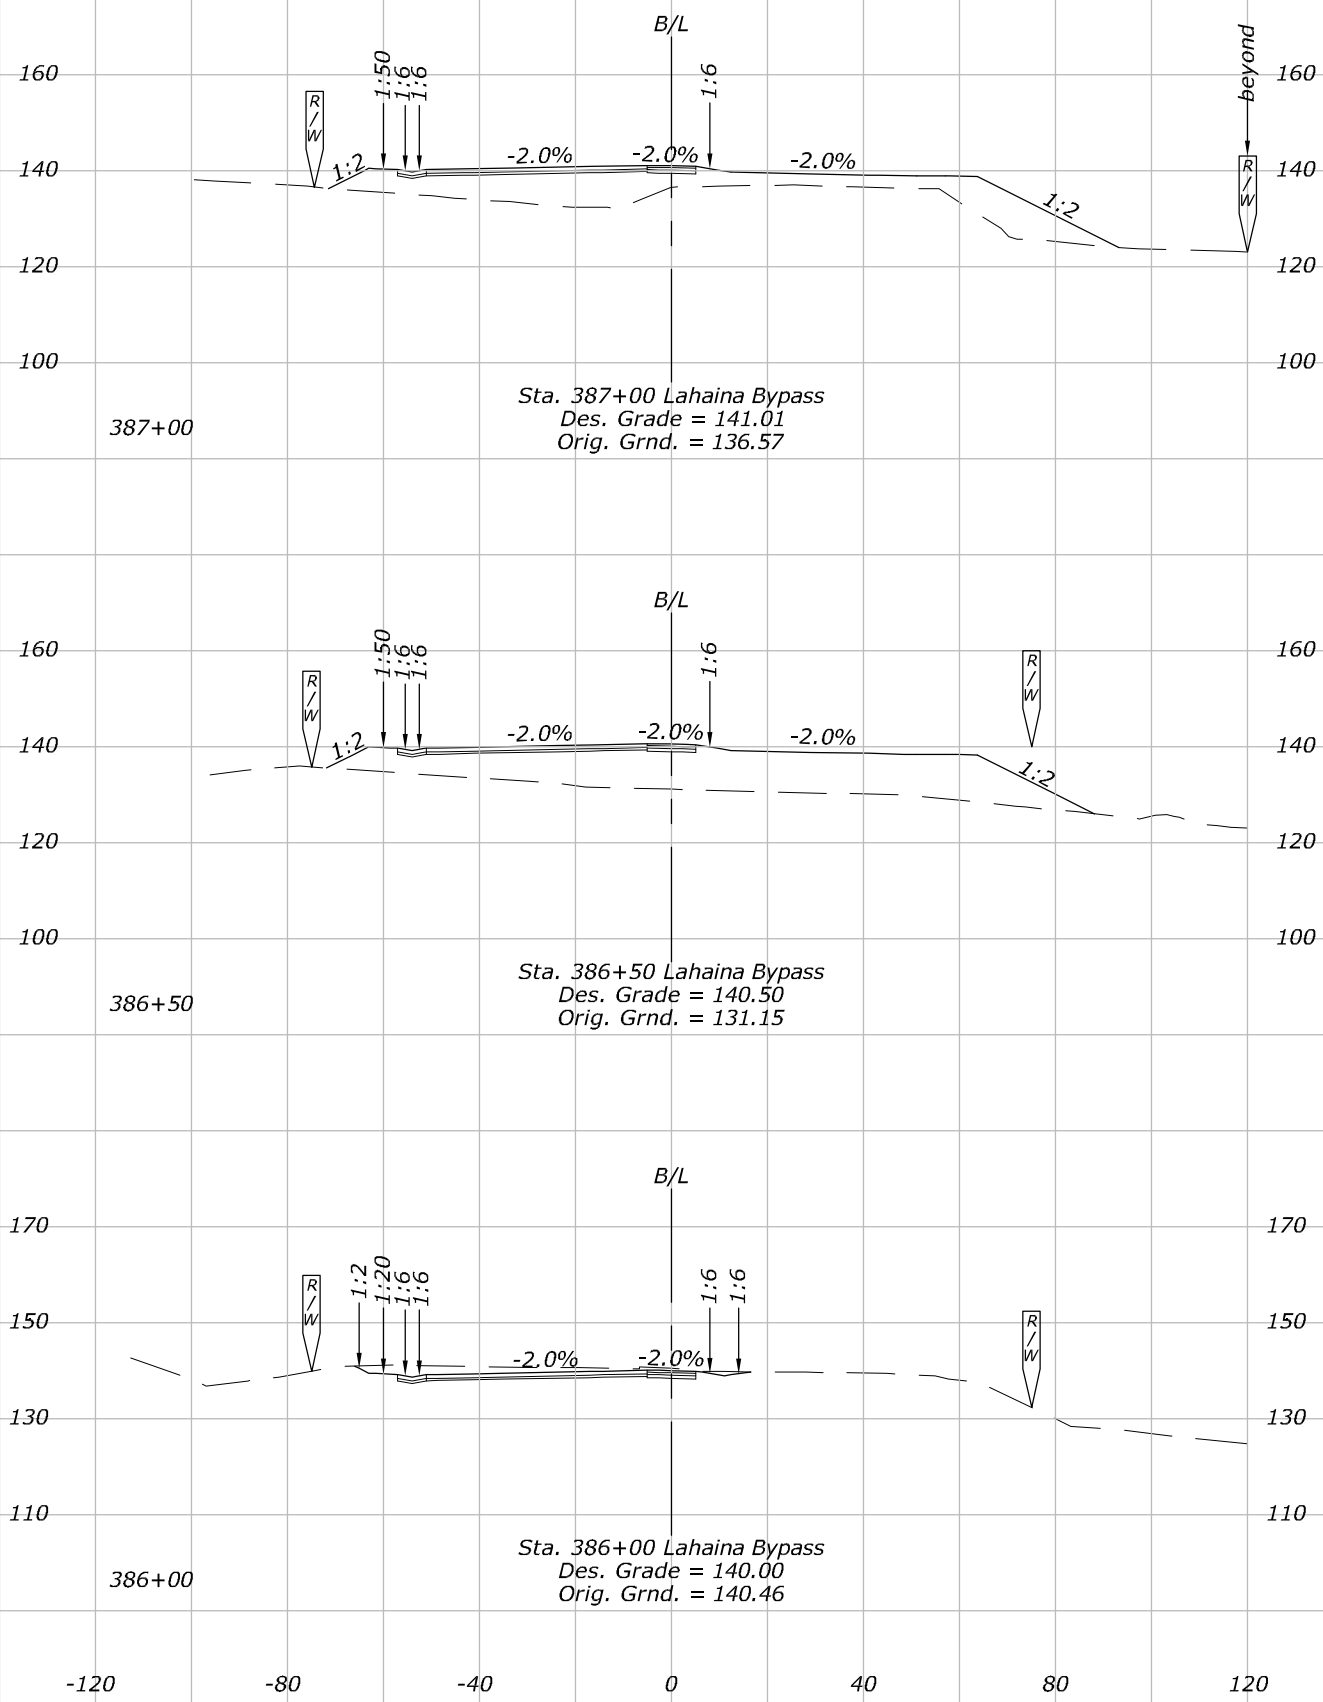


CROSS SECTIONS 386+00 TO 388+50

1. Elevations Shown on Roadway Sections are at B.

A circular professional engineer seal for Brian A. Lock. The outer ring contains the name "BRIAN A. LOCK" at the top and "HAWAII, U.S.A." at the bottom, separated by two stars. The center of the seal contains the text "LICENSED PROFESSIONAL ENGINEER" and "No. 9867-C".

WILSON OKAMOTO CORPORATION	LIC. EXP. DATE
----------------------------	----------------

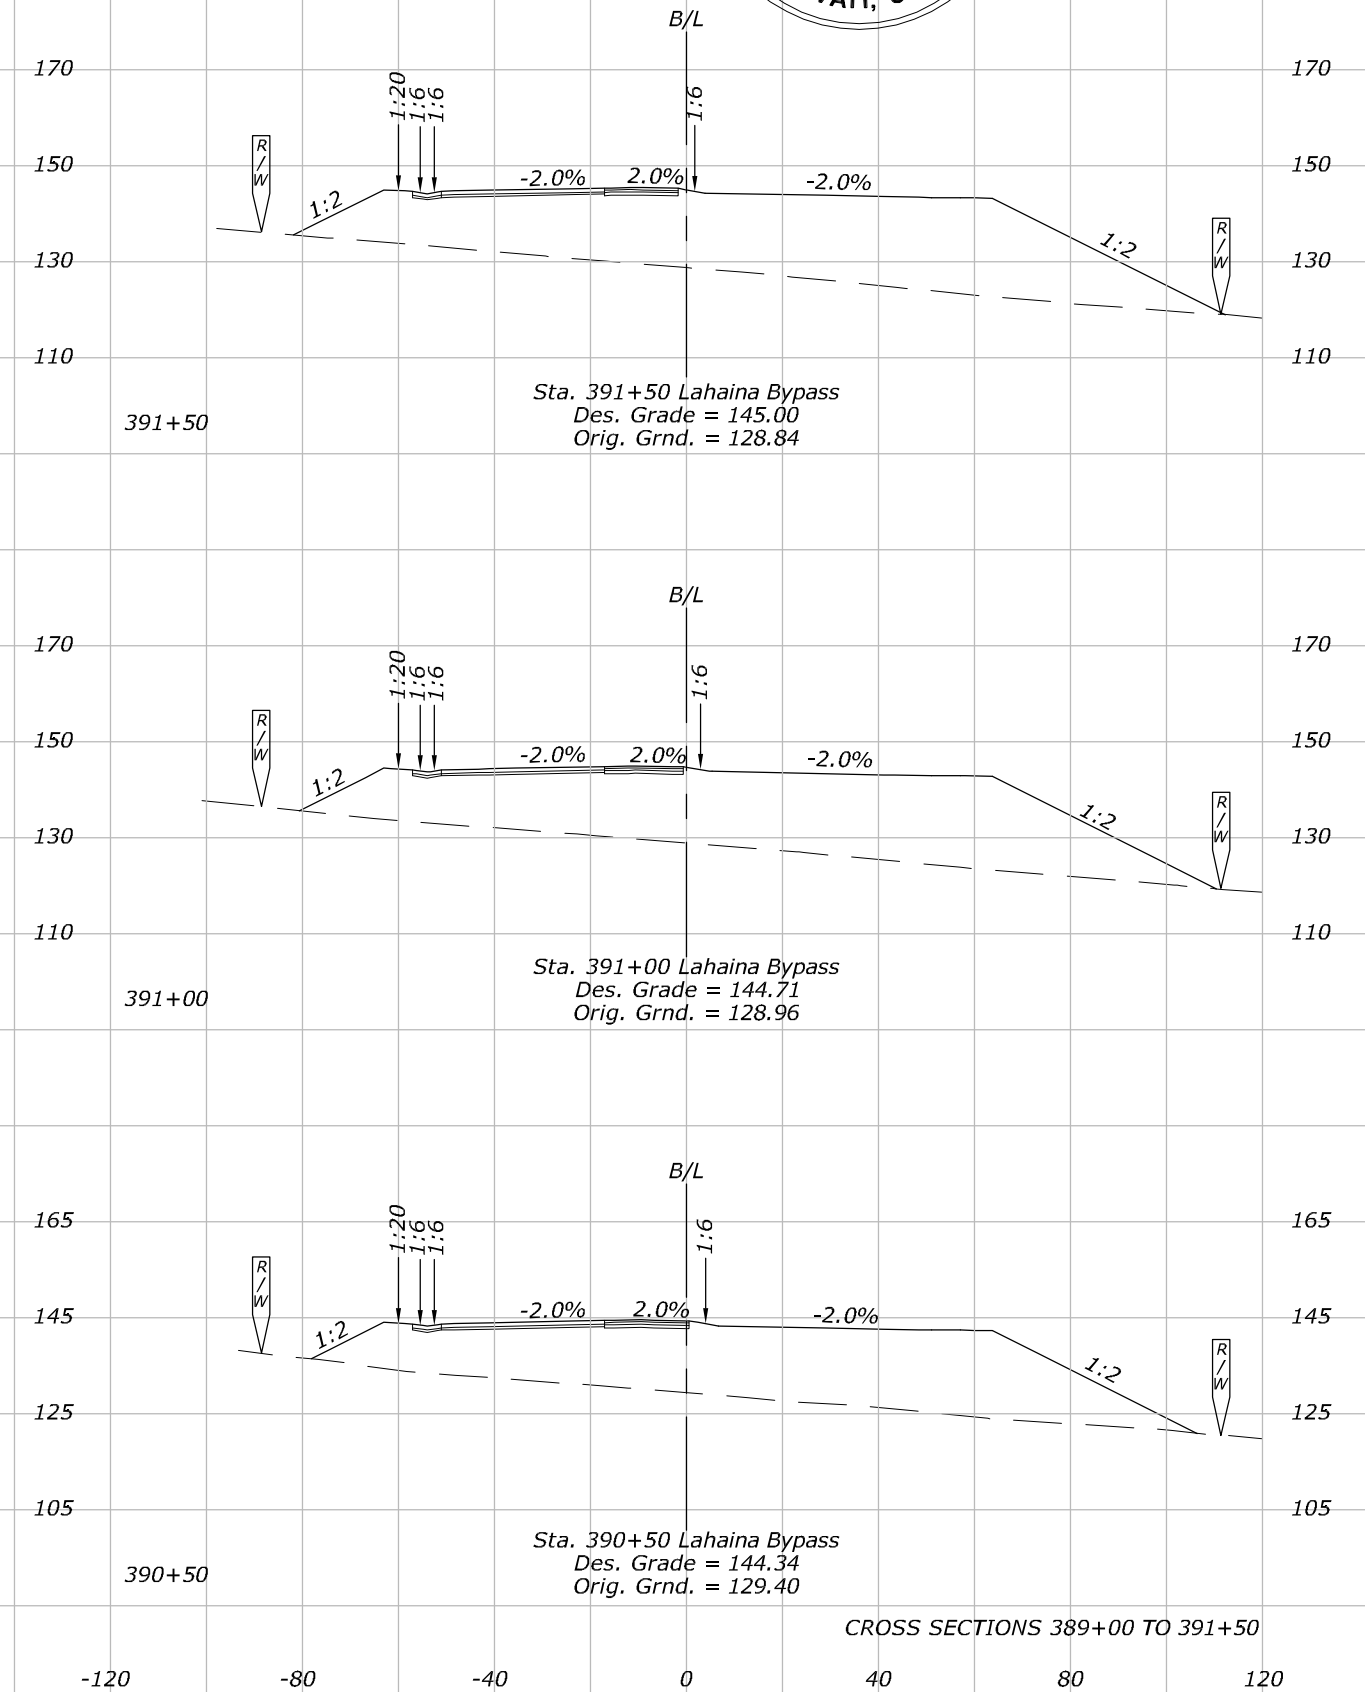

CROSS SECTIONS 389+00 TO 391+50

Patricia Choy

W:\10226-01\Civil\CADD\Site\DWGS\DRIVE_w\10226-01\Civil\CADD\Site\DWGS\X9 Cross Sections.dwg


14:09:11

January 11, 2019

NOTES:






1. Elevations Shown on Roadway
Sections are at 5'.

STATE	PROJECT	SHEET NO.
HI	HI STP SR 30(1)	X9

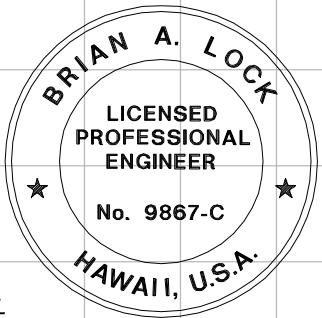

THIS WORK WAS PREPARED BY ME
OR UNDER MY SUPERVISION.

WILSON OKAMOTO CORPORATION
APRIL 30, 2020
LIC. EXP. DATE

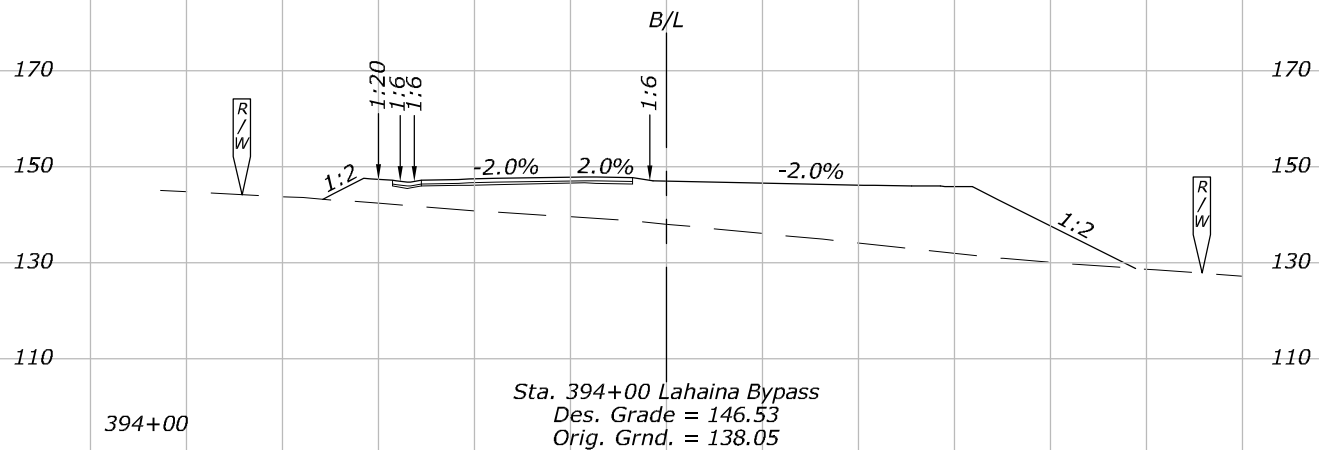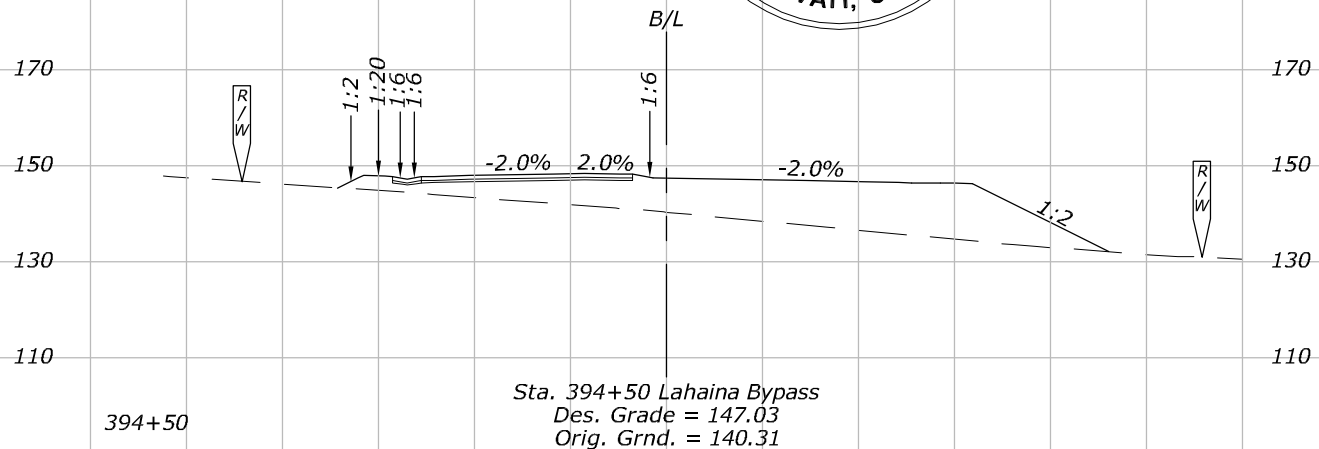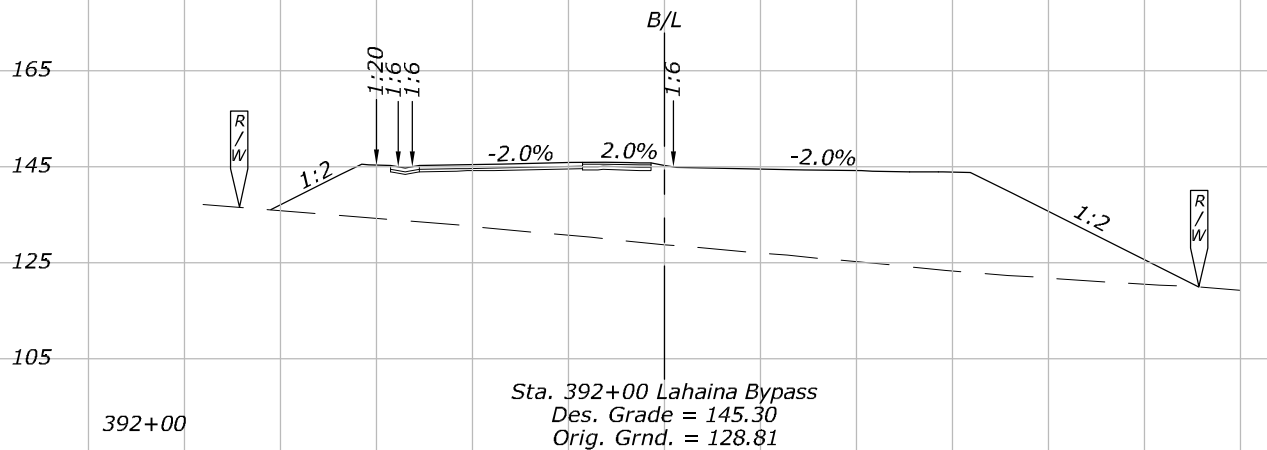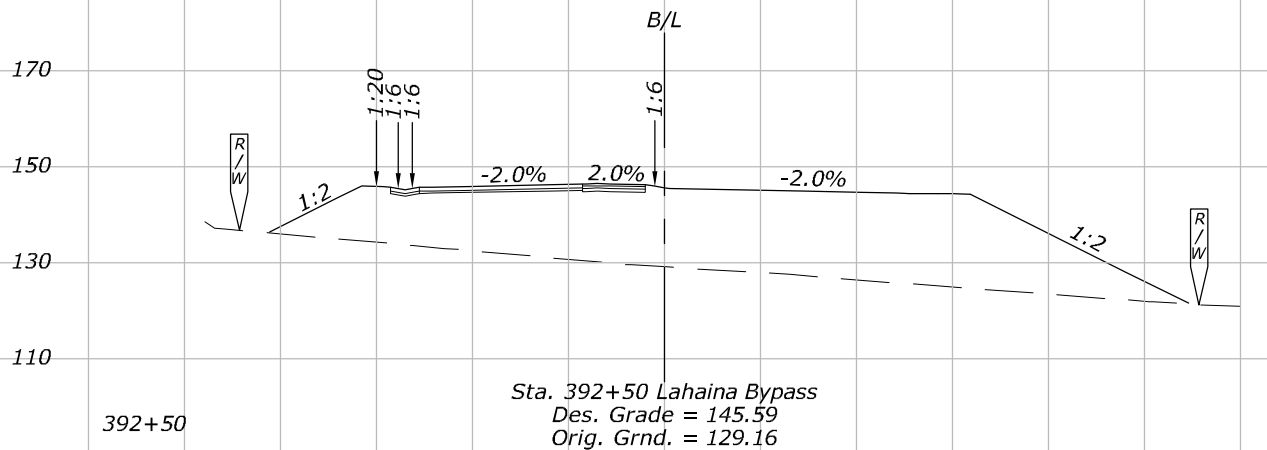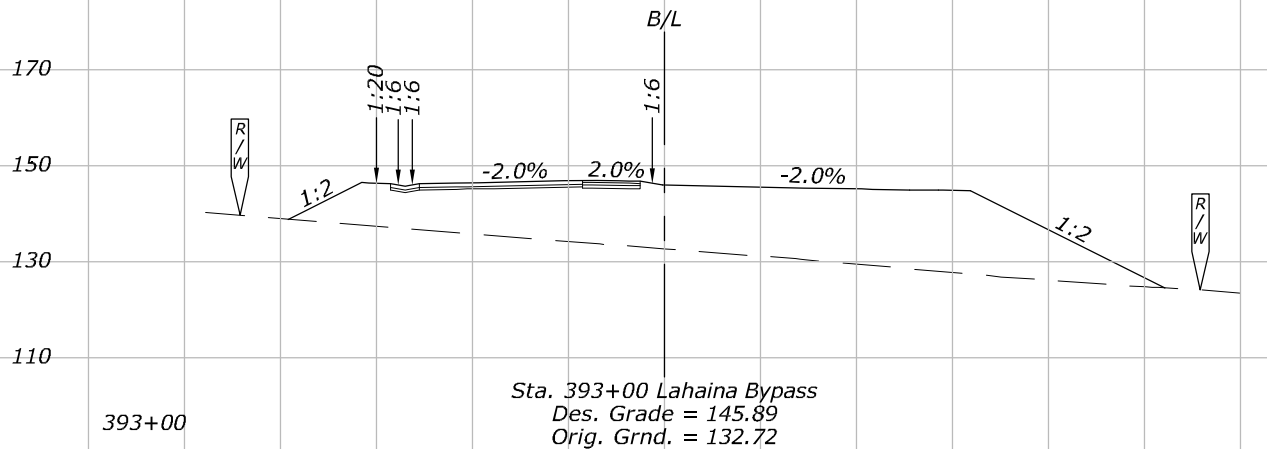

CROSS SECTIONS 392+00 TO 394+50

Patricia Choy

W:\10226-01\Civil\CADD\Site\DWGS\DRIVE_w\10226-01\Civil\CADD\Site\DWGS\X10 Cross Sections.dwg


14:01:07

January 11, 2019

NOTES:



1. Elevations Shown on Roadway
Sections are at 10'.

STATE	PROJECT	SHEET NO.
HI	HI STP SR 30(1)	X10

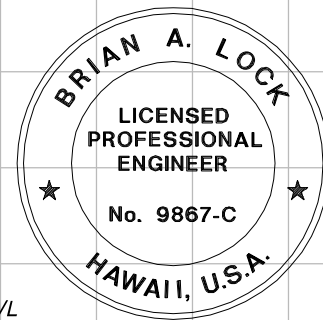

THIS WORK WAS PREPARED BY ME
OR UNDER MY SUPERVISION.

WILSON OKAMOTO CORPORATION
APRIL 30, 2020
LIC. EXP. DATE

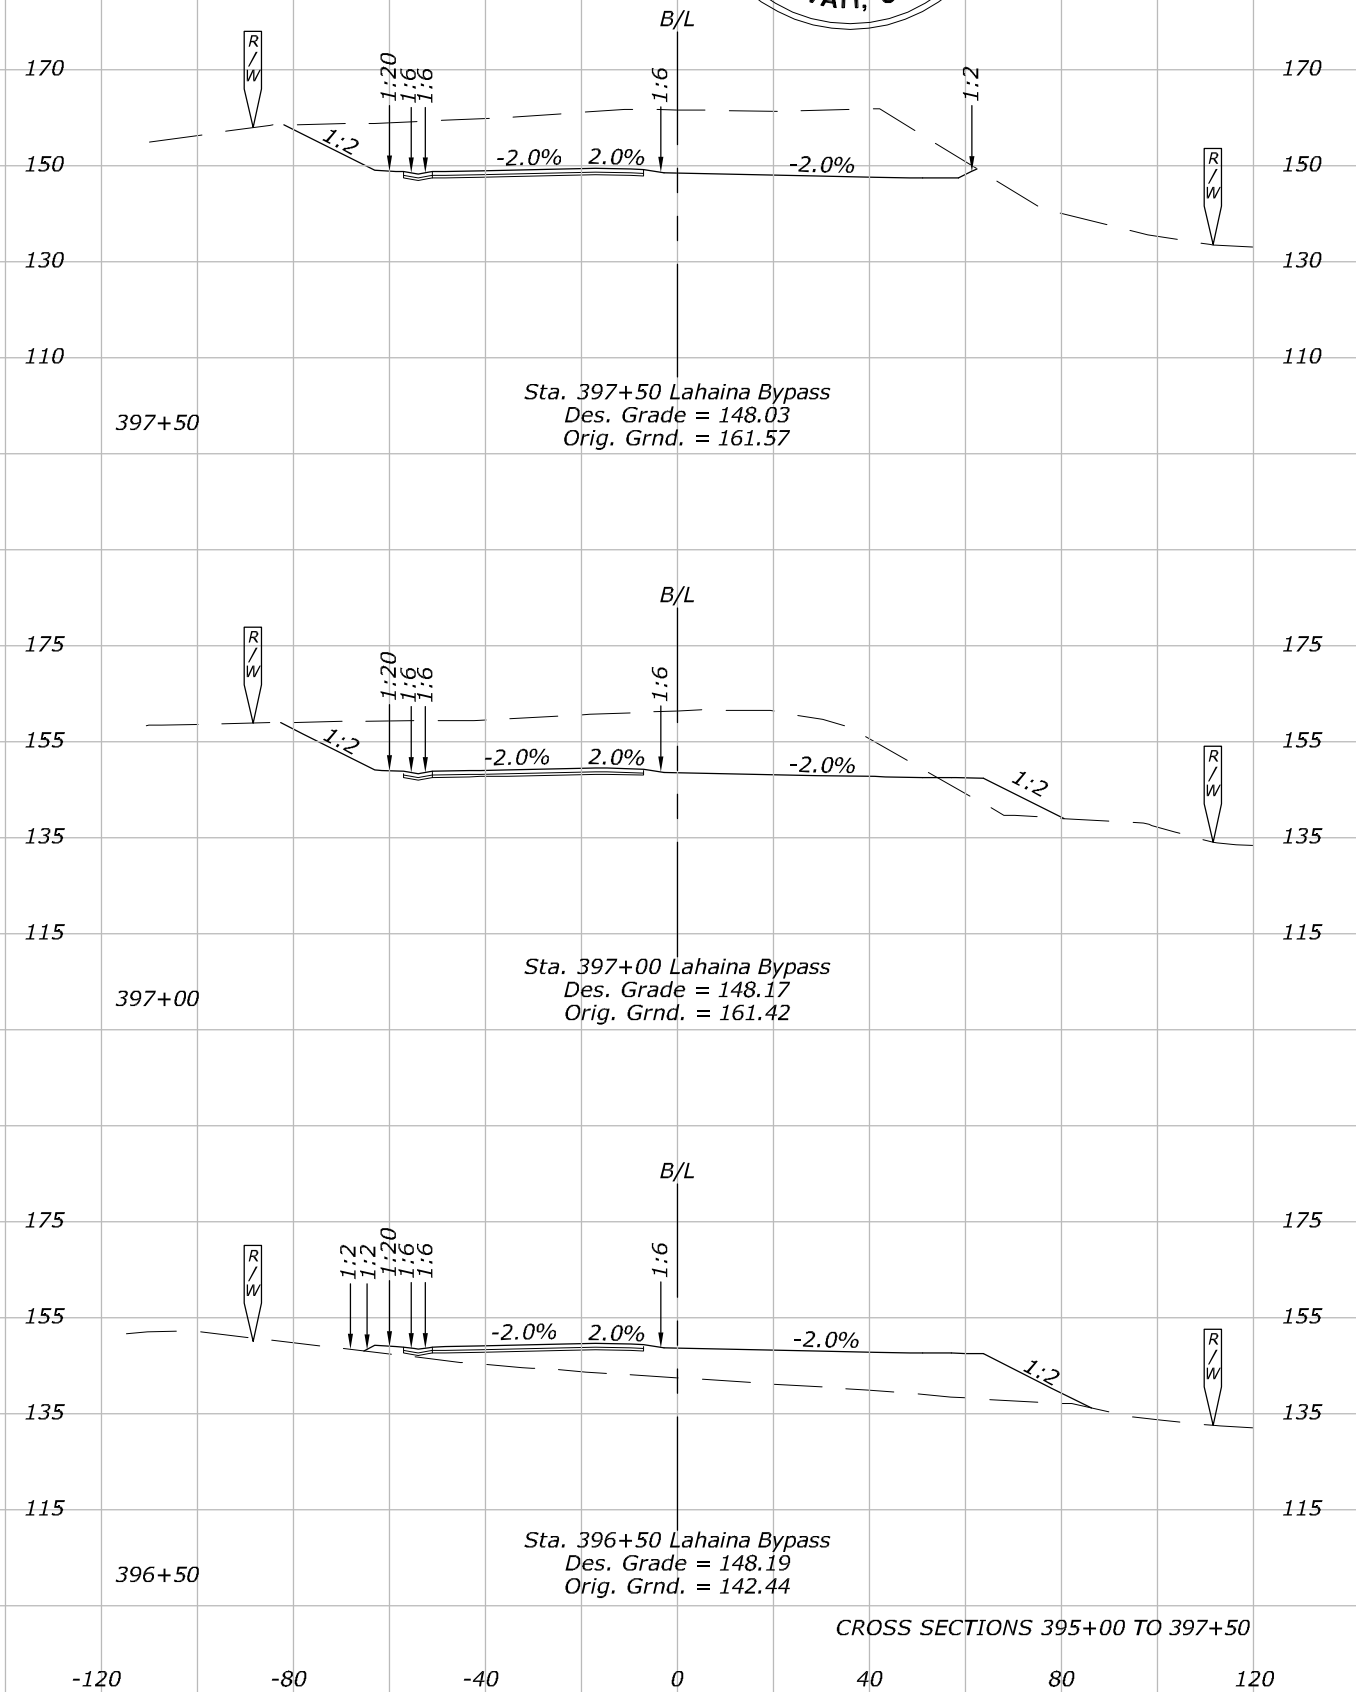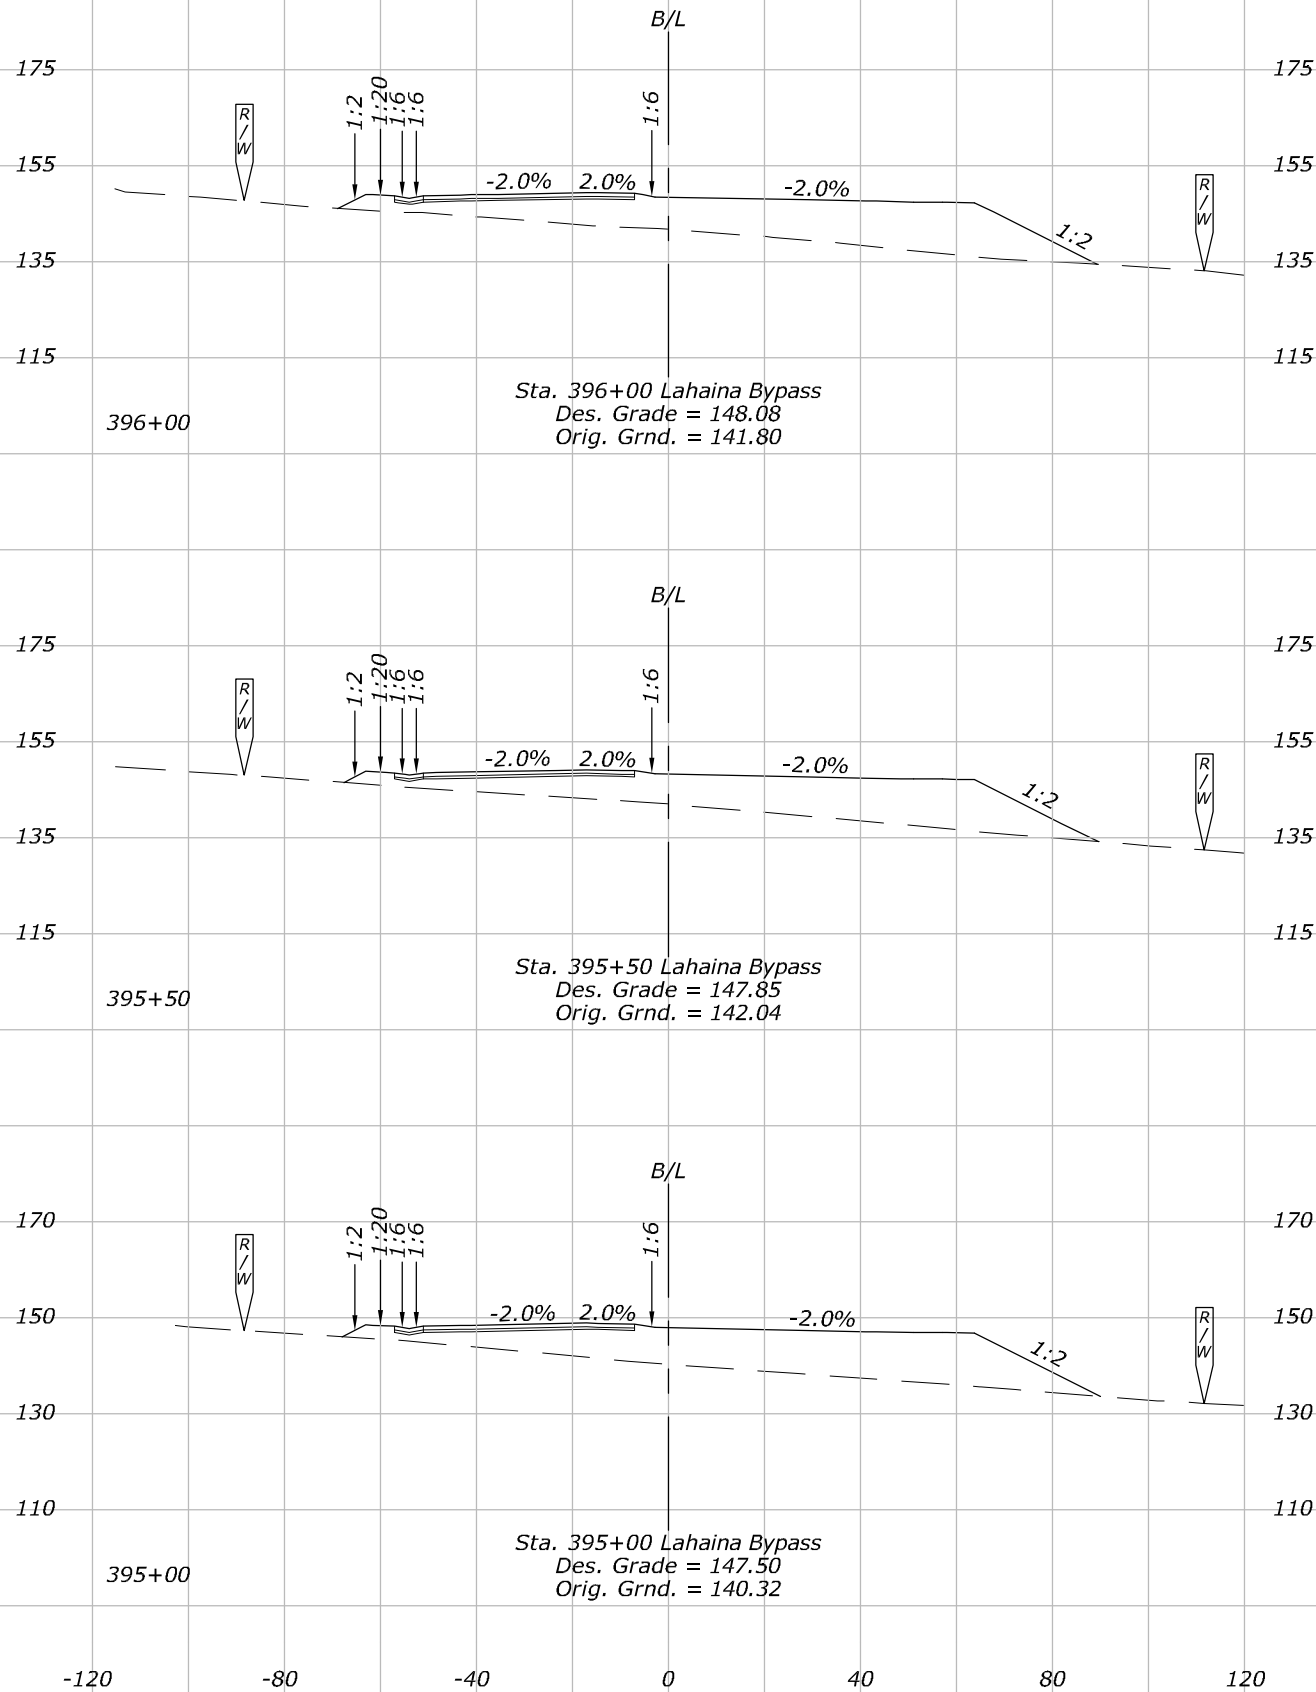

CROSS SECTIONS 395+00 TO 397+50

Patricia Choy

W:\10226-01\Civil\CADD\Site\AS-BUILT\DWGS\DRIVE_w\10226-01\Civil\CADD\Site\DWGS\X11 Cross Sections.dwg


14:02:27

January 11, 2019

NOTES:



1. Elevations Shown on Roadway
Sections are at 50'.

STATE	PROJECT	SHEET NO.
HI	HI STP SR 30(1)	X11

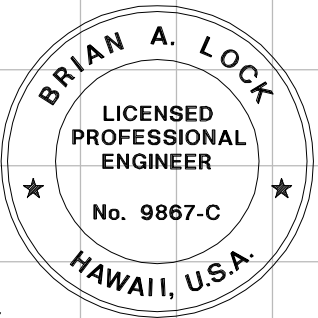

THIS WORK WAS PREPARED BY ME
OR UNDER MY SUPERVISION.

WILSON OKAMOTO CORPORATION
APRIL 30, 2020
LIC. EXP. DATE

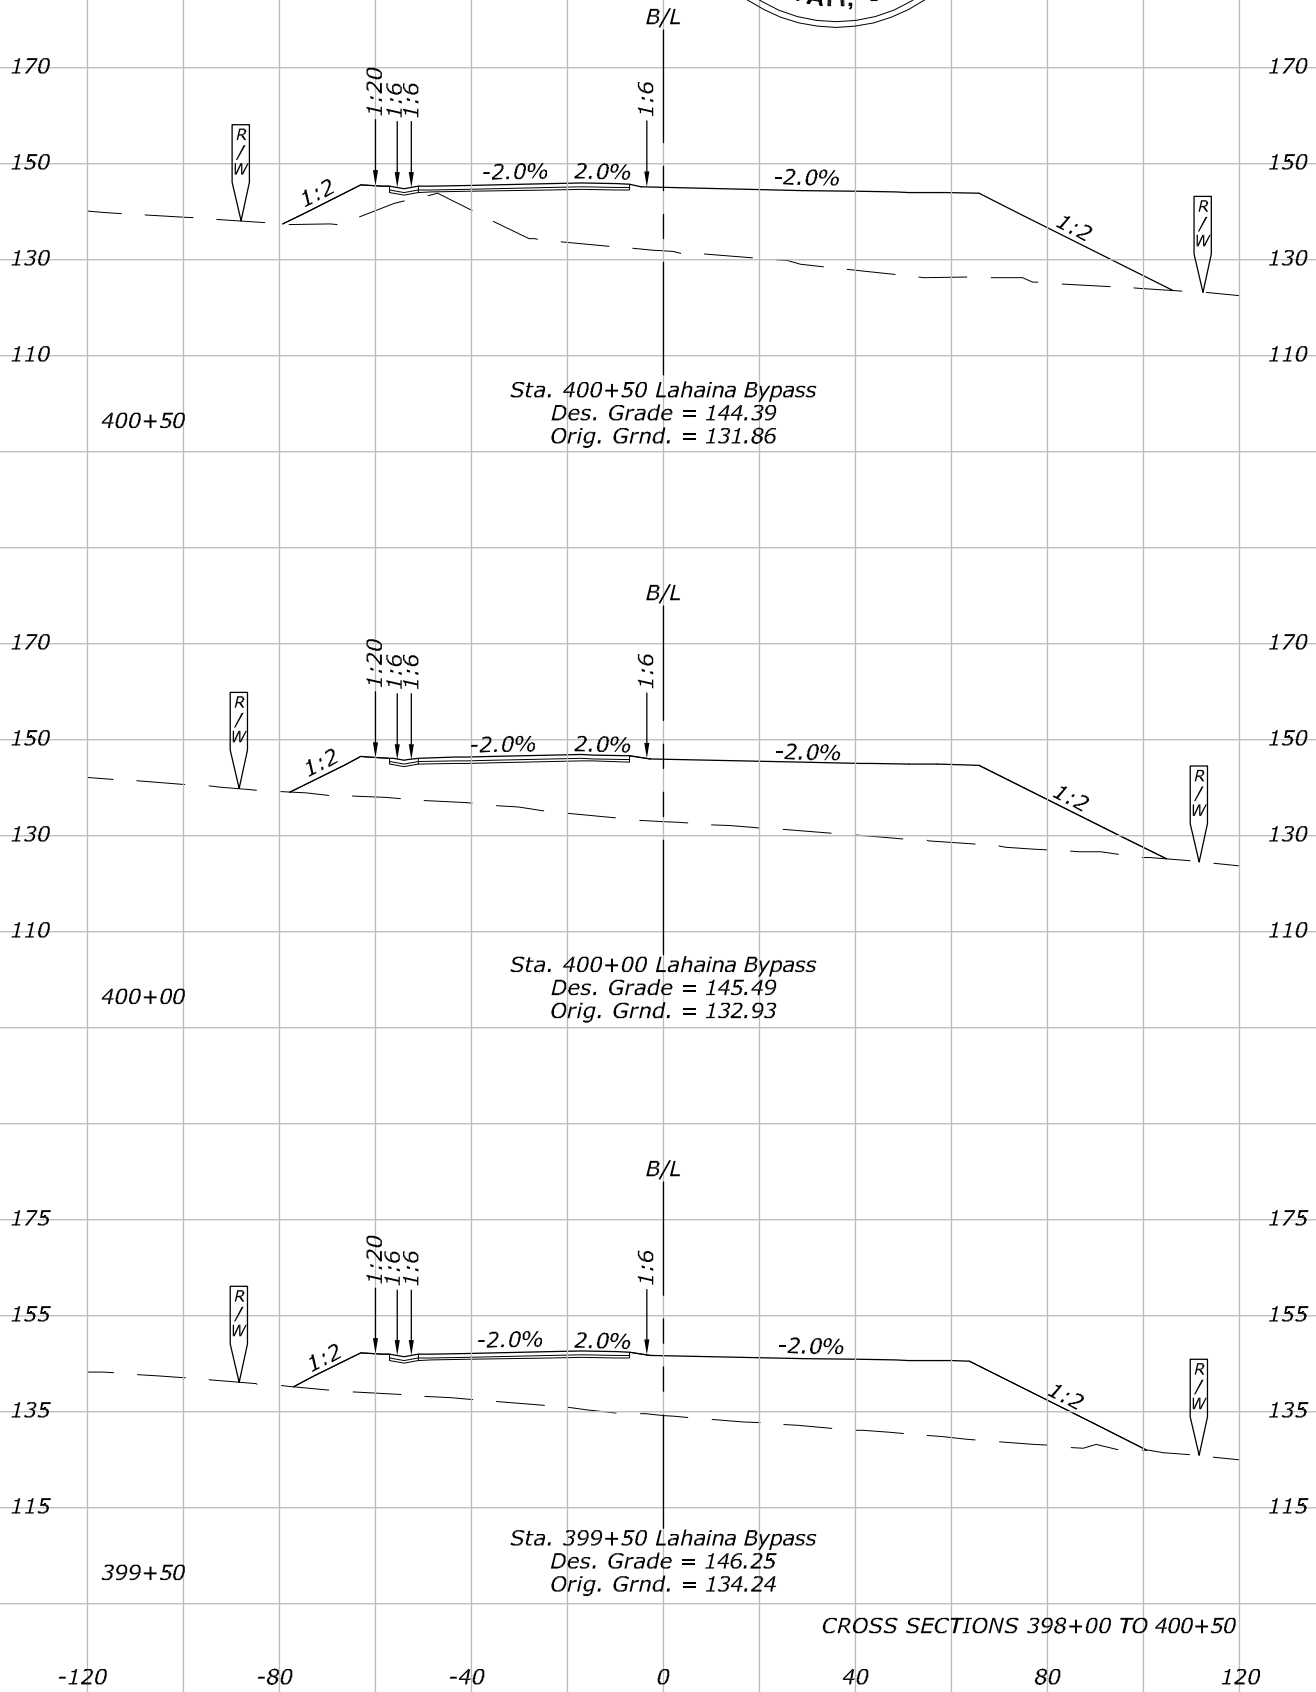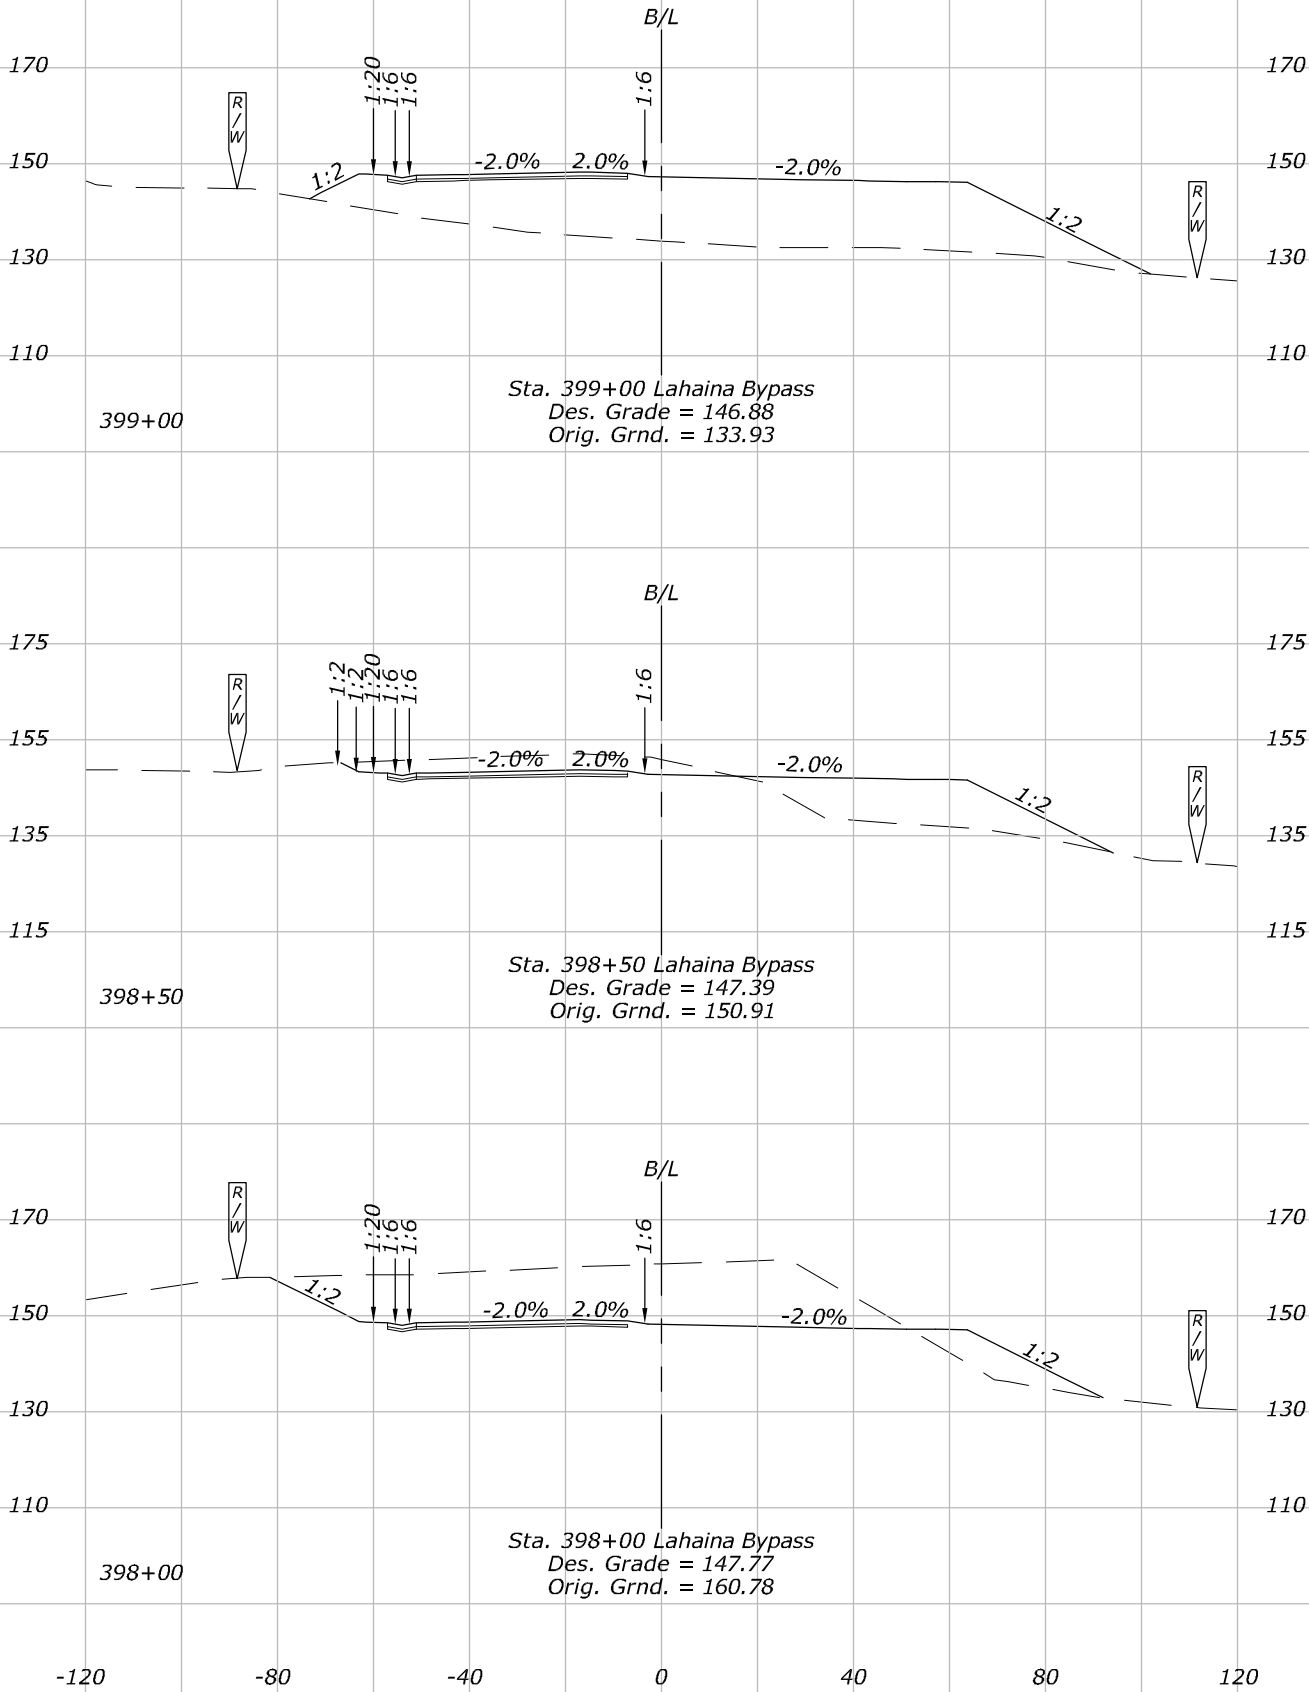

CROSS SECTIONS 398+00 TO 400+50

Patricia Choy

W:\102226-01\Civil\CADD\Site\DWGS\12 Cross Sections.dwg


14:03:33

January 11, 2019

NOTES:







1. Elevations Shown on Roadway
Sections are at 10'.

STATE	PROJECT	SHEET NO.
HI	HI STP SR 30(1)	X12

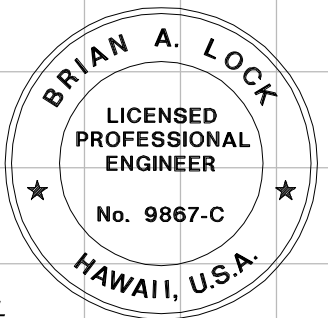

THIS WORK WAS PREPARED BY ME
OR UNDER MY SUPERVISION.

WILSON OKAMOTO CORPORATION
APRIL 30, 2020
LIC. EXP. DATE

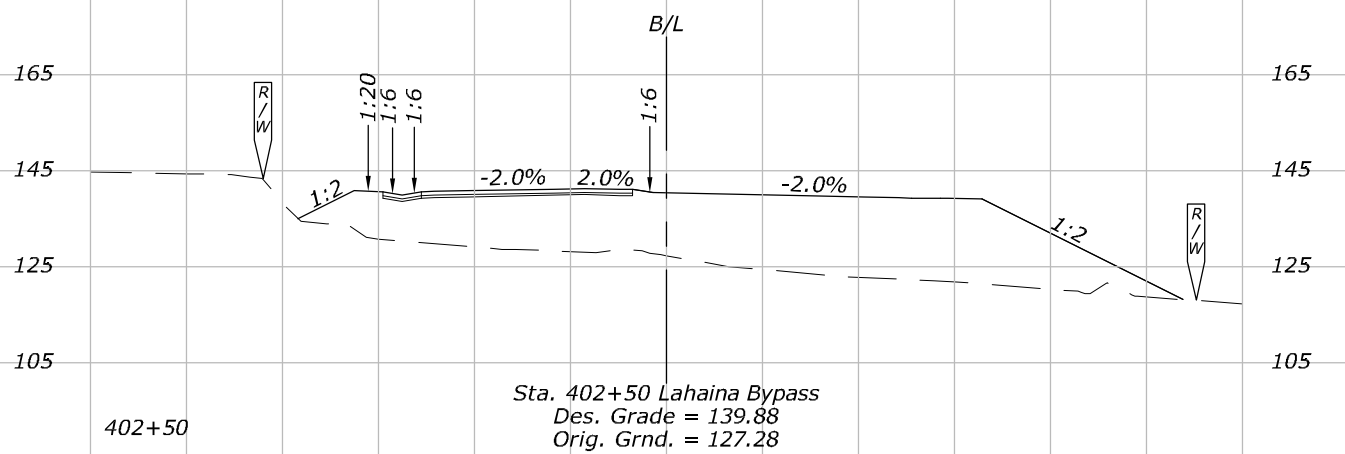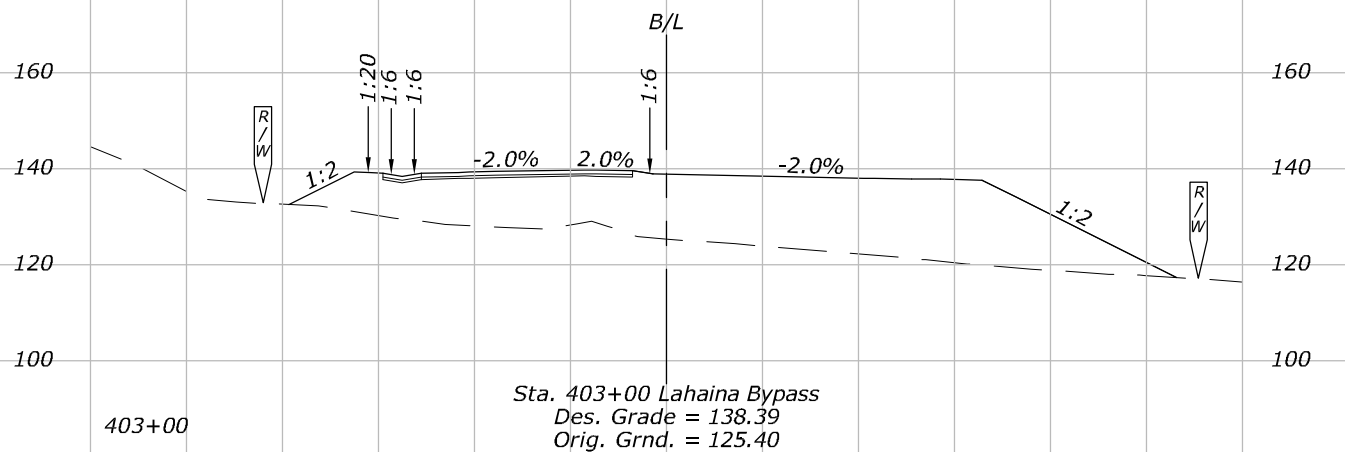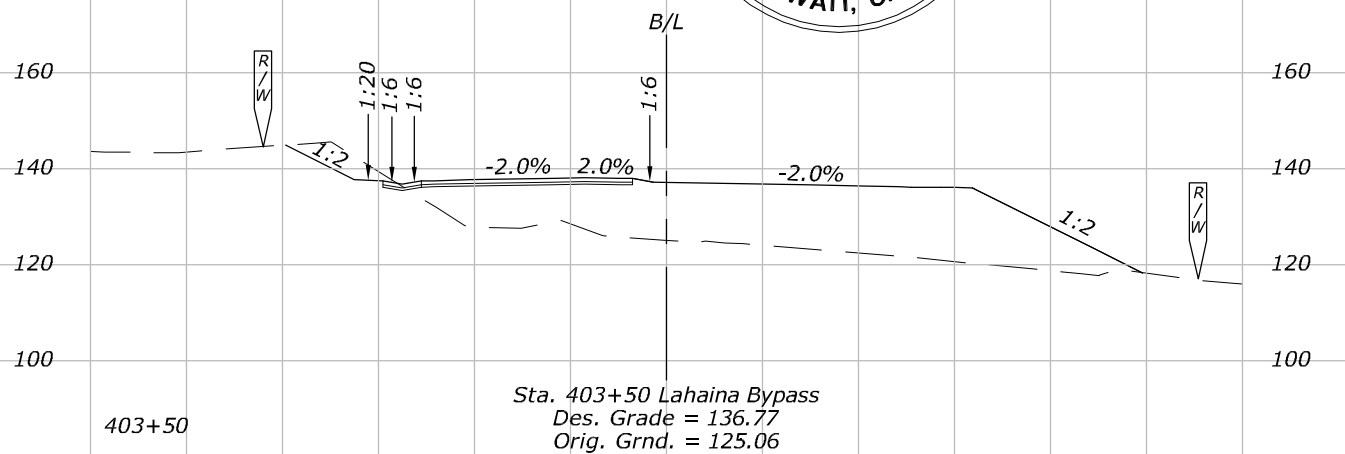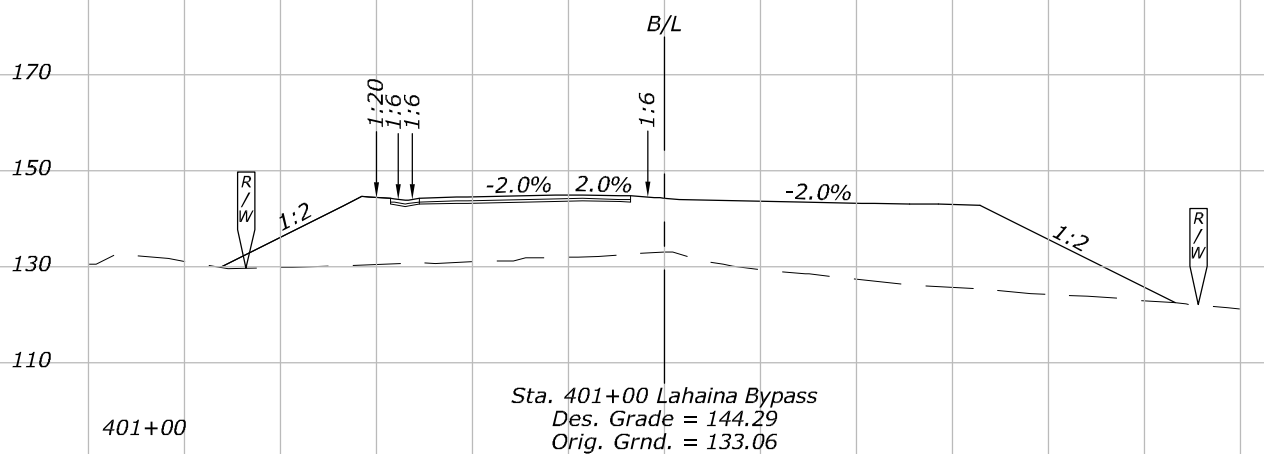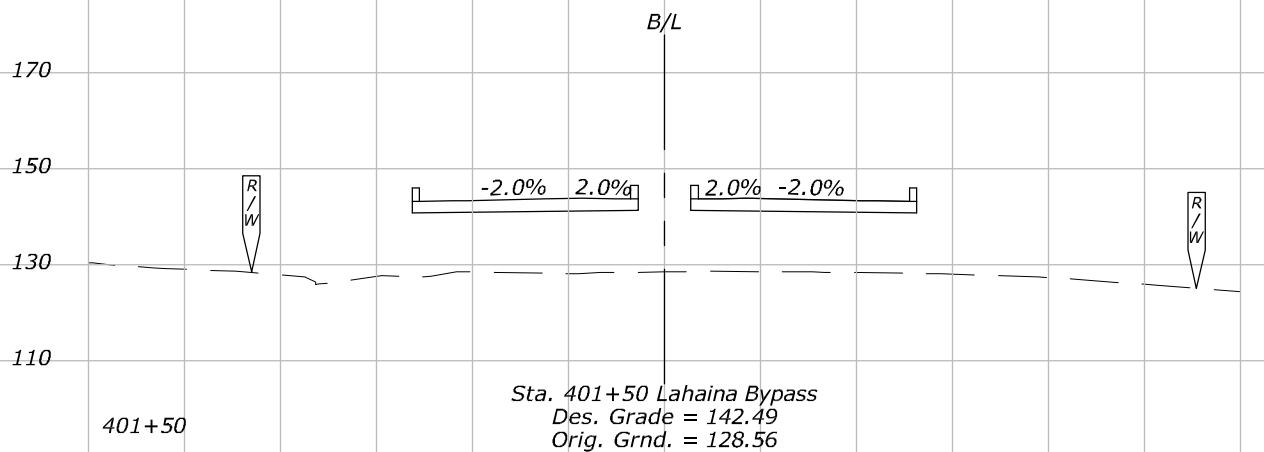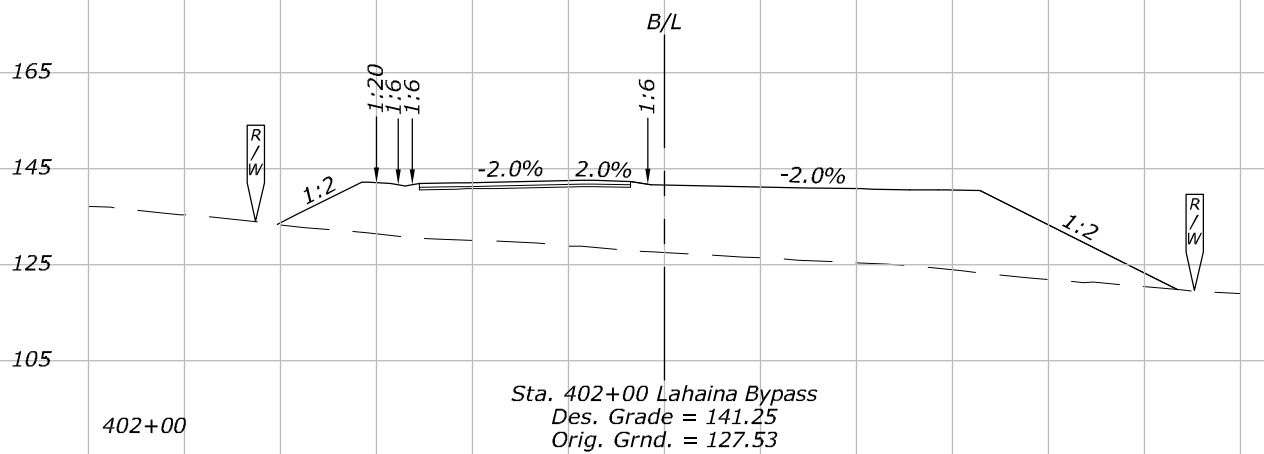

CROSS SECTIONS 401+00 TO 403+50

Patricia Choy

W:\102226-01\Civil\CADD\Site\AS-BUILTS\DWGS\DRIVE_w\102226-01\Civil\CADD\Site\DWGS\X13 Cross Sections.dwg


14:11:15

January 11, 2019

NOTES:







1. Elevations Shown on Roadway
Sections are at 5'.

STATE	PROJECT	SHEET NO.
HI	HI STP SR 30(1)	X13

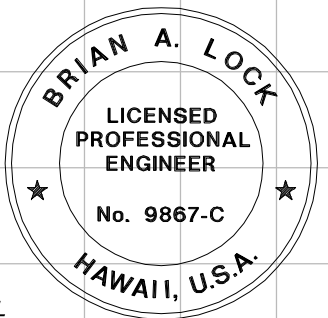

THIS WORK WAS PREPARED BY ME
OR UNDER MY SUPERVISION.

WILSON OKAMOTO CORPORATION
APRIL 30, 2020
LIC. EXP. DATE

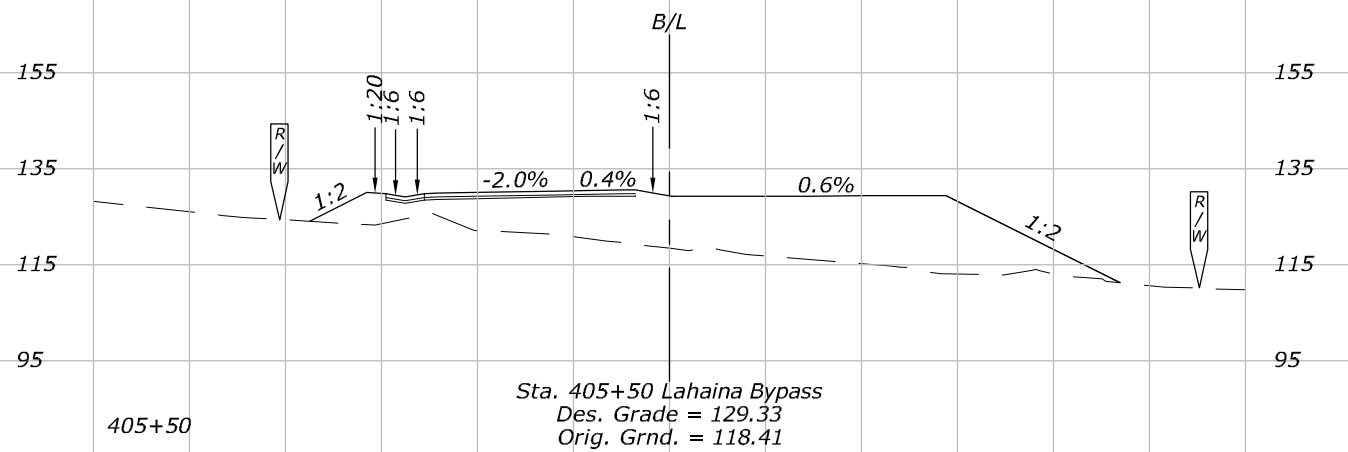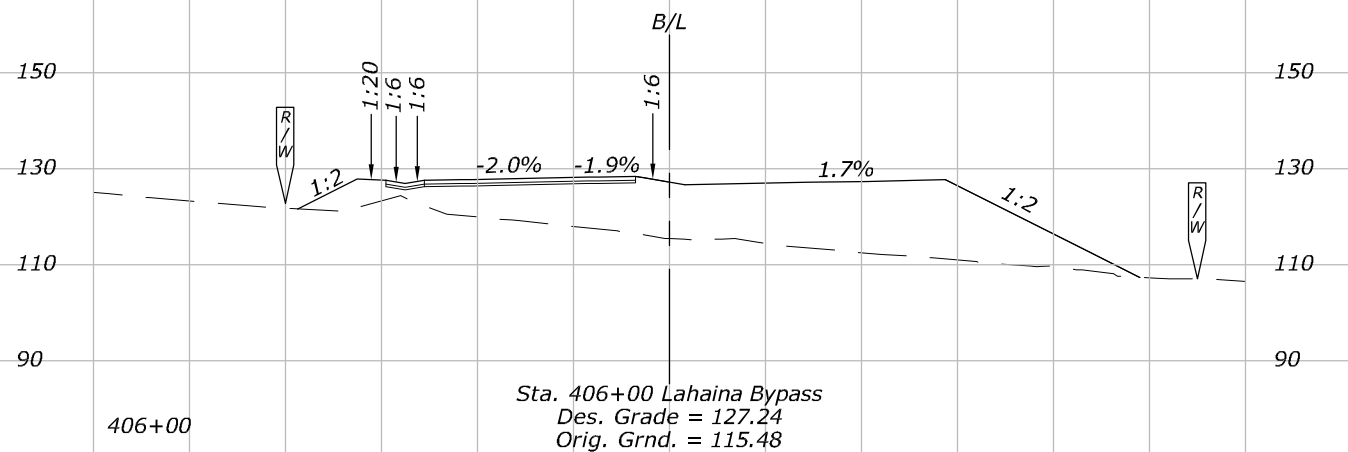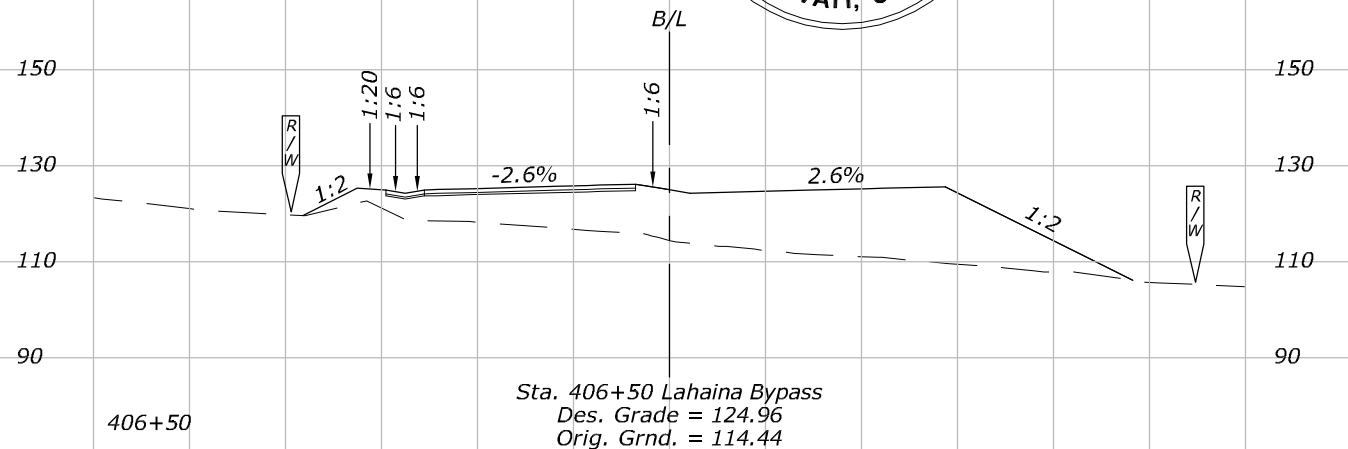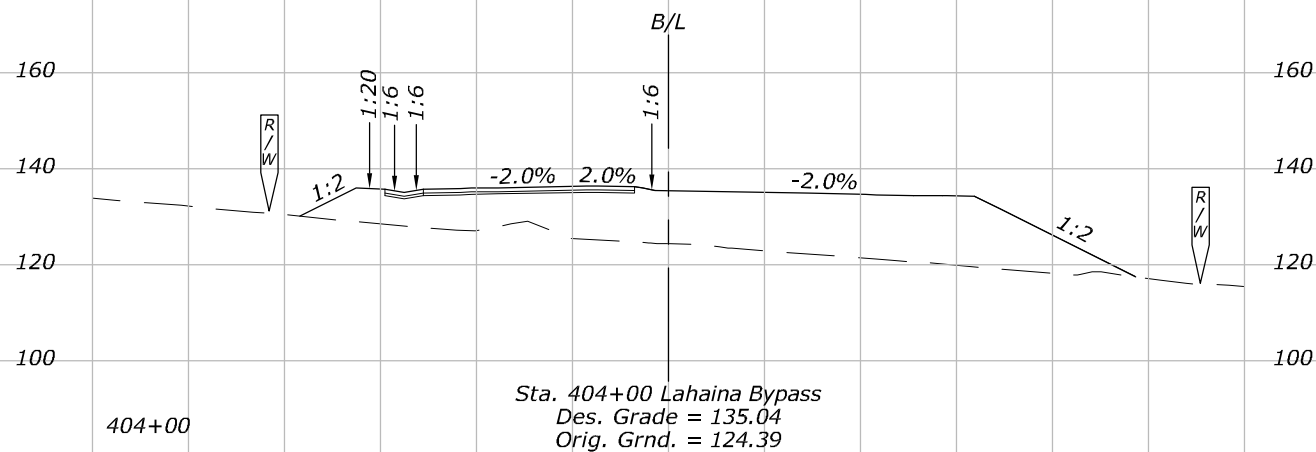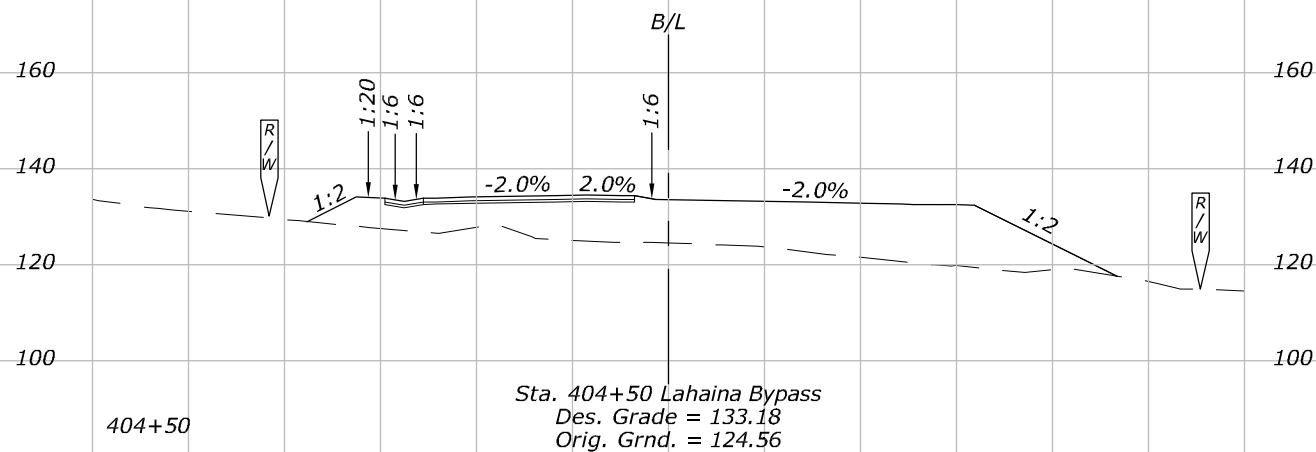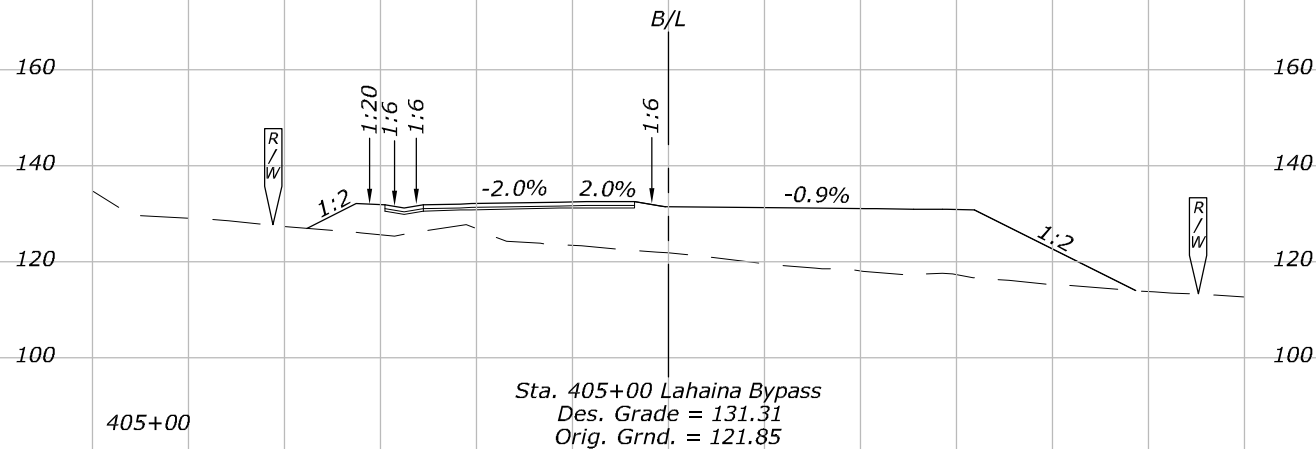

CROSS SECTIONS 404+00 TO 406+50

Patricia Choy

W:\10226-01\Civil\CADD\Site\DWGS\DRIVE - w\10226-01\Civil\CADD\Site\DWGS\X14 Cross Sections.dwg


13:47:27

January 11, 2019

NOTES:







1. Elevations Shown on Roadway
Sections are at 50'.

STATE	PROJECT	SHEET NO.
HI	HI STP SR 30(1)	X14

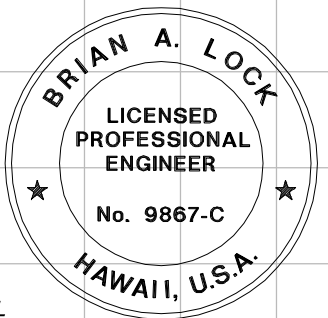

THIS WORK WAS PREPARED BY ME
OR UNDER MY SUPERVISION.

WILSON OKAMOTO CORPORATION
APRIL 30, 2020
LIC. EXP. DATE

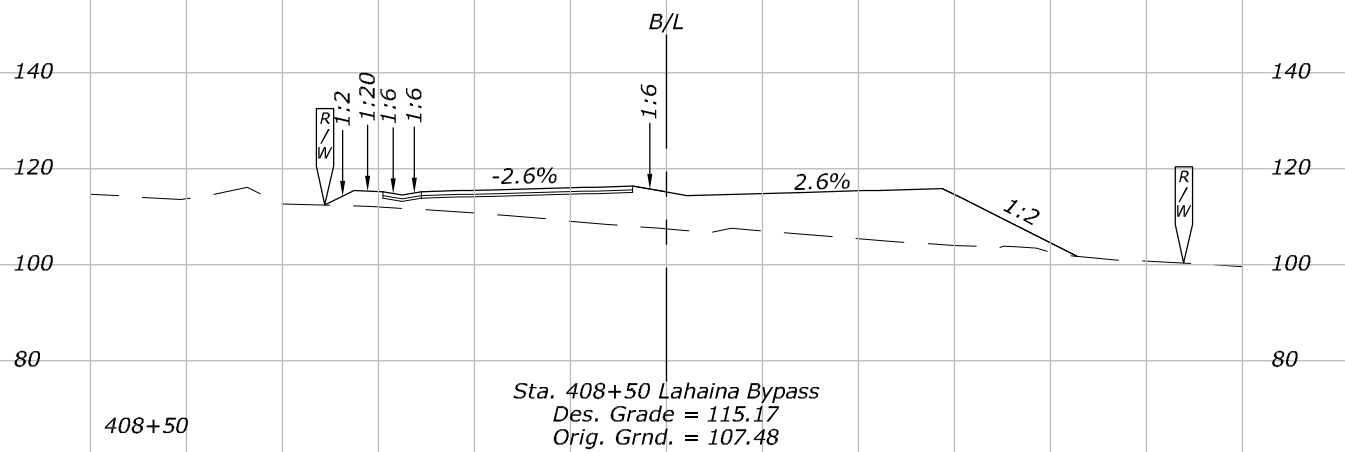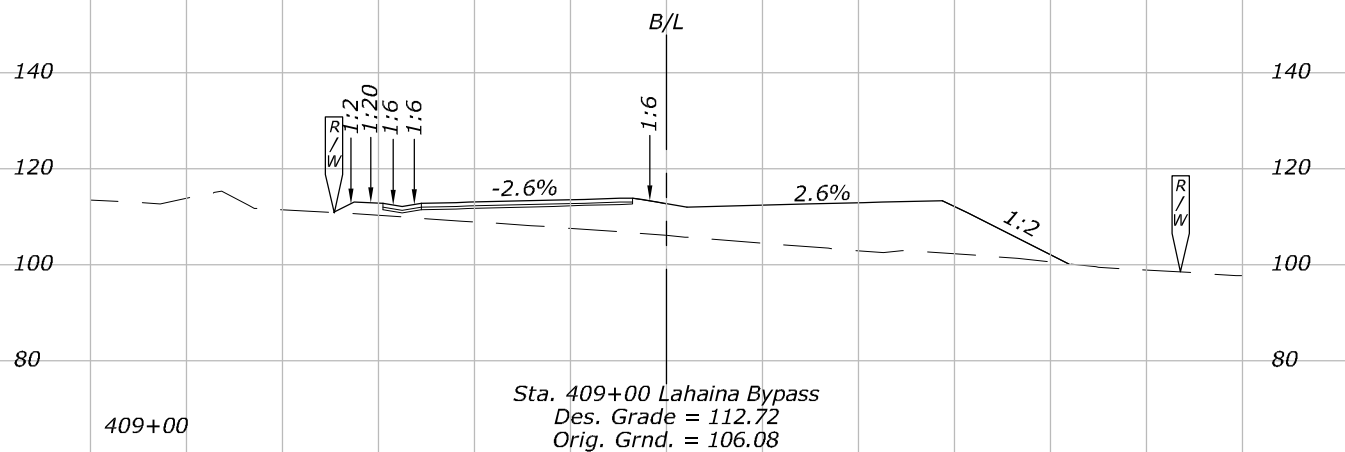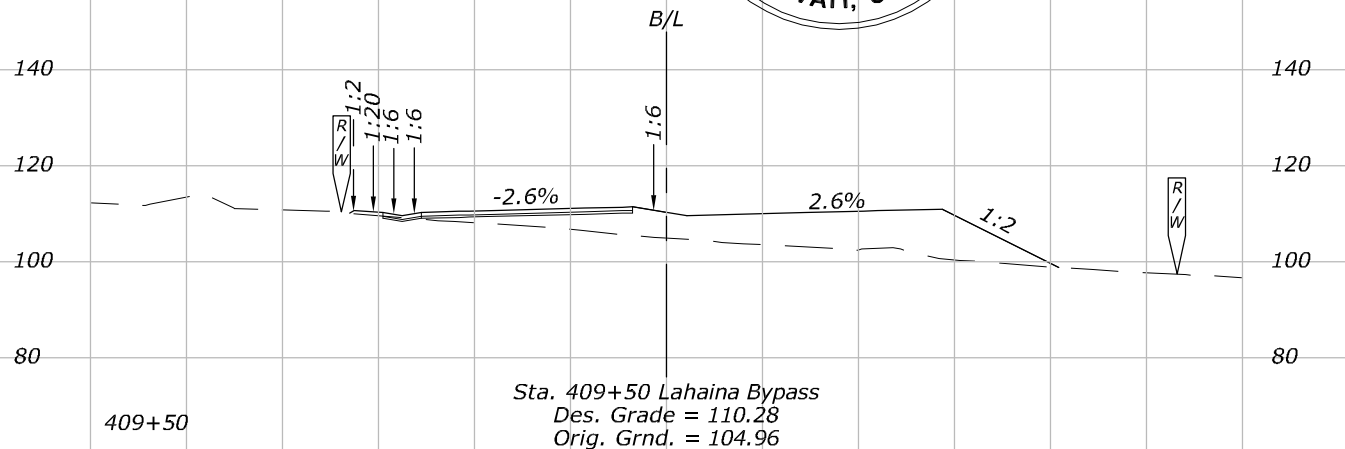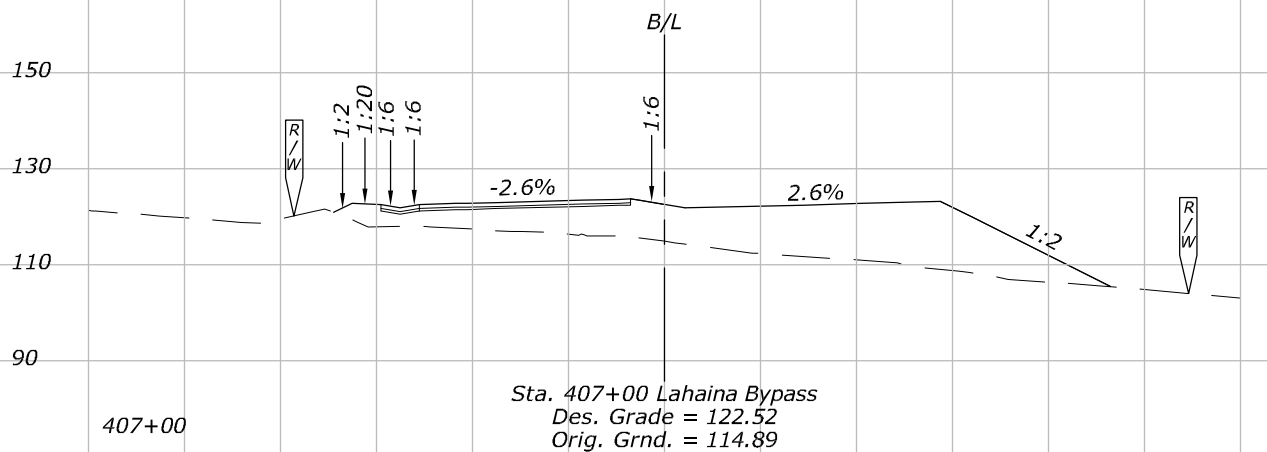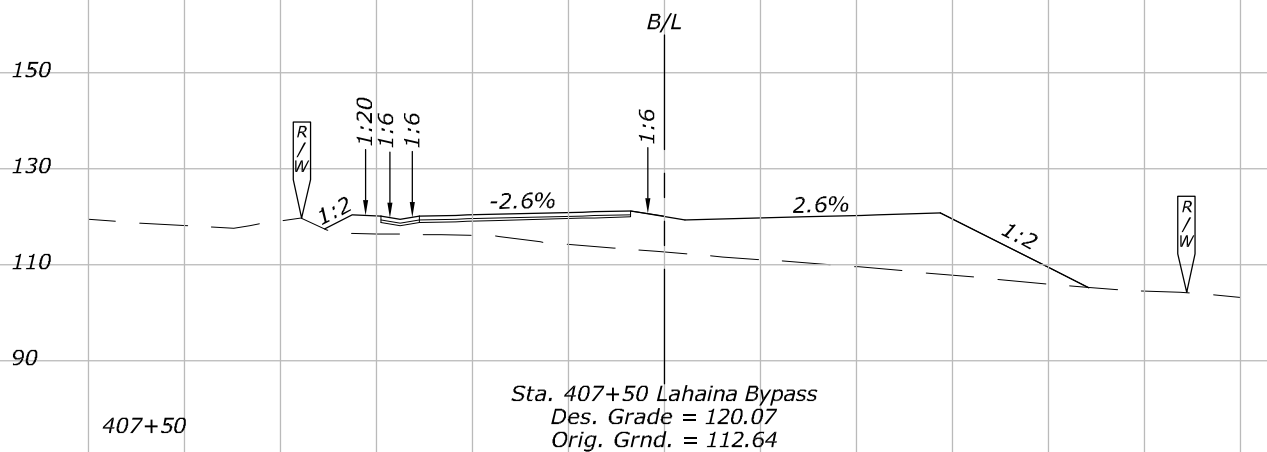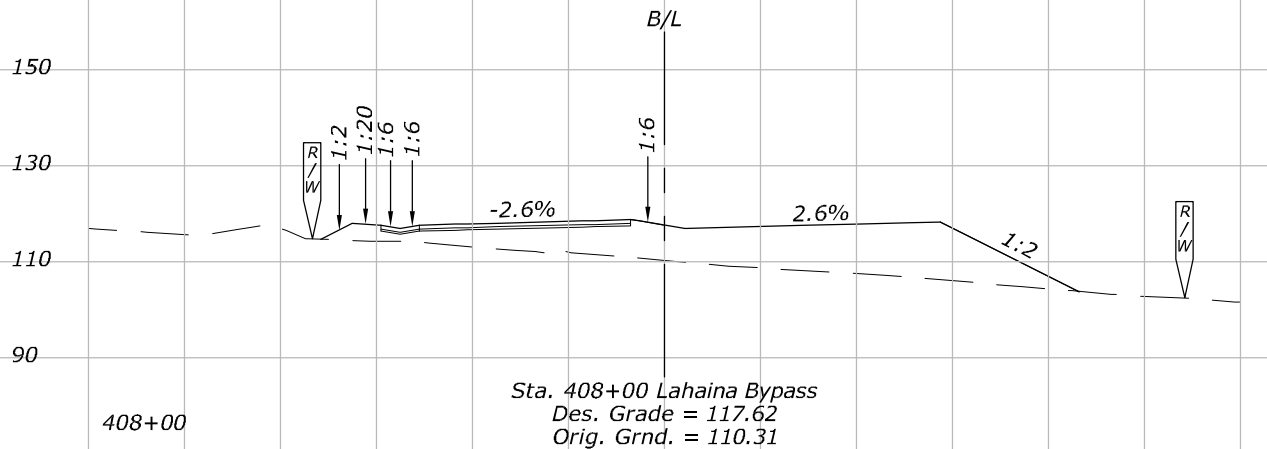

CROSS SECTIONS 407+00 TO 409+50

Patricia Choy

W:\10226-01\Civil\CADD\Site\AS-BUILT\DWGS\DRIVE_w\10226-01\Civil\CADD\Site\DWGS\X15 Cross Sections.dwg


13:49:27

January 11, 2019

NOTES:







1. Elevations Shown on Roadway
Sections are at 10'.

STATE	PROJECT	SHEET NO.
HI	HI STP SR 30(1)	X15

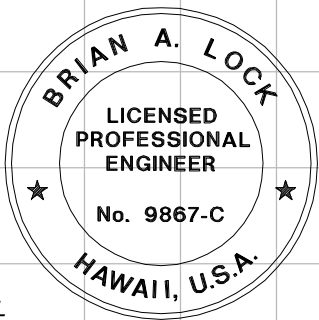

THIS WORK WAS PREPARED BY ME
OR UNDER MY SUPERVISION.

WILSON OKAMOTO CORPORATION
APRIL 30, 2020
LIC. EXP. DATE

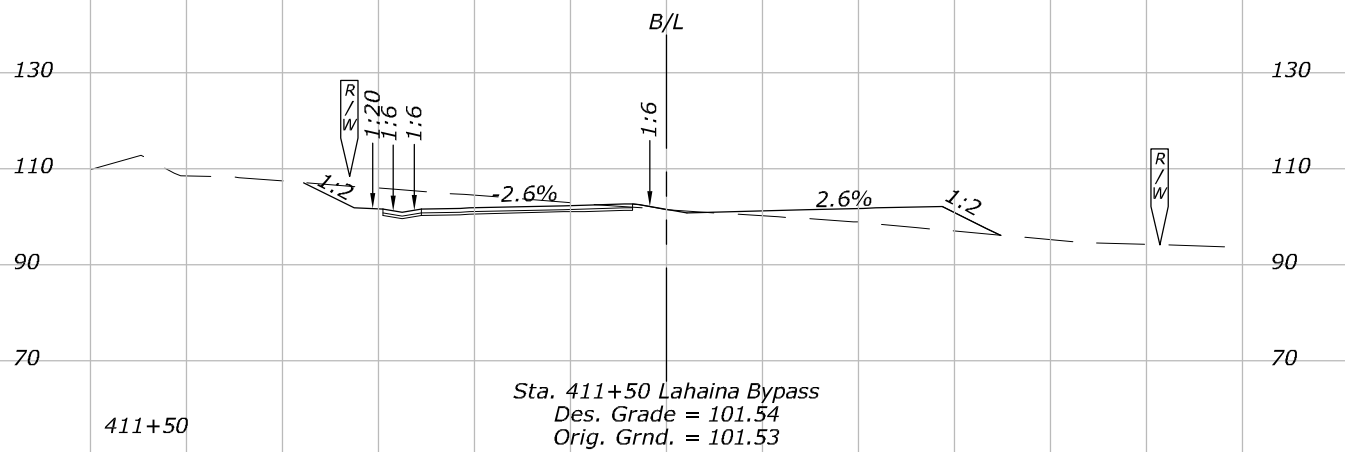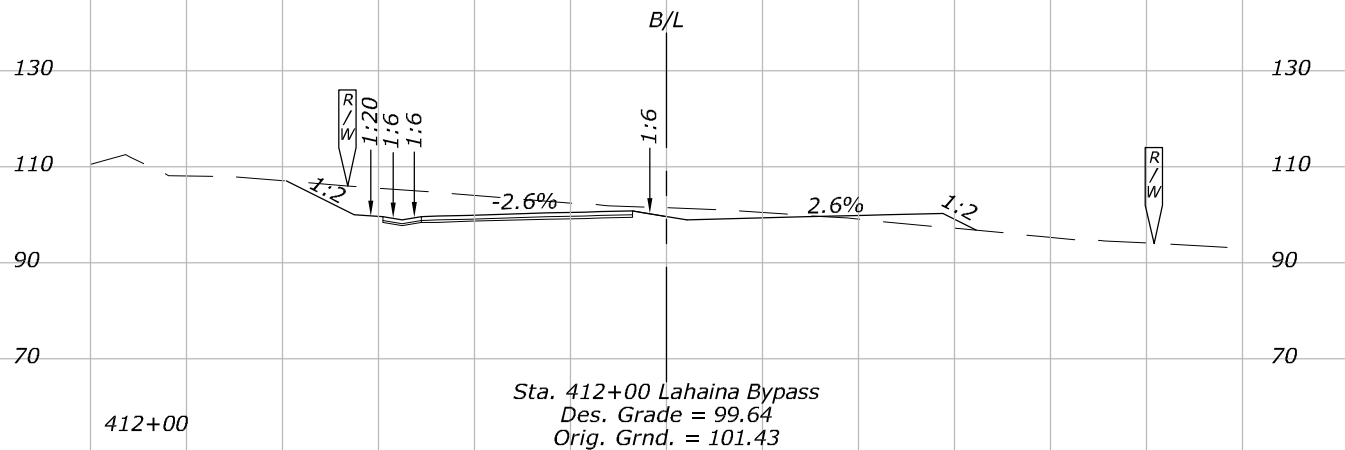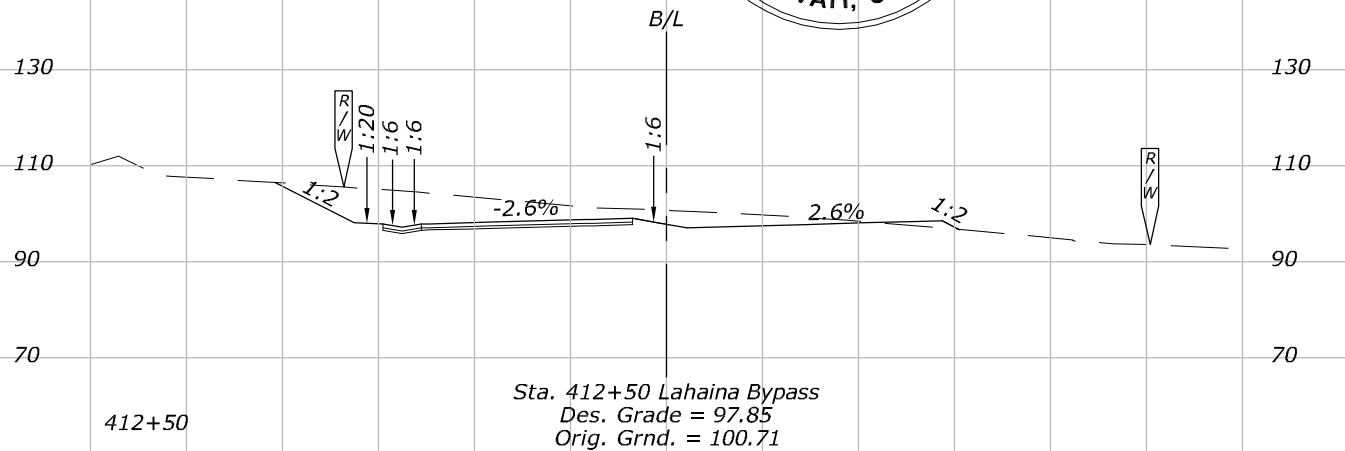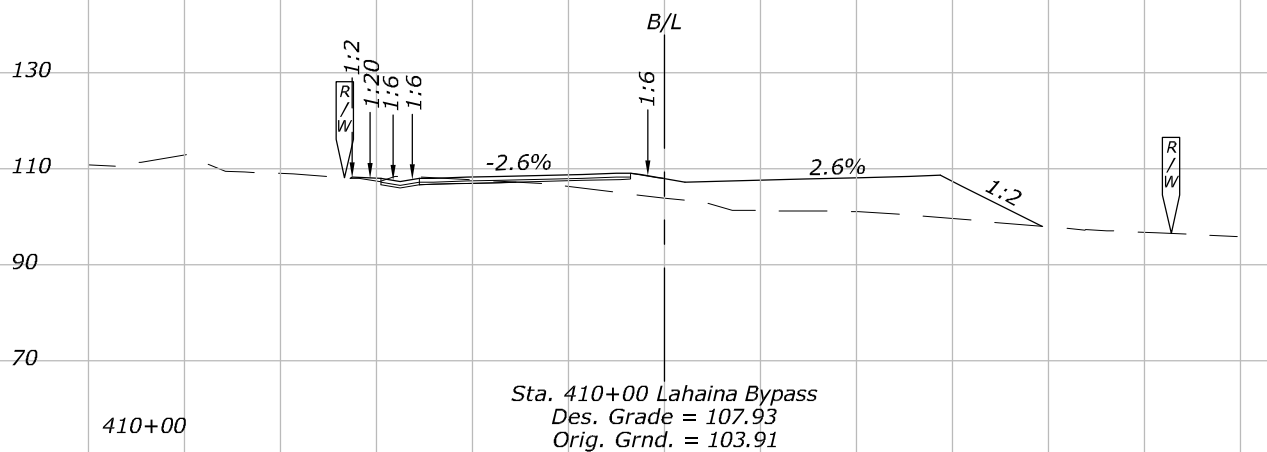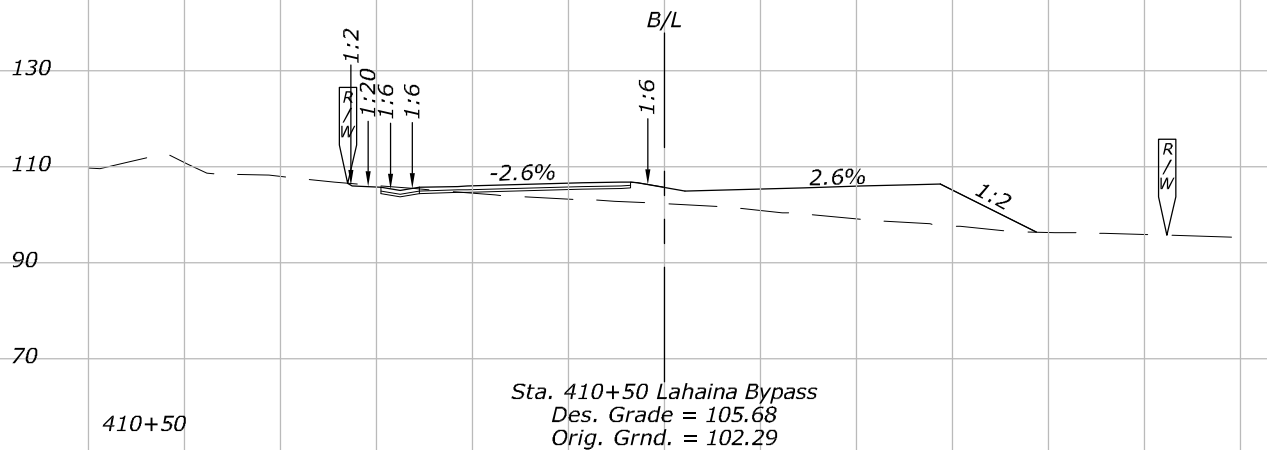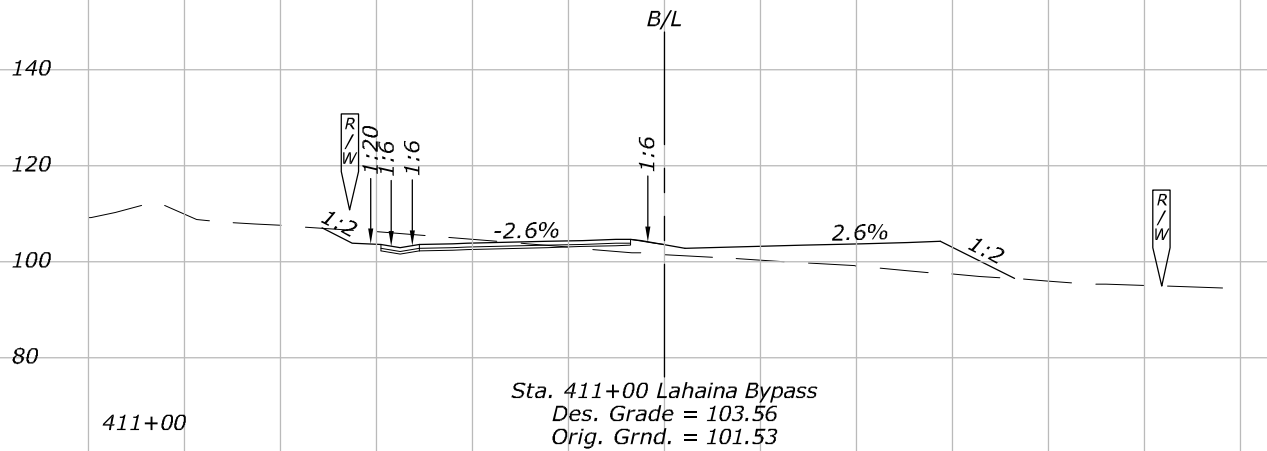

CROSS SECTIONS 410+00 TO 412+50

Patricia Choy

W:\10226-01\Civil\CADD\Site\AS-BUILT\DWGS\DRIVE_w\10226-01\Civil\CADD\Site\DWGS\X16 Cross Sections.dwg


13:50:18

January 11, 2019

NOTES:



- Elevations Shown on Roadway Sections are at $\frac{1}{8}$.

STATE	PROJECT	SHEET NO.
HI	HI STP SR 30(1)	X16

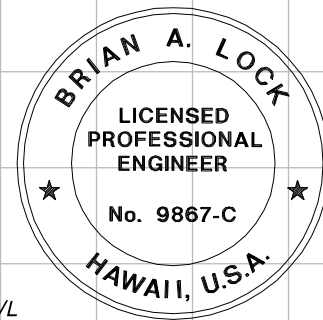

THIS WORK WAS PREPARED BY ME
OR UNDER MY SUPERVISION.

WILSON OKAMOTO CORPORATION
APRIL 30, 2020
LIC. EXP. DATE


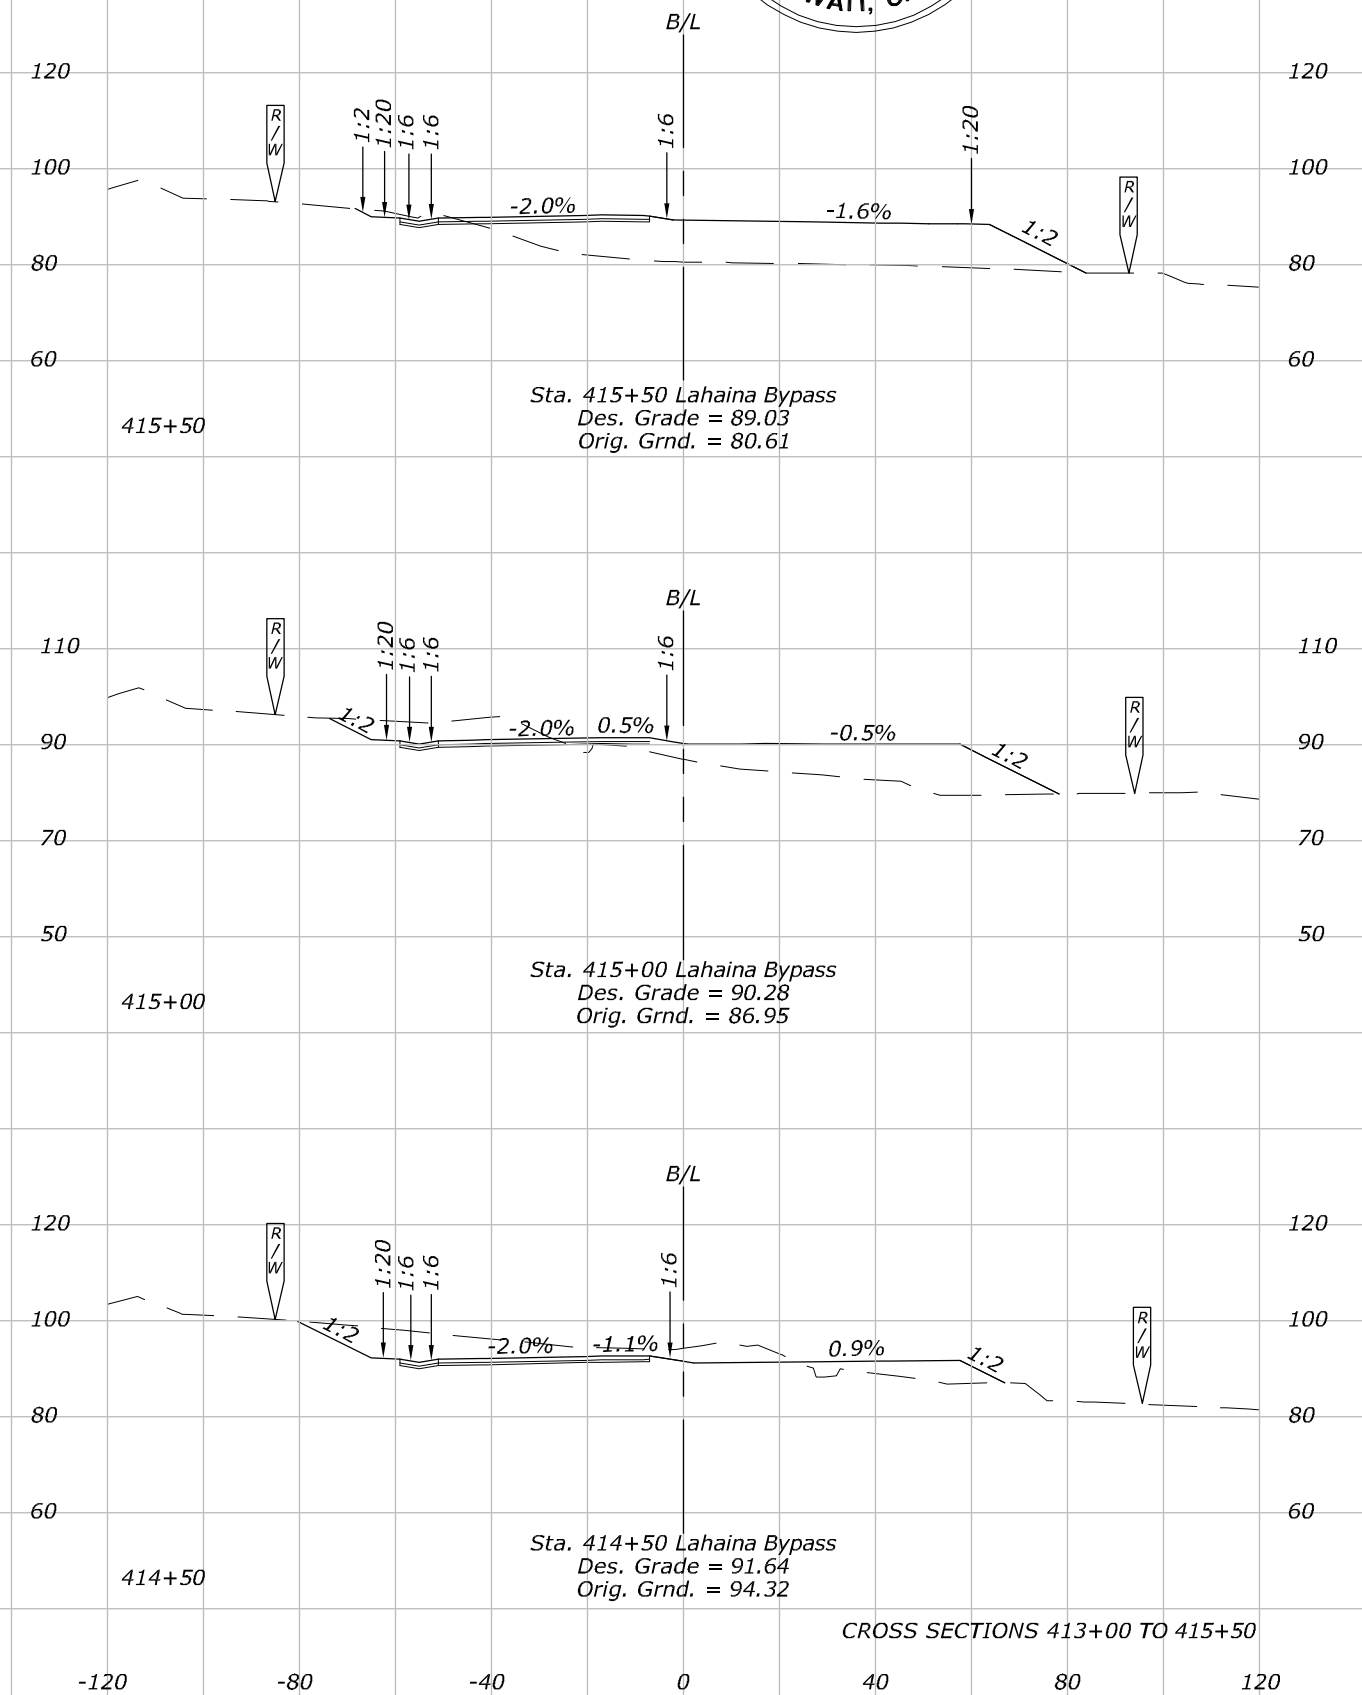
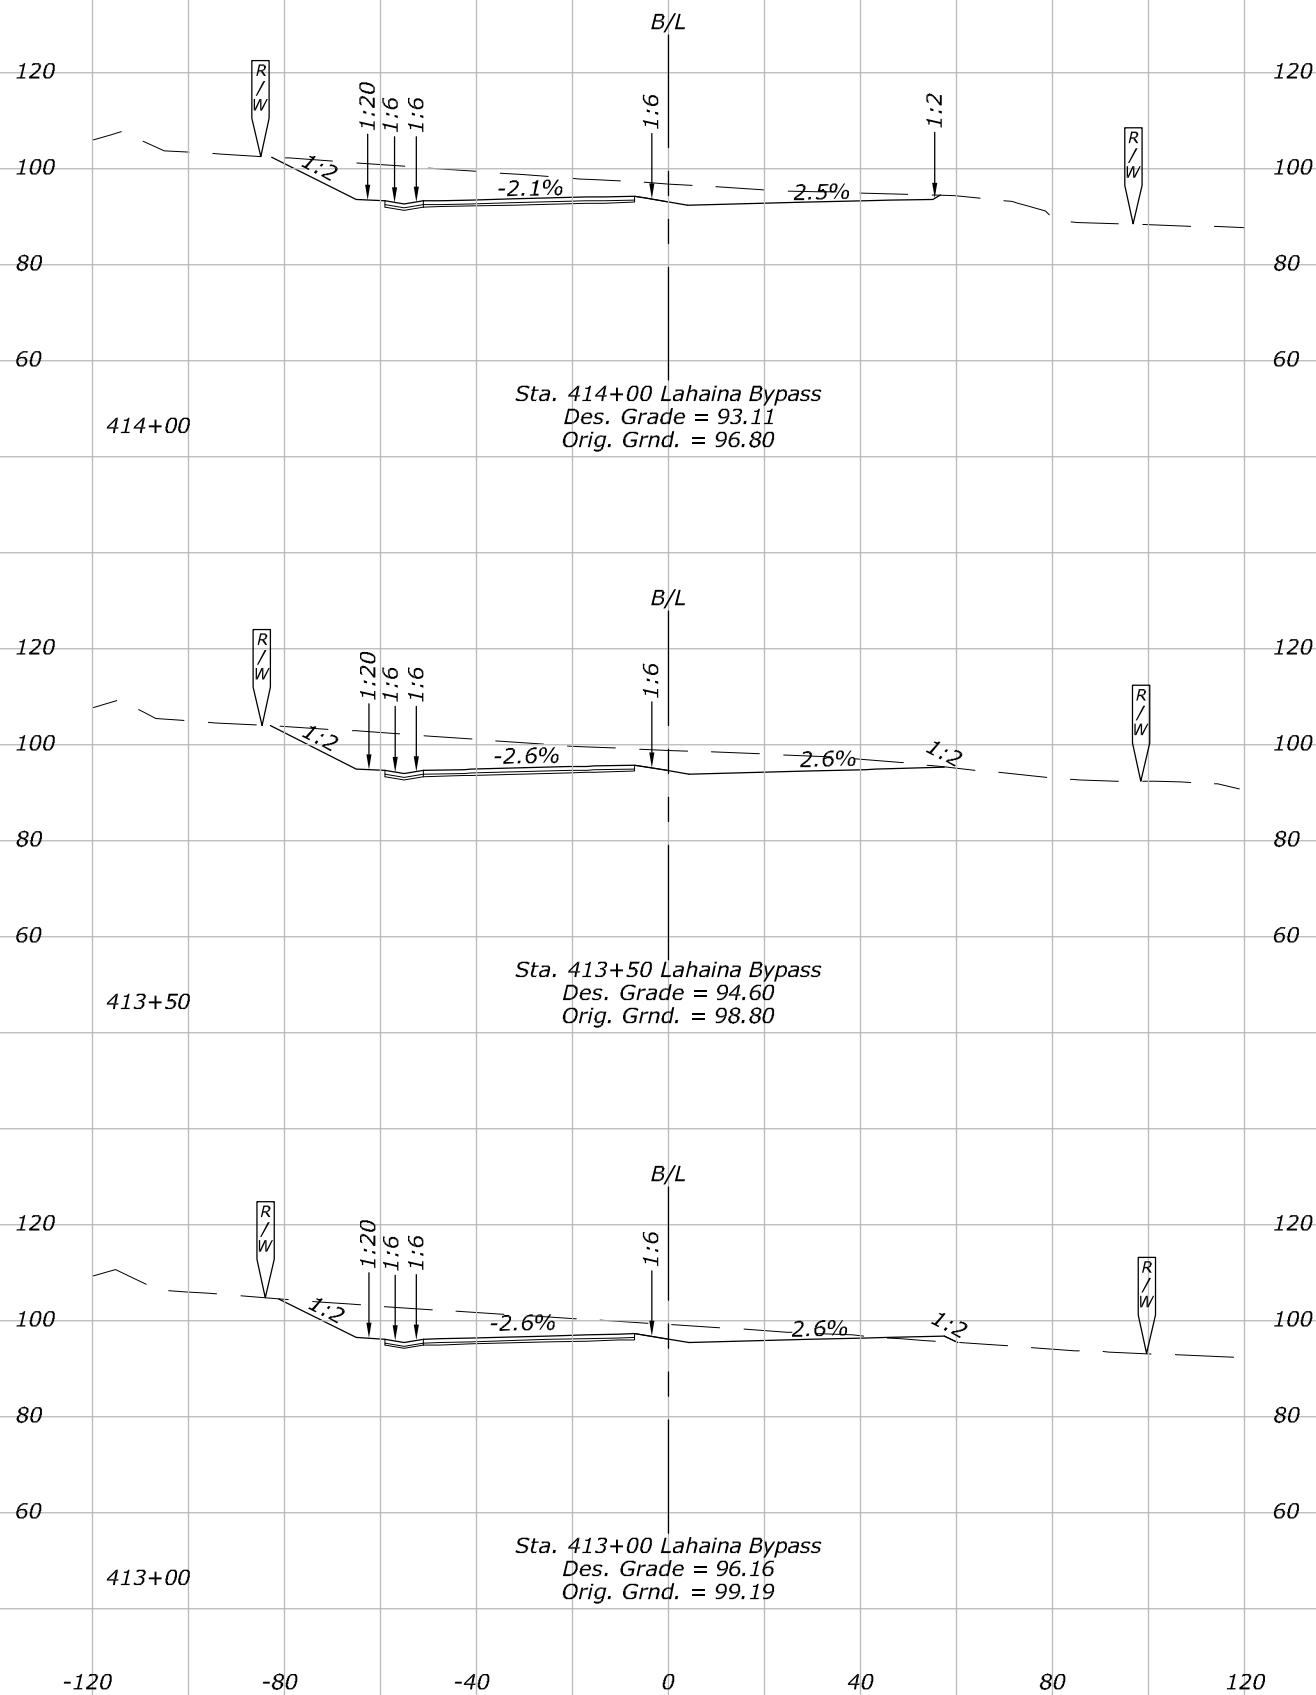


CROSS SECTIONS 413+00 TO 415+50

1. Elevations Shown on Roadway Sections are at B.

A circular professional engineer seal for Brian A. Lock. The outer ring contains the name "BRIAN A. LOCK" at the top and "HAWAII, U.S.A." at the bottom, separated by two stars. The center of the seal contains the text "LICENSED PROFESSIONAL ENGINEER" and "No. 9867-C".

WILSON OKAMOTO CORPORATION	LIC. EXP. DATE
----------------------------	----------------

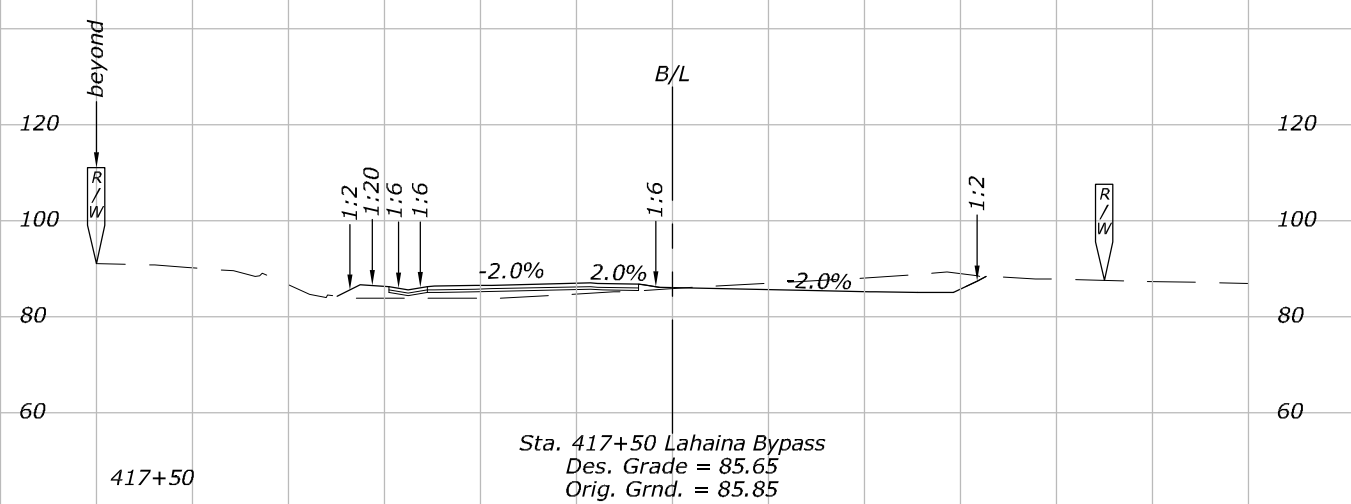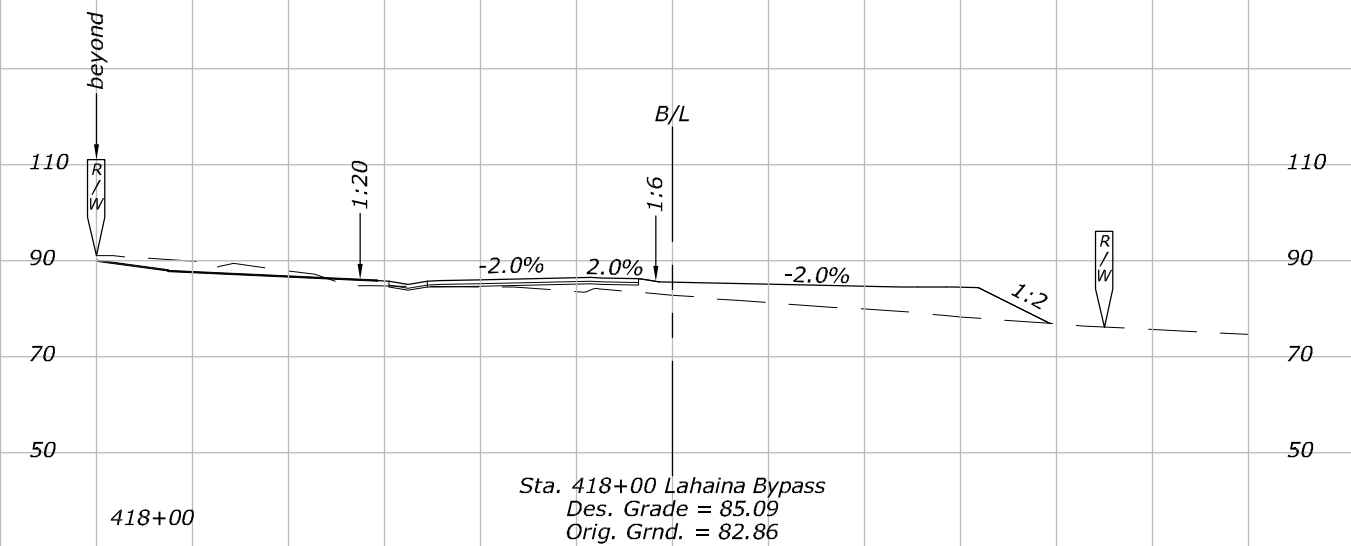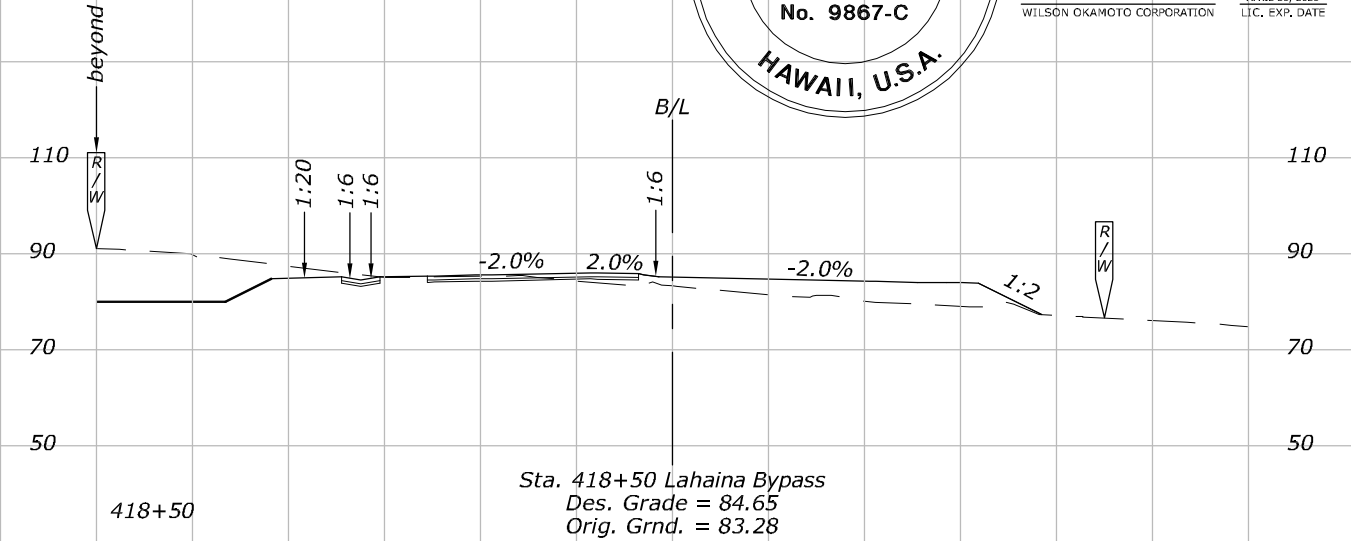

Patricia Choy

W: \\10226-01\Civil\CADD\Site\DWGS\DRIVE_w\10226-01\Civil\CADD_Site\DWGS\X17 Cross Sections.dwg

13:53:04

January 11, 2019

Patricia Choy

W:\102226-01\Civil\CADD\Site\AS-BUILT\DWGS\DRIVE_w\102226-01\Civil\CADD\Site\DWGS\X18 Cross Sections.dwg


14:14:56

January 11, 2019

NOTES:







1. Elevations Shown on Roadway
Sections are at 5'.

STATE	PROJECT	SHEET NO.
HI	HI STP SR 30(1)	X18

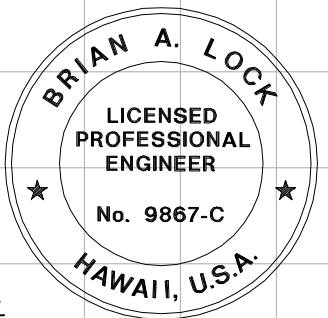

THIS WORK WAS PREPARED BY ME
OR UNDER MY SUPERVISION.

WILSON OKAMOTO CORPORATION
APRIL 30, 2020
LIC. EXP. DATE

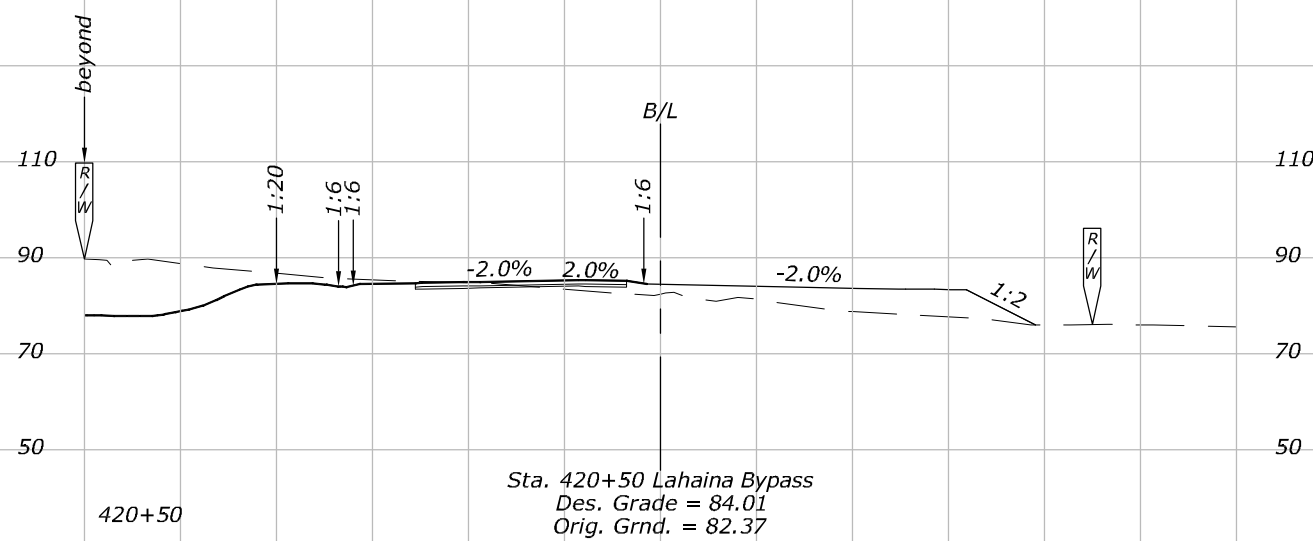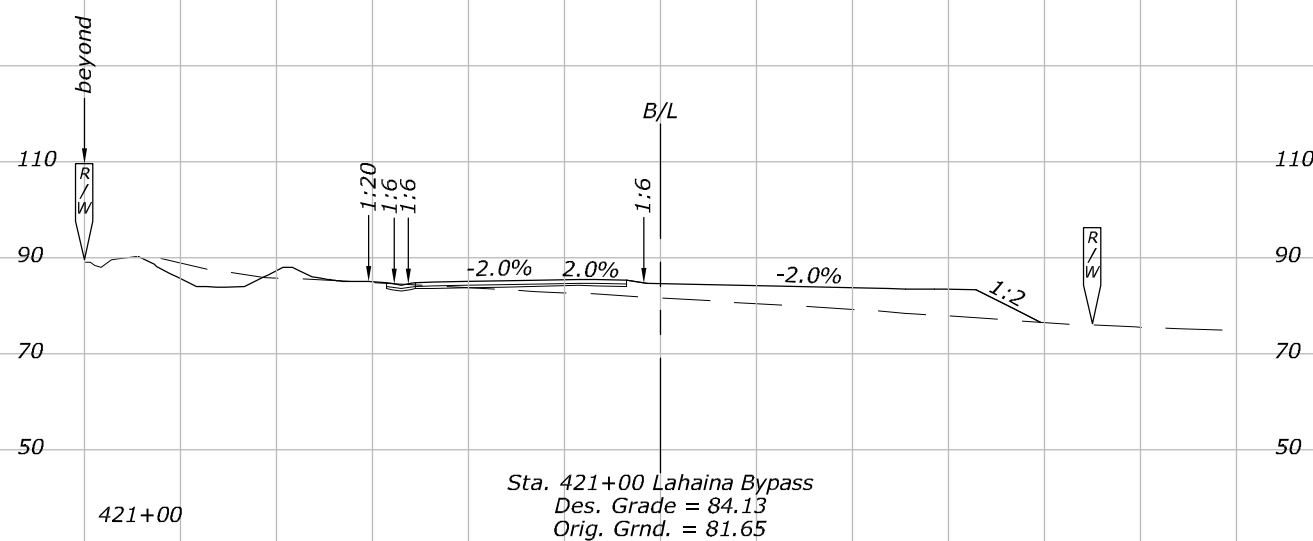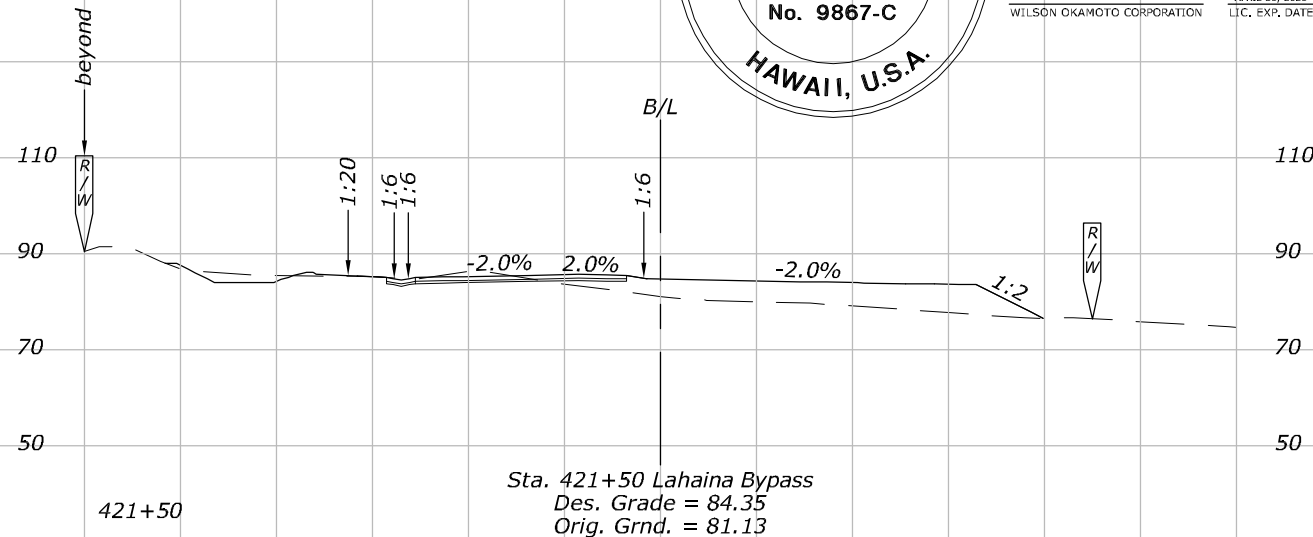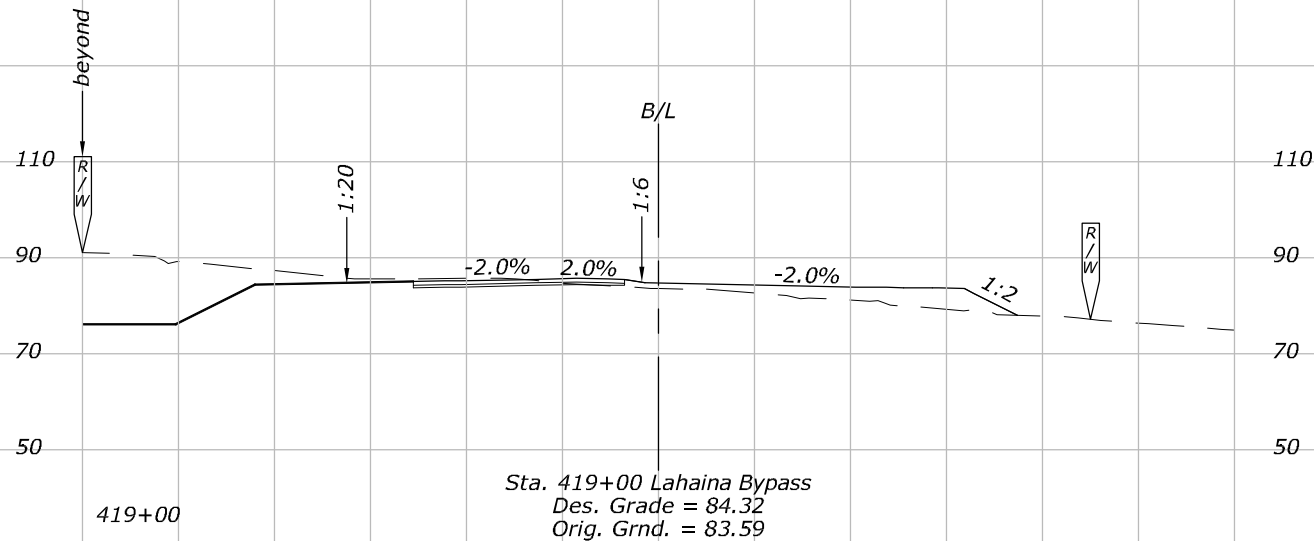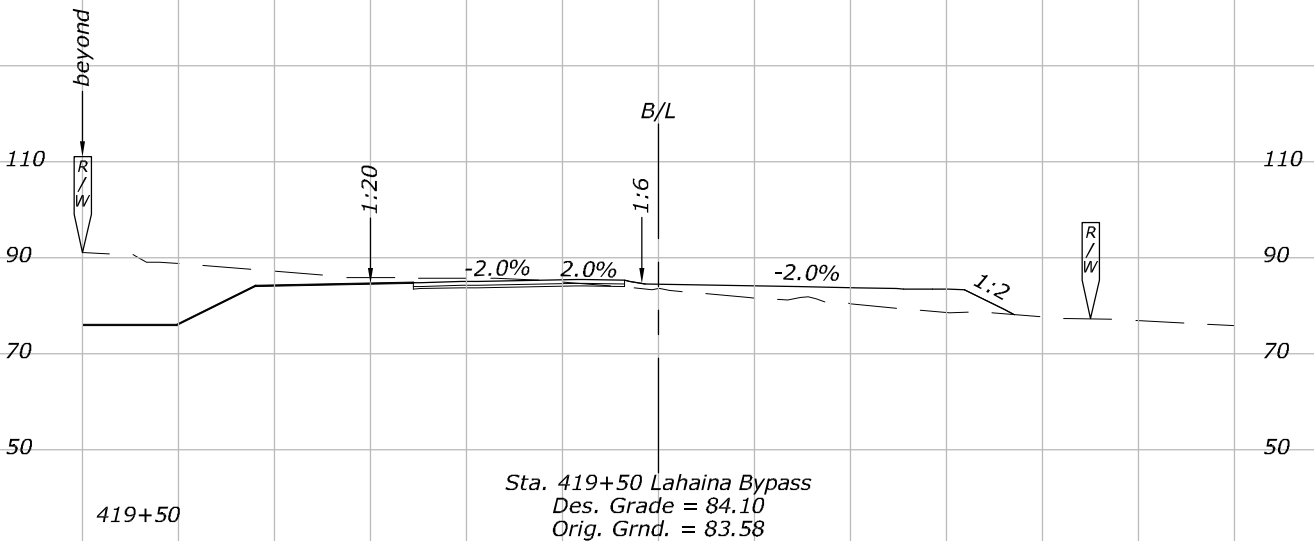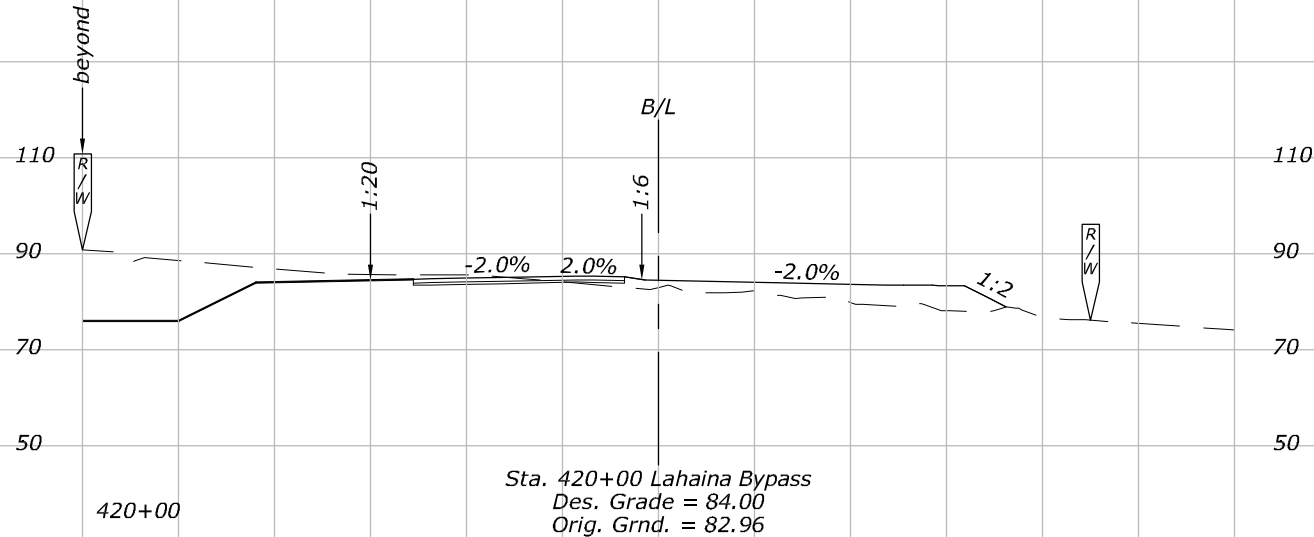

CROSS SECTIONS 419+00 TO 421+50

Patricia Choy

W:\102226-01\Civil\CADD\Site\DWGS\DRIVE_w\102226-01\Civil\CADD\Site\DWGS\X19 Cross Sections.dwg


14:17:12

January 11, 2019

NOTES:



1. Elevations Shown on Roadway
Sections are at 5'.

STATE	PROJECT	SHEET NO.
HI	HI STP SR 30(1)	X19

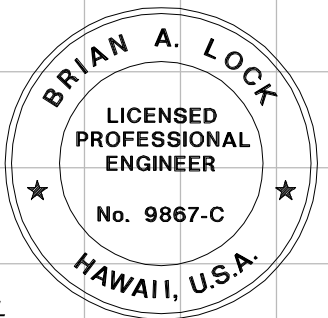

THIS WORK WAS PREPARED BY ME
OR UNDER MY SUPERVISION.

WILSON OKAMOTO CORPORATION
APRIL 30, 2020
LIC. EXP. DATE

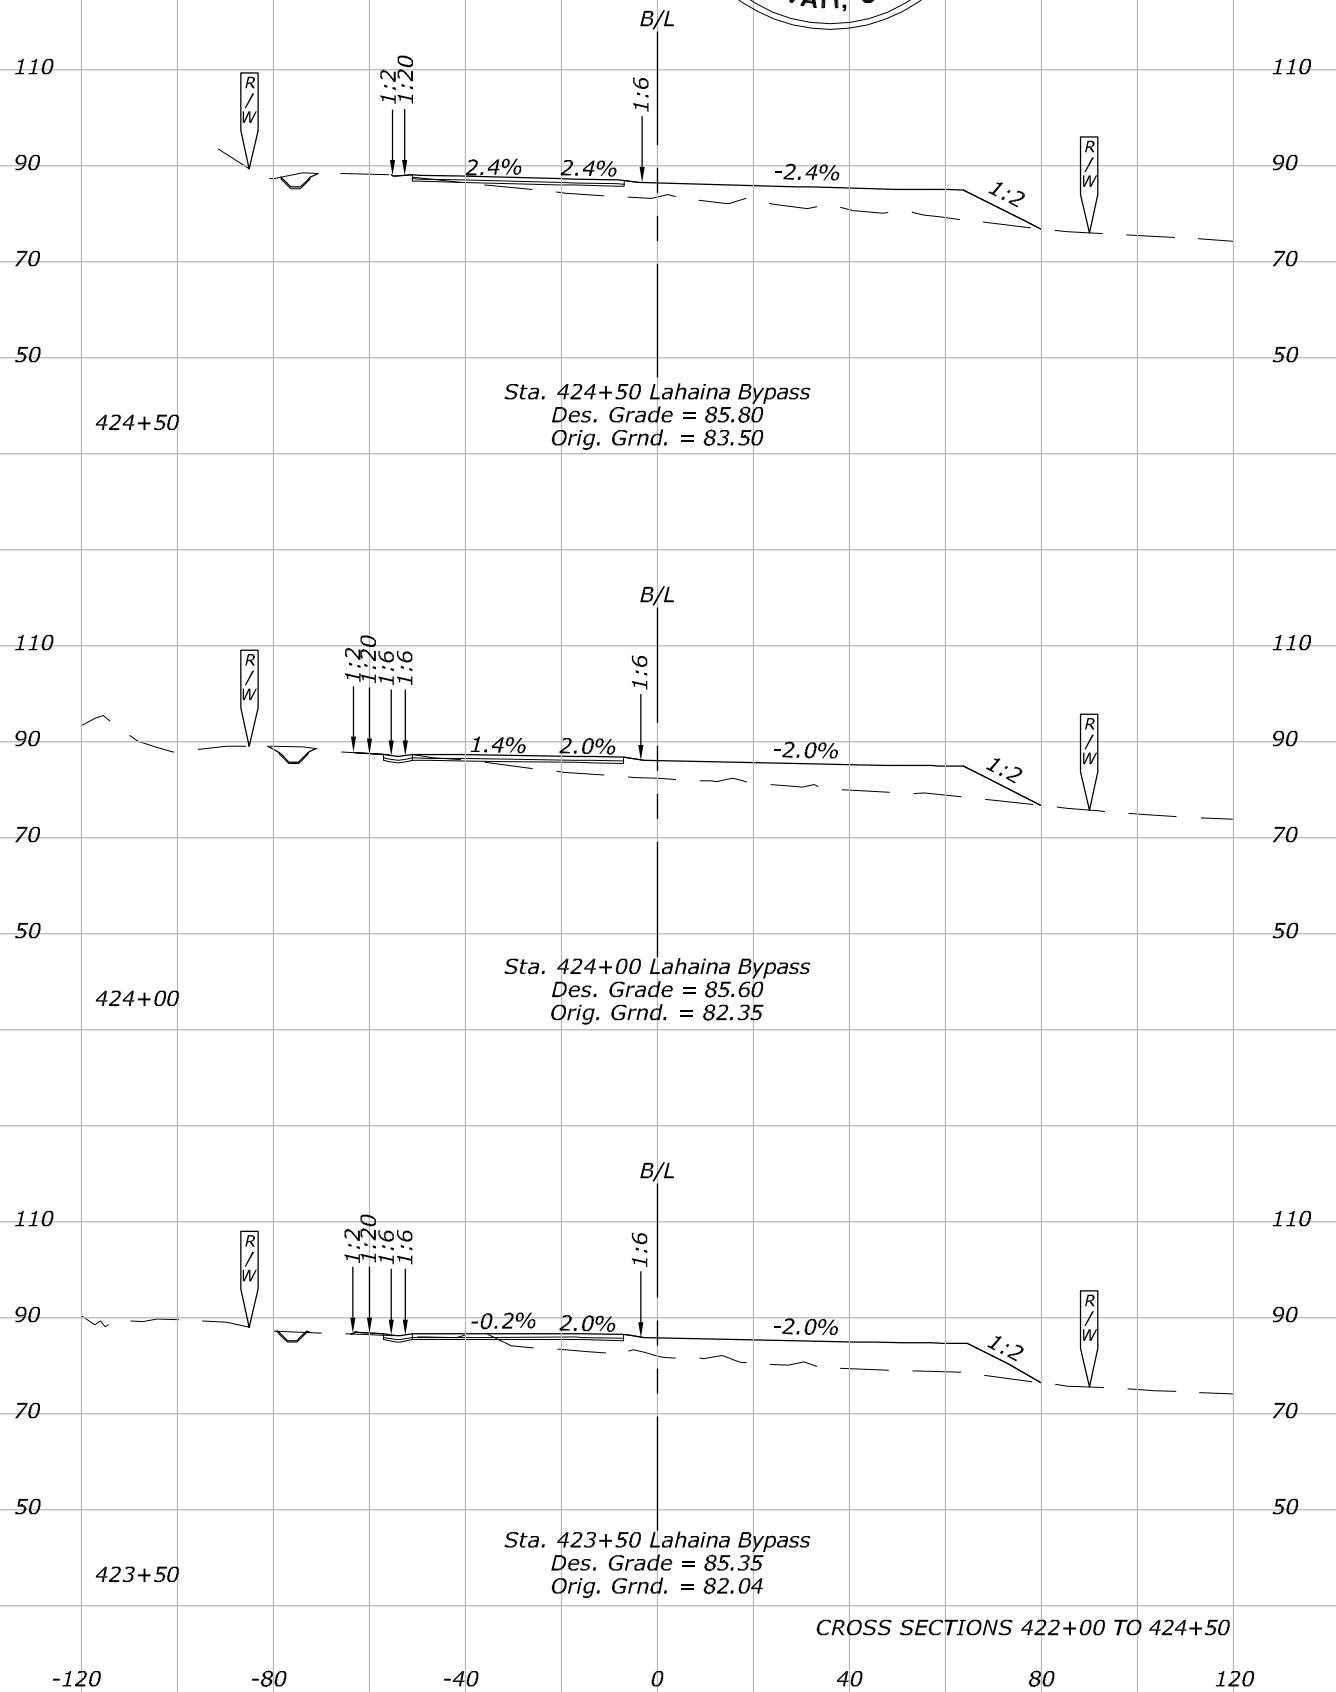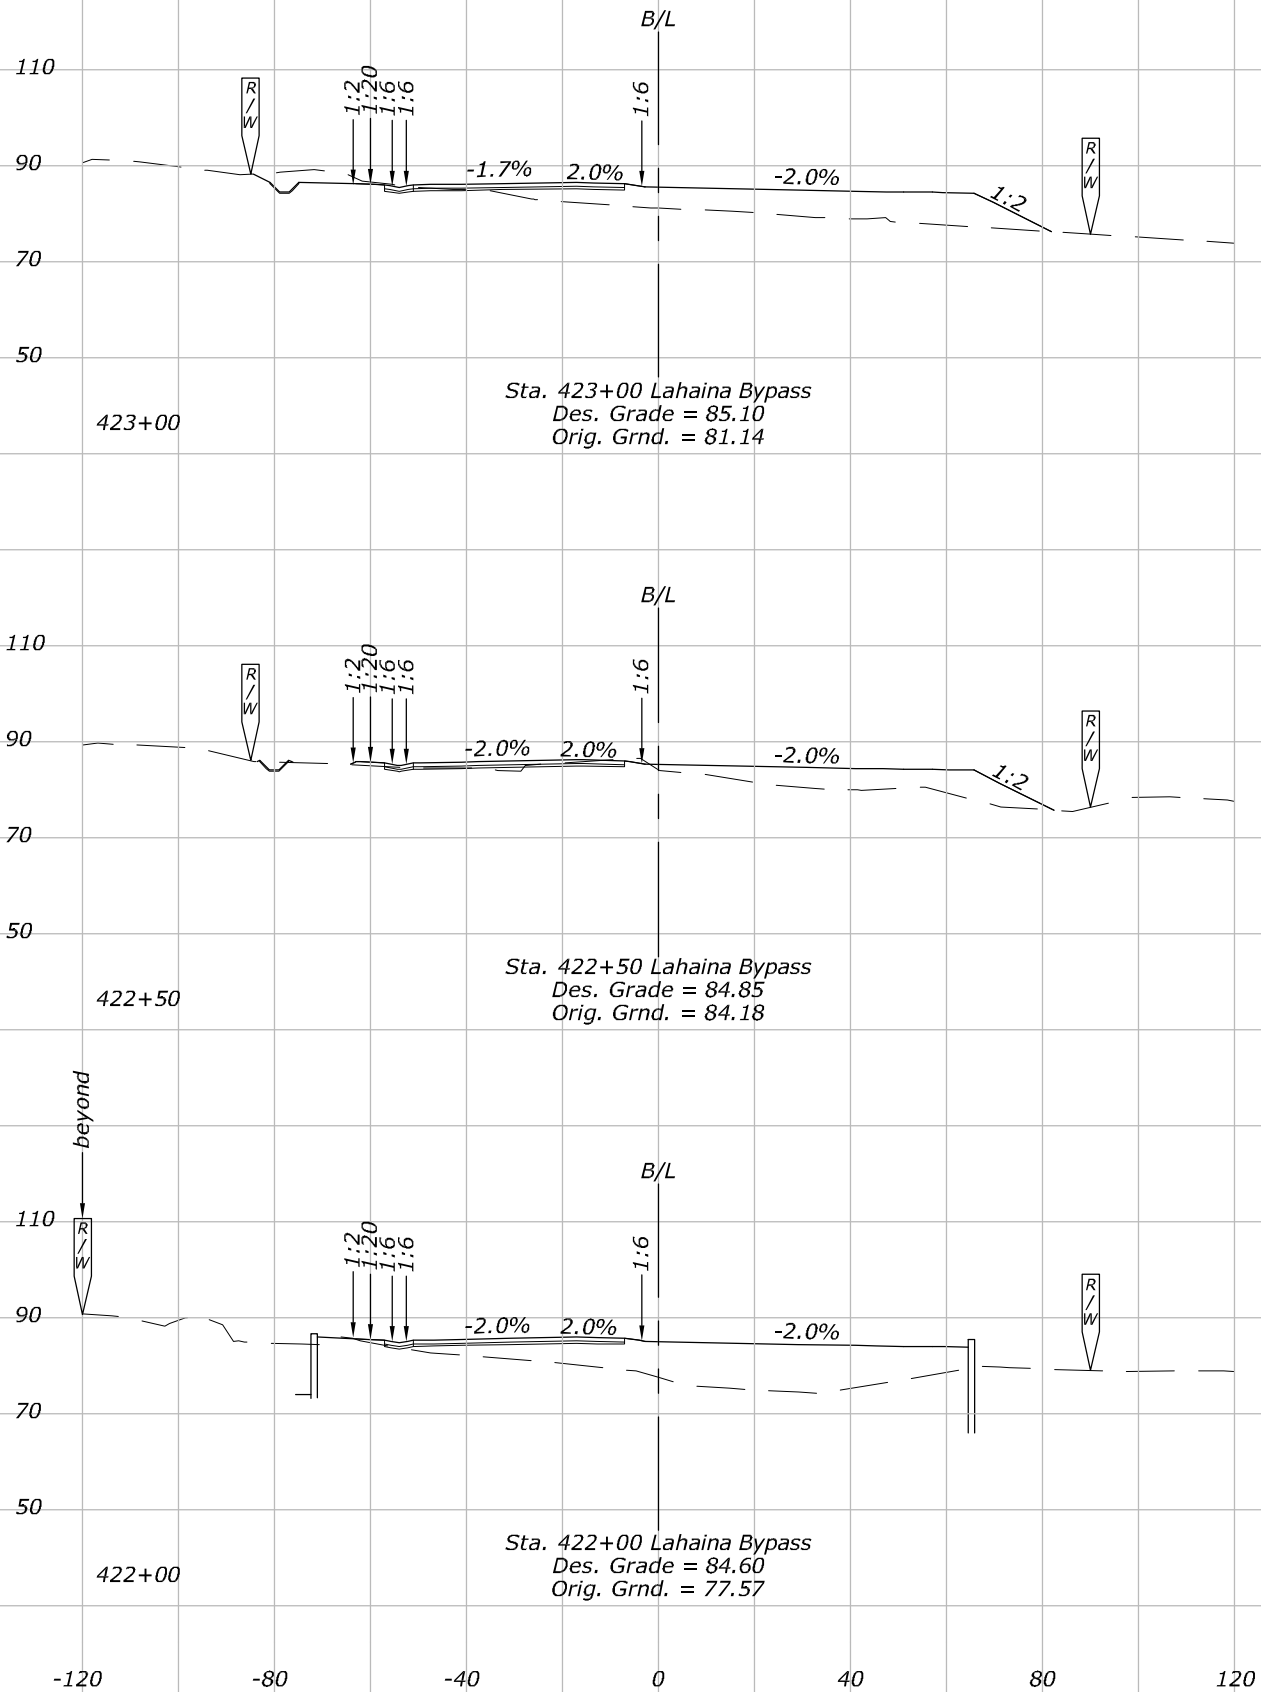

CROSS SECTIONS 422+00 TO 424+50

Patricia Choy

W:\102226-01\Civil\CADD\Site\AS-BUILT\DWGS\DRIVE_w\102226-01\Civil\CADD\Site\DWGS\X20 Cross Sections.dwg


14:21:52

January 11, 2019

NOTES:







1. Elevations Shown on Roadway
Sections are at 10'.

STATE	PROJECT	SHEET NO.
HI	HI STP SR 30(1)	X20

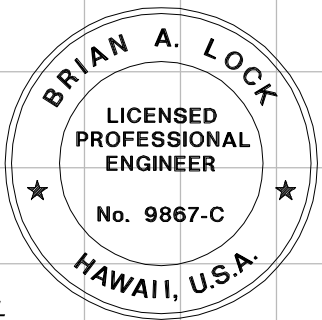

THIS WORK WAS PREPARED BY ME
OR UNDER MY SUPERVISION.

WILSON OKAMOTO CORPORATION
APRIL 30, 2020
LIC. EXP. DATE

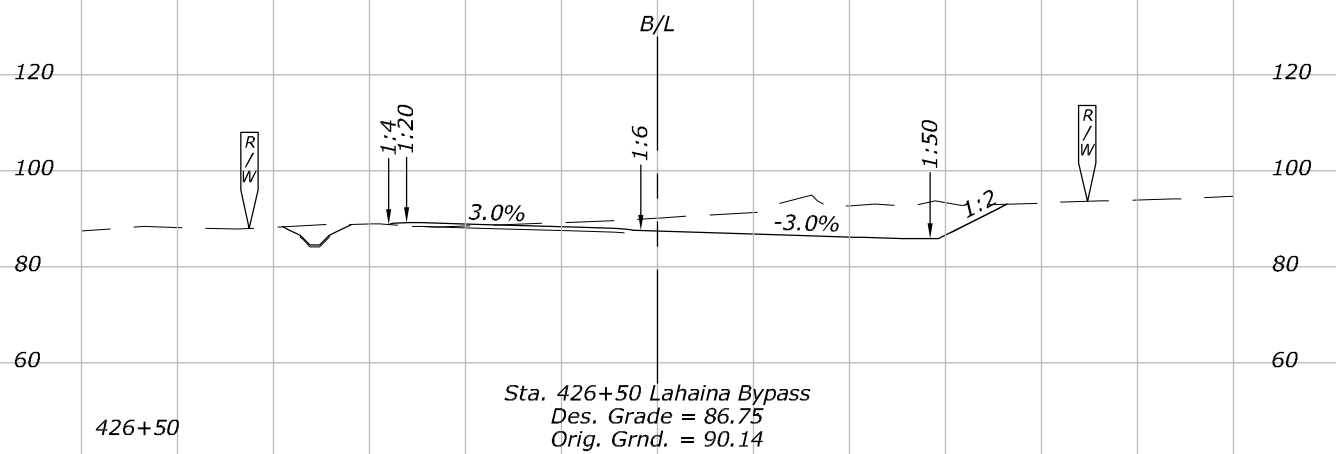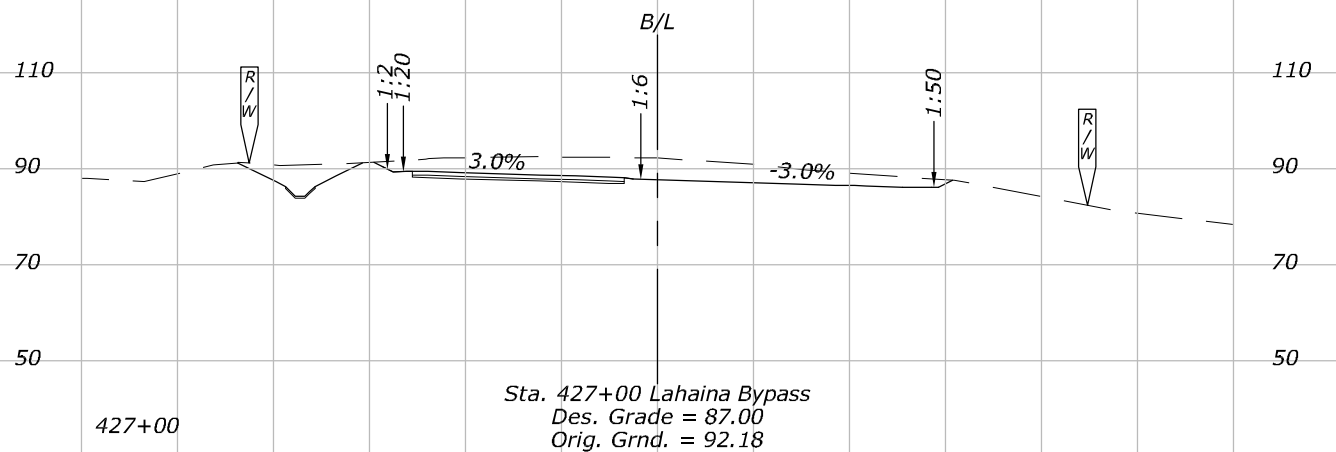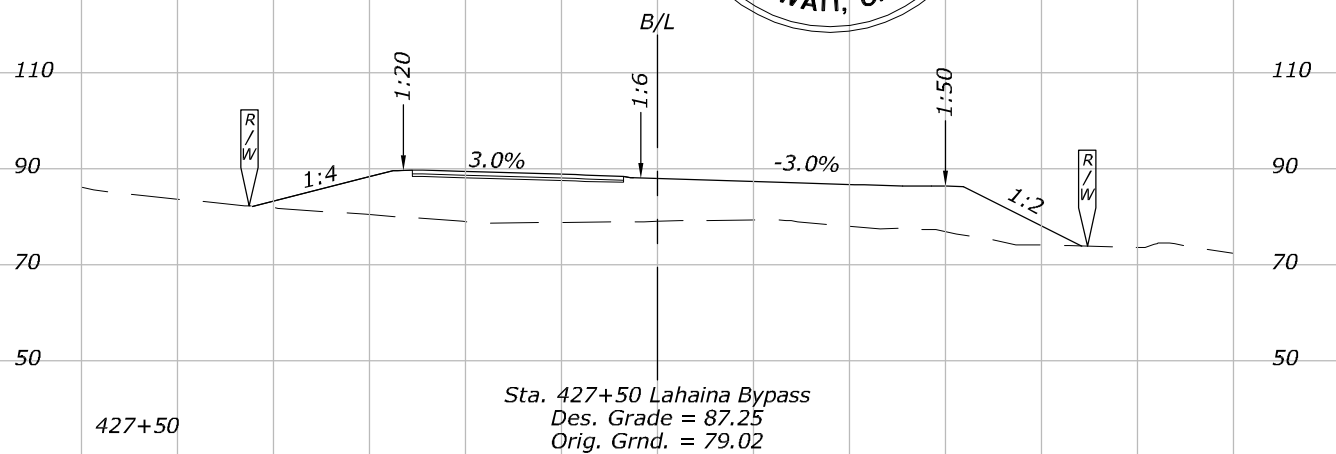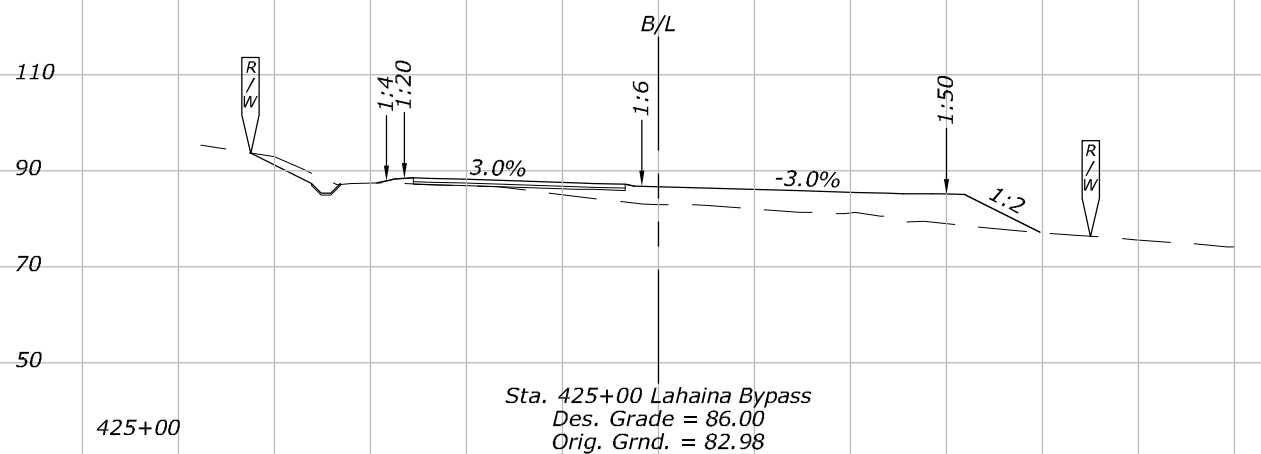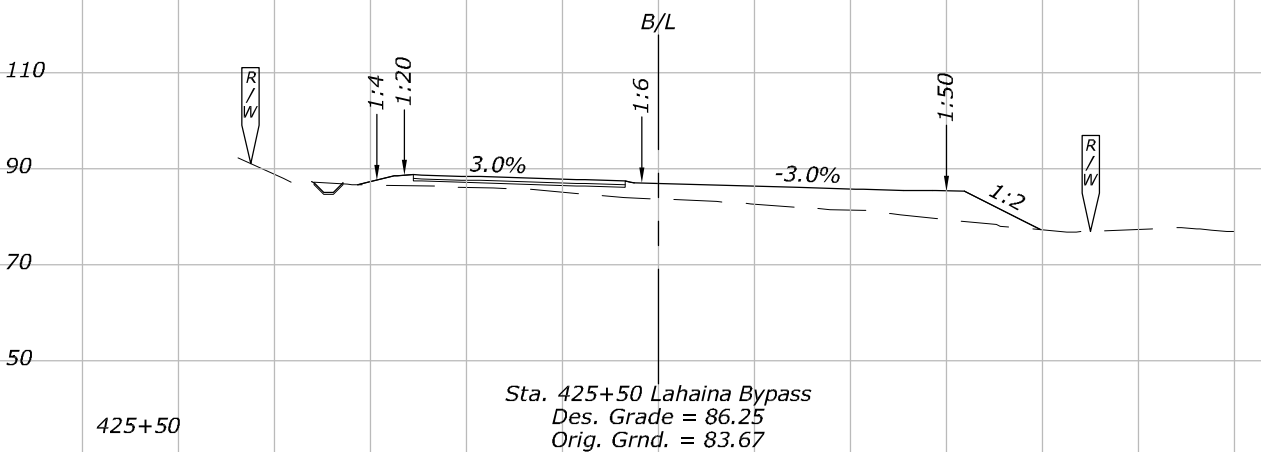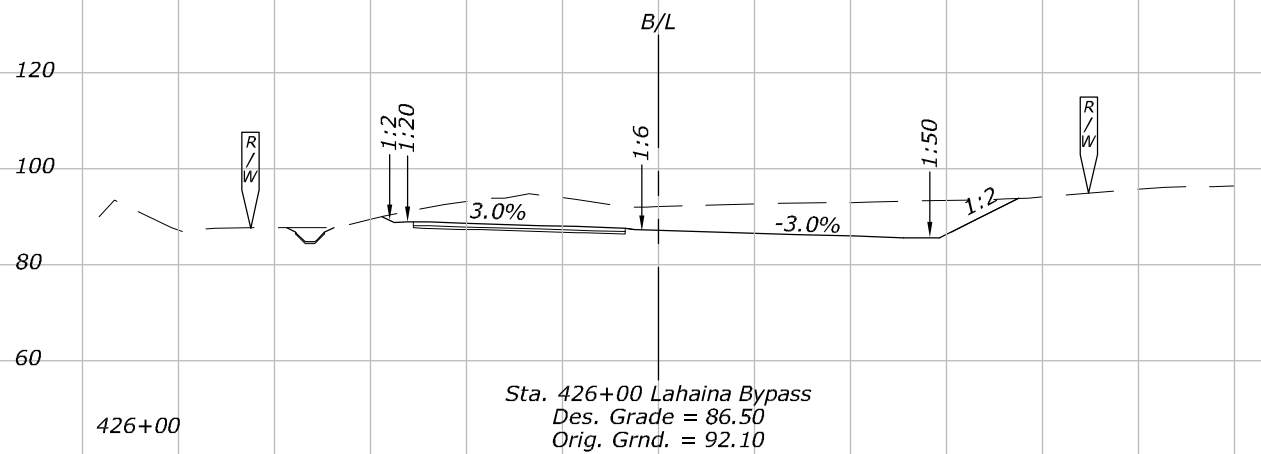

CROSS SECTIONS 425+00 TO 427+50

Patricia Choy

W:\102226-01\Civil\CADD\Site\AS-BUILT\DWGS\DRIVE_w\102226-01\Civil\CADD\Site\DWGS\X21 Cross Sections.dwg


14:30:57

January 11, 2019

NOTES:



1. Elevations Shown on Roadway
Sections are at 50'.

STATE	PROJECT	SHEET NO.
HI	HI STP SR 30(1)	X21

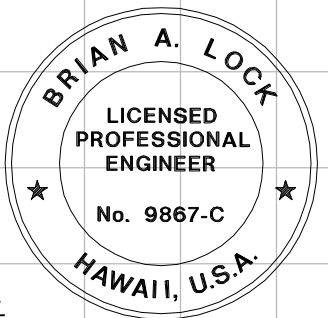

THIS WORK WAS PREPARED BY ME
OR UNDER MY SUPERVISION.

WILSON OKAMOTO CORPORATION
APRIL 30, 2020
LIC. EXP. DATE

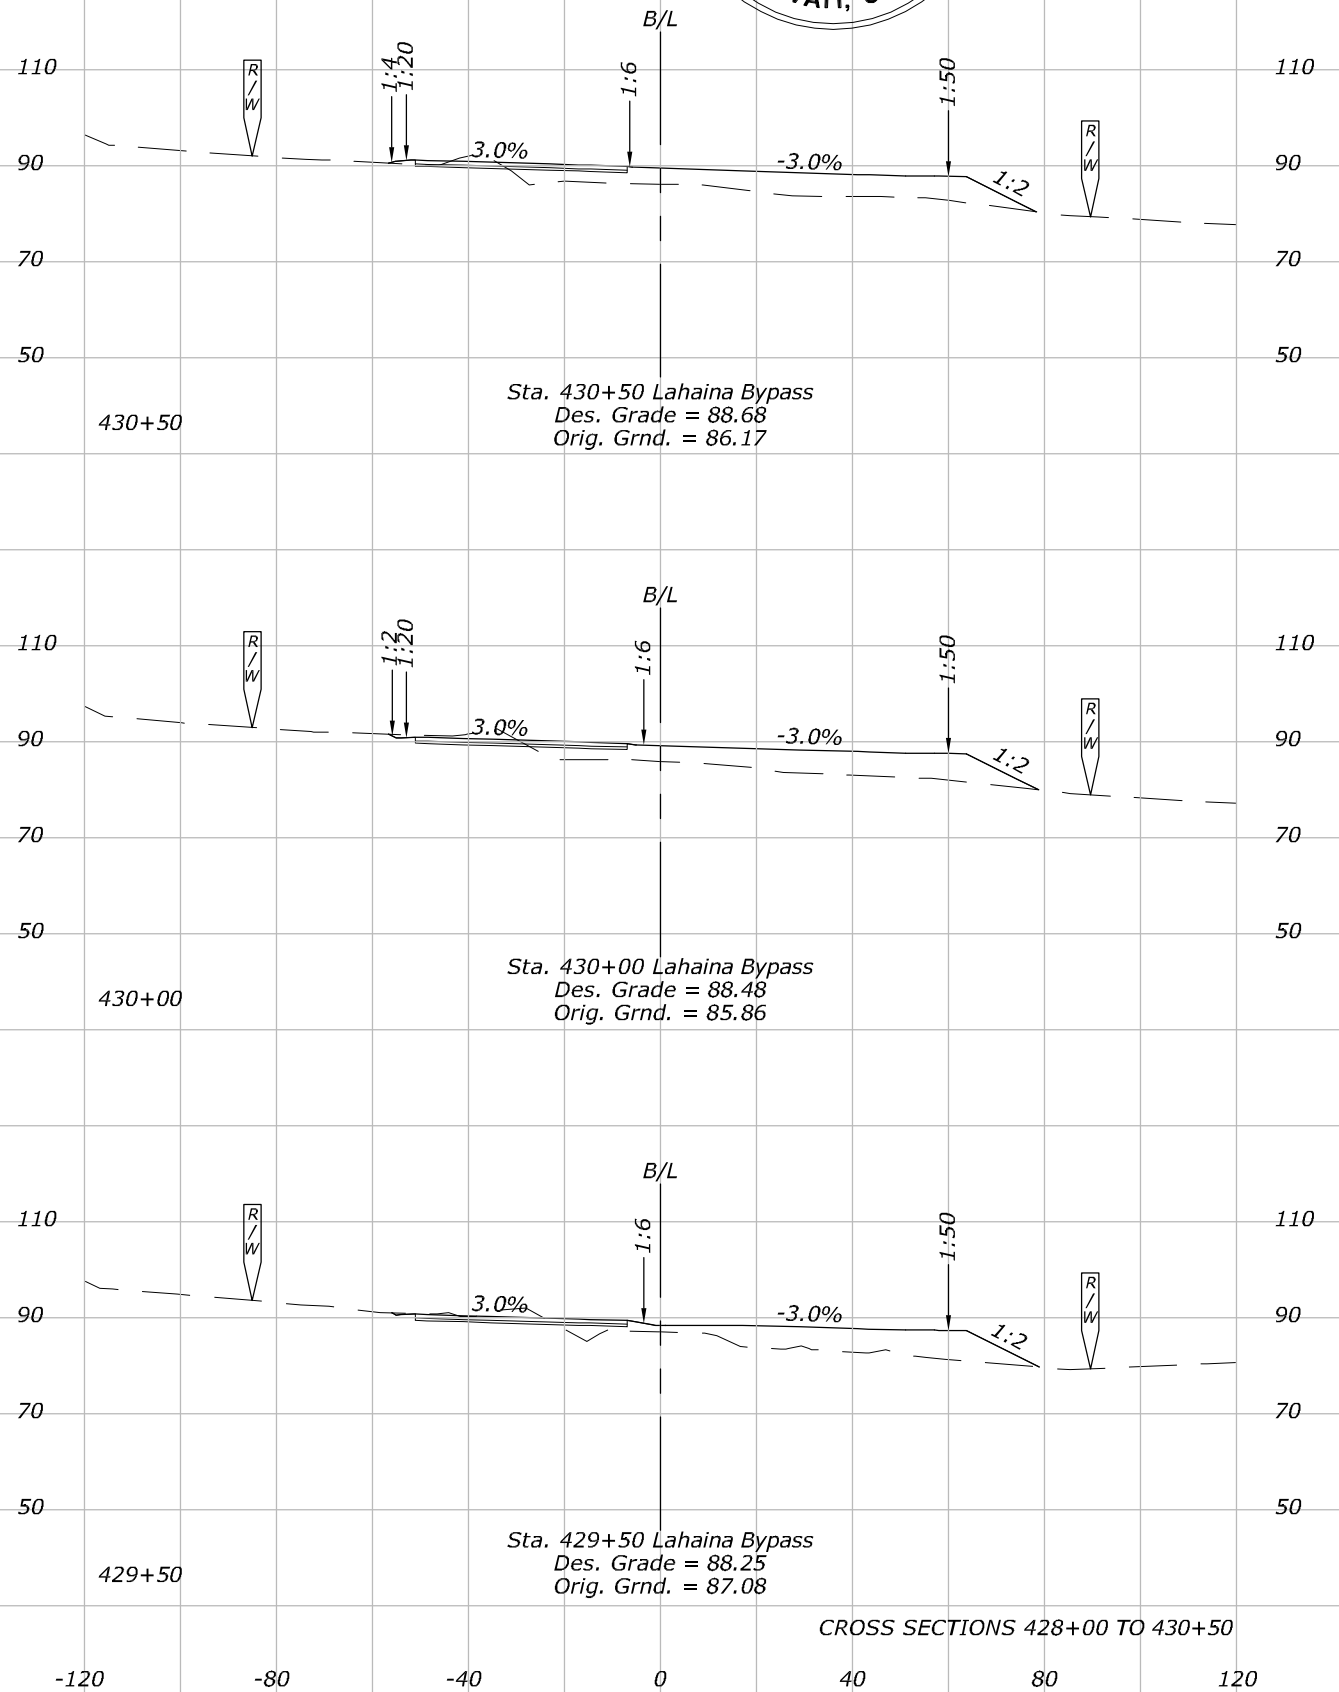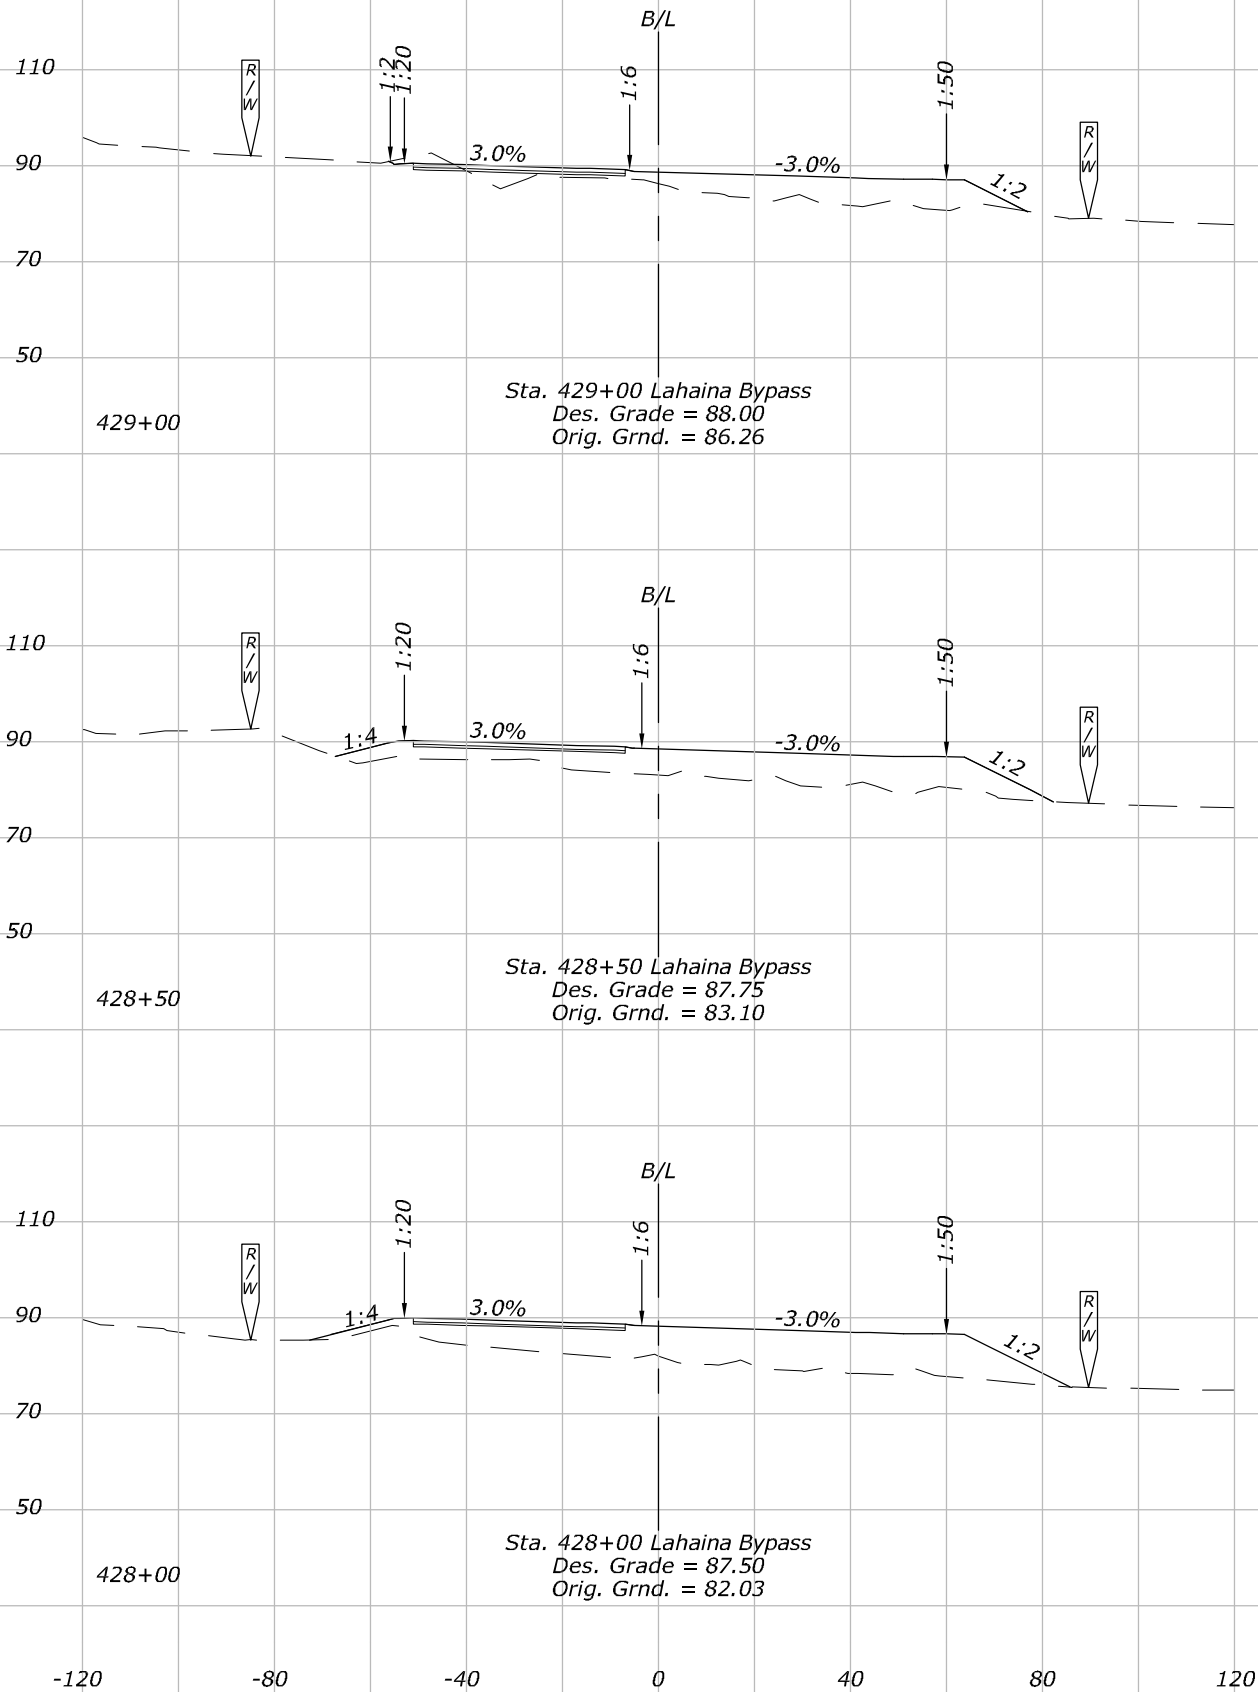

CROSS SECTIONS 428+00 TO 430+50

Patricia Choy

W:\102226-01\Civil\CADD\Site\AS-BUILT\DWGS\DRIVE_w\102226-01\Civil\CADD\Site\DWGS\X22 Cross Sections.dwg


14:32:55

January 11, 2019

NOTES:






1. Elevations Shown on Roadway
Sections are at 5'.

STATE	PROJECT	SHEET NO.
HI	HI STP SR 30(1)	X22

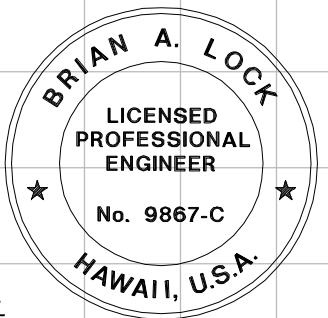

THIS WORK WAS PREPARED BY ME
OR UNDER MY SUPERVISION.

WILSON OKAMOTO CORPORATION
APRIL 30, 2020
LIC. EXP. DATE

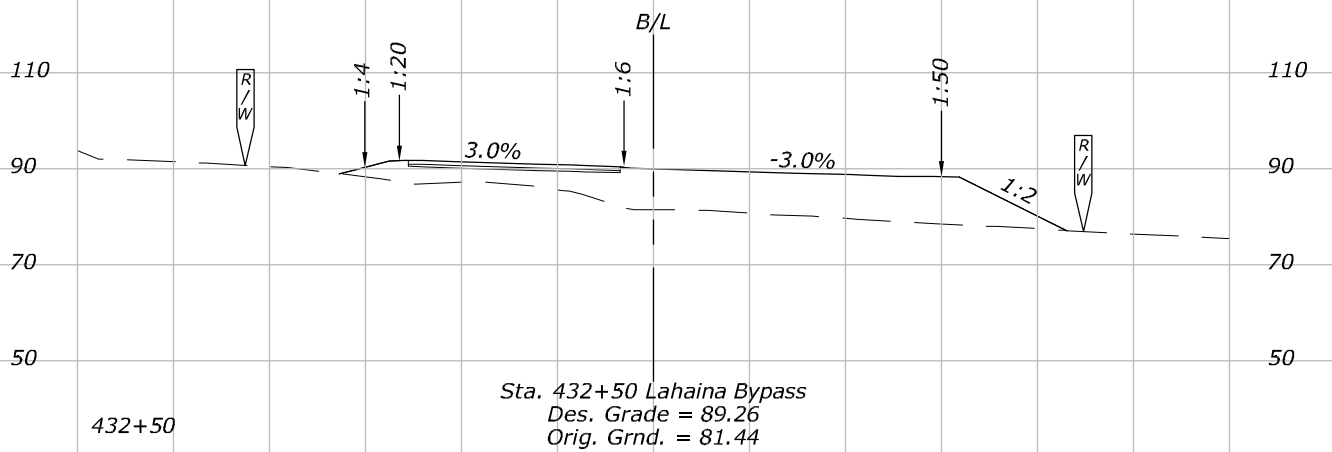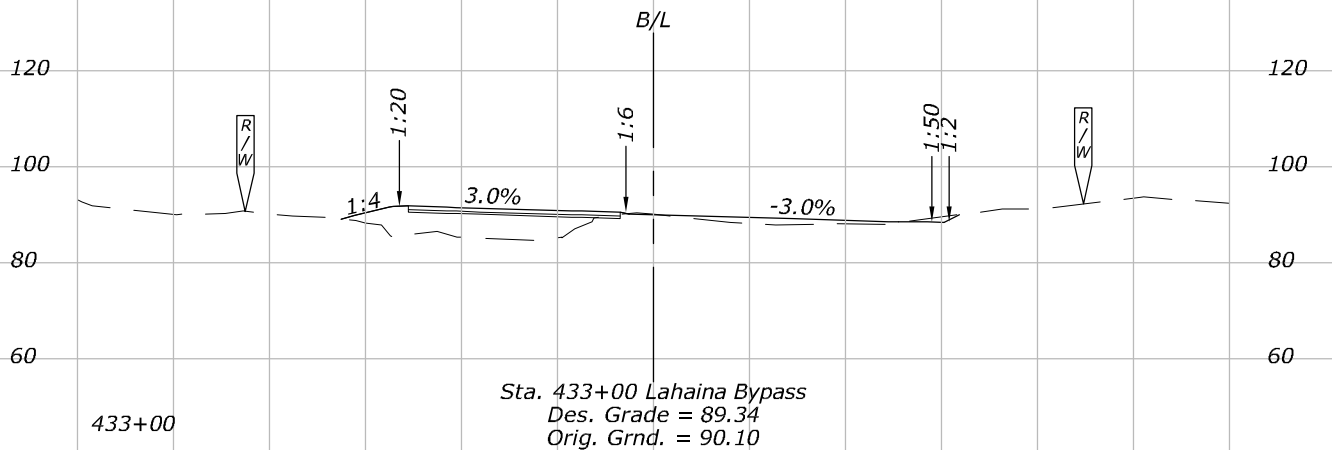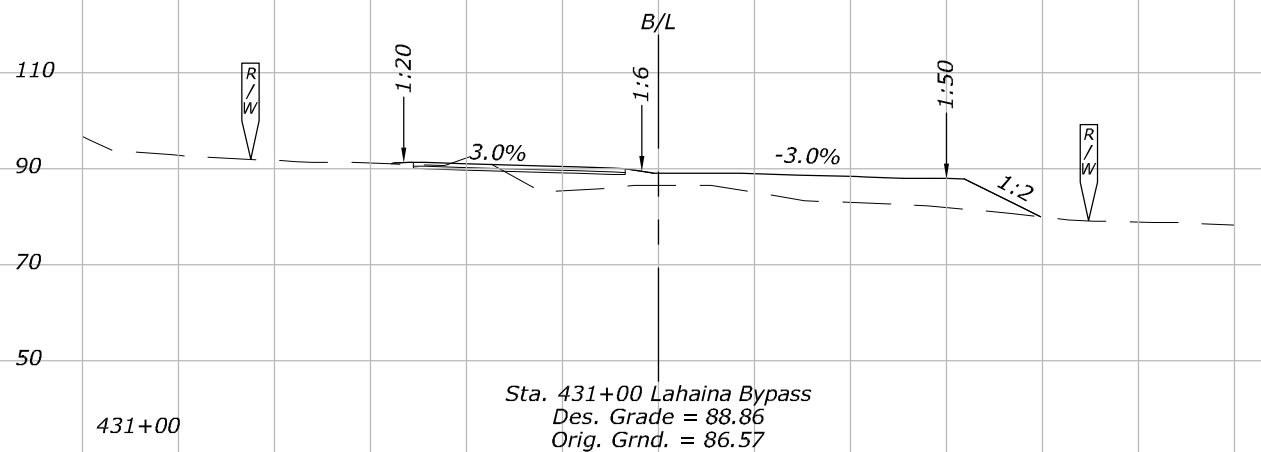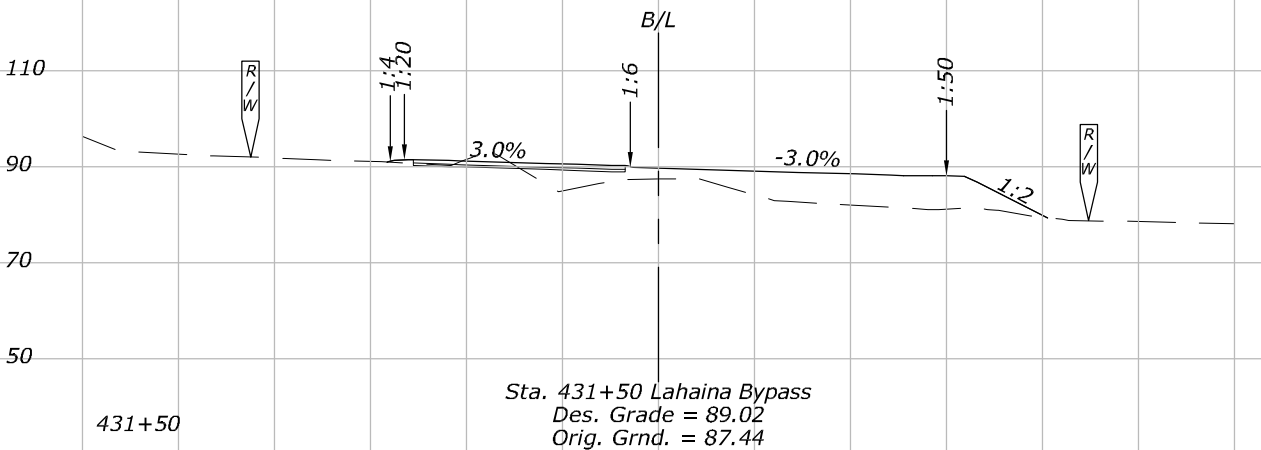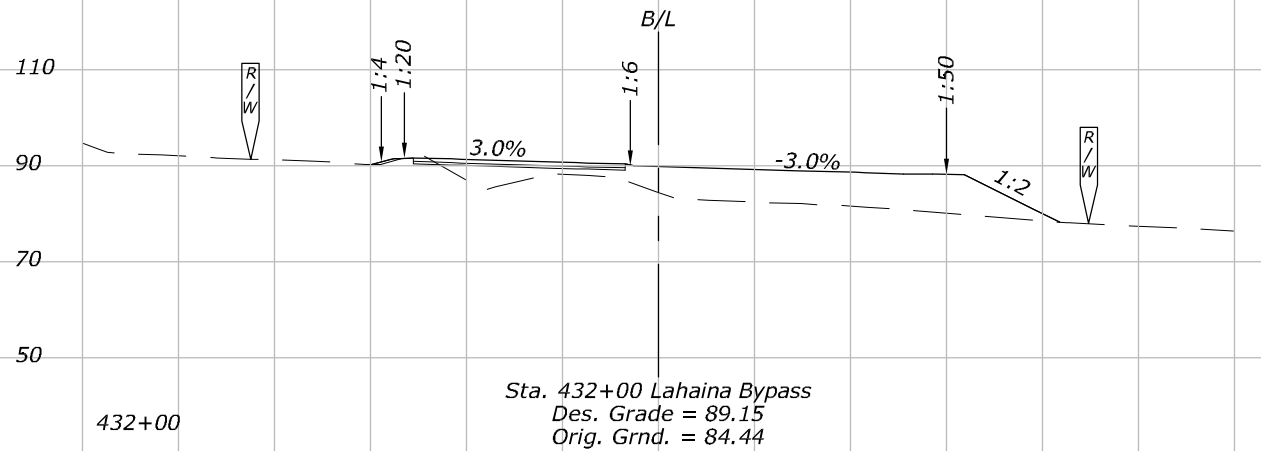

CROSS SECTIONS 431+00 TO 433+50

Patricia Choy

W:\10226-01\Civil\CADD\Site\AS-BUILT\DWGS\DRIVE_w\10226-01\Civil\CADD\Site\DWGS\X23 Cross Sections.dwg


14:36:00

January 11, 2019

NOTES:







1. Elevations Shown on Roadway
Sections are at 10'.

STATE	PROJECT	SHEET NO.
HI	HI STP SR 30(1)	X23

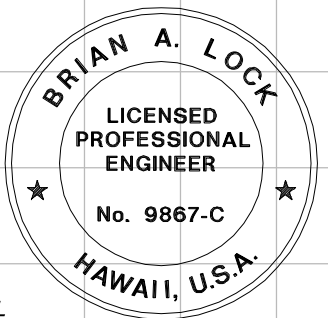

THIS WORK WAS PREPARED BY ME
OR UNDER MY SUPERVISION.

WILSON OKAMOTO CORPORATION
APRIL 30, 2020
LIC. EXP. DATE

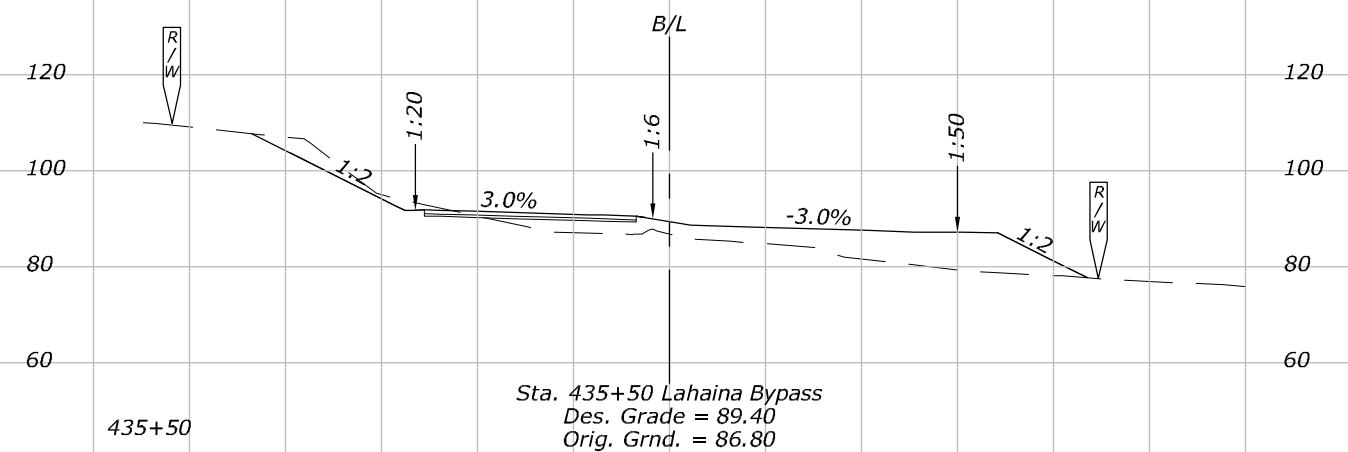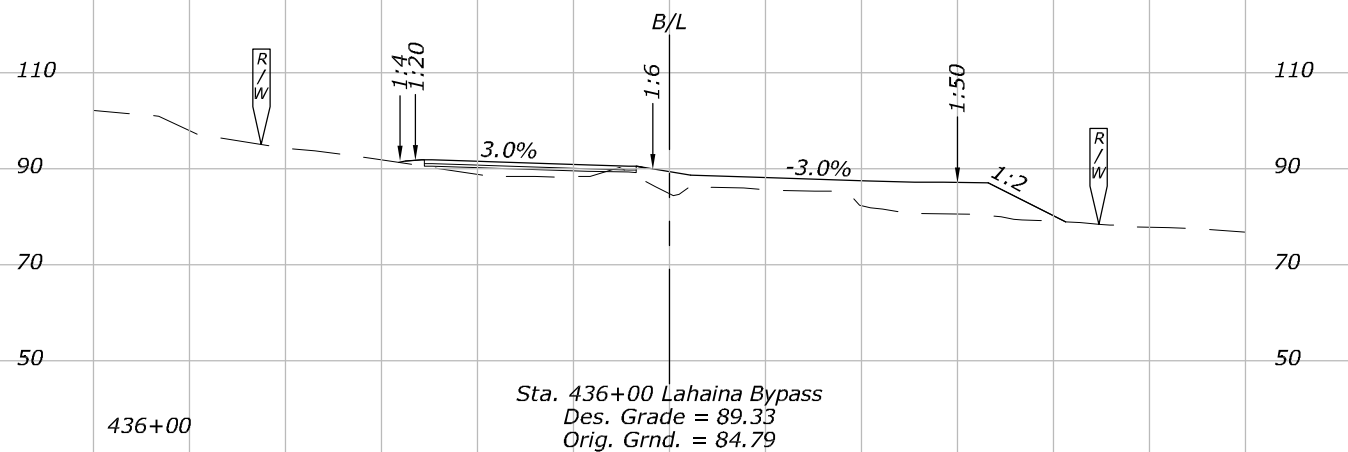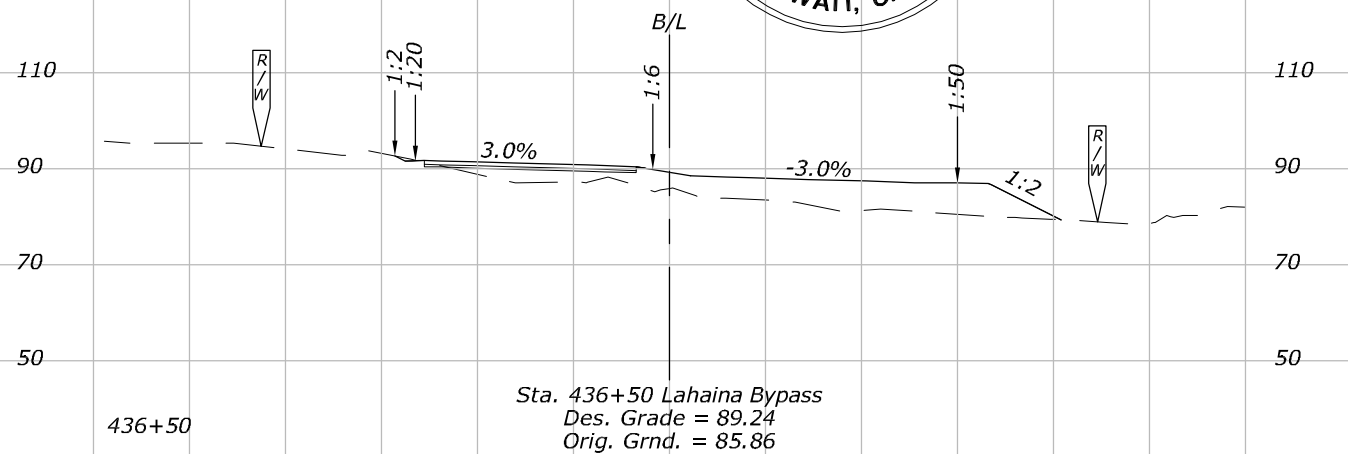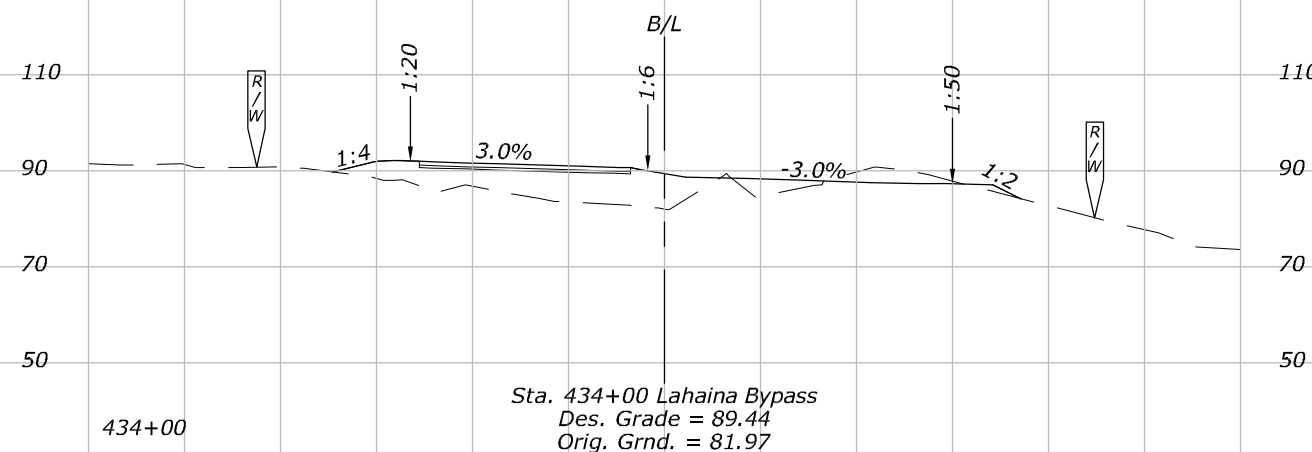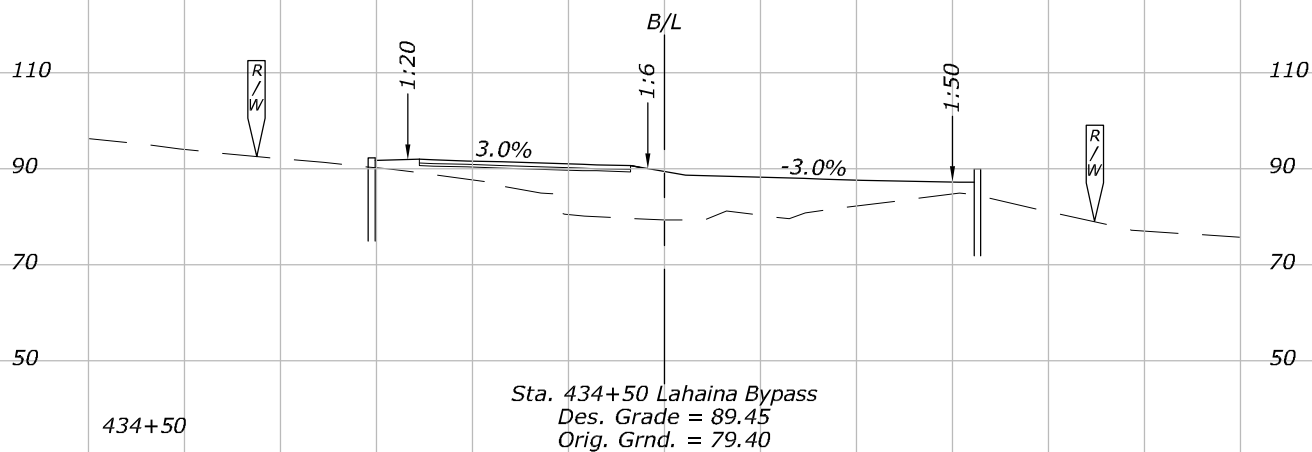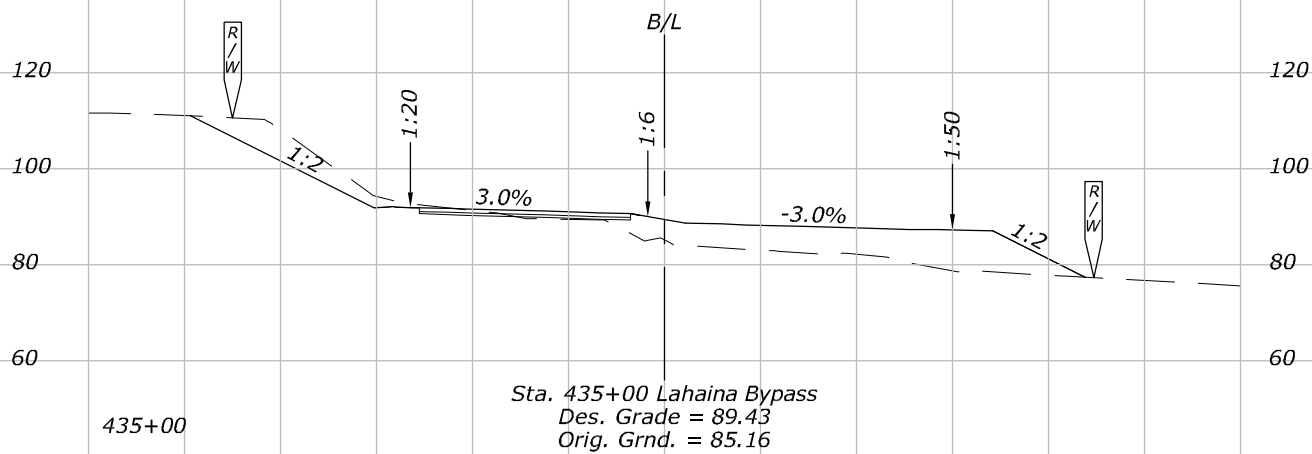

CROSS SECTIONS 434+00 TO 436+50

Patricia Choy

W:\10226-01\Civil\CADD\Site\AS-BUILT\DWGS\DRIVE_w\10226-01\Civil\CADD\Site\DWGS\X24 Cross Sections.dwg


14:37:42

January 11, 2019

NOTES:



1. Elevations Shown on Roadway
Sections are at 10'.

STATE	PROJECT	SHEET NO.
HI	HI STP SR 30(1)	X24

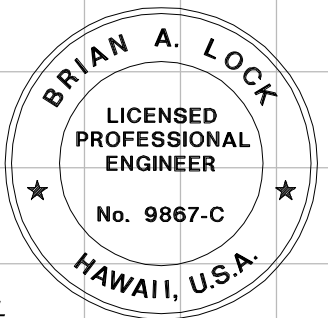

THIS WORK WAS PREPARED BY ME
OR UNDER MY SUPERVISION.

WILSON OKAMOTO CORPORATION
APRIL 30, 2020
LIC. EXP. DATE

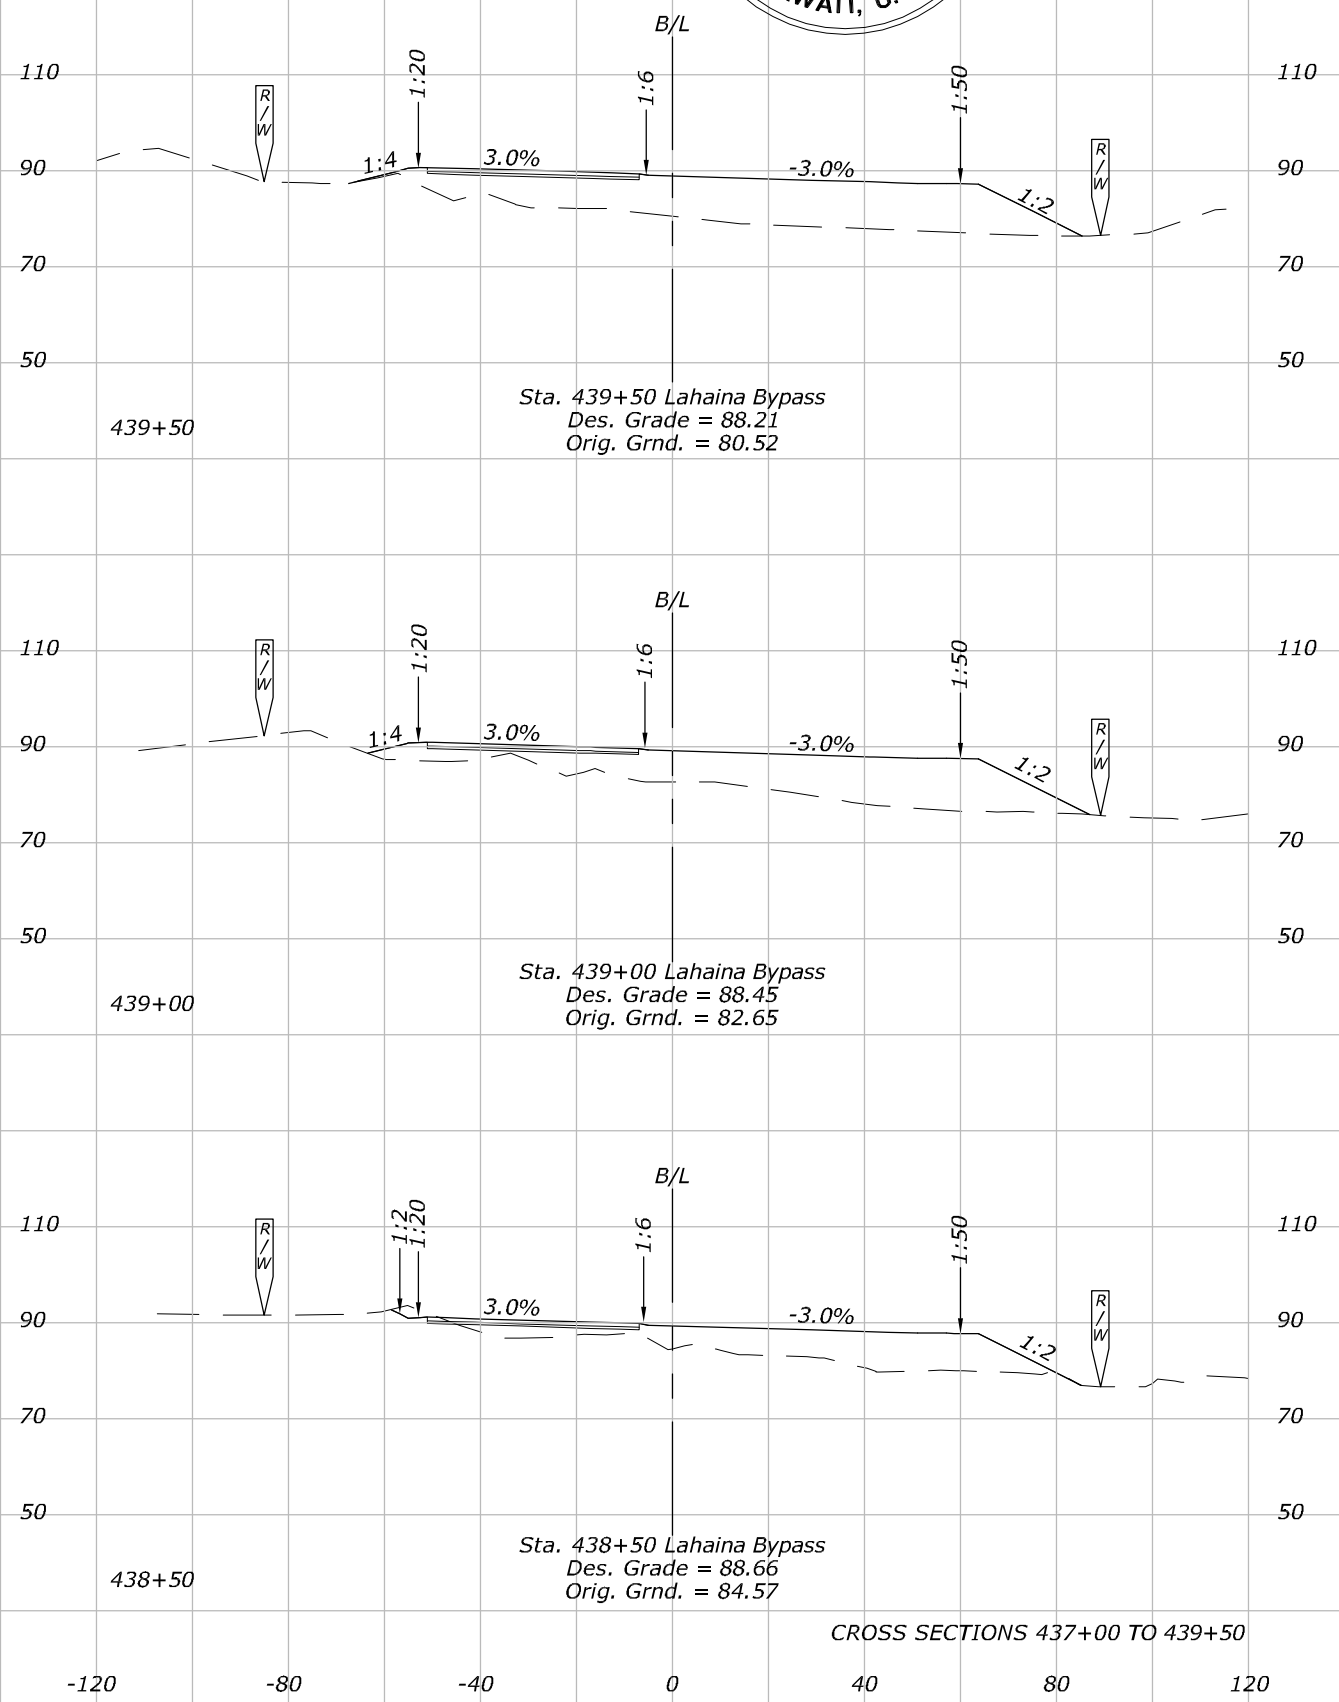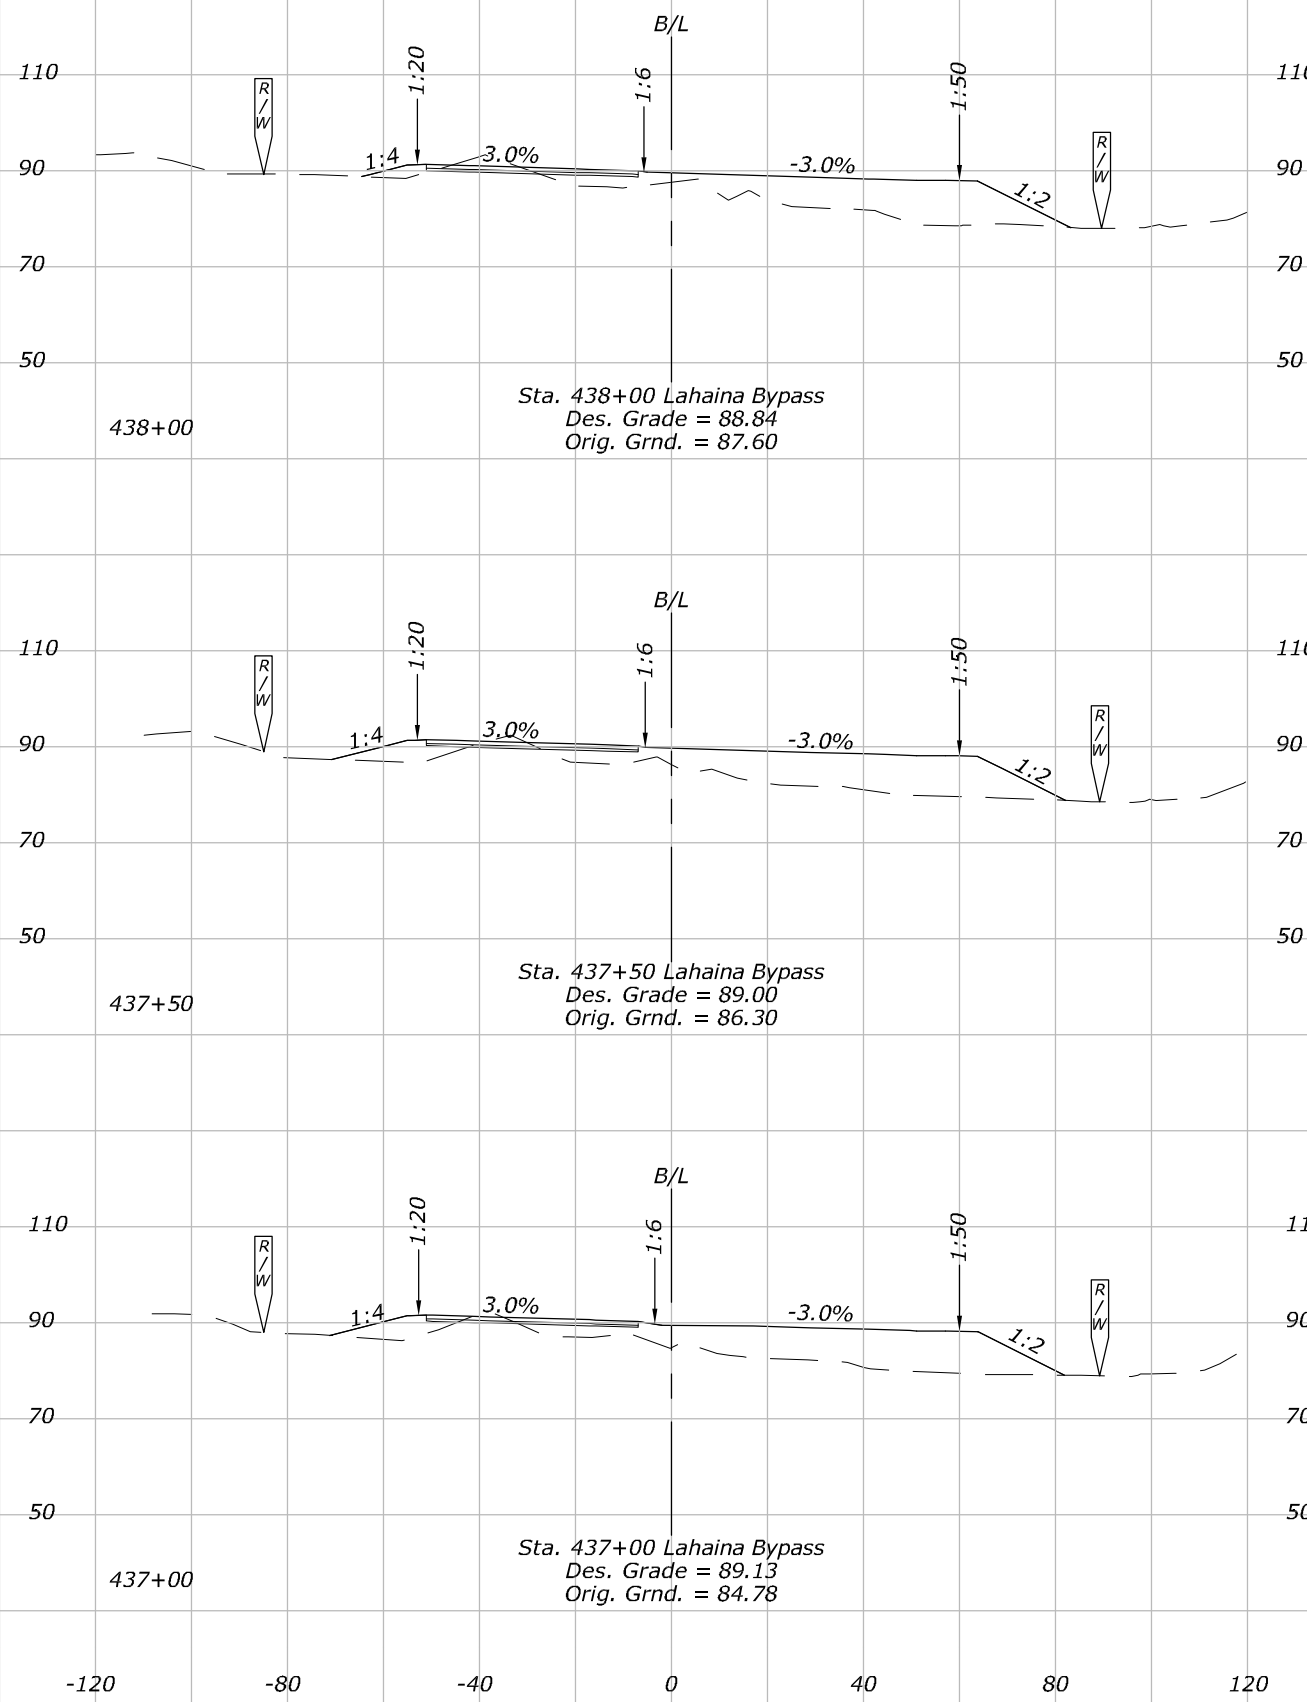

CROSS SECTIONS 437+00 TO 439+50

Patricia Choy

W:\10226-01\Civil\CADD\Site\AS-BUILT\DWGS\DRIVE_w\10226-01\Civil\CADD\Site\DWGS\X25 Cross Sections.dwg


14:39:03

January 11, 2019

NOTES:



1. Elevations Shown on Roadway
Sections are at 5'.

STATE	PROJECT	SHEET NO.
HI	HI STP SR 30(1)	X25

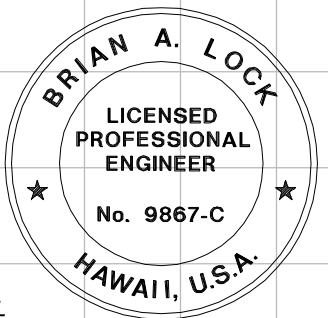

THIS WORK WAS PREPARED BY ME
OR UNDER MY SUPERVISION.

WILSON OKAMOTO CORPORATION
APRIL 30, 2020
LIC. EXP. DATE

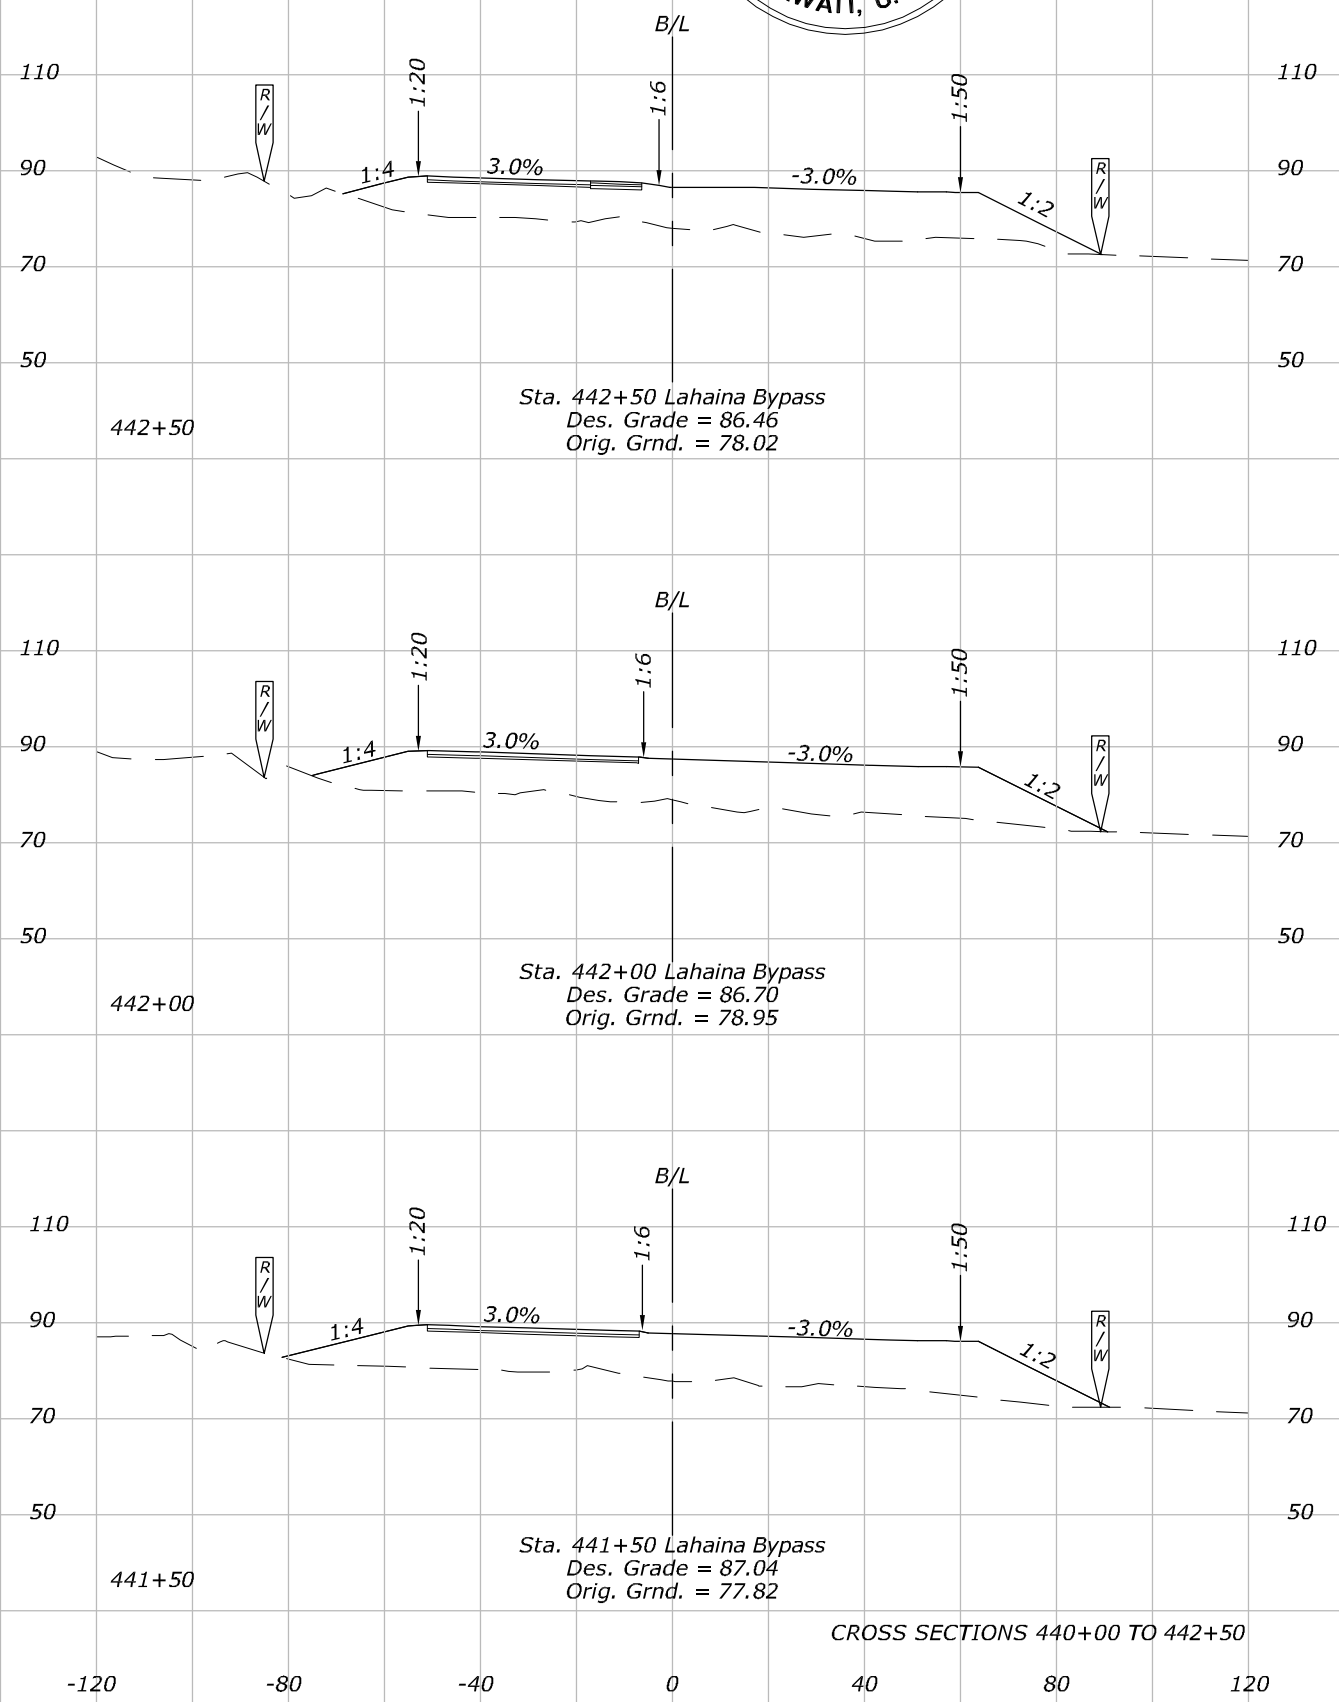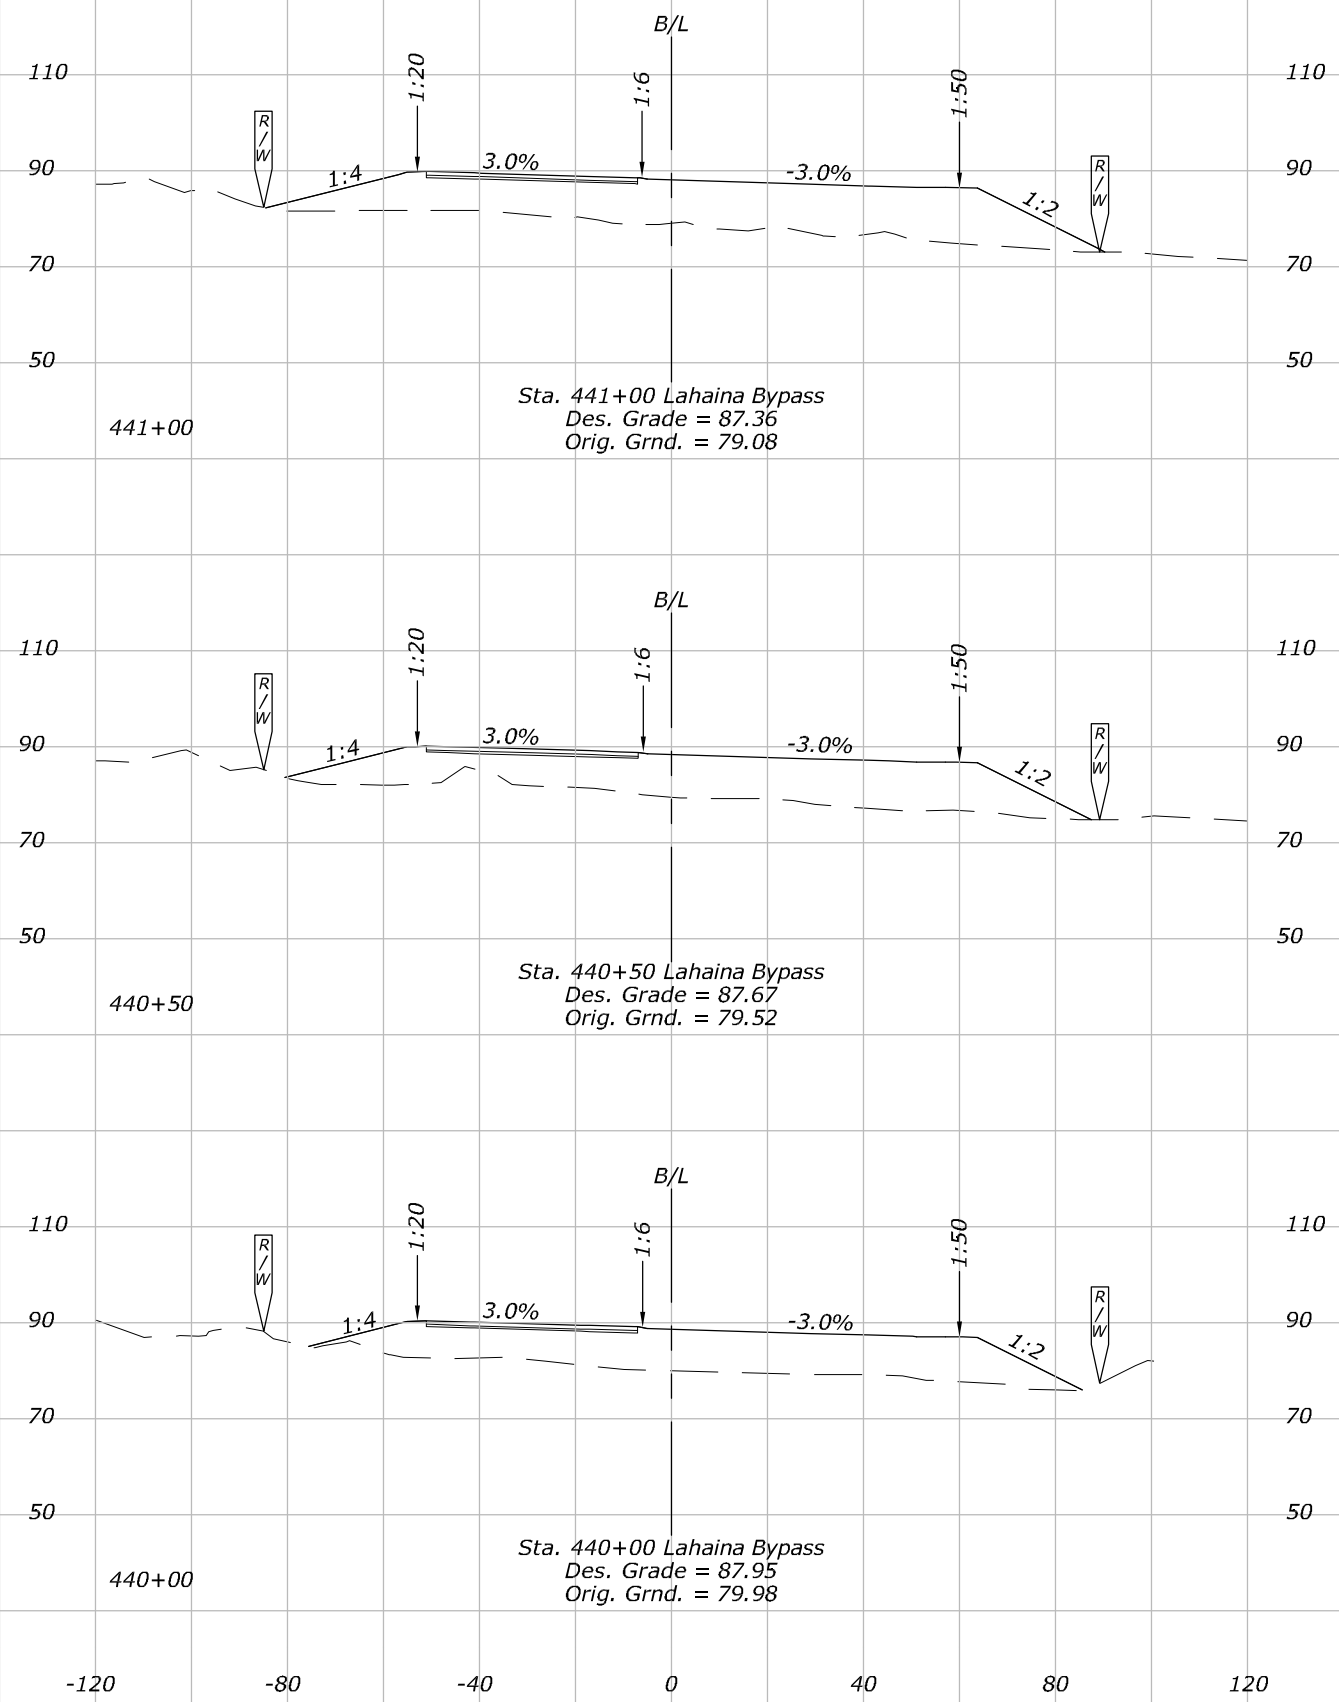

CROSS SECTIONS 440+00 TO 442+50

Patricia Choy

W:\10226-01\Civil\CADD\Site\DWGS\DRIVE_w\10226-01\Civil\CADD\Site\DWGS\X26 Cross Sections.dwg


14:44:11

January 11, 2019

NOTES:



1. Elevations Shown on Roadway
Sections are at 5'.

STATE	PROJECT	SHEET NO.
HI	HI STP SR 30(1)	X26

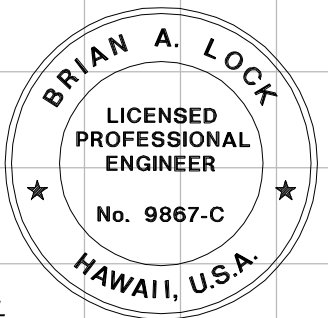

THIS WORK WAS PREPARED BY ME
OR UNDER MY SUPERVISION.

WILSON OKAMOTO CORPORATION
APRIL 30, 2020
LIC. EXP. DATE

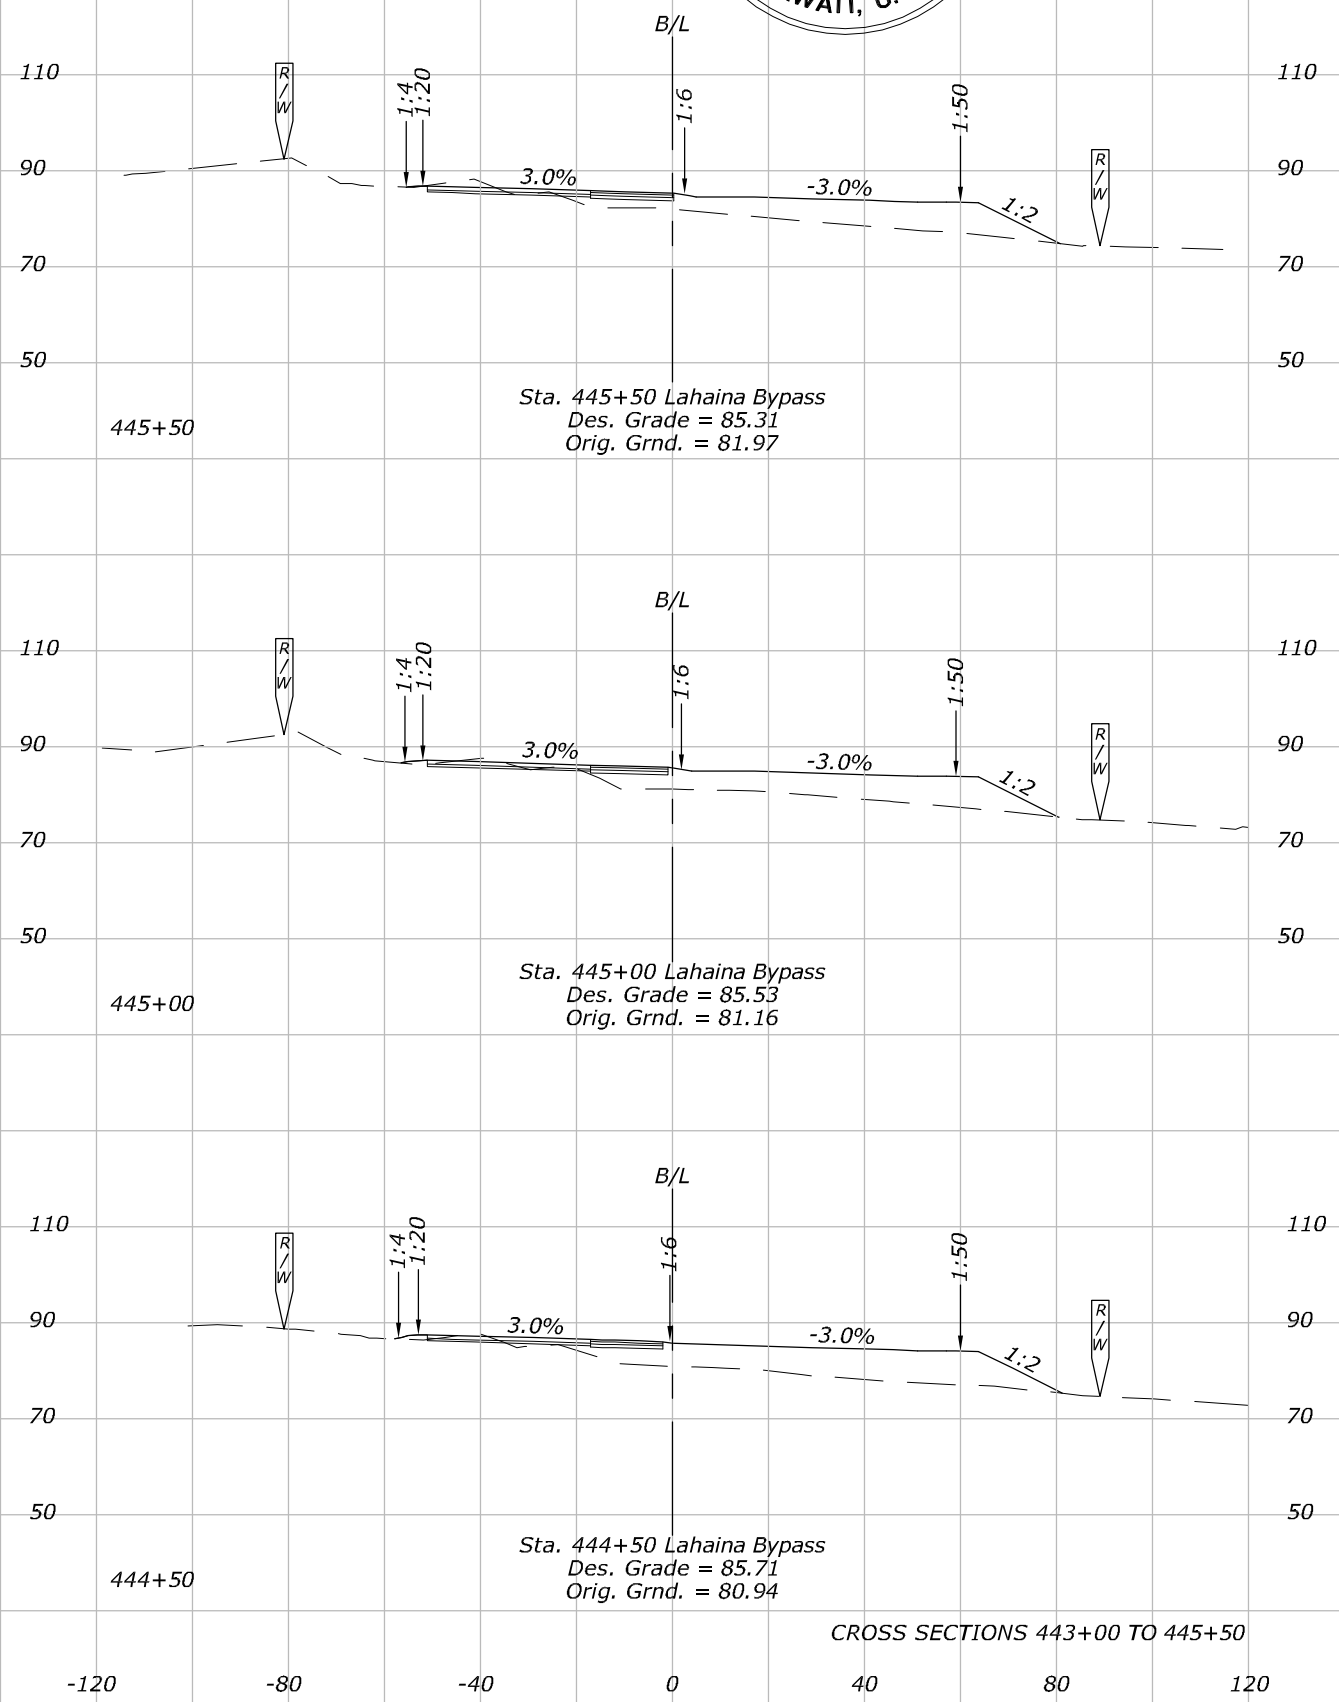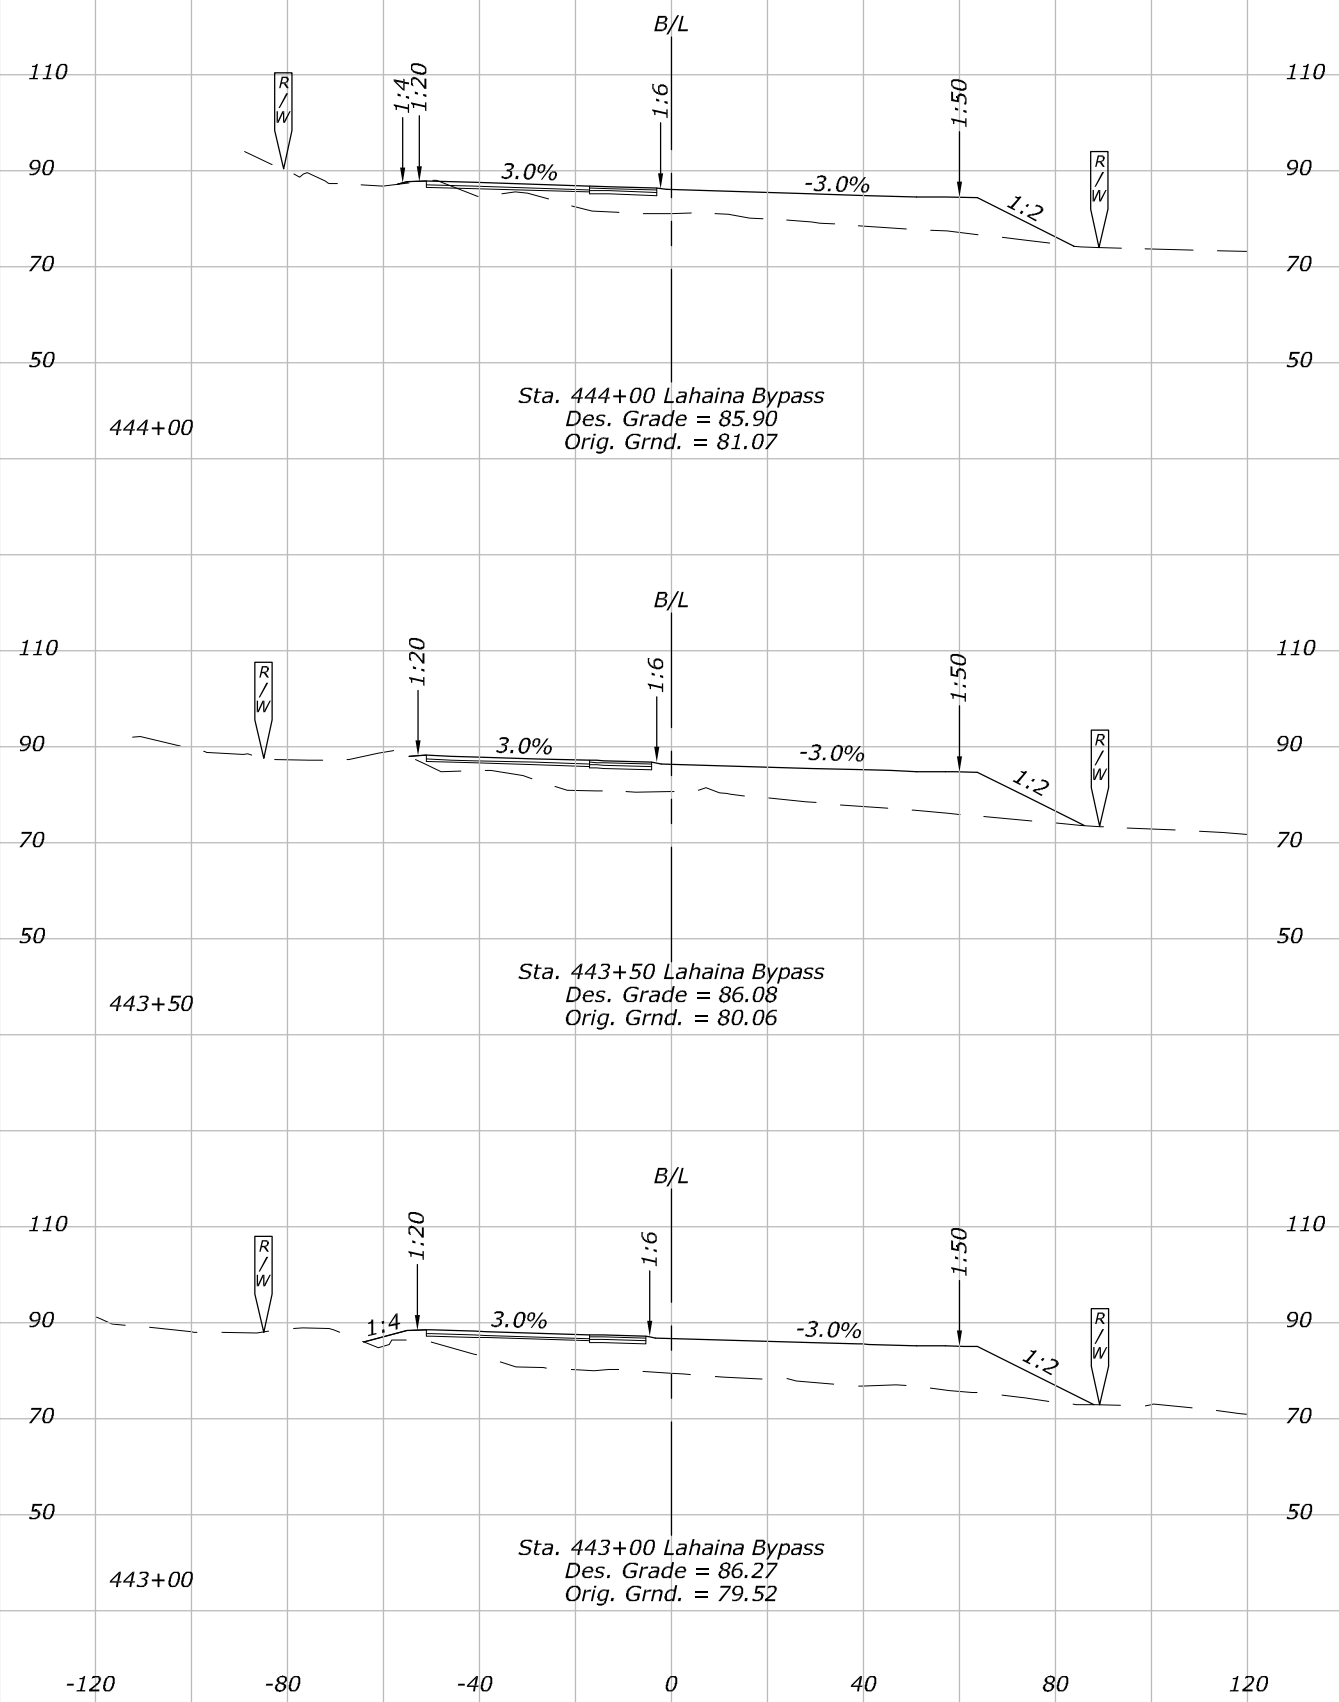

CROSS SECTIONS 443+00 TO 445+50

Patricia Choy

W:\10226-01\Civil\CADD\Site\DWGS\DRIVE_w\10226-01\Civil\CADD\Site\DWGS\X27 Cross Sections.dwg


14:45:24

January 11, 2019

NOTES:



1. Elevations Shown on Roadway
Sections are at 5'.

STATE	PROJECT	SHEET NO.
HI	HI STP SR 30(1)	X27

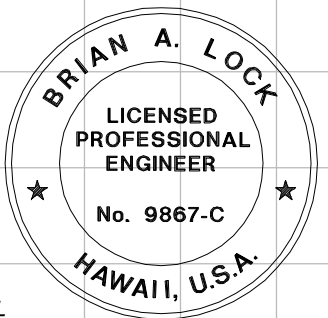

THIS WORK WAS PREPARED BY ME
OR UNDER MY SUPERVISION.

WILSON OKAMOTO CORPORATION
APRIL 30, 2020
LIC. EXP. DATE

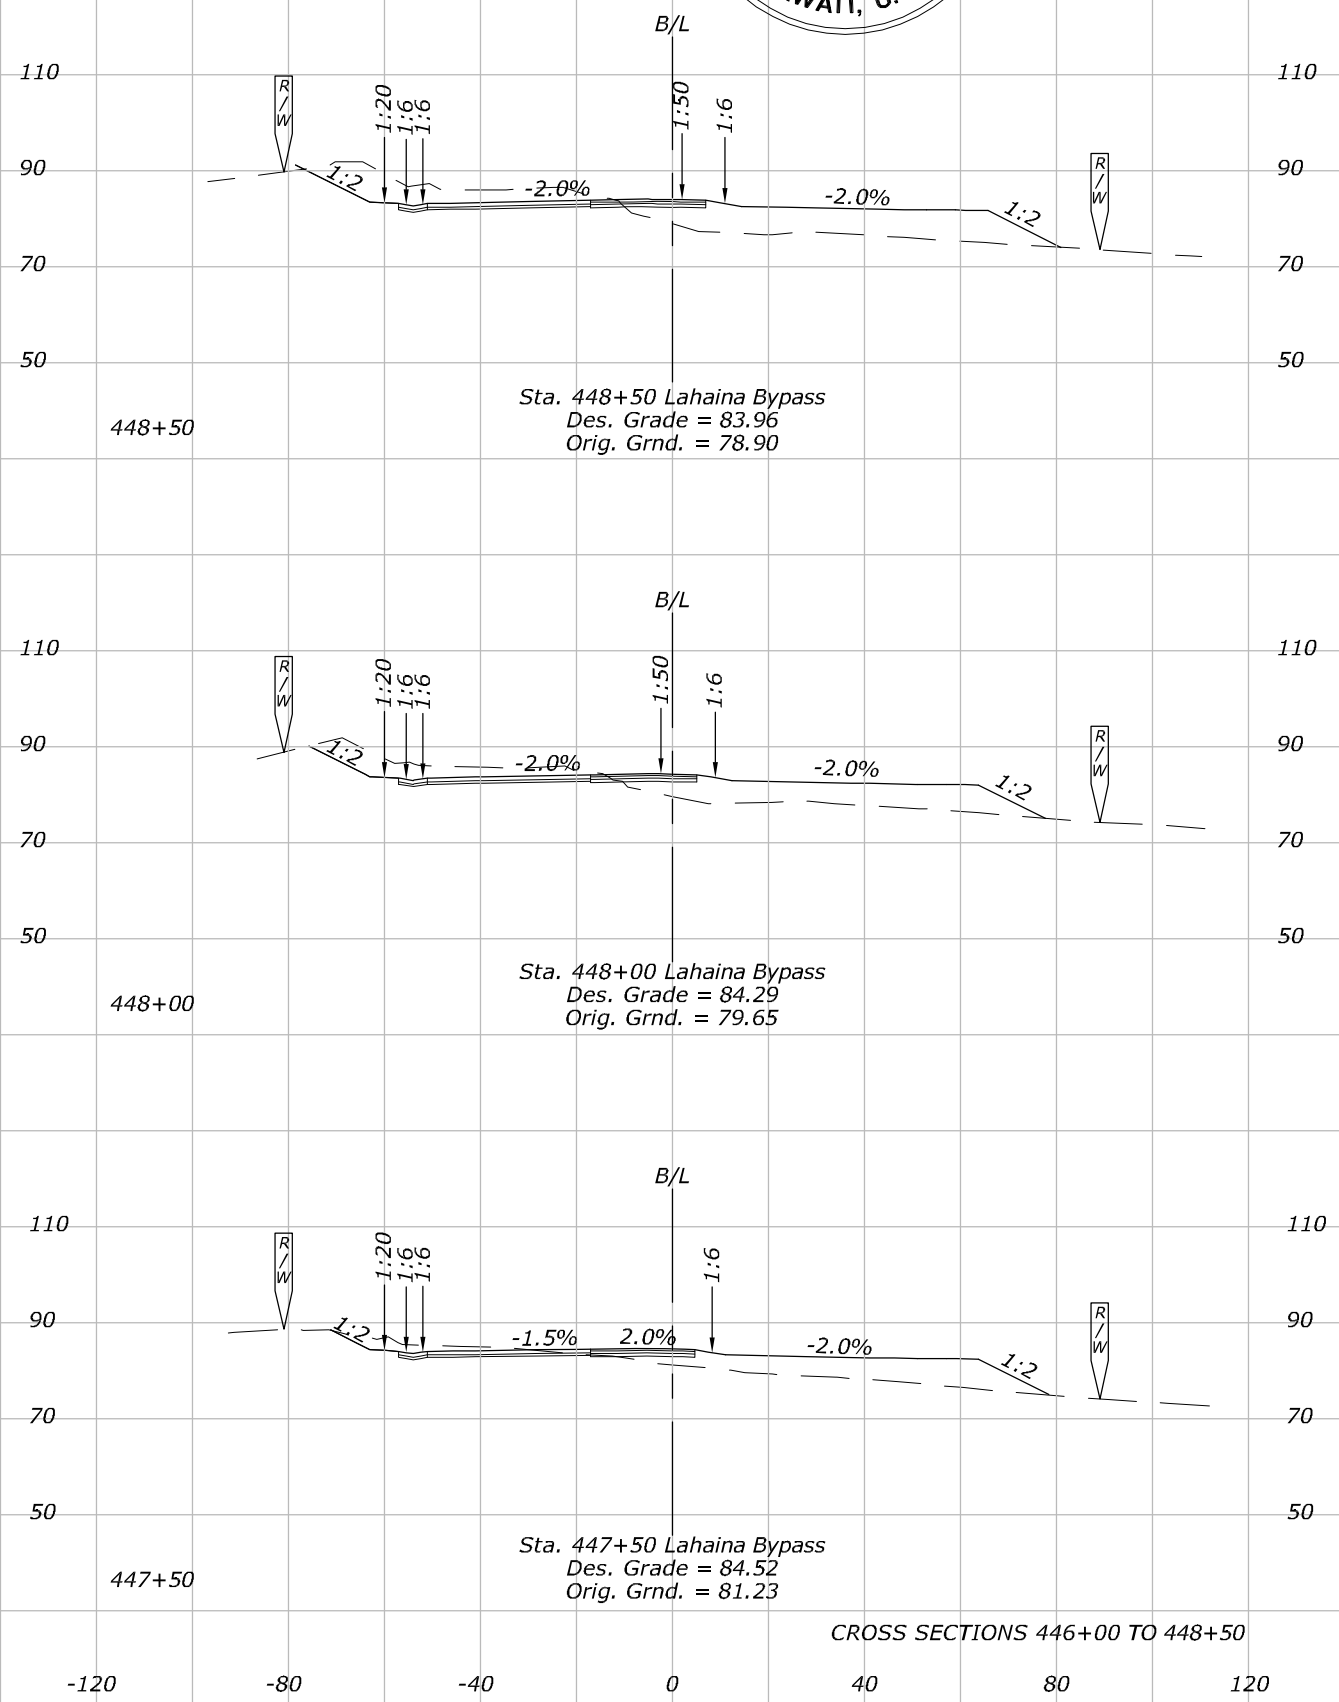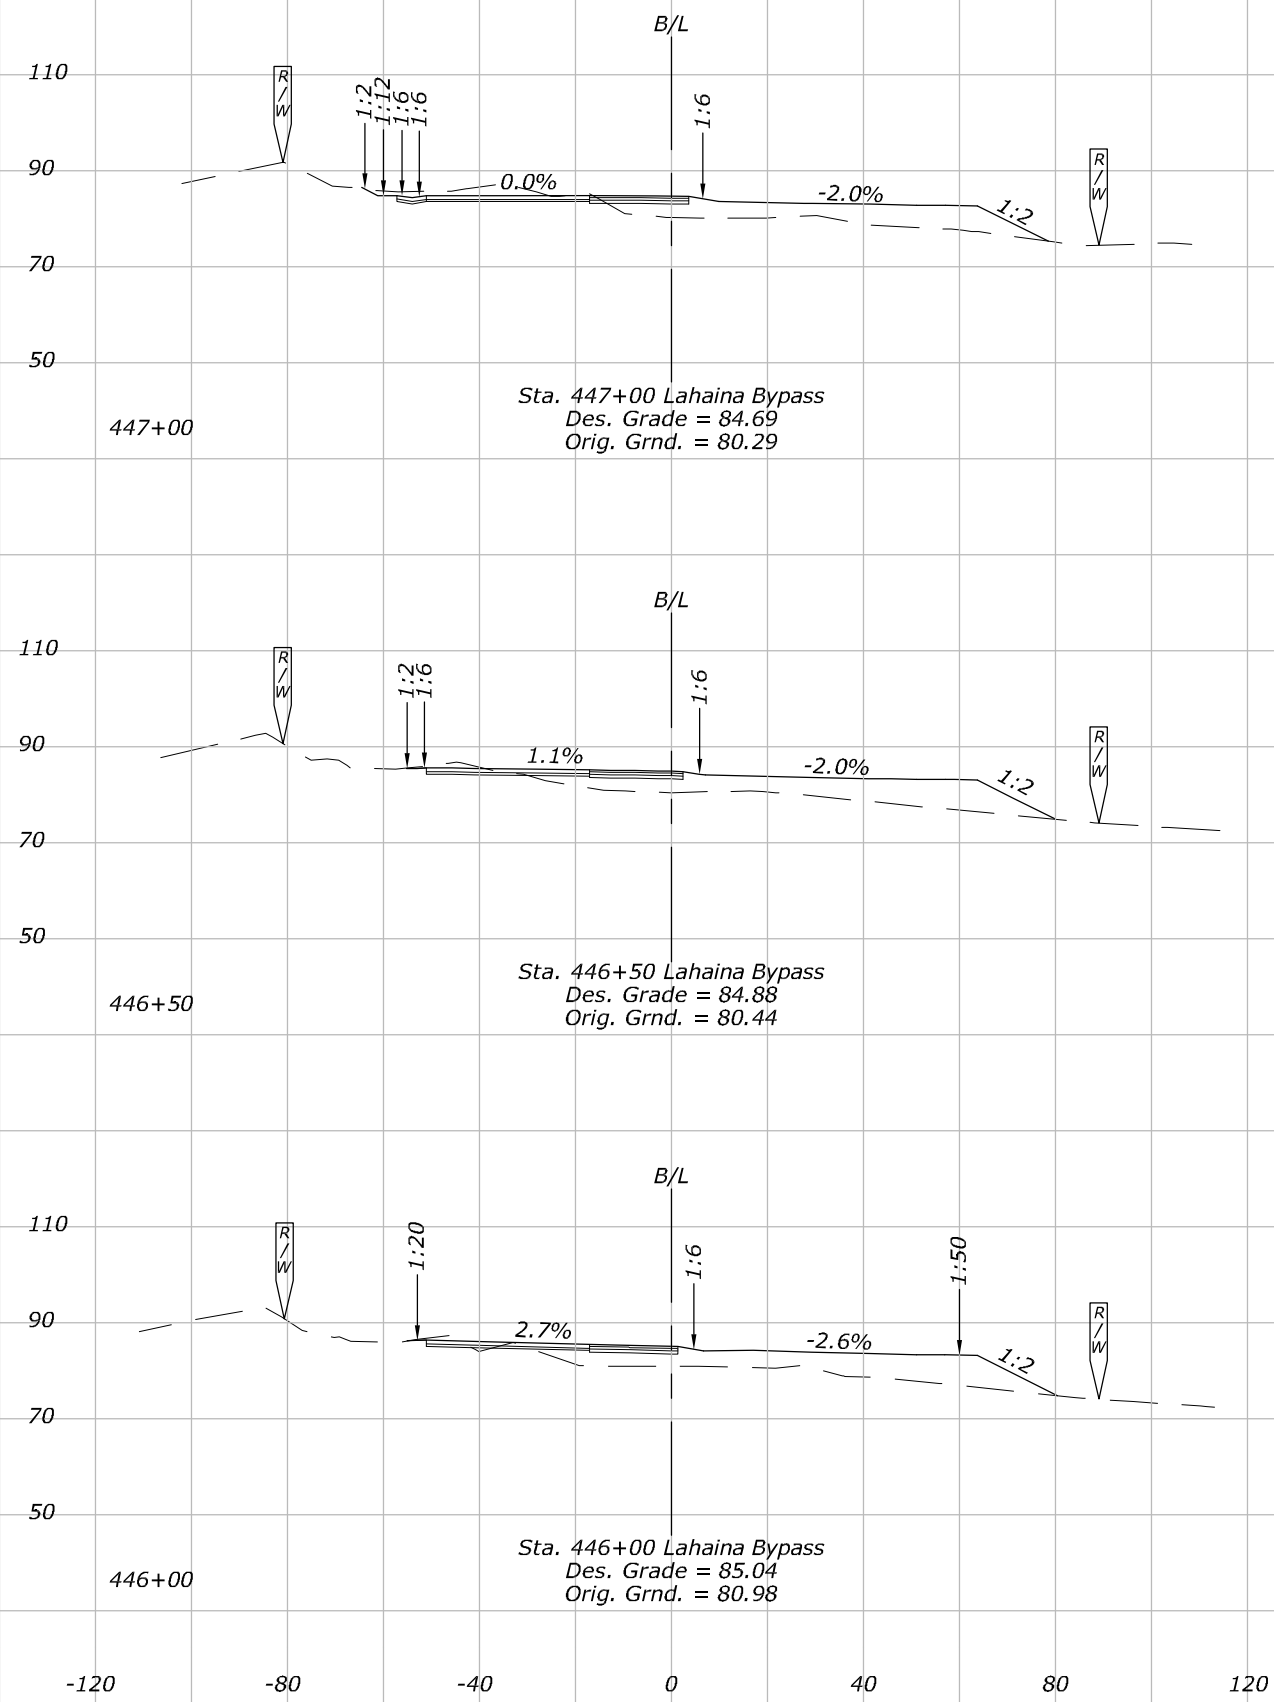

CROSS SECTIONS 446+00 TO 448+50

Patricia Choy

W:\102226-01\Civil\CADD\Site\AS-BUILT\DWGS\DRIVE_w\102226-01\Civil\CADD\Site\DWGS\X28 Cross Sections.dwg


14:47:18

January 11, 2019

NOTES:



1. Elevations Shown on Roadway
Sections are at 5'.

STATE	PROJECT	SHEET NO.
HI	HI STP SR 30(1)	X28

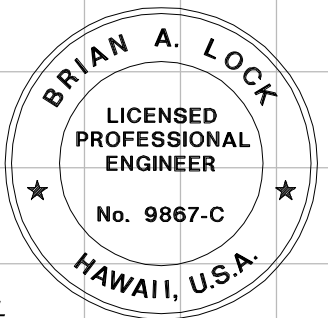

THIS WORK WAS PREPARED BY ME
OR UNDER MY SUPERVISION.

WILSON OKAMOTO CORPORATION
APRIL 30, 2020
LIC. EXP. DATE

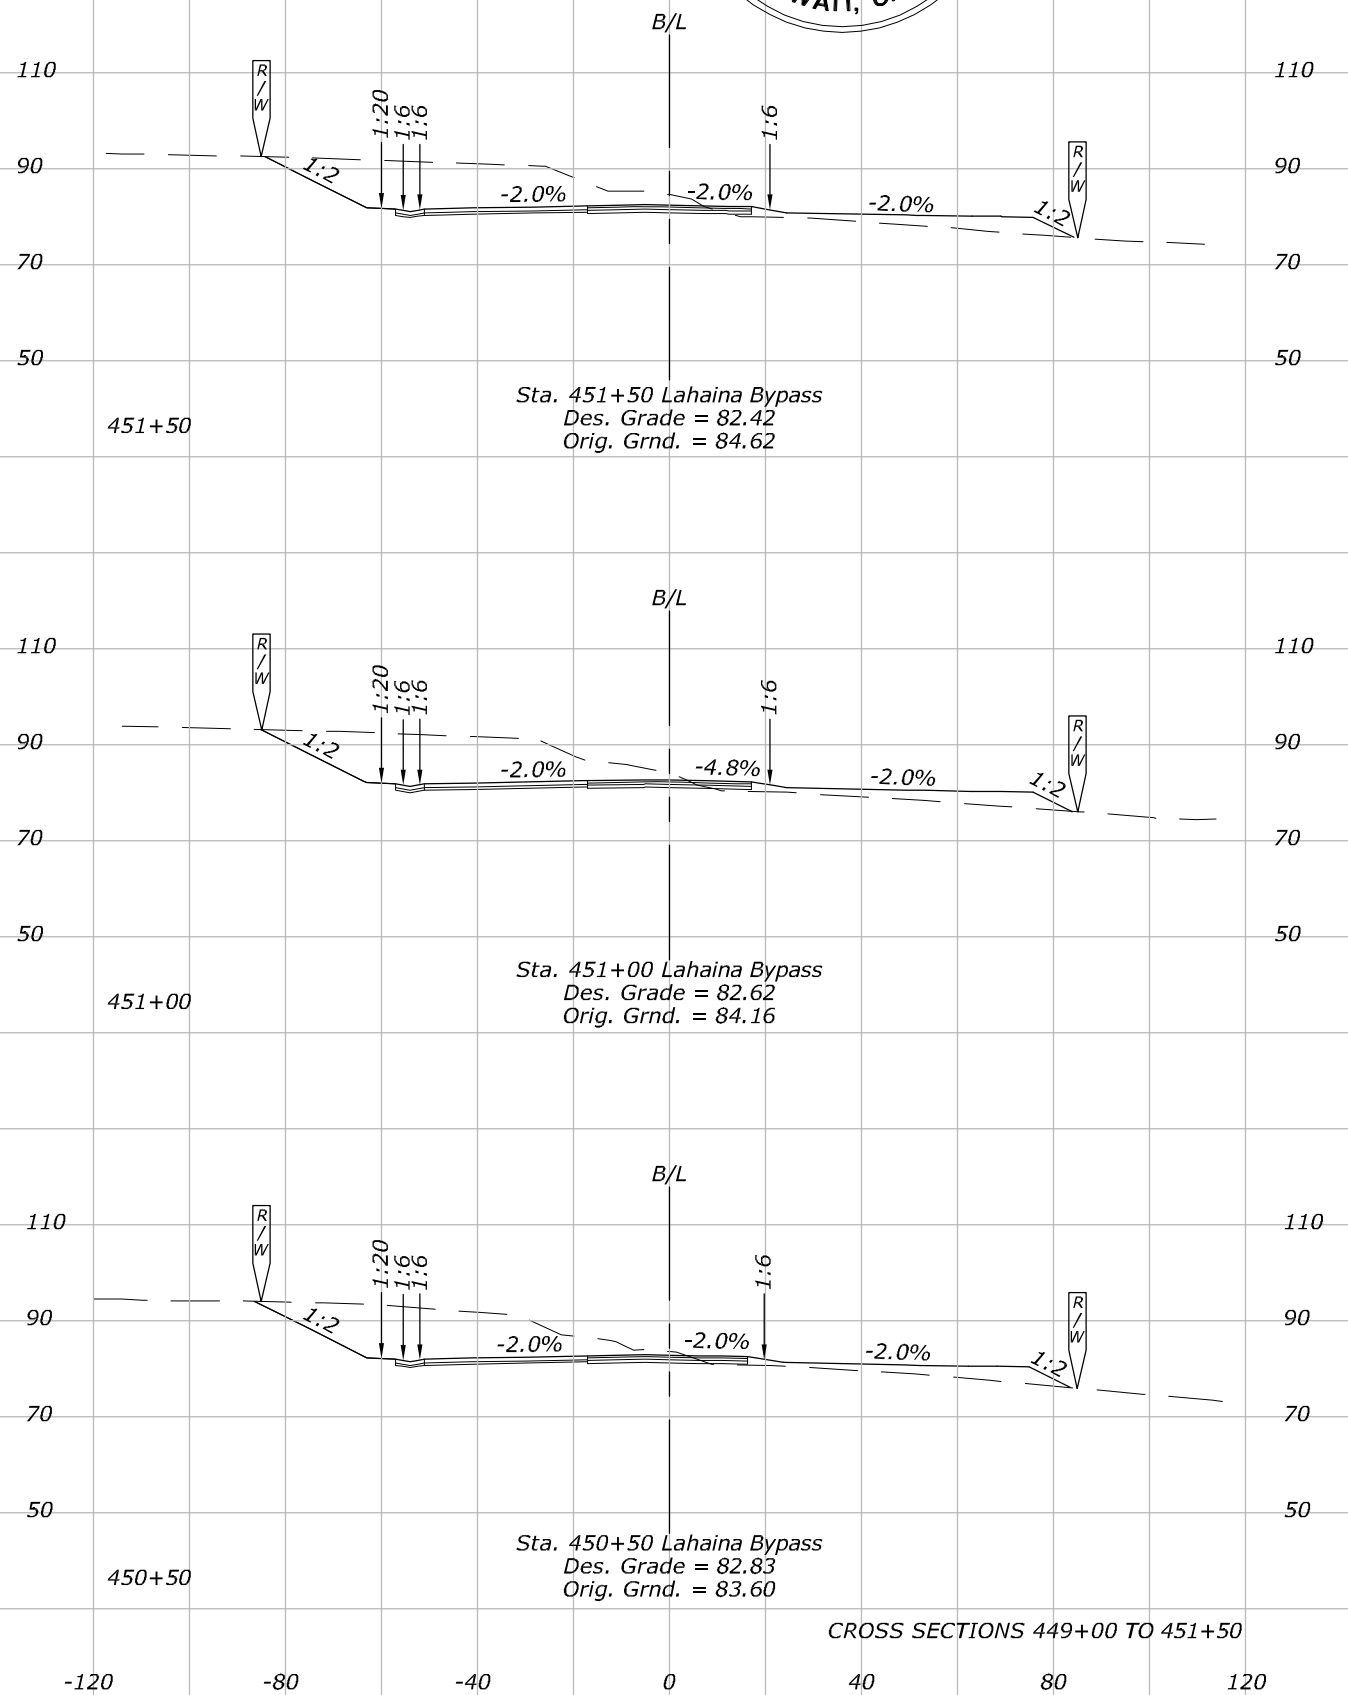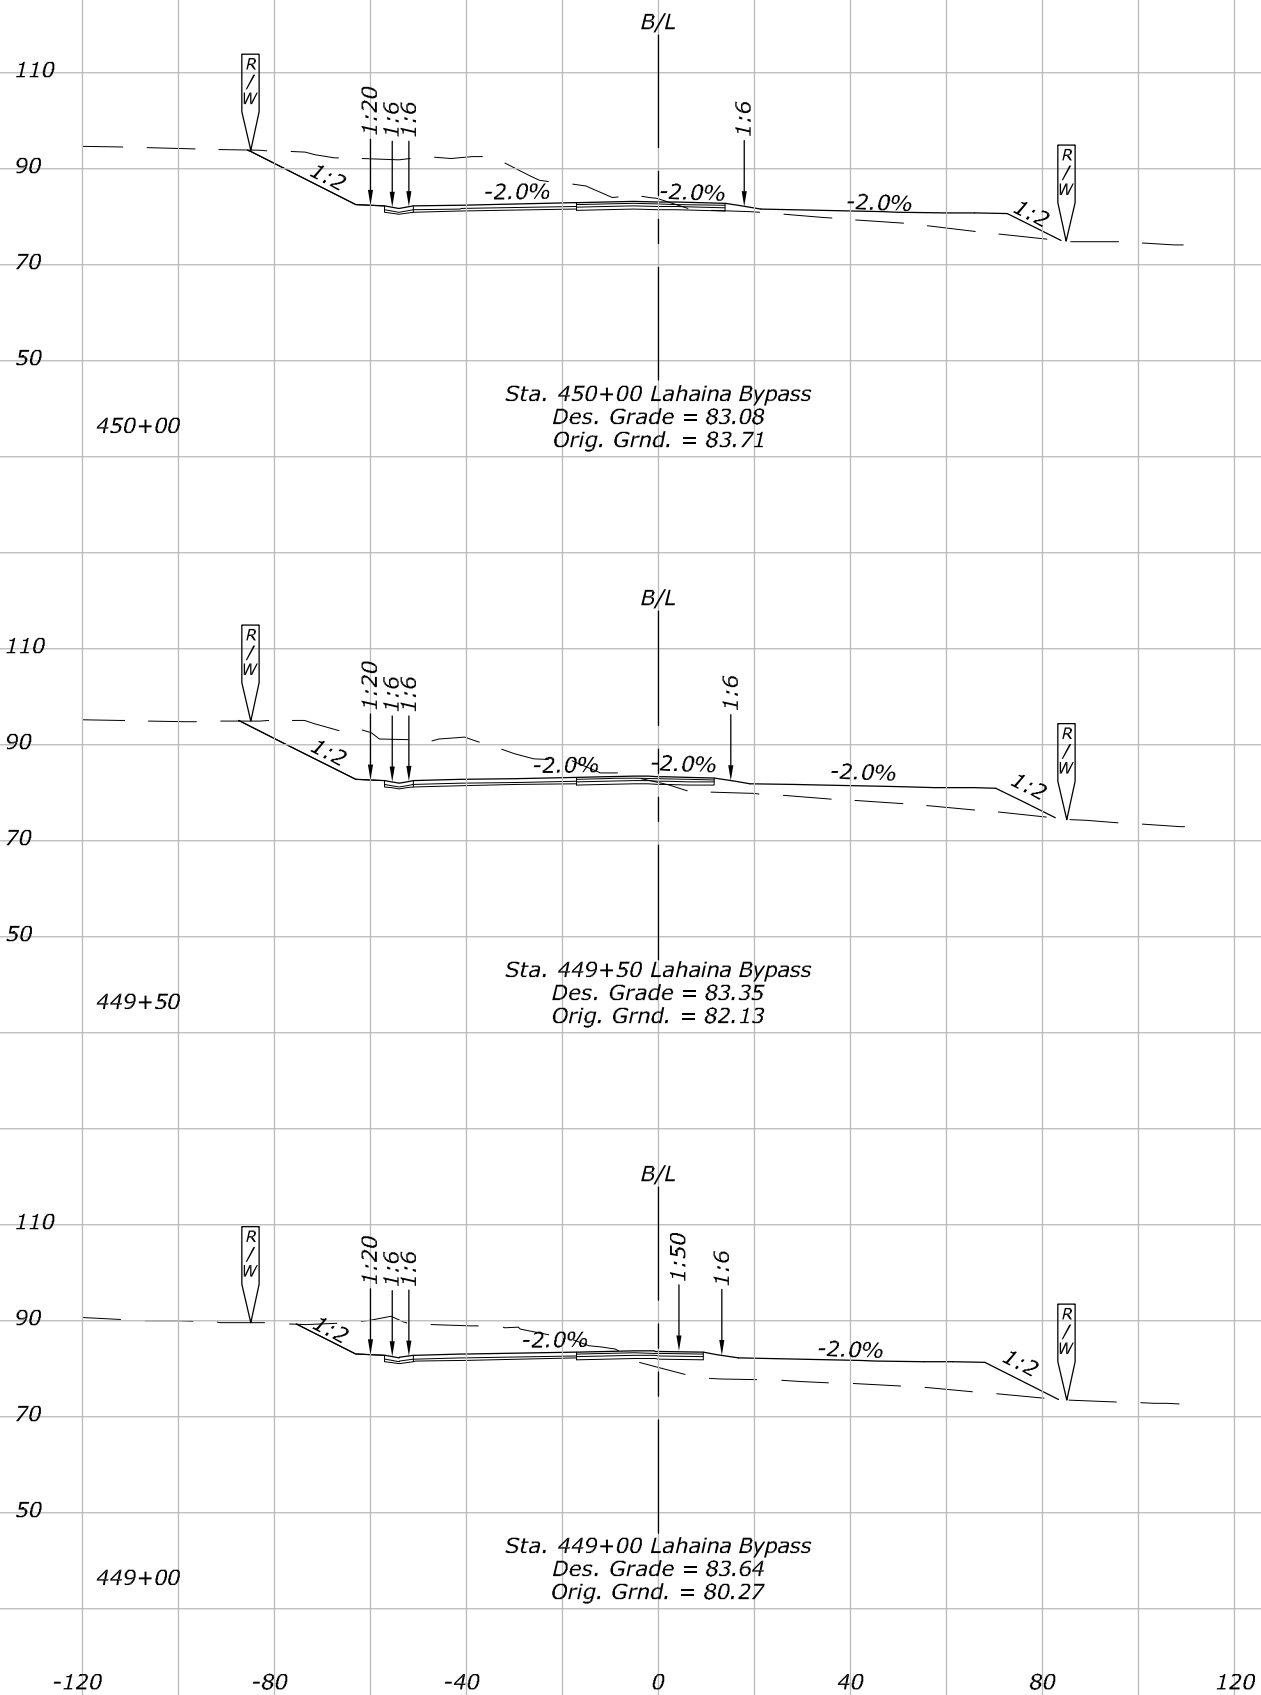

CROSS SECTIONS 449+00 TO 451+50

Patricia Choy

W:\102226-01\Civil\CADD\Site\DWGS\DRIVE_w\102226-01\Civil\CADD\Site\DWGS\X29 Cross Sections.dwg


14:48:46

January 11, 2019

NOTES:



1. Elevations Shown on Roadway
Sections are at 5'.

STATE	PROJECT	SHEET NO.
HI	HI STP SR 30(1)	X29

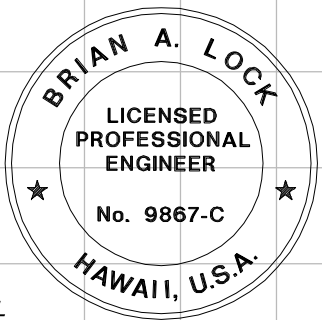

THIS WORK WAS PREPARED BY ME
OR UNDER MY SUPERVISION.

WILSON OKAMOTO CORPORATION
APRIL 30, 2020
LIC. EXP. DATE

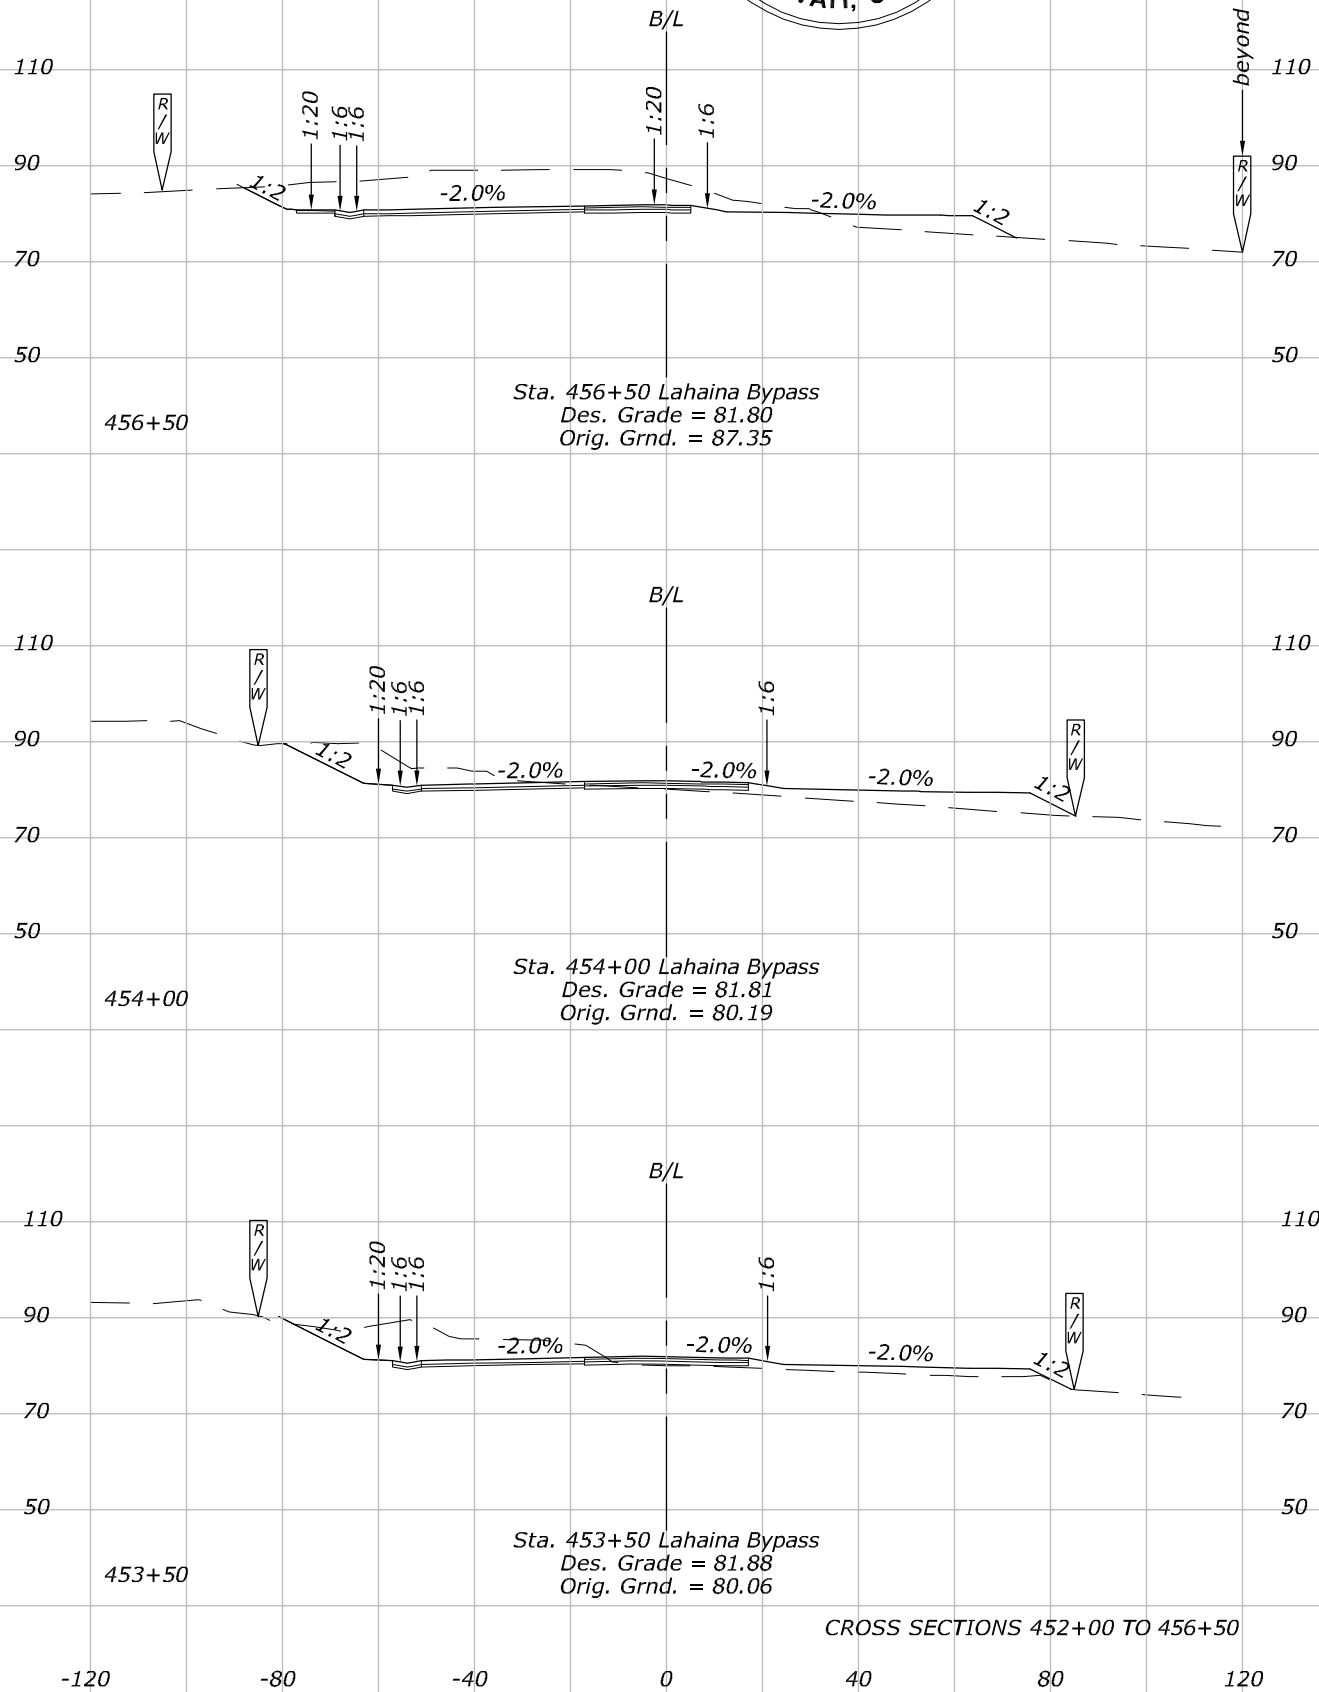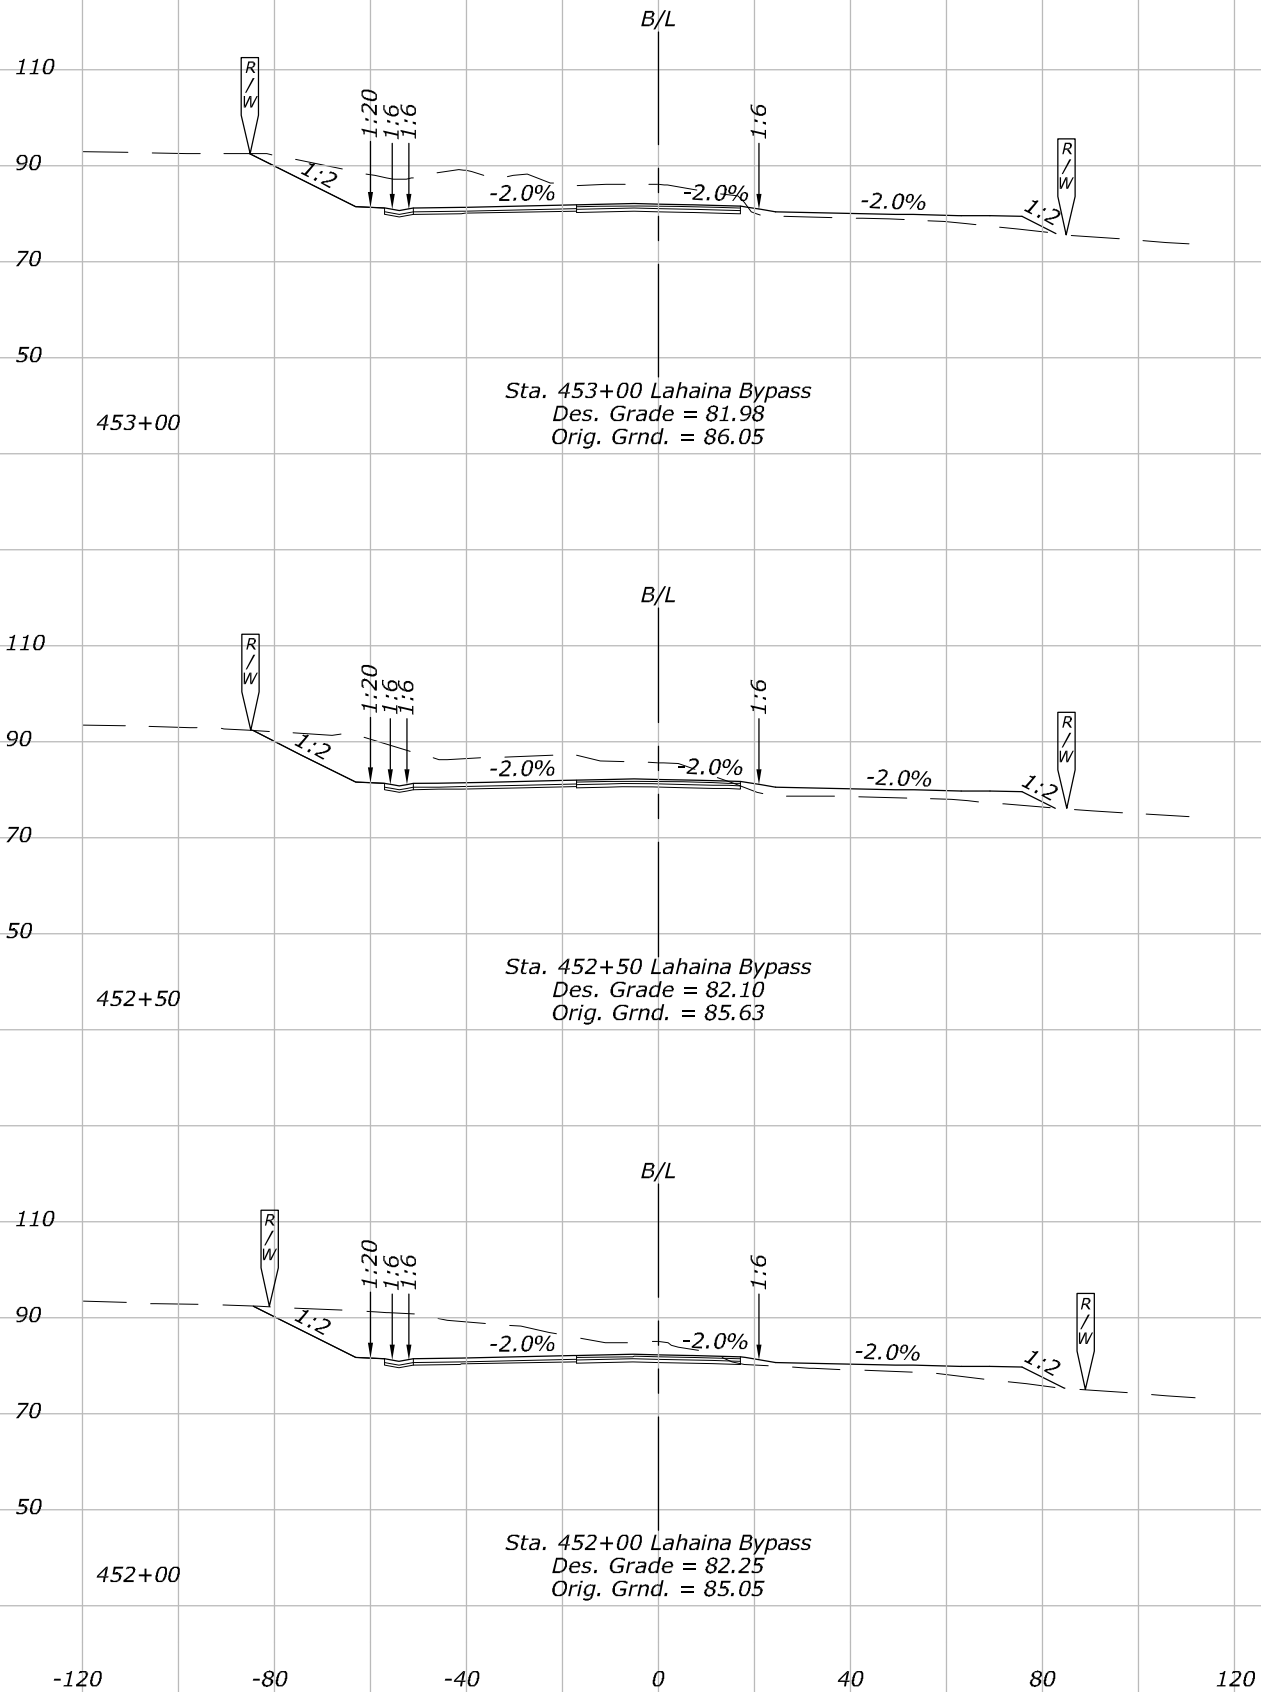

CROSS SECTIONS 452+00 TO 456+50

Patricia Choy

W:\10226-01\Civil\CADD\Site\AS-BUILT\DWGS\DRIVE_w\10226-01\Civil\CADD\Site\DWGS\X30 Cross Sections.dwg


14:50:06

January 11, 2019

NOTES:







1. Elevations Shown on Roadway Sections are at $\frac{1}{8}$.

STATE	PROJECT	SHEET NO.
HI	HI STP SR 30(1)	X30

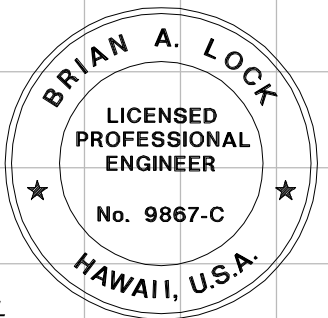

THIS WORK WAS PREPARED BY ME
OR UNDER MY SUPERVISION.

WILSON OKAMOTO CORPORATION
APRIL 30, 2020
LIC. EXP. DATE

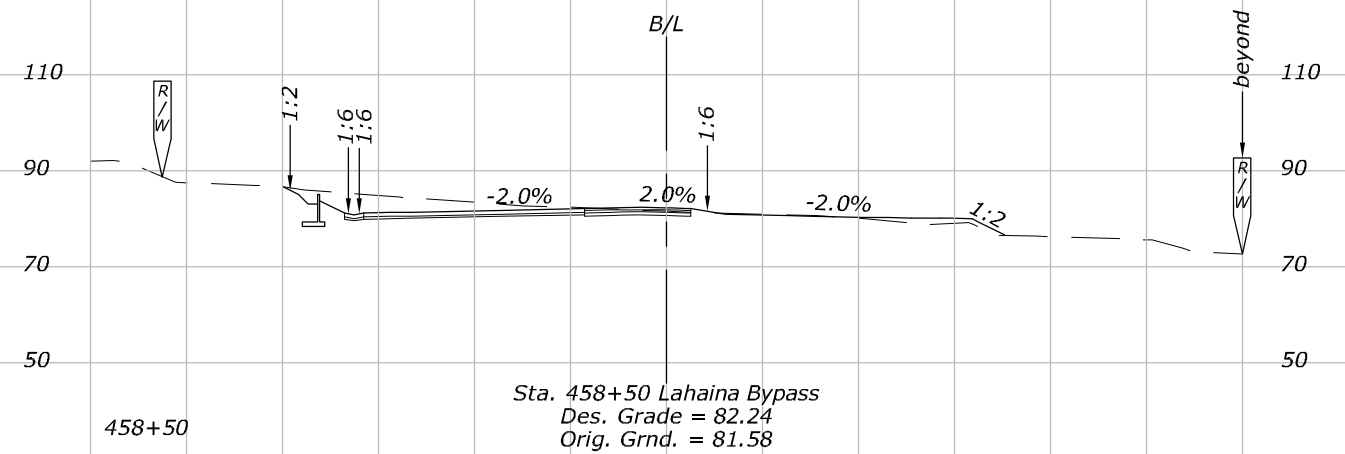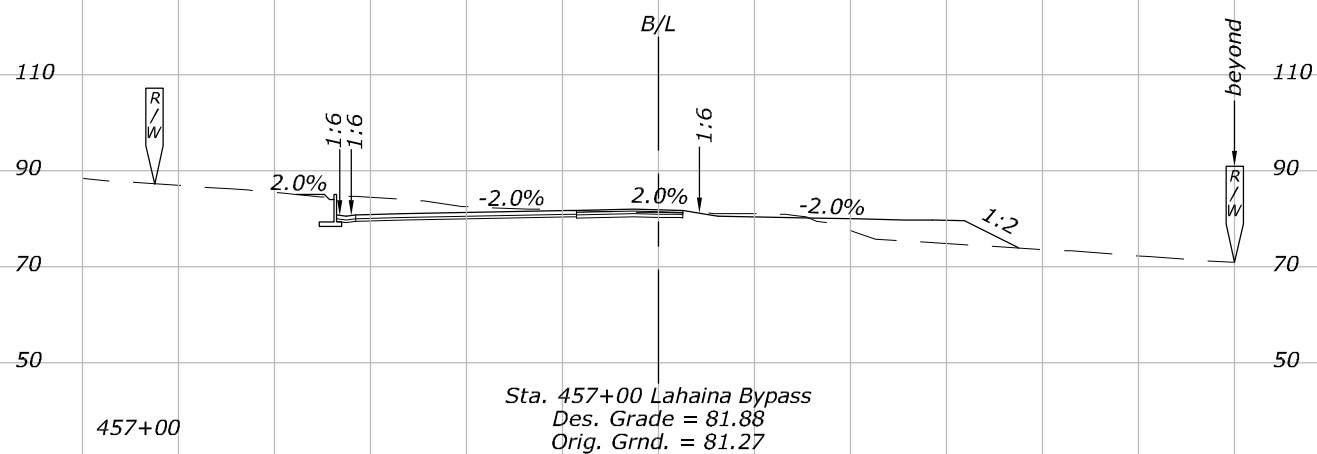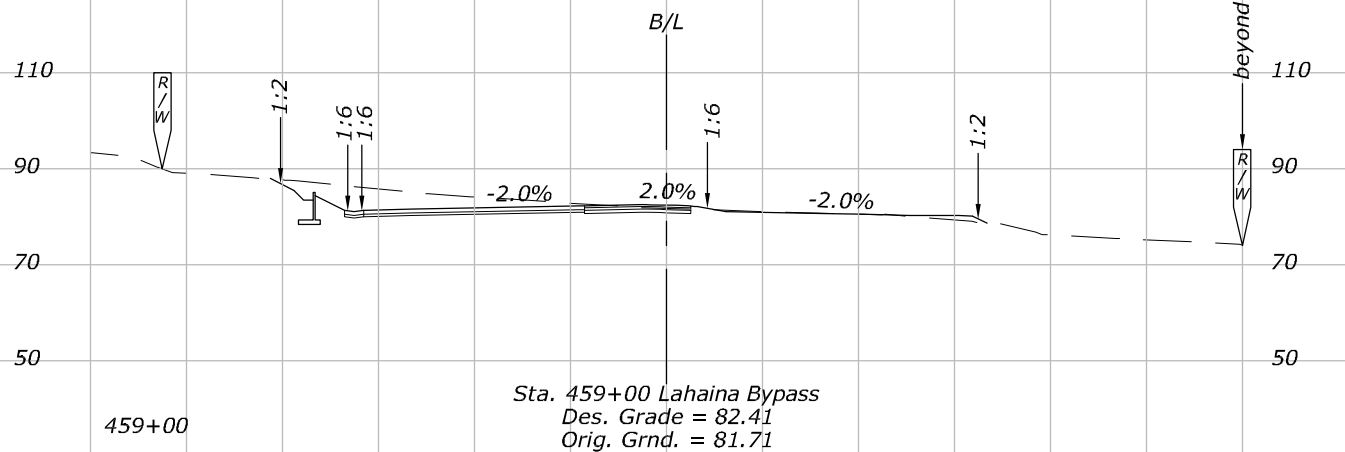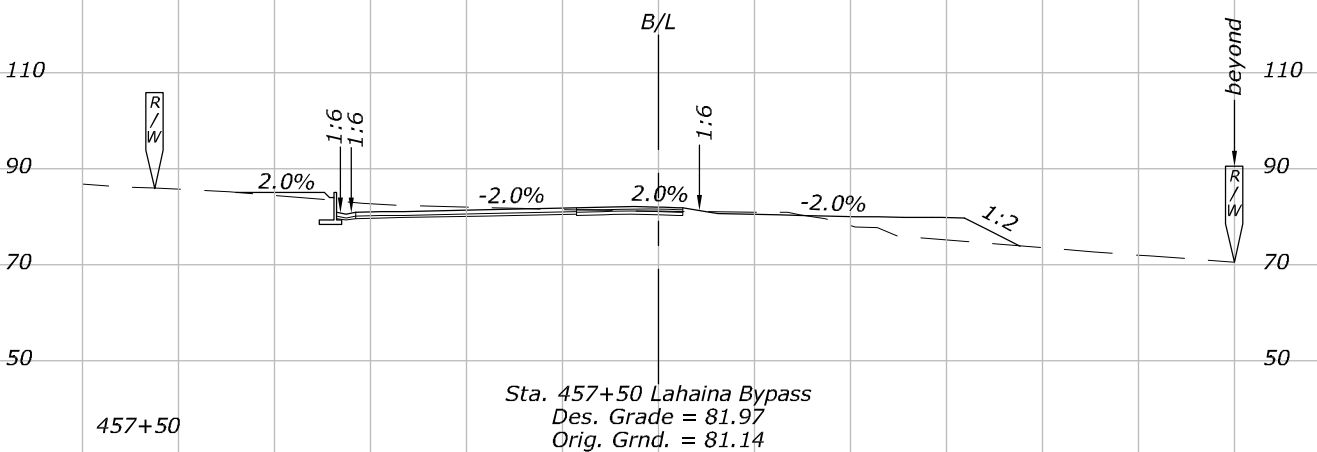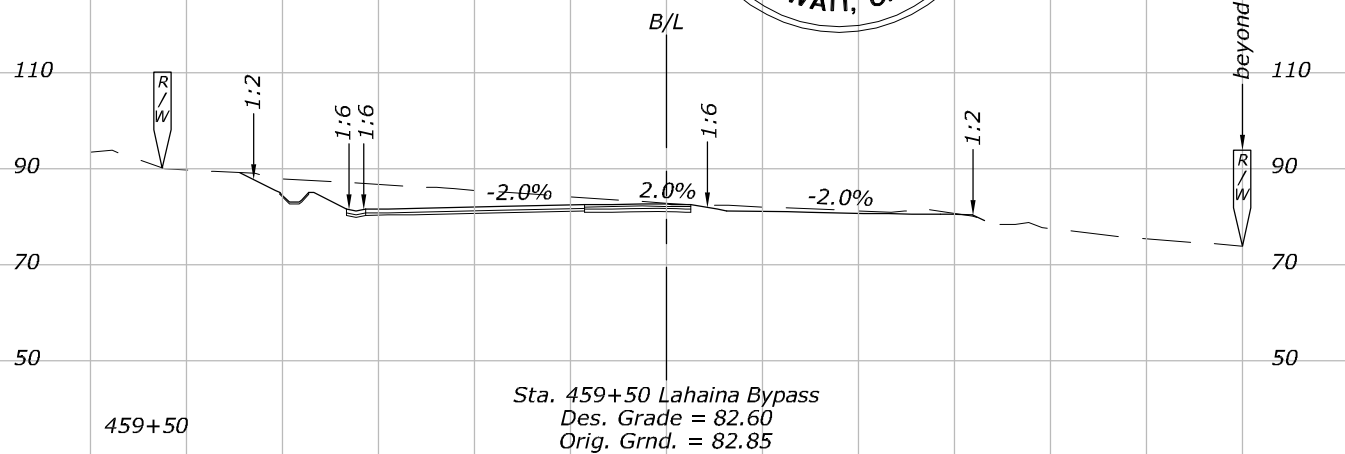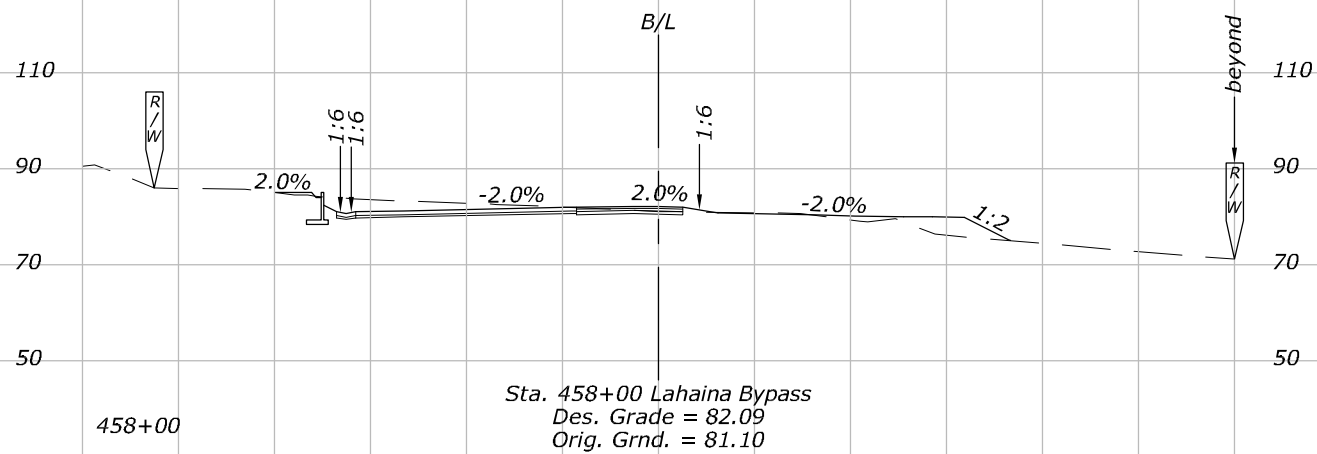

CROSS SECTIONS 457+00 TO 459+50

Patricia Choy

W:\10226-01\Civil\CADD\Site\AS-BUILT\DWGS\DRIVE_w\10226-01\Civil\CADD\Site\DWGS\X31 Cross Sections.dwg


14:52:13

January 11, 2019

NOTES:







1. Elevations Shown on Roadway
Sections are at 10'.

STATE	PROJECT	SHEET NO.
HI	HI STP SR 30(1)	X31

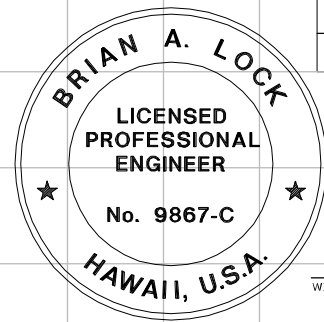

THIS WORK WAS PREPARED BY ME
OR UNDER MY SUPERVISION.

WILSON OKAMOTO CORPORATION
APRIL 30, 2020
LIC. EXP. DATE

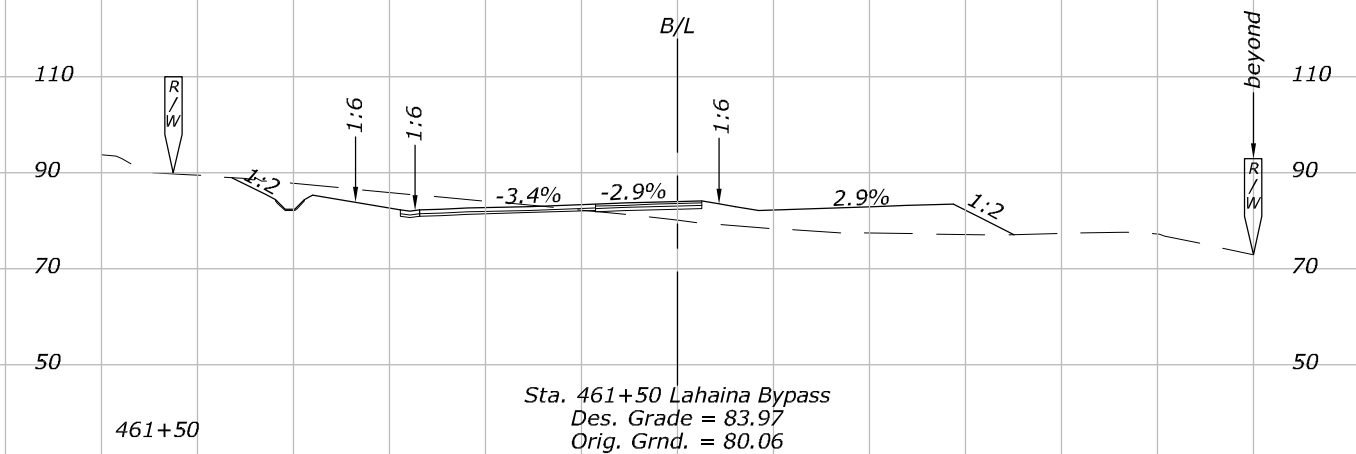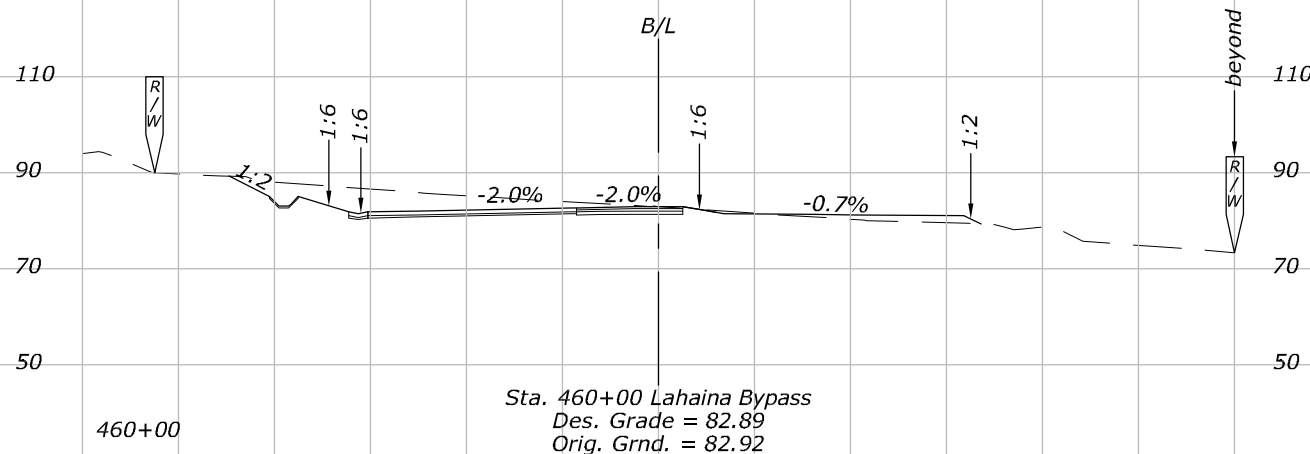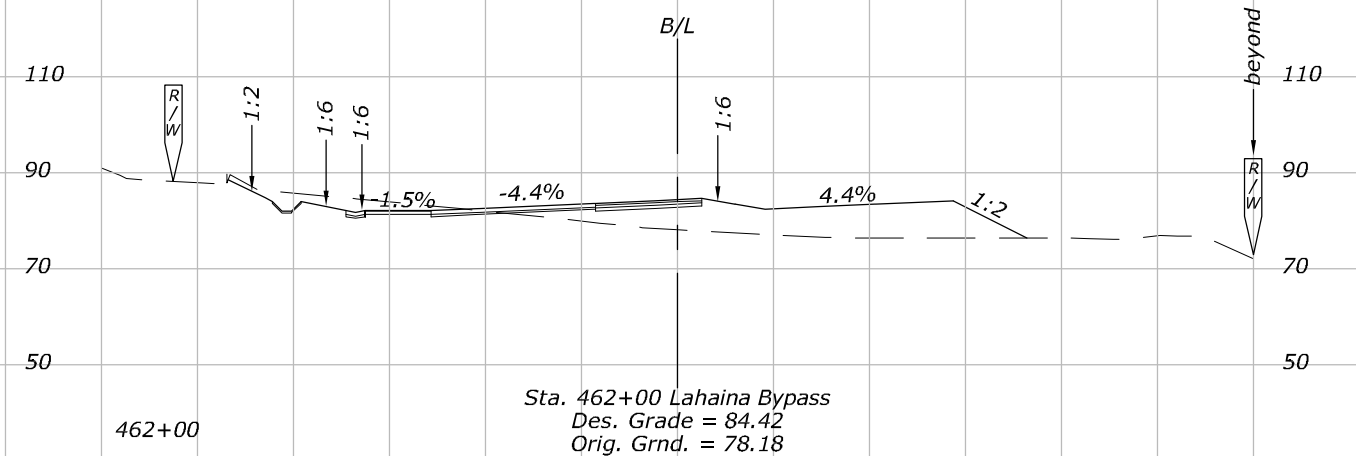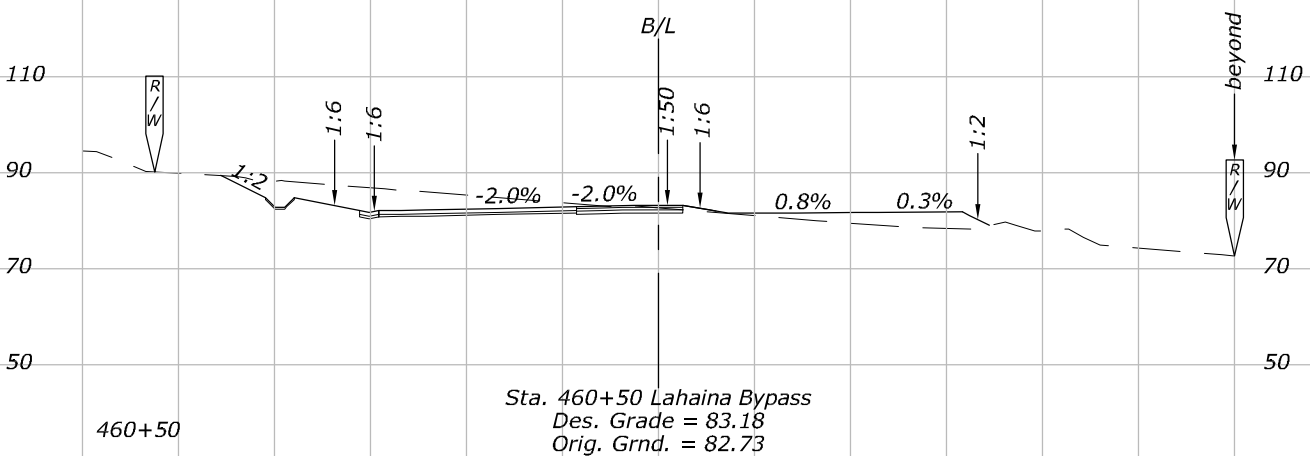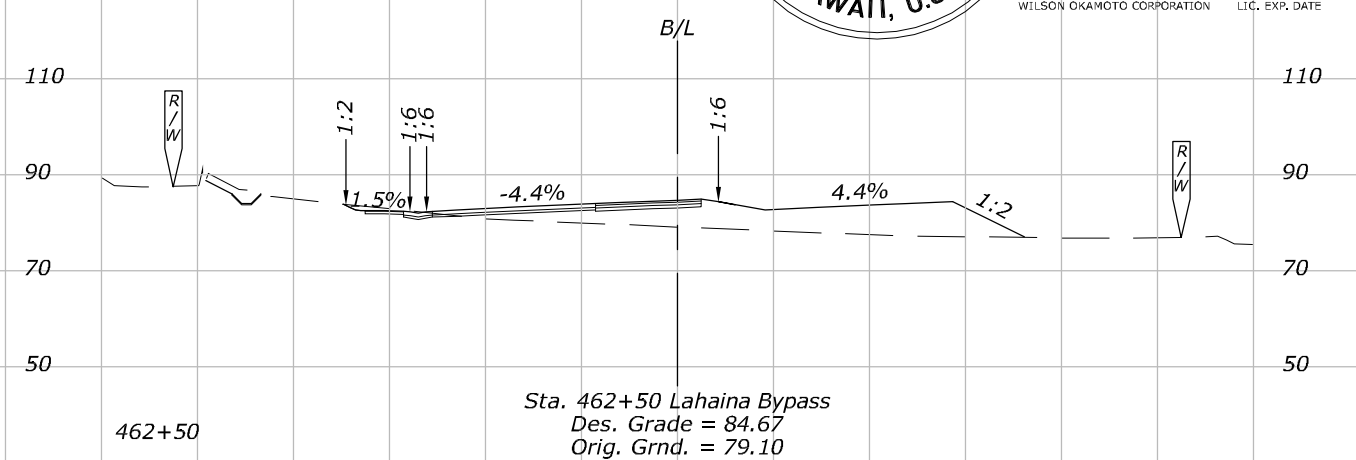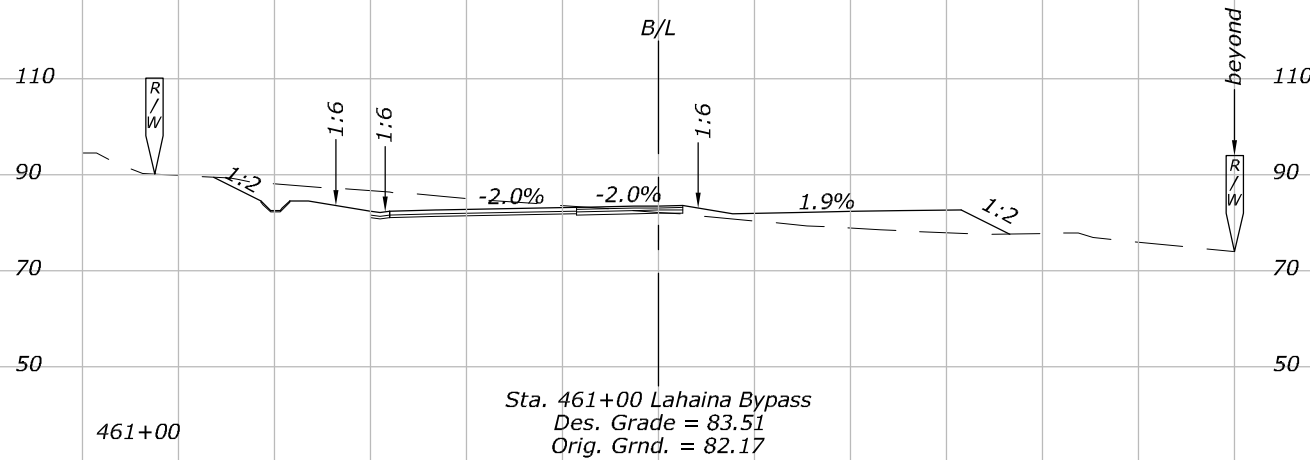

CROSS SECTIONS 460+00 TO 462+50

Patricia Choy

W:\10226-01\Civil\CADD\Site\AS-BUILT\DWGS\DRIVE_w\10226-01\Civil\CADD\Site\DWGS\X32 Cross Sections.dwg


14:52:56

January 11, 2019



NOTES:

1. Elevations Shown on Roadway
Sections are at 5'.

STATE	PROJECT	SHEET NO.
HI	HI STP SR 30(1)	X32

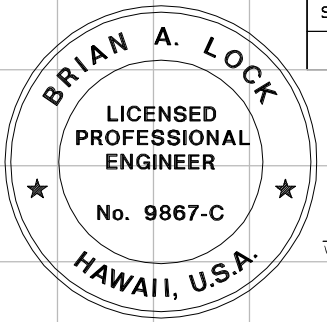

THIS WORK WAS PREPARED BY ME OR UNDER MY SUPERVISION.	APRIL 30, 2020 LIC. EXP. DATE
WILSON OKAMOTO CORPORATION	

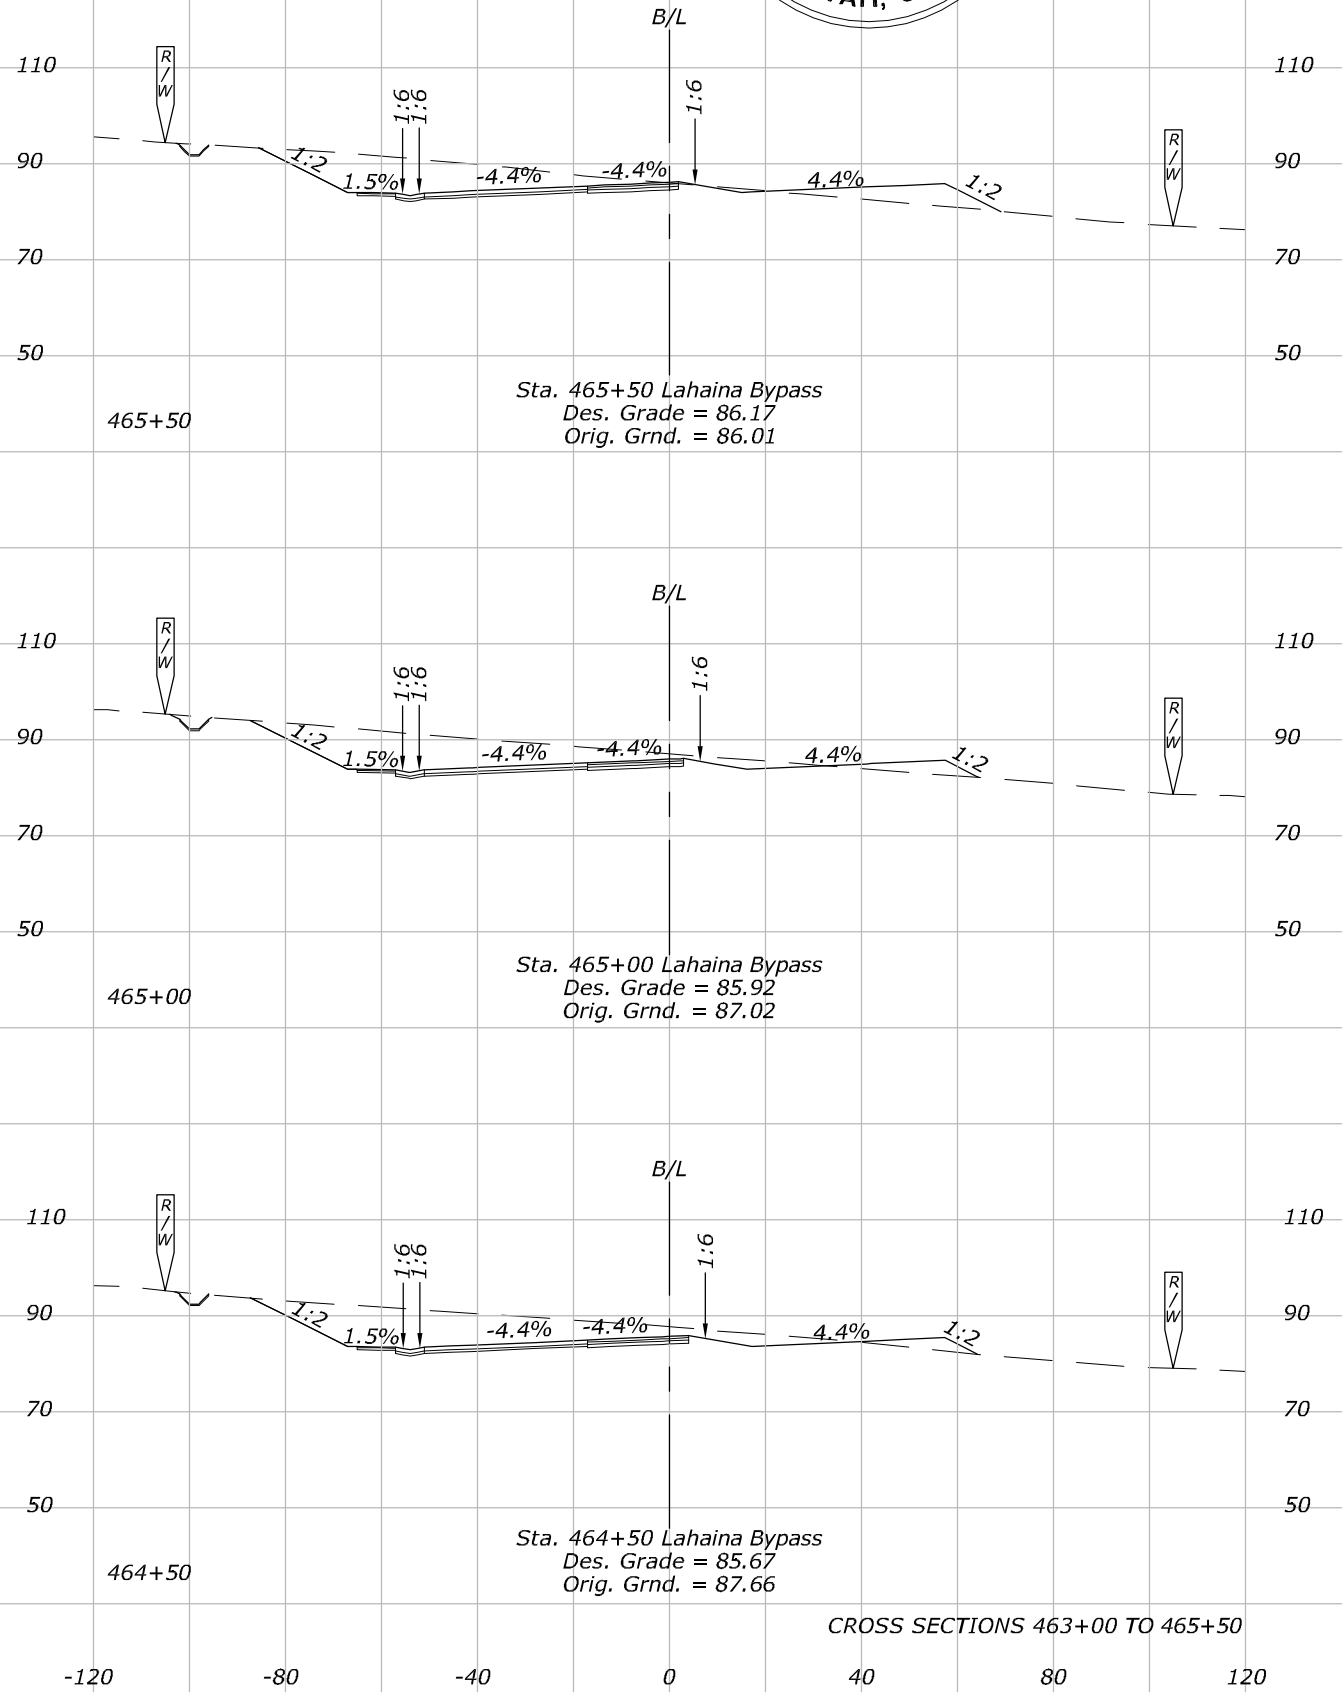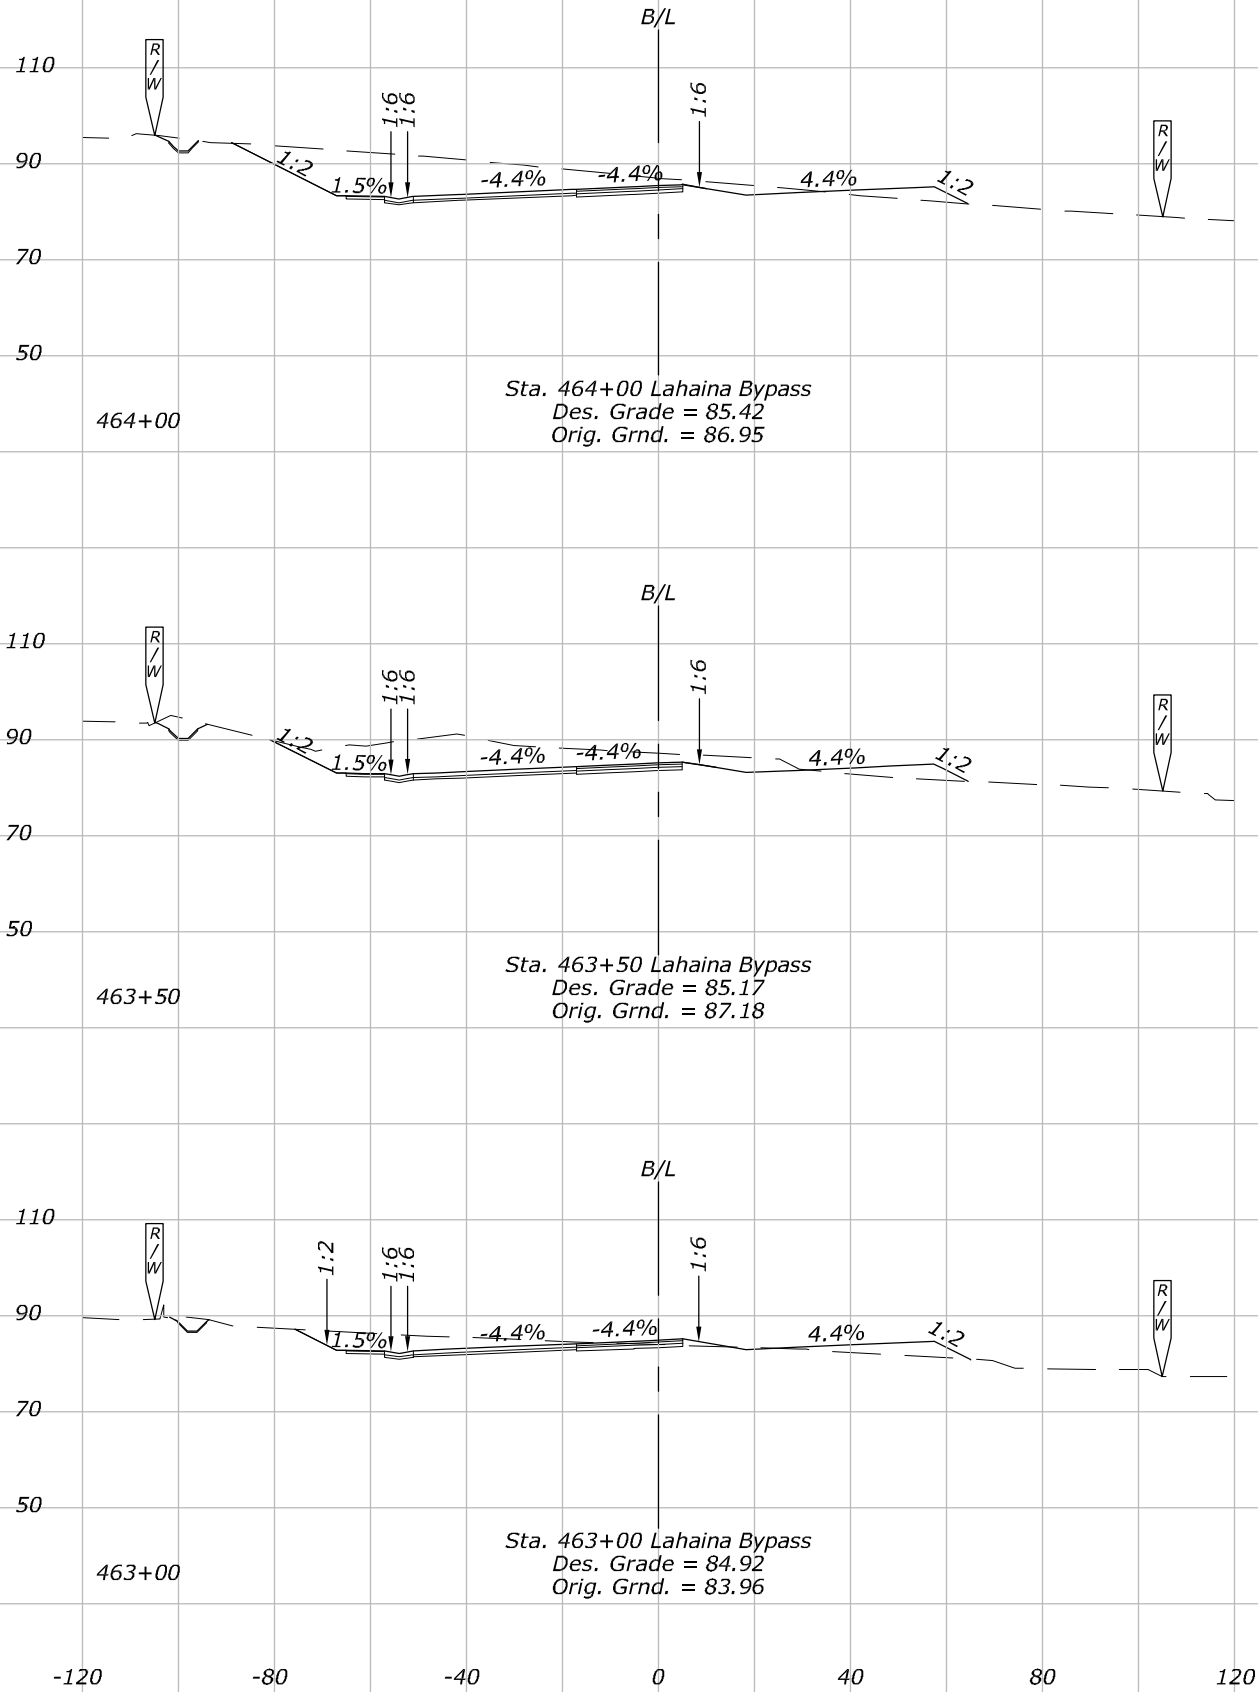

CROSS SECTIONS 463+00 TO 465+50

Patricia Choy

W:\102226-01\Civil\CADD\Site\DWGS\DRIVE - w\102226-01\Civil\CADD\Site\DWGS\X33 Cross Sections.dwg


14:54:08

January 11, 2019

NOTES:



1. Elevations Shown on Roadway
Sections are at 5'.

STATE	PROJECT	SHEET NO.
HI	HI STP SR 30(1)	X33

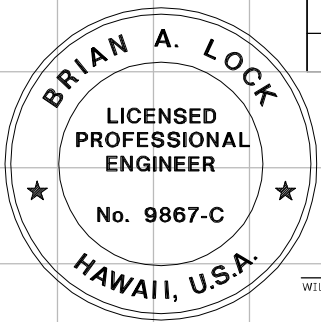

THIS WORK WAS PREPARED BY ME
OR UNDER MY SUPERVISION.

WILSON OKAMOTO CORPORATION
APRIL 30, 2020
LIC. EXP. DATE

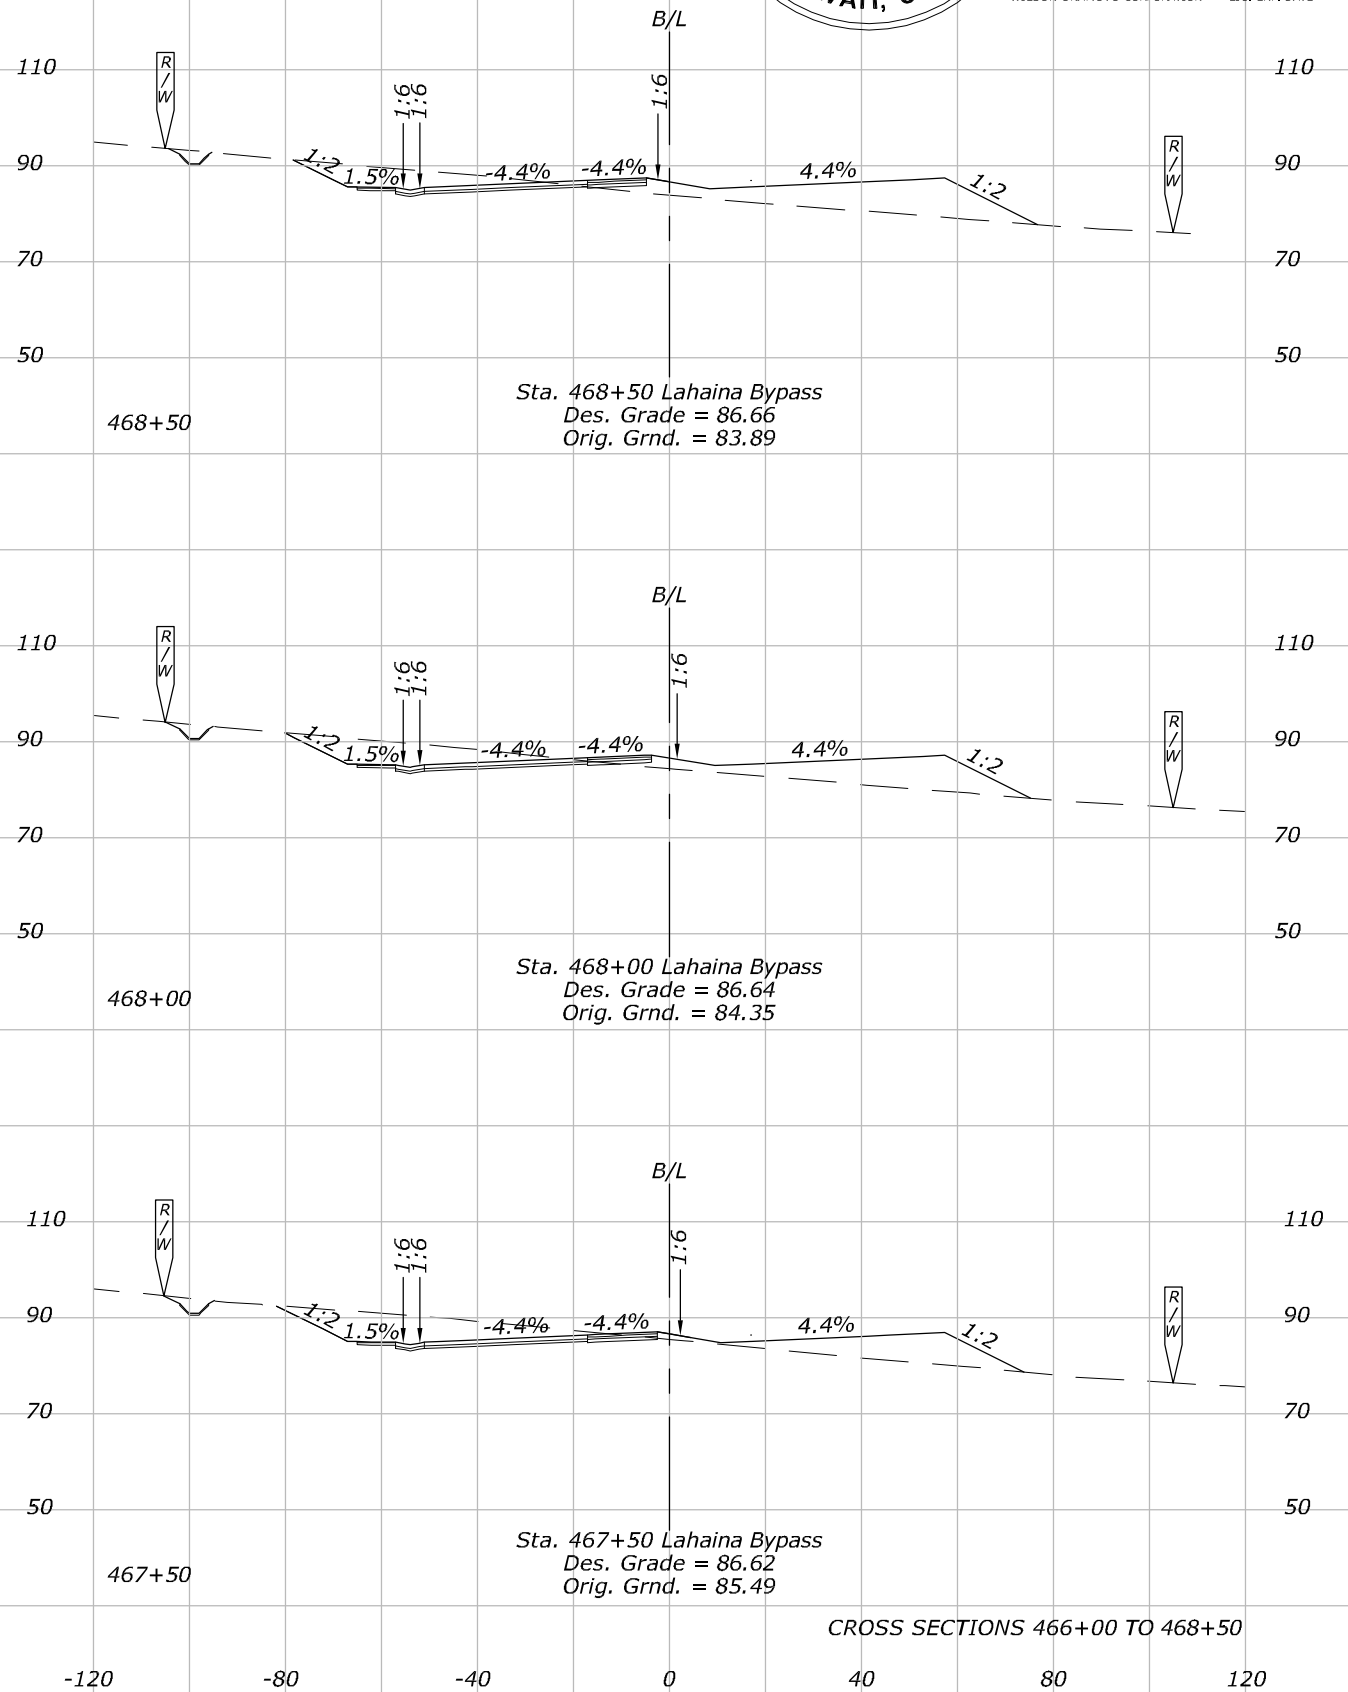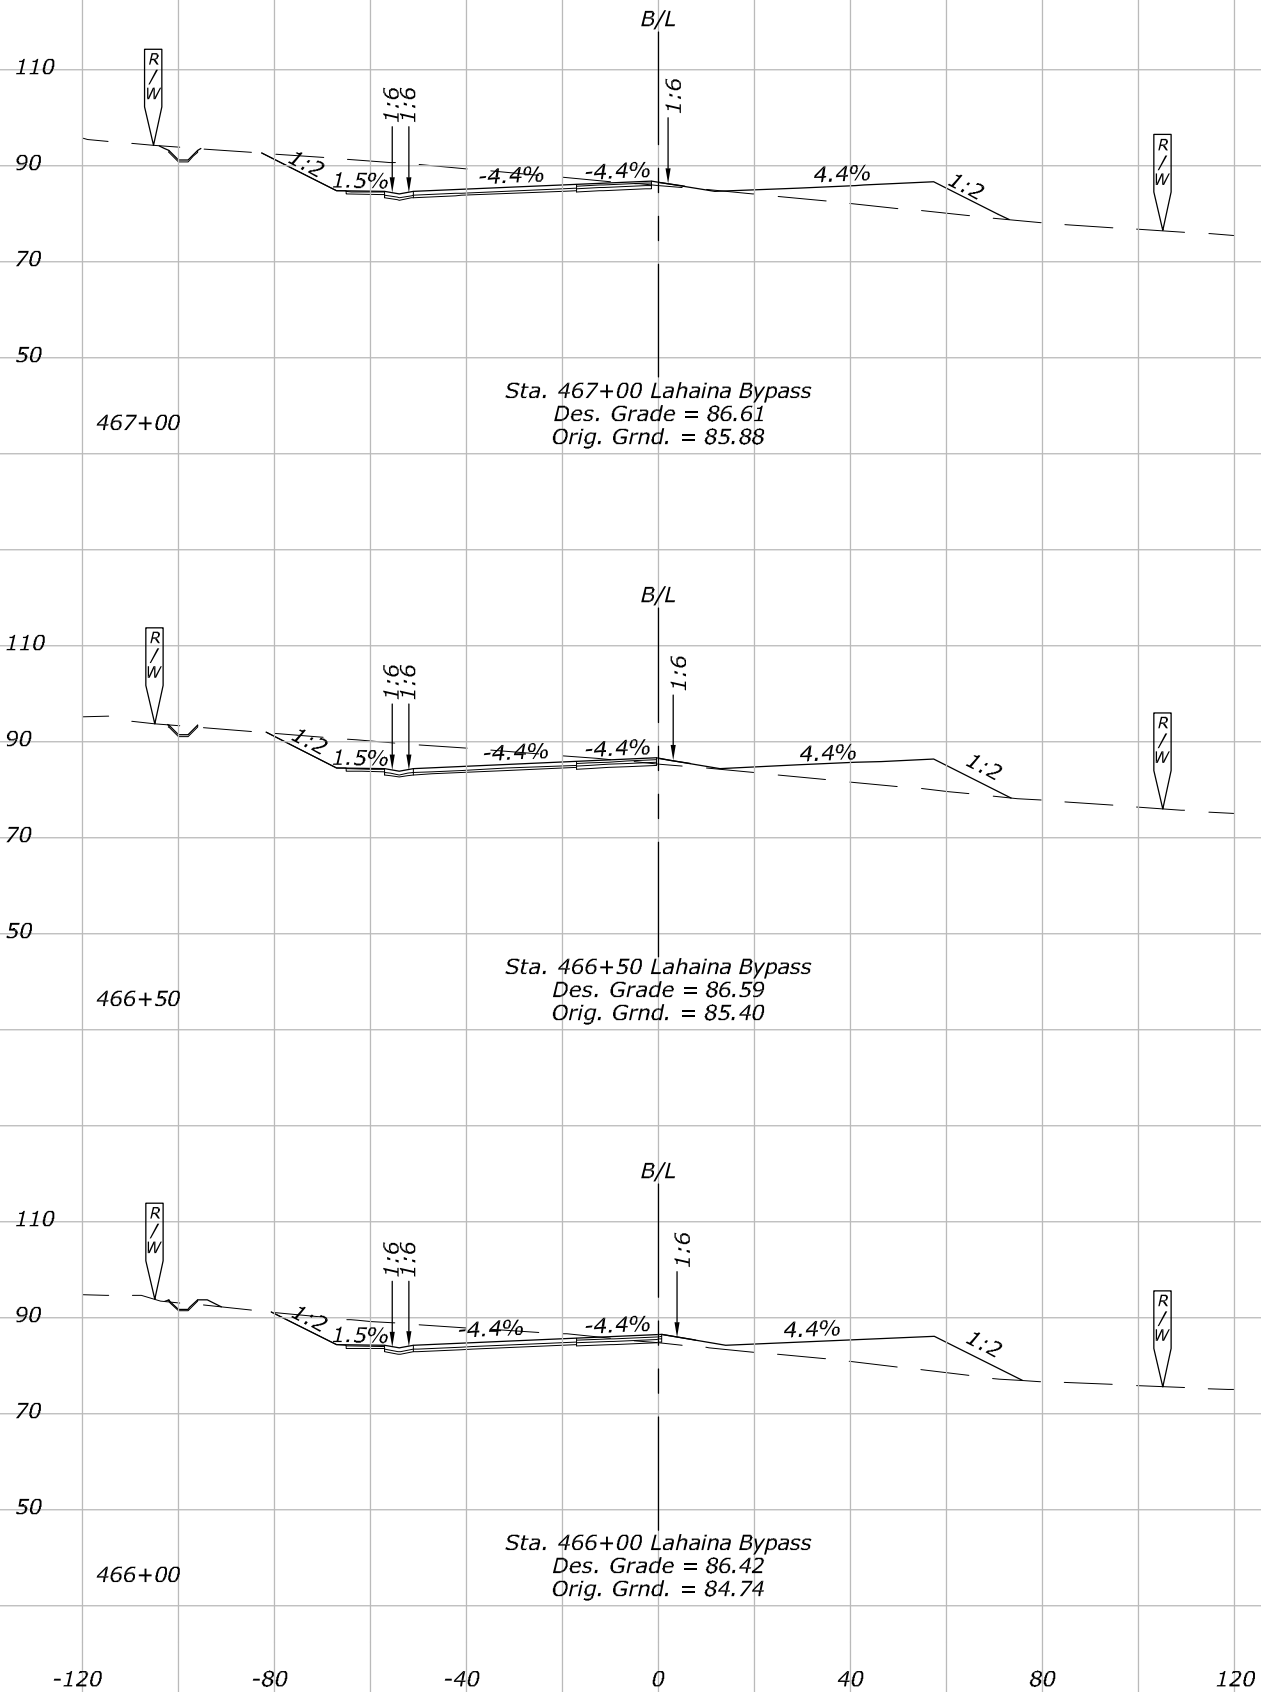

Patricia Choy

W:\10226-01\Civil\CADD\Site\AS-BUILT\DWGS\DRIVE_w\10226-01\Civil\CADD\Site\DWGS\X34 Cross Sections.dwg


14:55:52

January 11, 2019







NOTES:

1. Elevations Shown on Roadway
Sections are at 10'.

STATE	PROJECT	SHEET NO.
HI	HI STP SR 30(1)	X34

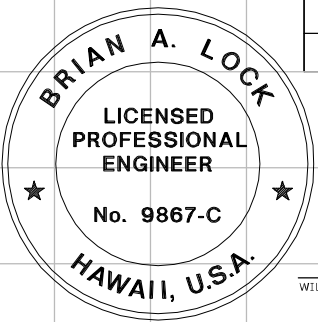

THIS WORK WAS PREPARED BY ME
OR UNDER MY SUPERVISION.
WILSON OKAMOTO CORPORATION
APRIL 30, 2020
LIC. EXP. DATE

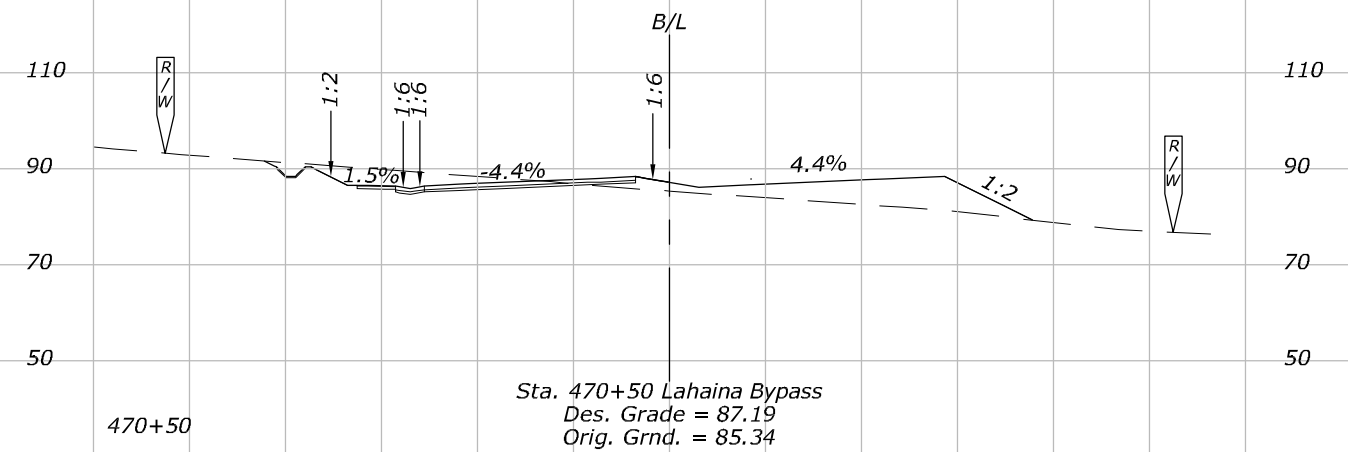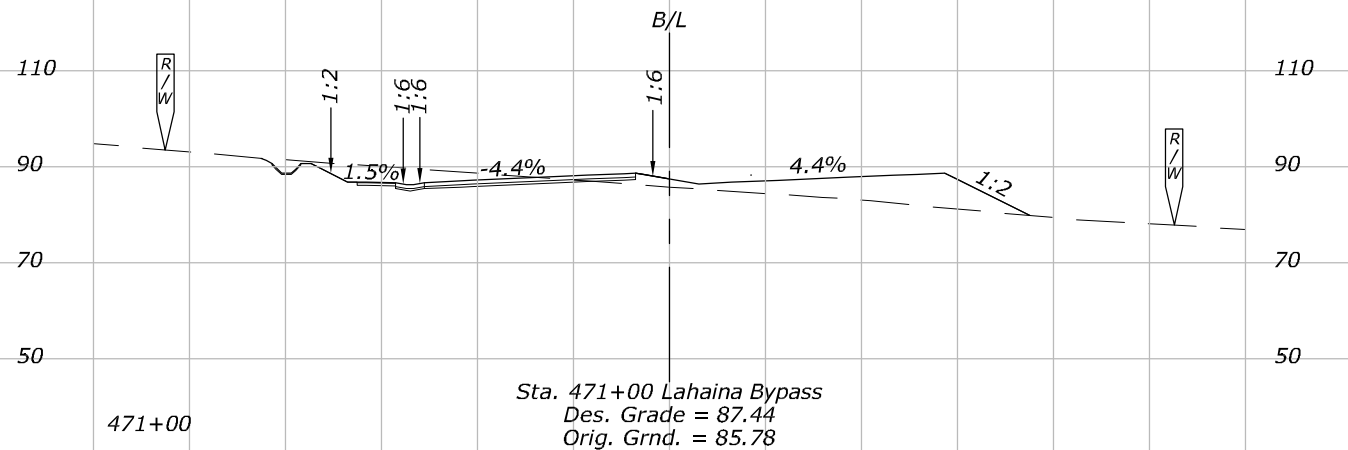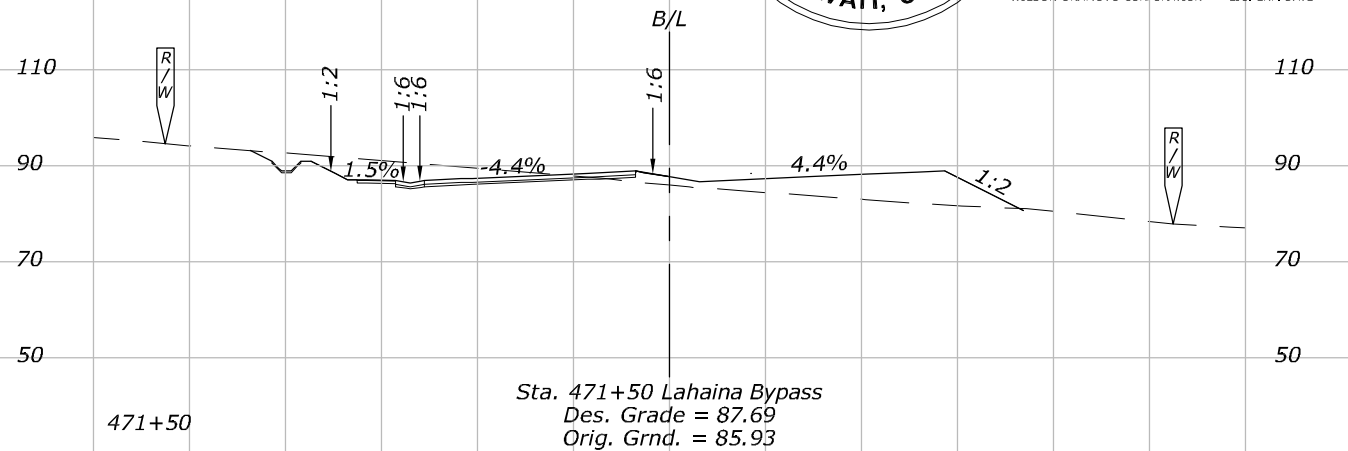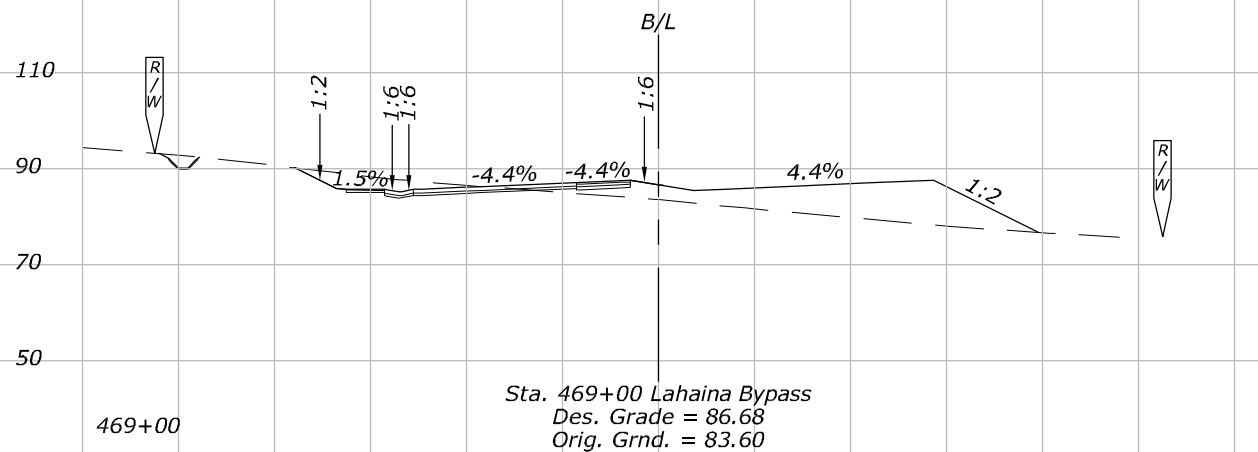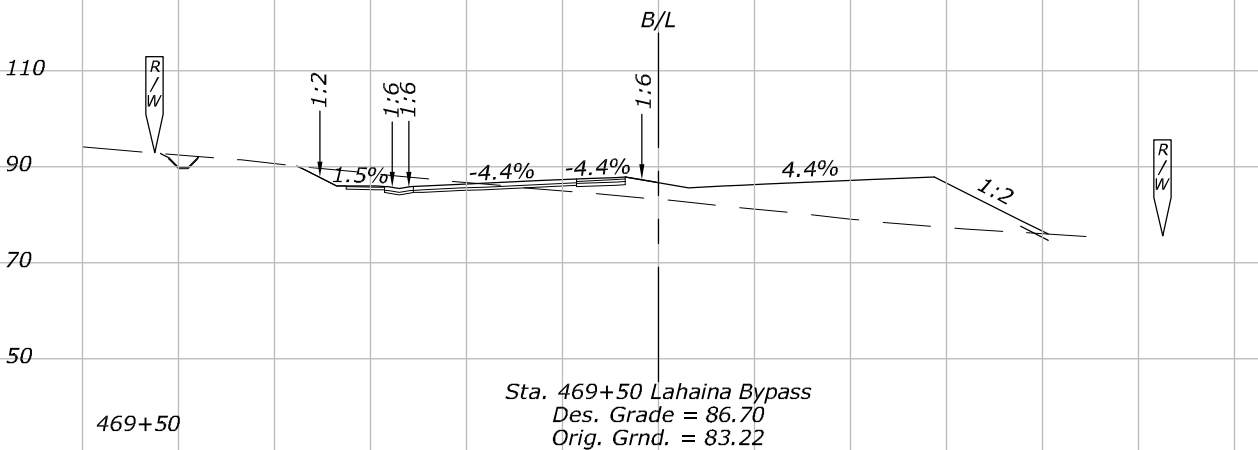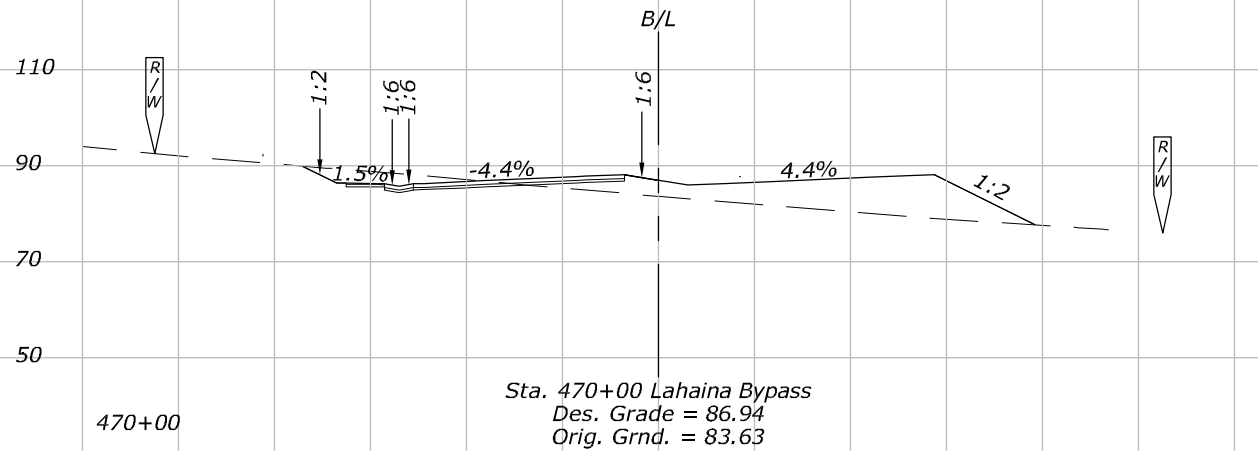

CROSS SECTIONS 469+00 TO 471+50

Patricia Choy

W:\102226-01\Civil\CADD\Site\AS-BUILT\DWGS\DRIVE_w\102226-01\Civil\CADD\Site\DWGS\X35 Cross Sections.dwg


14:56:53

January 11, 2019







NOTES:

1. Elevations Shown on Roadway
Sections are at 5'.

STATE	PROJECT	SHEET NO.
HI	HI STP SR 30(1)	X35

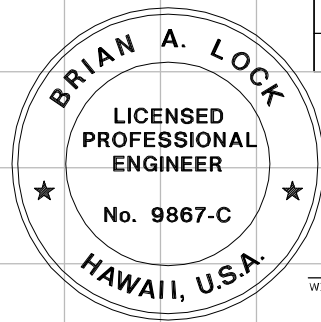

THIS WORK WAS PREPARED BY ME
OR UNDER MY SUPERVISION.
WILSON OKAMOTO CORPORATION
APRIL 30, 2020
LIC. EXP. DATE

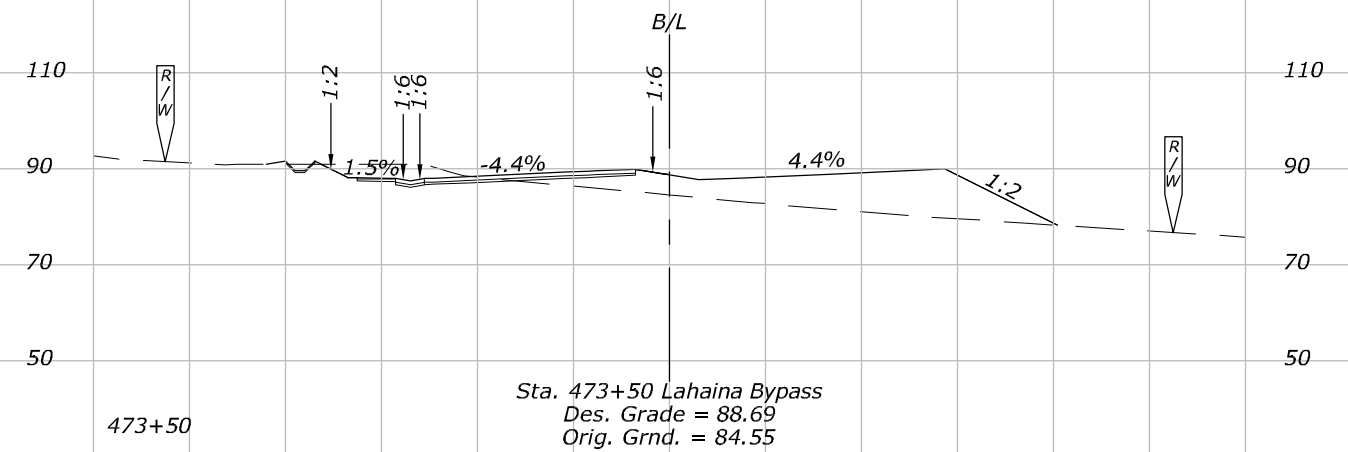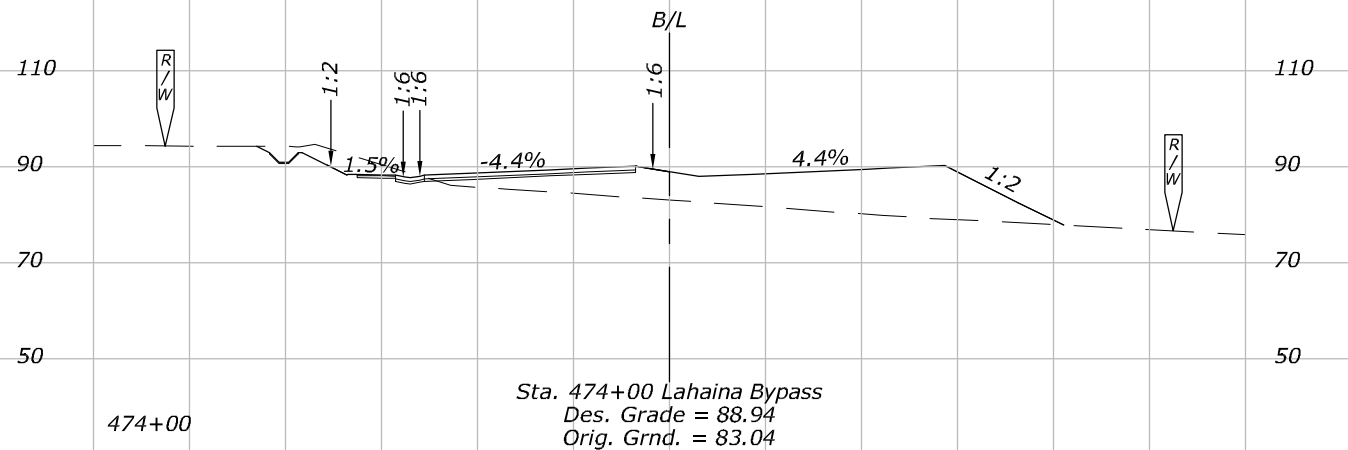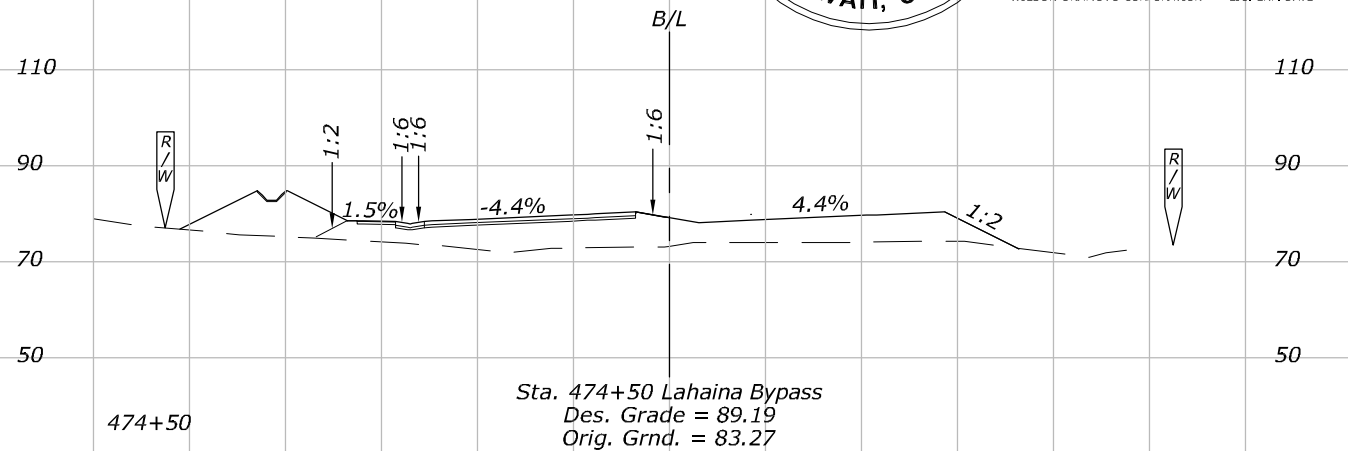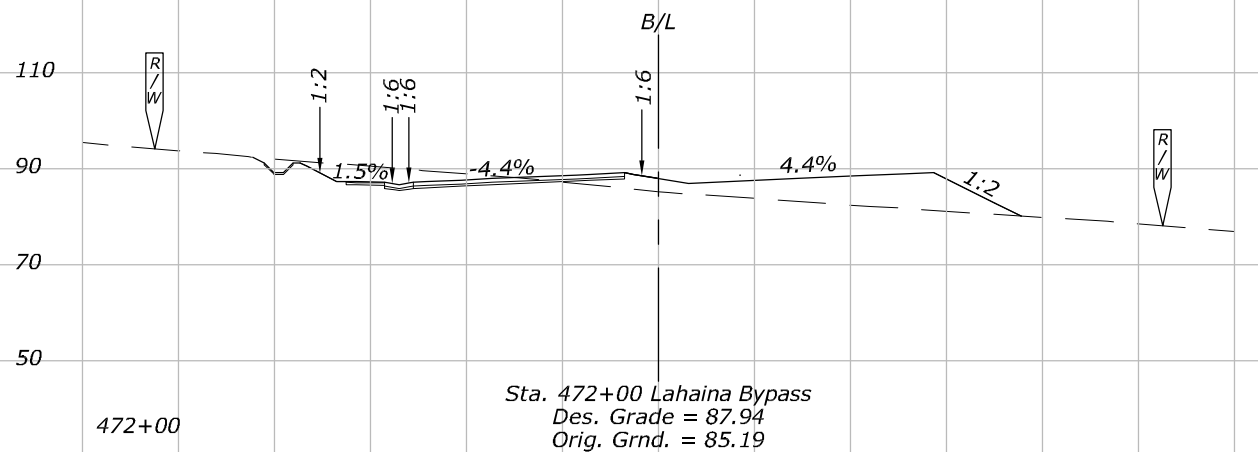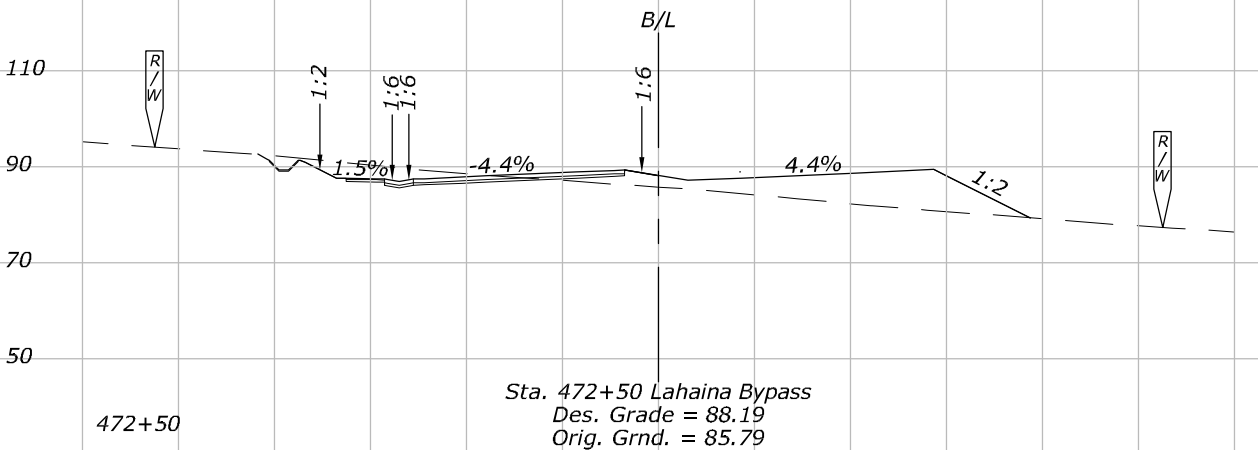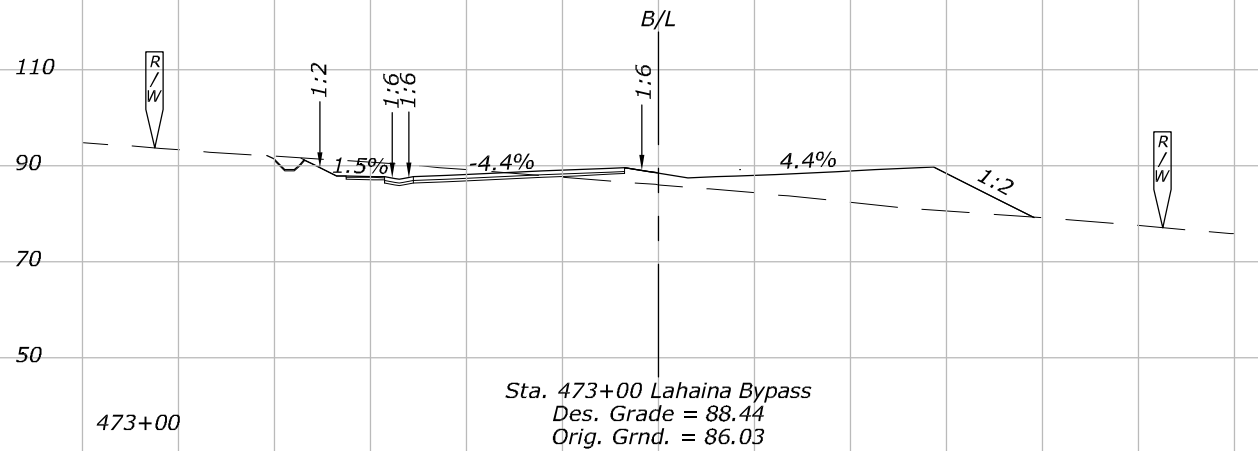

CROSS SECTIONS 472+00 TO 474+50

Patricia Choy

W:\102226-01\Civil\CADD\Site\AS-BUILT\DWGS\DRIVE_w\102226-01\Civil\CADD\Site\DWGS\X36 Cross Sections.dwg


14:58:26

January 11, 2019

NOTES:







1. Elevations Shown on Roadway
Sections are at 5'.

STATE	PROJECT	SHEET NO.
HI	HI STP SR 30(1)	X36

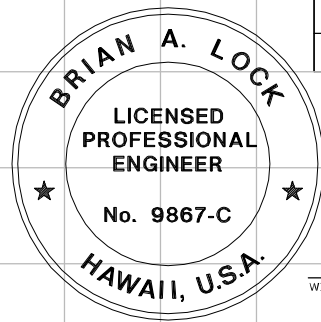

THIS WORK WAS PREPARED BY ME
OR UNDER MY SUPERVISION.

WILSON OKAMOTO CORPORATION
APRIL 30, 2020
LIC. EXP. DATE

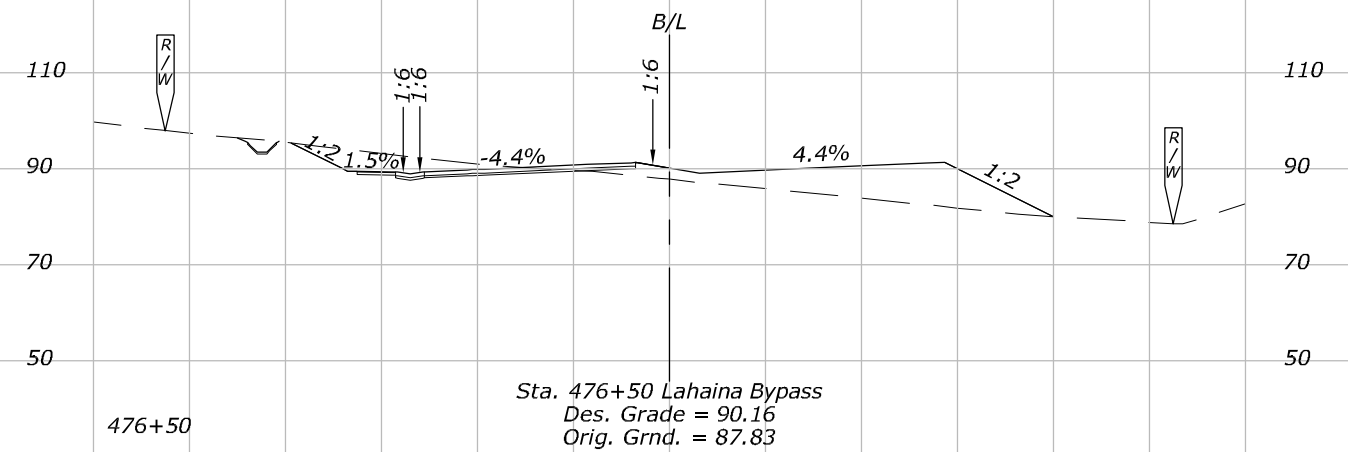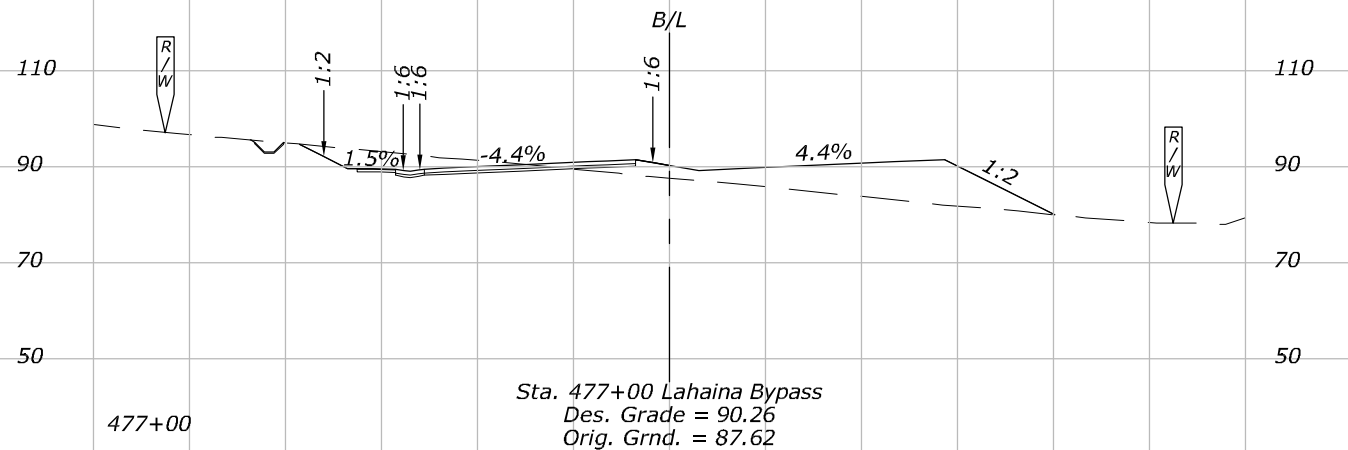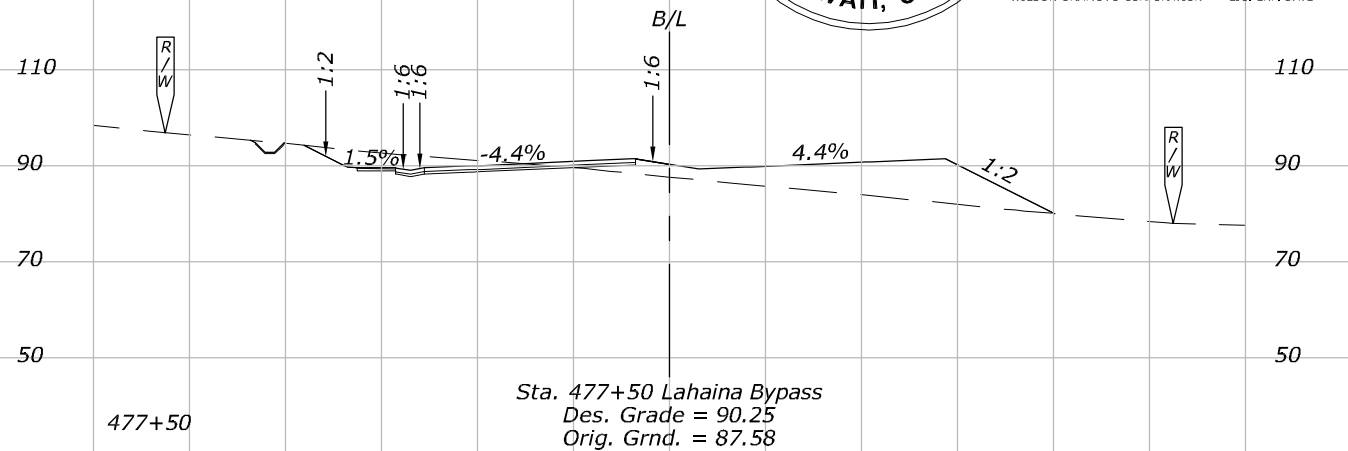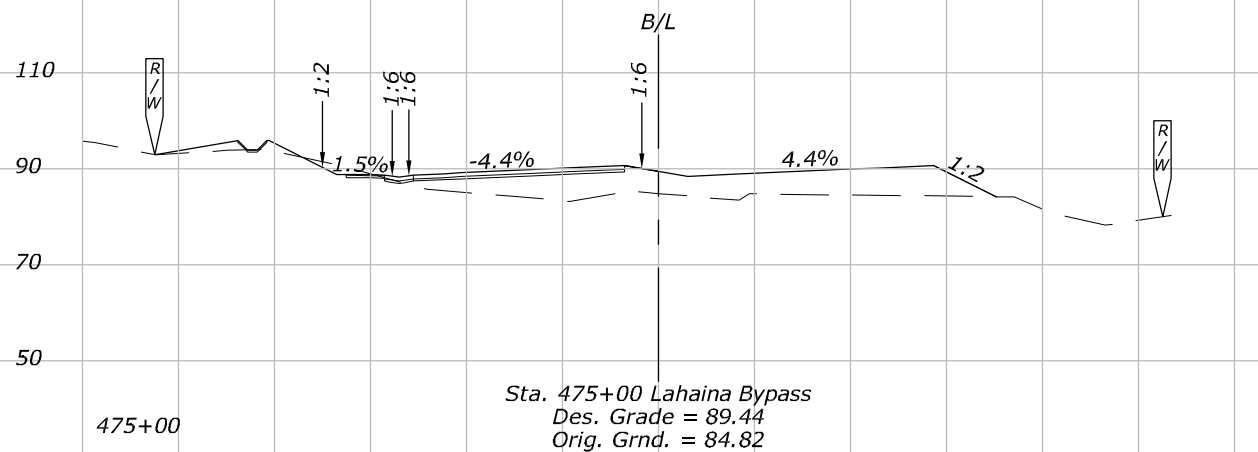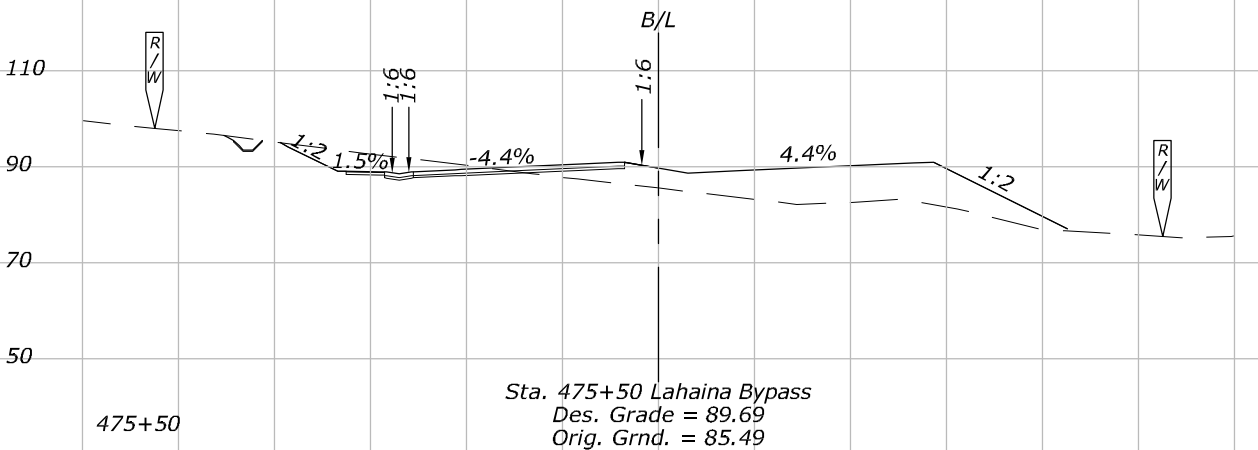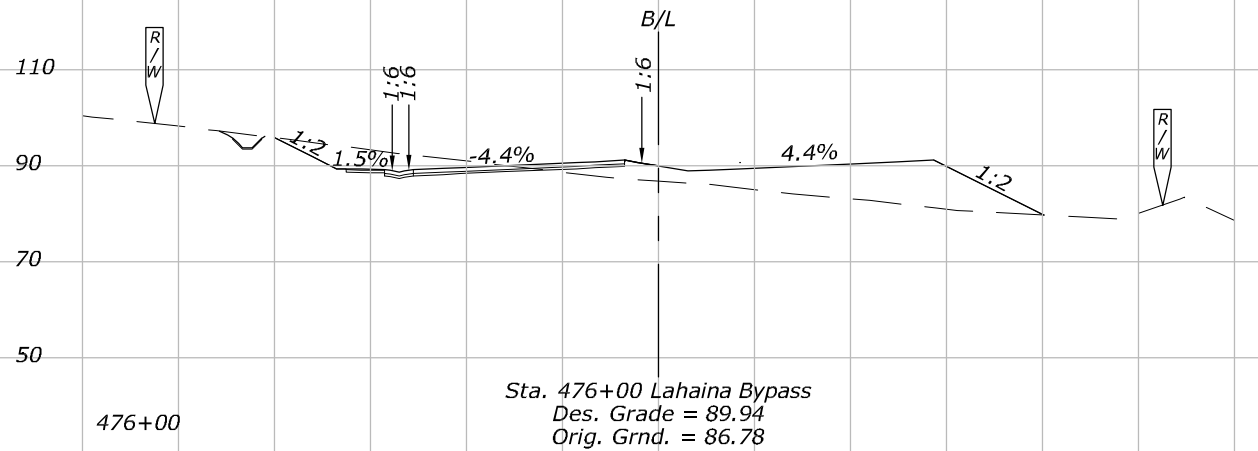

CROSS SECTIONS 475+00 TO 477+50

Patricia Choy

W:\102226-01\Civil\CADD\Site\AS-BUILT\DWGS\DRIVE_w\102226-01\Civil\CADD\Site\DWGS\X37 Cross Sections.dwg


14:59:13

January 11, 2019

NOTES:







1. Elevations Shown on Roadway
Sections are at 10'.

STATE	PROJECT	SHEET NO.
HI	HI STP SR 30(1)	X37

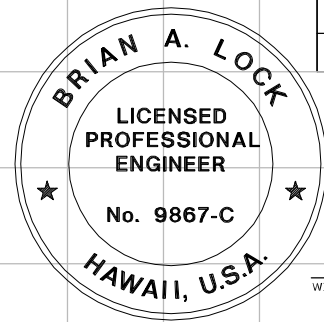

THIS WORK WAS PREPARED BY ME
OR UNDER MY SUPERVISION.

WILSON OKAMOTO CORPORATION
APRIL 30, 2020
LIC. EXP. DATE

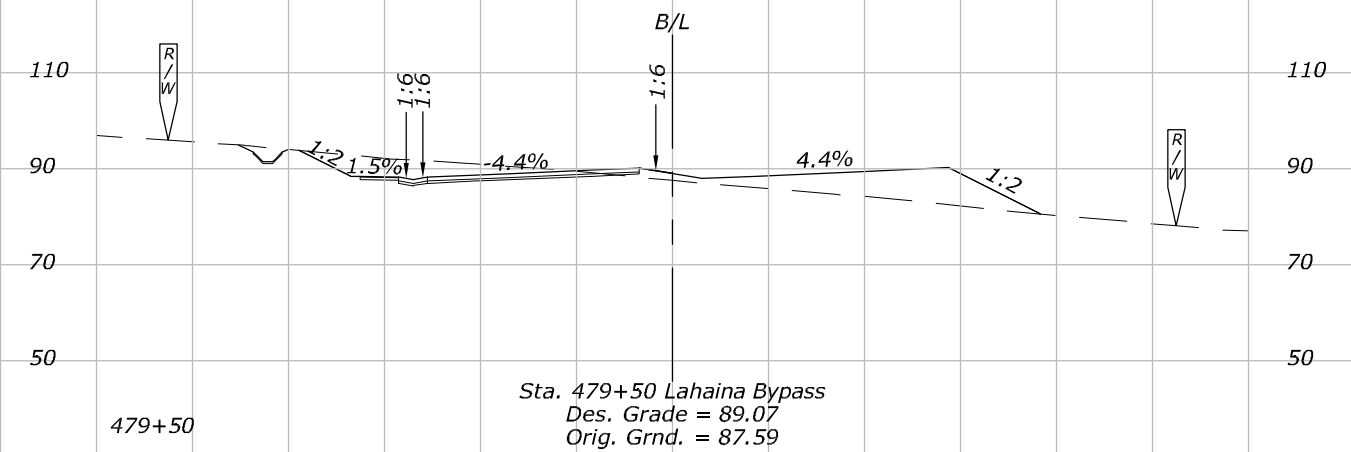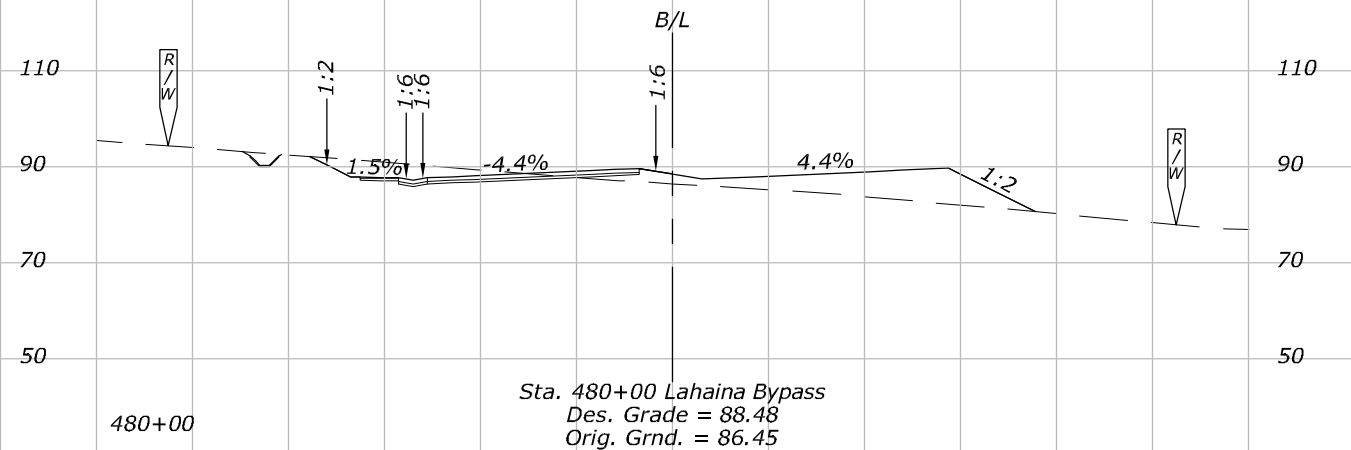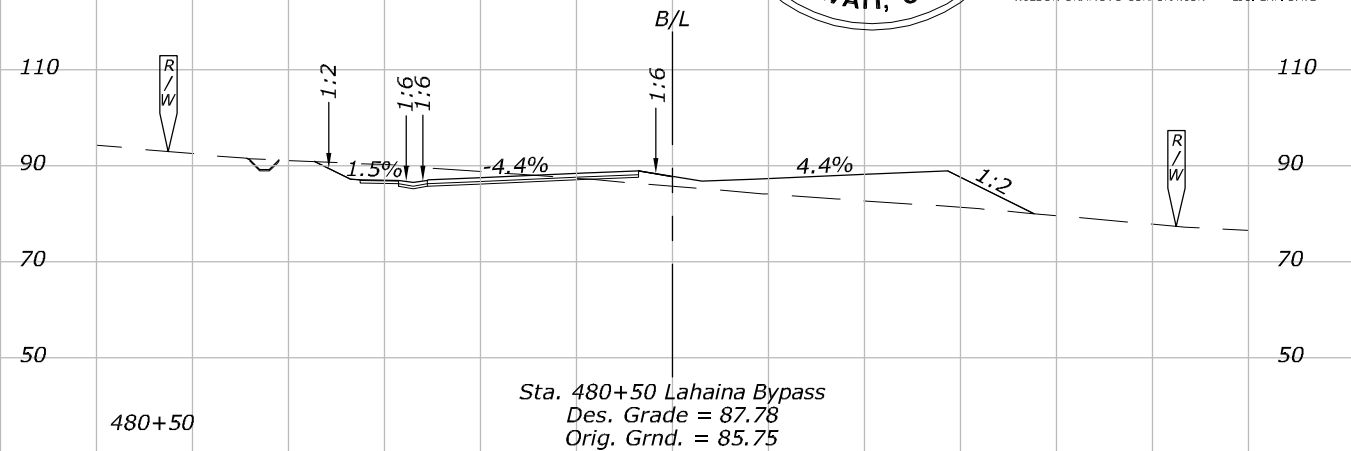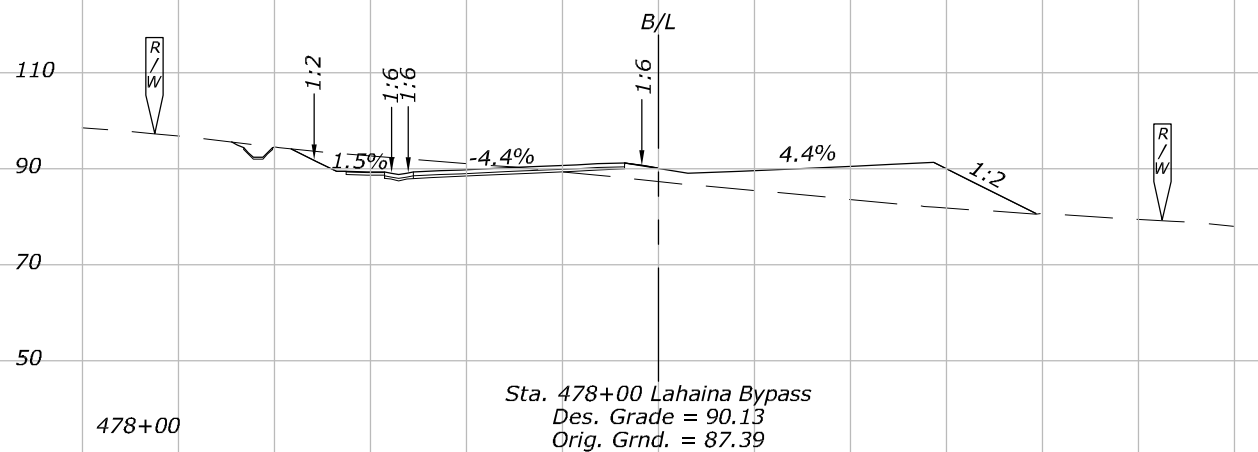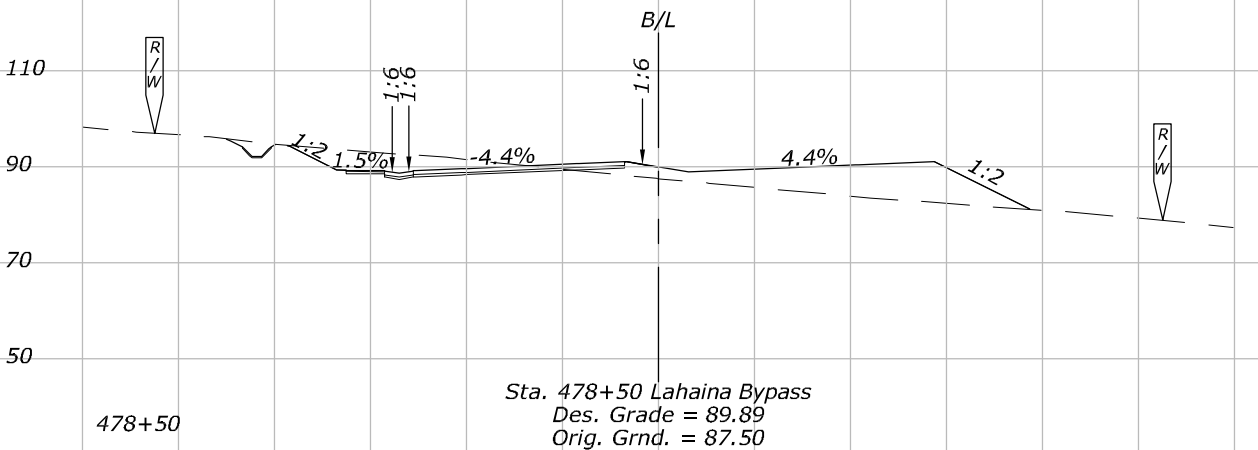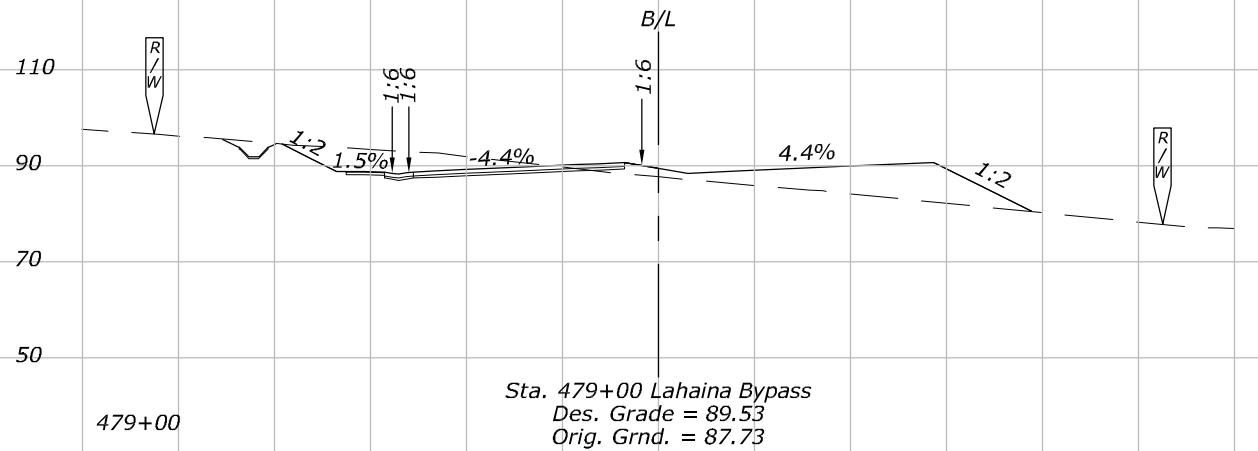

CROSS SECTIONS 478+00 TO 480+50

Patricia Choy

W:\102226-01\Civil\CADD\Site\AS-BUILT\DWGS\DRIVE_w\102226-01\Civil\CADD\Site\DWGS\X38 Cross Sections.dwg


15:00:05

January 11, 2019

NOTES:







1. Elevations Shown on Roadway
Sections are at 10'.

STATE	PROJECT	SHEET NO.
HI	HI STP SR 30(1)	X38

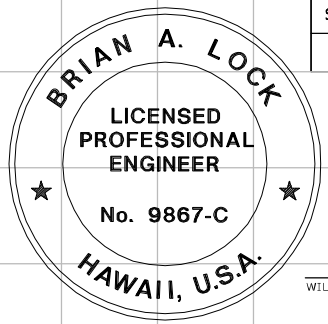

THIS WORK WAS PREPARED BY ME
OR UNDER MY SUPERVISION.

WILSON OKAMOTO CORPORATION
APRIL 30, 2020
LIC. EXP. DATE

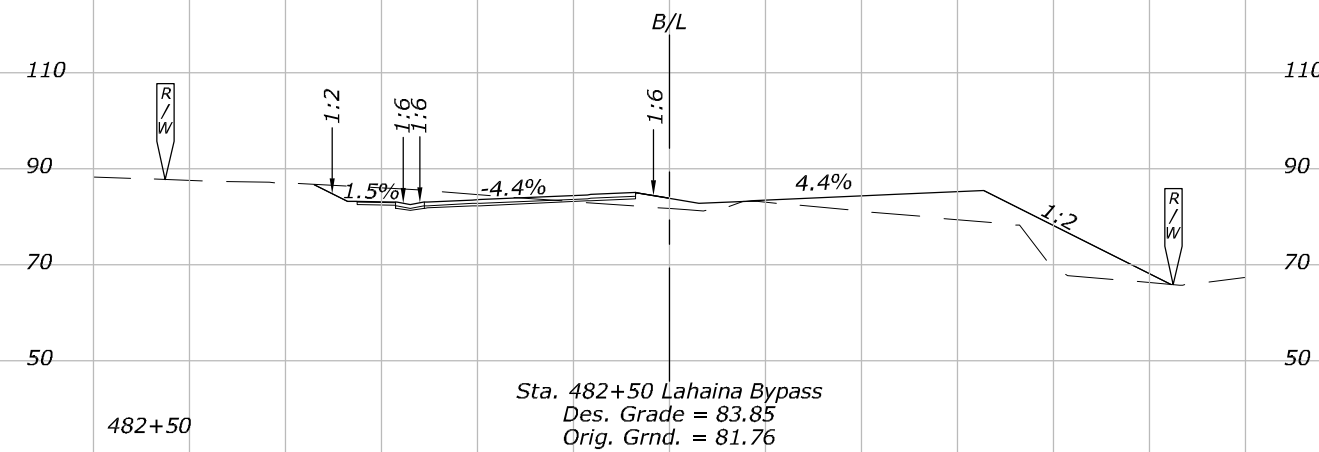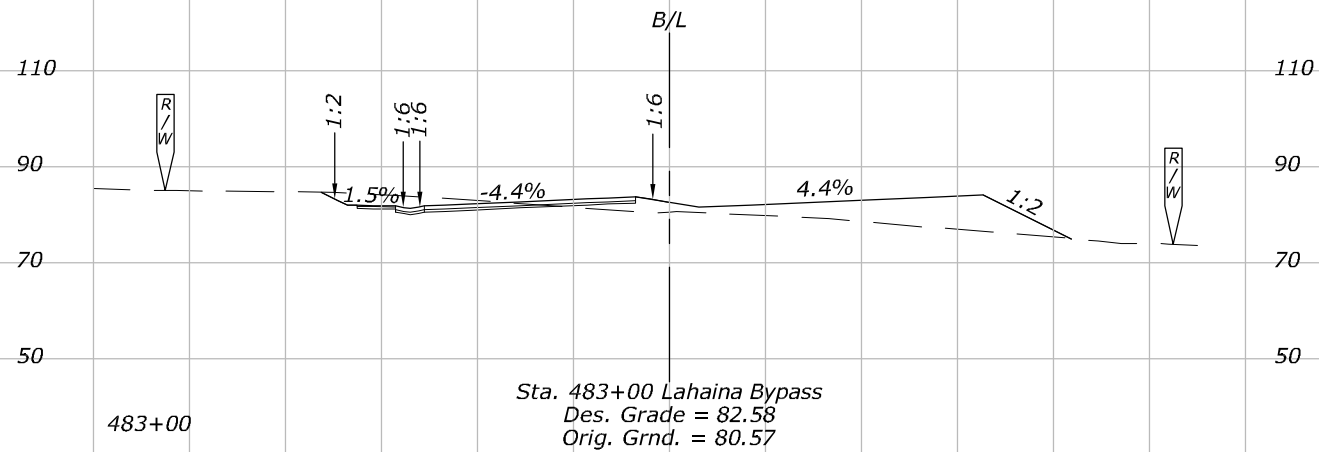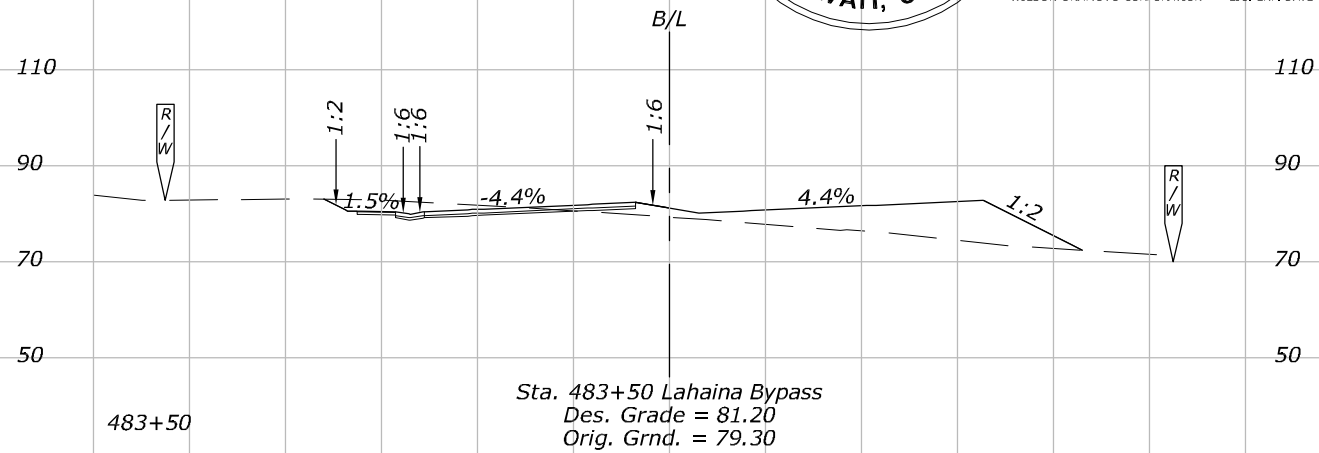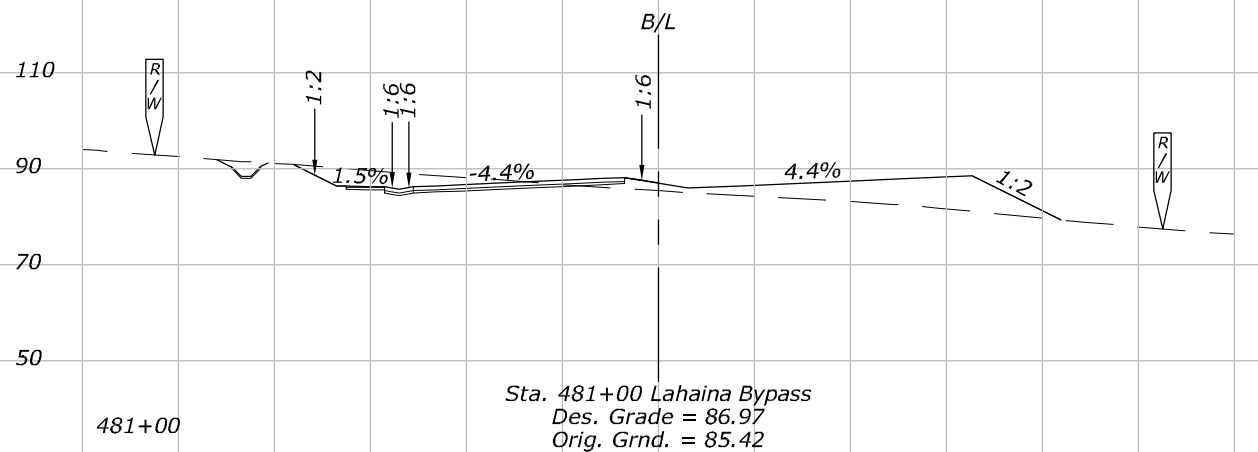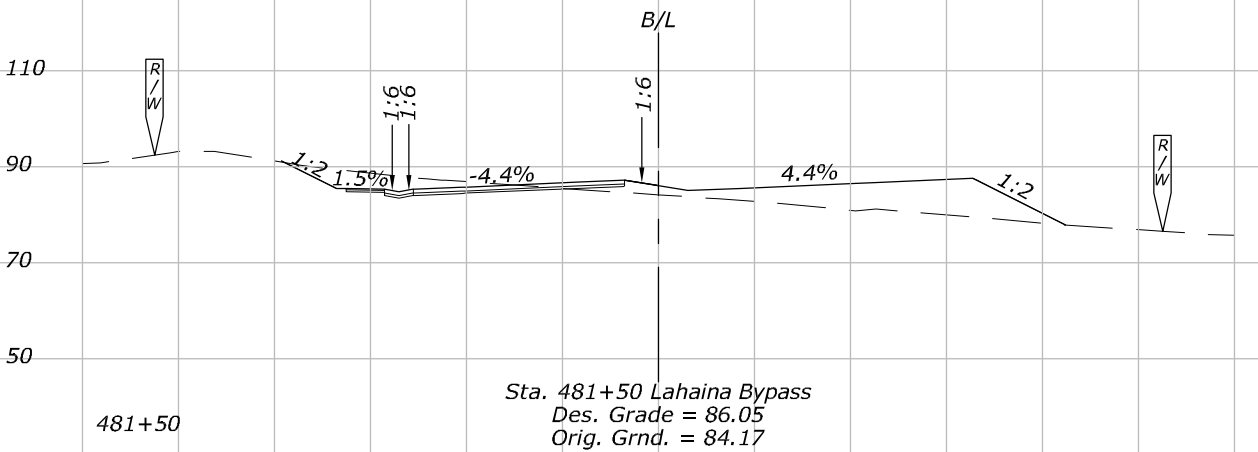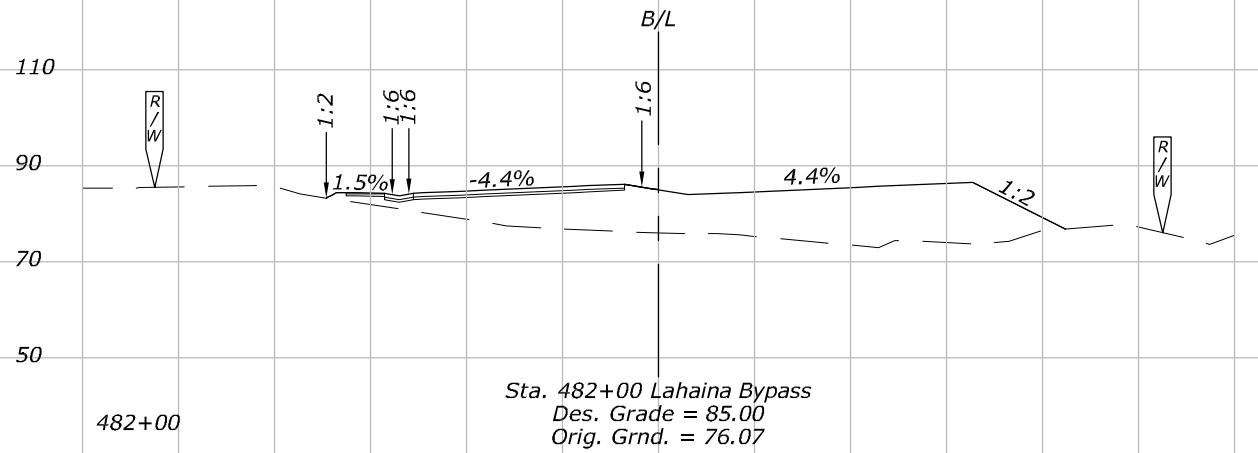

CROSS SECTIONS 481+00 TO 483+50

Patricia Choy

W:\102226-01\Civil\CADD\Site\AS-BUILTS\DWGS\DRIVE_w\102226-01\Civil\CADD\Site\DWGS\X39 Cross Sections.dwg


15:01:32

January 11, 2019

NOTES:






1. Elevations Shown on Roadway
Sections are at 5'.

STATE	PROJECT	SHEET NO.
HI	HI STP SR 30(1)	X39

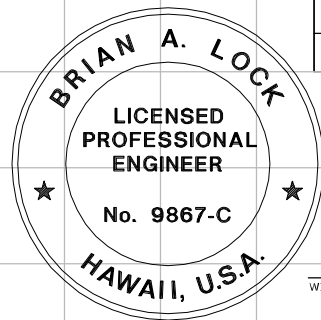

THIS WORK WAS PREPARED BY ME
OR UNDER MY SUPERVISION.

WILSON OKAMOTO CORPORATION
APRIL 30, 2020
LIC. EXP. DATE

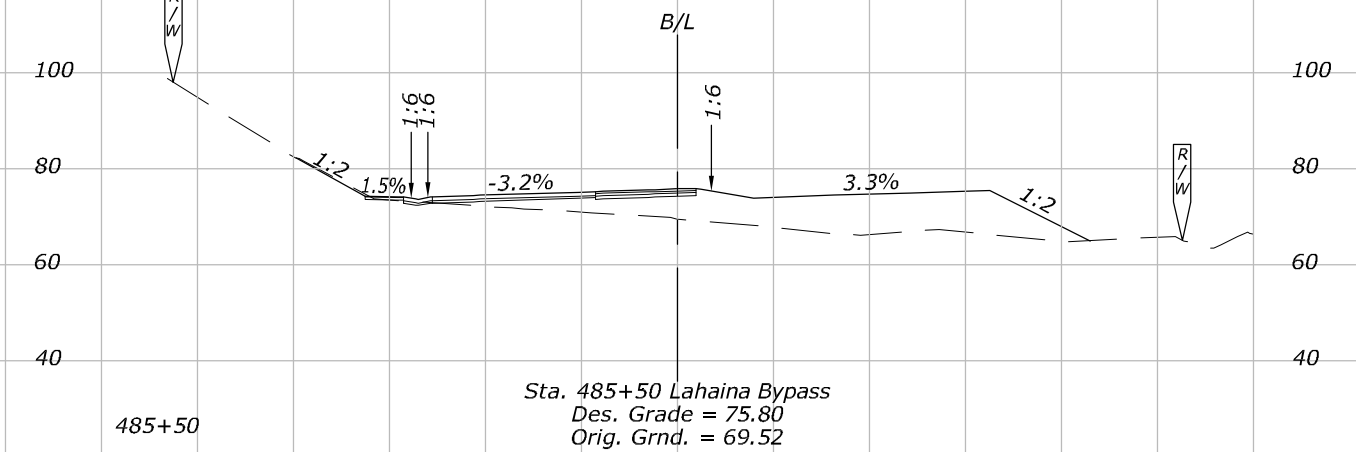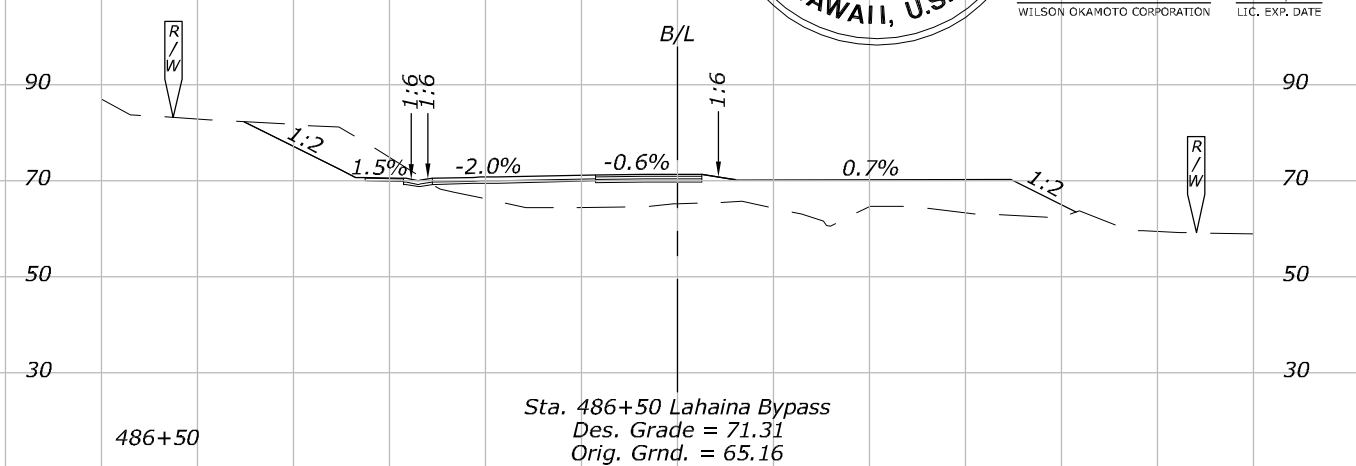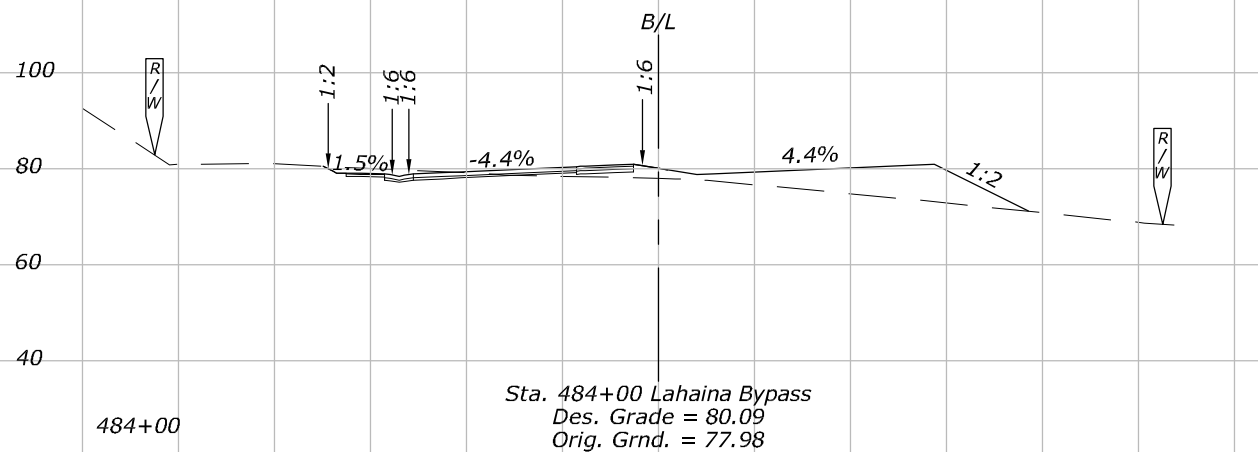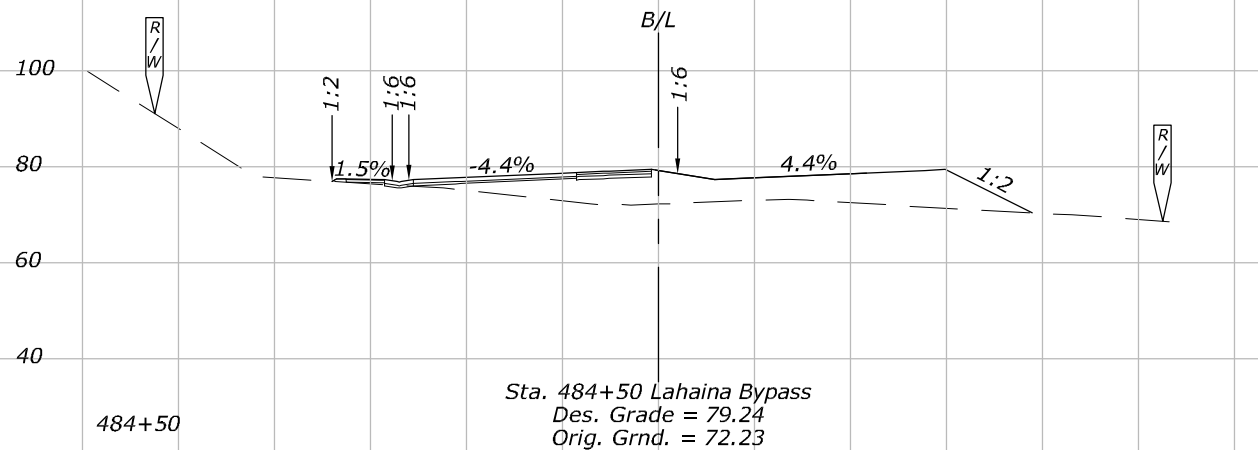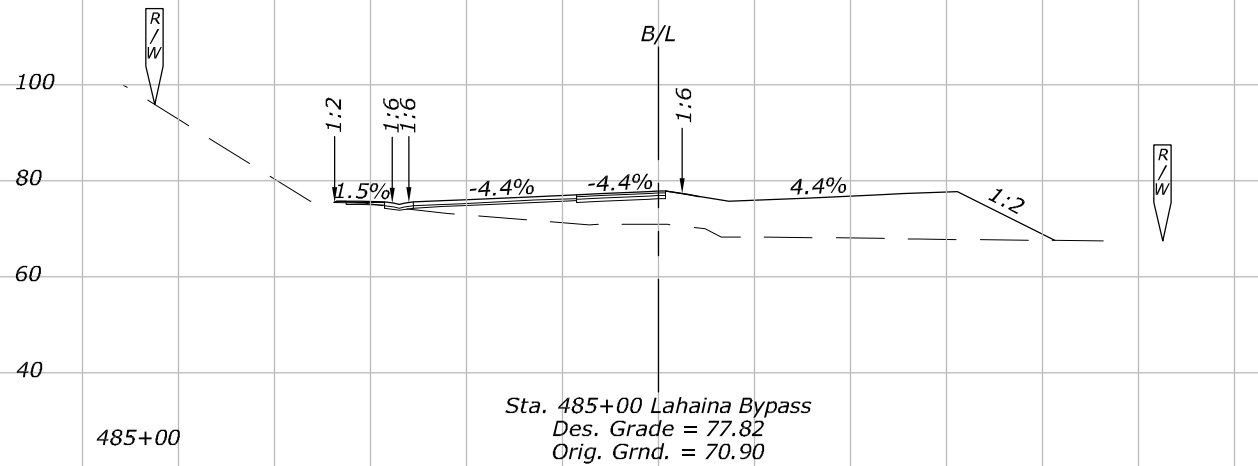

CROSS SECTIONS 484+00 TO 486+50

Patricia Choy

W:\10226-01\Civil\CADD\Site\AS-BUILTS\DWGS\DRIVE_w\10226-01\Civil\CADD\Site\DWGS\X40 Cross Sections.dwg


15:02:14

January 11, 2019

NOTES:


1. Elevations Shown on Roadway
Sections are at 10'.

STATE	PROJECT	SHEET NO.
HI	HI STP SR 30(1)	X40

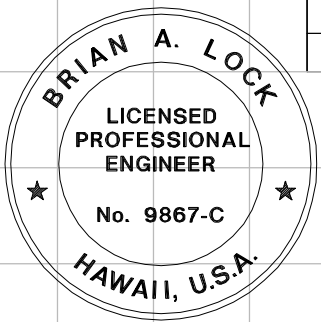


THIS WORK WAS PREPARED BY ME
OR UNDER MY SUPERVISION.
WILSON OKAMOTO CORPORATION
APRIL 30, 2020
LIC. EXP. DATE

Beyond
R/W

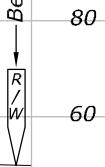

Sta. 488+00 Lahaina Bypass
Des. Grade = 63.96
Orig. Grnd. = 61.84

488+00

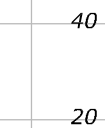


Sta. 489+50 Lahaina Bypass
Des. Grade = 56.47
Orig. Grnd. = 55.85

489+50




Sta. 487+50 Lahaina Bypass
Des. Grade = 66.39
Orig. Grnd. = 63.14

487+50

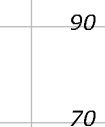

Sta. 489+00 Lahaina Bypass
Des. Grade = 58.97
Orig. Grnd. = 59.09

489+00

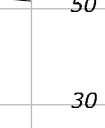

Sta. 487+00 Lahaina Bypass
Des. Grade = 68.92
Orig. Grnd. = 63.47

487+00



Sta. 488+50 Lahaina Bypass
Des. Grade = 61.47
Orig. Grnd. = 58.78

488+50

CROSS SECTIONS 487+00 TO 489+50

-120 -80 -40 0 40 80 120

-120 -80 -40 0 40 80 120

Patricia Choy

W:\10226-01\Civil\CADD\Site\AS-BUILTS\DWGS\DRIVE_w\10226-01\Civil\CADD\Site\DWGS\X41 Cross Sections.dwg


15:08:58

January 11, 2019







NOTES:

1. Elevations Shown on Roadway Sections are at $\frac{1}{8}$.

STATE	PROJECT	SHEET NO.
HI	HI STP SR 30(1)	X41

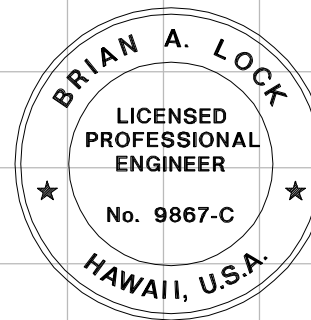

THIS WORK WAS PREPARED BY ME
OR UNDER MY SUPERVISION.
WILSON OKAMOTO CORPORATION
APRIL 30, 2020
LIC. EXP. DATE

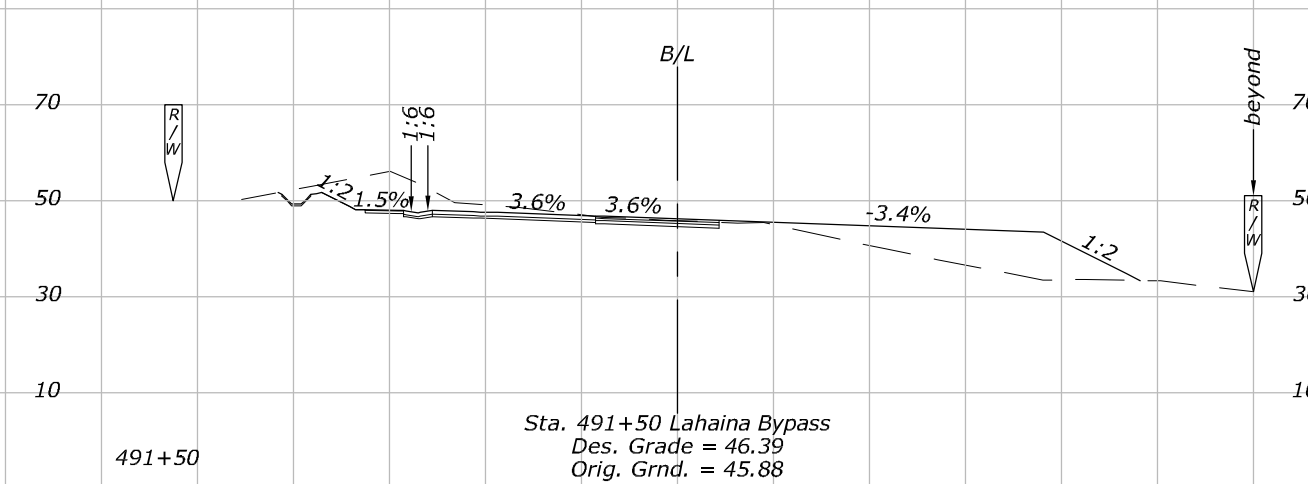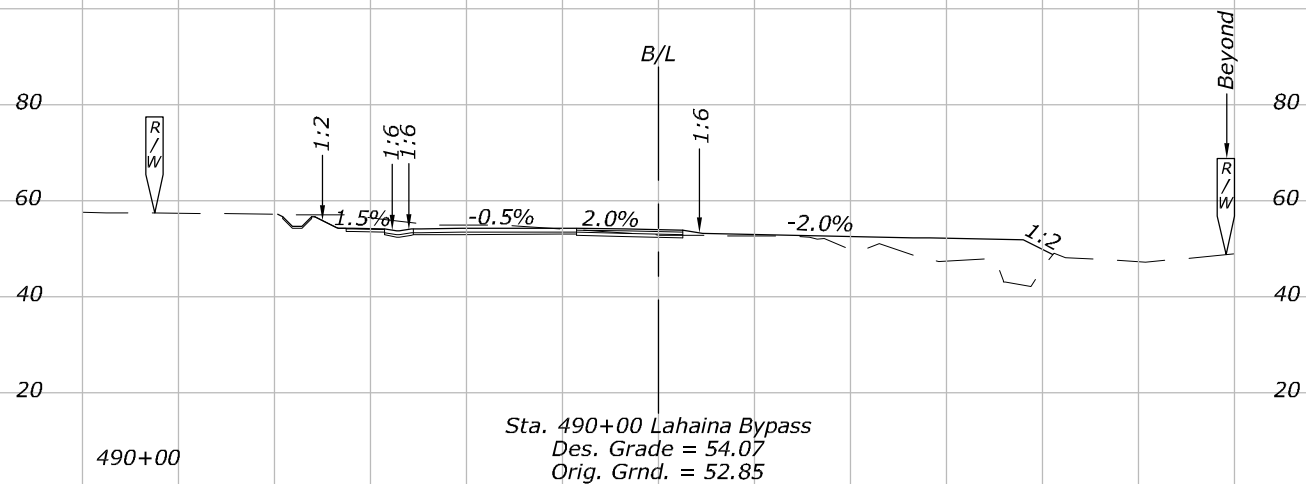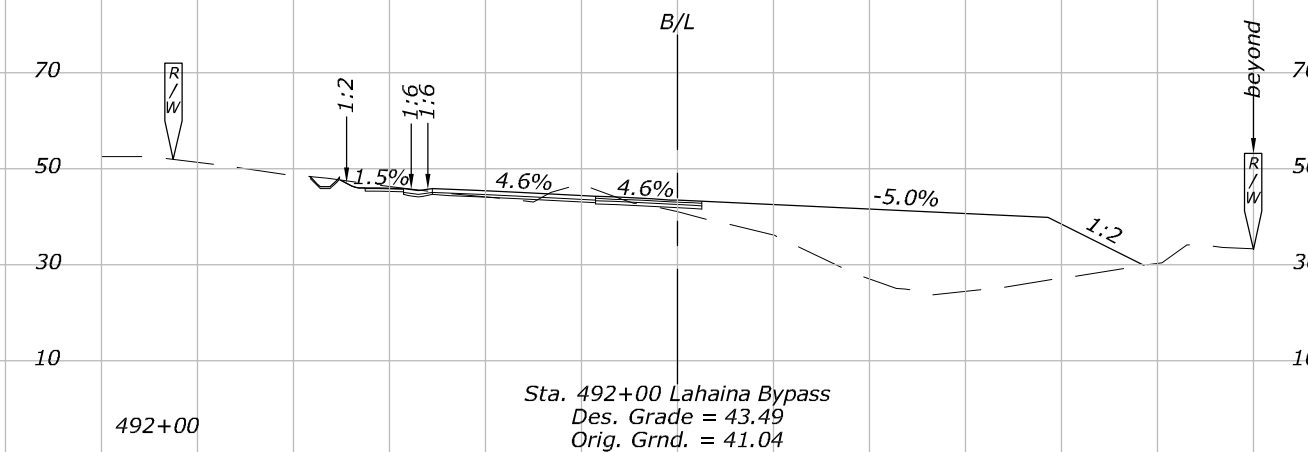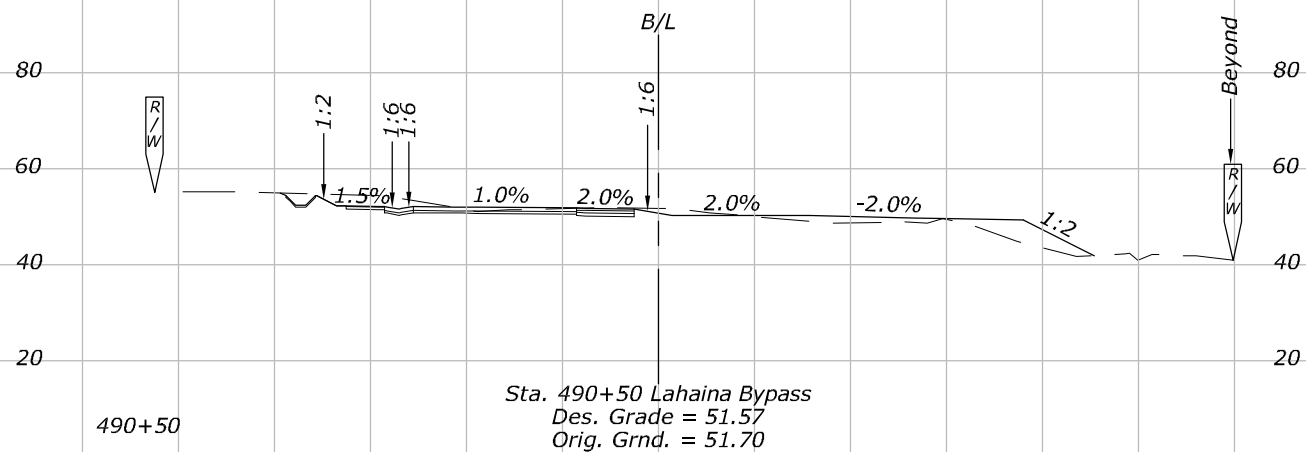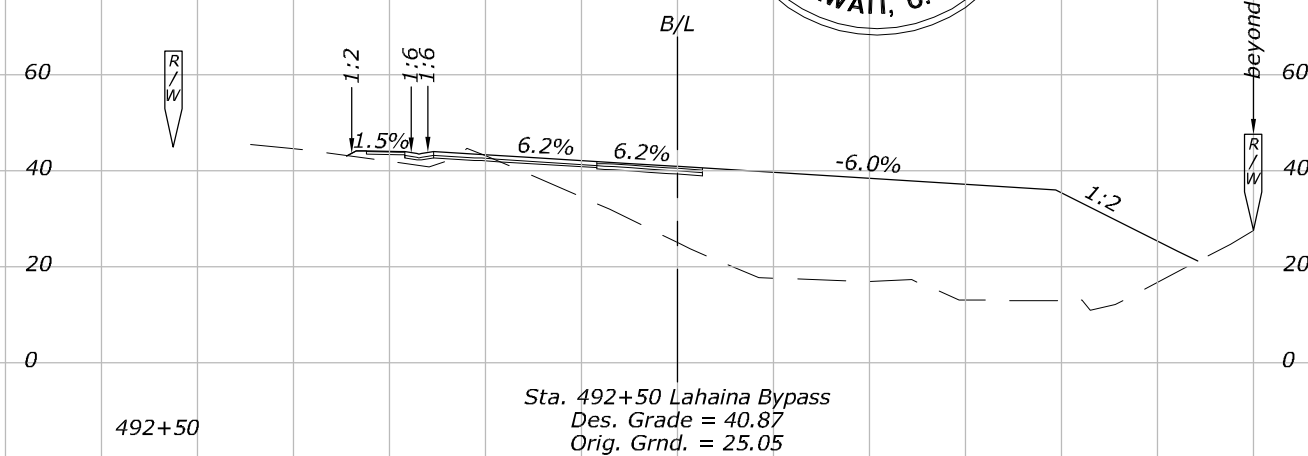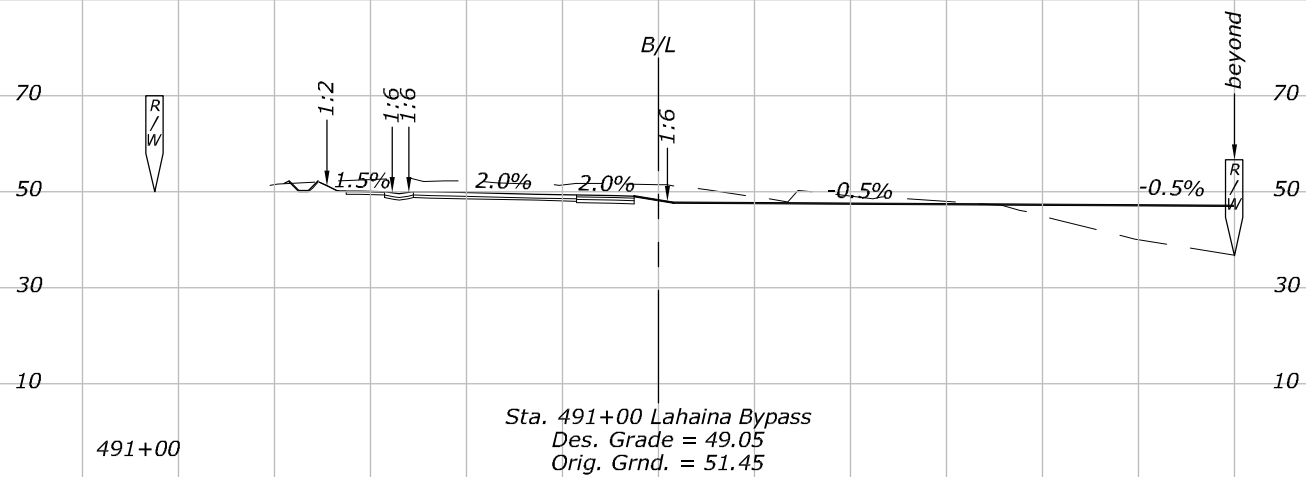

CROSS SECTIONS 490+00 TO 492+50

Patricia Choy

W:\10226-01\Civil\CADD\Site\AS-BUILT\DWGS\DRIVE_w\10226-01\Civil\CADD\Site\DWGS\X42 Cross Sections.dwg


15:09:40

January 11, 2019







NOTES:

1. Elevations Shown on Roadway
Sections are at 10'.

STATE	PROJECT	SHEET NO.
HI	HI STP SR 30(1)	X42

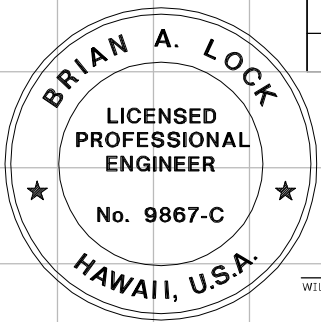

THIS WORK WAS PREPARED BY ME
OR UNDER MY SUPERVISION.
WILSON OKAMOTO CORPORATION
APRIL 30, 2020
LIC. EXP. DATE

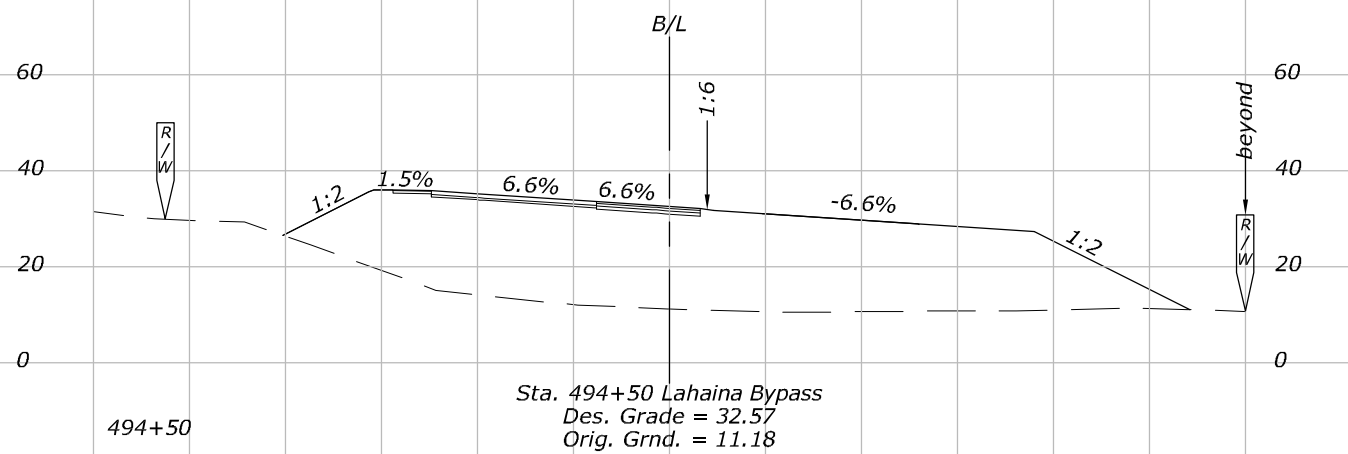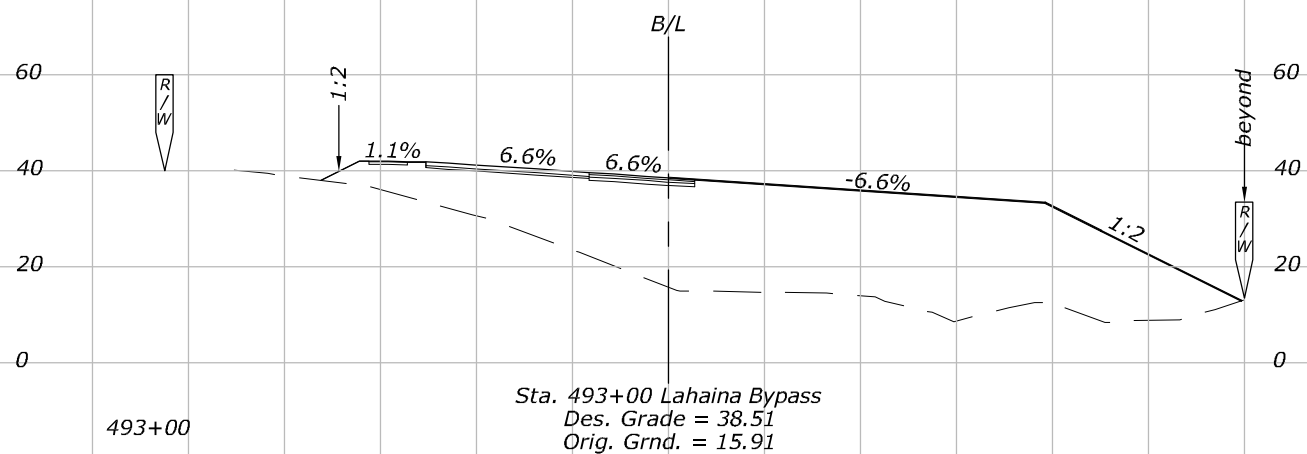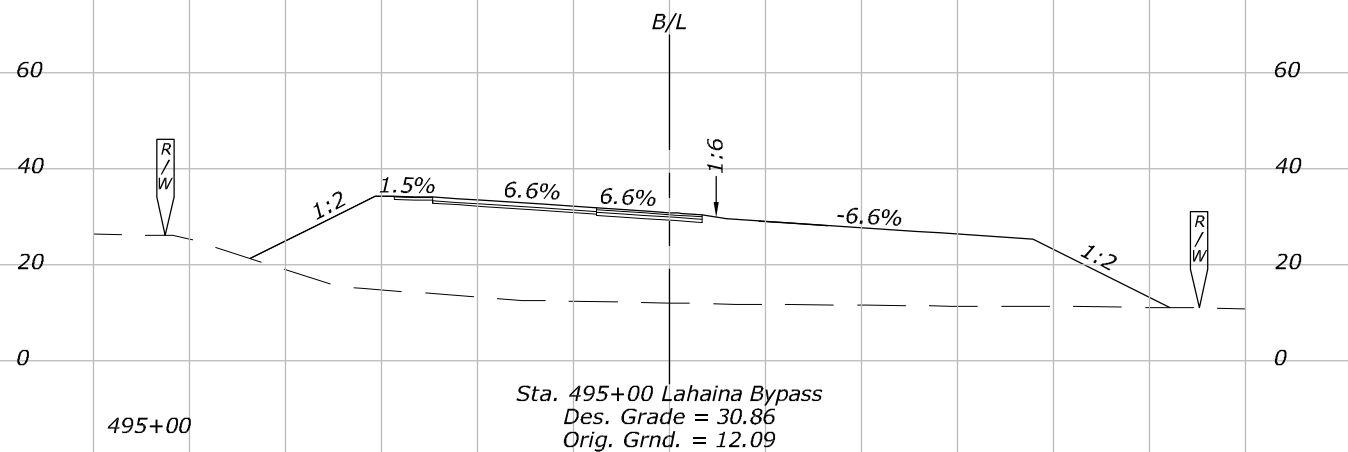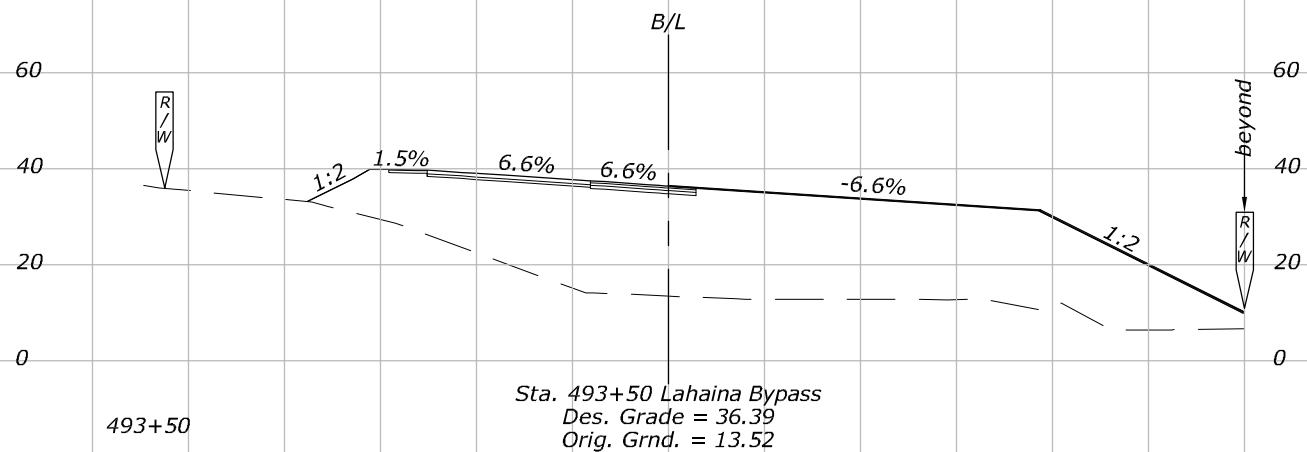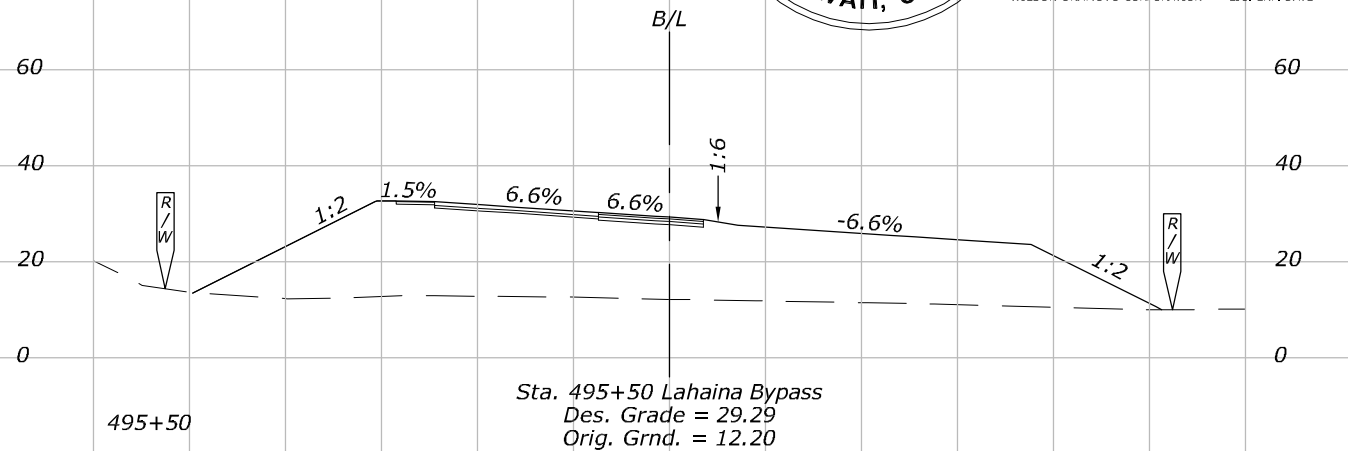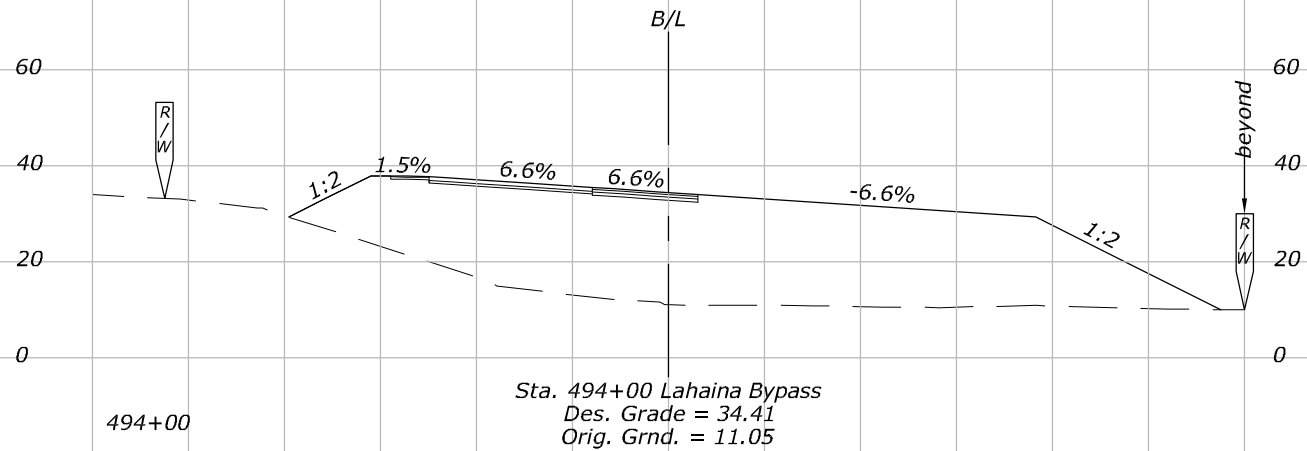

CROSS SECTIONS 493+00 TO 495+50

Patricia Choy

W:\10226-01\Civil\CADD\Site\AS-BUILTS\DWGS\DRIVE_w\10226-01\Civil\CADD\Site\DWGS\X43 Cross Sections.dwg


15:10:42

January 11, 2019

NOTES:

1. Elevations Shown on Roadway
Sections are at 5'.



STATE	PROJECT	SHEET NO.
HI	HI STP SR 30(1)	X43

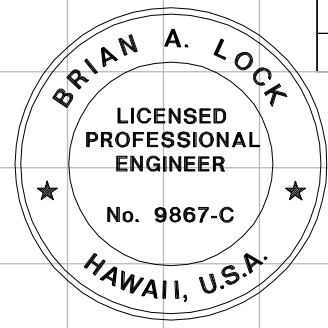

THIS WORK WAS PREPARED BY ME
OR UNDER MY SUPERVISION.

WILSON OKAMOTO CORPORATION

APRIL 30, 2020
LIC. EXP. DATE

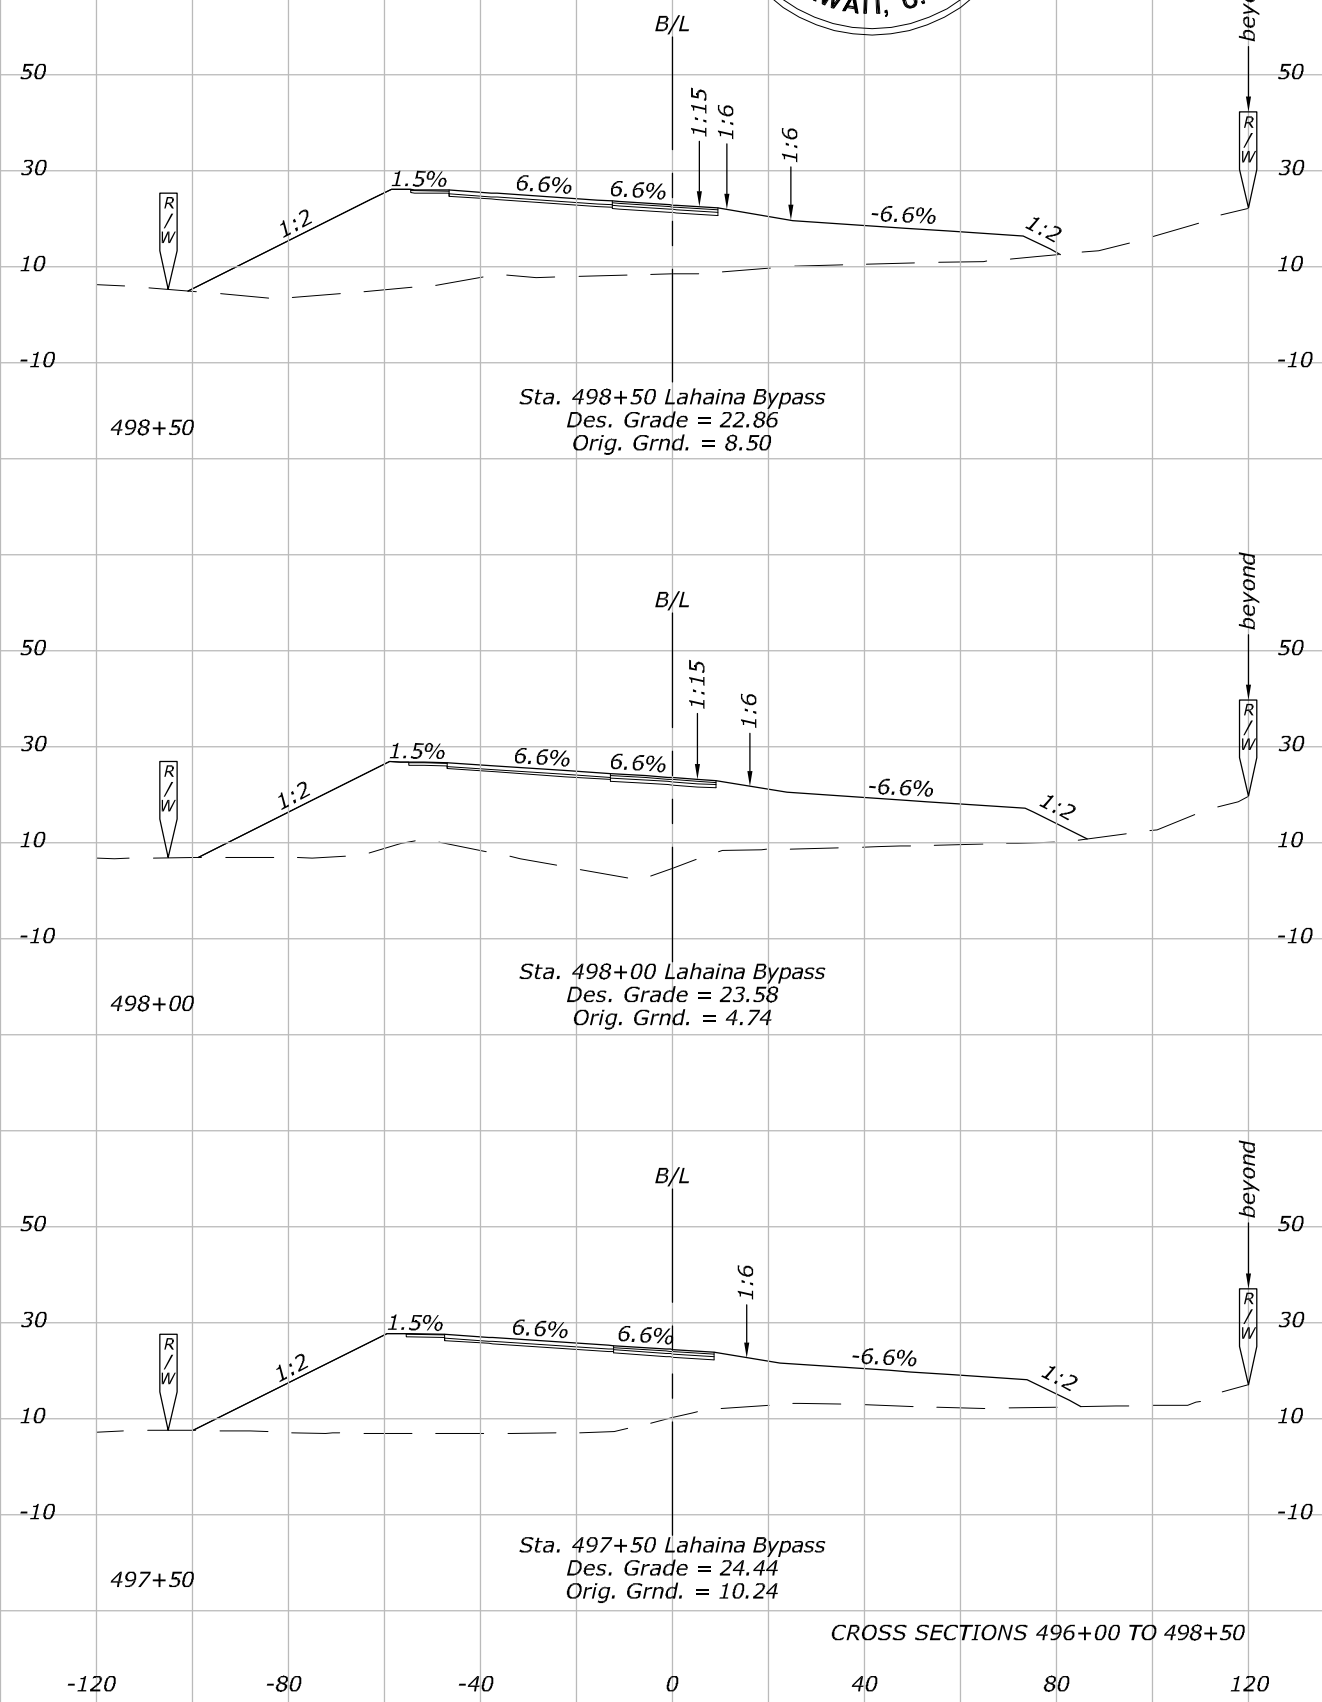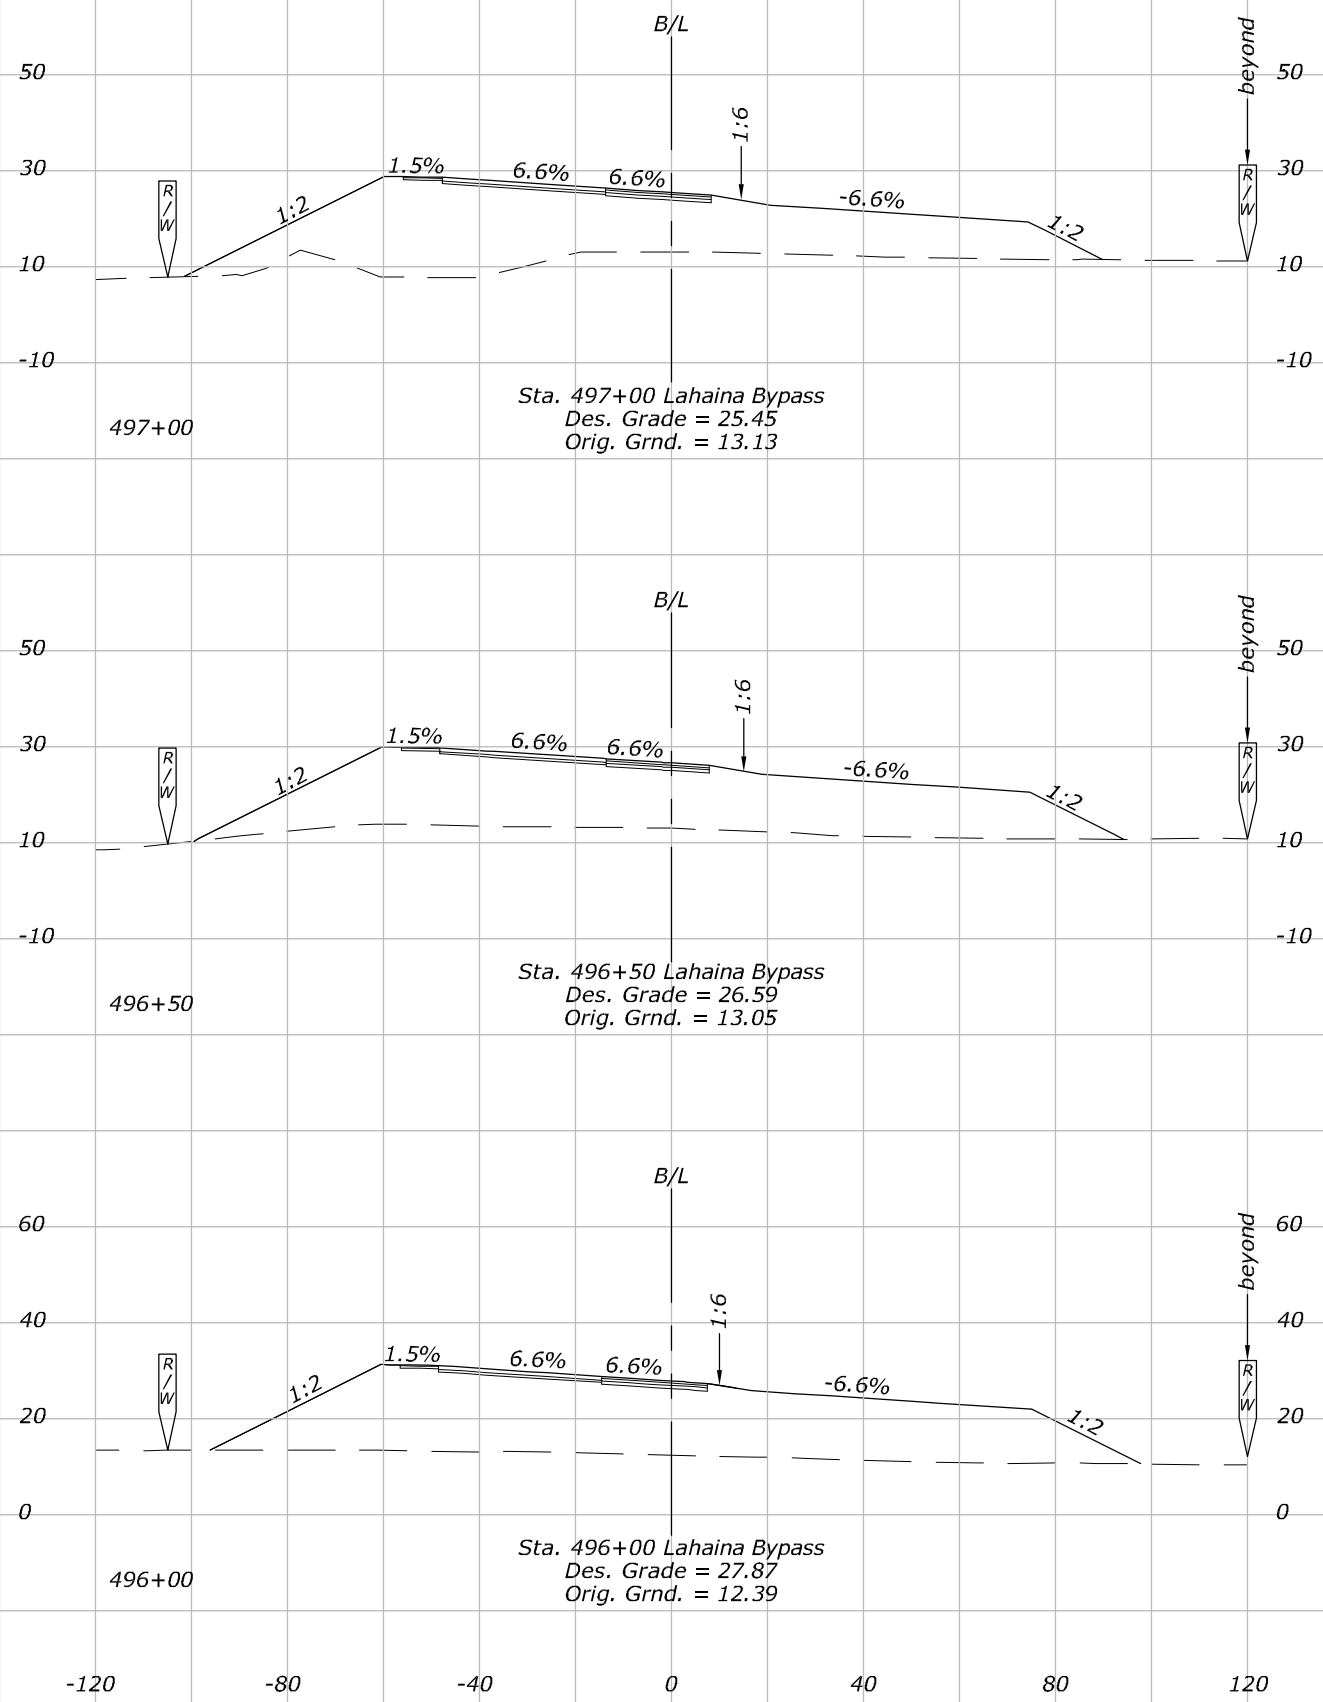

CROSS SECTIONS 496+00 TO 498+50

Patricia Choy

W:\10226-01\Civil\CADD\Site\DWGS\DRIVE_w\10226-01\Civil\CADD\Site\DWGS\X44 Cross Sections.dwg


15:14:19

January 11, 2019



NOTES:

1. Elevations Shown on Roadway
Sections are at 10'.

STATE	PROJECT	SHEET NO.
HI	HI STP SR 30(1)	X44

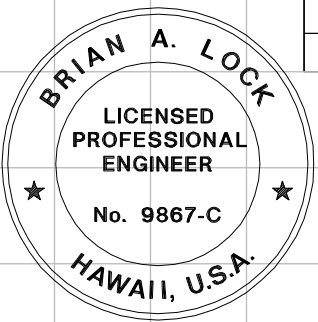

THIS WORK WAS PREPARED BY ME
OR UNDER MY SUPERVISION.
WILSON OKAMOTO CORPORATION
APRIL 30, 2020
LIC. EXP. DATE

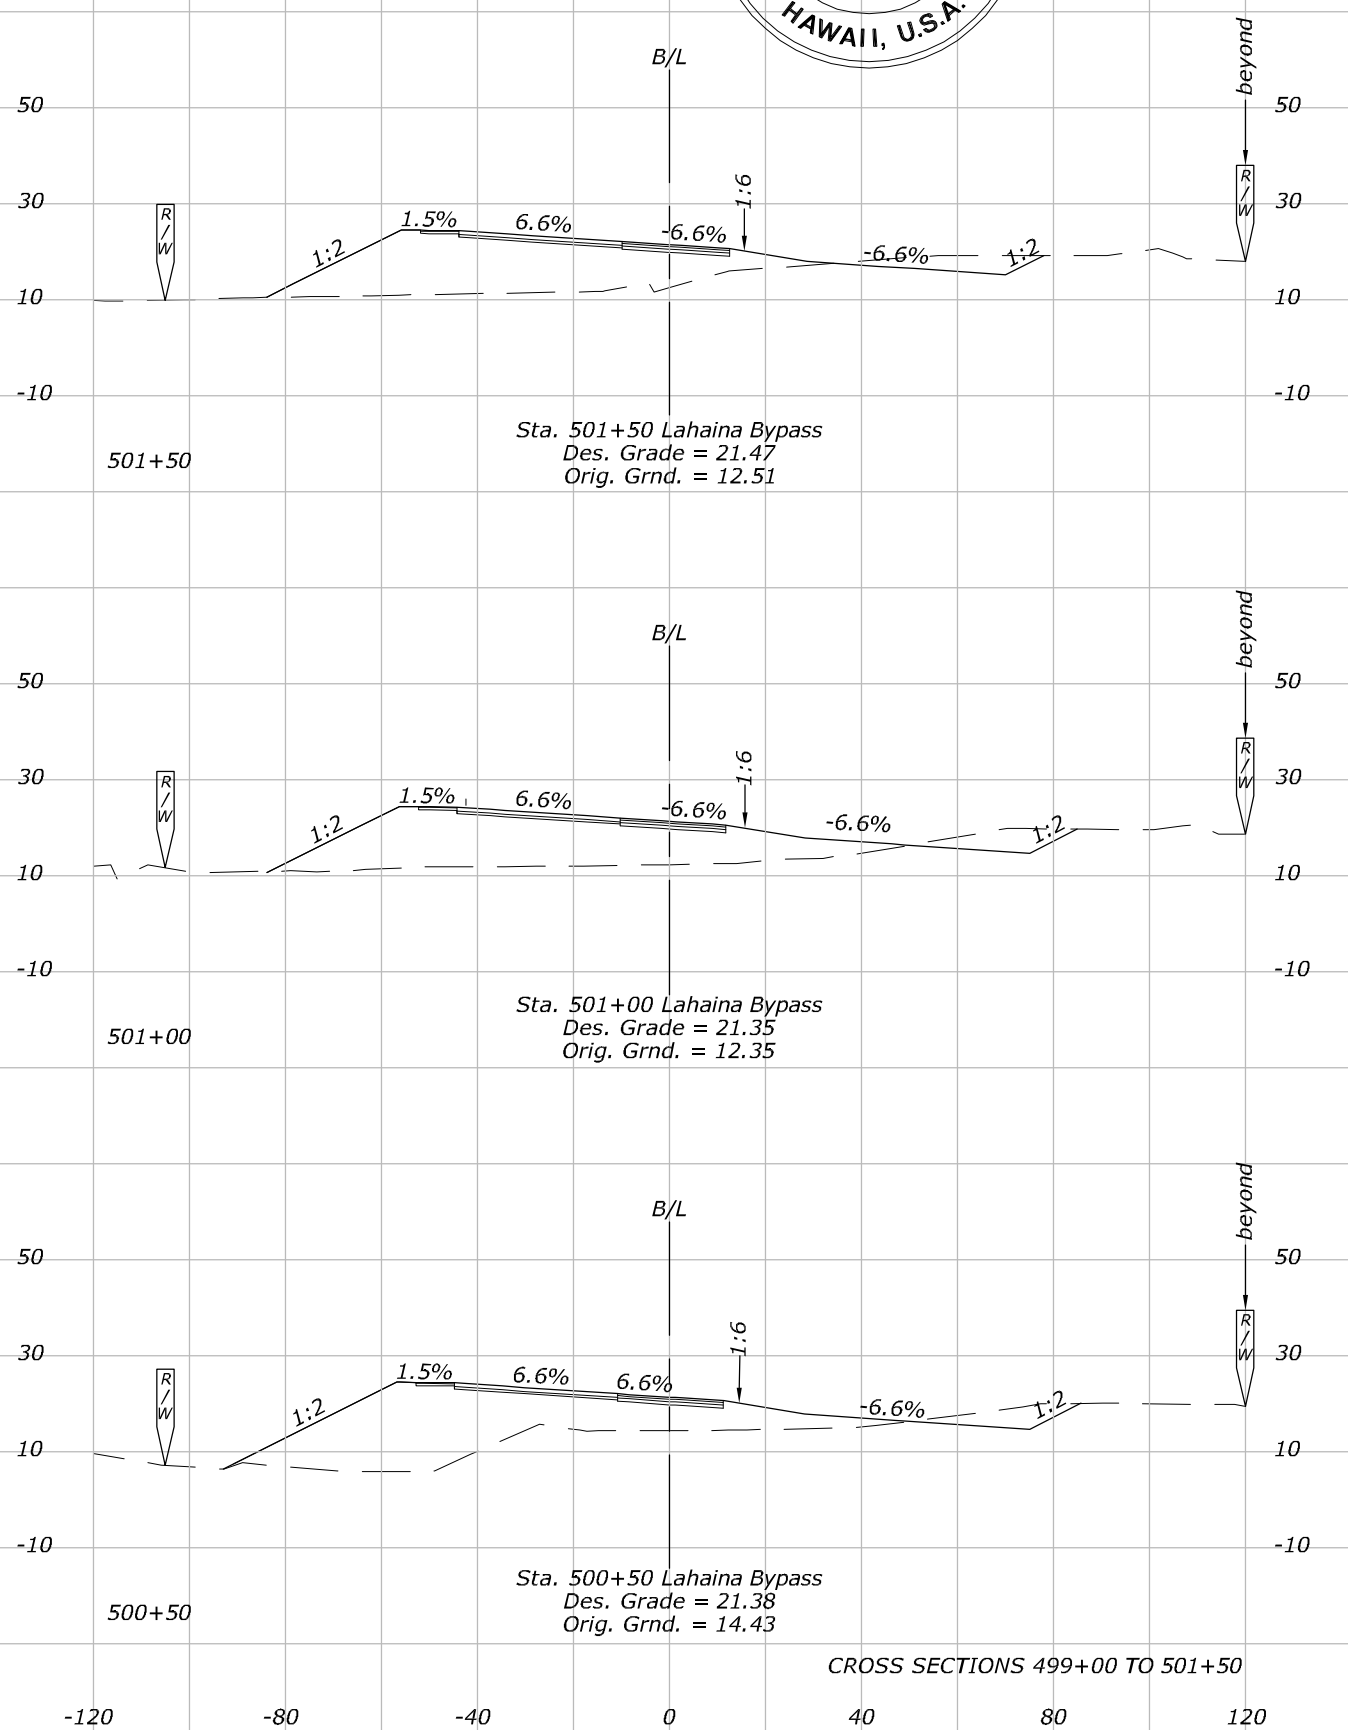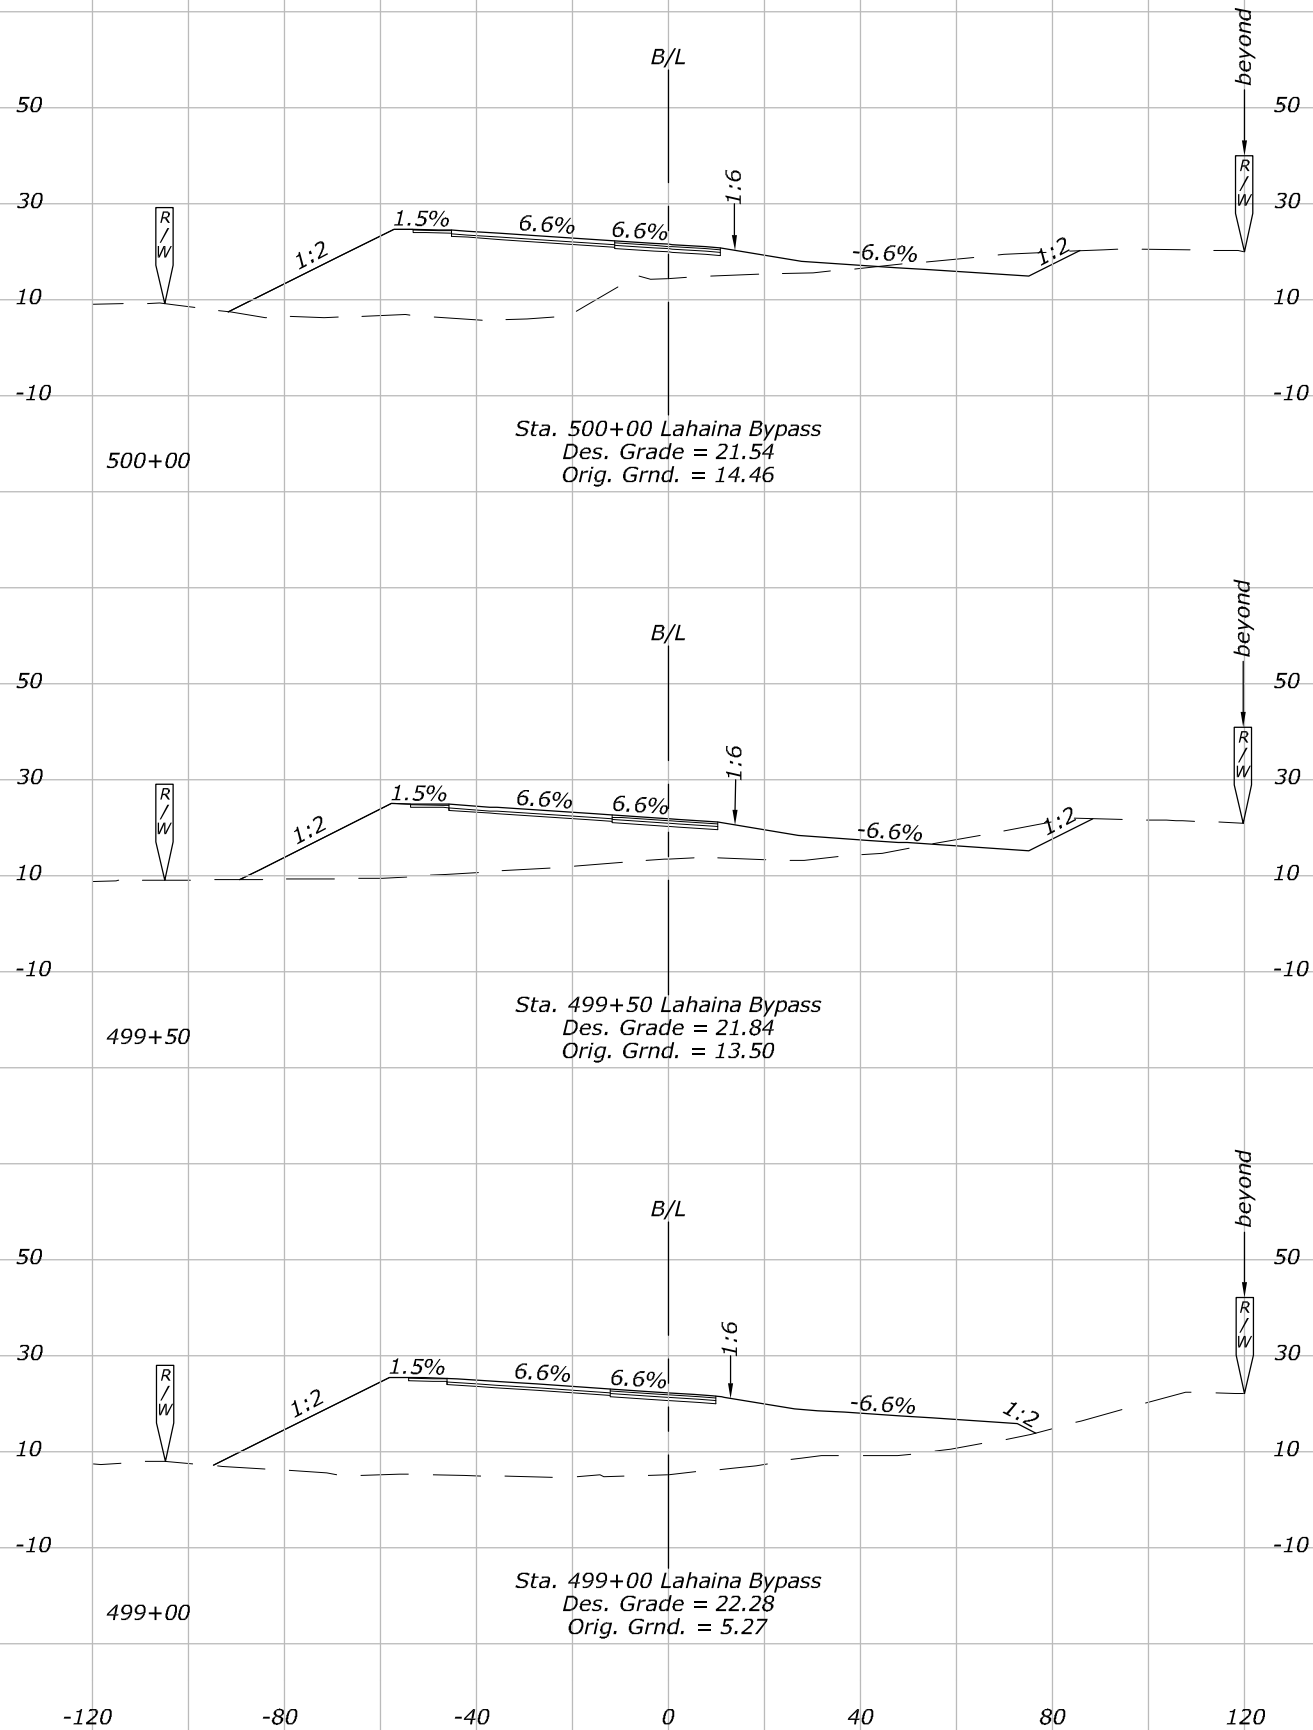

CROSS SECTIONS 499+00 TO 501+50

Patricia Choy


W:\10226-01\Civil\CADD\Site\AS-BUILT\DWGS\DRIVE_w\10226-01\Civil\CADD\Site\DWGS\X45 Cross Sections.dwg

January 11, 2019 15:18:55

NOTES:



1. Elevations Shown on Roadway
Sections are at 5'.

STATE	PROJECT	SHEET NO.
HI	HI STP SR 30(1)	X45

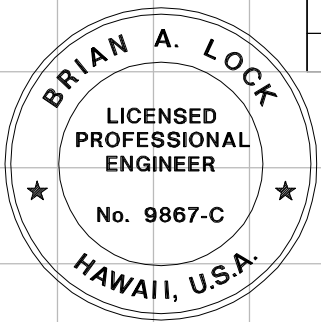

THIS WORK WAS PREPARED BY ME
OR UNDER MY SUPERVISION.

WILSON OKAMOTO CORPORATION
APRIL 30, 2020
LIC. EXP. DATE

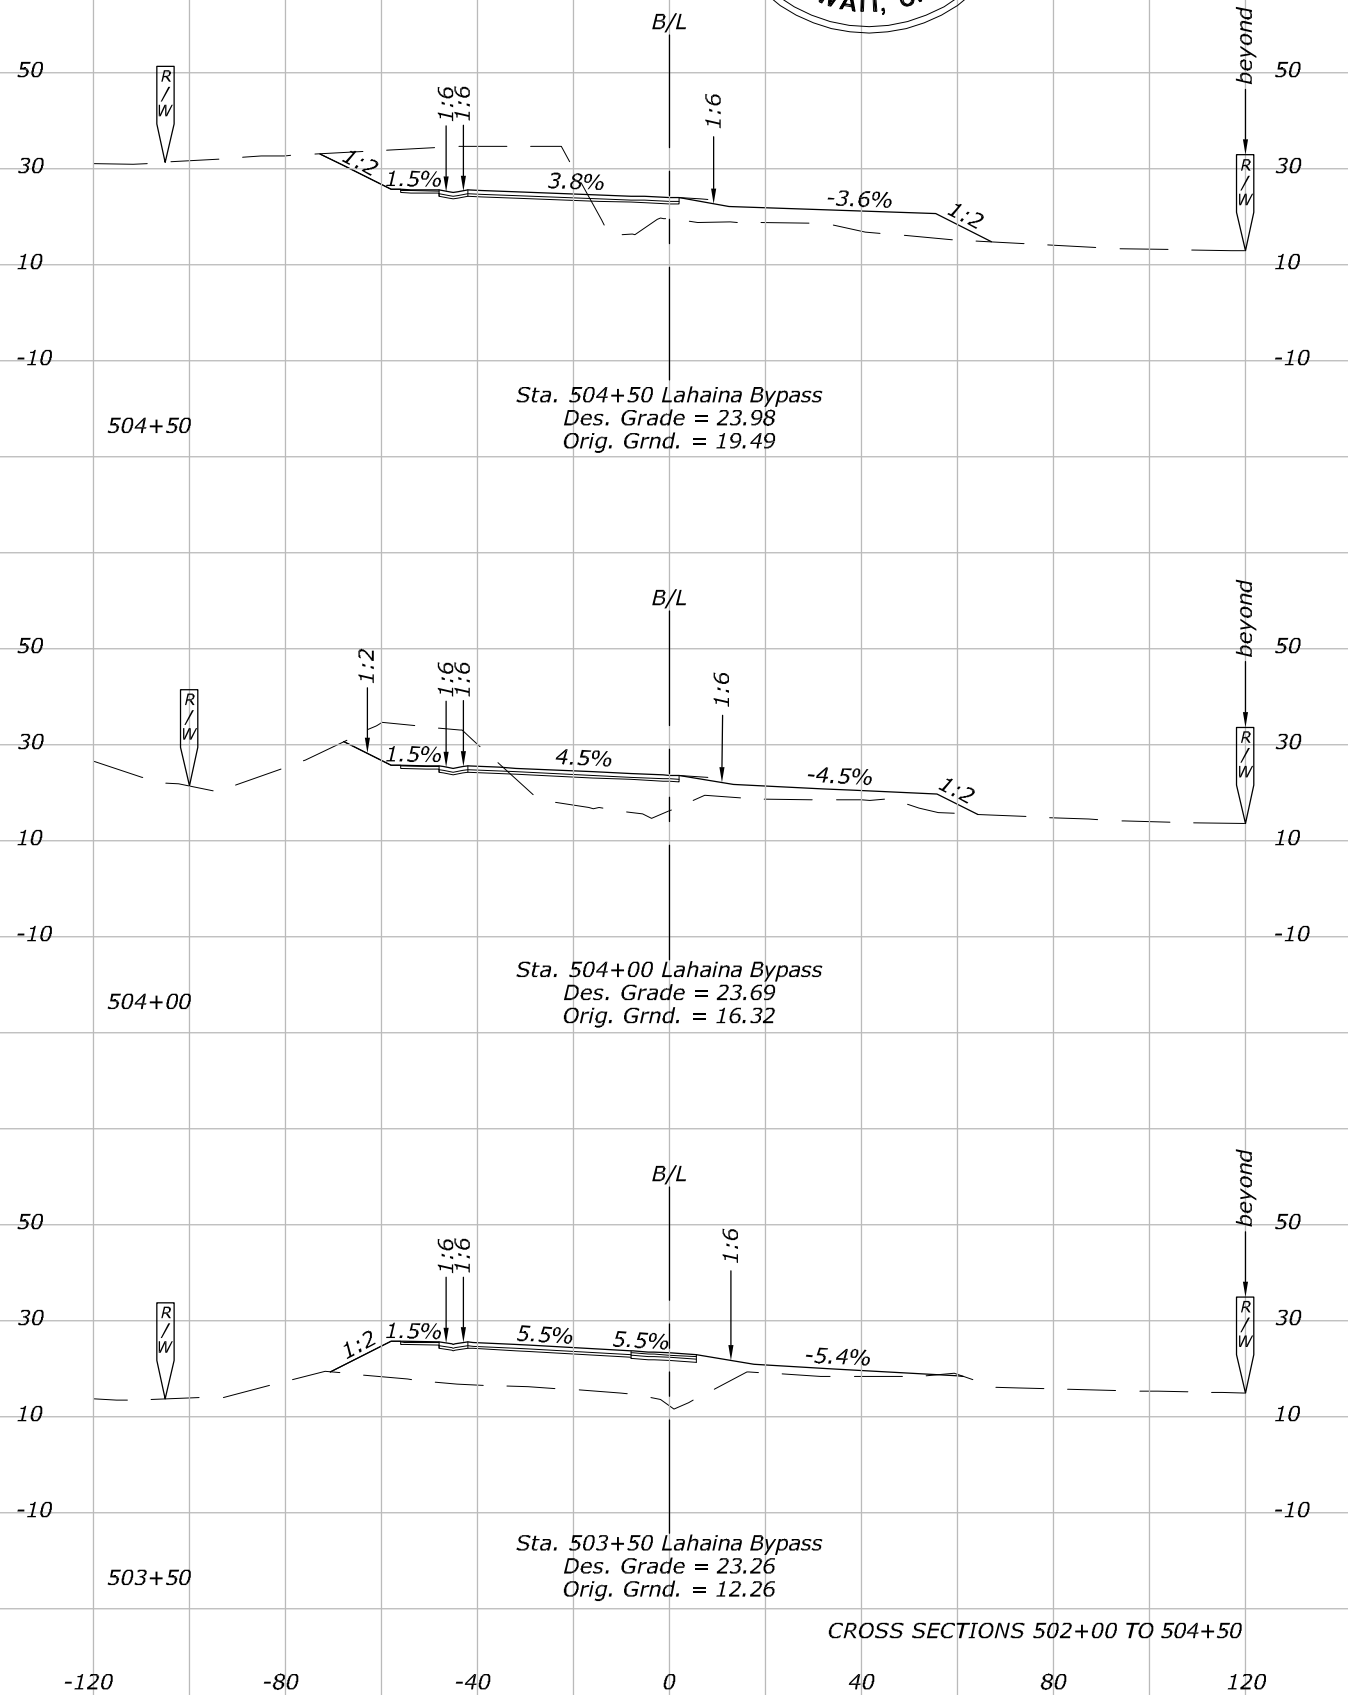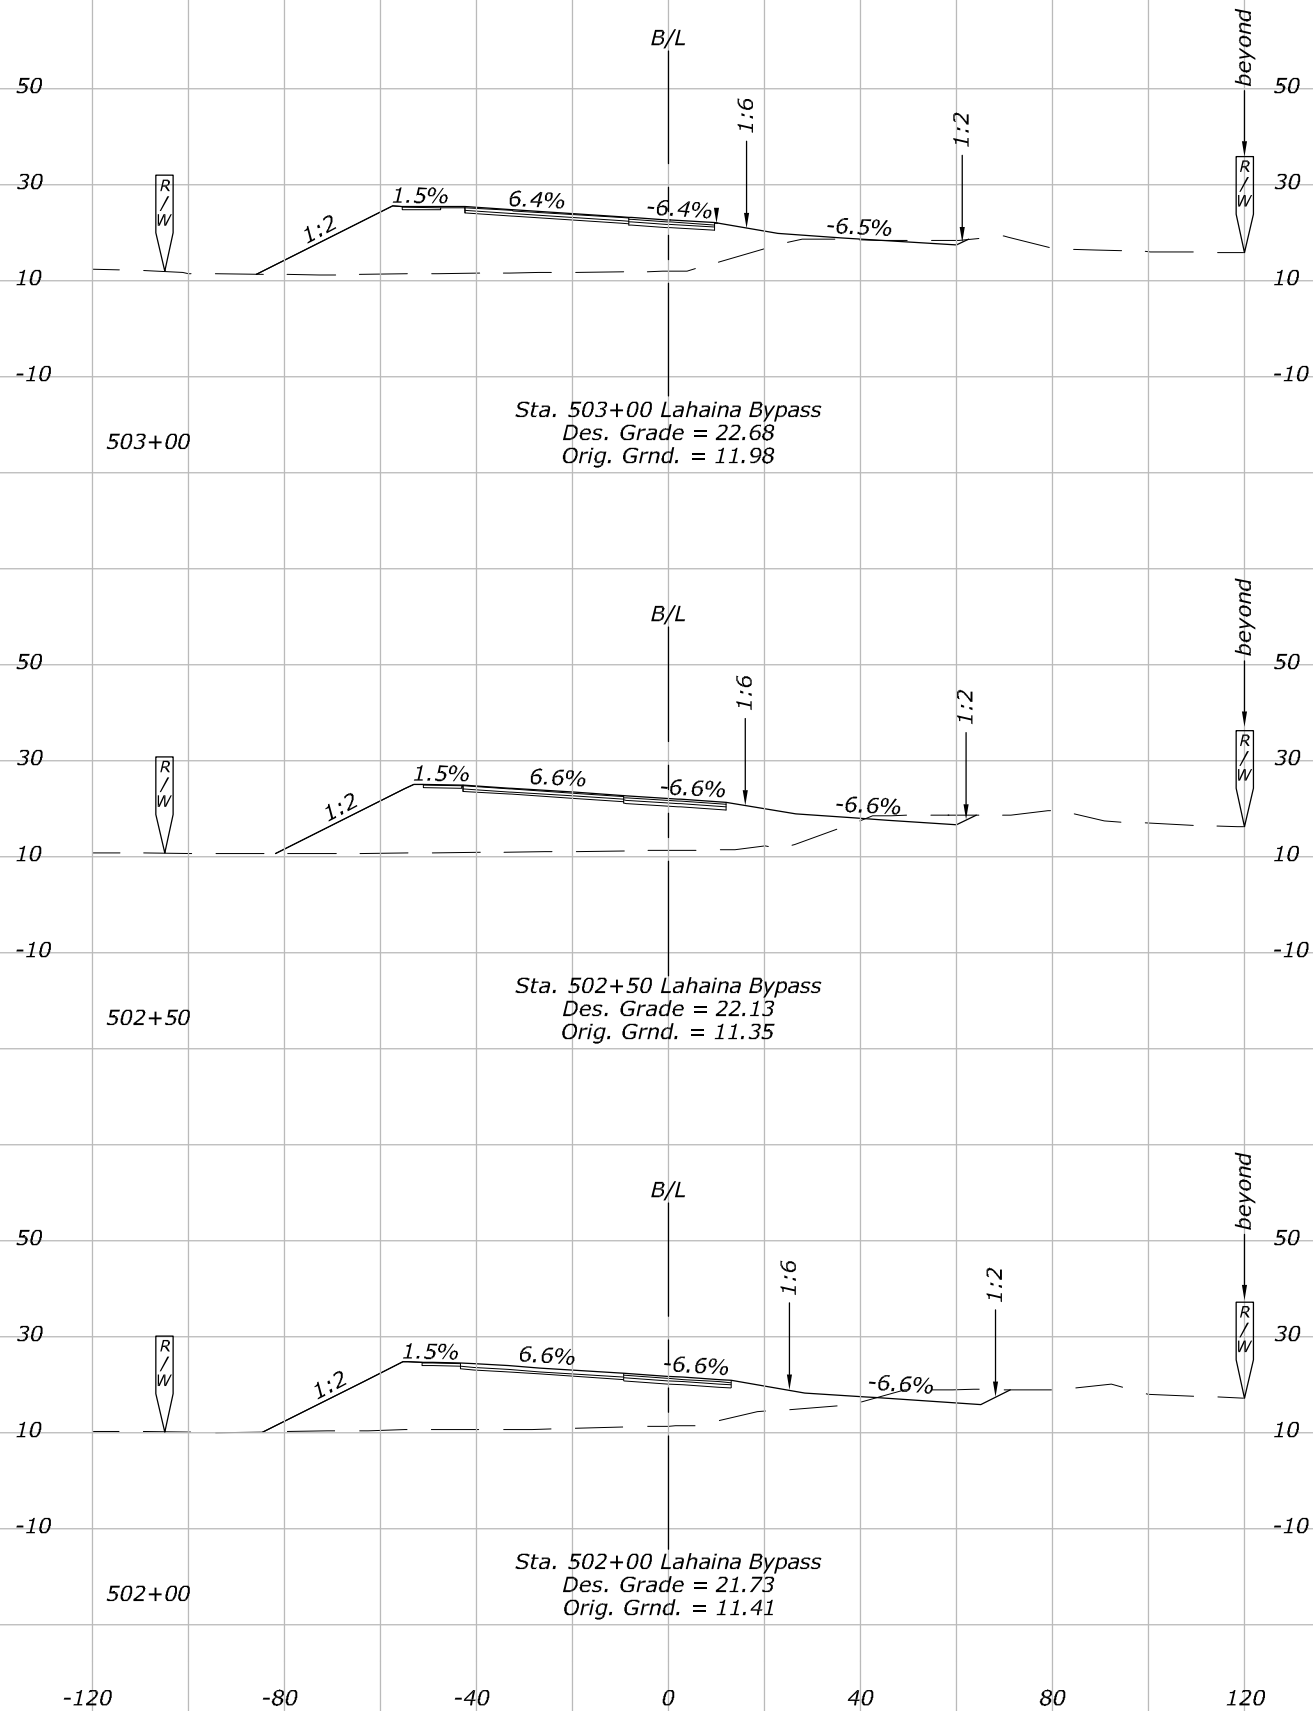

CROSS SECTIONS 502+00 TO 504+50

Patricia Choy

W:\10226-01\Civil\CADD\Site\AS-BUILT\DWGS\DRIVE_w\10226-01\Civil\CADD\Site\DWGS\X46 Cross Sections.dwg


15:24:12

January 11, 2019

NOTES:



1. Elevations Shown on Roadway
Sections are at $\frac{1}{4}$.

STATE	PROJECT	SHEET NO.
HI	HI STP SR 30(1)	X46

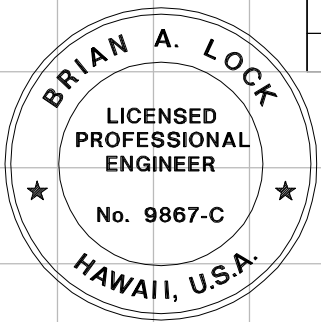

THIS WORK WAS PREPARED BY ME
OR UNDER MY SUPERVISION.

WILSON OKAMOTO CORPORATION
APRIL 30, 2020
LIC. EXP. DATE

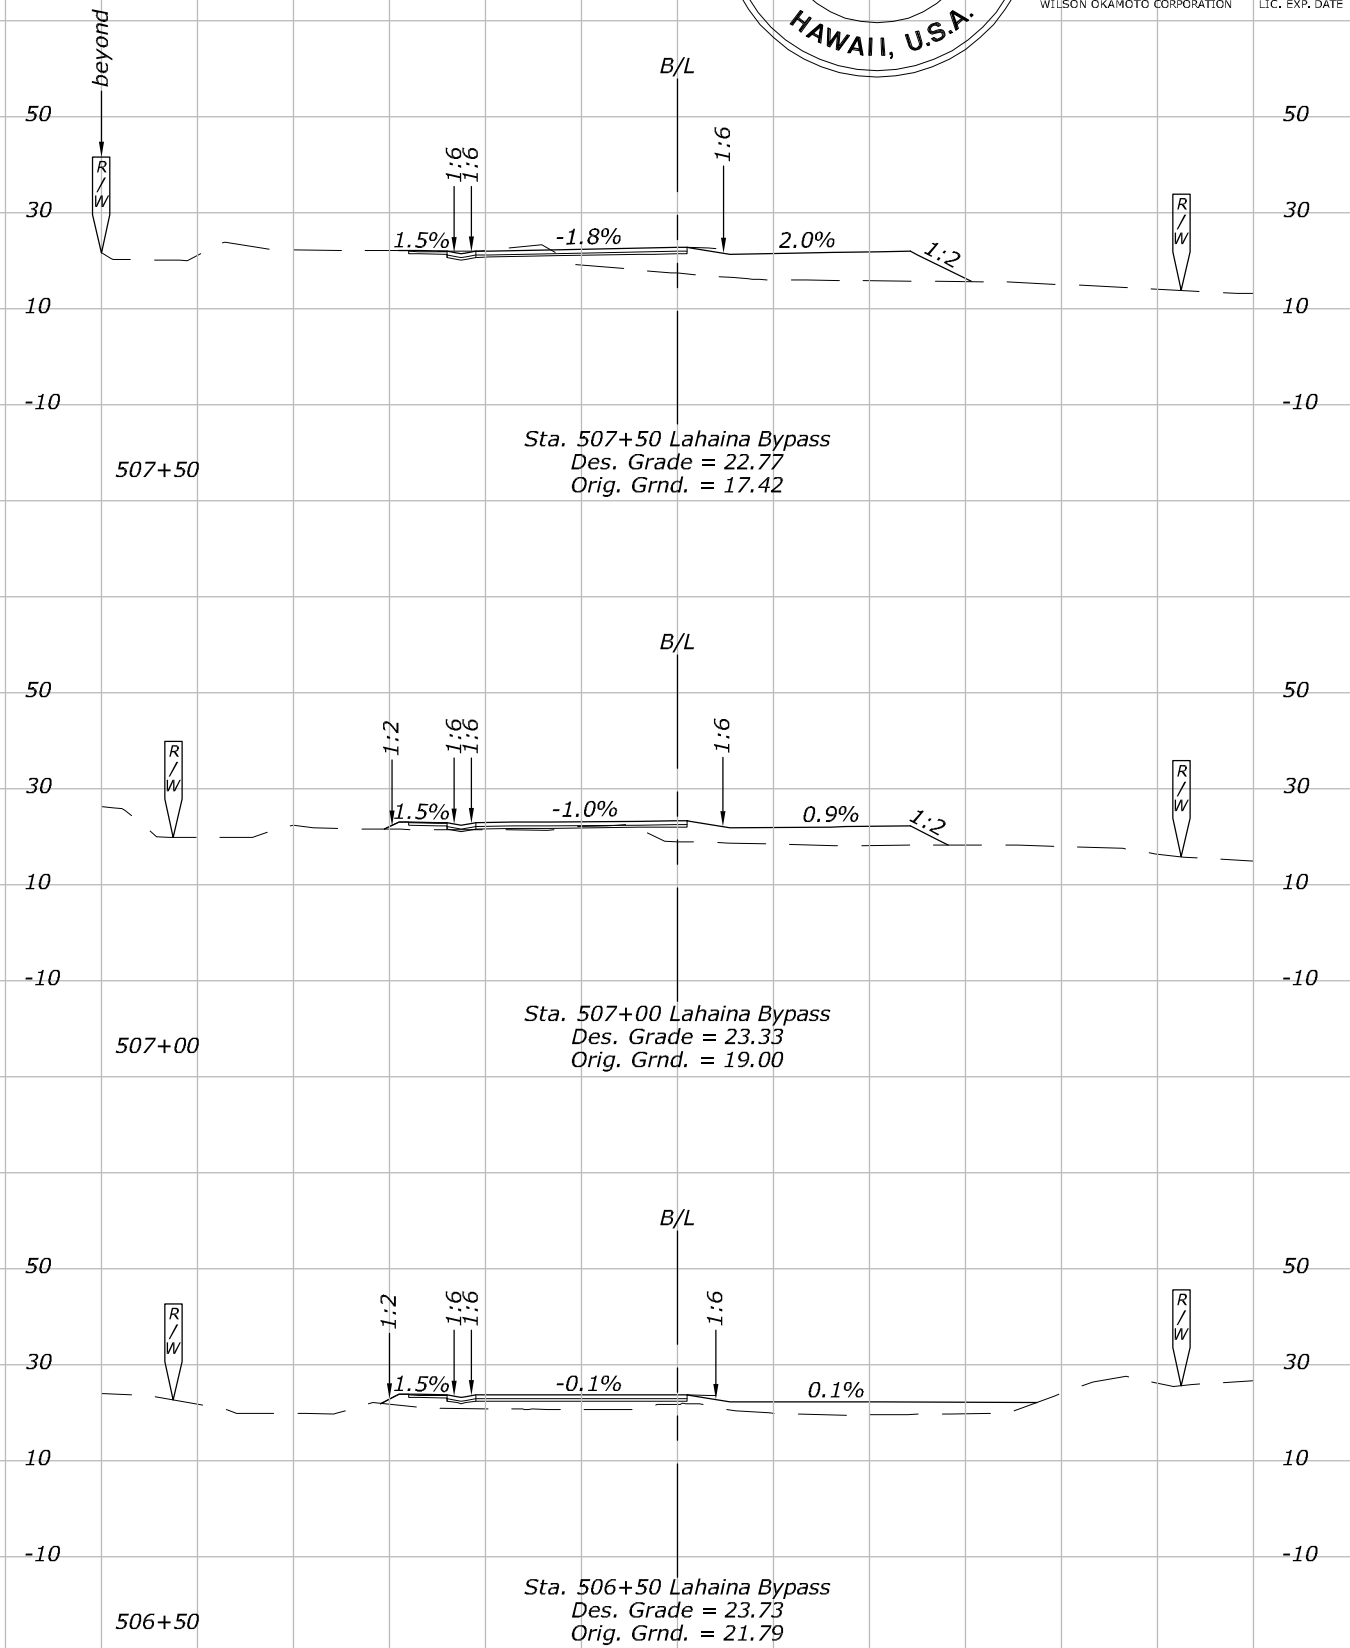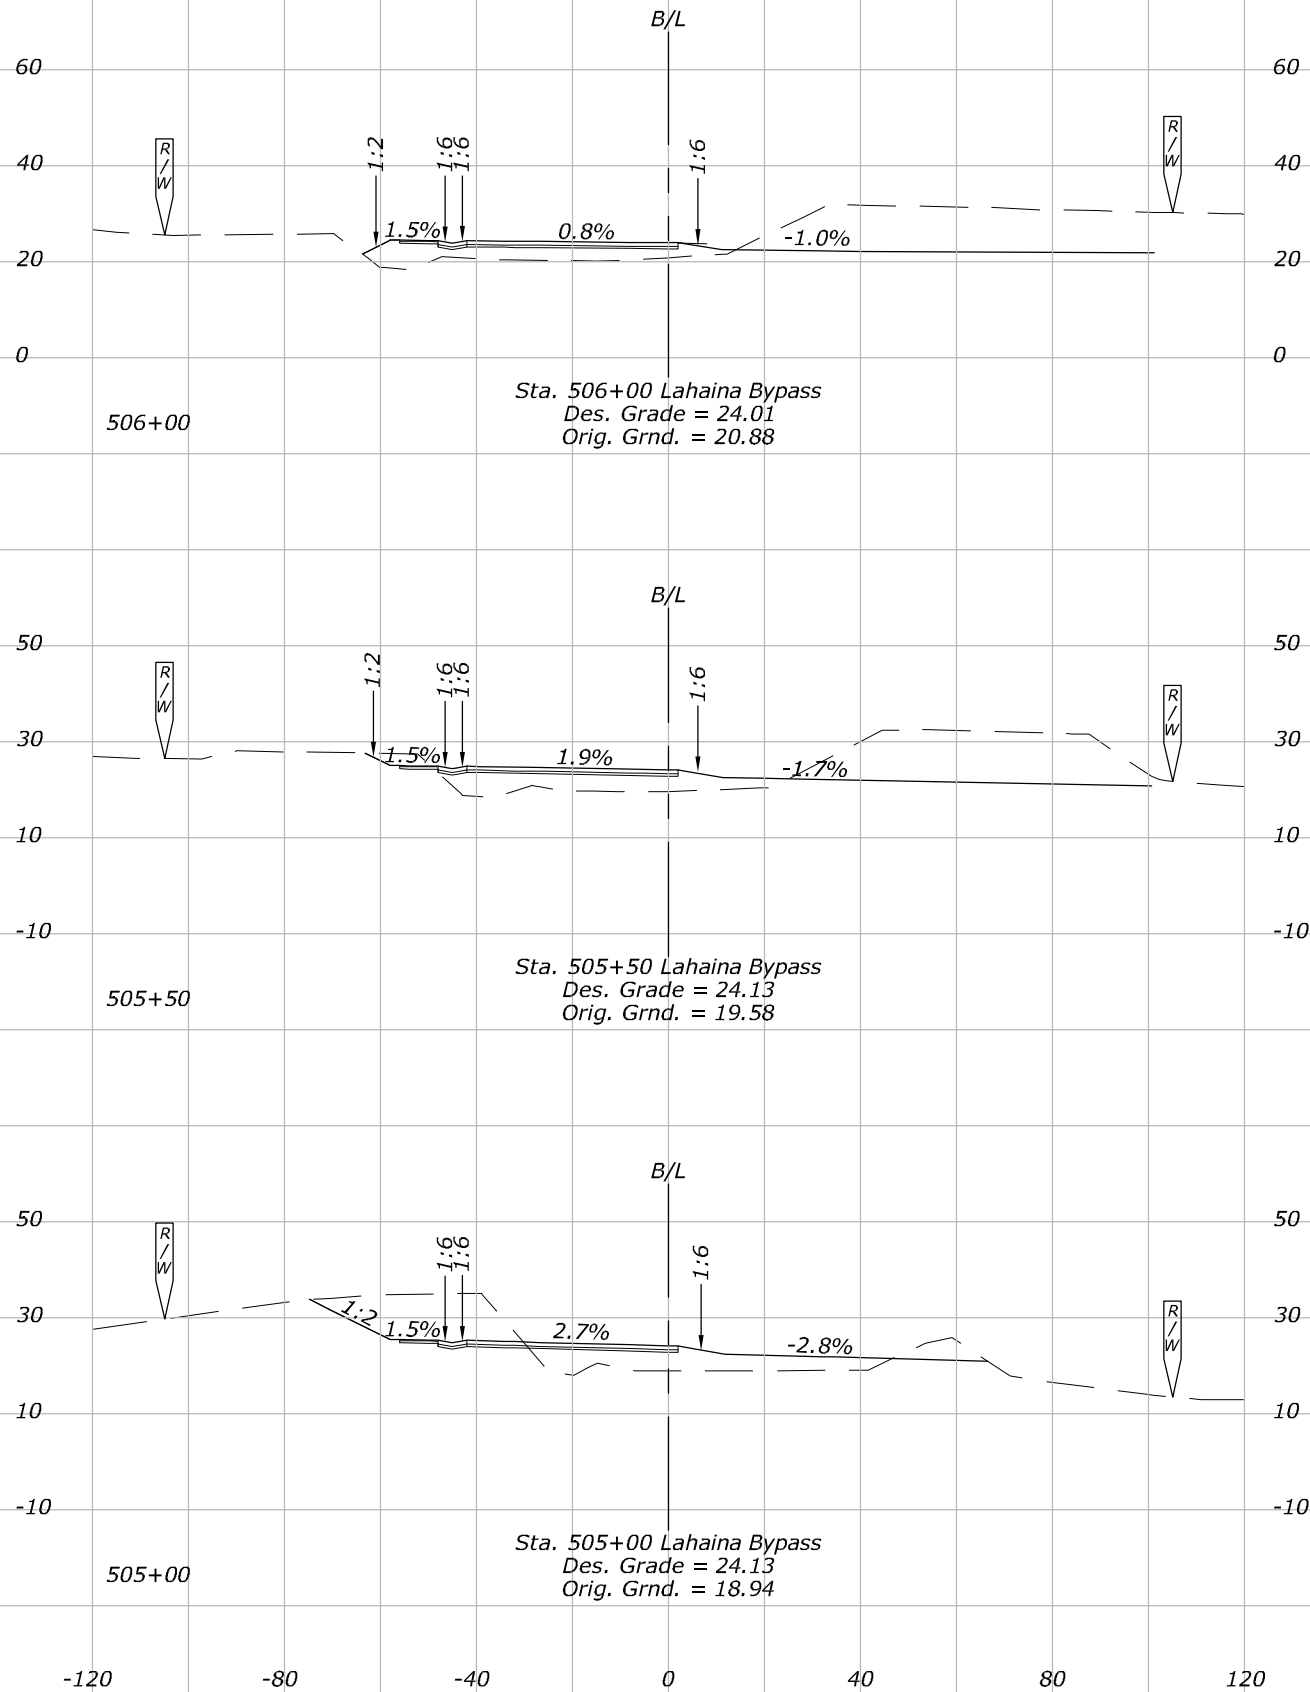

CROSS SECTIONS 505+00 TO 507+50

Patricia Choy

W:\10226-01\Civil\CADD\Site\AS-BUILT\DWGS\DRIVE_w\10226-01\Civil\CADD\Site\DWGS\X47 Cross Sections.dwg


15:33:58

January 11, 2019



NOTES:

1. Elevations Shown on Roadway
Sections are at 5'.

STATE	PROJECT	SHEET NO.
HI	HI STP SR 30(1)	X47

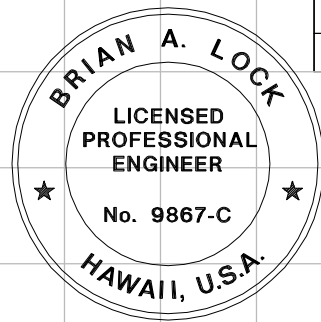

THIS WORK WAS PREPARED BY ME
OR UNDER MY SUPERVISION.
WILSON OKAMOTO CORPORATION
APRIL 30, 2020
LIC. EXP. DATE

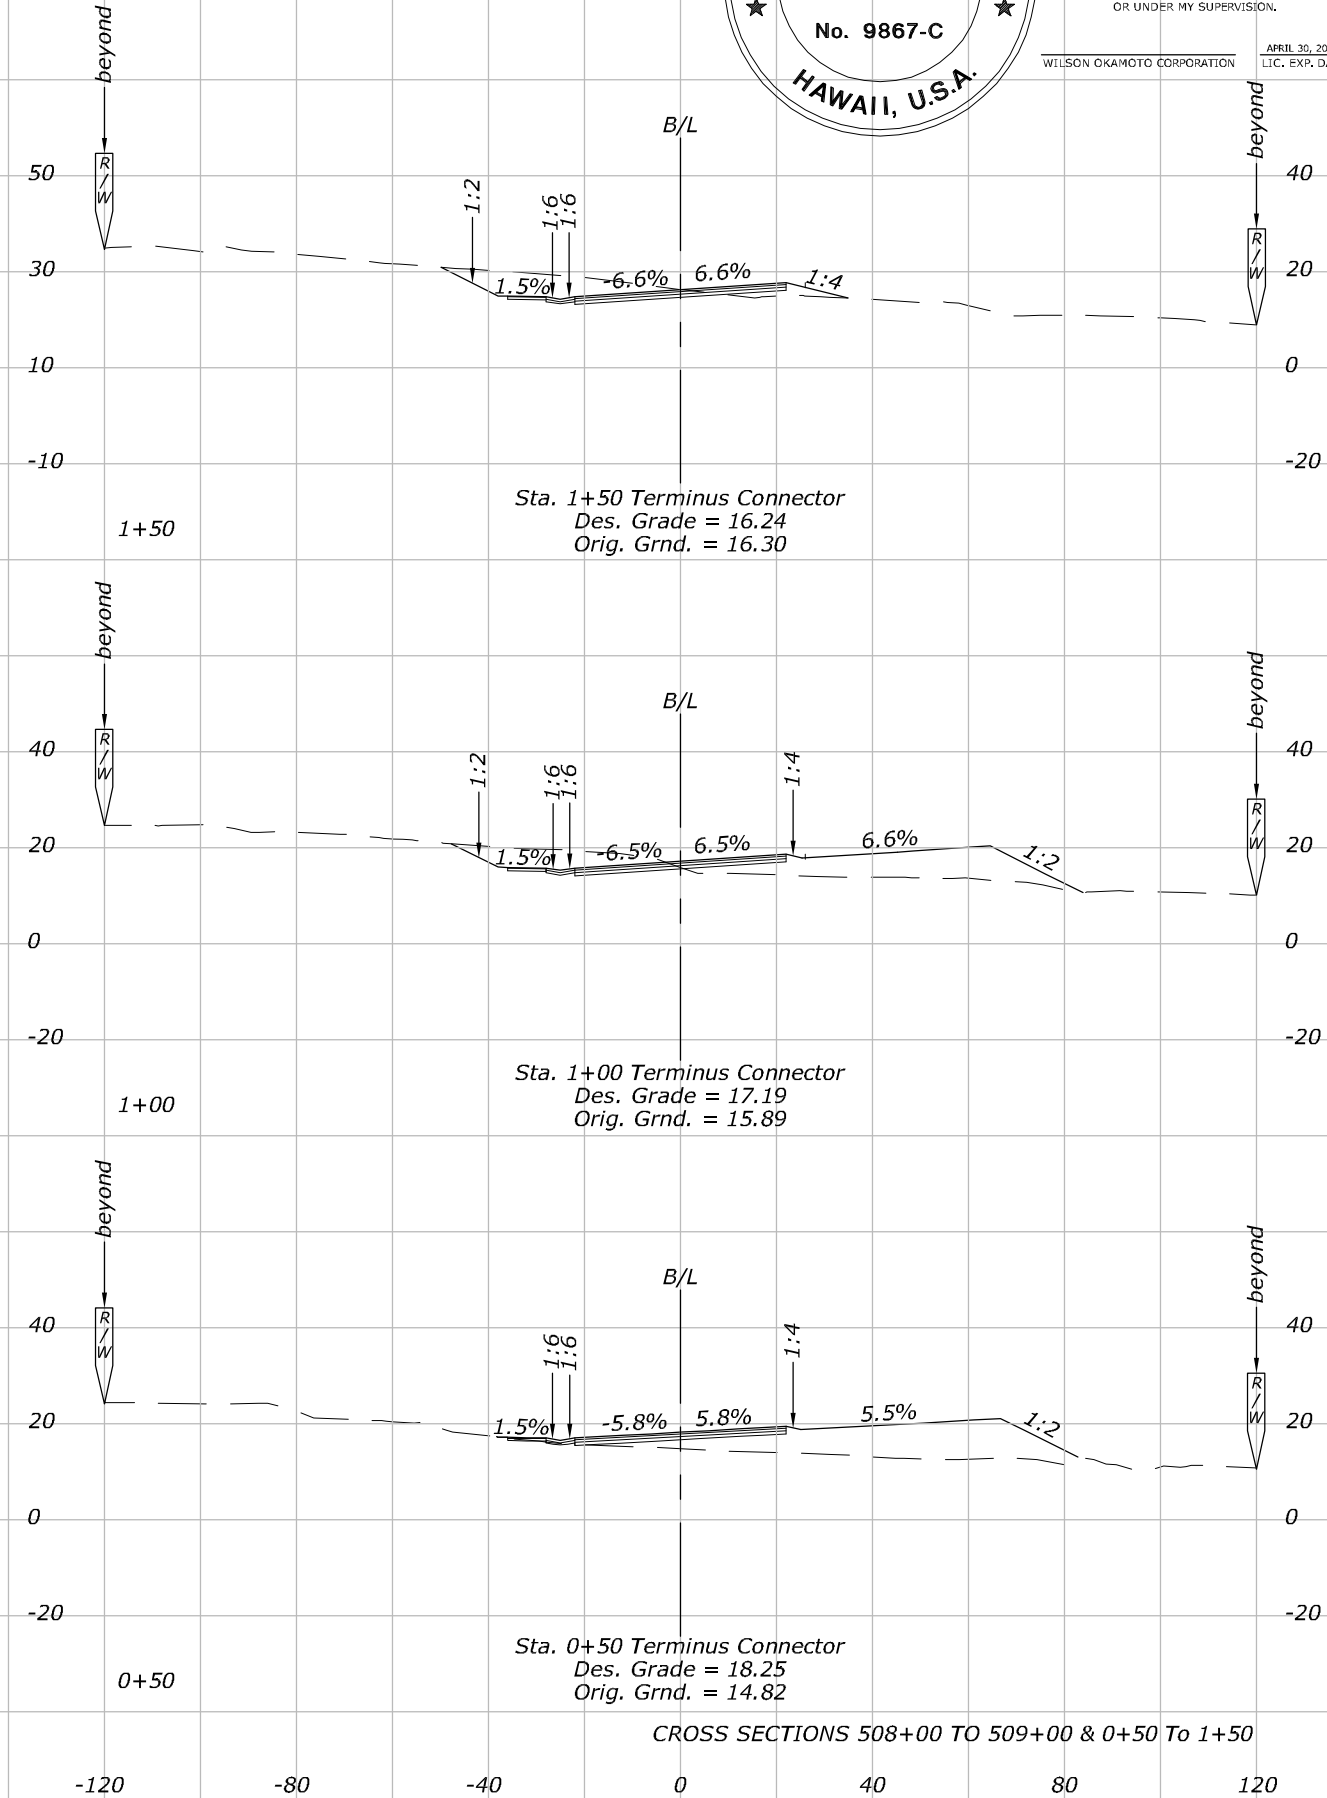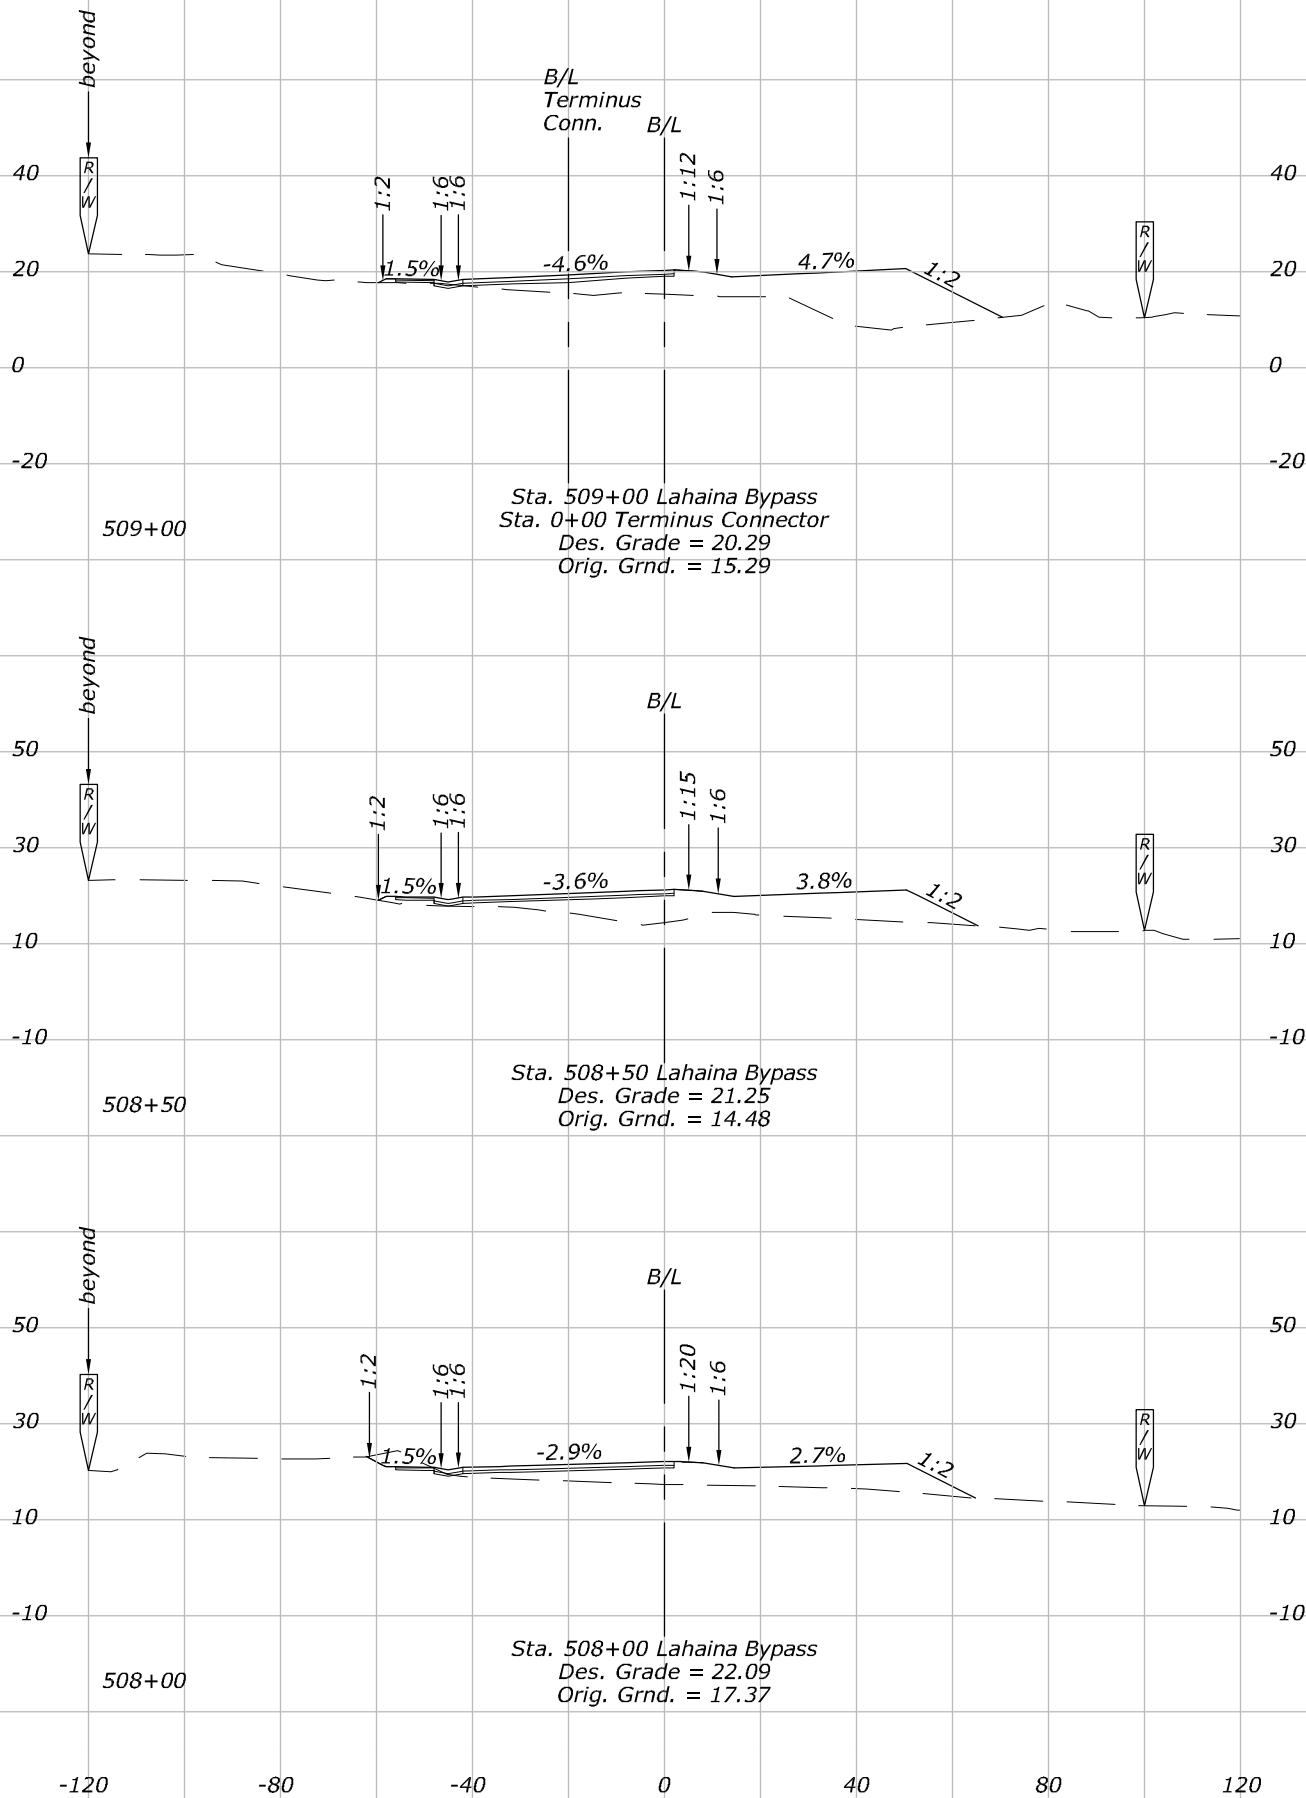

CROSS SECTIONS 508+00 TO 509+00 & 0+50 To 1+50

Patricia Choy

W:\10226-01\Civil\CADD\Site\AS-BUILT\DWGS\DRIVE_w\10226-01\Civil\CADD\Site\DWGS\X48 Cross Sections.dwg


12:42:14

January 11, 2019

NOTES:



1. Elevations Shown on Roadway
Sections are at 10'.

STATE	PROJECT	SHEET NO.
HI	HI STP SR 30(1)	X48

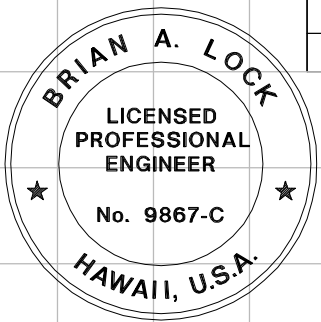

THIS WORK WAS PREPARED BY ME
OR UNDER MY SUPERVISION.

WILSON OKAMOTO CORPORATION
APRIL 30, 2020
LIC. EXP. DATE

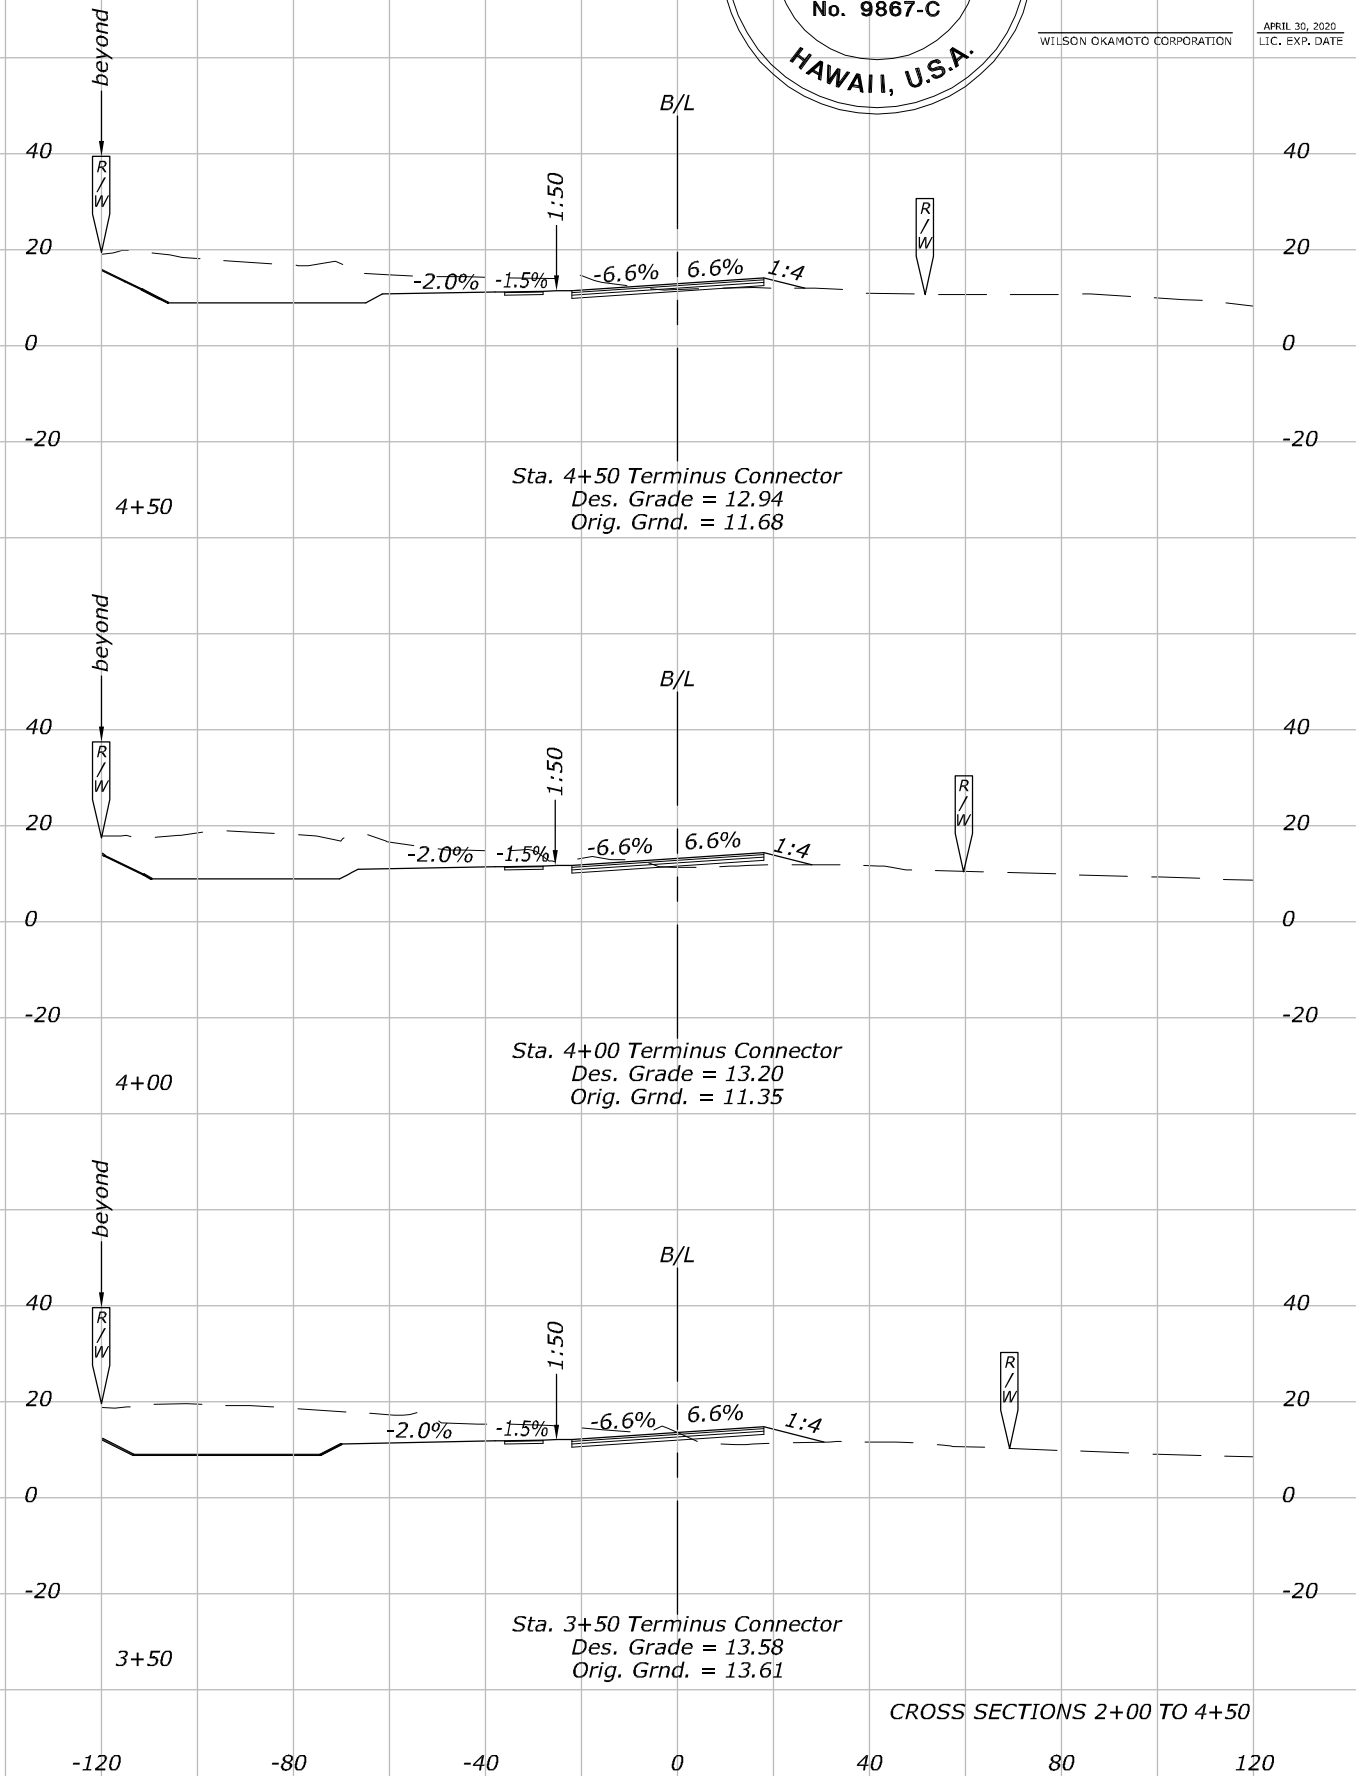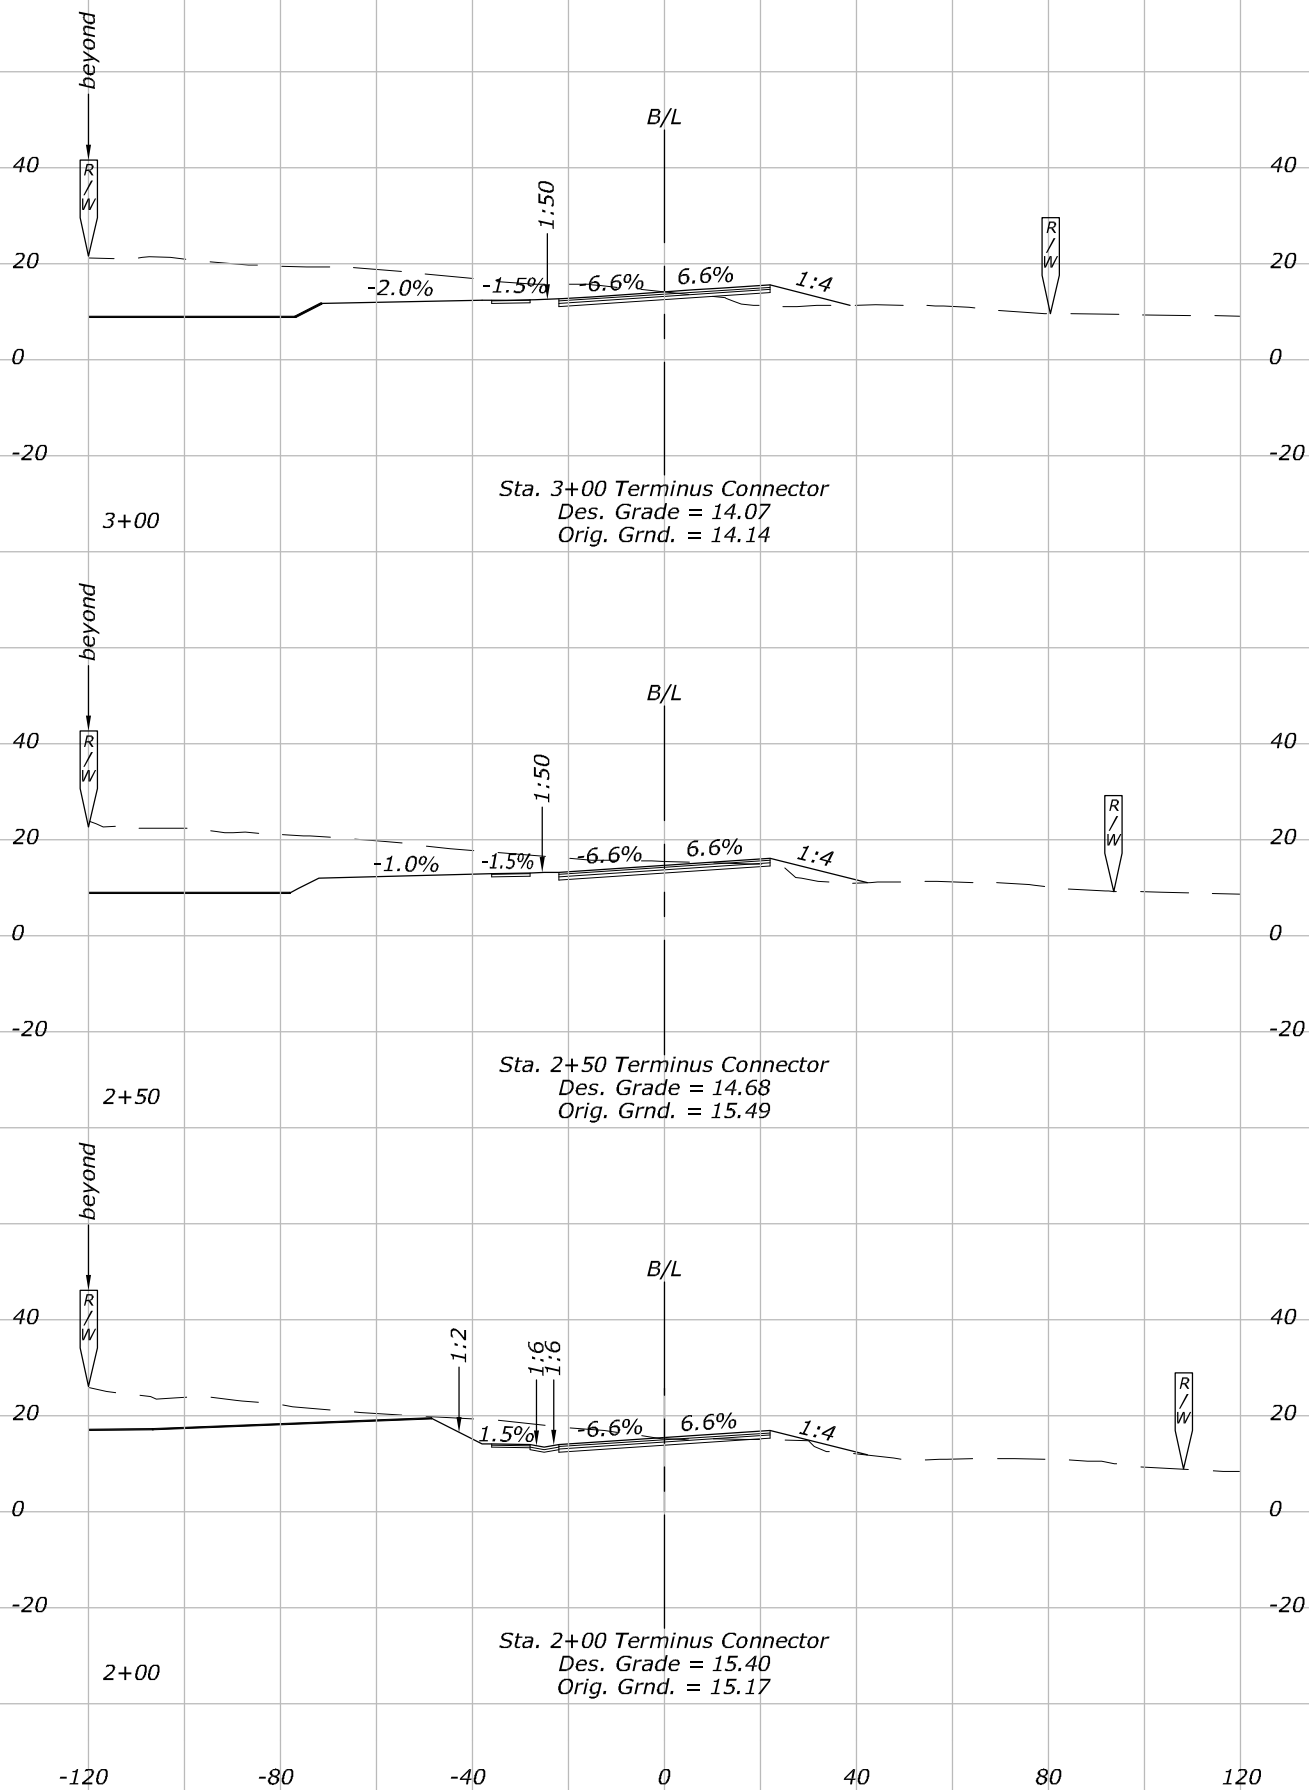

CROSS SECTIONS 2+00 TO 4+50

Patricia Choy

W:\10226-01\Civil\CADD\Site\AS-BUILT\DWGS\DRIVE - w\10226-01\Civil\CADD\Site\DWGS\X49 Cross Sections.dwg


12:42:30

January 11, 2019

NOTES:



1. Elevations Shown on Roadway
Sections are at 5'.

STATE	PROJECT	SHEET NO.
HI	HI STP SR 30(1)	X49

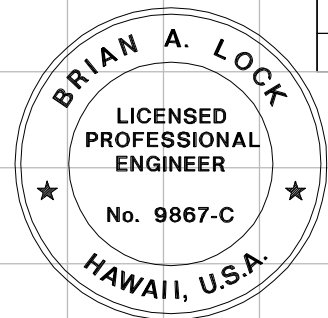

THIS WORK WAS PREPARED BY ME
OR UNDER MY SUPERVISION.

WILSON OKAMOTO CORPORATION
APRIL 30, 2020
LIC. EXP. DATE

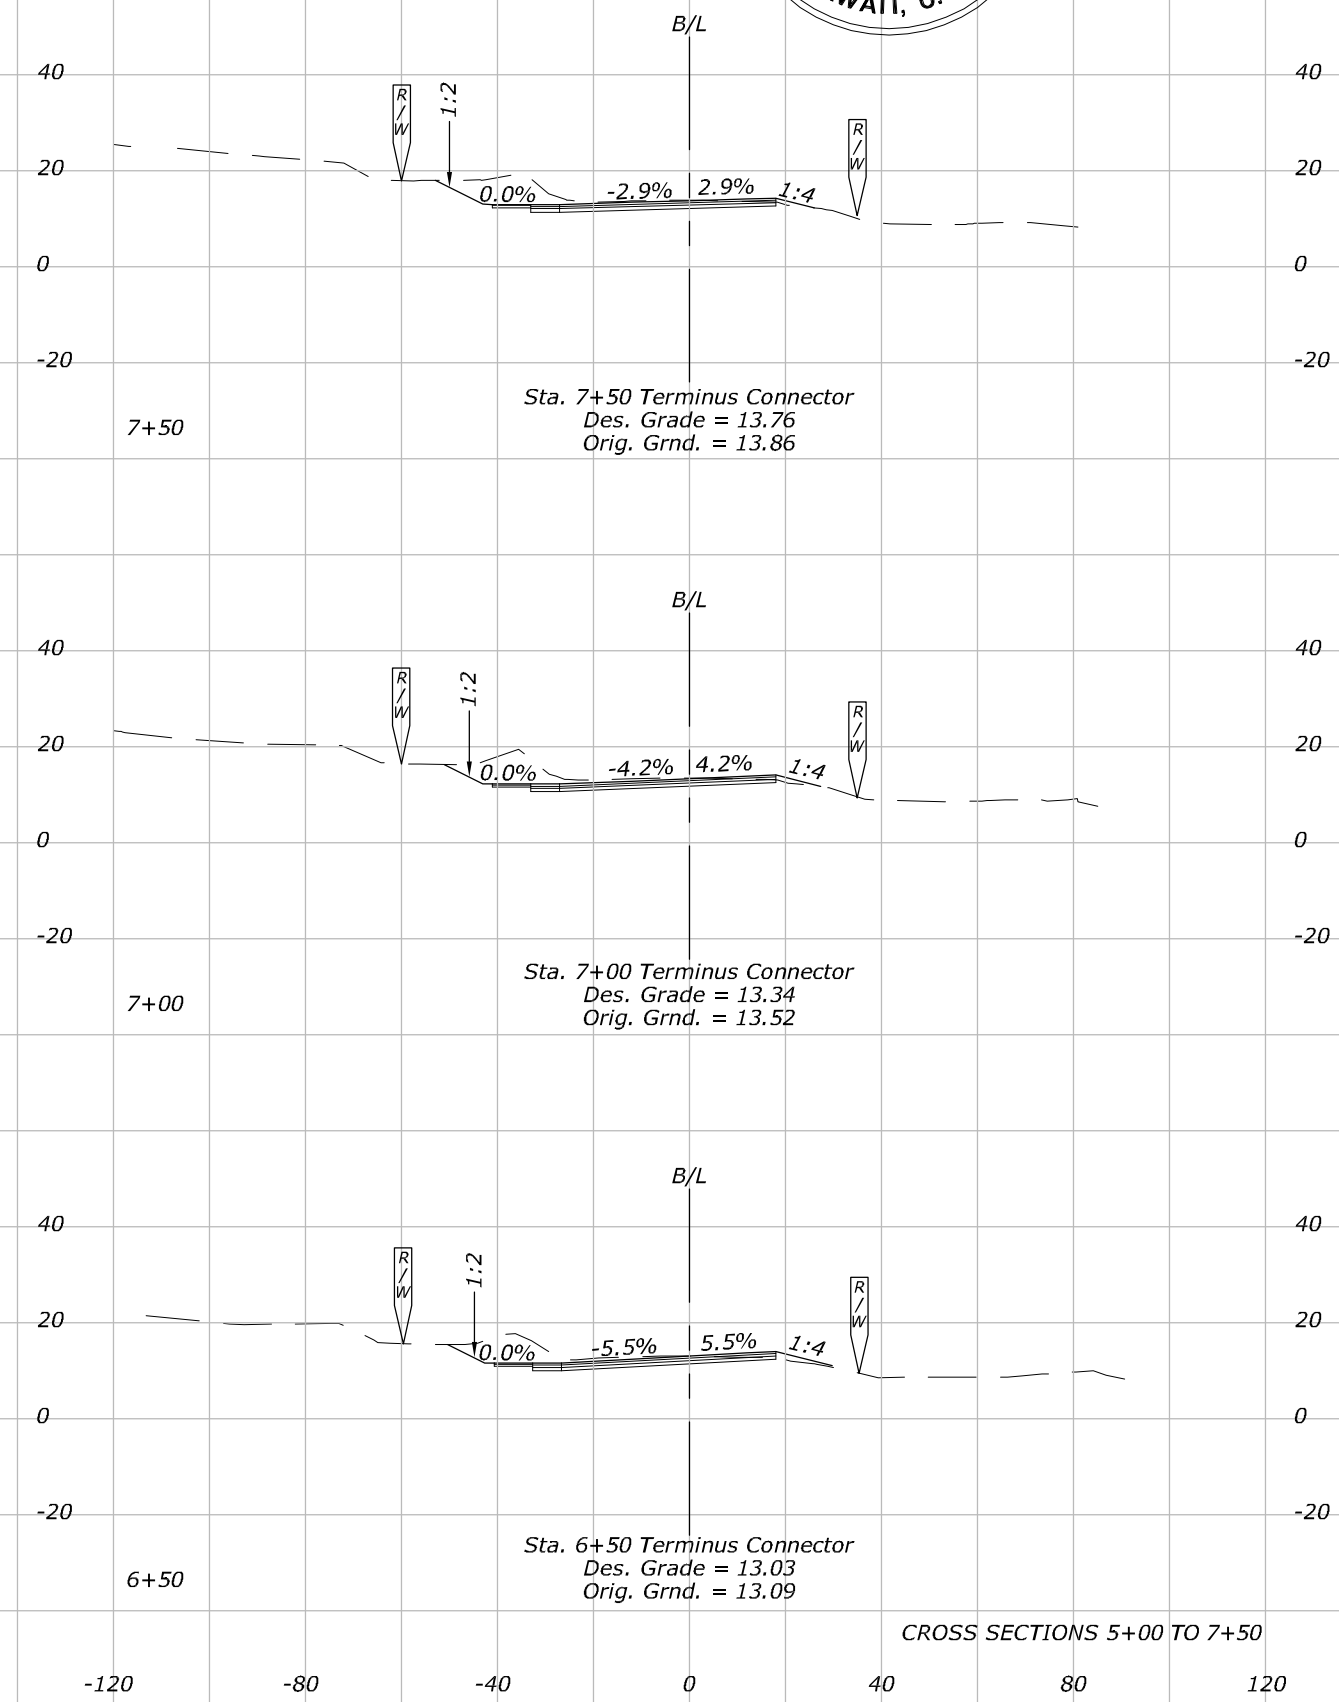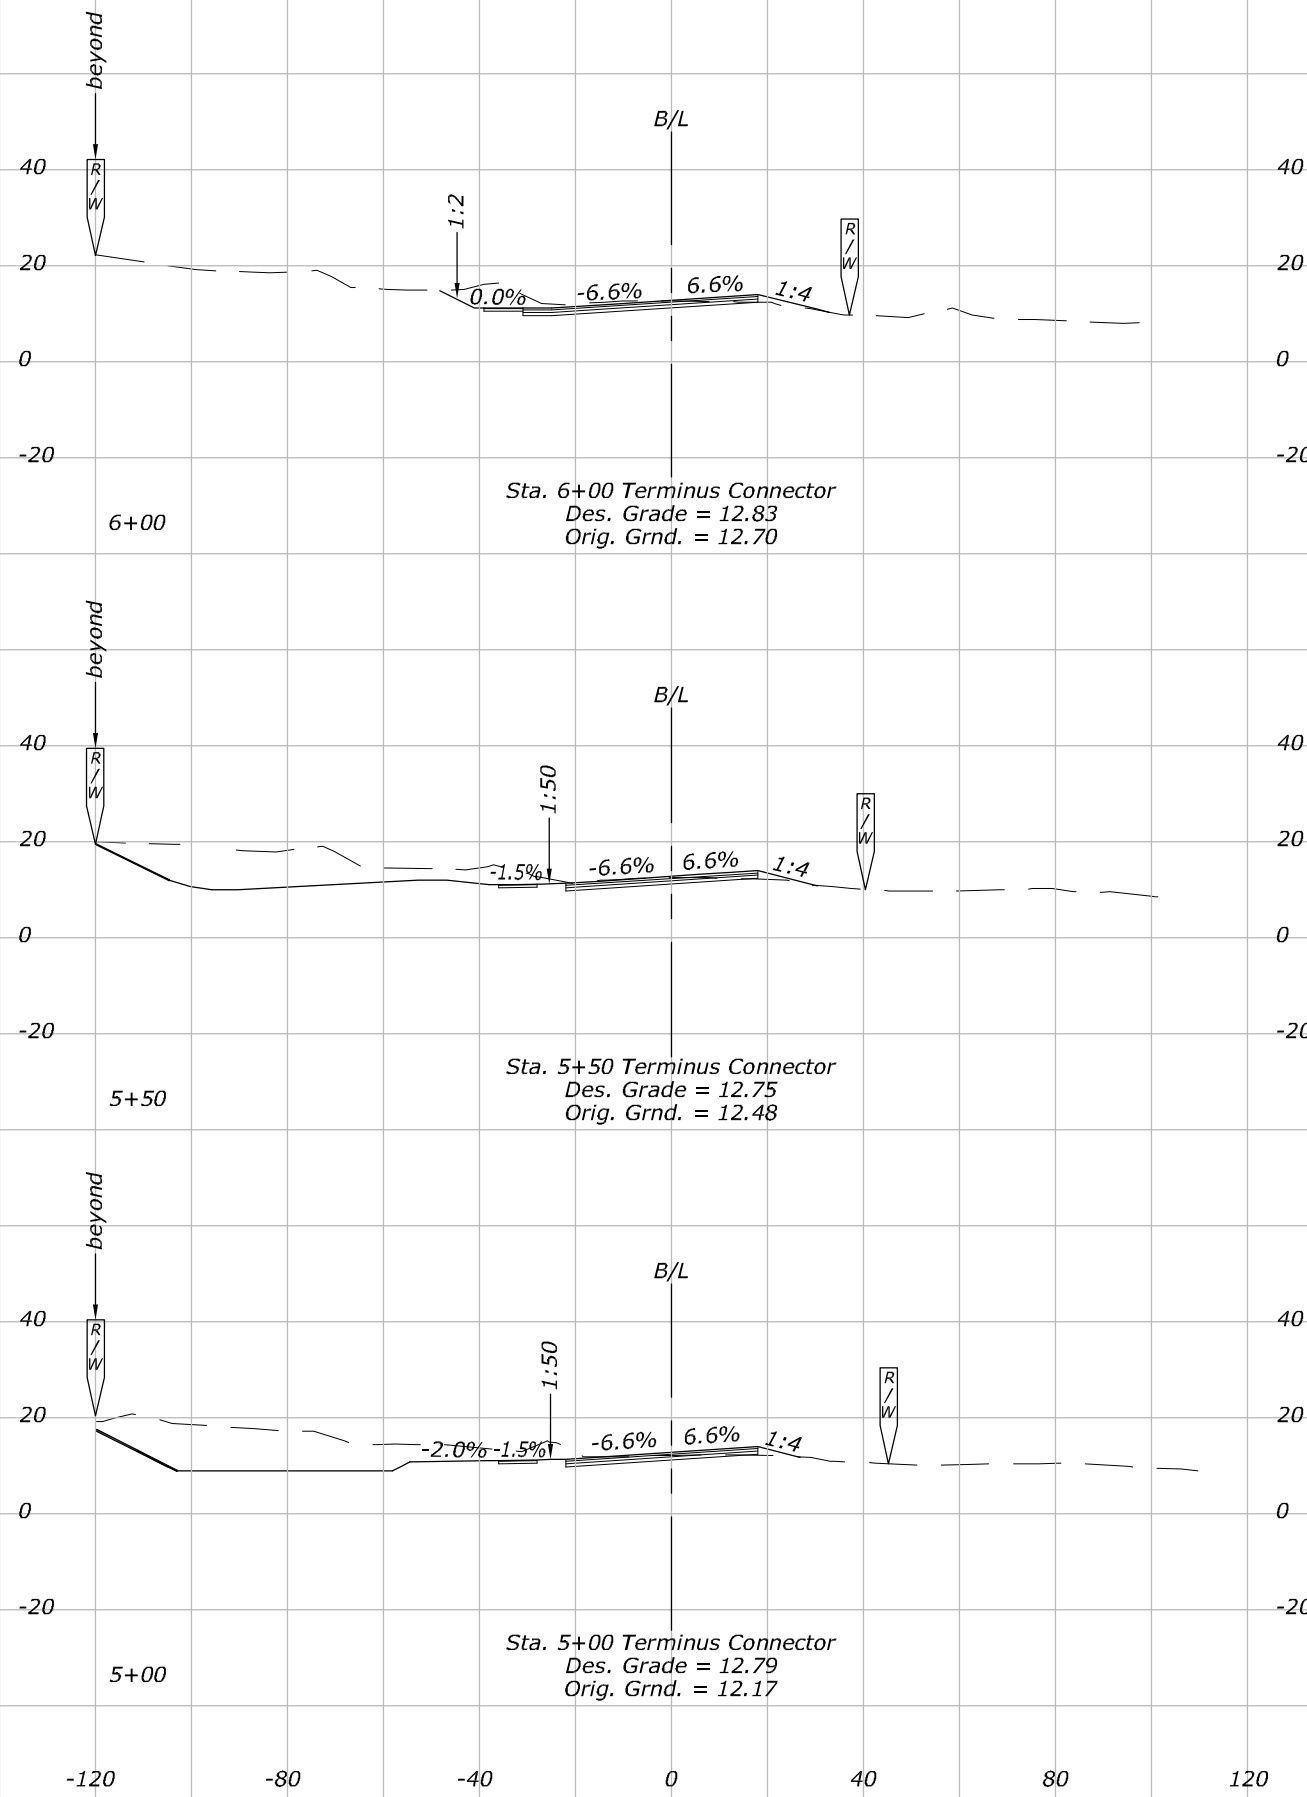

CROSS SECTIONS 5+00 TO 7+50

Patricia Choy

W:\10226-01\Civil\CADD\Site\DWGS\DRIVE_w\10226-01\Civil\CADD\Site\DWGS\X50 Cross Sections.dwg


12:42:48

January 11, 2019






NOTES:

1. Elevations Shown on Roadway
Sections are at 5'.

STATE	PROJECT	SHEET NO.
HI	HI STP SR 30(1)	X50

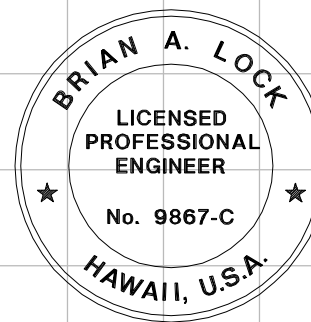

THIS WORK WAS PREPARED BY ME OR UNDER MY SUPERVISION.		APRIL 30, 2020 LIC. EXP. DATE
WILSON OKAMOTO CORPORATION		

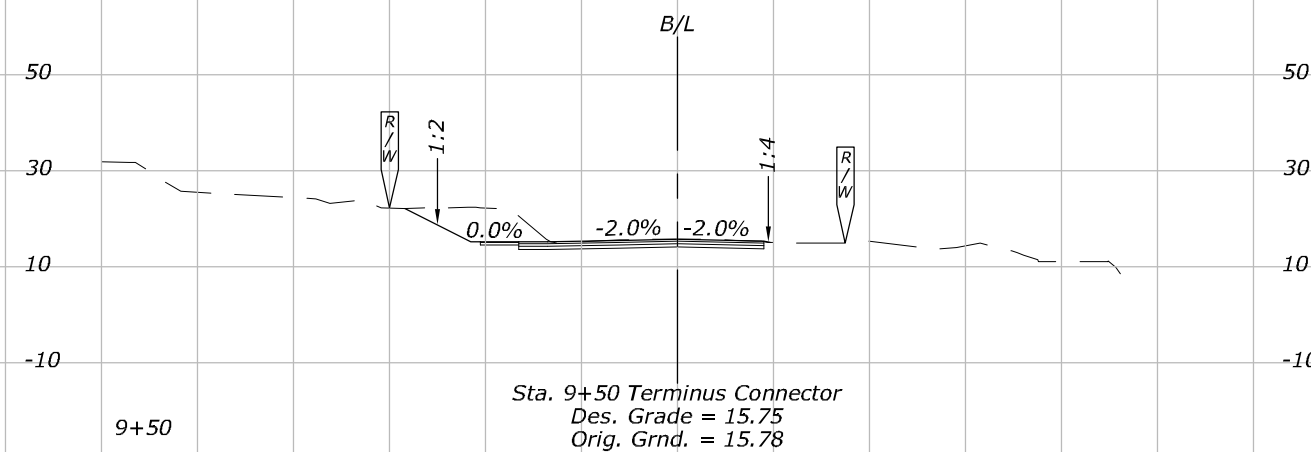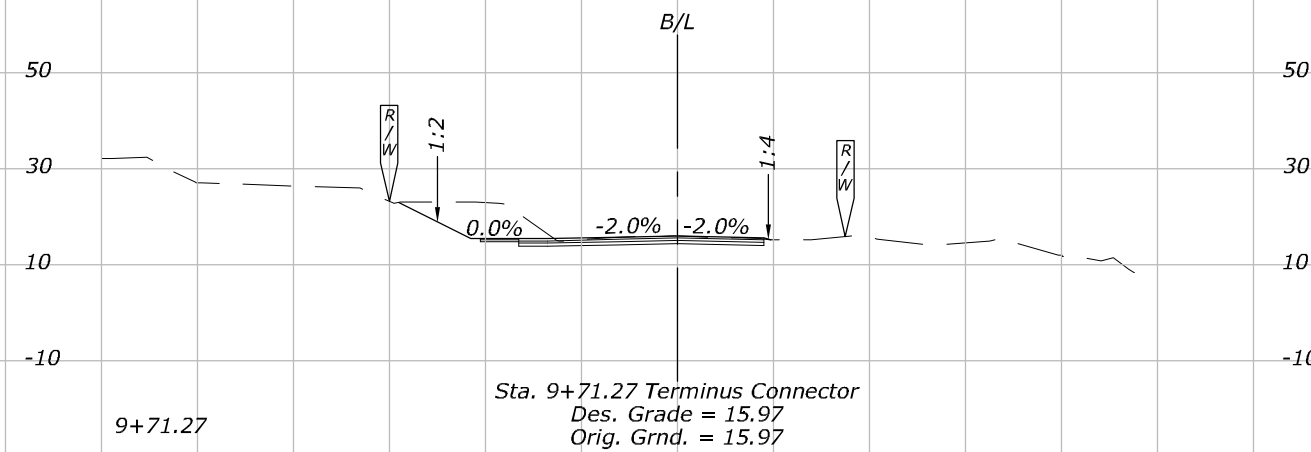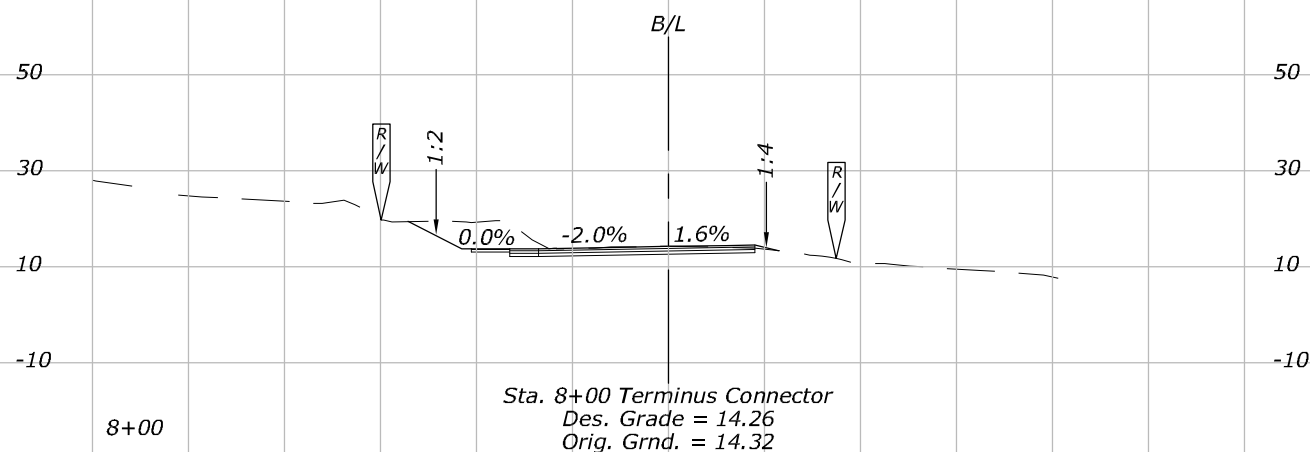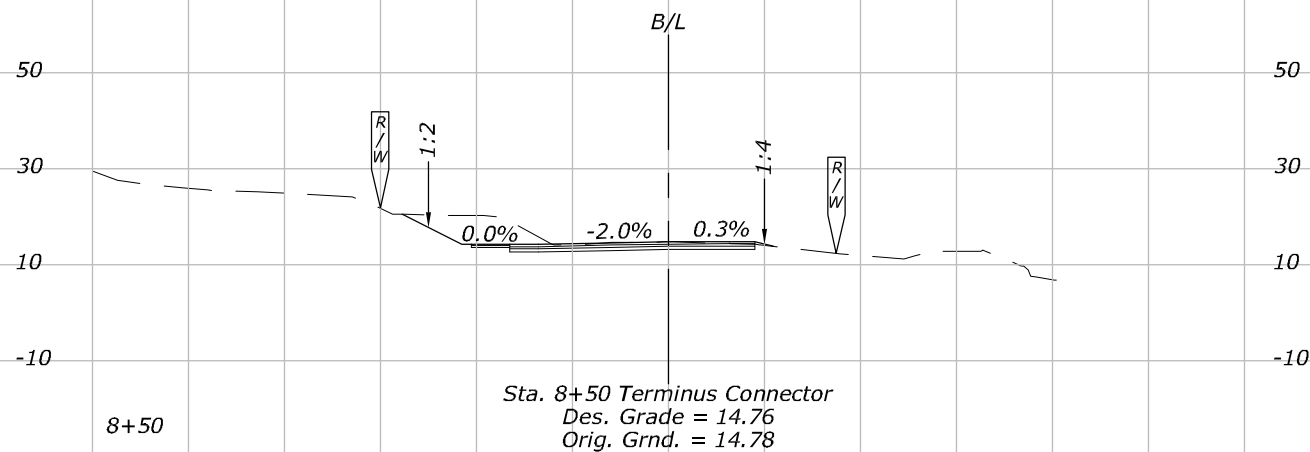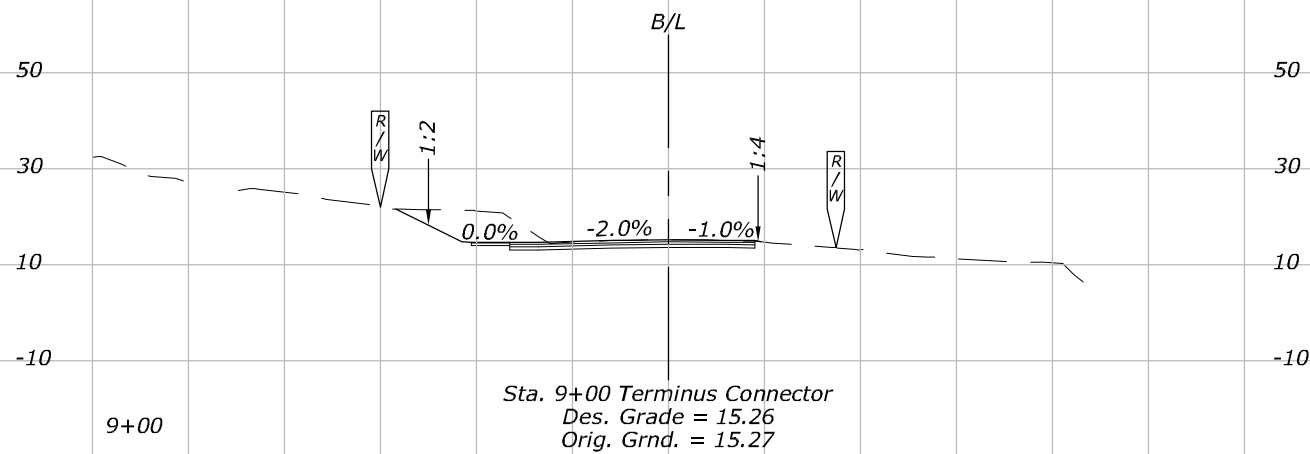

CROSS SECTIONS 8+00 TO 9+71.27