
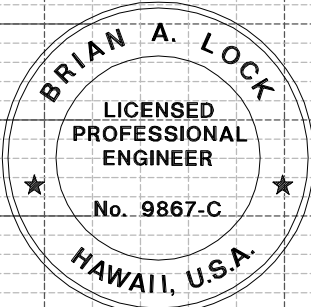
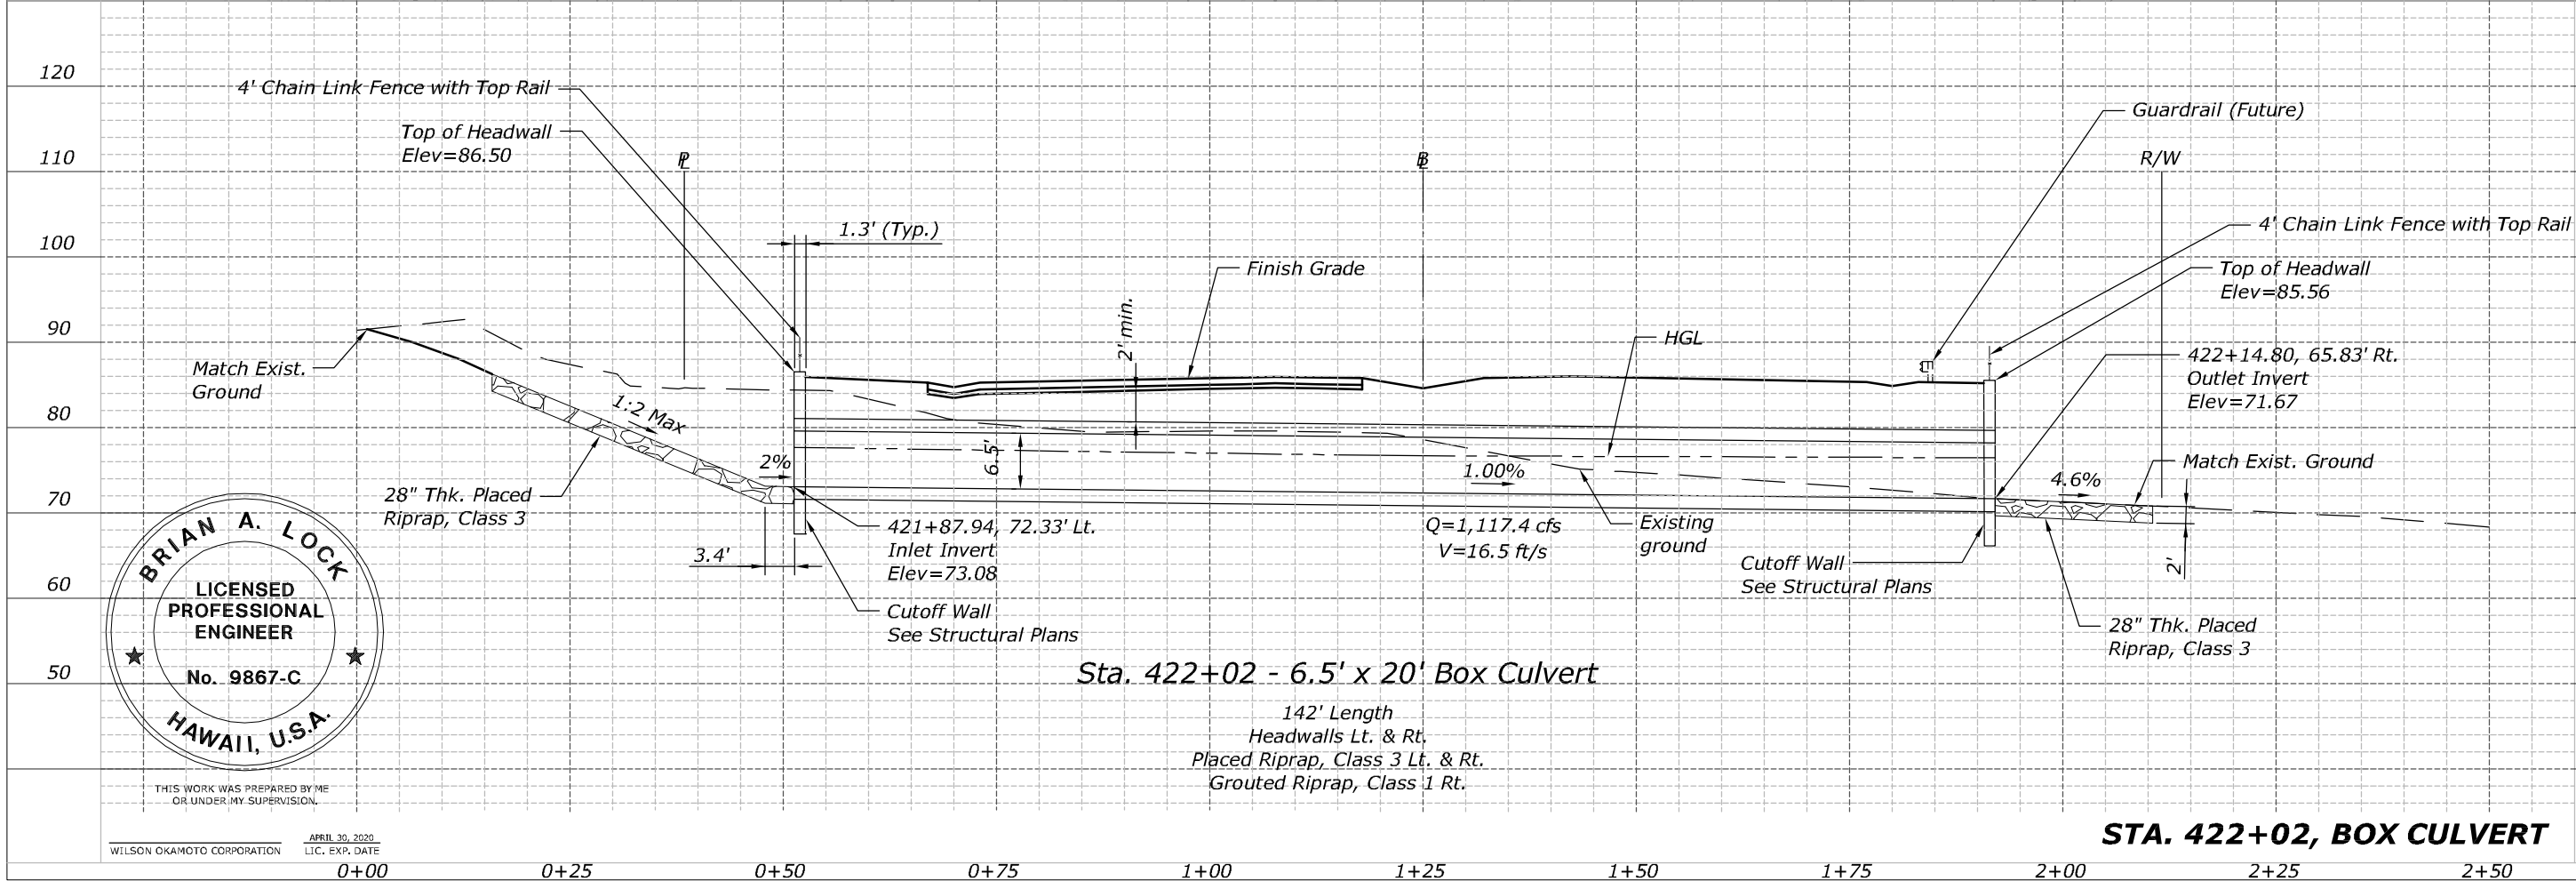


STATE	PROJECT	SHEET NO.
HI	HI STP SR 30(1)	T50

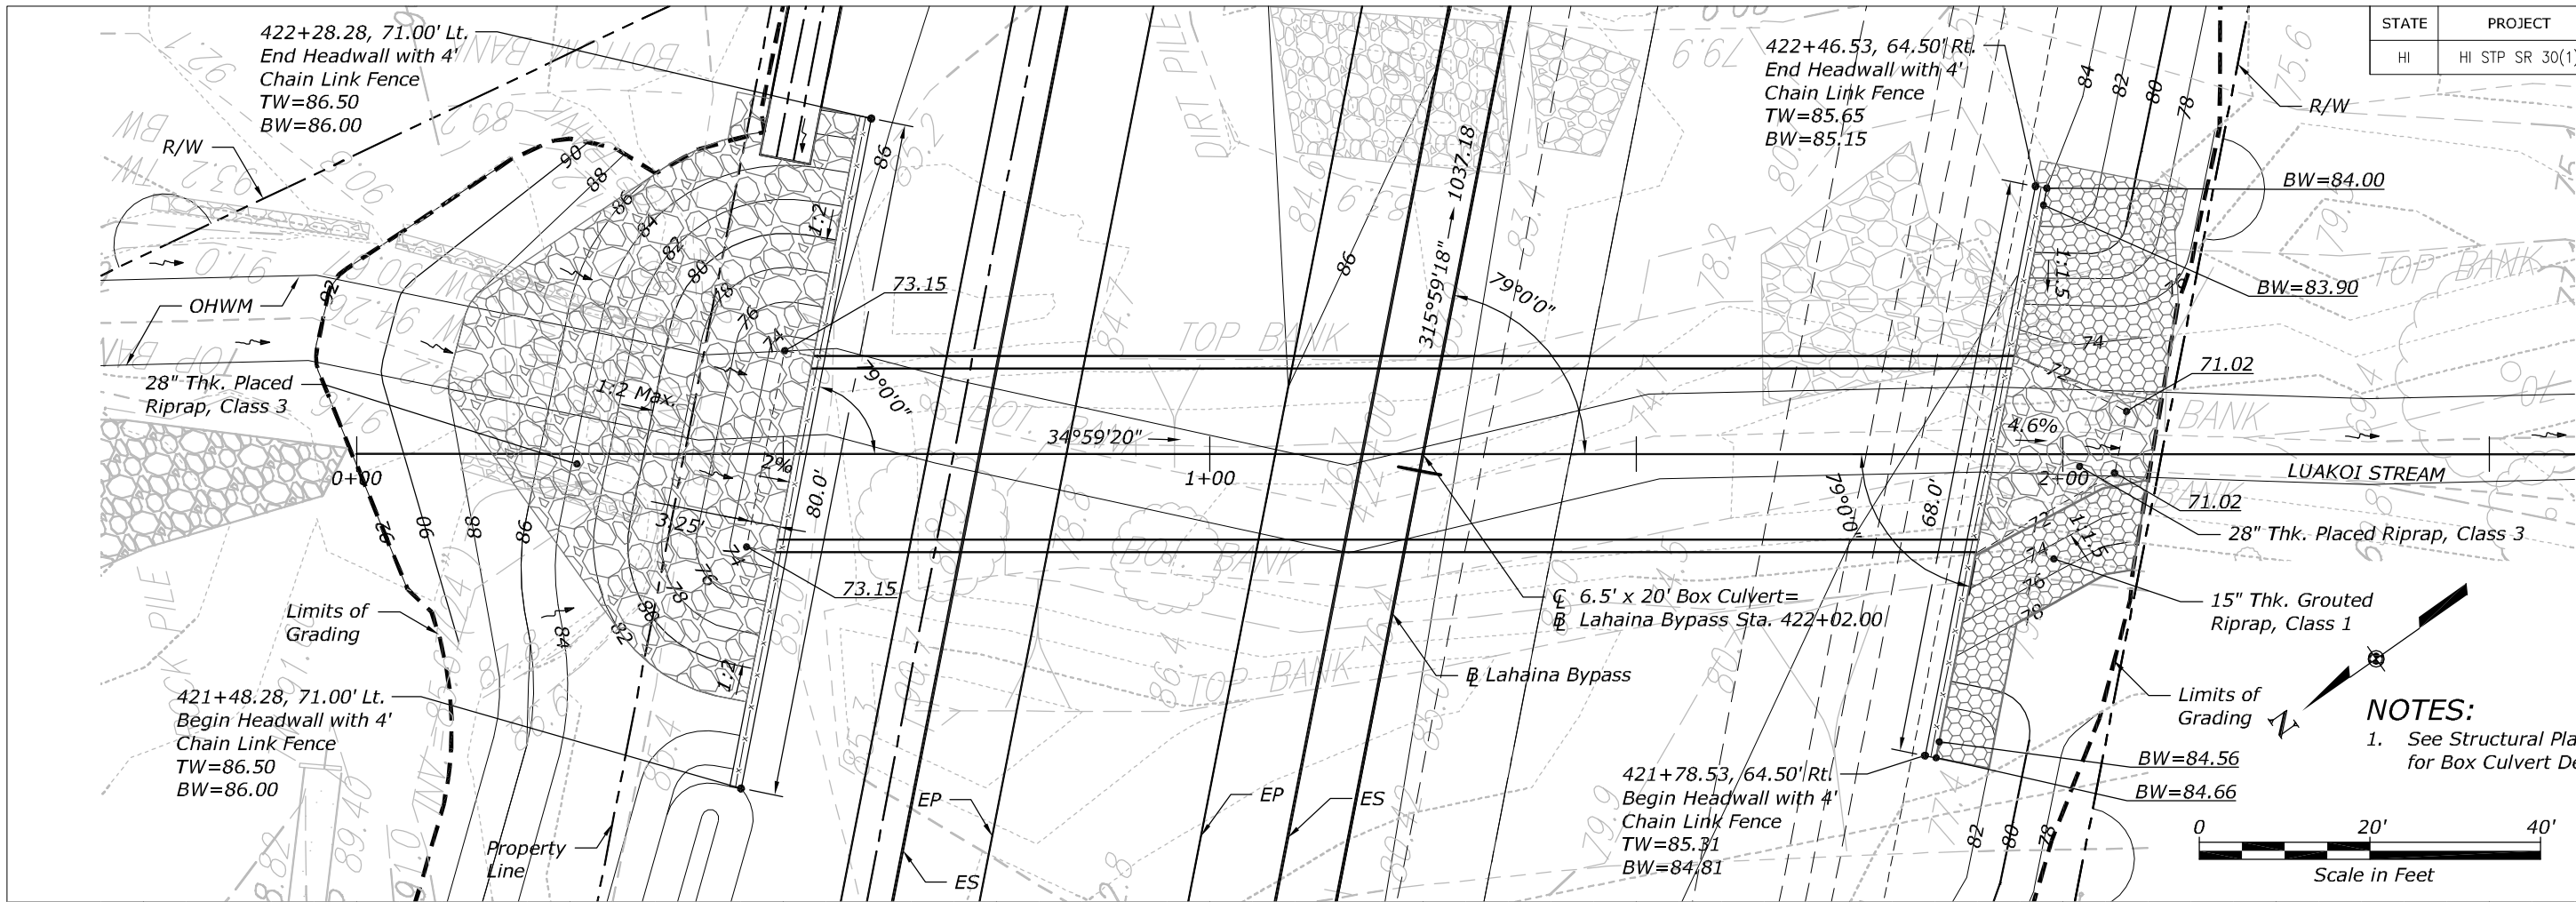

THIS WORK WAS PREPARED BY ME
OR UNDER MY SUPERVISION.

WILSON OKAMOTO CORPORATION


APRIL 30, 2020
LIC. EXP. DATE

Sta. 422+02 - 6.5' x 20' Box Culvert




142' Length
Headwalls Lt. & Rt.
Placed Riprap, Class 3 Lt. & Rt.
Grouted Riprap, Class 1 Rt.

STA. 422+02, BOX CULVERT

STATE	PROJECT	SHEET NO.
HI	HI STP SR 30(1)	T51

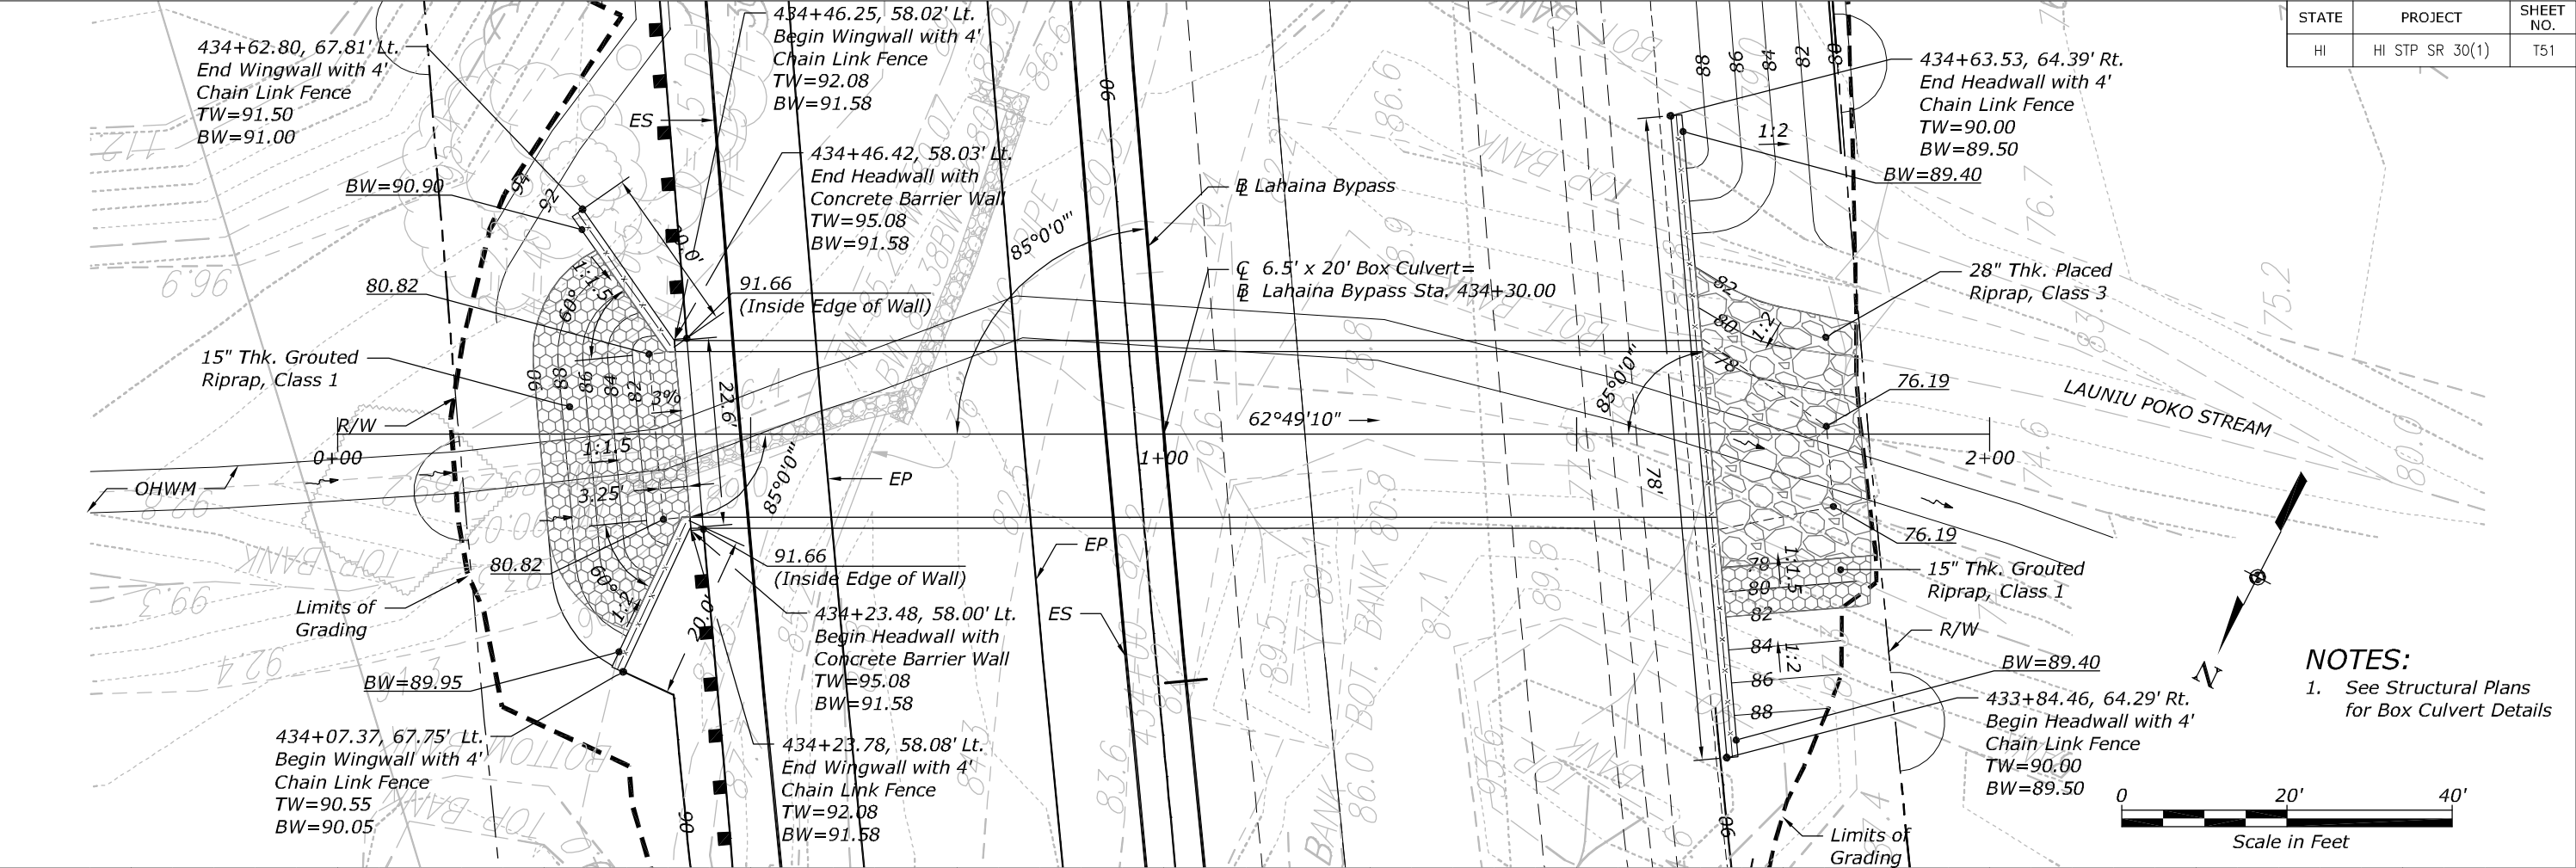

NOTES:
1. See Structural Plans
for Box Culvert Details

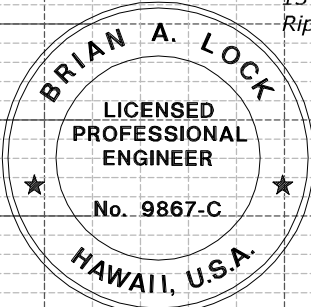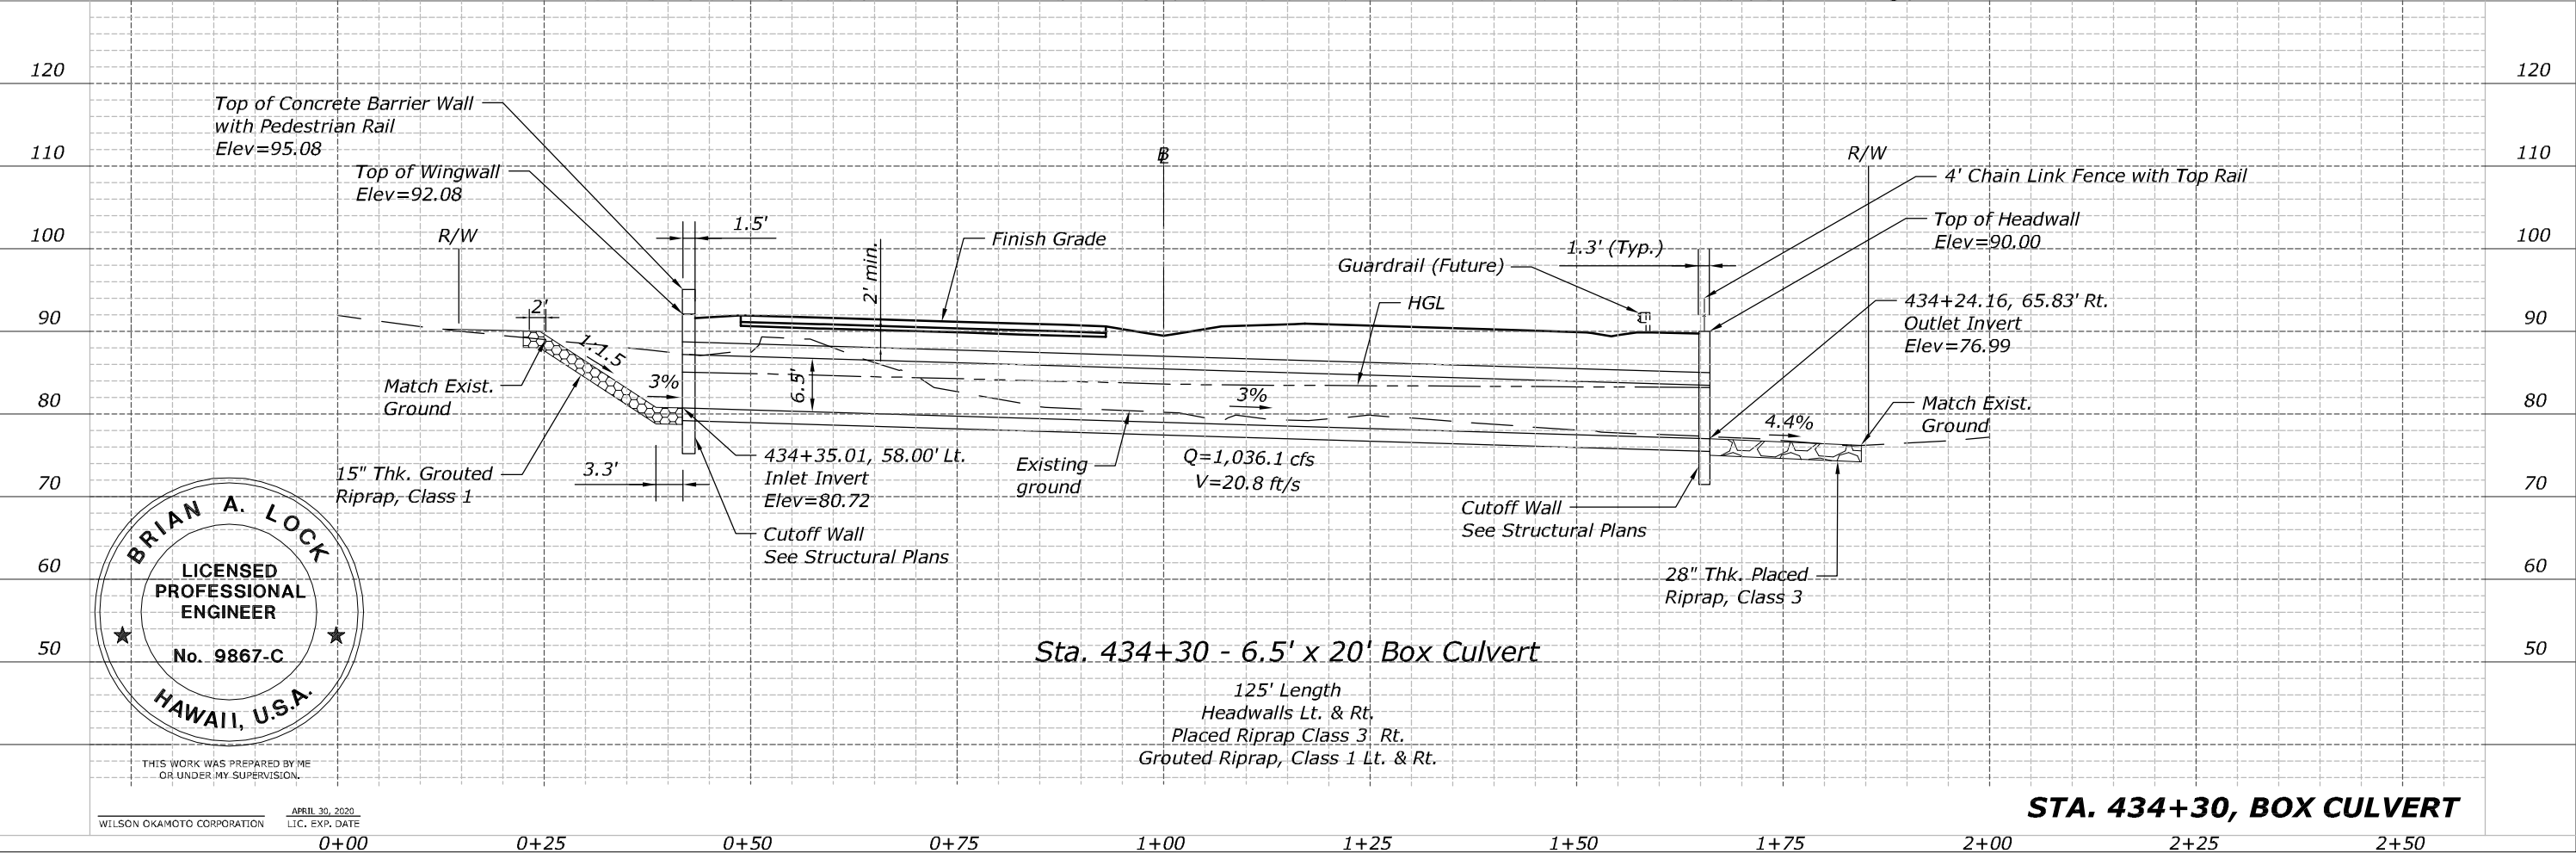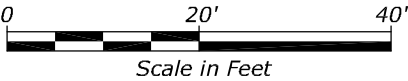

THIS WORK WAS PREPARED BY ME
OR UNDER MY SUPERVISION.

WILSON OKAMOTO CORPORATION


APRIL 30, 2020
LIC. EXP. DATE

Sta. 434+30 - 6.5' x 20' Box Culvert




125' Length
Headwalls Lt. & Rt.
Placed Riprap Class 3 Rt.
Grouted Riprap, Class 1 Lt. & Rt.

STA. 434+30, BOX CULVERT

STATE	PROJECT	SHEET NO.
HI	HI STP SR 30(1)	T52

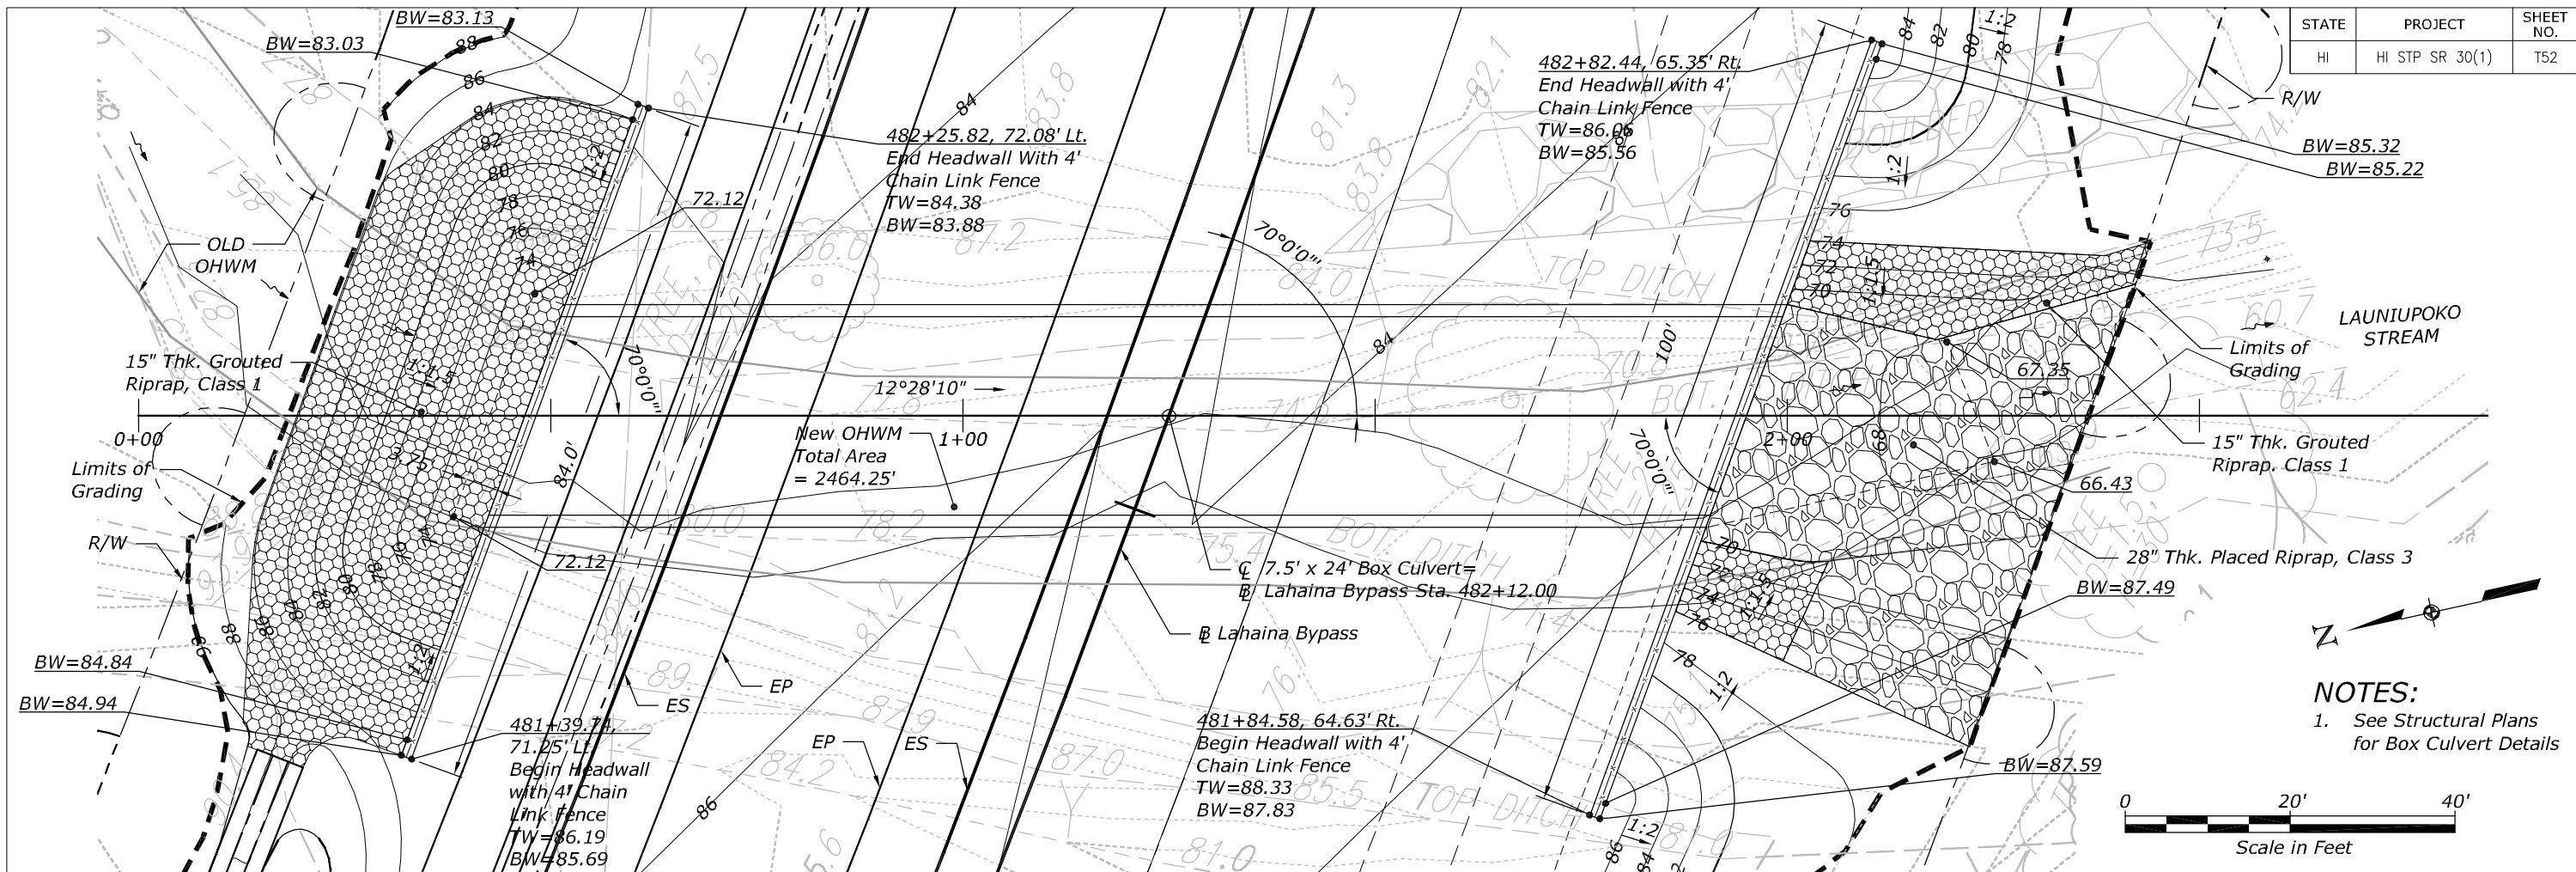

NOTES:
1. See Structural Plans
for Box Culvert Details

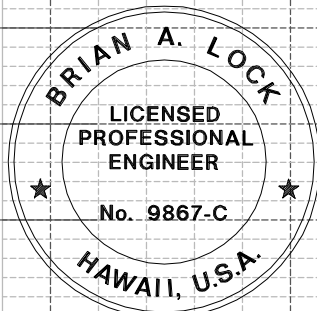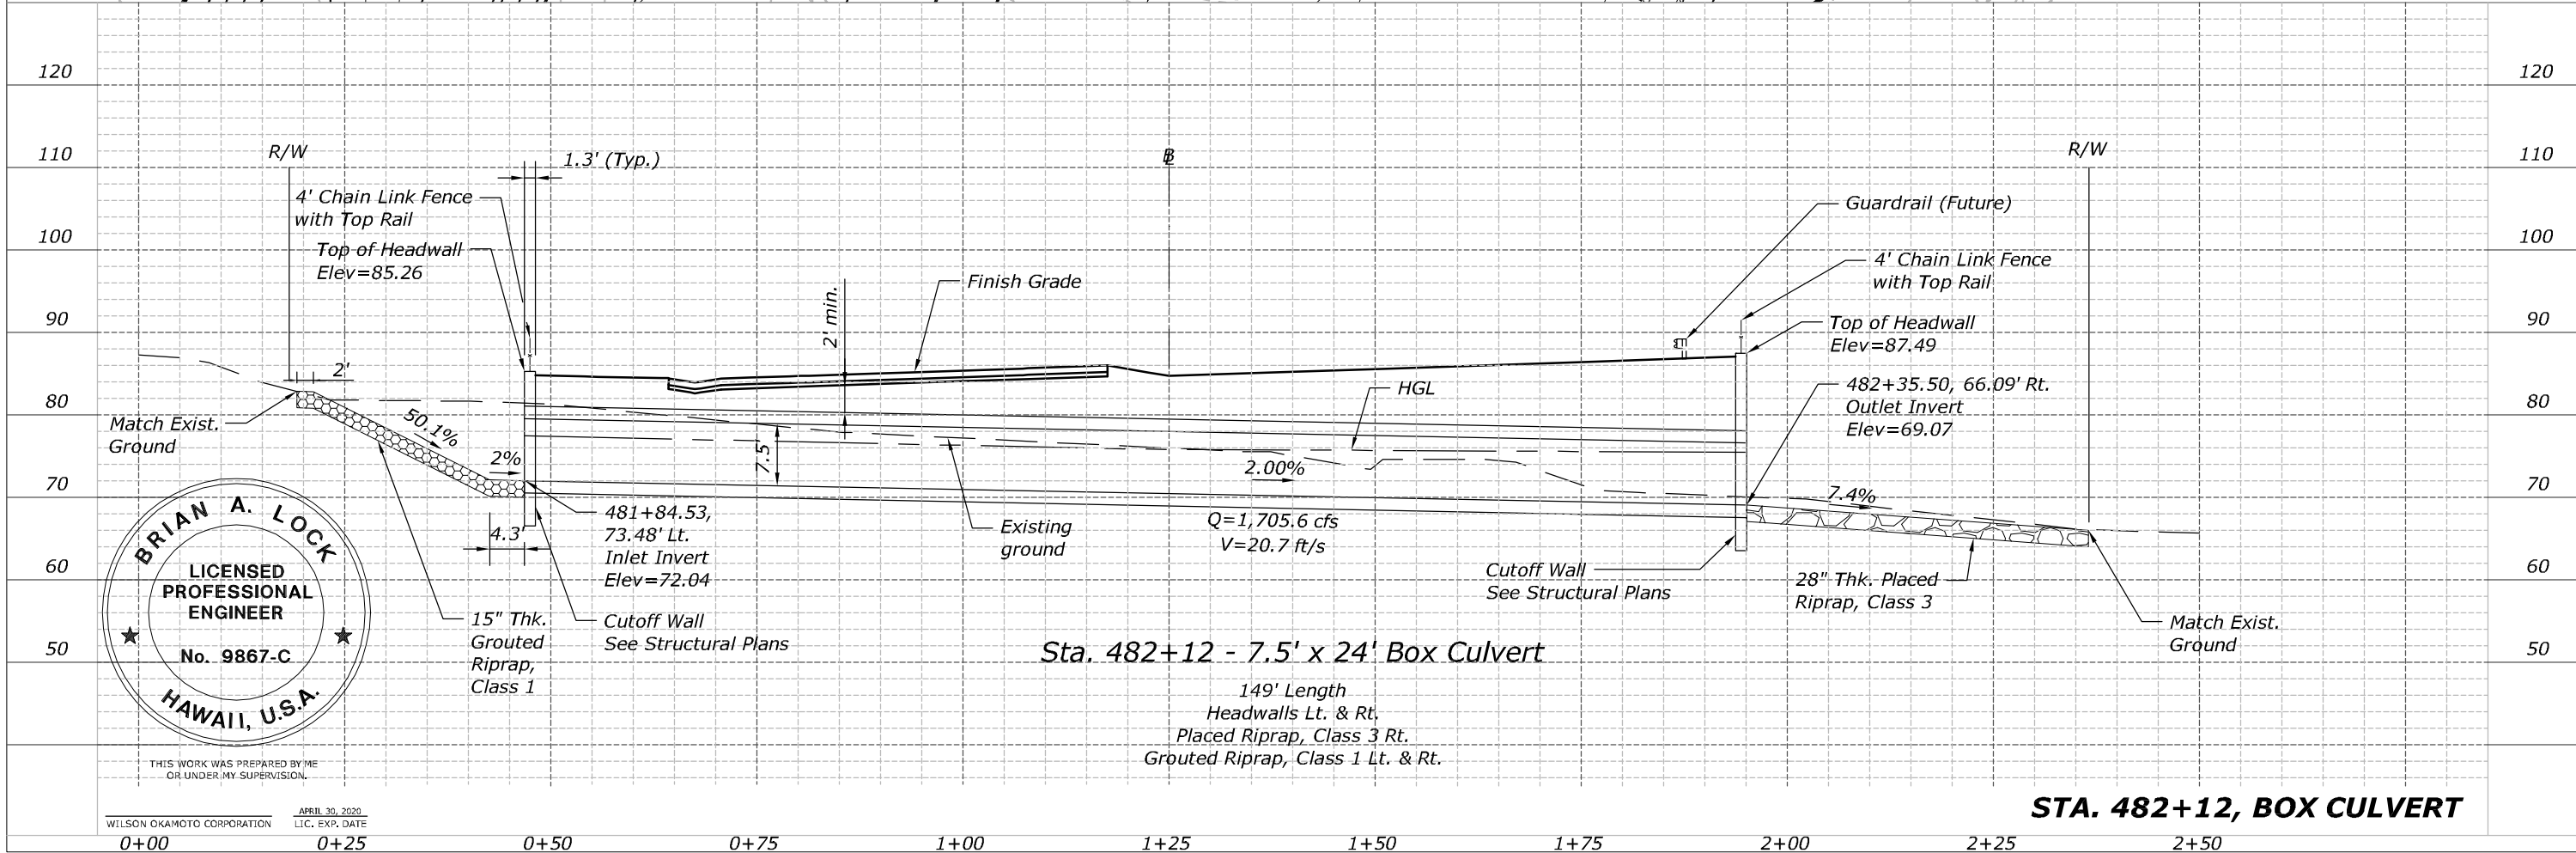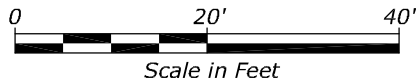


THIS WORK WAS PREPARED BY ME
OR UNDER MY SUPERVISION.



WILSON OKAMOTO CORPORATION
APRIL 30, 2020
LIC. EXP. DATE

STA. 482+12, BOX CULVERT

STATE	PROJECT	SHEET NO.
HI	HI STP SR 30(1)	T53

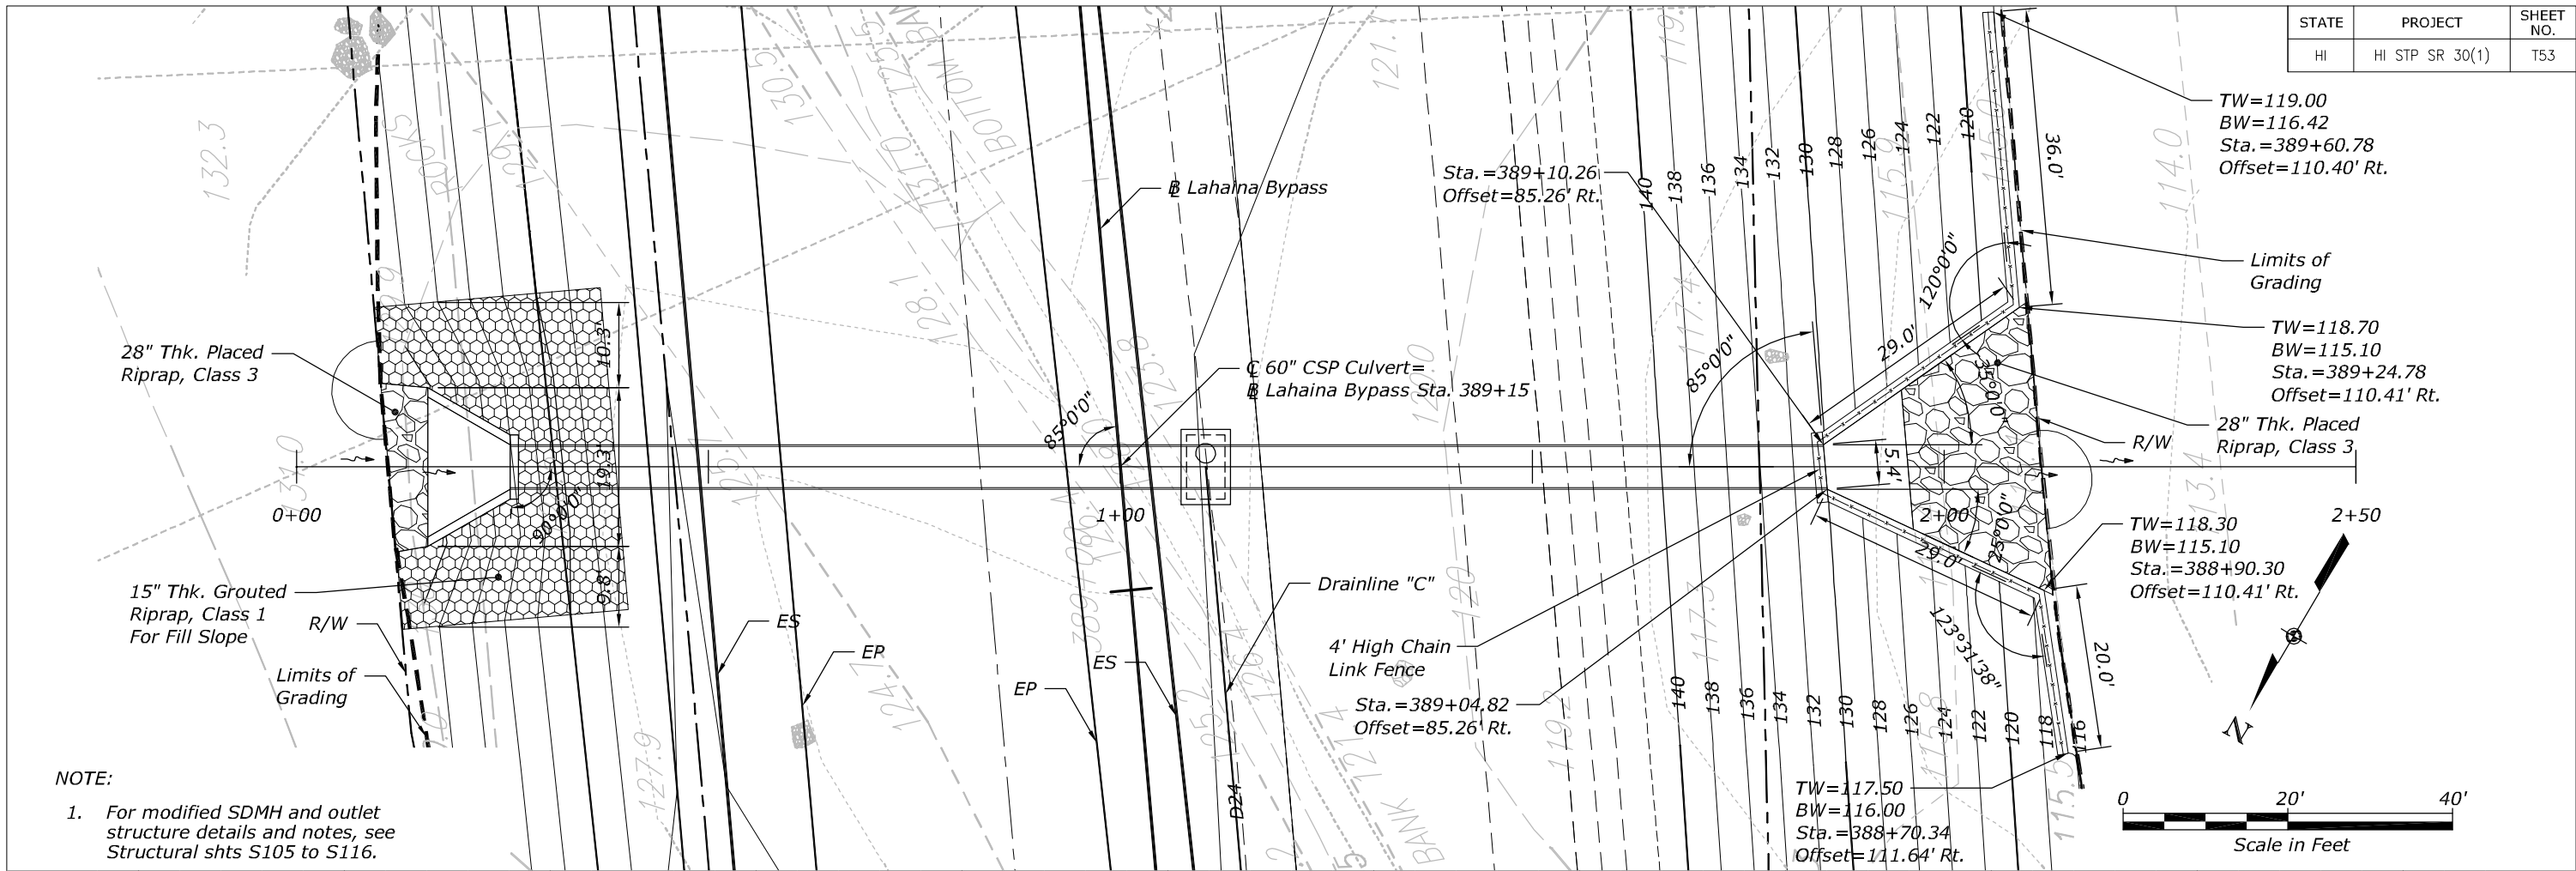

NOTE:
1. For modified SDMH and outlet structure details and notes, see Structural shts S105 to S116.


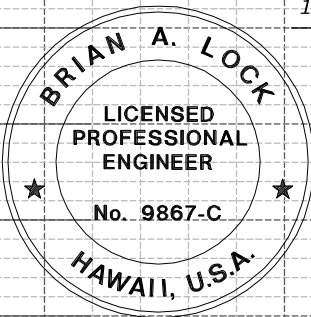
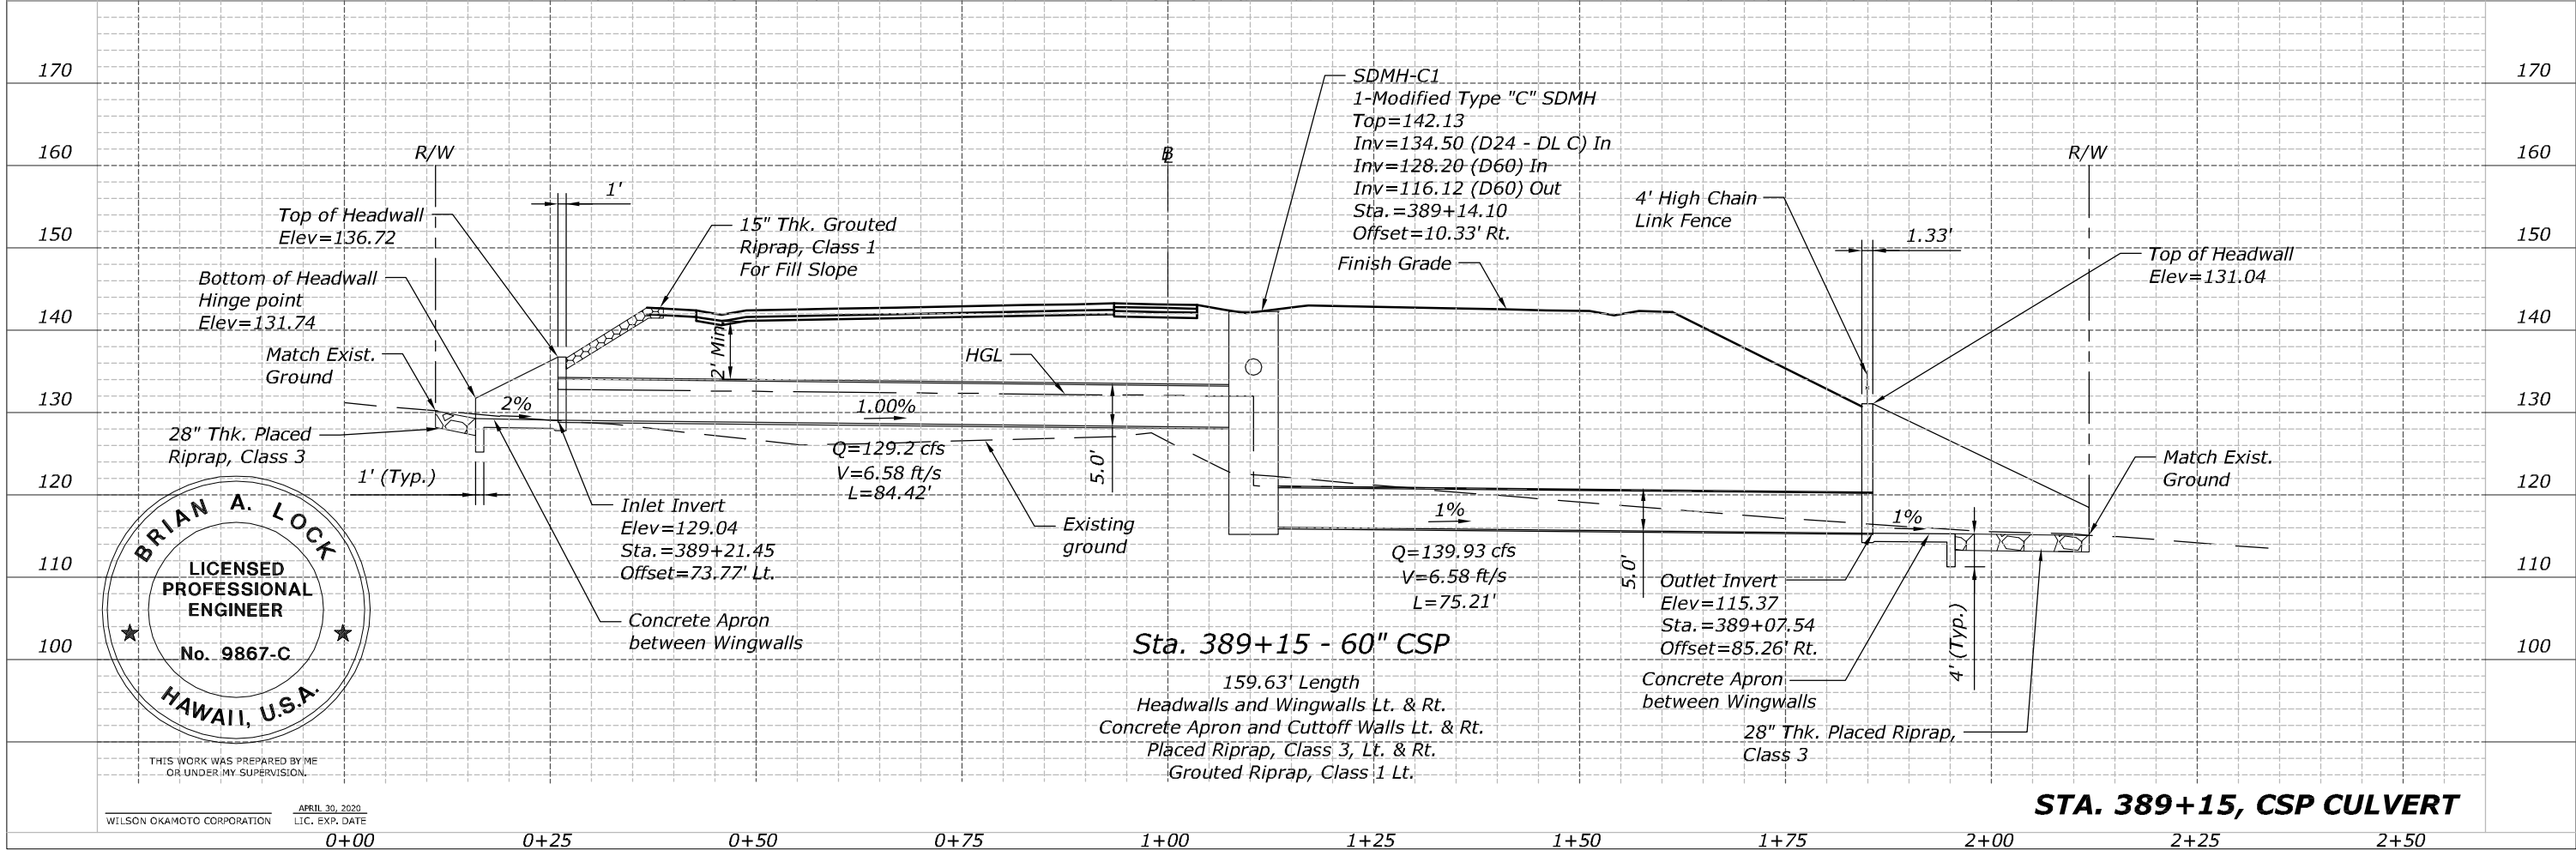


THIS WORK WAS PREPARED BY ME OR UNDER MY SUPERVISION.

WILSON OKAMOTO CORPORATION
APRIL 30, 2020
LIC. EXP. DATE

STA. 389+15, CSP CULVERT

STATE	PROJECT	SHEET NO.
HI	HI STP SR 30(1)	T55

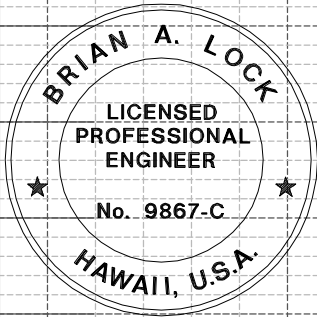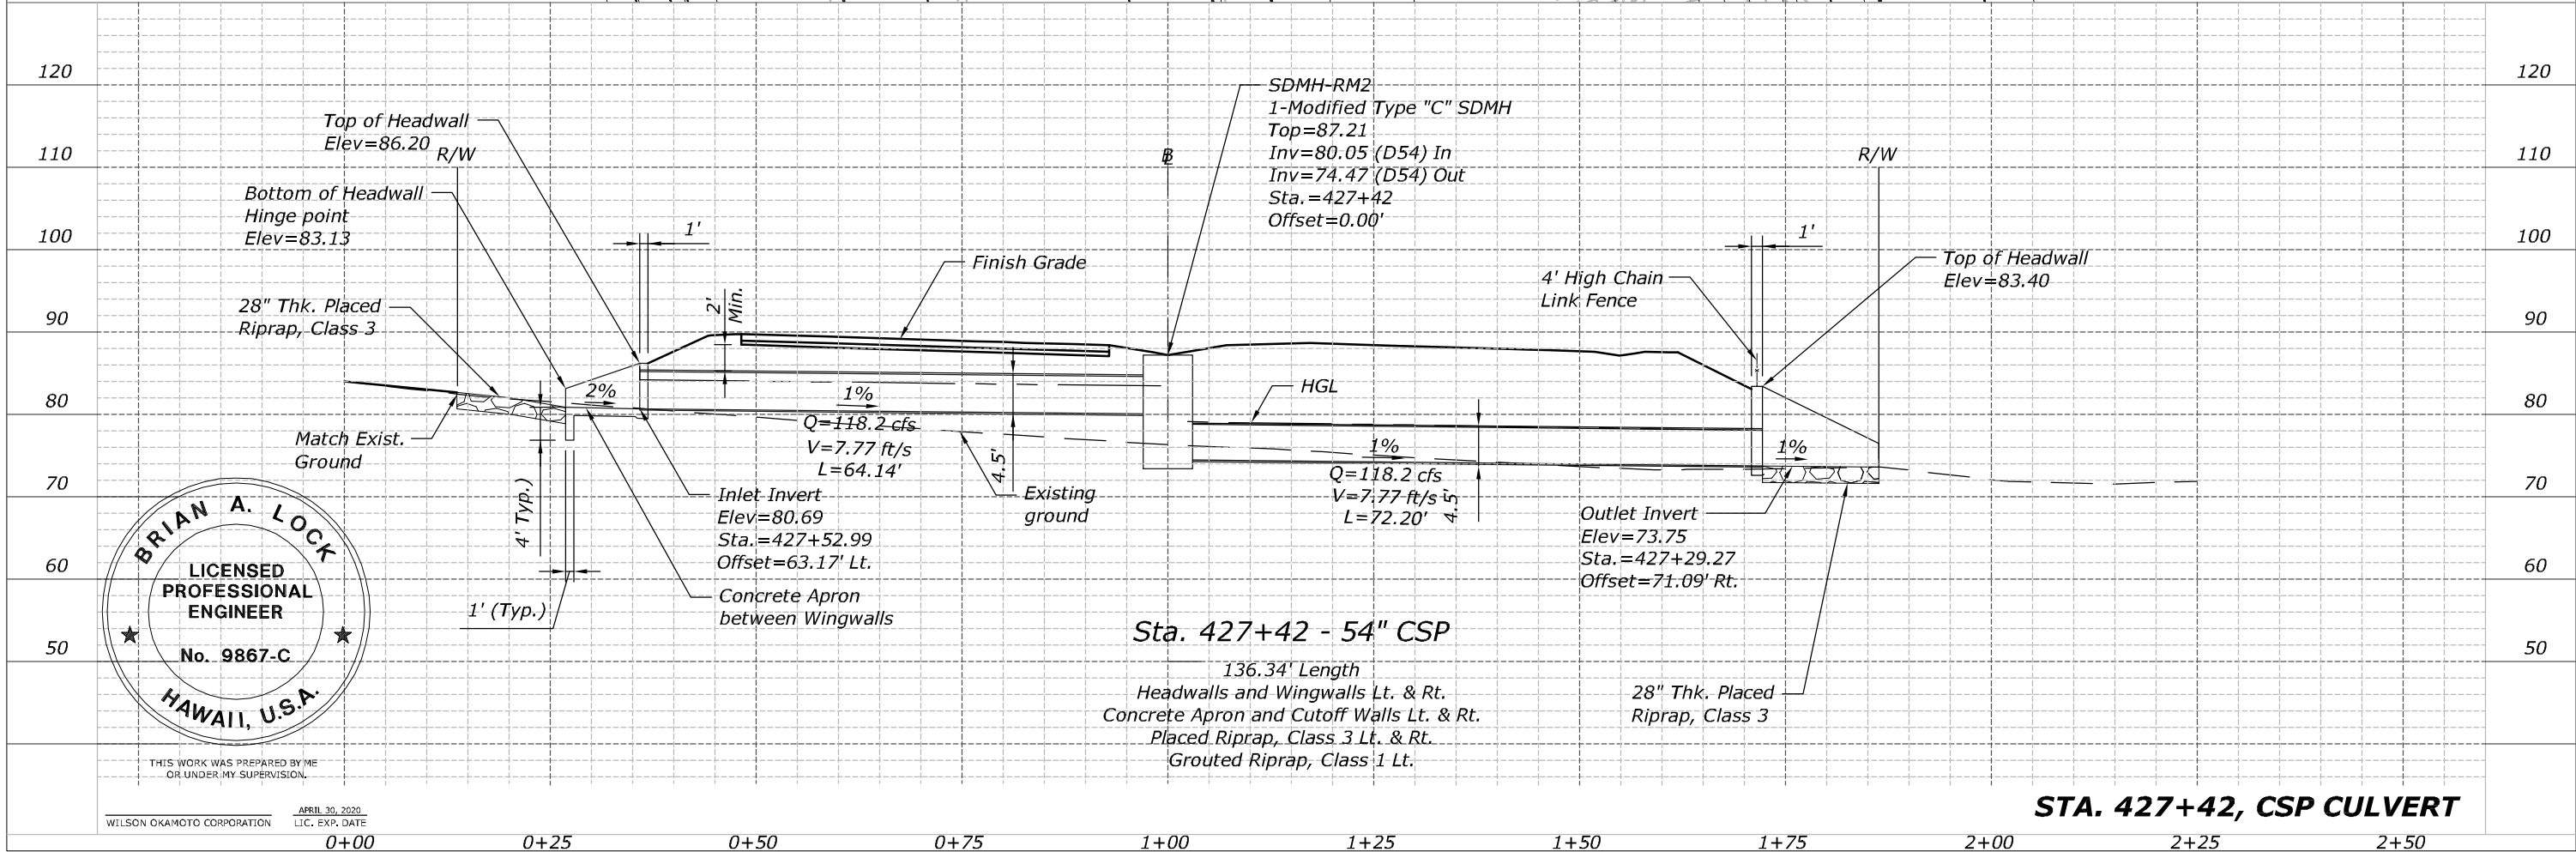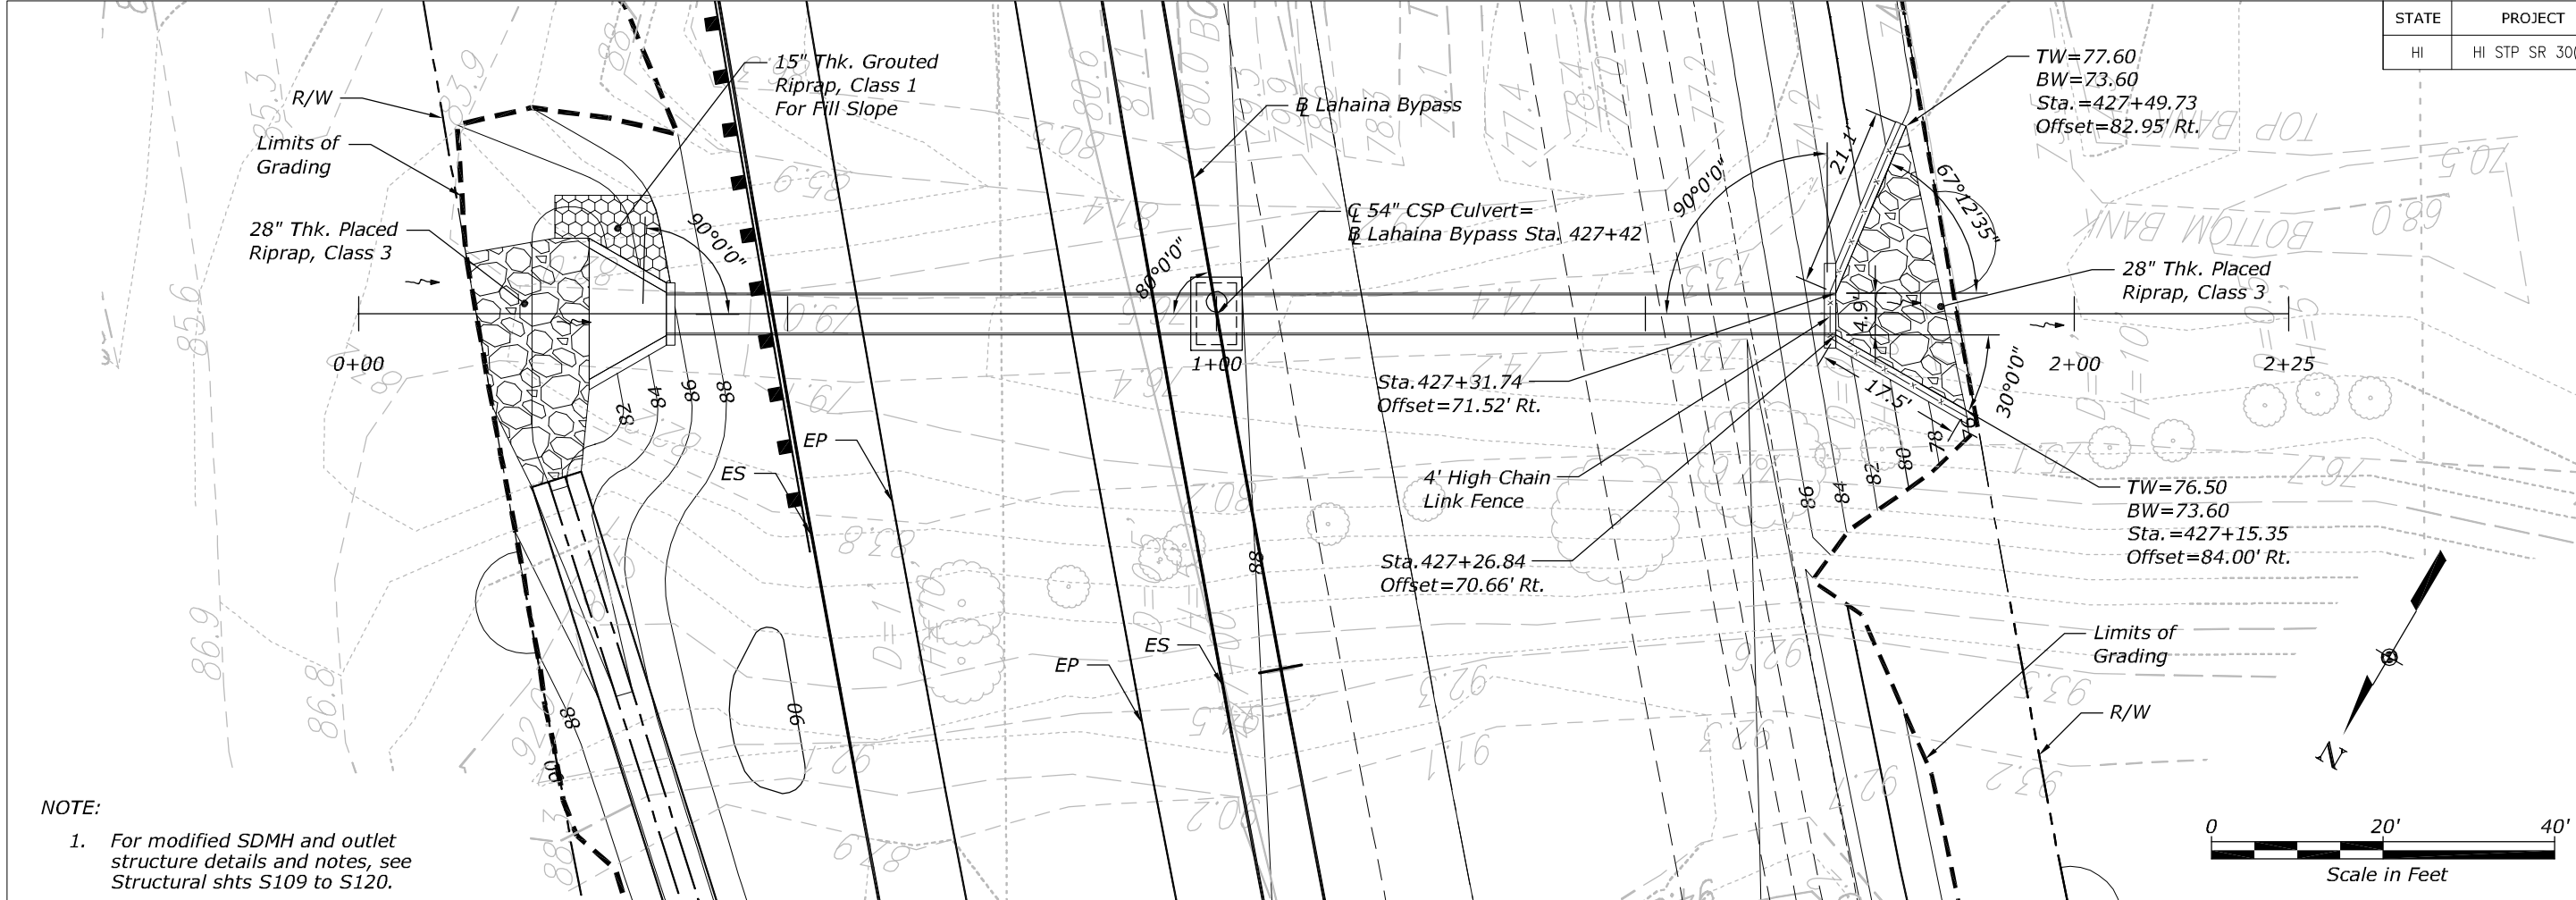


THIS WORK WAS PREPARED BY ME
OR UNDER MY SUPERVISION.

WILSON OKAMOTO CORPORATION




APRIL 30, 2020
LIC. EXP. DATE

STA. 427+42, CSP CULVERT

STATE	PROJECT	SHEET NO.
HI	HI STP SR 30(1)	T56

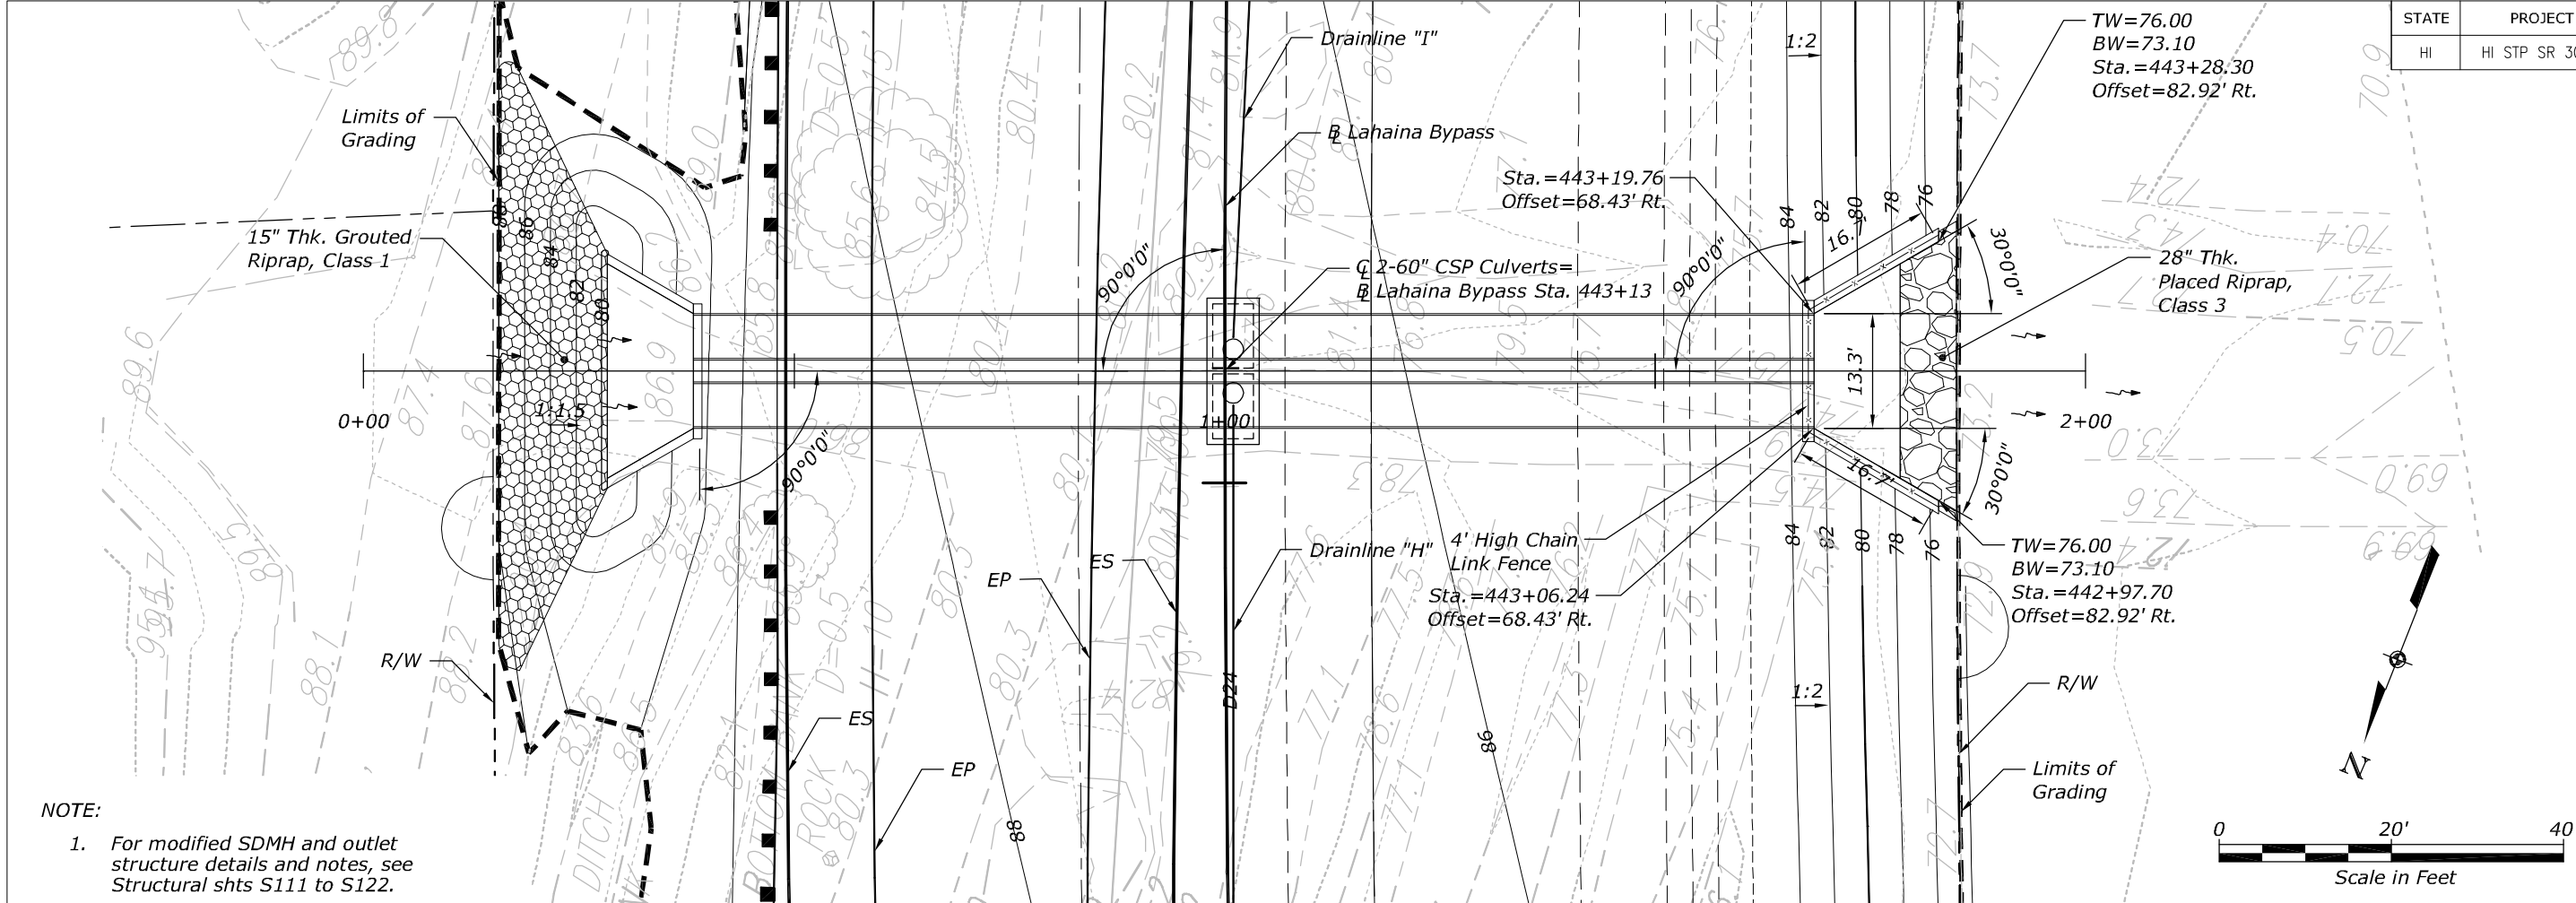



NOTE:
1. For modified SDMH and outlet structure details and notes, see Structural shts S111 to S122.

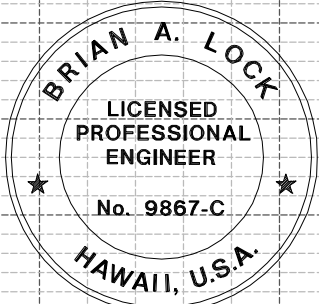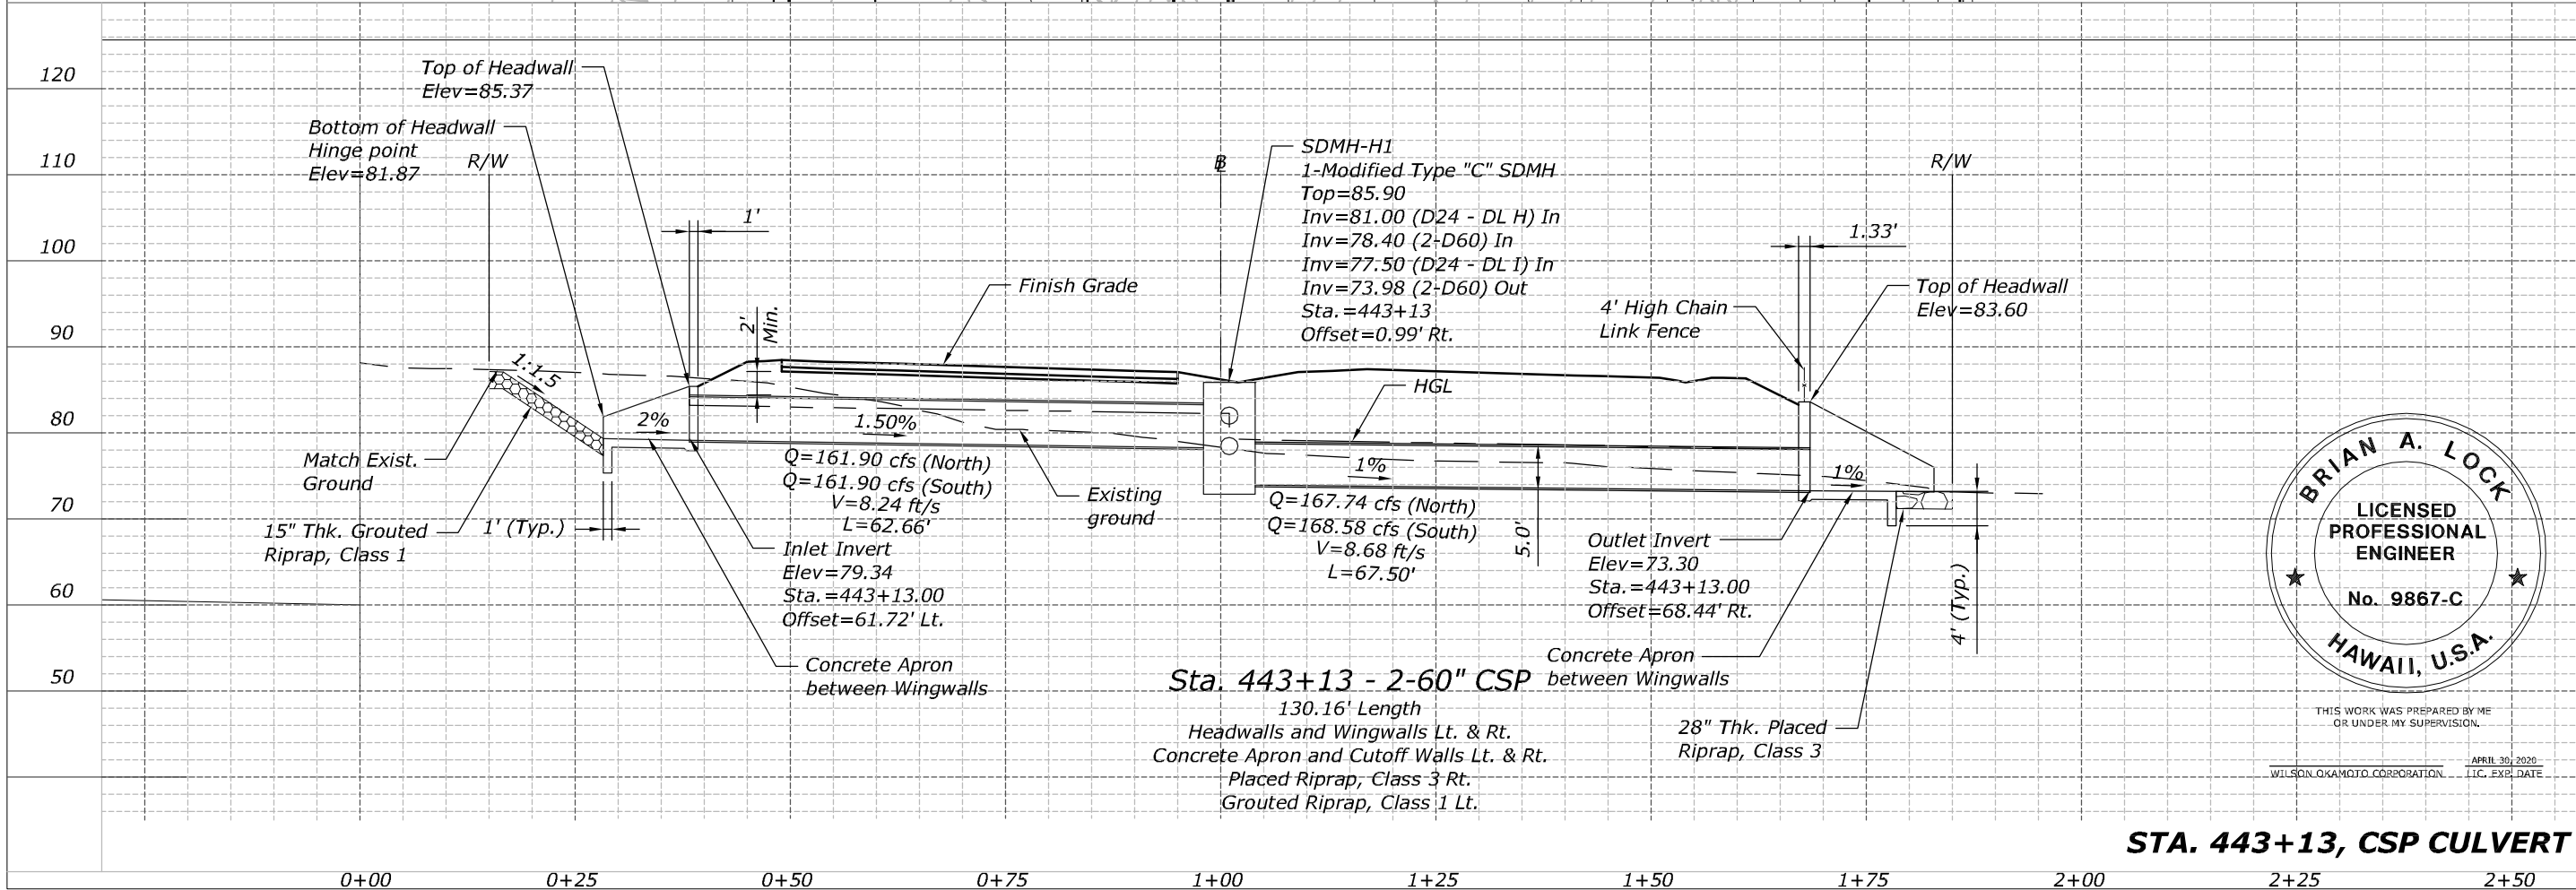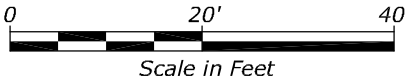


THIS WORK WAS PREPARED BY ME OR UNDER MY SUPERVISION.
APRIL 30, 2020
WILSON OKAMOTO CORPORATION, L.L.C. EXPI. DATE

STA. 443+13, CSP CULVERT


STATE	PROJECT	SHEET NO.
HI	HI STP SR 30(1)	T58

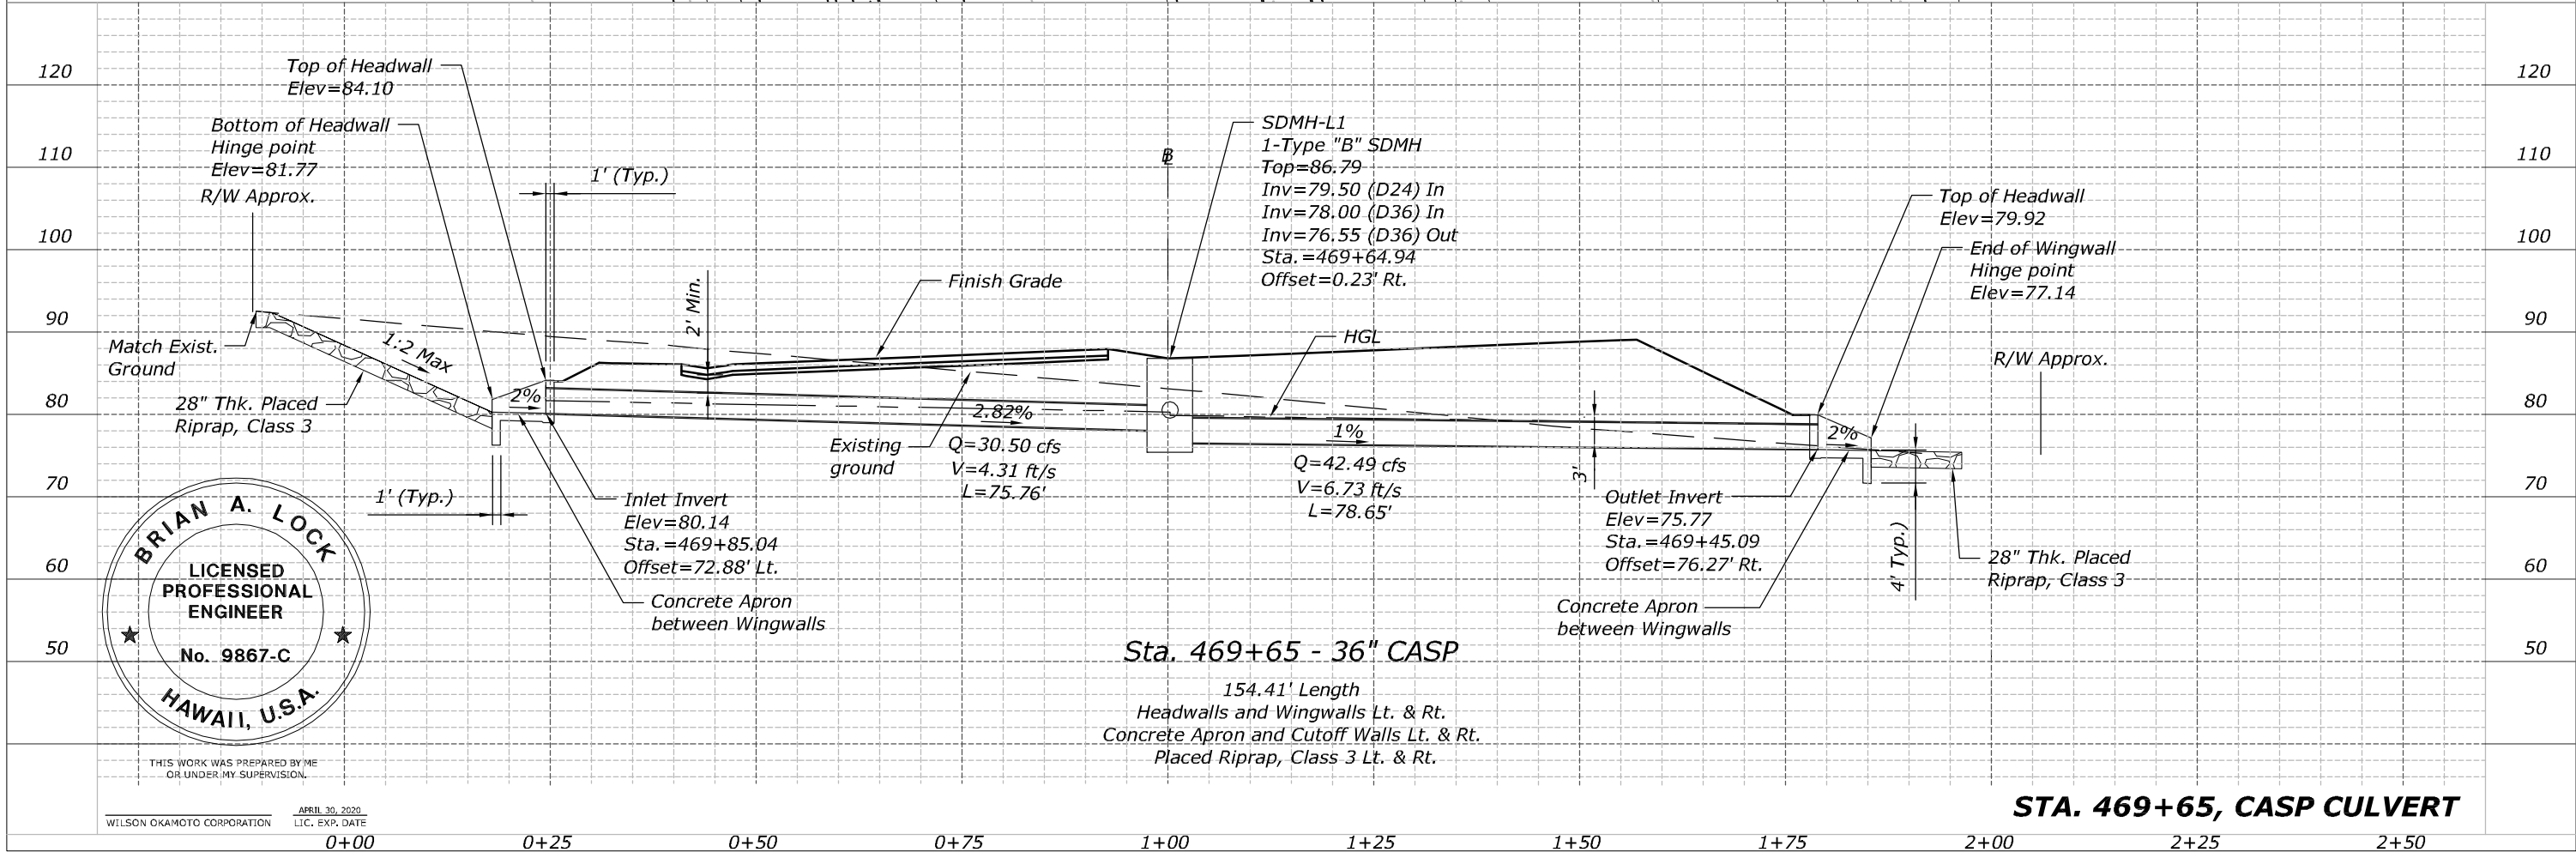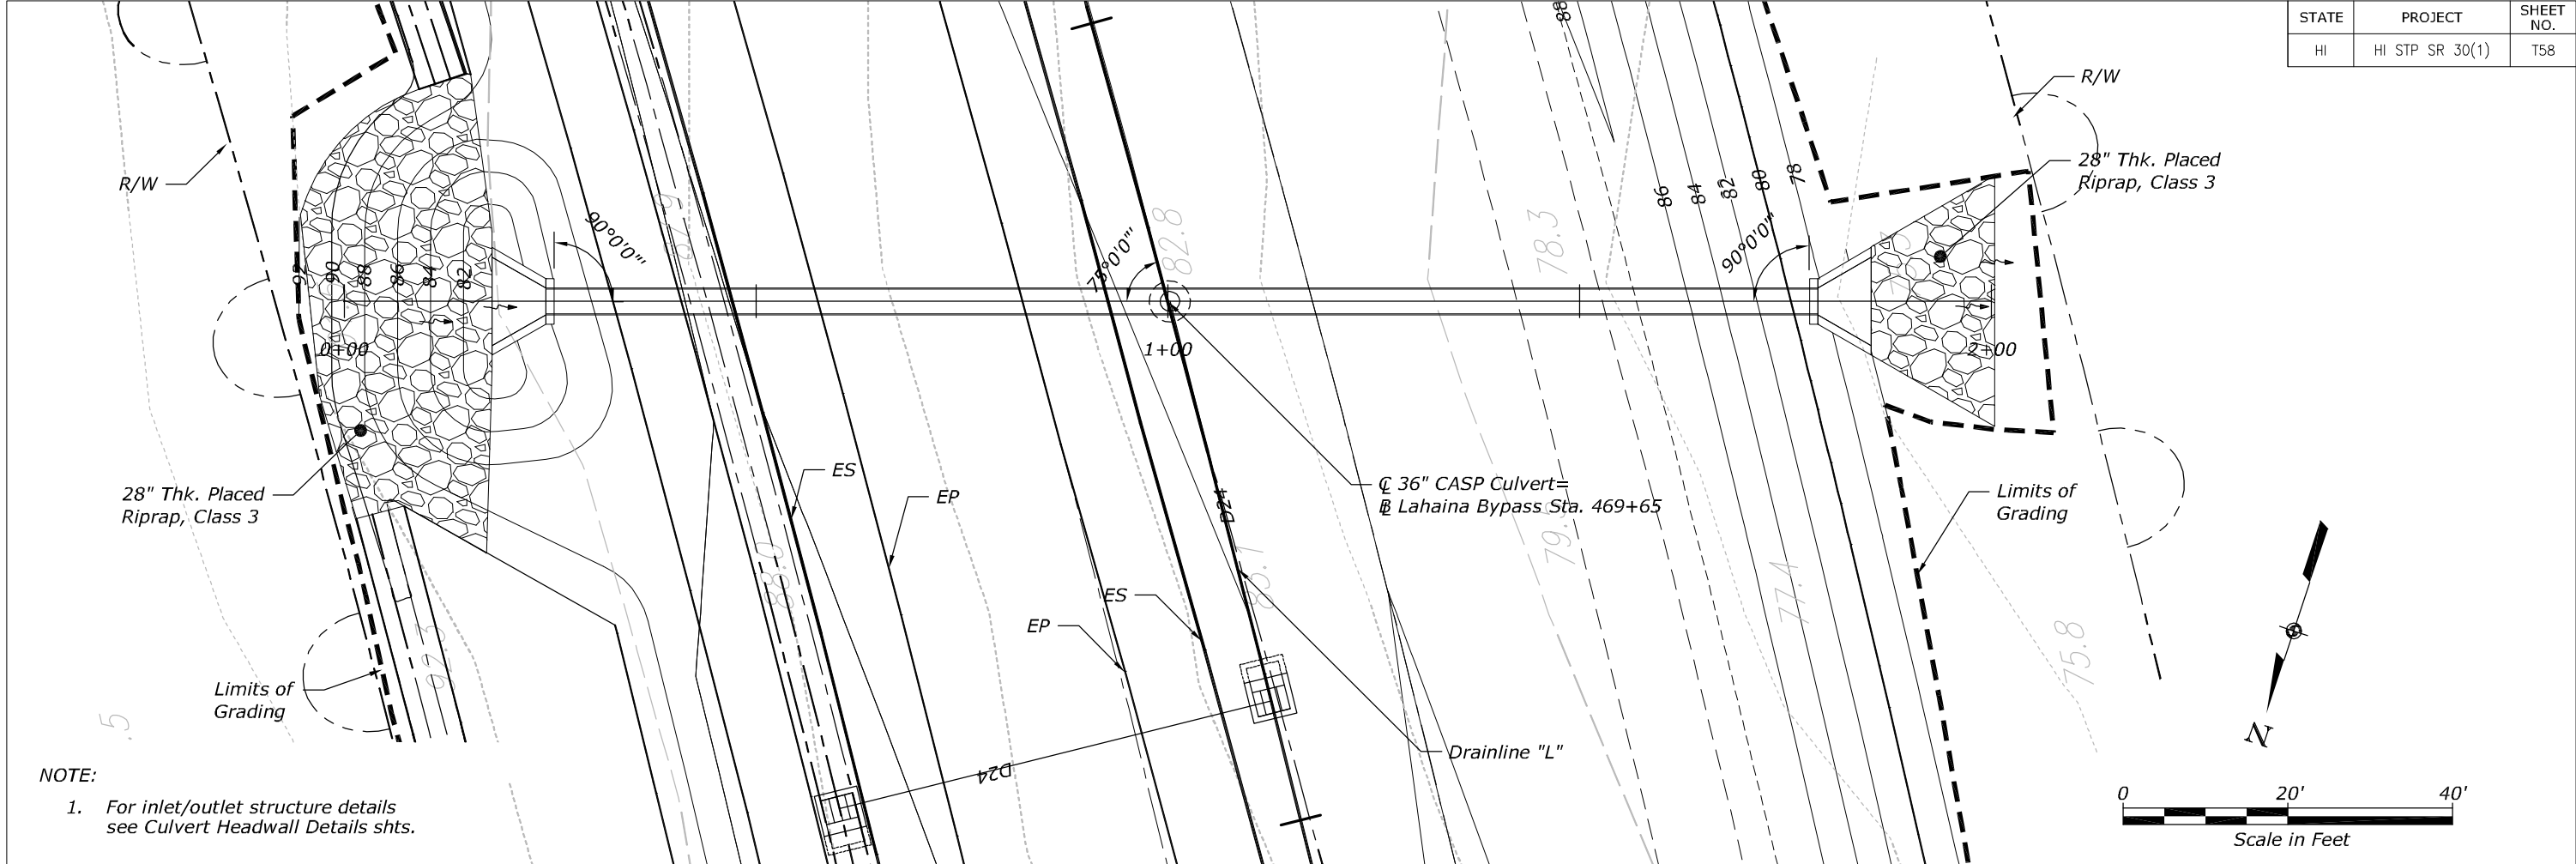



STATE	PROJECT	SHEET NO.
HI	HI STP SR 30(1)	T59

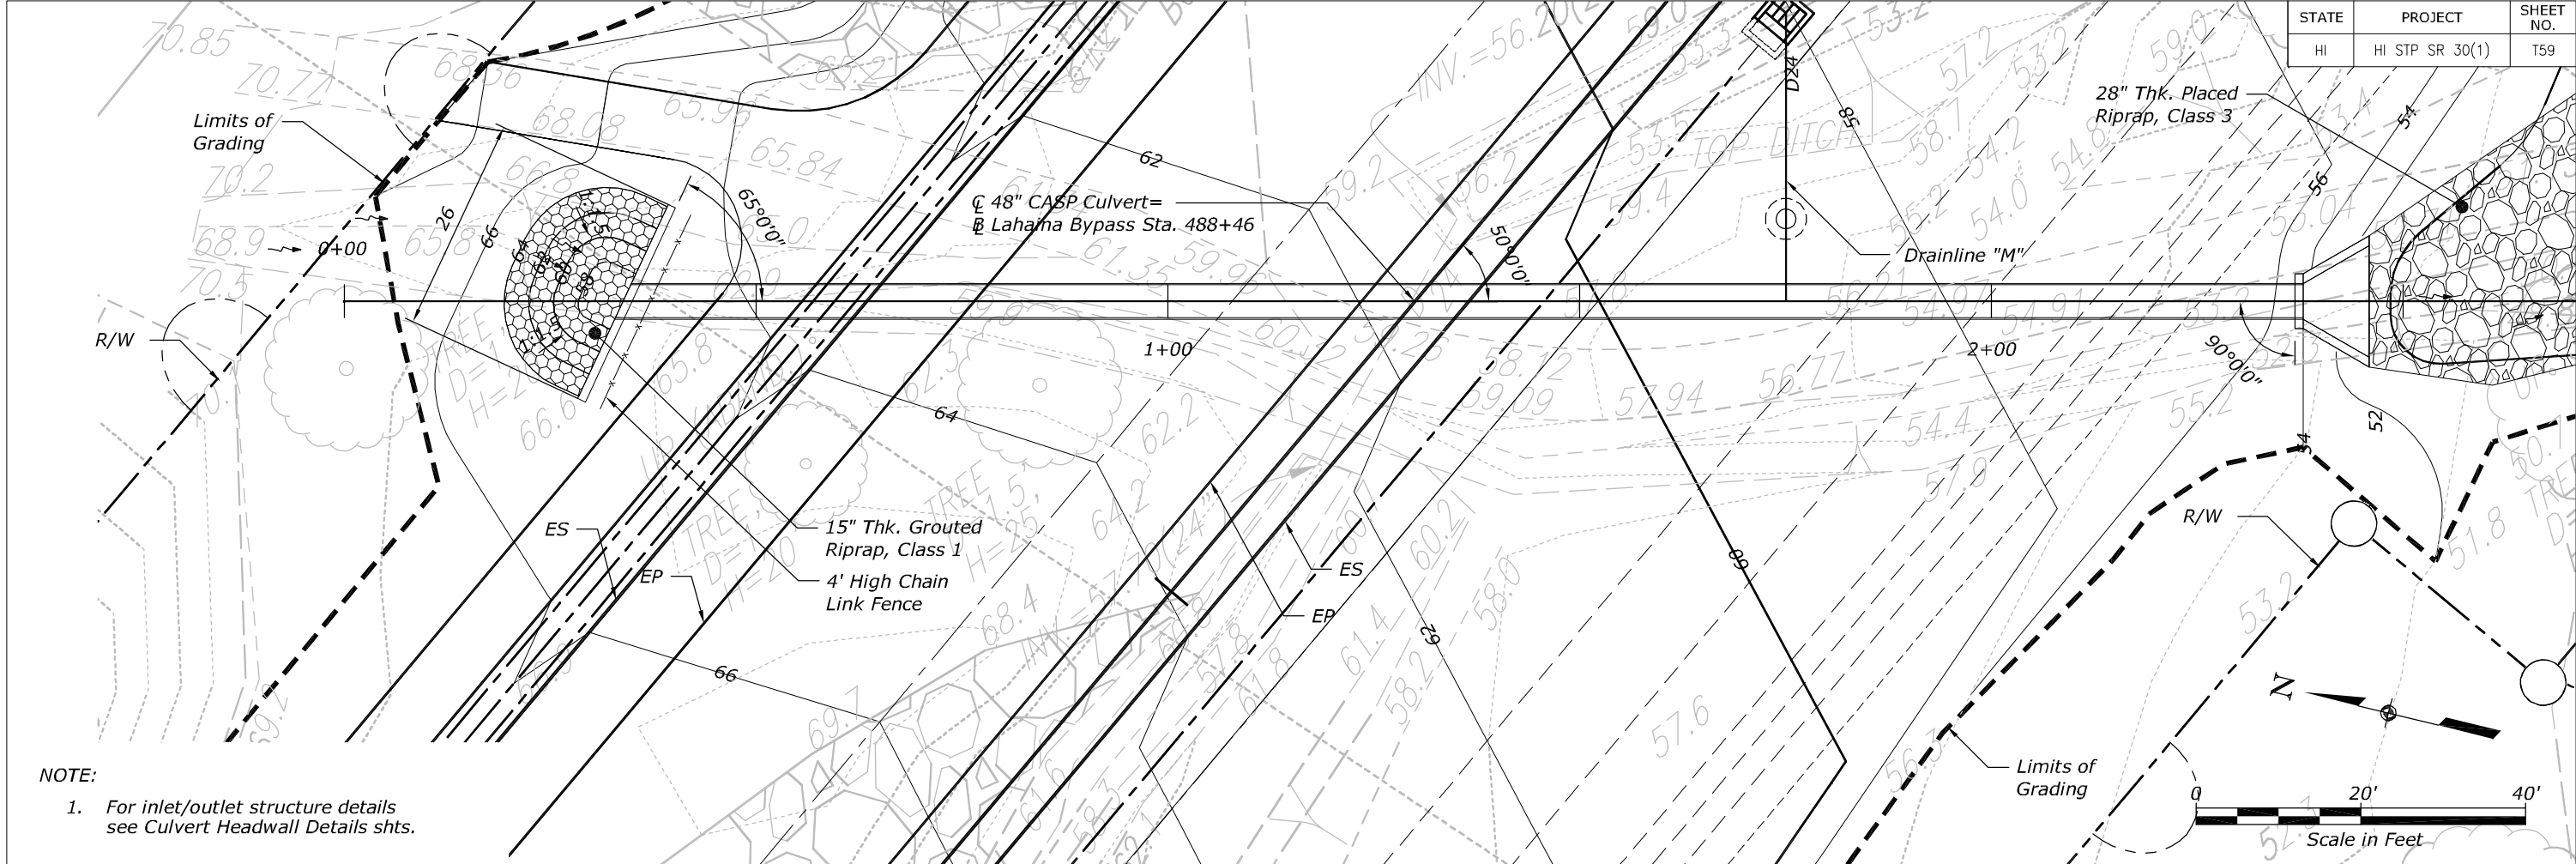

NOTE:
1. For inlet/outlet structure details see Culvert Headwall Details shts.

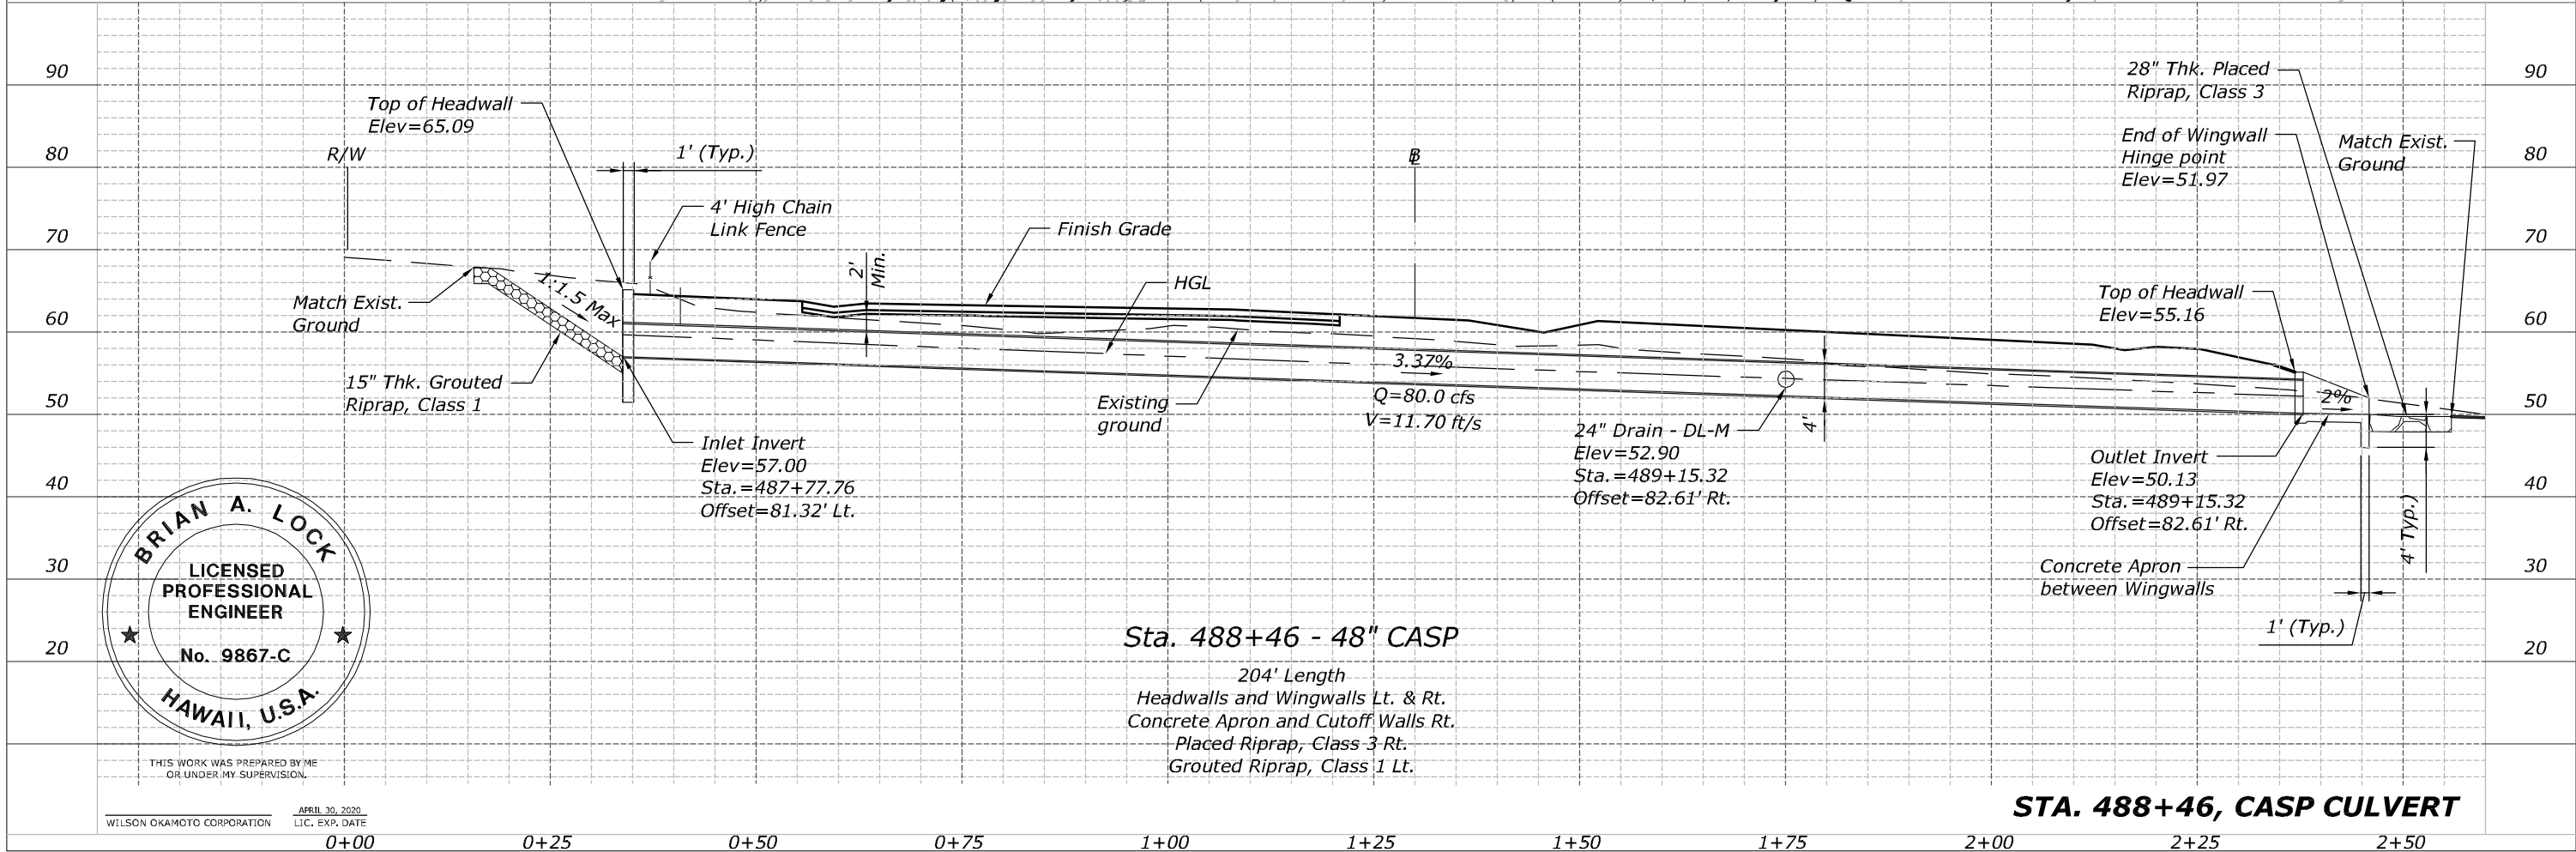

STATE	PROJECT	SHEET NO.
HI	HI STP SR 30(1)	T60

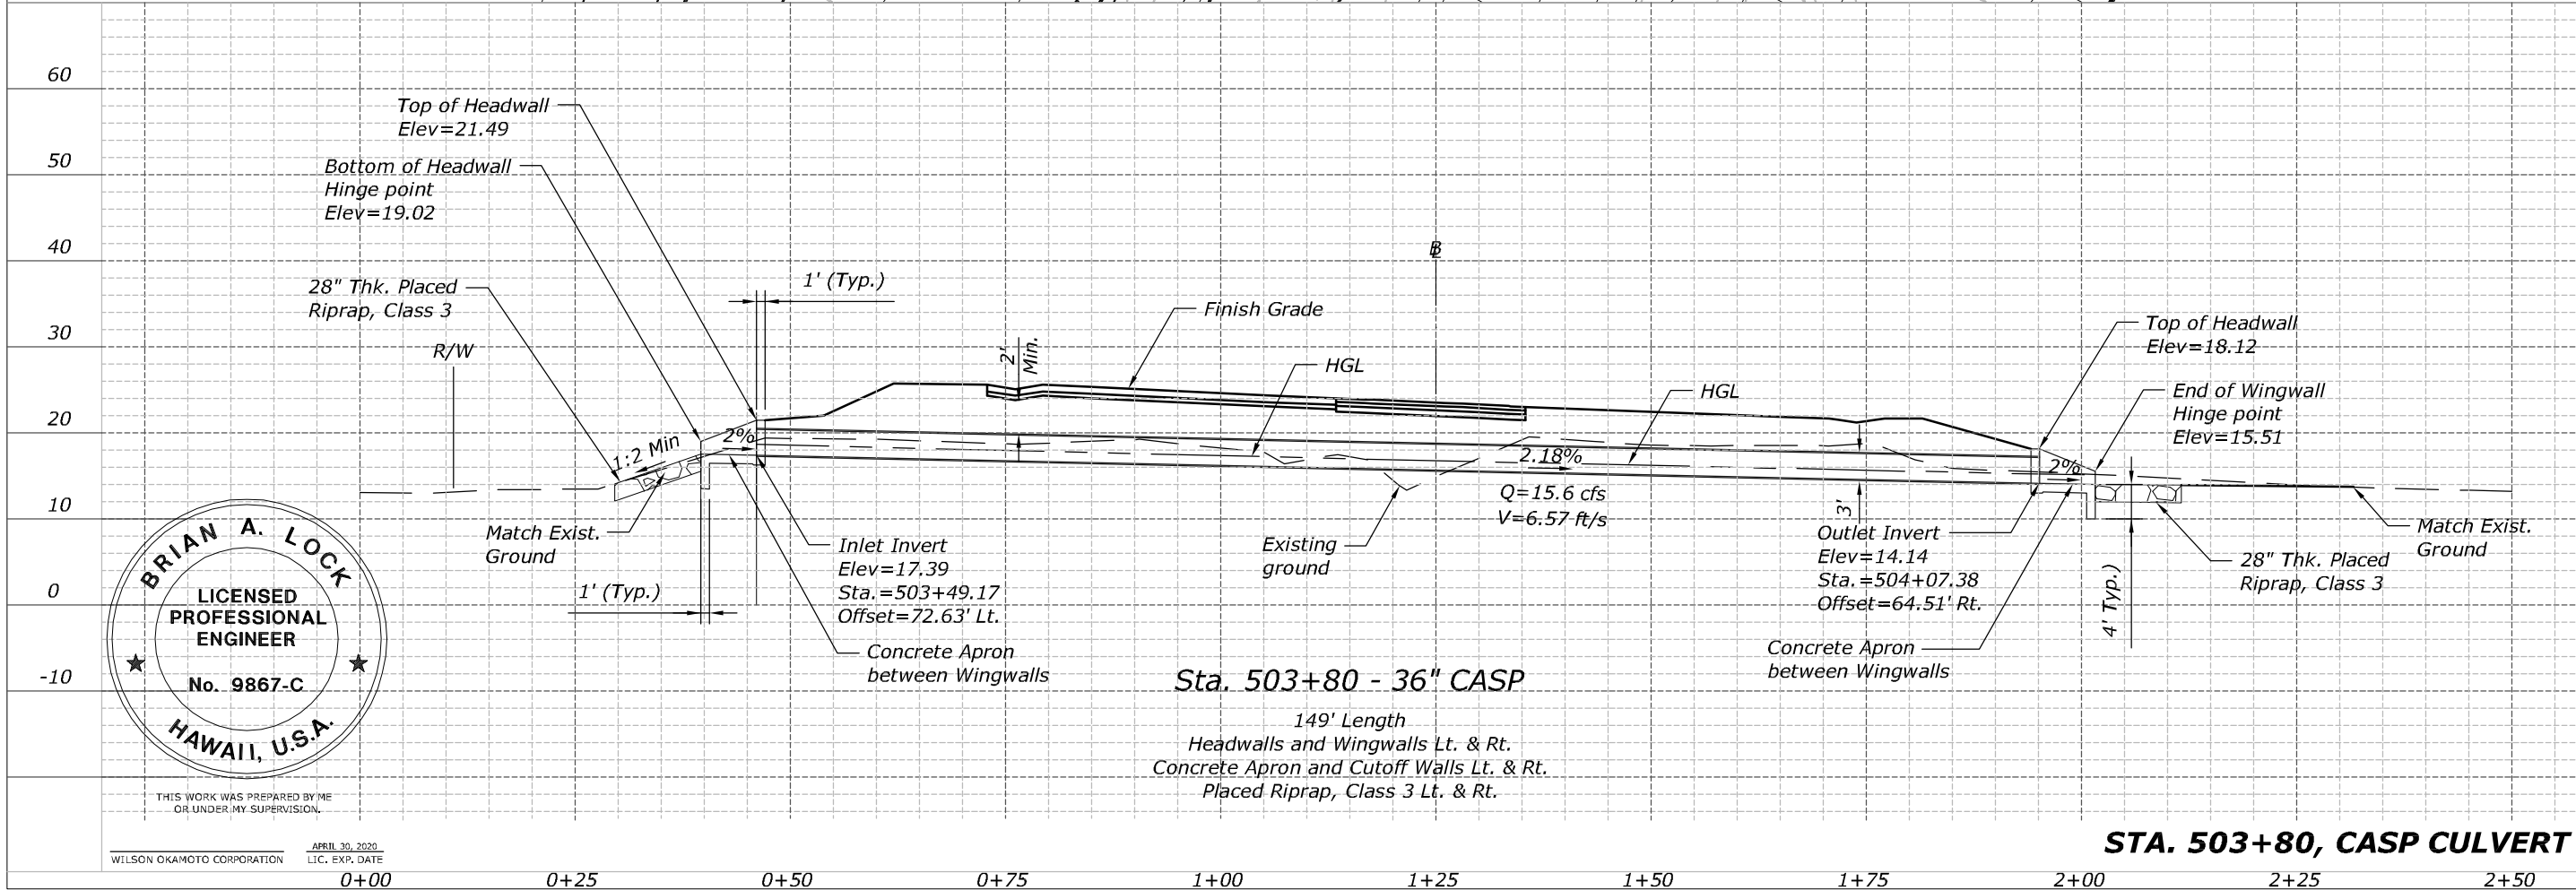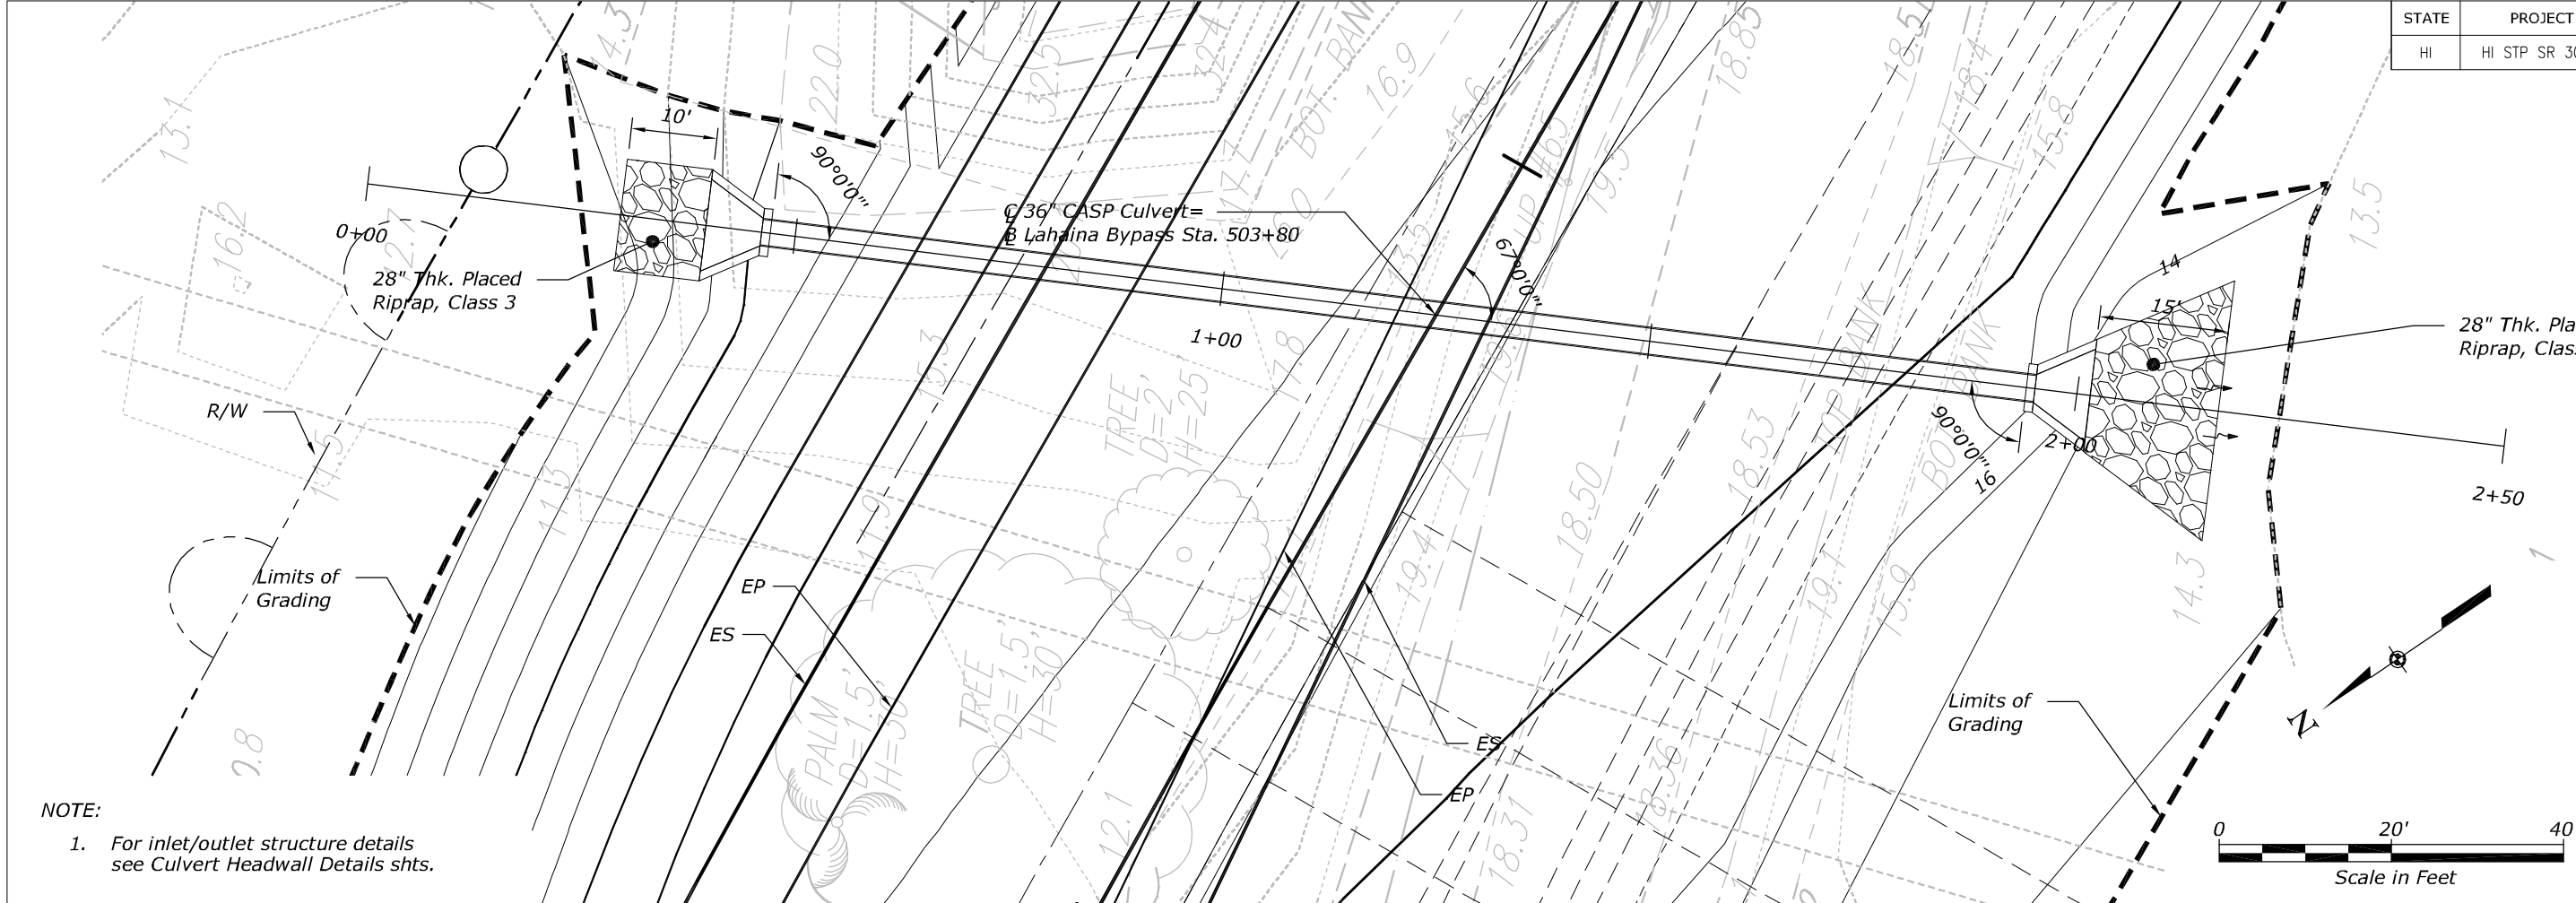

STATE	PROJECT	SHEET NO.
HI	HI STP SR 30(1)	T62

