

NOTES FOR WORK ON CONCRETE STRUCTURES:

MATERIALS:

Unless otherwise noted:



- Concrete shall be 4,000 psi compressive strength at 28 days.
- Reinforcing steel shall conform to AASHTO M31 Grade 60 (ASTM A615 Grade 60) unless otherwise noted.
- Reinforcing shall be ASTM A706 where welded connections are required.
- Welded wire fabric reinforcement shall conform to AASHTO M55 (ASTM A185).
- Structural steel (except wide flanges, pipes, and tubes) shall be AASHTO M270 Grade 36 (ASTM A36) zinc coated.
- Structural steel wide flanges shall conform to ASTM A270 Grade 50 (ASTM A709 Grade 50) zinc coated.
- Structural steel pipe shall conform to ASTM A53, Type E or S, Grade B zinc coated.
- Structural steel tubes shall conform to ASTM A500, Grade B zinc coated.
- Anchor bolts for aluminum and stainless steel structures, including nuts and washers, shall be stainless steel and shall conform to ASTM A193 UNS Designation S31600 and AASHTO M292, AISI 316 (ASTM A194, Type 316 Grade 8M, 8MA). Anchor bolts for structural steel, including nuts and washers, shall conform to AASHTO M314-90, (ASTM F1554) zinc coated.
- Structural connection bolts shall be AASHTO M164 (ASTM A325) zinc coated.
- Zinc coating shall conform to AASHTO M111 or AASHTO M232 (ASTM A123 or ASTM A153).
- For Glass Fiber Reinforced Polymer (GFRP) rebars, see Special Provisions.

CONSTRUCTION METHODS:


- Except as otherwise noted, all vertical dimensions are measured plumb.
- Exact location of reinforcing bars shall be so arranged that no interference will occur between vertical and horizontal reinforcing, so that the concrete can be properly placed and consolidated, and as directed by the Engineer.
- All dimensions relating to reinforcing are to centers of bars unless otherwise noted.
- Anchor bolts for structural supports for highway signs, luminaires and traffic signals shall be installed with misalignments of less than 1:40 from vertical.

GENERAL NOTES:

- The Contractor shall verify the location of all existing utility lines and notify the respective owners before commencing work.
- Except as otherwise noted on drawings, all exterior corners and re-entrant angles 90 degrees or less in concrete work shall be chamfered 3/4" x 3/4".
- Standard plans, details, and drawings refer to all structures in general except for modifications as may be required for special conditions. For such modifications refer to corresponding detailed drawings.
- Gothic letters and figures approximating dimensions shown will be acceptable if approved by the Engineer.

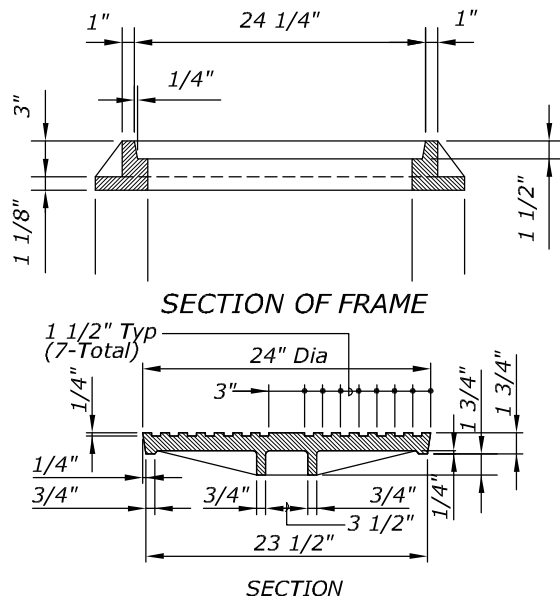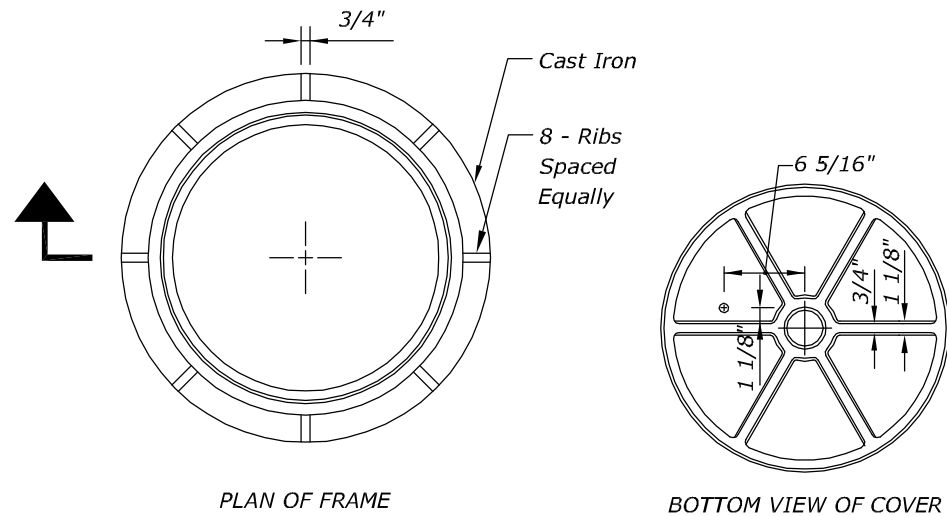


TYPE "P" CAST IRON FRAME AND COVER

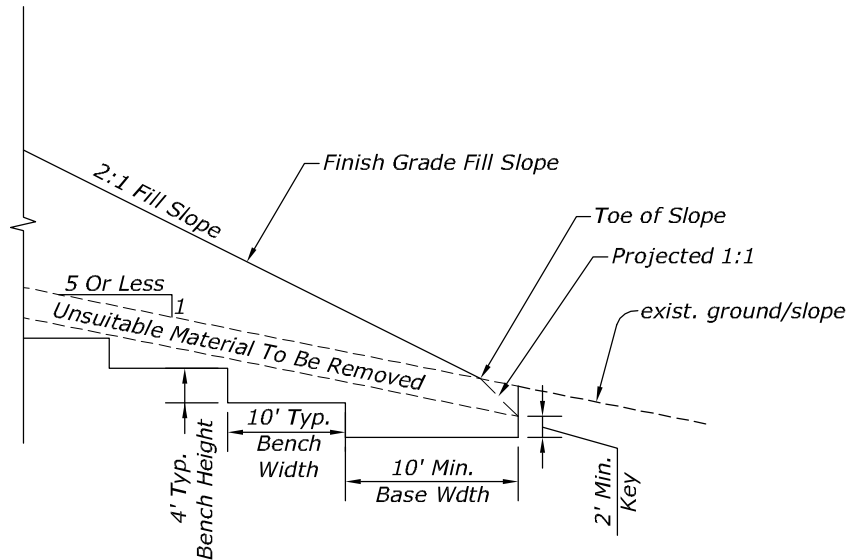


TYPICAL FILL SLOPE KEY AND BENCH DETAIL

NOTE:

Where Natural/existing Slope is 5:1 or Flatter, Benching is not Necessary. However, Fill Should Not be Placed on Compressible or Unsuitable Material.

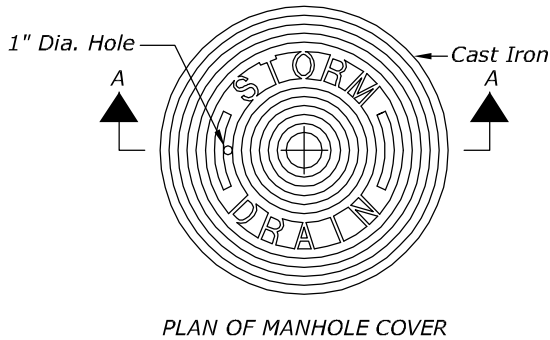

NO SCALE

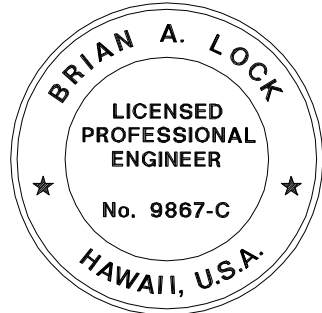

THIS WORK WAS PREPARED BY ME OR UNDER MY SUPERVISION.

WILSON OKAMOTO CORPORATION APRIL 30, 2020 LIC. EXP. DATE



U.S. DEPARTMENT OF TRANSPORTATION
FEDERAL HIGHWAY ADMINISTRATION
CENTRAL FEDERAL LANDS HIGHWAY DIVISION

U.S. CUSTOMARY SPECIAL


DRAIN DETAILS

SPECIAL

DRAWING NO.:

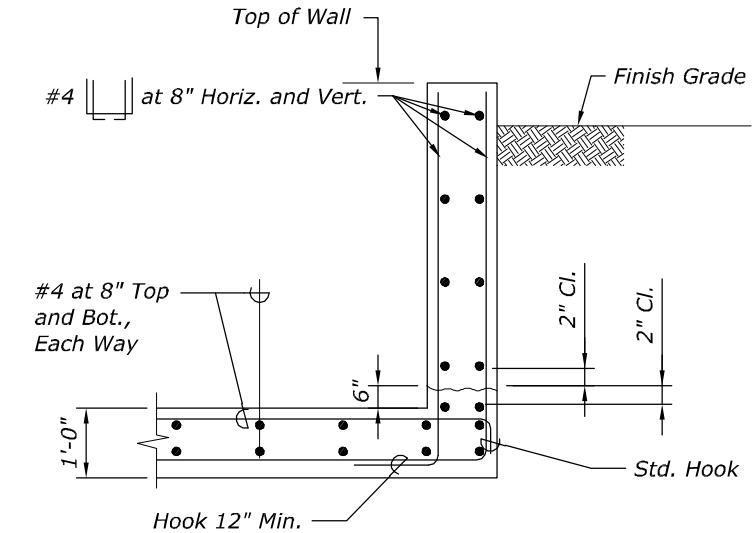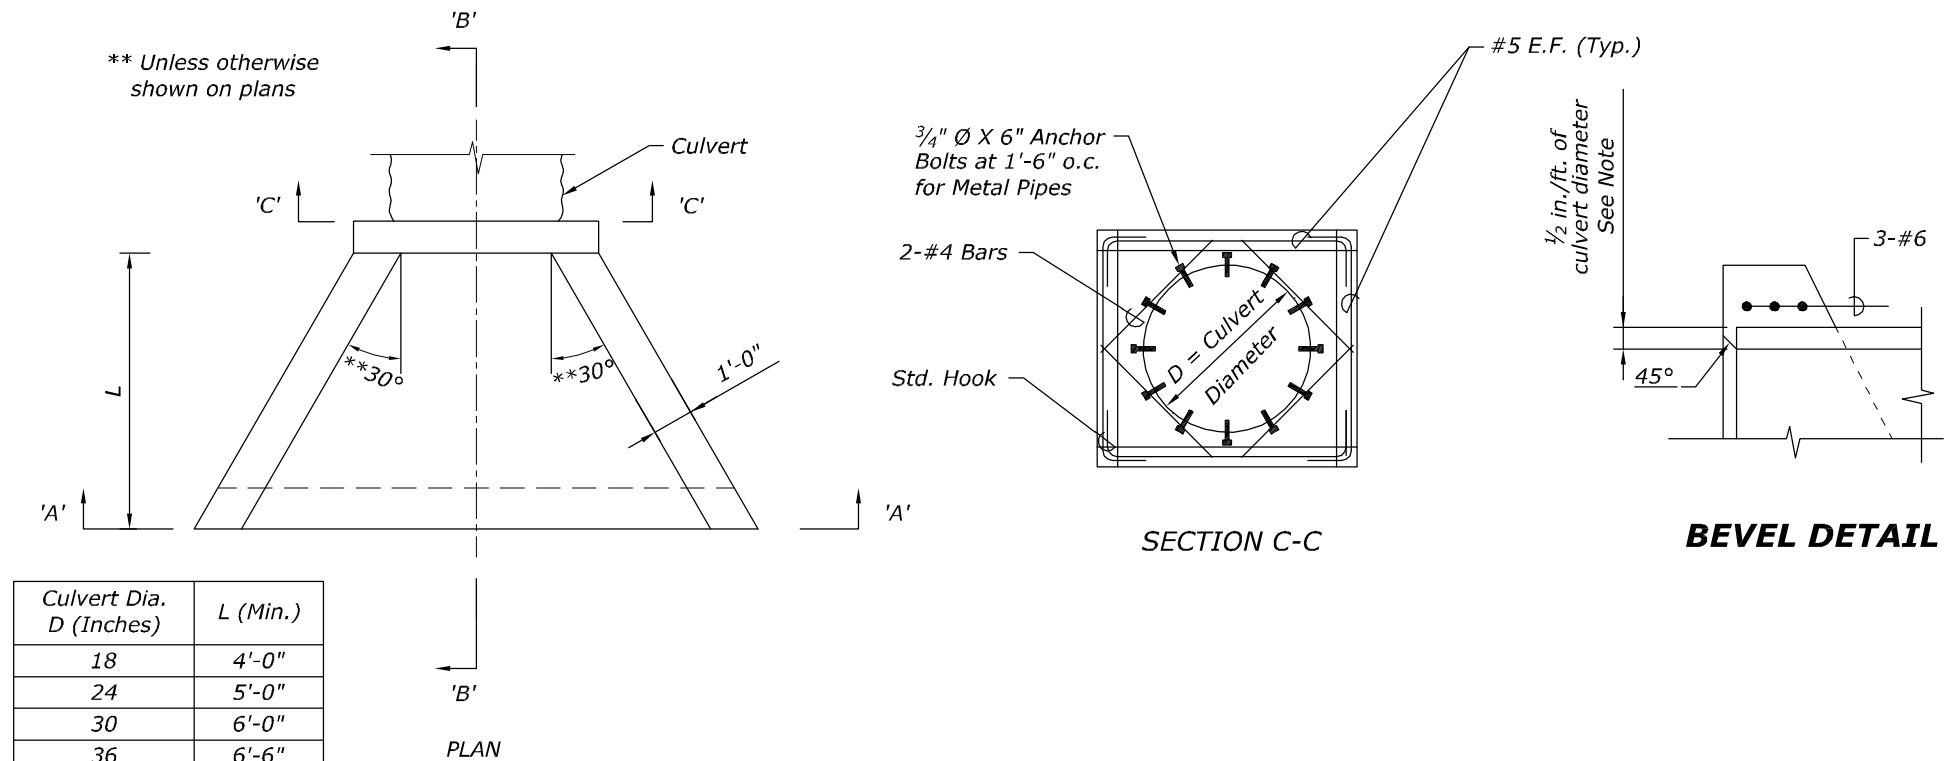

- GENERAL NOTES:**
- Construct bevels 1/2 in./ft. of culvert diameter or rise.
 - The groove or bell end of the concrete culvert may be used in place of the bevels.
 - Anchor bolts shall be ASTM A307 and zinc coated.
 - Design Criteria
 - Active Horizontal Pressure = 60 pcf (2 to 1 Sloping Backfill, Above Groundwater)
 - Active Vertical Pressure = 30 pcf (2 to 1 Sloping Backfill, Above Groundwater)
 - Strength Bearing Capacity = 2,500 psf
 - Inlet / Outlet Structures were not designed for Extreme Event Load Combination
 - See Sheet T63 for additional notes.

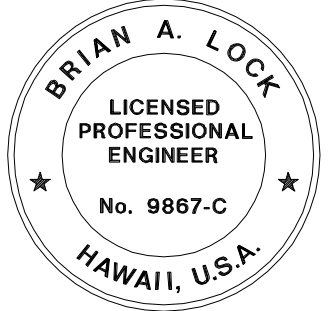

THIS WORK WAS PREPARED BY ME OR UNDER MY SUPERVISION.

WILSON OKAMOTO CORPORATION APRIL 30, 2020 L.I.C. EXP. DATE


U.S. DEPARTMENT OF TRANSPORTATION
FEDERAL HIGHWAY ADMINISTRATION
CENTRAL FEDERAL LANDS HIGHWAY DIVISION

U.S. CUSTOMARY SPECIAL


CULVERT HEADWALL DETAILS

SPECIAL

NO SCALE

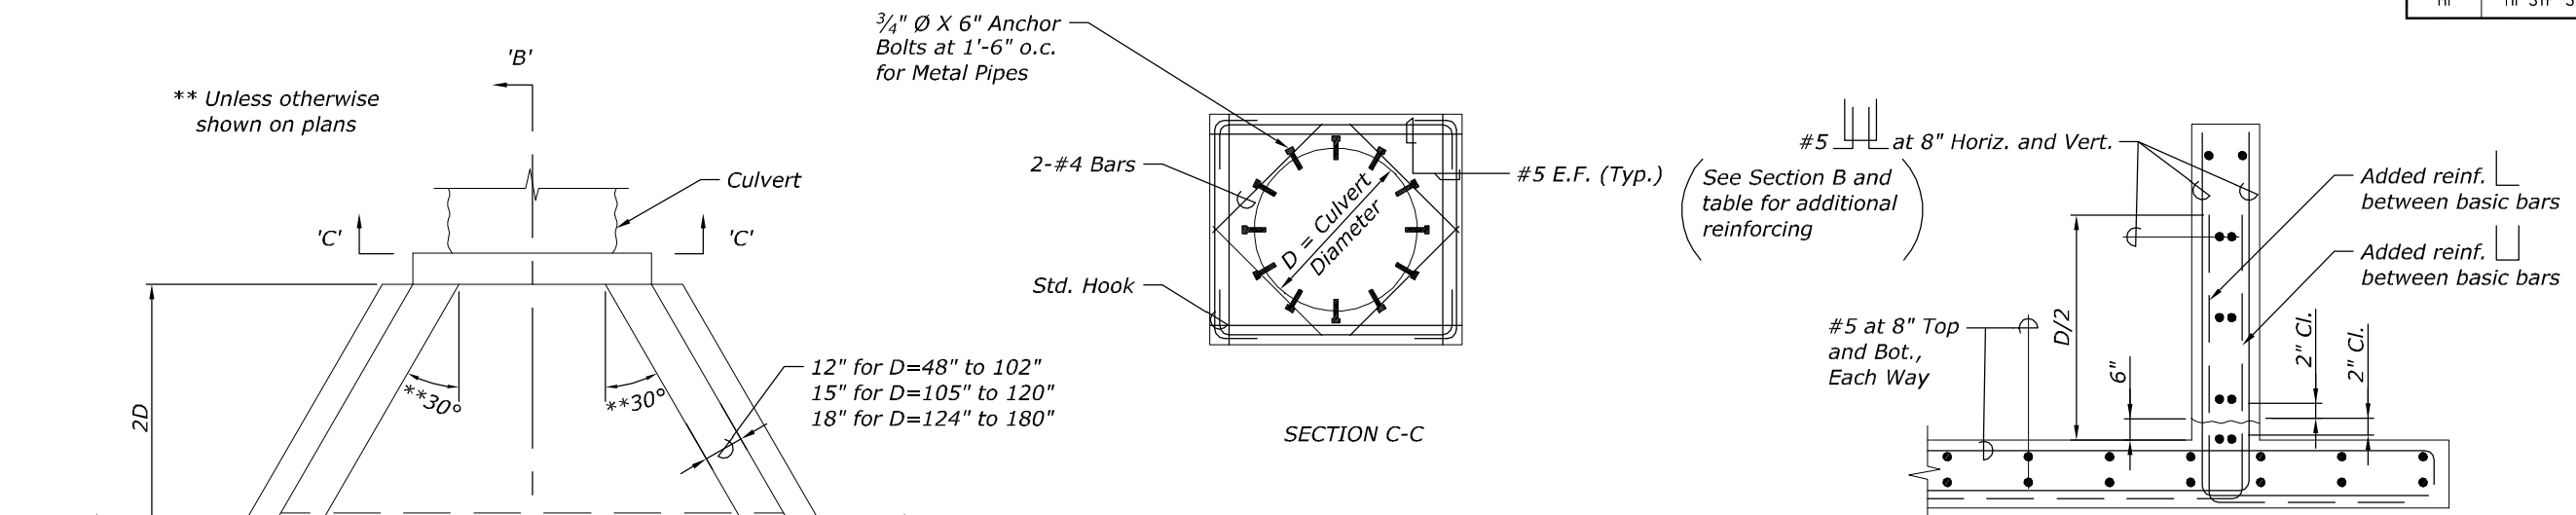


12", 15", AND 18" WING WALLS
TYPICAL WING WALL REINFORCING SECTION

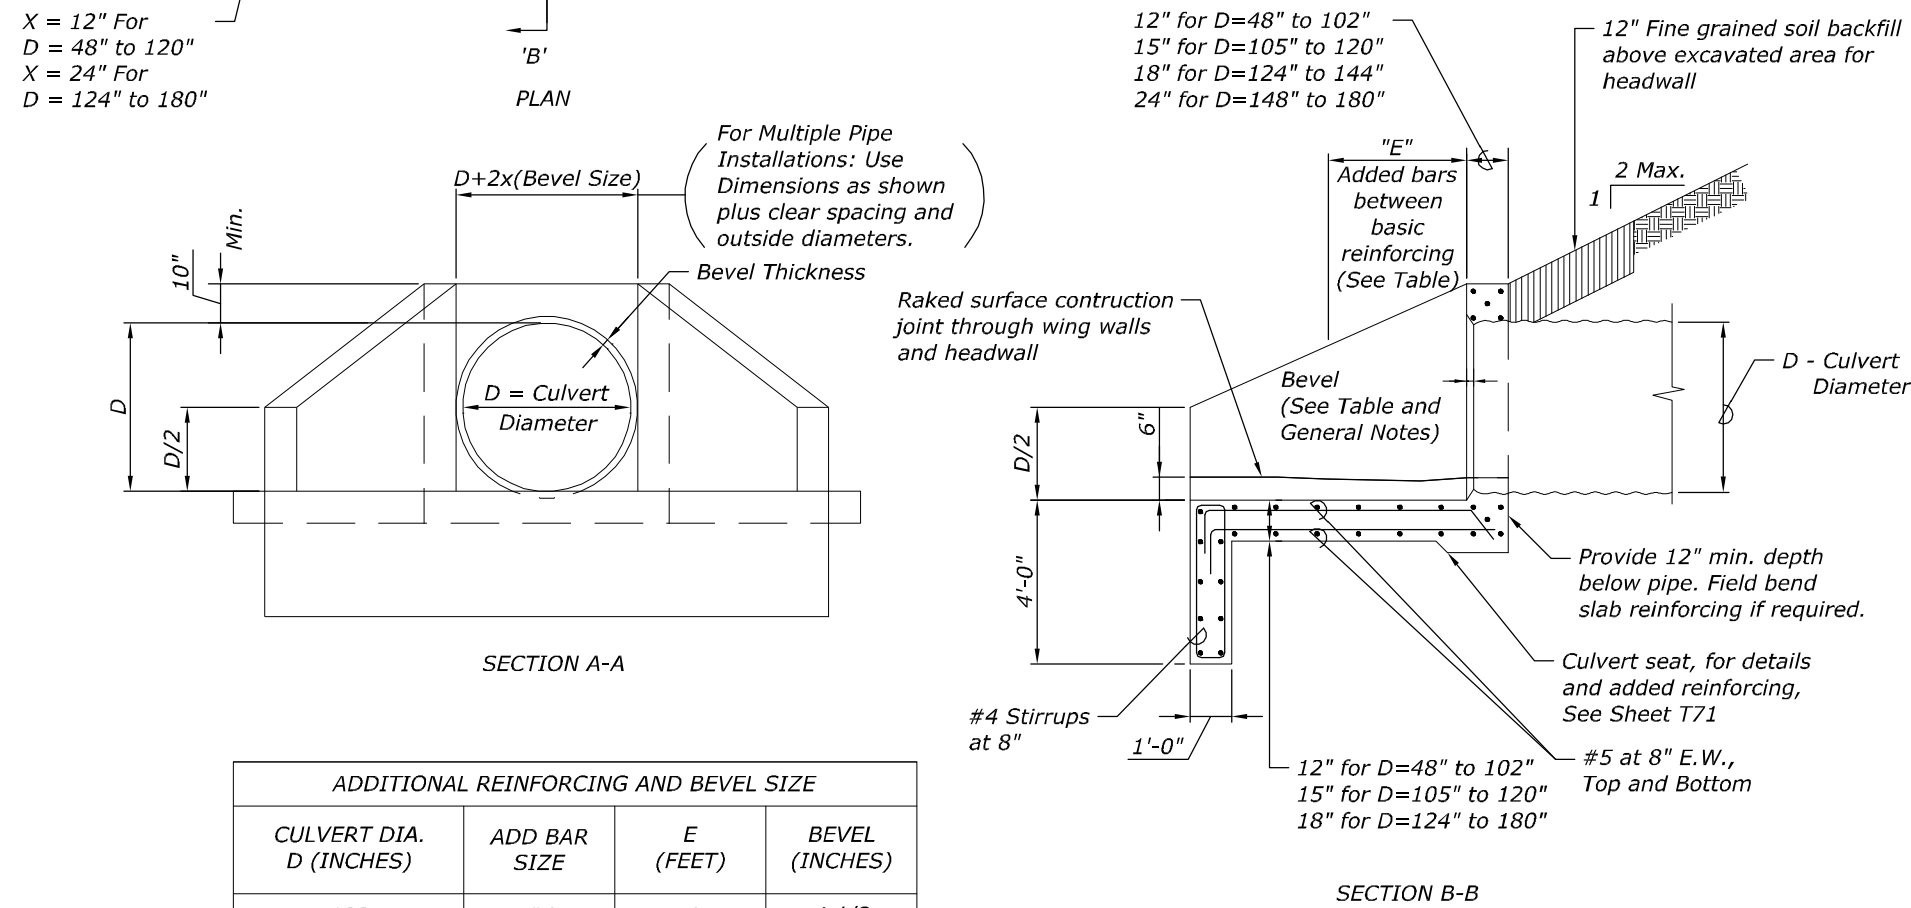

- GENERAL NOTES:**
- Construct bevels 1/2 in./ft. of culvert diameter or rise. See Sheet T64 for bevel detail.
 - The groove or bell end of the concrete culvert may be used in place of the bevels.
 - Anchor bolts shall be ASTM A307 and zinc coated.
 - Design Criteria
 - Active Horizontal Pressure = 60 pcf (2 to 1 Sloping Backfill, Above Groundwater)
 - Active Vertical Pressure = 30 pcf (2 to 1 Sloping Backfill, Above Groundwater)
 - Strength Bearing Capacity = 2,500 psf
 - Inlet / Outlet Structures were not designed for Extreme Event Load Combination
 - See Sheet T63 for additional notes.

ADDITIONAL REINFORCING AND BEVEL SIZE			
CULVERT DIA. D (INCHES)	ADD BAR SIZE	E (FEET)	BEVEL (INCHES)
108	#4	4	4 1/2
120	#4	6	5
144	#5	9	6
180	#7	20	7 1/2

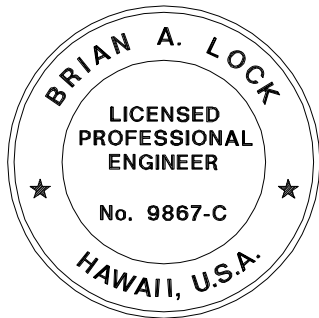


THIS WORK WAS PREPARED BY ME
OR UNDER MY SUPERVISION.

WILSON OKAMOTO CORPORATION
APRIL 30, 2020
LIC. EXP. DATE


U.S. DEPARTMENT OF TRANSPORTATION FEDERAL HIGHWAY ADMINISTRATION CENTRAL FEDERAL LANDS HIGHWAY DIVISION	
U.S. CUSTOMARY SPECIAL	
CULVERT HEADWALL DETAILS	
	SPECIAL

INLET/OUTLET STRUCTURE FOR CULVERT SIZES 48 IN. TO 180 IN. DIA.

NO SCALE

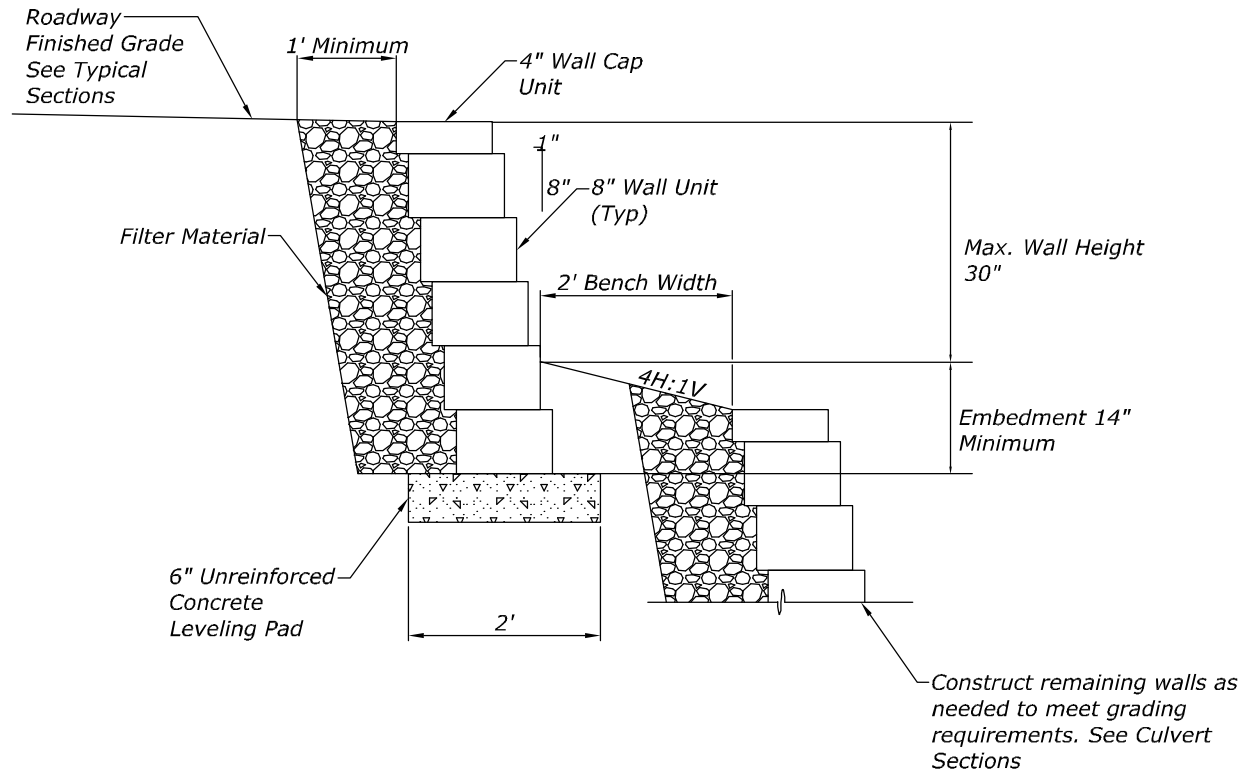


CMU DETAIL

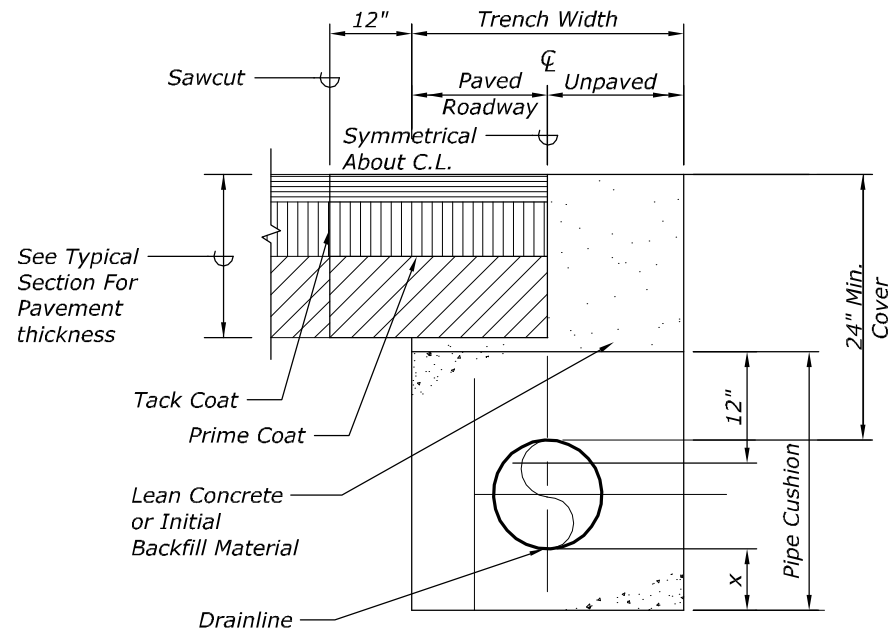


Culvert Dia. D (Inches)	x (Min.)
12 to 54	4"
> 54	6"

DRAINLINE TRENCH RESTORATION

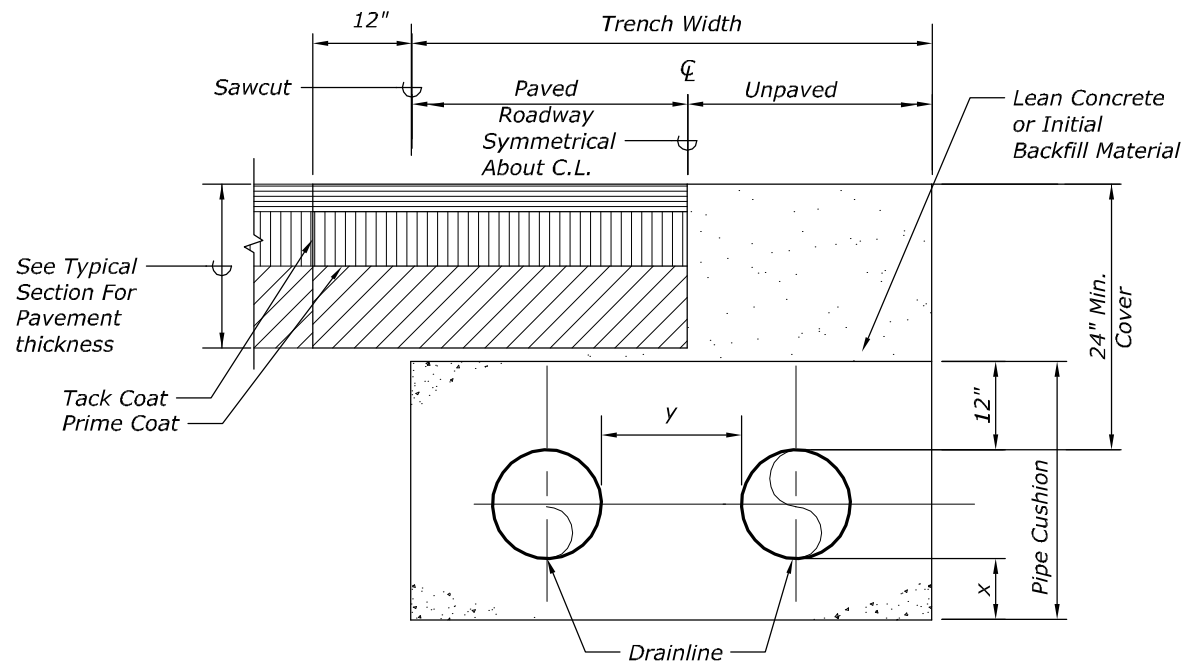

Culvert Dia. D (Inches)	x (Min.)	y (Min.)
48"	4"	2'
60"	6"	2.5'

MULTIPLE DRAINLINE TRENCH RESTORATION

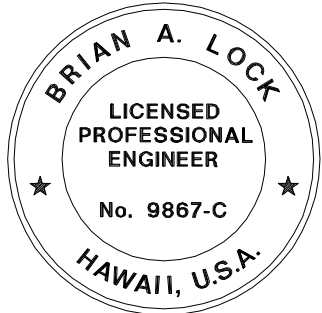

THIS WORK WAS PREPARED BY ME
OR UNDER MY SUPERVISION.

WILSON OKAMOTO CORPORATION
APRIL 30, 2020
LIC. EXP. DATE


U.S. DEPARTMENT OF TRANSPORTATION
FEDERAL HIGHWAY ADMINISTRATION
CENTRAL FEDERAL LANDS HIGHWAY DIVISION

U.S. CUSTOMARY SPECIAL


DRAIN DETAILS

SPECIAL


NO SCALE

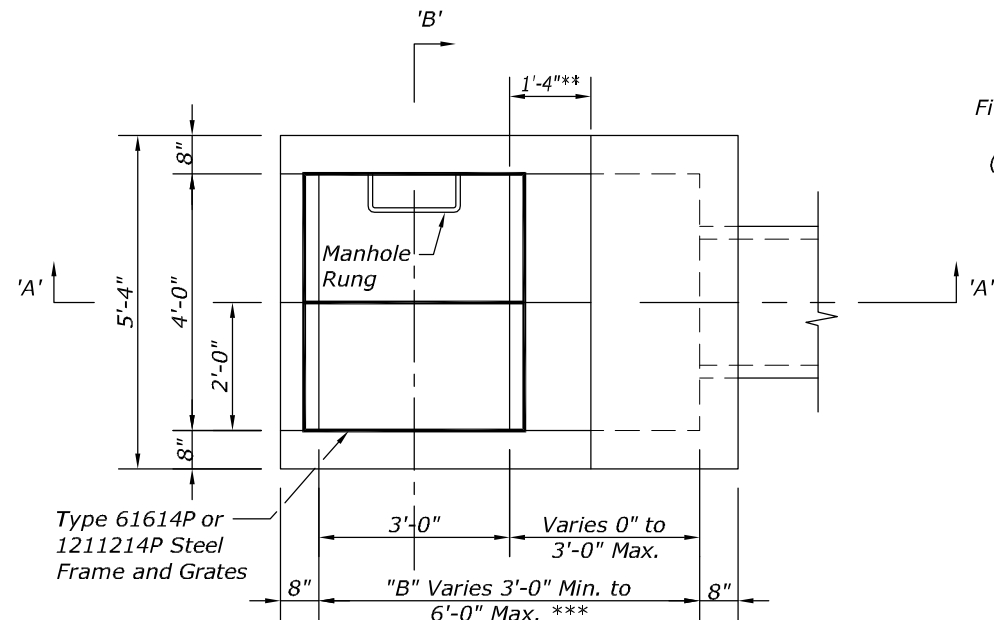


PLAN

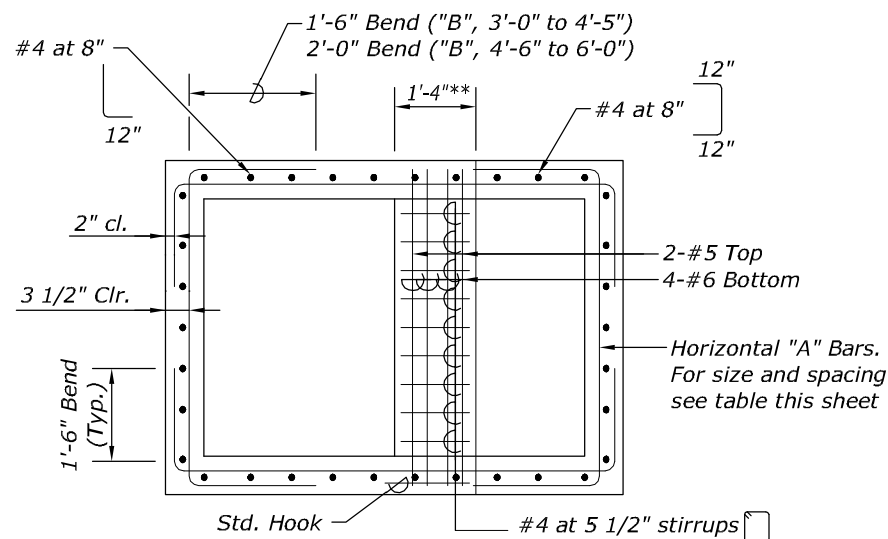


PLAN VIEW OF WALL REINFORCING

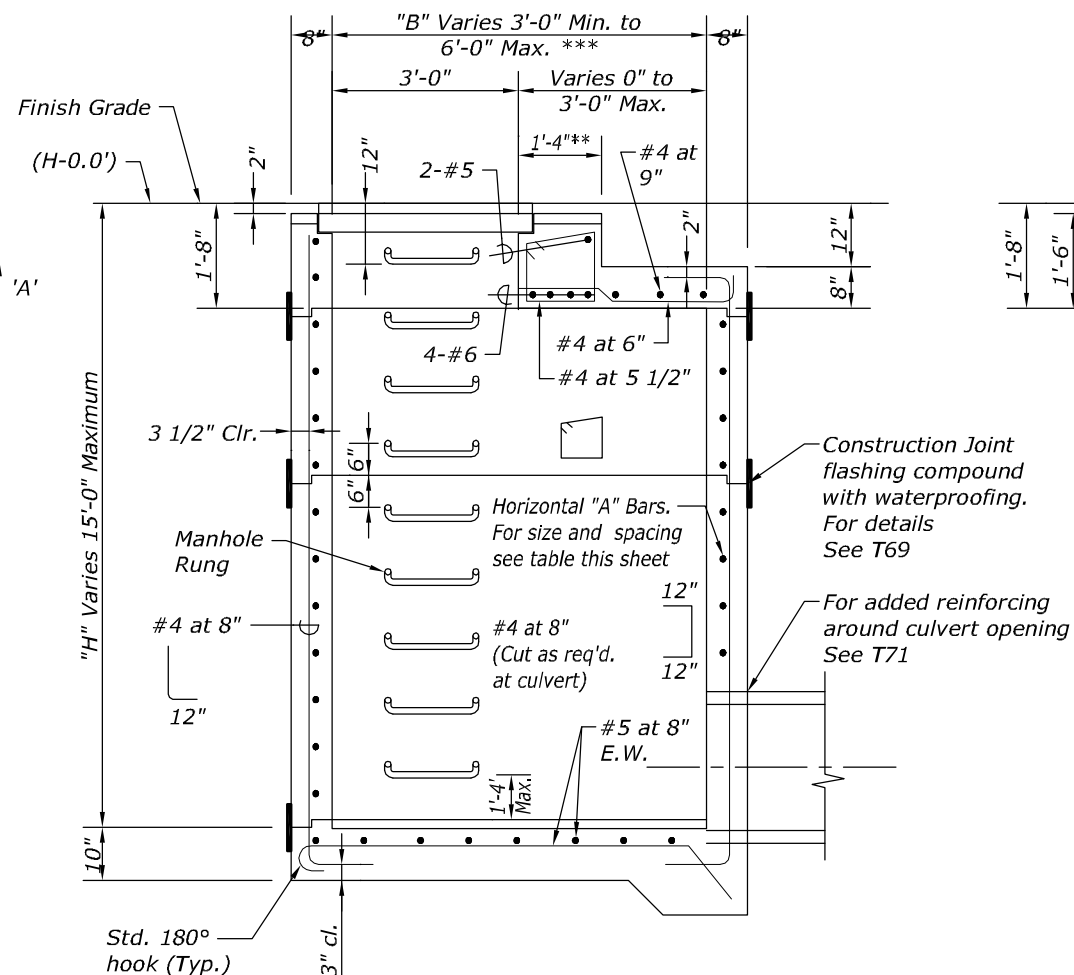

SECTION A-A

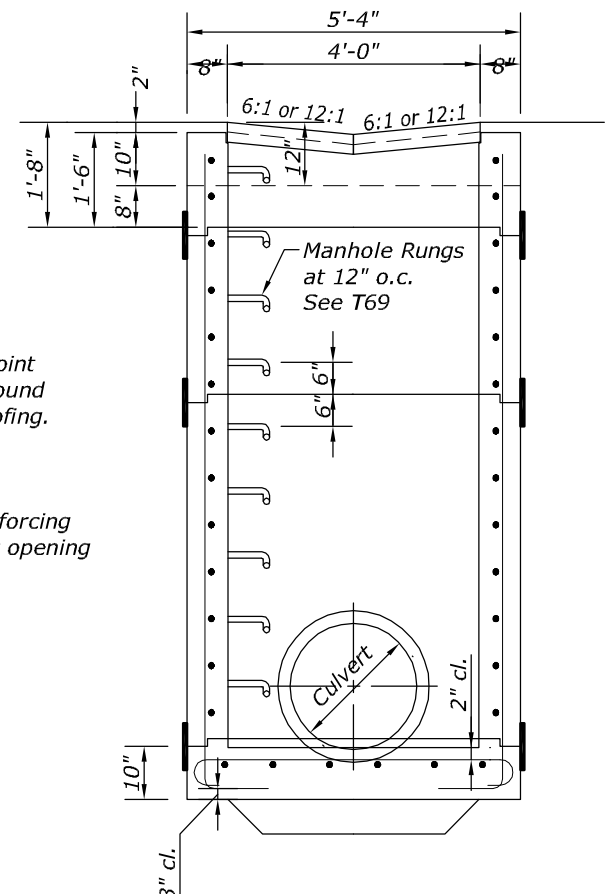

SECTION B-B

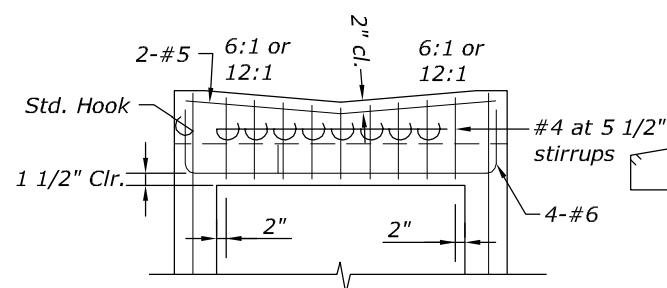

SECTION OF BEAM REINFORCING

TYPE 61614(P) GRATED DROP INLET


HORIZ. "A" BARS FOR GRATED DROP INLET		
DEPTH "H"	"A" BARS	
	"B"-3'-0" to 4'-5"	"B"-4'-6" to 6'-0"
0'-0" to 5'-0"	#4 at 12"	#5 at 10"
5'-1" to 10'-0"	#4 at 10"	#5 at 8"
10'-1" to 15'-0"	#4 at 8"	#5 at 6"

GENERAL NOTES:

- General Criteria
 - At-rest Horizontal Pressure = 80 pcf (2 to 1 sloping backfill, above groundwater)
 - At-rest Vertical Pressure = 40 pcf (2 to sloping backfill, above groundwater)
 - Allowable Bearing Capacity = 1,700 psf+8 x (overburden pressure); where overburden pressure equals 100 pcf x H
 - Live Load Surcharge (Equivalent Height of Soil)
For H = 0' to 5'; heq = 4'-0"
For H = 5' to 20'; heq = 3'-0"
- Exposure Factor (For Crack Control) = 1.0 for Class 1 exposure.
- For vertical rebar lap splice length, See T72.
- See T63 for additional notes.

LEGEND:

- *** For minimum size box (3'-0"), eliminate beam and use typical wall and wall reinforcing shown in the top portion.
- *** For culverts larger than 30", the minimum dimension shall be D (Diameter of pipe culvert or 3'-0", whichever is bigger.)

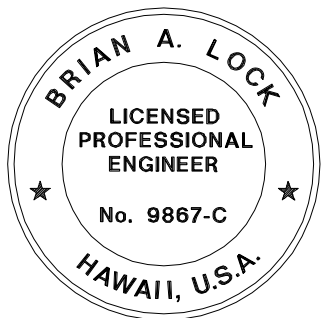

THIS WORK WAS PREPARED BY ME OR UNDER MY SUPERVISION.


WILSON OKAMOTO CORPORATION APRIL 30, 2020
LIC. EXP. DATE

U.S. DEPARTMENT OF TRANSPORTATION
FEDERAL HIGHWAY ADMINISTRATION
CENTRAL FEDERAL LANDS HIGHWAY DIVISION


U.S. CUSTOMARY SPECIAL

DRAINAGE DETAILS


SPECIAL

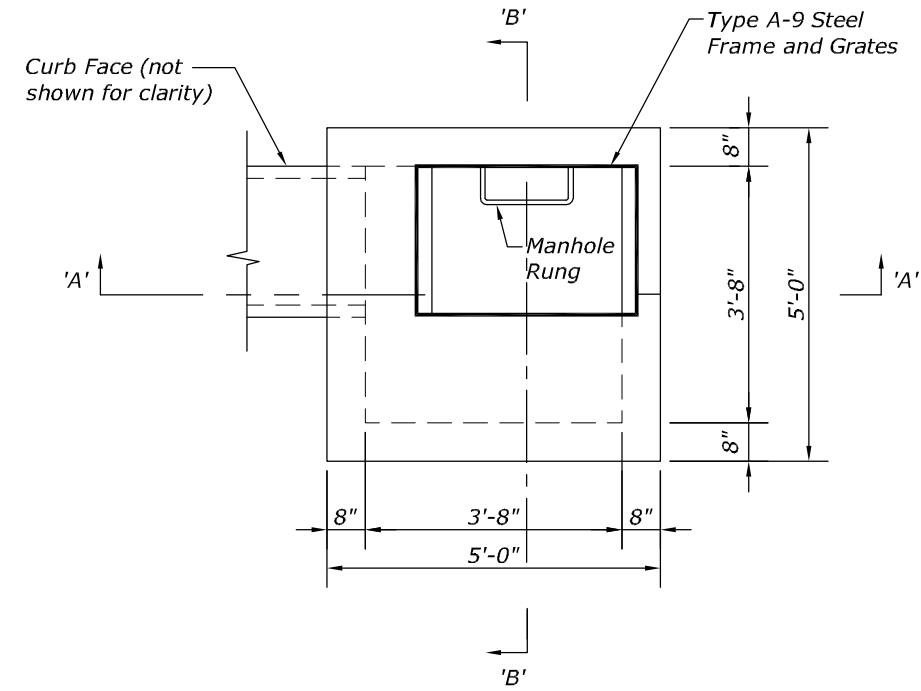

PLAN

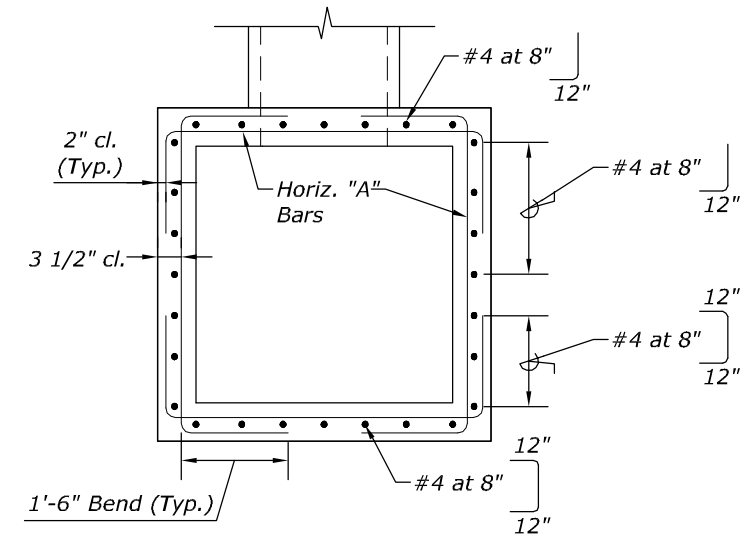

PLAN VIEW OF WALL REINFORCING

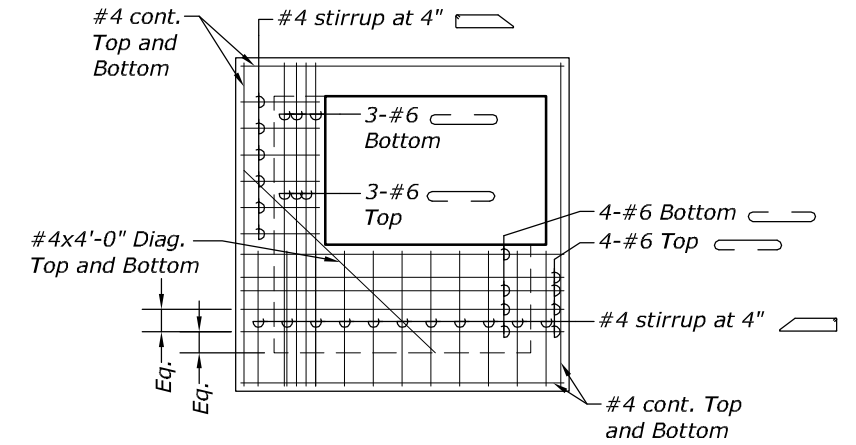

PLAN VIEW OF TOP SLAB REINFORCING

HORIZONTAL "A" BARS FOR GRATED DROP INLET	
DEPTH "H"	"A" BARS
0'-0" to 5'-0"	#4 at 12"
5'-1" to 10'-0"	#4 at 12"
10'-1" to 15'-0"	#4 at 9"

GENERAL NOTES:

- General Criteria
 - At-rest Horizontal Pressure = 80 pcf (2 to 1 sloping backfill, above groundwater)
 - At-rest Vertical Pressure = 40 pcf (2 to 1 sloping backfill, above groundwater)
 - Allowable Bearing Capacity = 1,700 psf + 8 x (overburden pressure); where overburden pressure equals 100 pcf x H
 - Live Load Surcharge (Equivalent Height of Soil)
For H = 0' to 5'; heq = 4'-0"
For H = 5' to 20'; heq = 3'-0"
- Exposure Factor (For Crack Control) = 1.0 for Class 1 exposure.
- For vertical rebar lap splice length, See T72.
- See T63 for additional notes.



THIS WORK WAS PREPARED BY ME
OR UNDER MY SUPERVISION.

WILSON OKAMOTO CORPORATION
APRIL 30, 2020
LIC. EXP. DATE

U.S. DEPARTMENT OF TRANSPORTATION
FEDERAL HIGHWAY ADMINISTRATION
CENTRAL FEDERAL LANDS HIGHWAY DIVISION


U.S. CUSTOMARY SPECIAL

DRAINAGE DETAILS


SPECIAL

NO SCALE

DRAWING NO.:

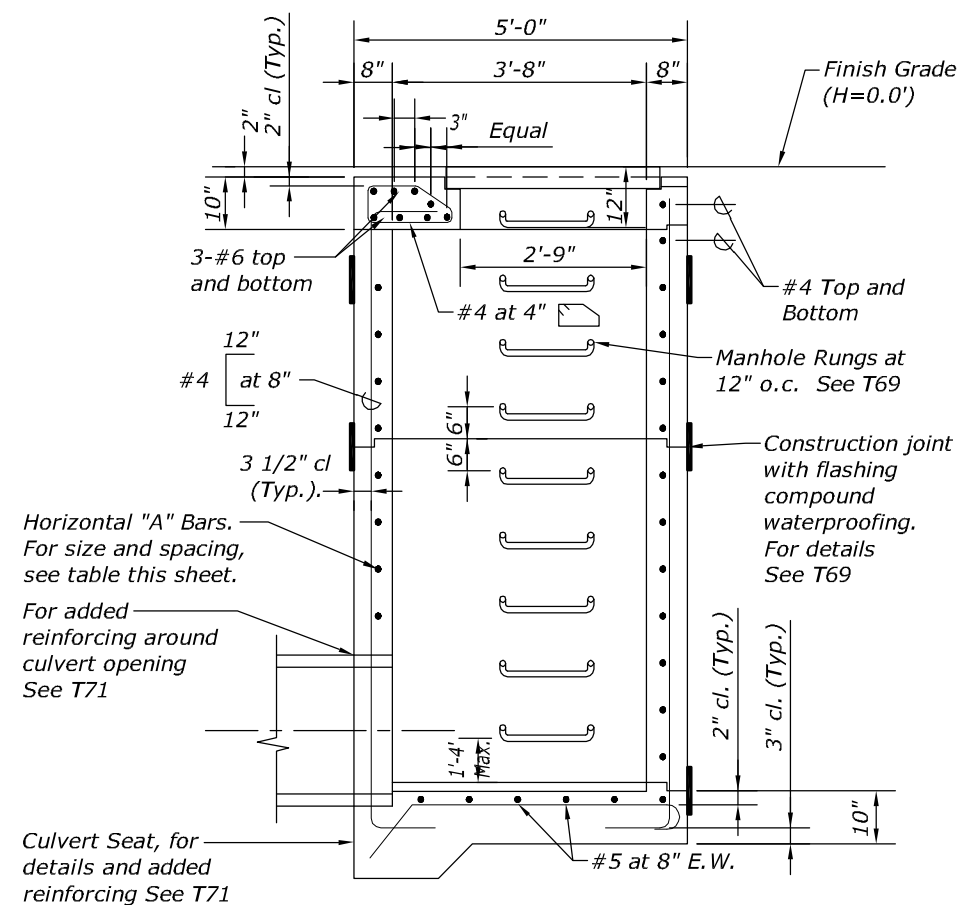


SECTION "A"

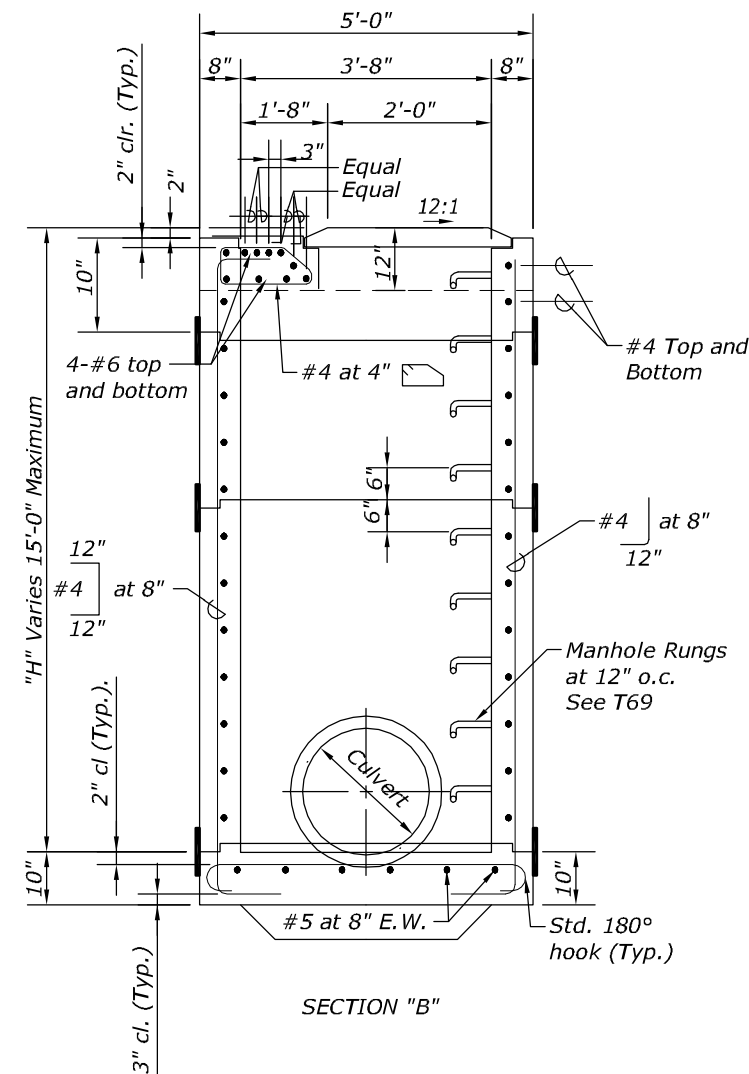


SECTION "B"

TYPE 1A-9 GRATED DROP INLET

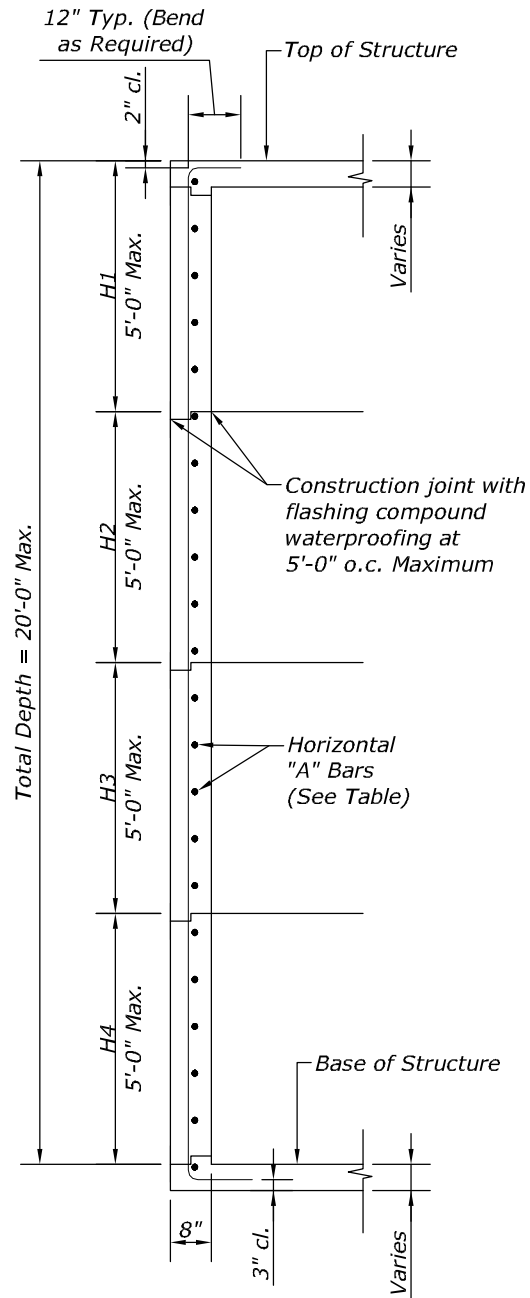


ELEVATION VIEW OF WALL SECTION

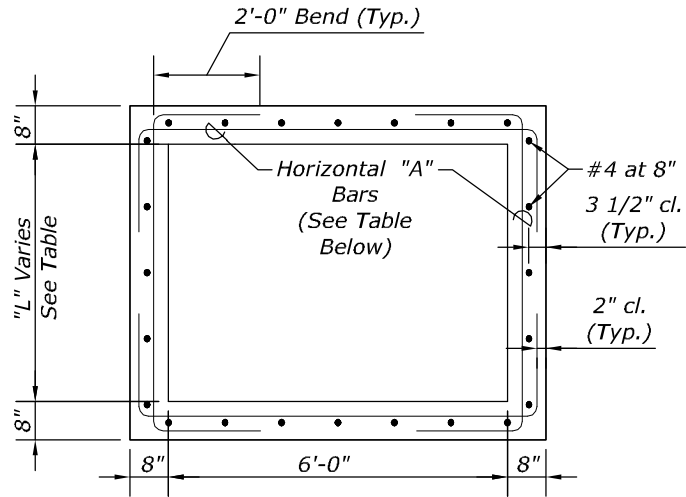


PLAN VIEW OF WALL REINFORCING


- General Notes:**
- General Criteria
 - At-rest Horizontal Pressure = 80 pcf (2 to 1 sloping backfill, above groundwater)
 - At-rest Vertical Pressure = 40 pcf (2 to 1 sloping backfill, above groundwater)
 - Allowable Bearing Capacity = 1,700 psf + 8 x (overburden pressure); where overburden pressure equals 100 pcf x H
 - Live Load Surcharge (Equivalent Height of Soil)
For H = 0' to 5'; heq = 4'-0"
For H = 5' to 20'; heq = 3'-0"
 - Exposure Factor (For Crack Control) = 1.0 for Class 1 exposure.
 - See T63 for additional notes.

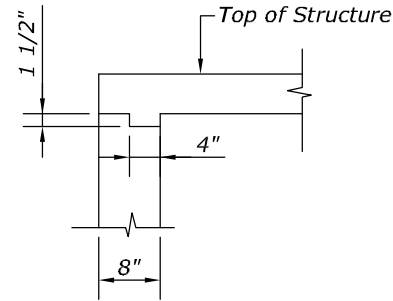

JOINT AT TOP

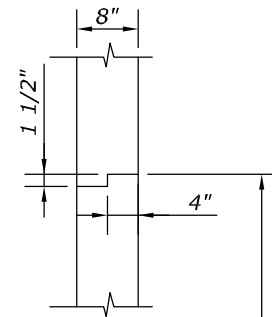


INTERMEDIATE JOINT

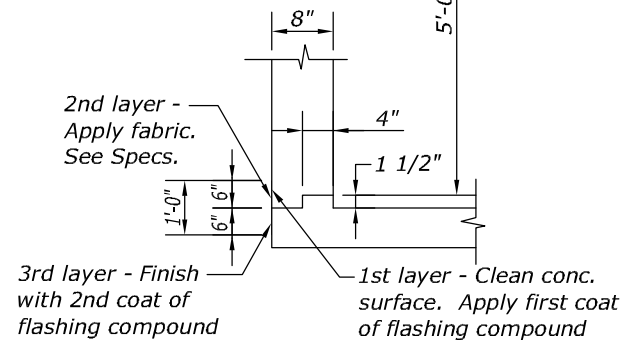


JOINT AT BASE


Note:
Waterproof all construction joints.

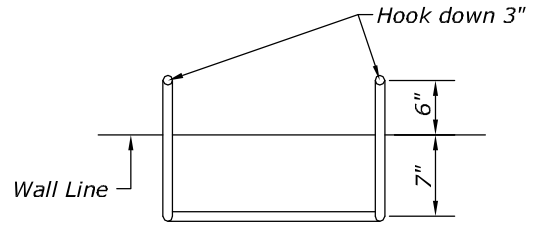

PLAN

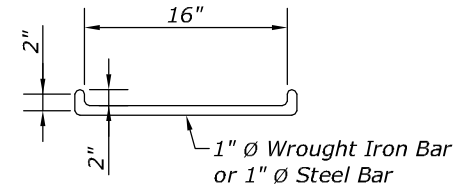


FRONT VIEW

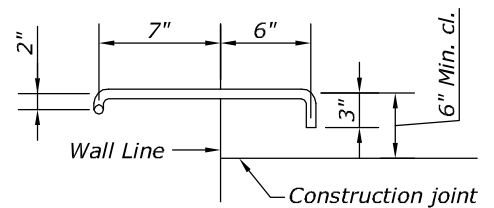

SIDE VIEW

MANHOLE RUNG

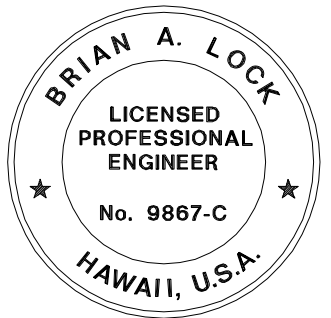

THIS WORK WAS PREPARED BY ME
OR UNDER MY SUPERVISION.

WILSON OKAMOTO CORPORATION APRIL 30, 2020
LIC. EXP. DATE

U.S. DEPARTMENT OF TRANSPORTATION
FEDERAL HIGHWAY ADMINISTRATION
CENTRAL FEDERAL LANDS HIGHWAY DIVISION

U.S. CUSTOMARY SPECIAL

**DRAINAGE DETAILS
TYPICAL REINFORCING FOR
DRAINAGE STRUCTURES**


SPECIAL

NO SCALE

DRAWING NO.:


HORIZONTAL "A" BARS FOR CATCH BASINS					
DEPTH	"L" MAX.				
	4'-0"	6'-0"	7'-4"	8'-4"	9'-4"
H1 0" to 5'-0"	#5 at 10"	#5 at 10"	#5 at 8"	#5 at 6"	#5 at 5"
H2 5'-1" to 10'-0"	#5 at 8"	#5 at 8"	#5 at 6"	N.A.	N.A.
H3 10'-1" to 15'-0"	#5 at 6"	#5 at 6"	N.A.	N.A.	N.A.
H4 15'-1" to 20'-0"	#5 at 6"	N.A.	N.A.	N.A.	N.A.

Note: N.A. = Not Applicable

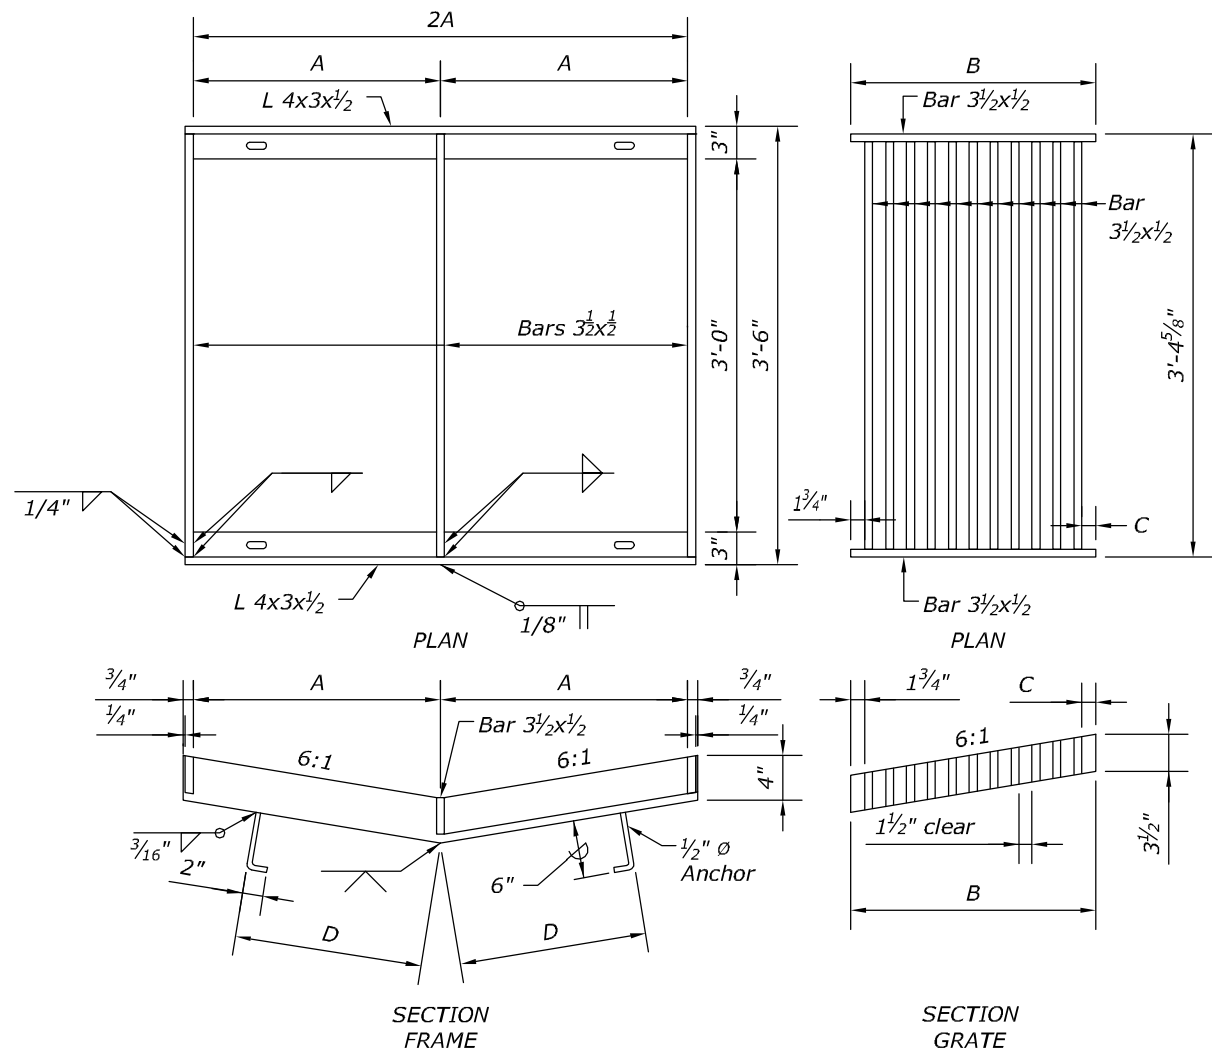

DIMENSIONS					
TYPE	NO. BARS	A	B	C	D
61614	11	2'-0"	1'-11 1/2"	1 1/4"	1'-6"
61616	17	3'-0"	2'-11 3/8"	1 1/8"	2'-0"


TYPE 61614 STEEL FRAME AND GRATES
(GRATE PLAN AND SECTION DRAWN FOR TYPE 61614, TYPE 61616 SIMILAR)

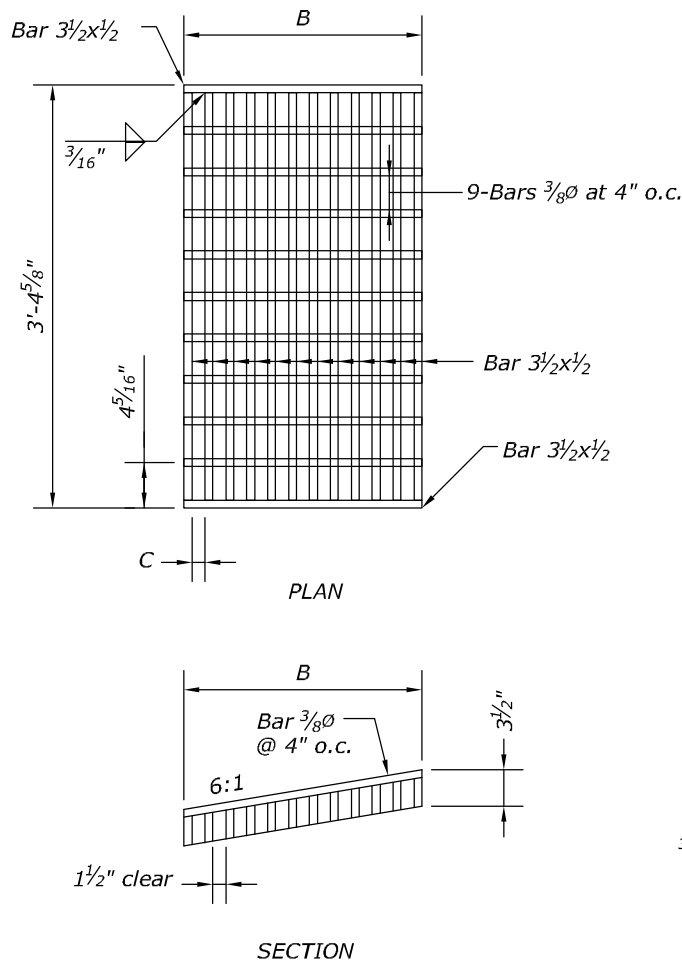

DIMENSIONS			
TYPE	NO. BARS	B	C
61614P	12	1'-11 1/2"	2"
61616P	18	2'-11 3/8"	1 15/16"


TYPE 61614P STEEL GRATES
(GRATE PLAN AND SECTIONS DRAWN FOR TYPE 61614P, TYPE 61616P SIMILAR)

- GENERAL NOTES:**
- All welds $\frac{3}{8}$ " unless otherwise noted.
 - Grates and frames shall be zinc coated after fabrication.
 - Anchors shall be ASTM A 307 and zinc coated.
 - See T63 for additional notes.

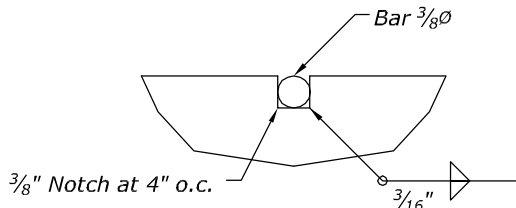

NOTCH DETAIL

GRATE

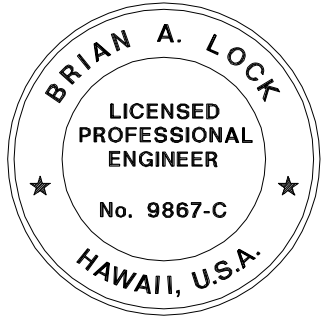

THIS WORK WAS PREPARED BY ME
OR UNDER MY SUPERVISION.

WILSON OKAMOTO CORPORATION
APRIL 30, 2020
LIC. EXP. DATE

U.S. DEPARTMENT OF TRANSPORTATION
FEDERAL HIGHWAY ADMINISTRATION
CENTRAL FEDERAL LANDS HIGHWAY DIVISION


U.S. CUSTOMARY SPECIAL

**DRAINAGE DETAILS
TYPE 61614 STEEL FRAME AND
GRATE**


SPECIAL

NO SCALE


STATE	PROJECT	SHEET NO.
HI	HI STP SR 30(1)	T71

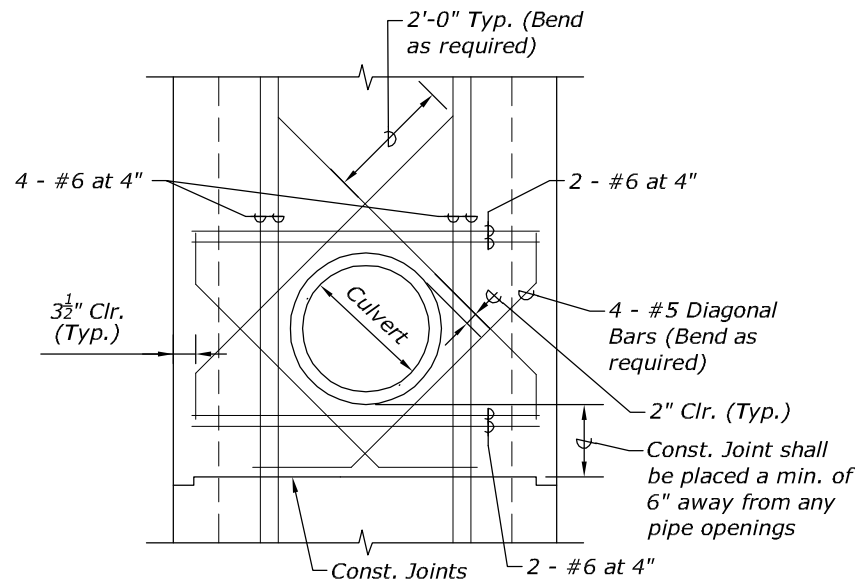


**ADDED REINFORCING FOR
CULVERT OPENINGS (ABOVE
BOTTOM SLAB)**

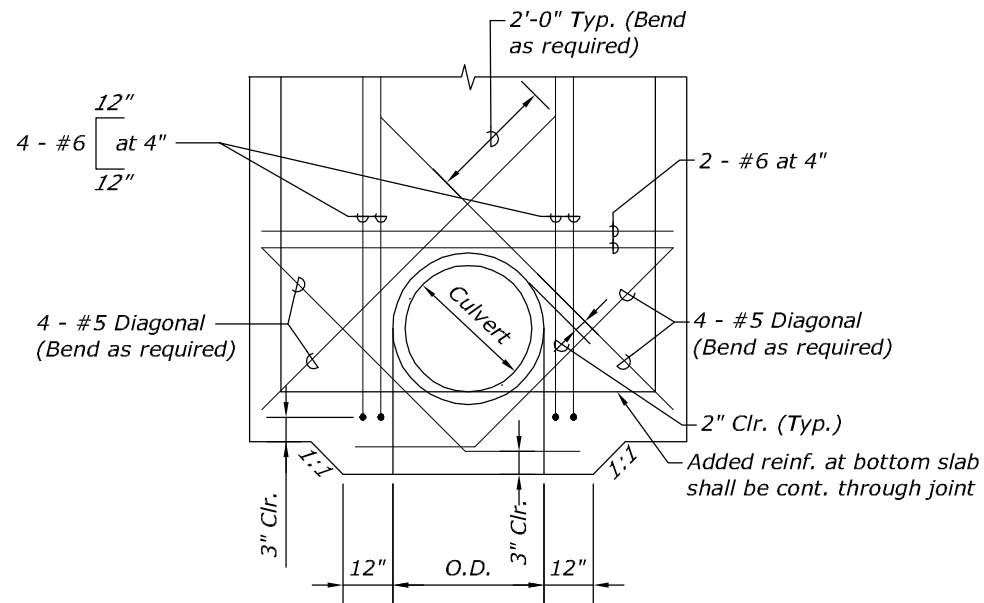

**ADDED REINFORCING FOR
CULVERT OPENINGS AT BOTTOM
SLAB**

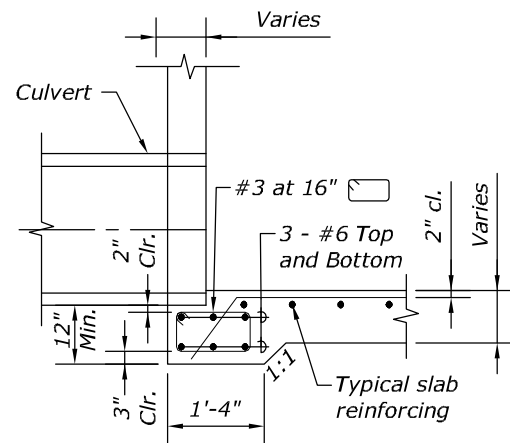

DETAIL OF CULVERT SEAT

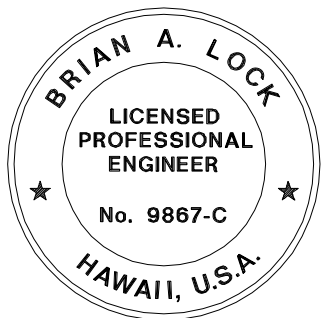

THIS WORK WAS PREPARED BY ME
OR UNDER MY SUPERVISION.

WILSON OKAMOTO CORPORATION
APRIL 30, 2020
L.I.C. EXP. DATE

U.S. DEPARTMENT OF TRANSPORTATION
FEDERAL HIGHWAY ADMINISTRATION
CENTRAL FEDERAL LANDS HIGHWAY DIVISION


U.S. CUSTOMARY SPECIAL

**DRAINAGE DETAILS
TYPICAL REINFORCING FOR
DRAINAGE STRUCTURES**

SPECIAL


NO SCALE

DRAWING NO.:

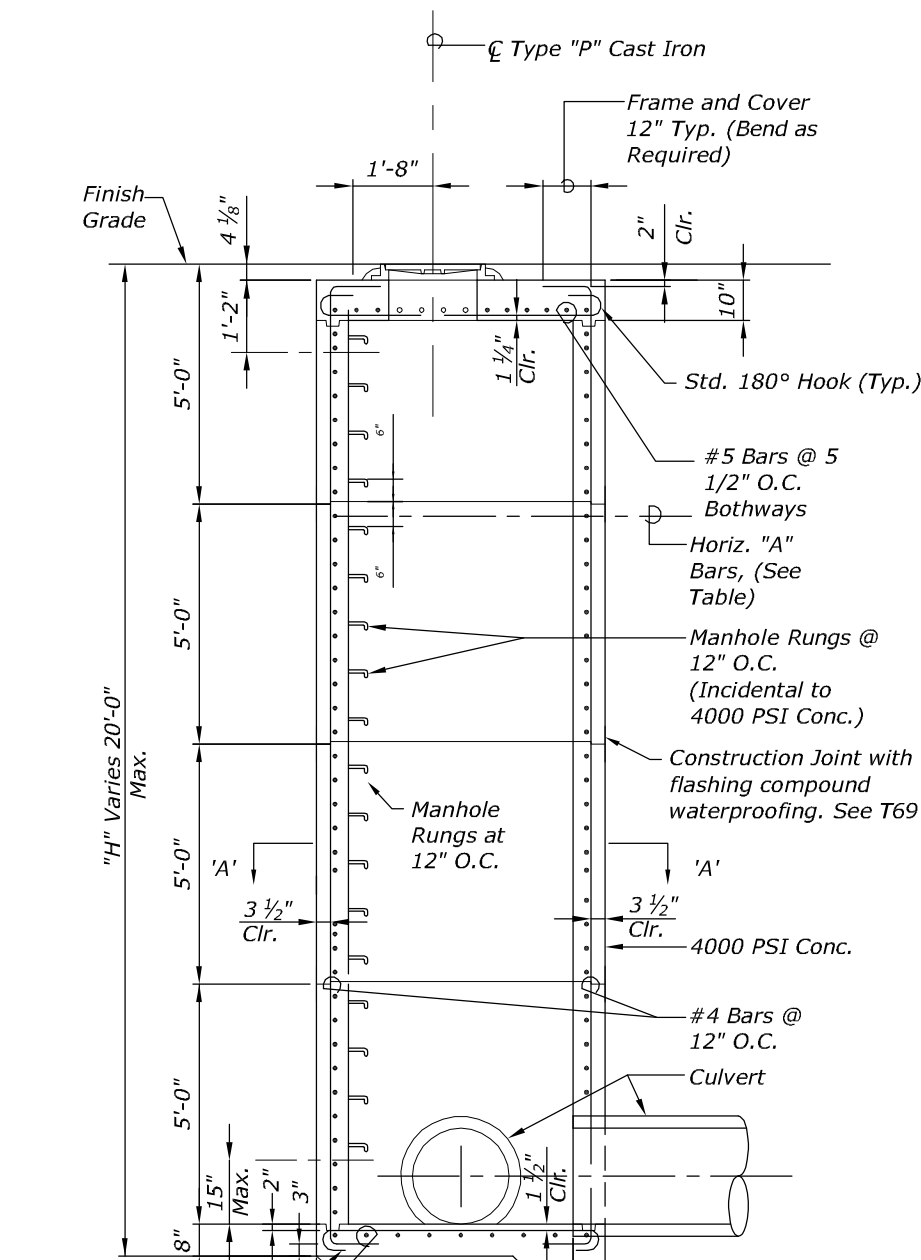


Vert. Reinf. at bottom slab shall be cont. through joint
#5 Bars @ 8" O.C., Bothways

SECTION A-A

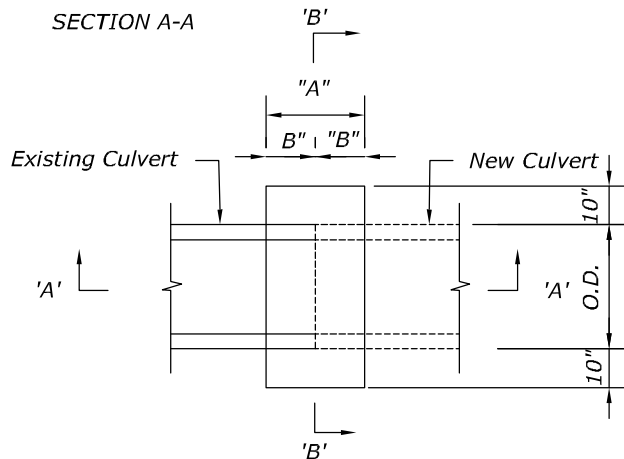


PLAN

REINFORCED CONCRETE JACKET


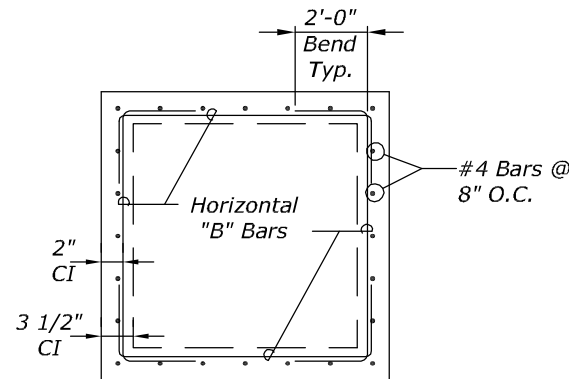


SECTION B

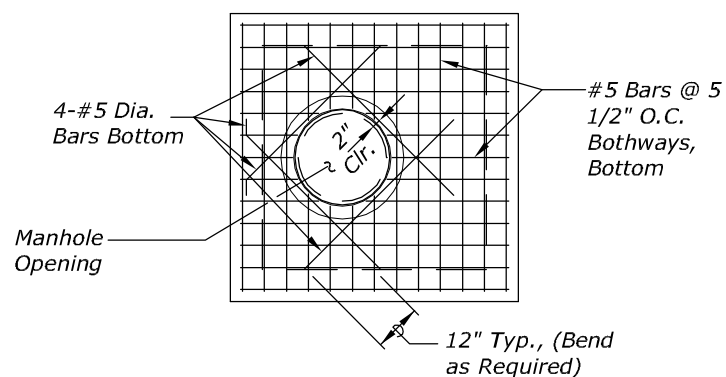

PLAN
(Top Slab Reinforcing)

MODIFIED TYPE "A", "B", & "C" STORM DRAIN MANHOLE

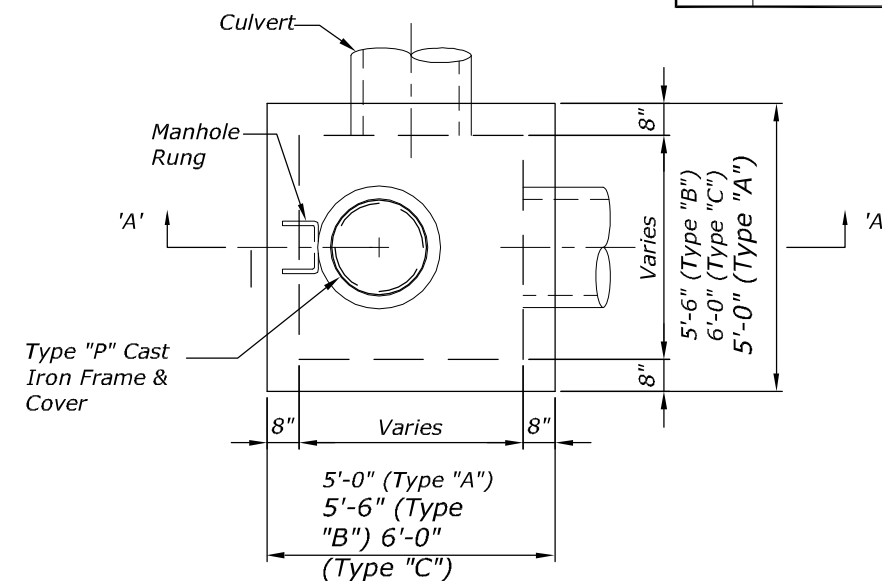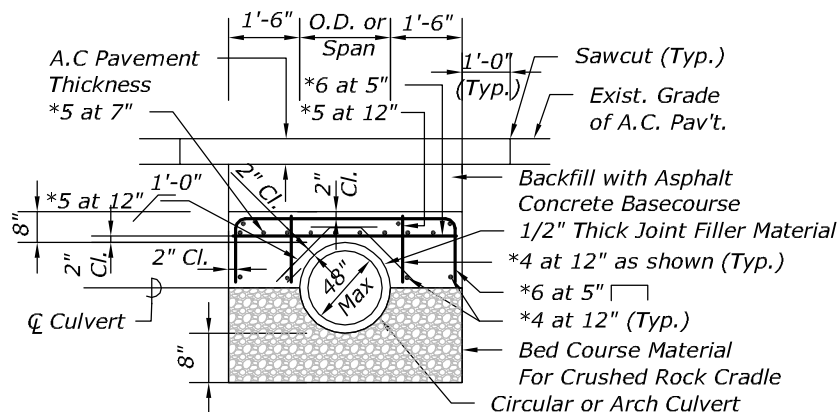


PLAN

HORIZONTAL "A" BARS FOR STORM DRAIN MANHOLE	
SDMH DEPTH	Horizontal "A" Bars
0'-0" to 5'-0"	#5 at 10"
5'-1" to 10'-0"	#5 at 8"
10'-1" to 15'-0"	#5 at 6"
15'-1" to 20'-0"	#5 at 6"

VERT. BAR LAP SPLICE	
BAR	VERT. LAP LENGTH
*4	1'-B"
*5	2'-2"

GENERAL NOTES

- General Criteria
 - At-rest Horizontal Pressure = 80 pcf (2 to 1 sloping backfill, above groundwater)
 - At-Rest Vertical Pressure = 40 pcf (2 to 1 sloping backfill, above groundwater)
 - Allowable Bearing Capacity = 1,700 psf + 8 x (overburden pressure); where overburden pressure equals 100 pcf x H
For H = 0' to 5'; heq = 4'-0"
For H = 5' to 20'; heq = 3'-0"
 - Live Load Surcharge (Equivalent Height of Soil)
- Exposure Factor (For Crack Control) = 1.0 for Class 1 exposure
- See T63 for additional notes

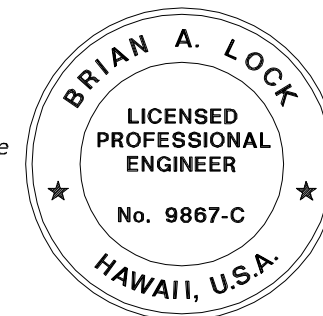

THIS WORK WAS PREPARED BY ME
OR UNDER MY SUPERVISION.

WILSON OKAMOTO CORPORATION
APRIL 30, 2020
LIC. EXP. DATE

U.S. DEPARTMENT OF TRANSPORTATION
FEDERAL HIGHWAY ADMINISTRATION
CENTRAL FEDERAL LANDS HIGHWAY DIVISION

U.S. CUSTOMARY SPECIAL

DRAINAGE DETAILS

SPECIAL

NO SCALE

DRAWING NO.:

