

THIS WORK WAS PREPARED BY ME
OR UNDER MY SUPERVISION.

WILSON OKAMOTO CORPORATION
APRIL 30, 2020
LIC. EXP. DATE



RETENTION BASIN A STORAGE CAPACITY	
Required Volume	2389 CY
Design Volume	3690 CY

SECTION A-A
Not to Scale


U.S. DEPARTMENT OF TRANSPORTATION
FEDERAL HIGHWAY ADMINISTRATION
CENTRAL FEDERAL LANDS HIGHWAY DIVISION

U.S. CUSTOMARY

**BASIN DRAINAGE
PLAN**

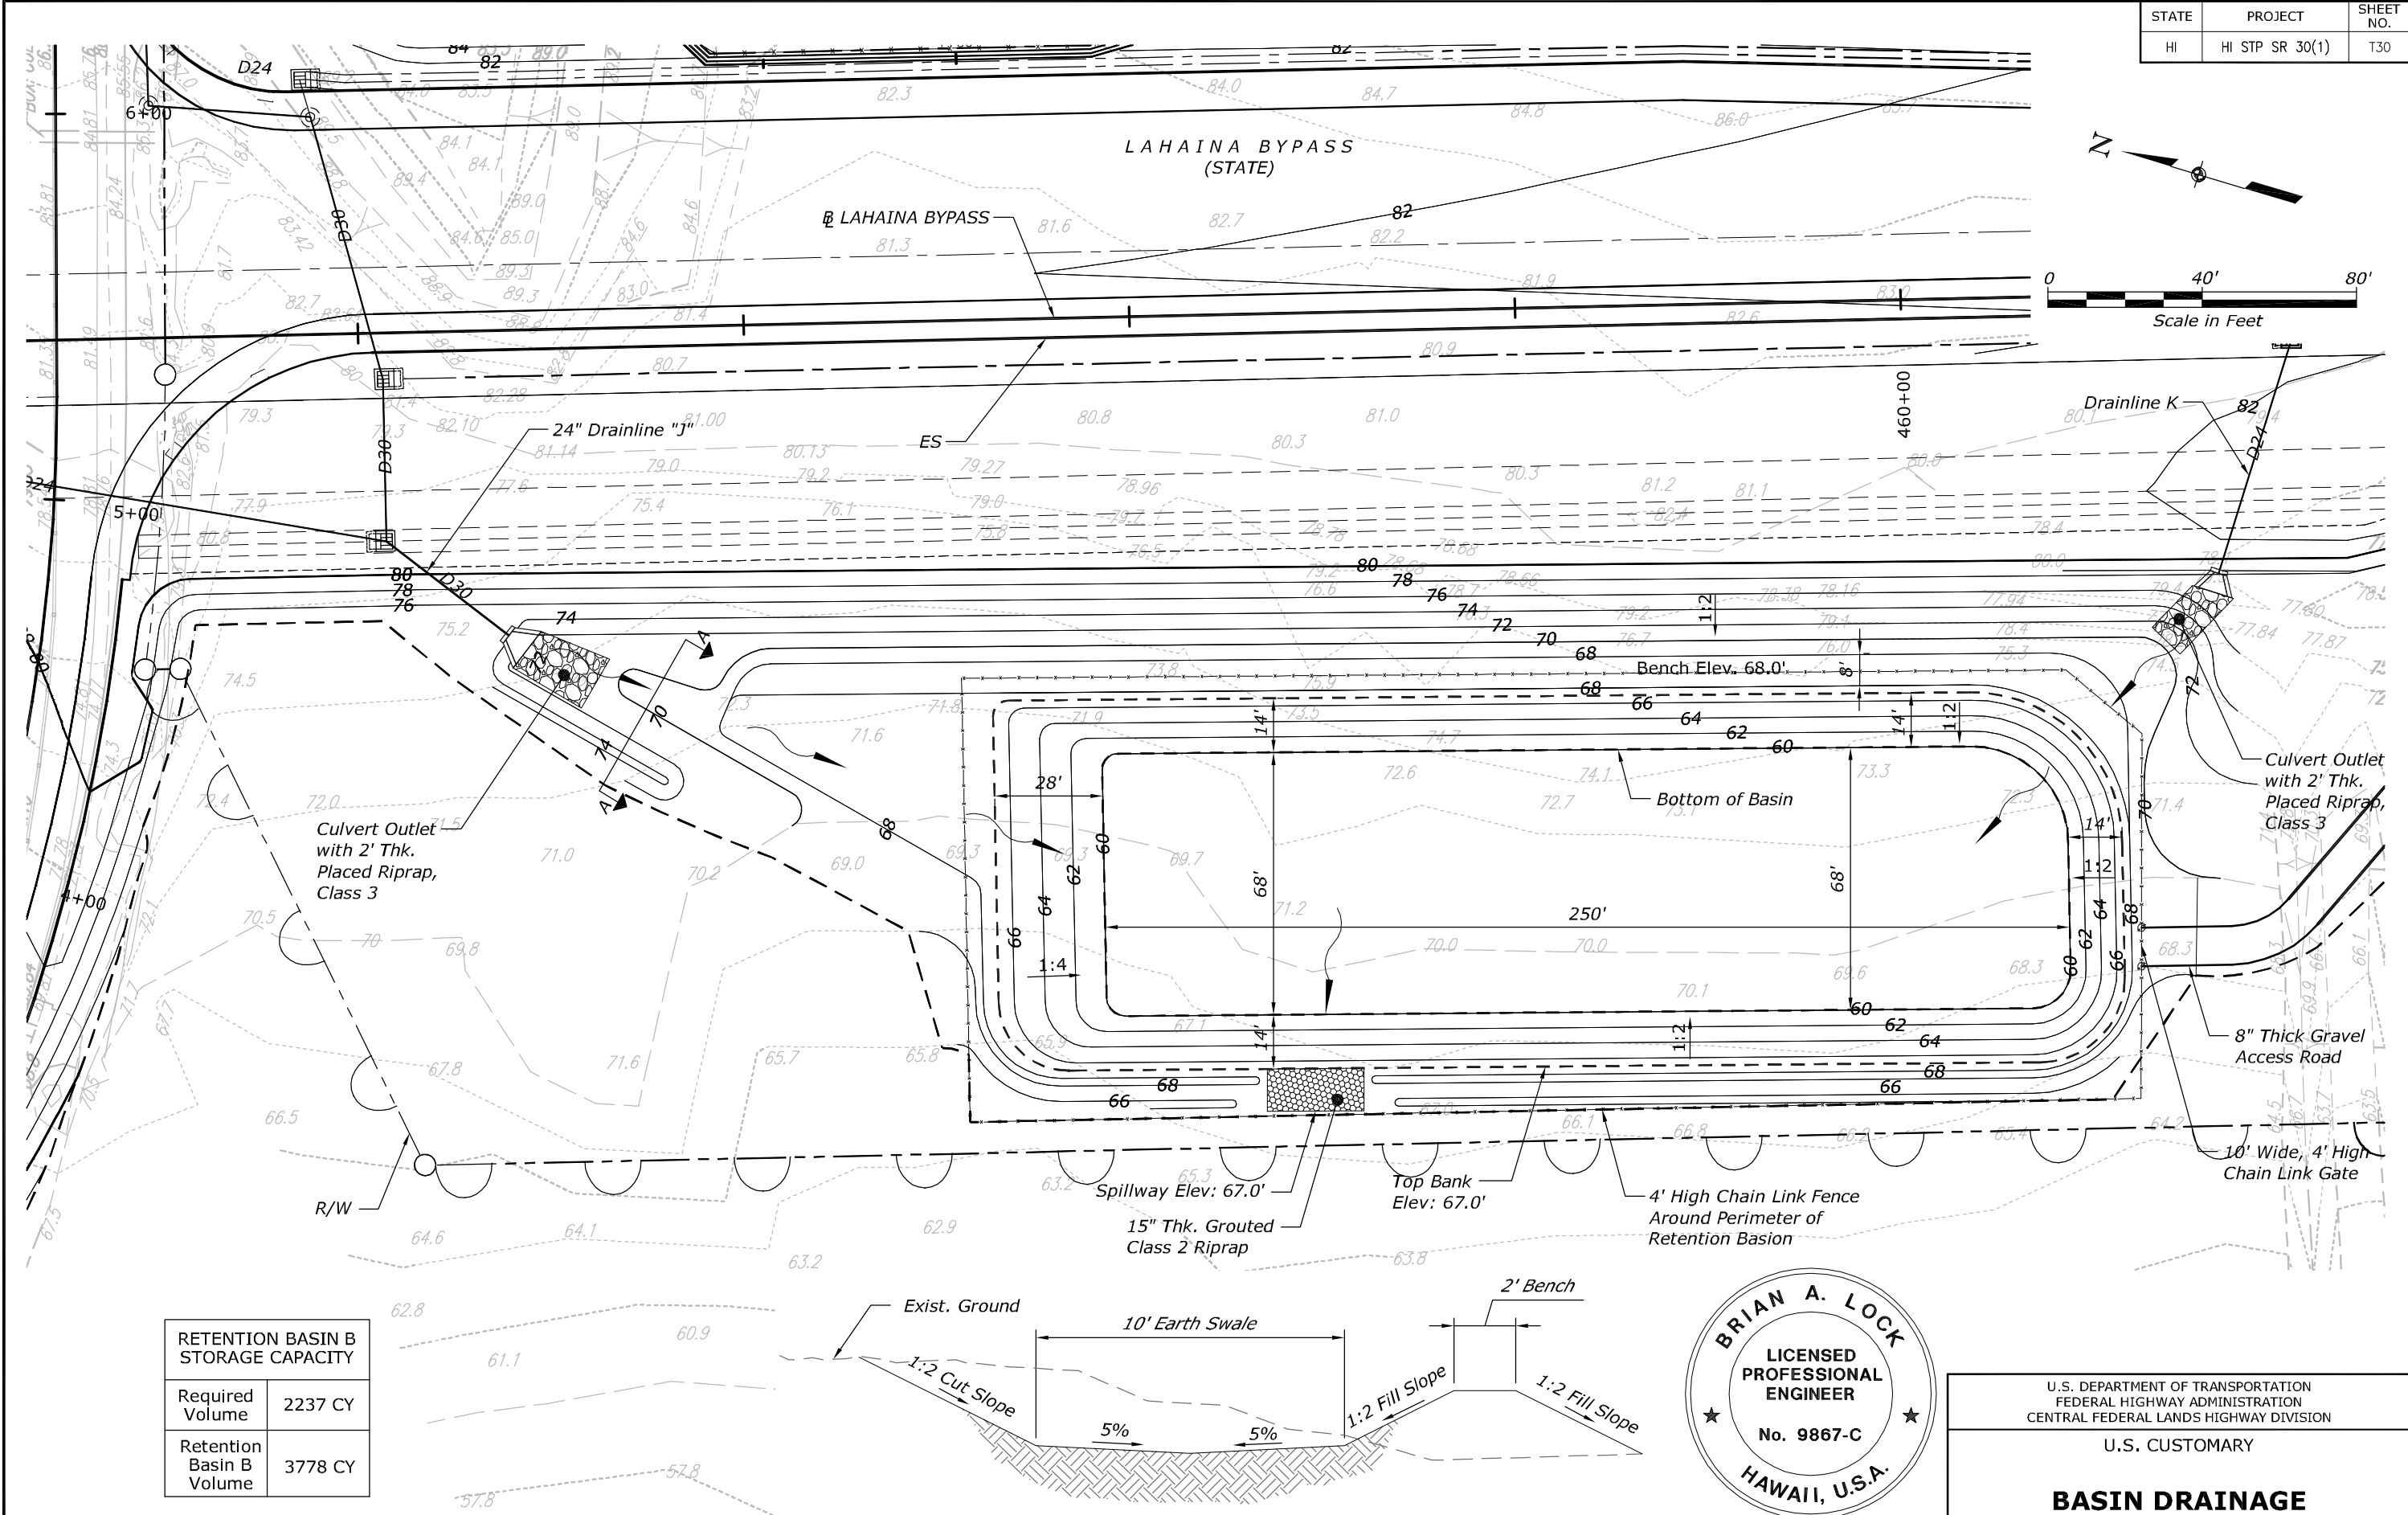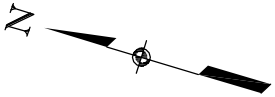

RETENTION BASIN B STORAGE CAPACITY	
Required Volume	2237 CY
Retention Basin B Volume	3778 CY

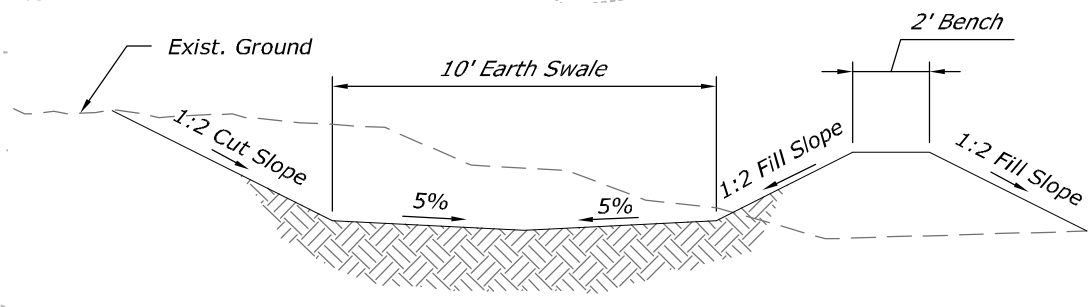

SECTION A-A
Not to Scale





THIS WORK WAS PREPARED BY ME
OR UNDER MY SUPERVISION.
WILSON OKAMOTO CORPORATION
APRIL 30, 2020
LIC. EXP. DATE


U.S. DEPARTMENT OF TRANSPORTATION
FEDERAL HIGHWAY ADMINISTRATION
CENTRAL FEDERAL LANDS HIGHWAY DIVISION

U.S. CUSTOMARY

BASIN DRAINAGE
PLAN

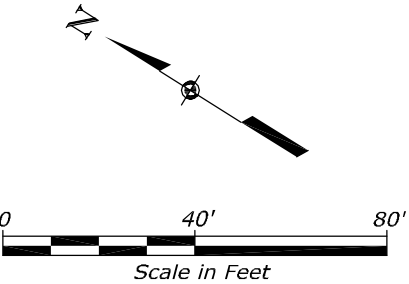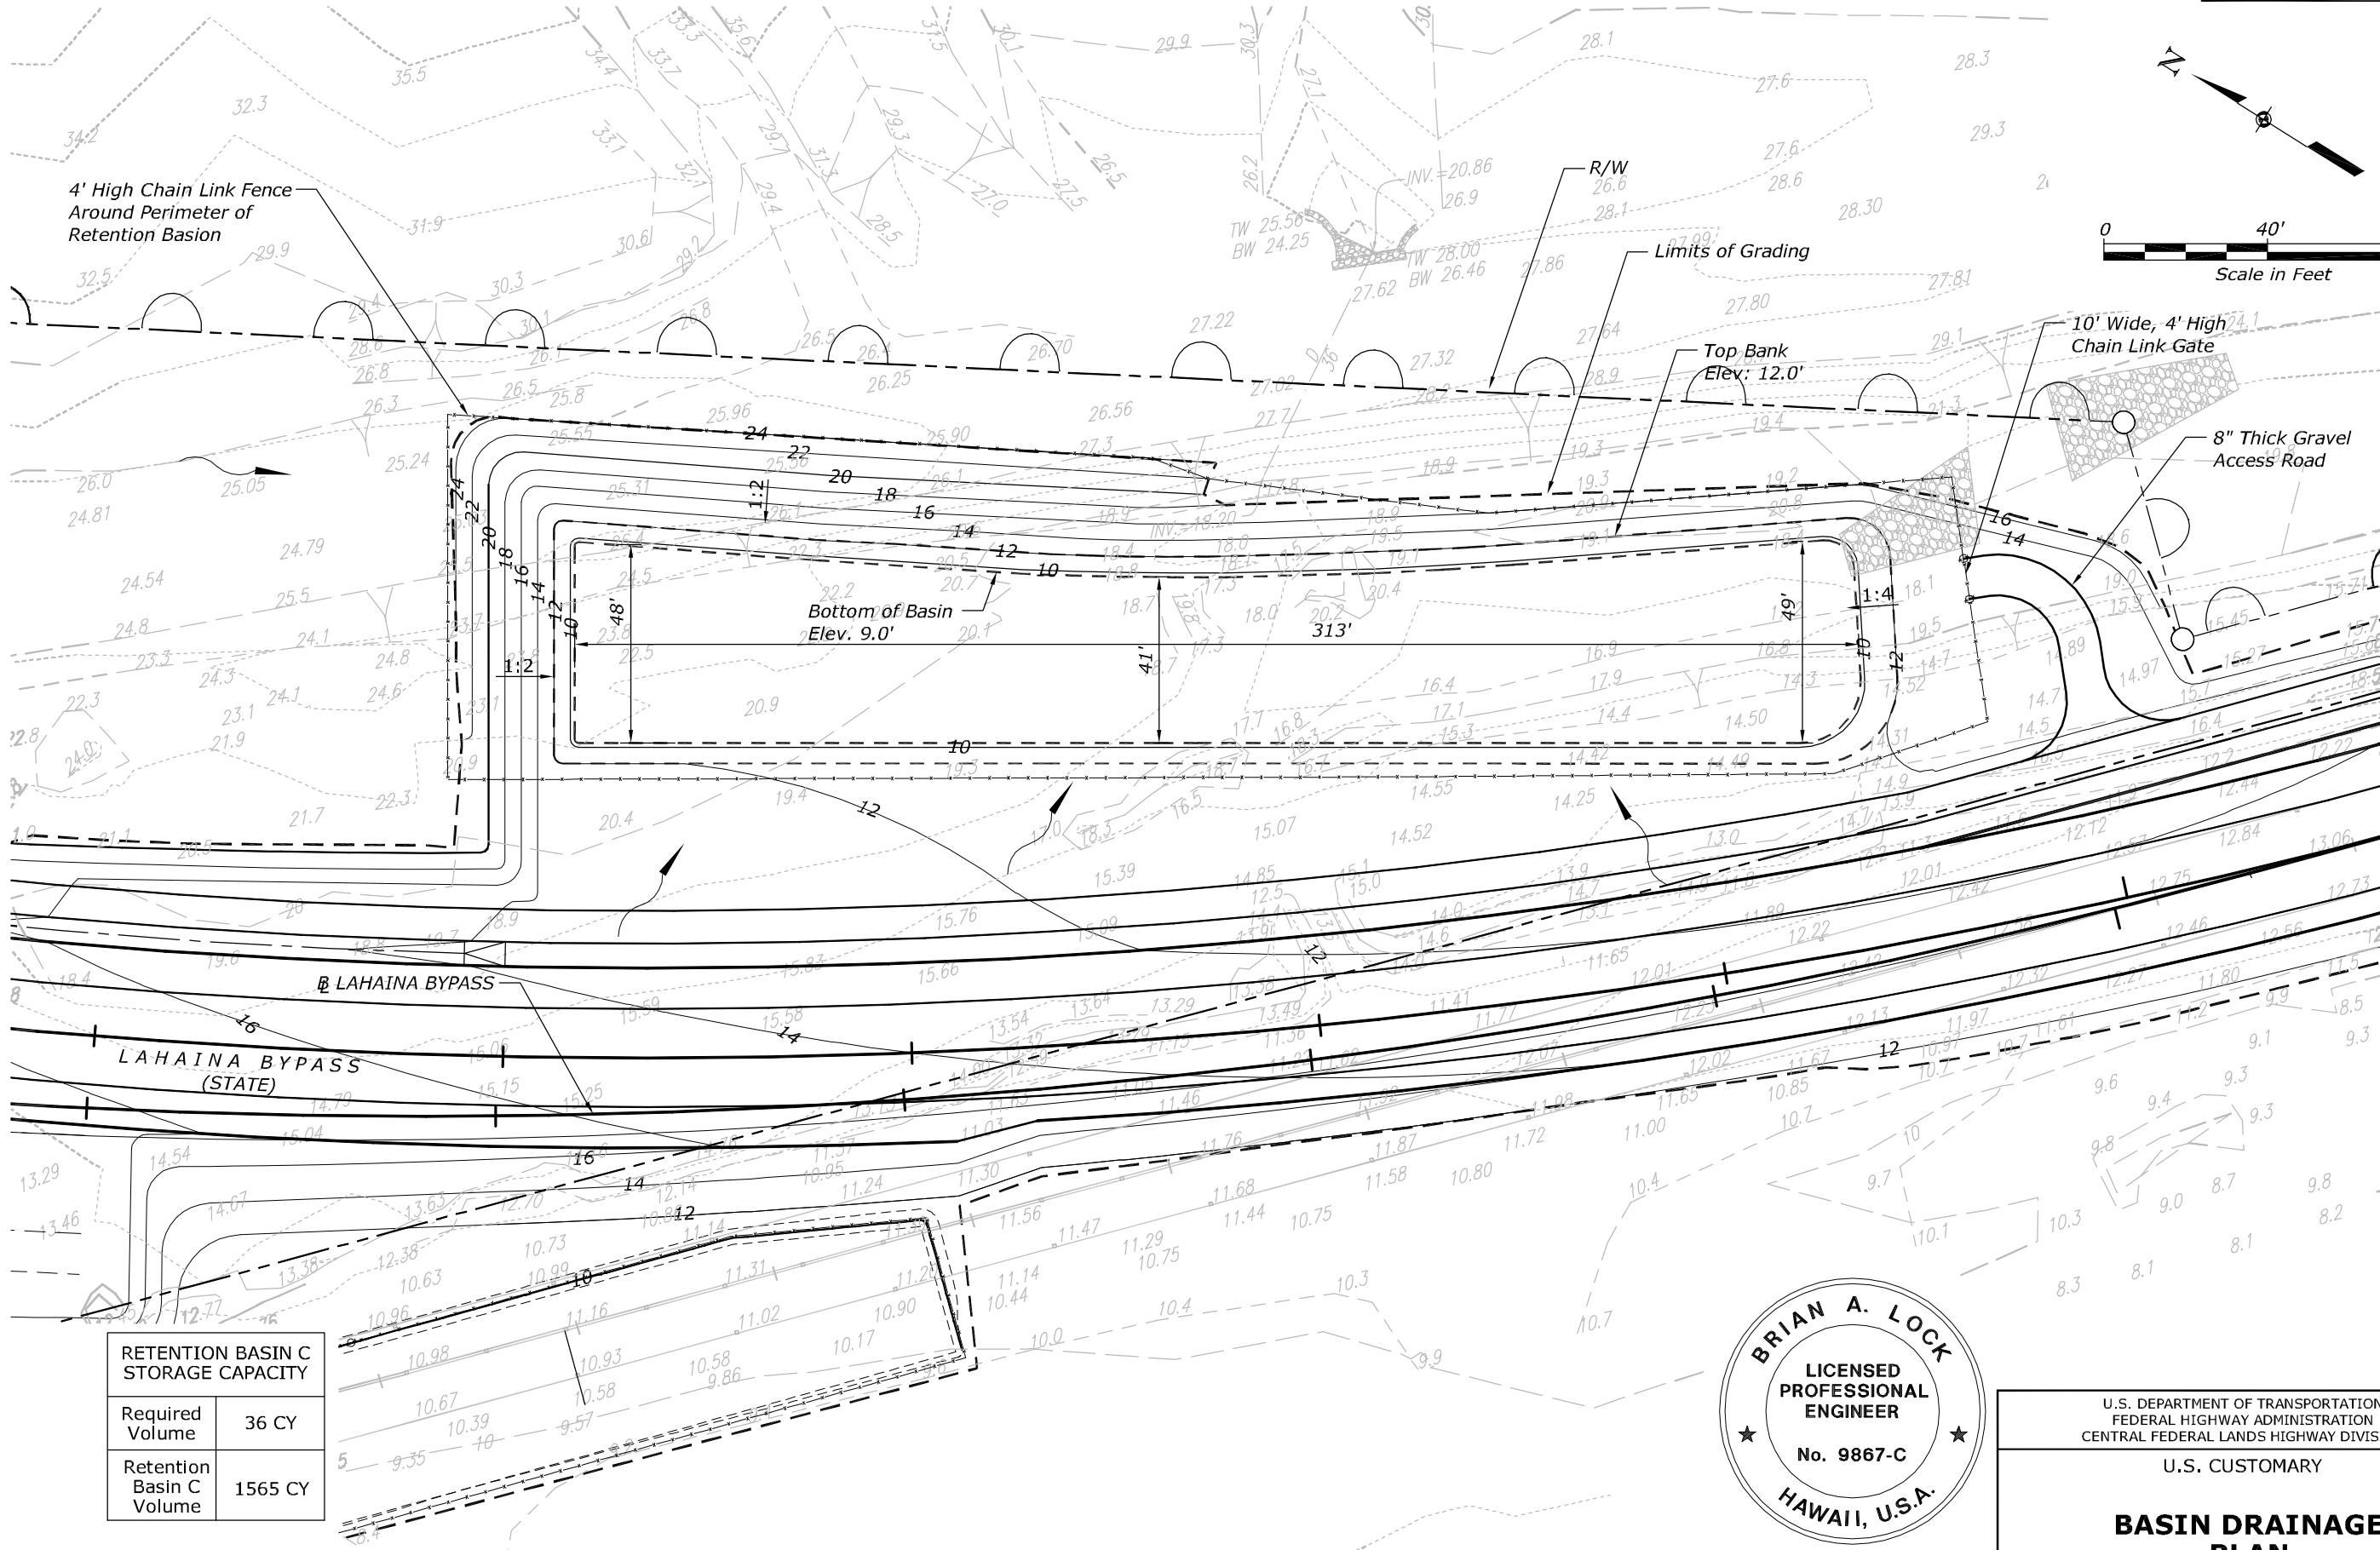

RETENTION BASIN C STORAGE CAPACITY	
Required Volume	36 CY
Retention Basin C Volume	1565 CY

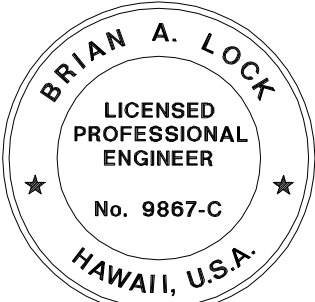

U.S. DEPARTMENT OF TRANSPORTATION
FEDERAL HIGHWAY ADMINISTRATION
CENTRAL FEDERAL LANDS HIGHWAY DIVISION

U.S. CUSTOMARY

BASIN DRAINAGE PLAN

THIS WORK WAS PREPARED BY ME OR UNDER MY SUPERVISION.

WILSON OKAMOTO CORPORATION APRIL 30, 2020
LIC. EXP. DATE