

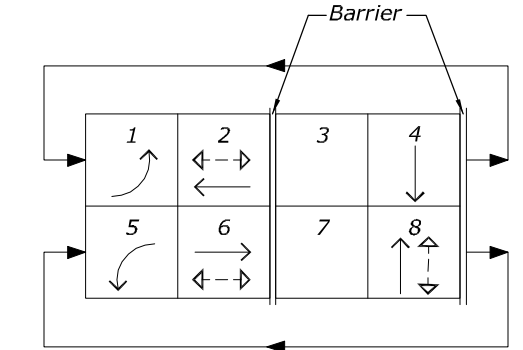


CONDUIT AND CABLE SCHEDULE					
Δ	CONDUIT	CABLE	Δ	CONDUIT	CABLE
1	2-2"	2-26C#14	6	2-2"	2-26C#14
	1-2"	6-2C#14		1-2"	1-2C#14
	2-2"	2-Opticom		1-2"	Spare
2	1-2"	1-2C#14	7	1-2"	3-2C#14
3	2-2"	2-26C#14	8	2-2"	2-26C#14
	1-2"	3-2C#14		1-2"	3-2C#14
	2-2"	2-Opticom		1-2"	Spare
4	2-2"	2-26C#14	9	2-2"	2-26C#14
	1-2"	2-2C#14		1-2"	3-2C#14
	2-2"	2-Opticom		1-2"	1-Opticom
5	2-2"	2-26C#14	10	2-2"	2-26C#14
	1-2"	2-2C#14		1-2"	5-2C#14
	1-2"	1-Opticom		2-2"	2-Opticom

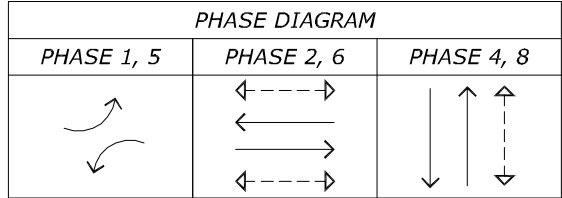


PHASE ASSIGNMENT DIAGRAM

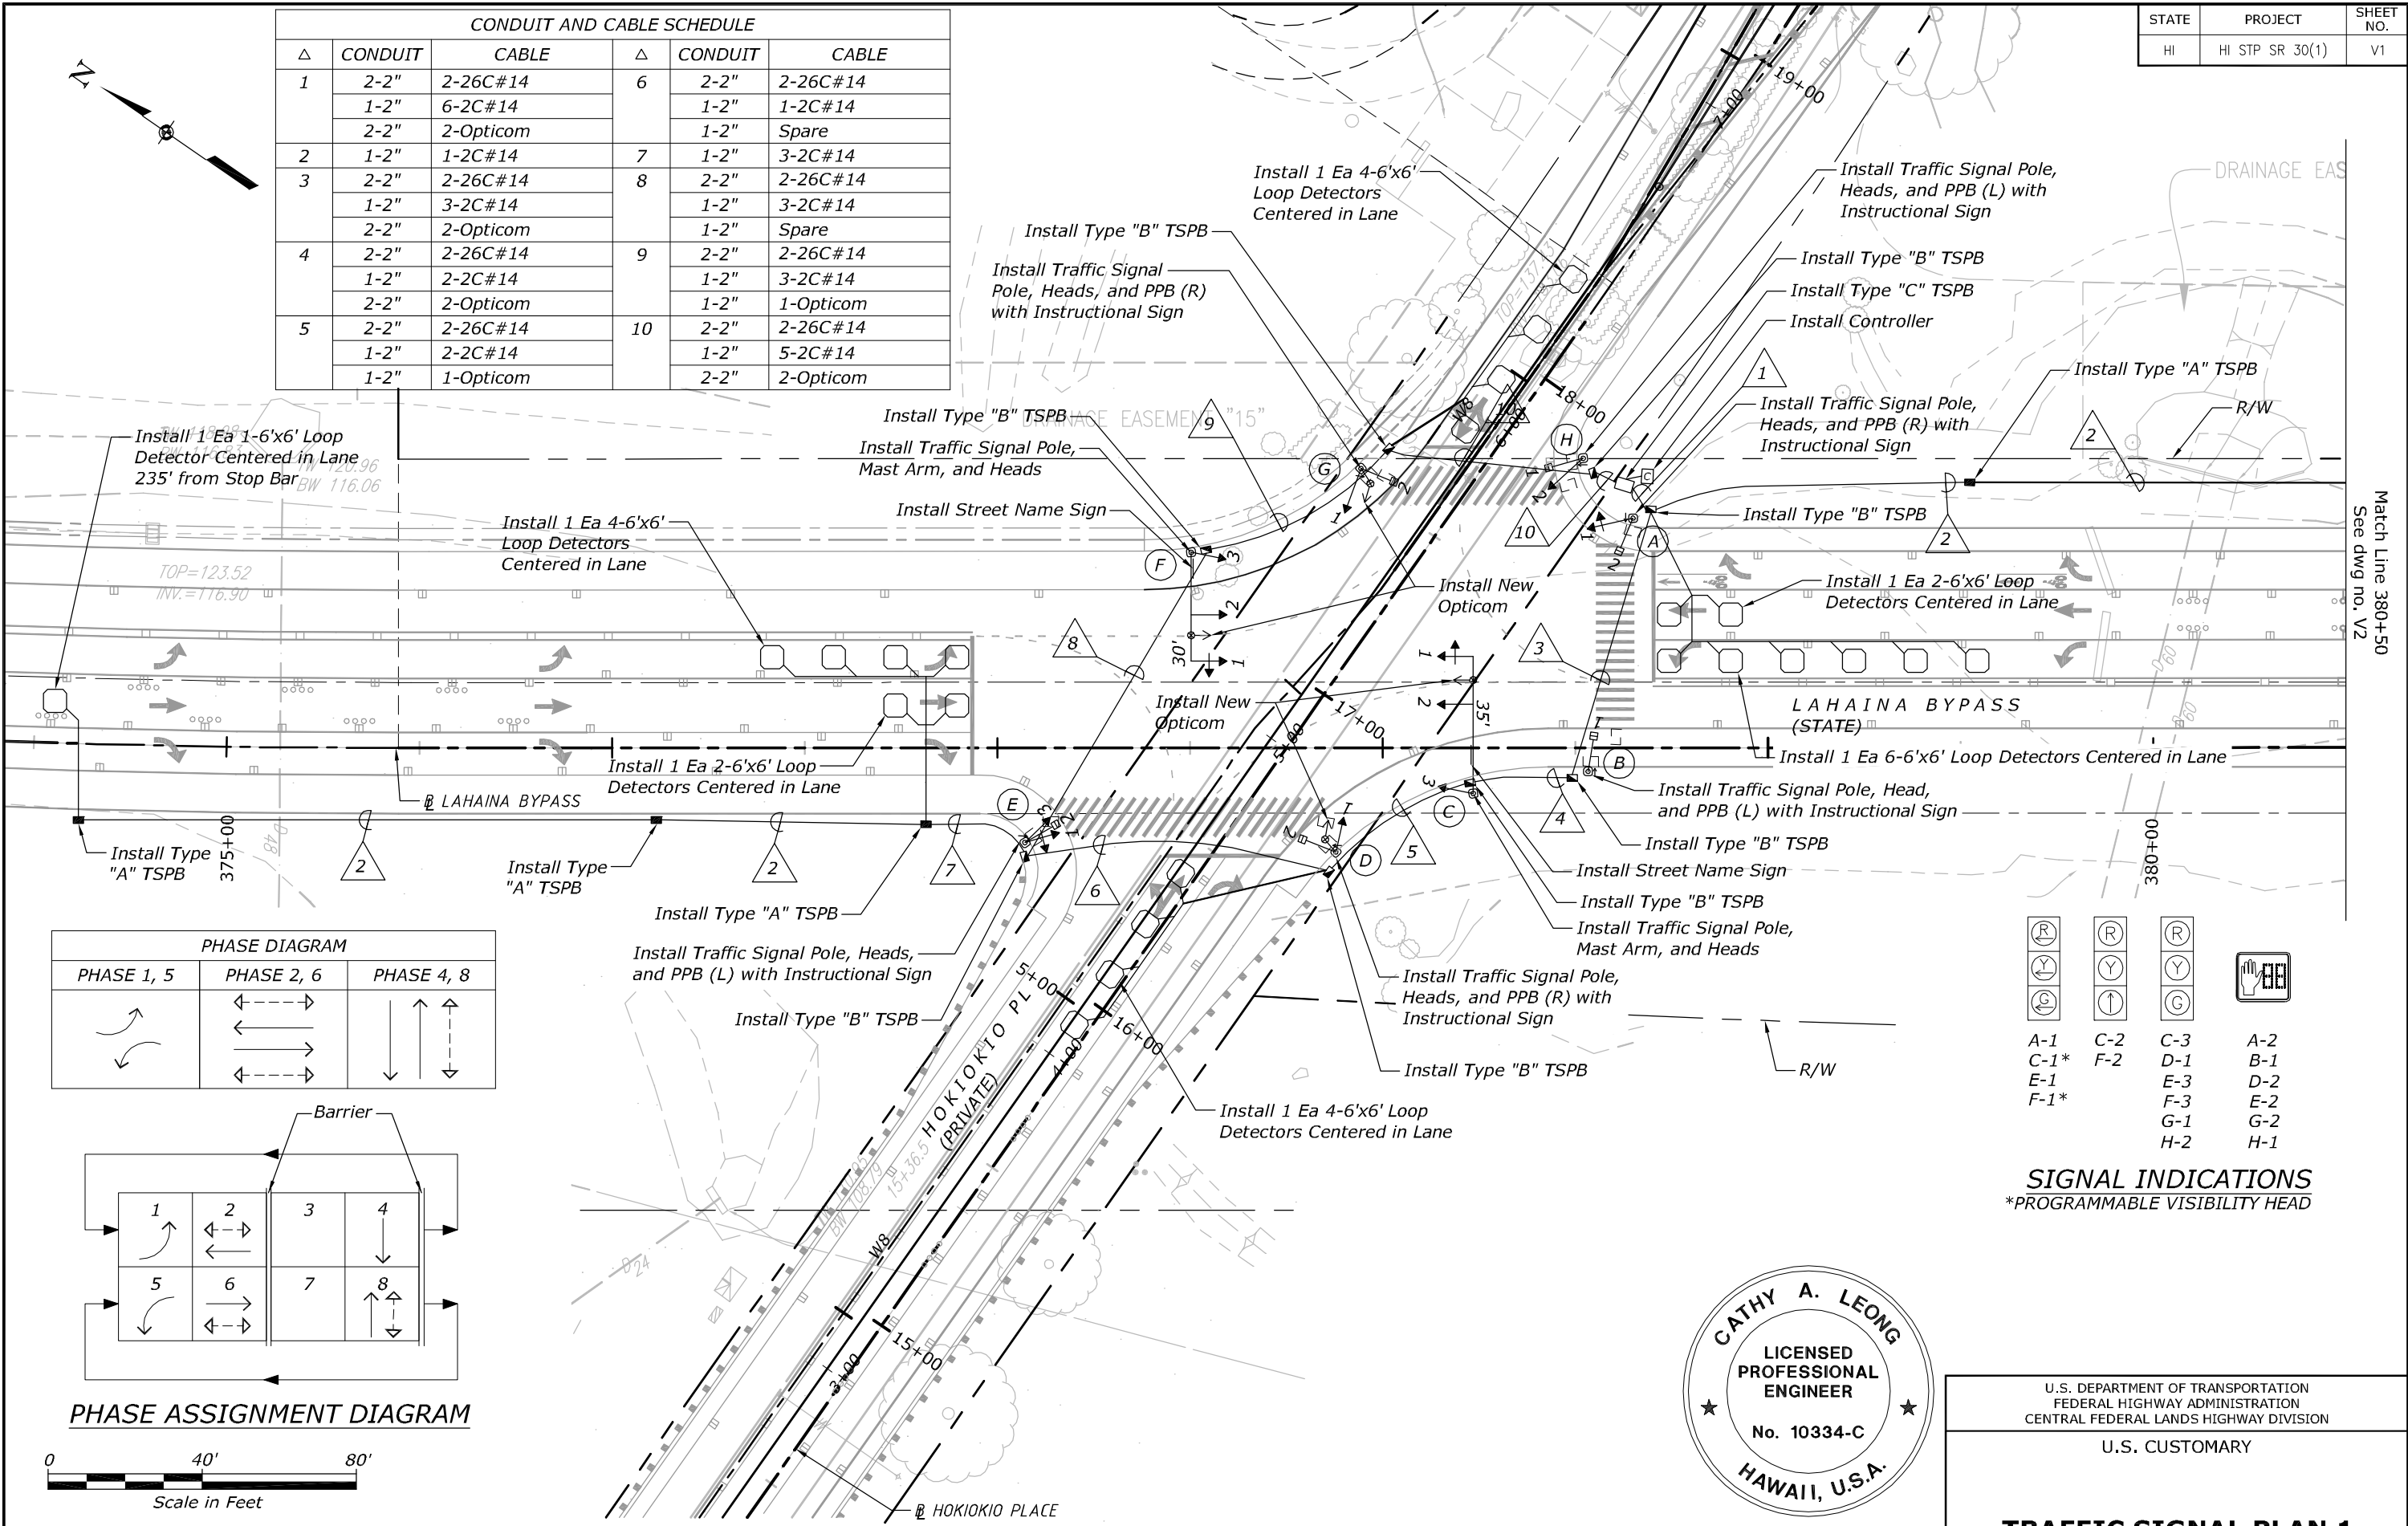

A-1	C-2	C-3	A-2
C-1*	F-2	D-1	B-1
E-1		E-3	D-2
F-1*		F-3	E-2
		G-1	G-2
		H-2	H-1

SIGNAL INDICATIONS  
\*PROGRAMMABLE VISIBILITY HEAD

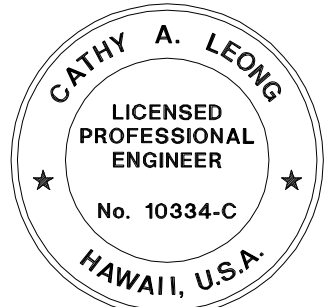

U.S. DEPARTMENT OF TRANSPORTATION  
FEDERAL HIGHWAY ADMINISTRATION  
CENTRAL FEDERAL LANDS HIGHWAY DIVISION


U.S. CUSTOMARY

TRAFFIC SIGNAL PLAN 1



THIS WORK WAS PREPARED BY ME  
OR UNDER MY SUPERVISION.  
WILSON OKAMOTO CORPORATION  
APRIL 30, 2020  
LIC. EXP. DATE

STATE	PROJECT	SHEET NO.
HI	HI STP SR 30(1)	V2


CONDUIT AND CABLE SCHEDULE		
Δ	CONDUIT	CABLE
2	1-2"	1-2C#14

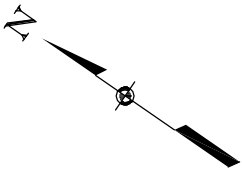

TMK: 4-7-03: 27

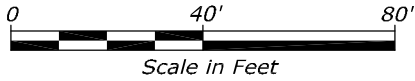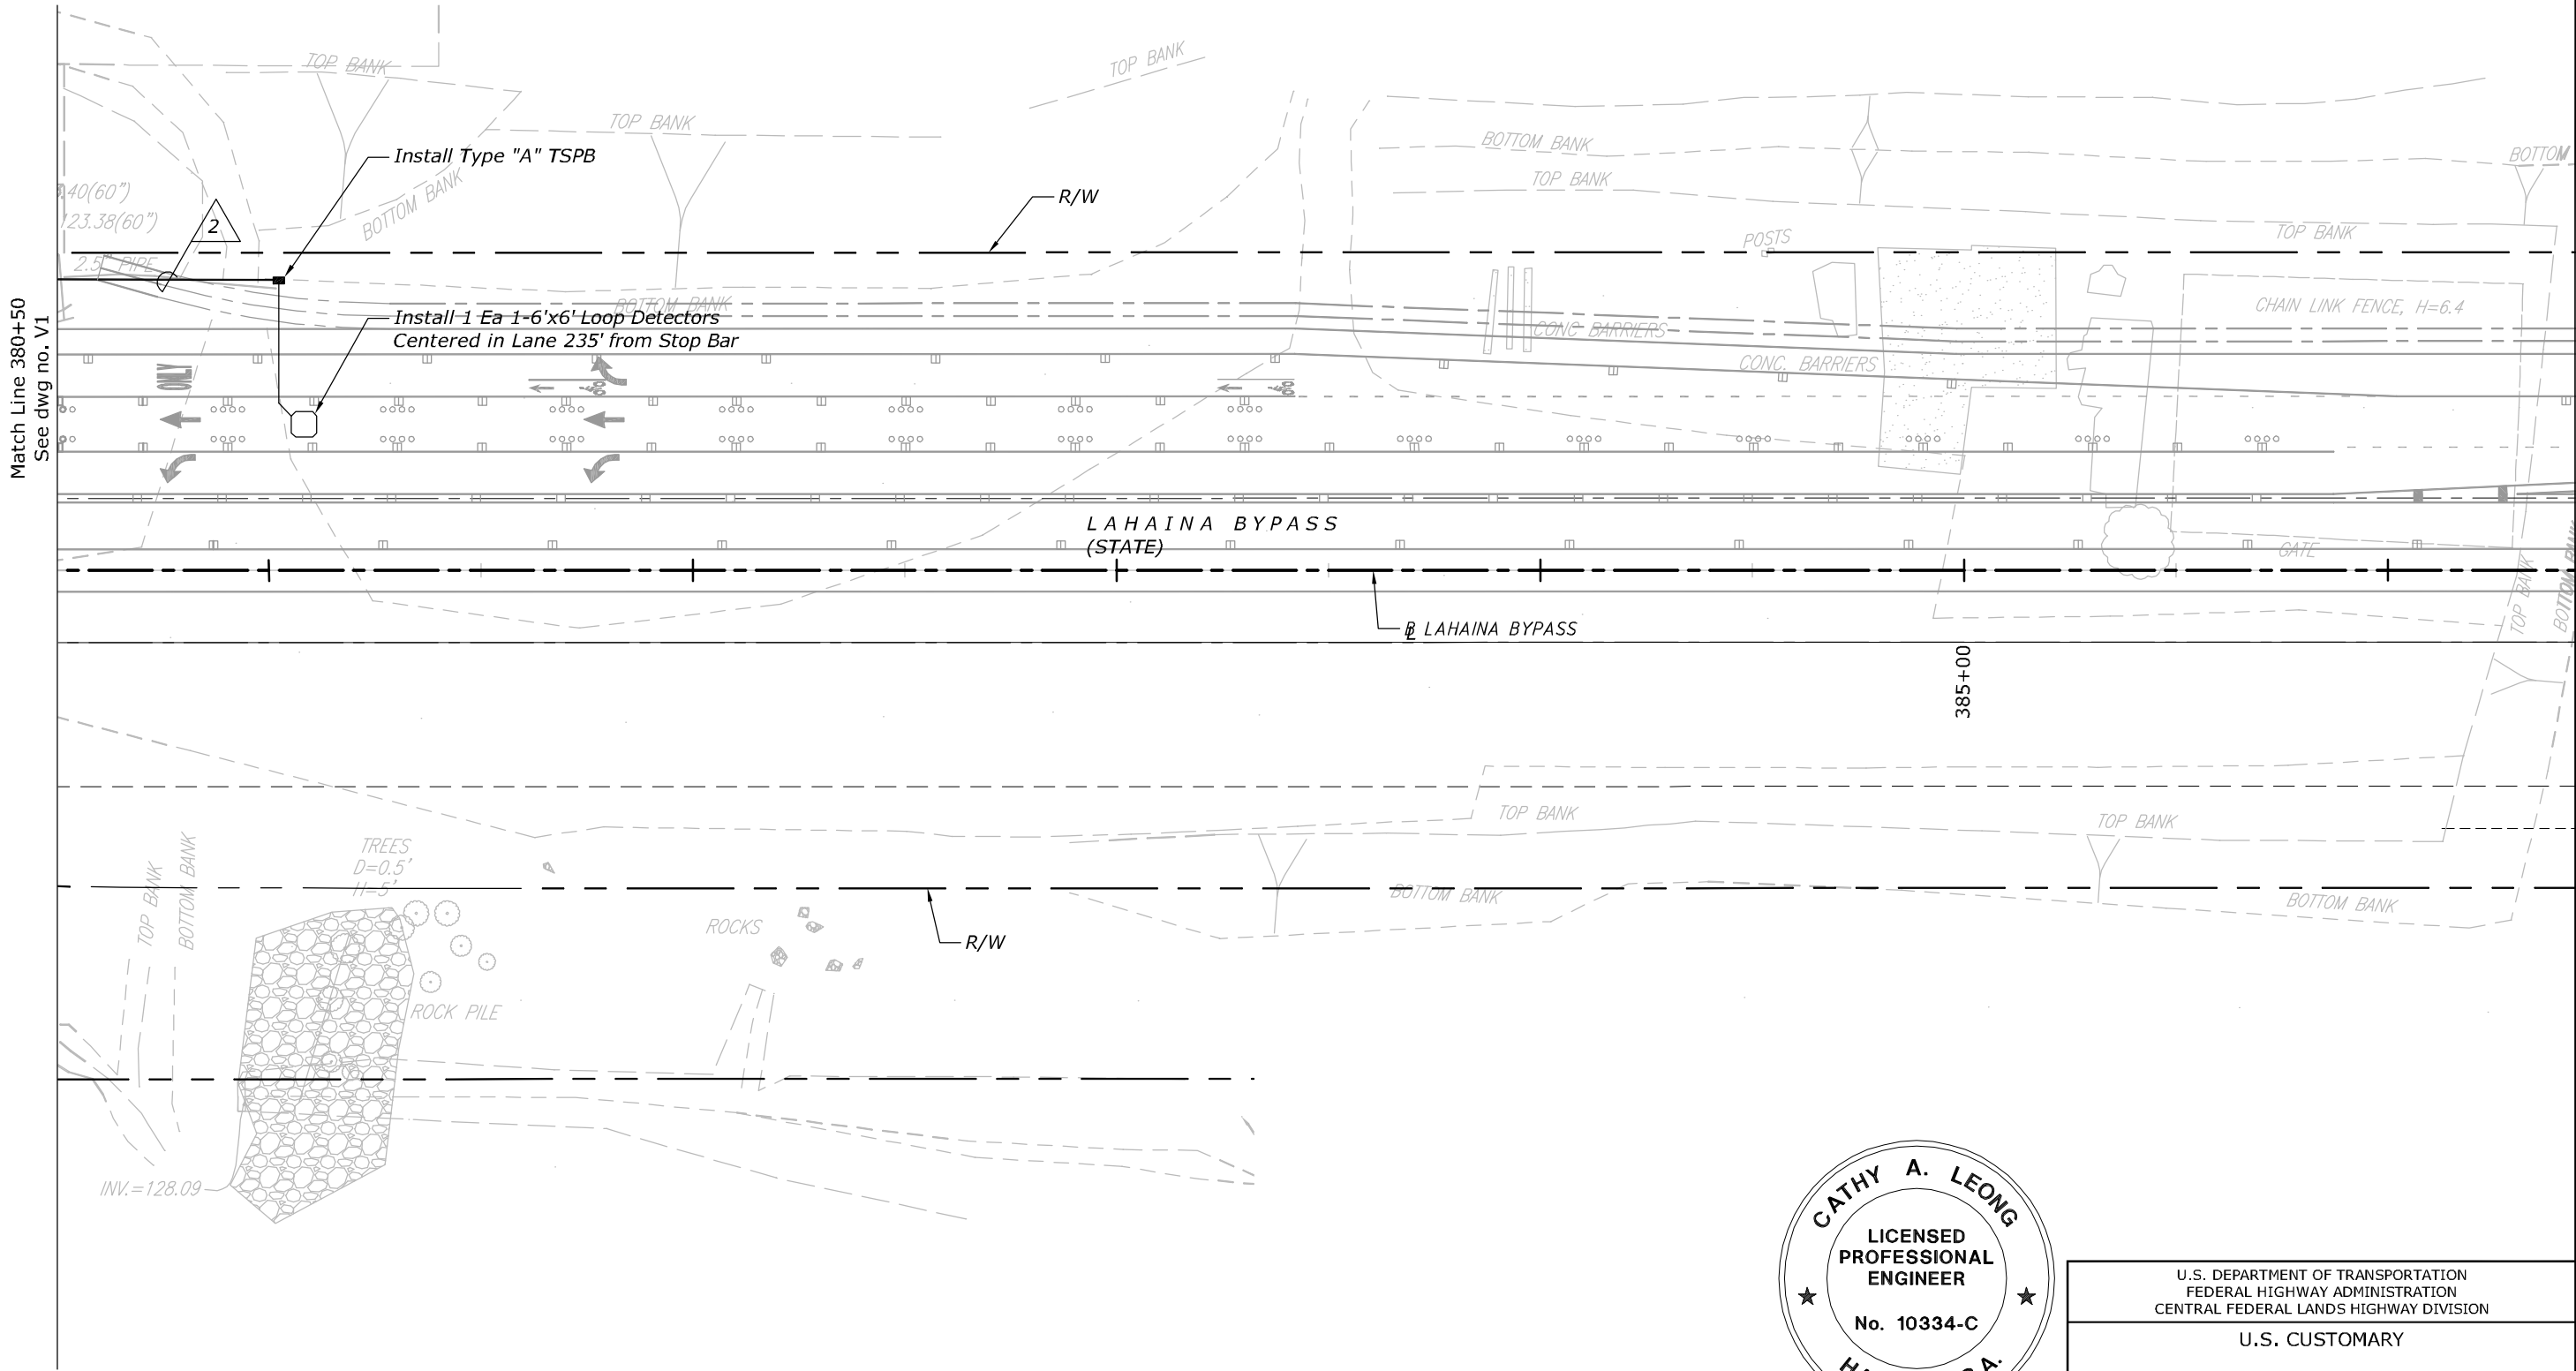

TMK: 4-7-03: 28

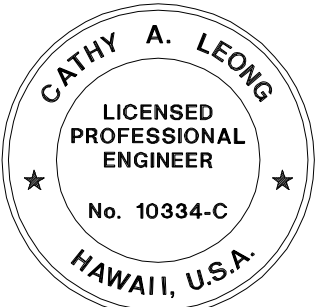




THIS WORK WAS PREPARED BY ME  
OR UNDER MY SUPERVISION.  
WILSON OKAMOTO CORPORATION  
APRIL 30, 2020  
LIC. EXP. DATE

U.S. DEPARTMENT OF TRANSPORTATION  
FEDERAL HIGHWAY ADMINISTRATION  
CENTRAL FEDERAL LANDS HIGHWAY DIVISION

U.S. CUSTOMARY

TRAFFIC SIGNAL PLAN 2


CONDUIT AND CABLE SCHEDULE					
Δ	CONDUIT	CABLE	Δ	CONDUIT	CABLE
1	2-2"	2-26C#14	7	1-2"	3-2C#14
	1-2"	6-2C#14		2-2"	2-26C#14
	2-2"	2-Opticom		1-2"	3-2C#14
2	1-2"	1-2C#14	8	1-2"	Spare
	2-2"	2-26C#14		1-2"	3-2C#14
3	2-2"	2-26C#14	9	2-2"	2-26C#14
	1-2"	3-2C#14		1-2"	3-2C#14
	2-2"	2-Opticom		1-2"	1-Opticom
4	2-2"	2-26C#14	10	2-2"	2-26C#14
	1-2"	2-2C#14		1-2"	5-2C#14
	1-2"	1-Opticom		1-2"	1-Opticom
5	2-2"	2-26C#14	11	2-2"	2-26C#14
	1-2"	1-2C#14		1-2"	5-2C#14
	1-2"	1-Opticom		2-2"	2-Opticom
6	2-2"	2-26C#14	Install Traffic Signal Pole, Heads, and PPB (R) with Instructional Sign		
	1-2"	1-2C#14			
	1-2"	Spare			

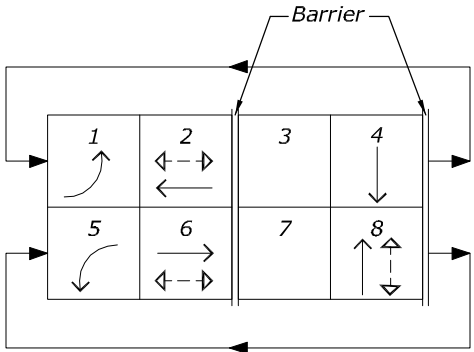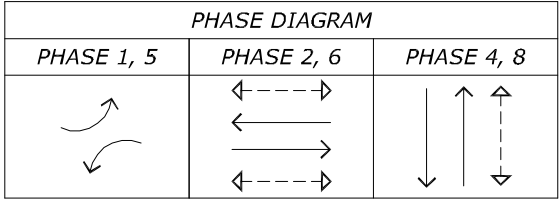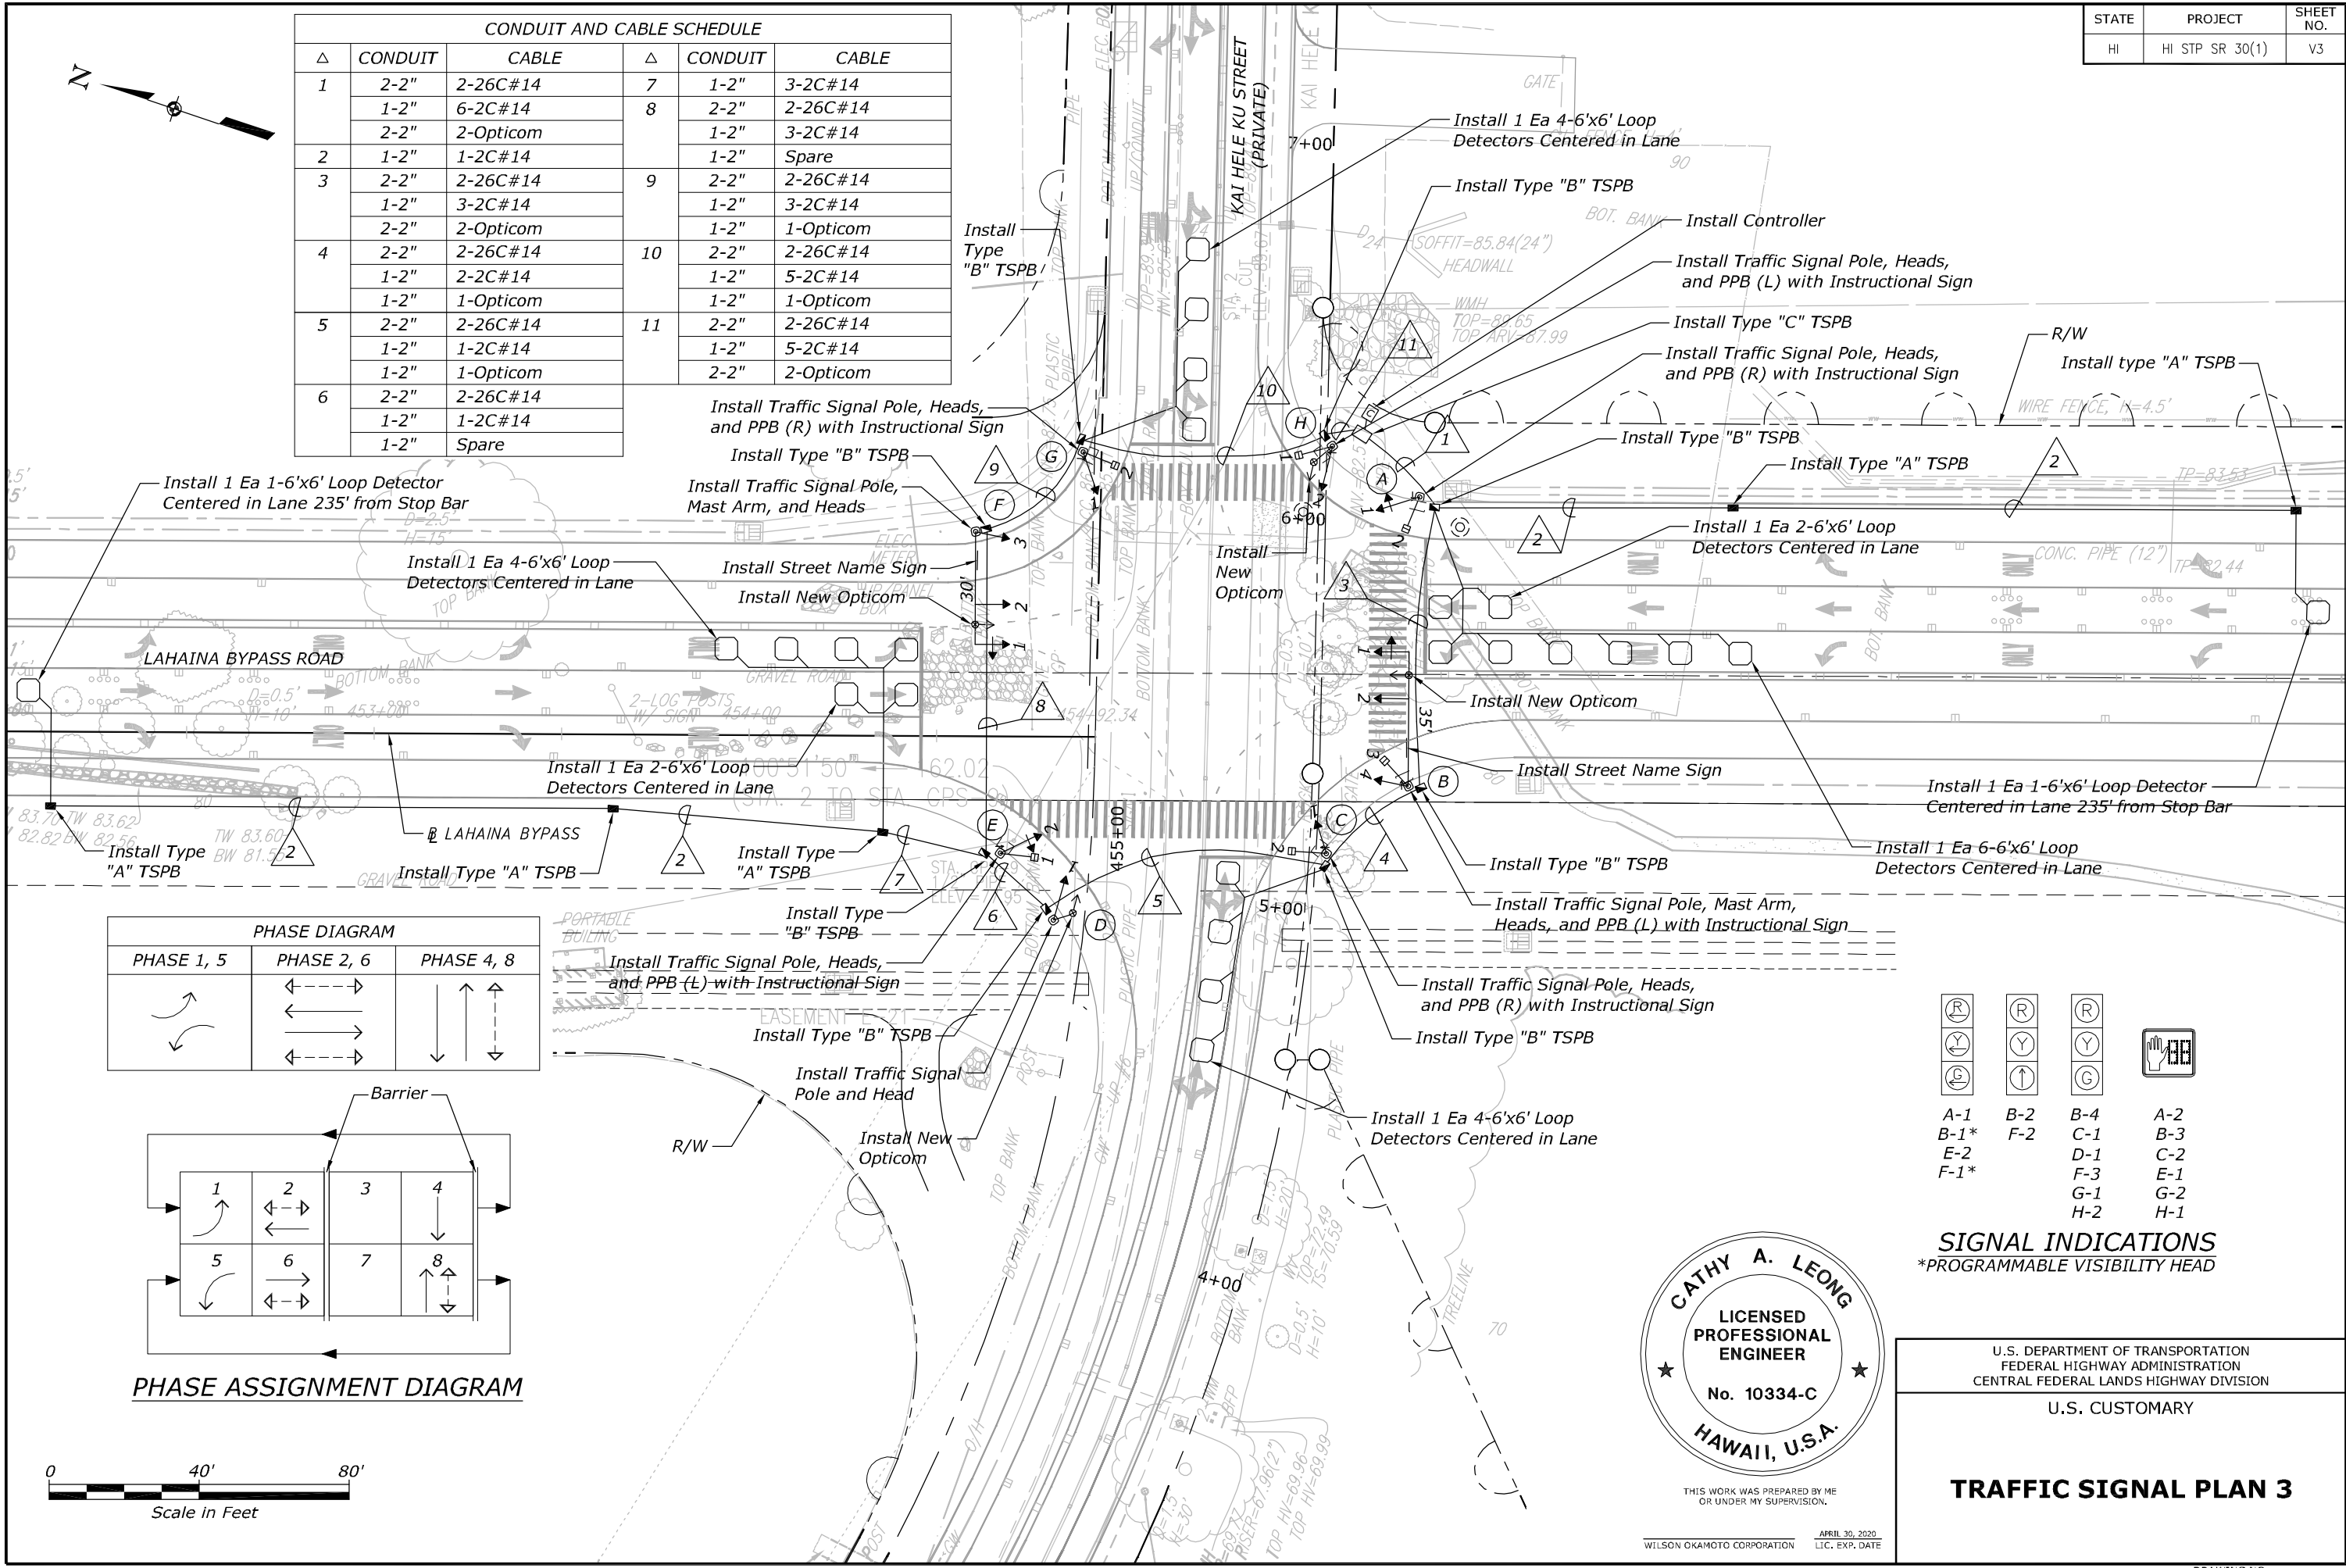

PHASE ASSIGNMENT DIAGRAM

A-1	B-2	B-4	A-2
B-1*	F-2	C-1	B-3
E-2		D-1	C-2
F-1*		F-3	E-1
		G-1	G-2
		H-2	H-1

SIGNAL INDICATIONS  
\*PROGRAMMABLE VISIBILITY HEAD

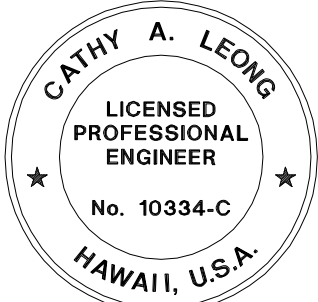

THIS WORK WAS PREPARED BY ME  
OR UNDER MY SUPERVISION.

WILSON OKAMOTO CORPORATION

APRIL 30, 2020  
LIC. EXP. DATE

U.S. DEPARTMENT OF TRANSPORTATION  
FEDERAL HIGHWAY ADMINISTRATION  
CENTRAL FEDERAL LANDS HIGHWAY DIVISION

U.S. CUSTOMARY

TRAFFIC SIGNAL PLAN 3