



STATE	PROJECT	SHEET NO.
HI	HI STP SR 30(1)	A7

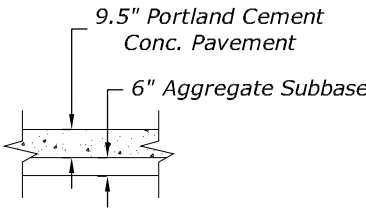


PCC PAVEMENT SECTION

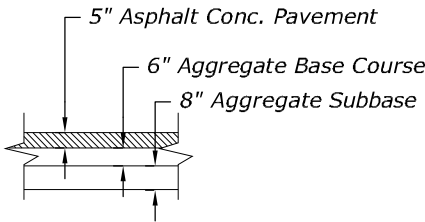


AC PAVEMENT SECTION

NOTES:
1. AC Pavement Section differs for Side Roads (Hokiokio Pl., Punakea Loop, Kai Hele Ku Street), See Typical Sections.

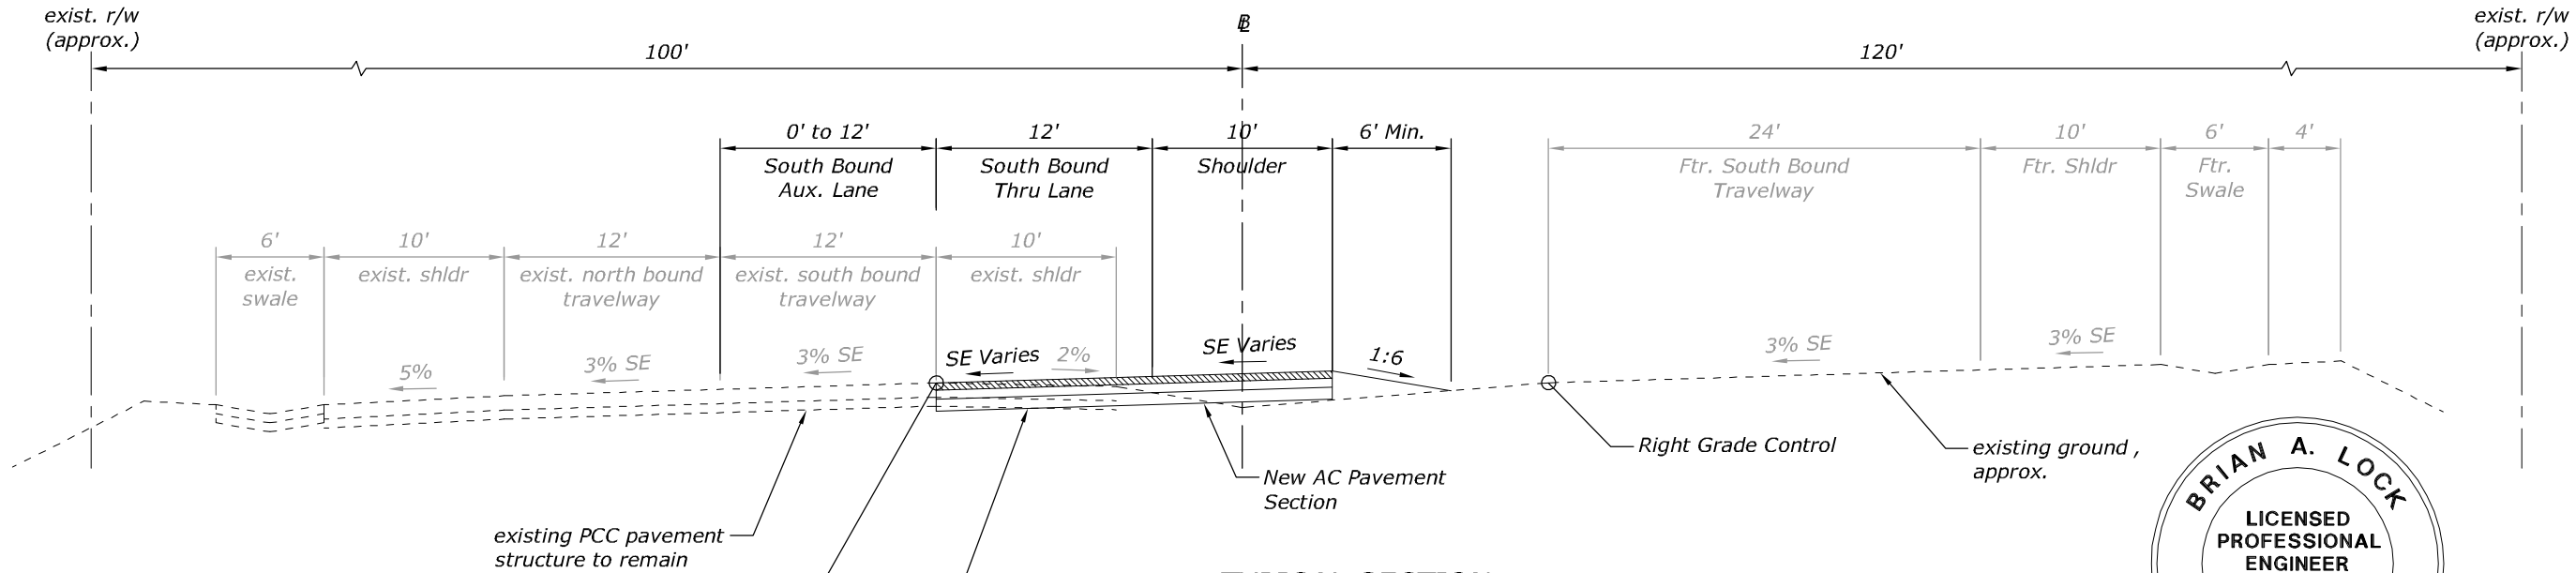


NOTES:
1. Left Grade Control Elevations Equal Right Grade Control Elevations.
2. Existing ground previously graded to approximate finish grade.

TYPICAL SECTION
365+52.30 to 370+98.67 LAHAINA BYPASS

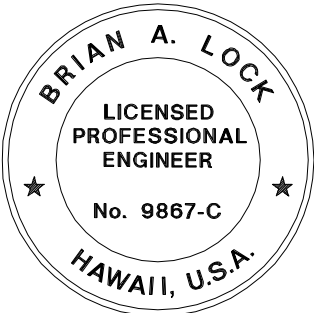


THIS WORK WAS PREPARED BY ME OR UNDER MY SUPERVISION.

WILSON OKAMOTO CORPORATION APRIL 30, 2020
LIC. EXP. DATE

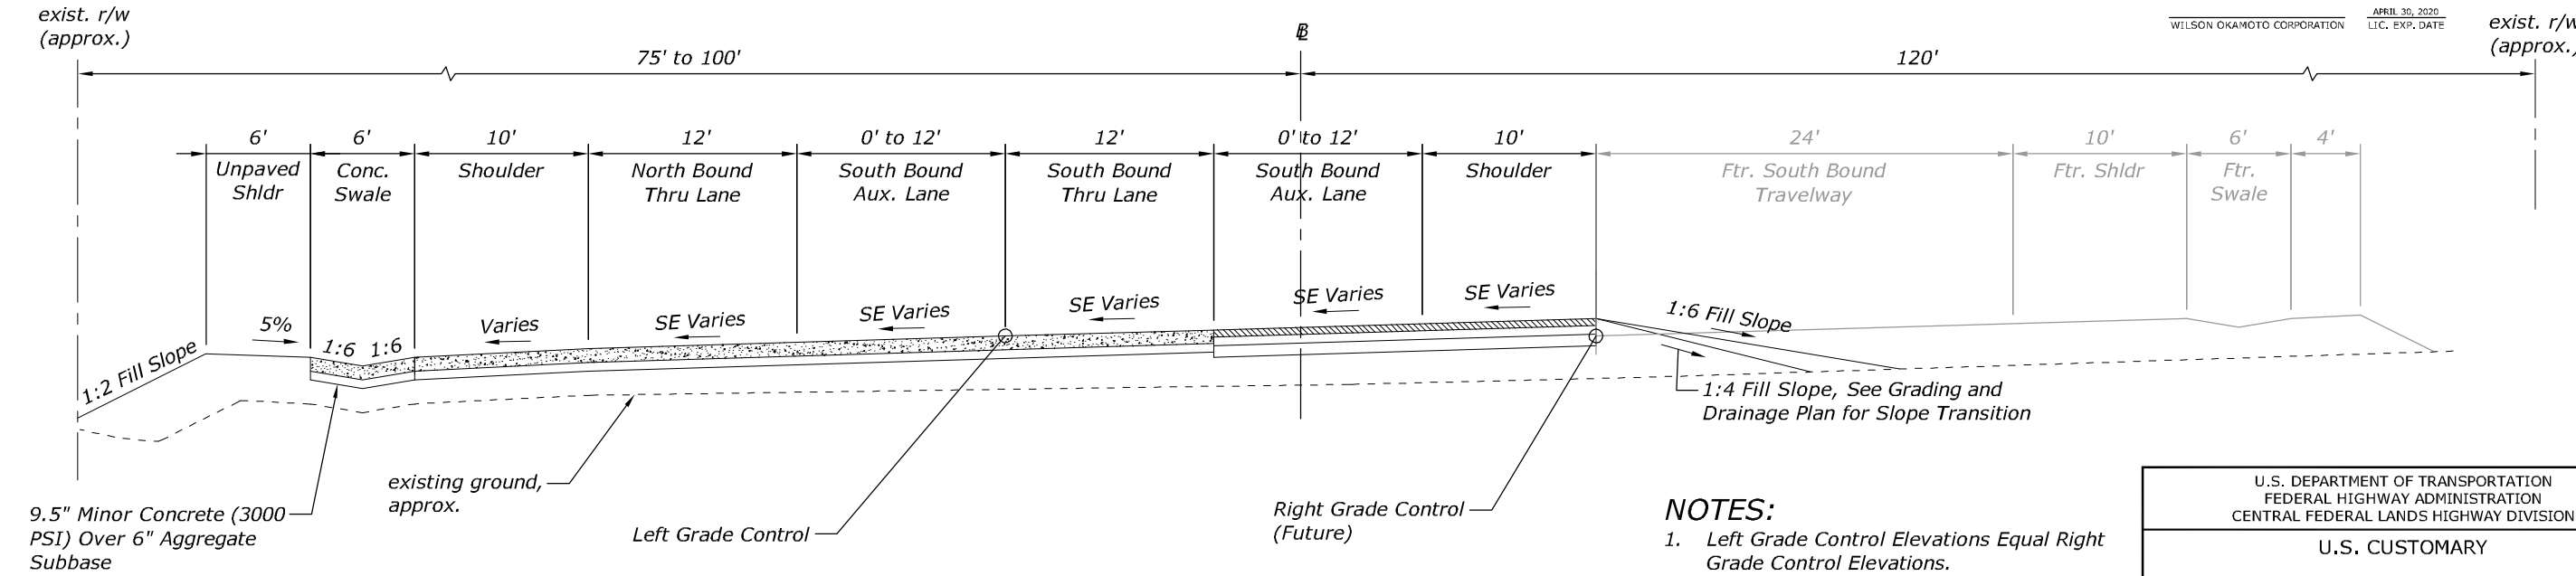

NOTES:
1. Left Grade Control Elevations Equal Right Grade Control Elevations.
2. See Drainage Details for Concrete Swale Detail

TYPICAL SECTION
370+98.67 to 377+87 LAHAINA BYPASS

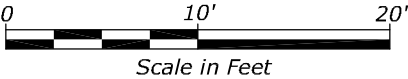


U.S. DEPARTMENT OF TRANSPORTATION
FEDERAL HIGHWAY ADMINISTRATION
CENTRAL FEDERAL LANDS HIGHWAY DIVISION


U.S. CUSTOMARY

TYPICAL SECTIONS


STATE	PROJECT	SHEET NO.
HI	HI STP SR 30(1)	A9

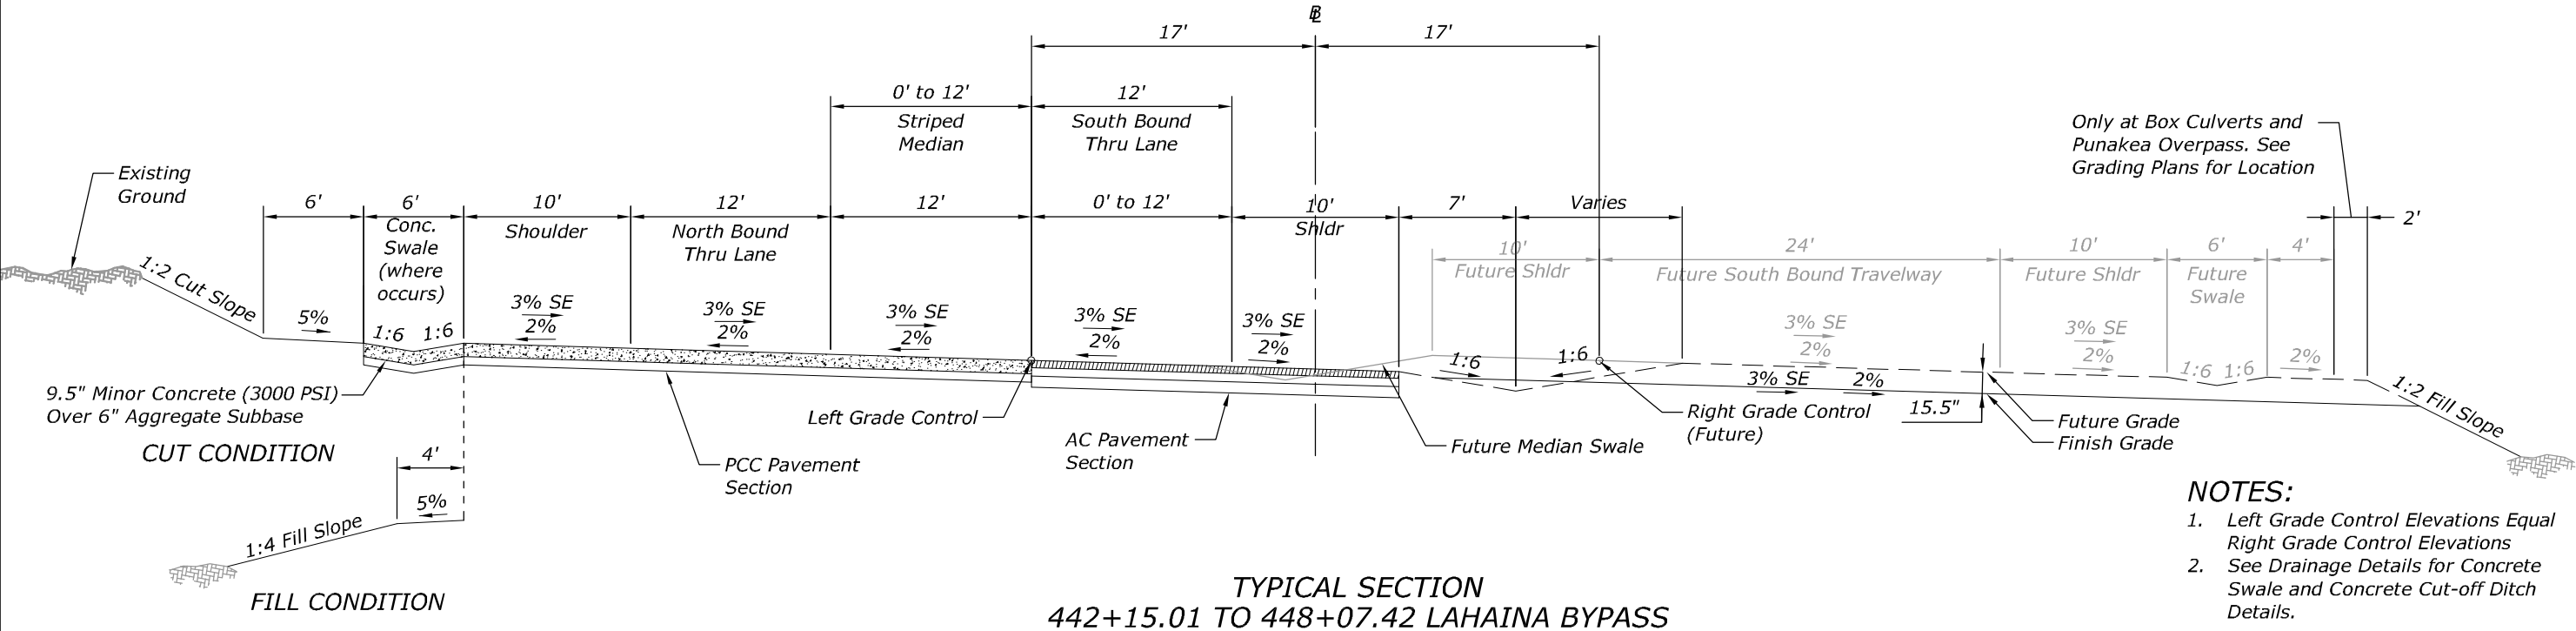

- NOTES:**
1. Left Grade Control Elevations Equal Right Grade Control Elevations
 2. See Drainage Details for Concrete Swale and Concrete Cut-off Ditch Details.

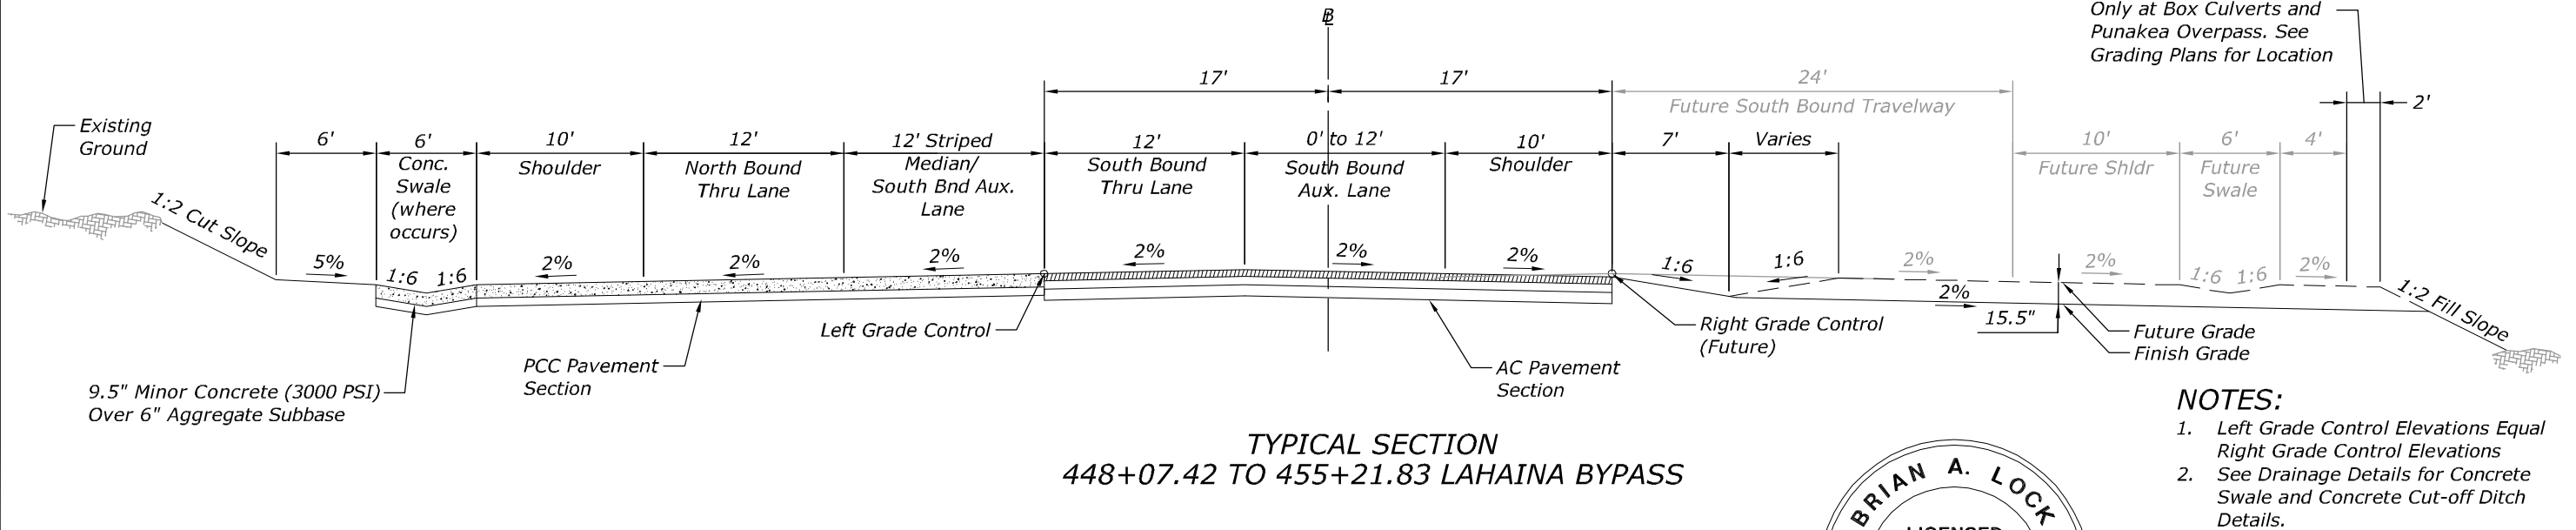

- NOTES:**
1. Left Grade Control Elevations Equal Right Grade Control Elevations
 2. See Drainage Details for Concrete Swale and Concrete Cut-off Ditch Details.

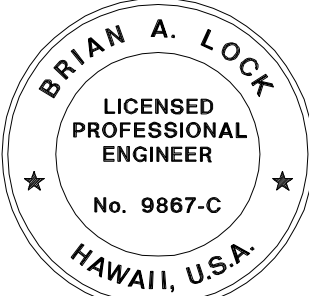



THIS WORK WAS PREPARED BY ME
OR UNDER MY SUPERVISION,
WILSON OKAMOTO CORPORATION APRIL 30, 2020
LIC. EXP. DATE

U.S. DEPARTMENT OF TRANSPORTATION
FEDERAL HIGHWAY ADMINISTRATION
CENTRAL FEDERAL LANDS HIGHWAY DIVISION

U.S. CUSTOMARY


TYPICAL SECTIONS

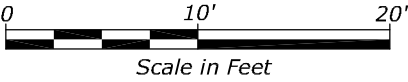

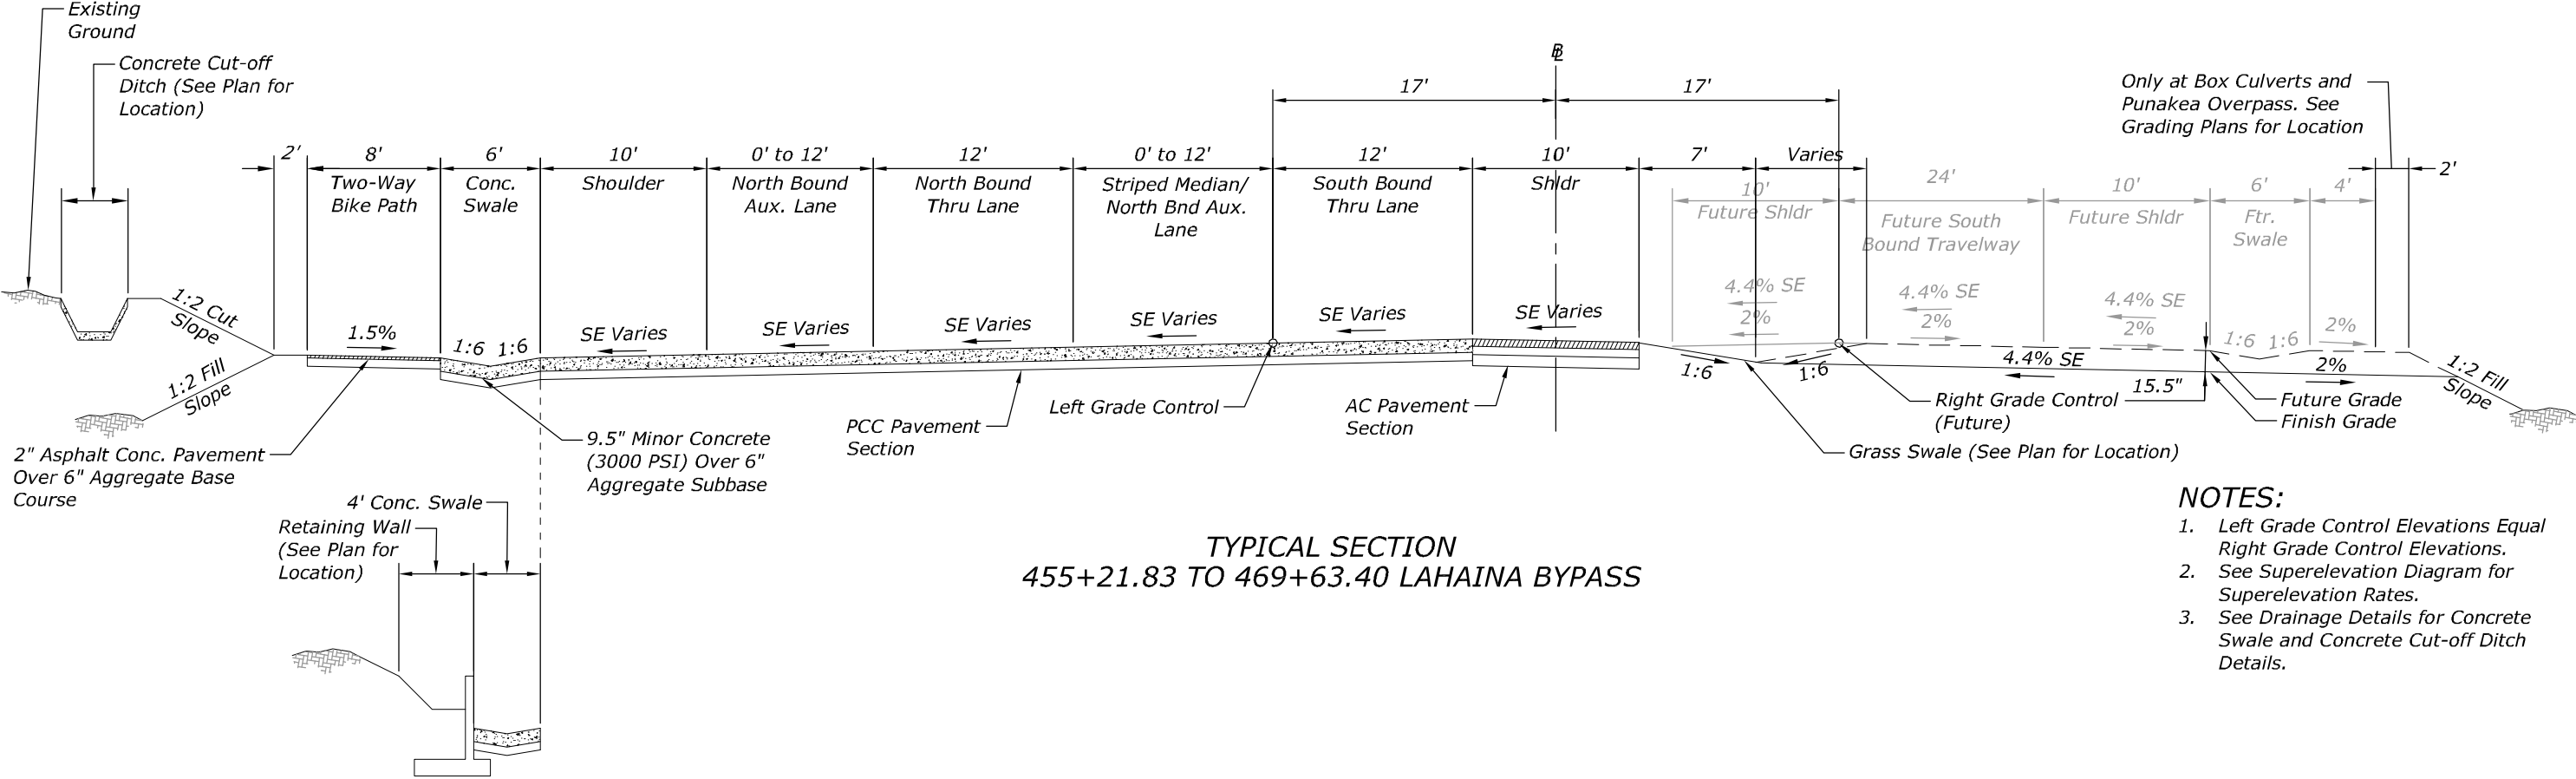


TYPICAL SECTION
455+21.83 TO 469+63.40 LAHAINA BYPASS

- NOTES:
1. Left Grade Control Elevations Equal Right Grade Control Elevations.
 2. See Superelevation Diagram for Superelevation Rates.
 3. See Drainage Details for Concrete Swale and Concrete Cut-off Ditch Details.

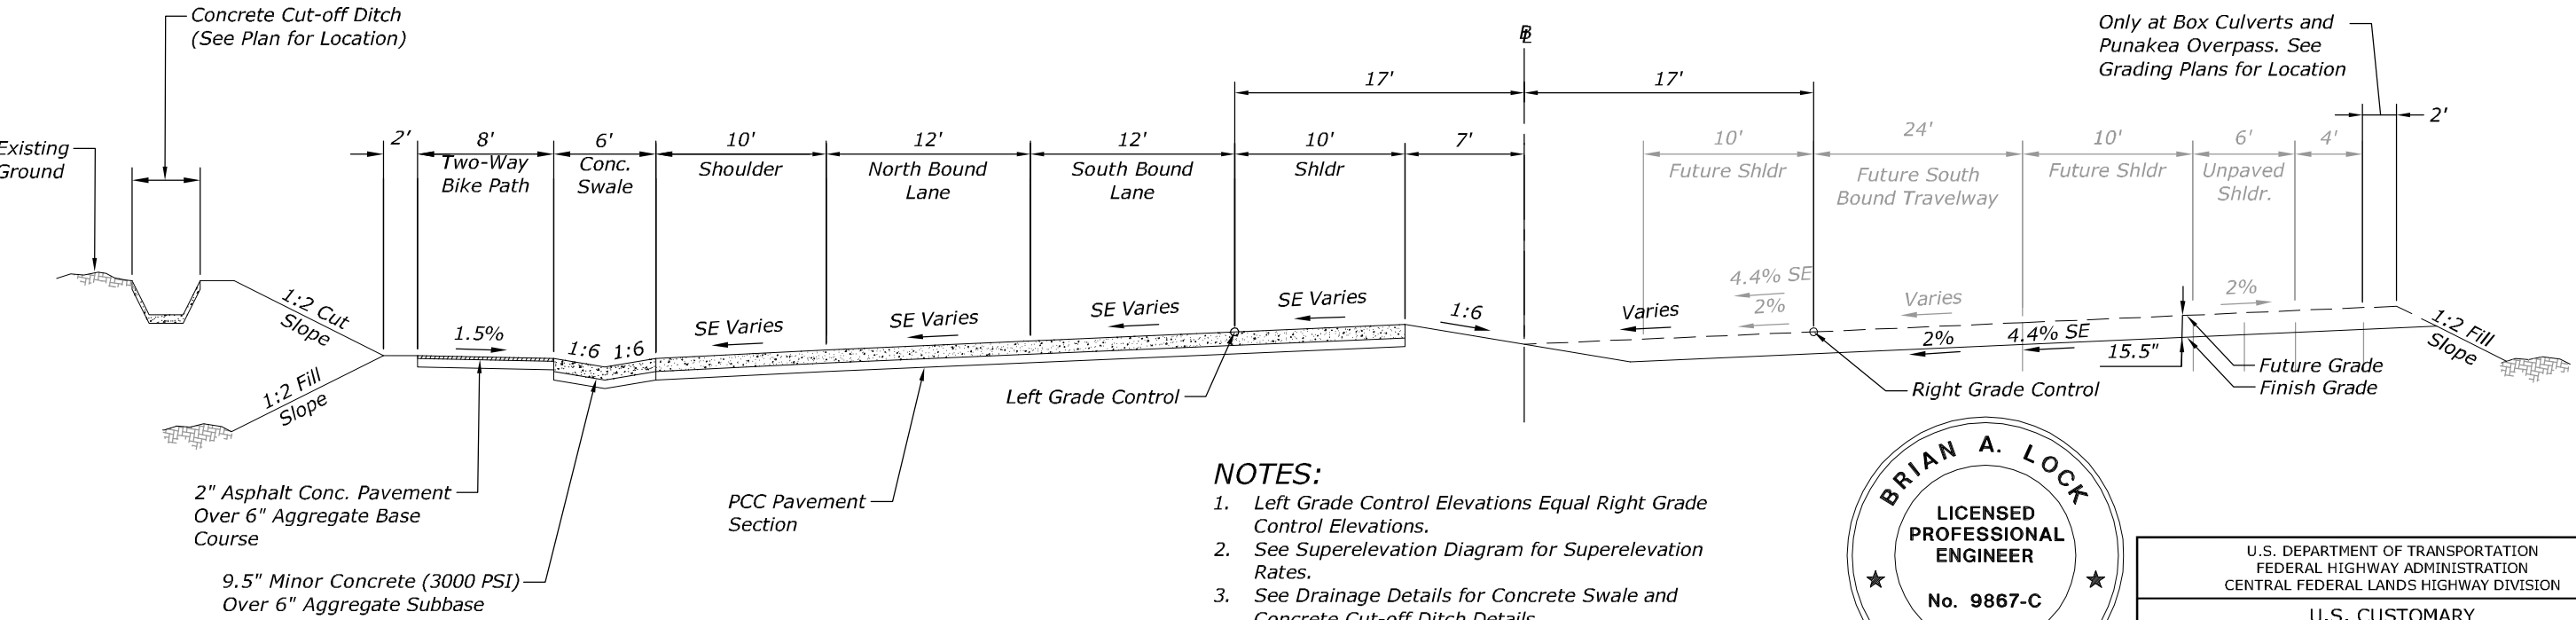


- NOTES:
1. Left Grade Control Elevations Equal Right Grade Control Elevations.
 2. See Superelevation Diagram for Superelevation Rates.
 3. See Drainage Details for Concrete Swale and Concrete Cut-off Ditch Details.

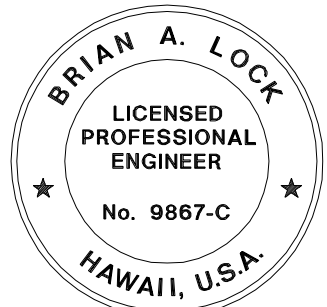

U.S. DEPARTMENT OF TRANSPORTATION
FEDERAL HIGHWAY ADMINISTRATION
CENTRAL FEDERAL LANDS HIGHWAY DIVISION


TYPICAL SECTIONS

THIS WORK WAS PREPARED BY ME
OR UNDER MY SUPERVISION,
WILSON OKAMOTO CORPORATION
APRIL 30, 2020
LIC. EXP. DATE

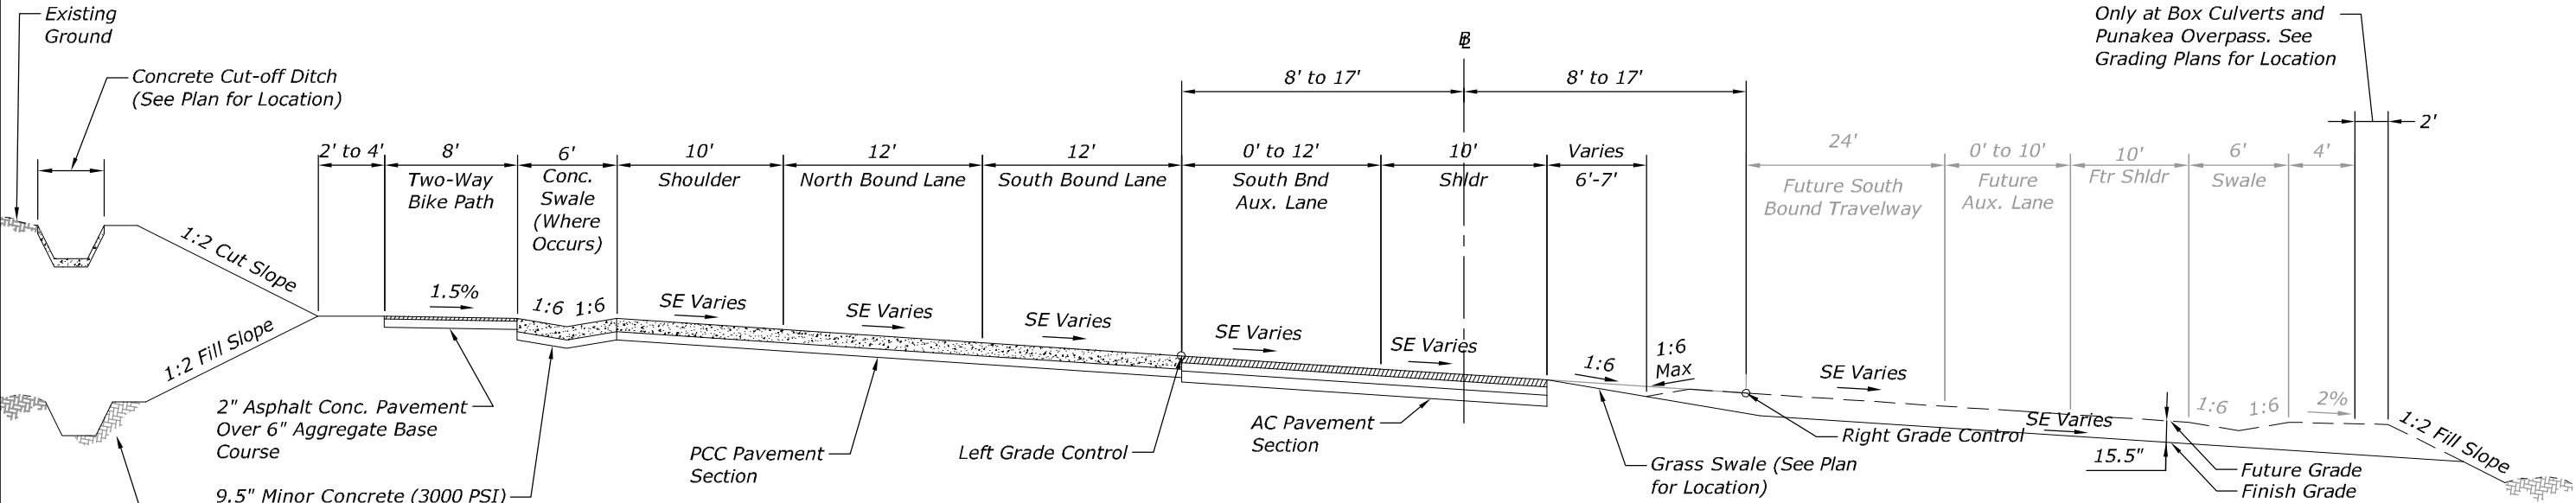


TYPICAL SECTION
483+66.43 TO 504+43.40 LAHAINA BYPASS

- NOTES:
1. Grade Control Elevations Differ. See Roadway Plan & Profile.
 2. See Superelevation Diagram for Superelevation Rates.
 3. See Drainage Details for Concrete Swale and Concrete Cut-off Ditch Details.

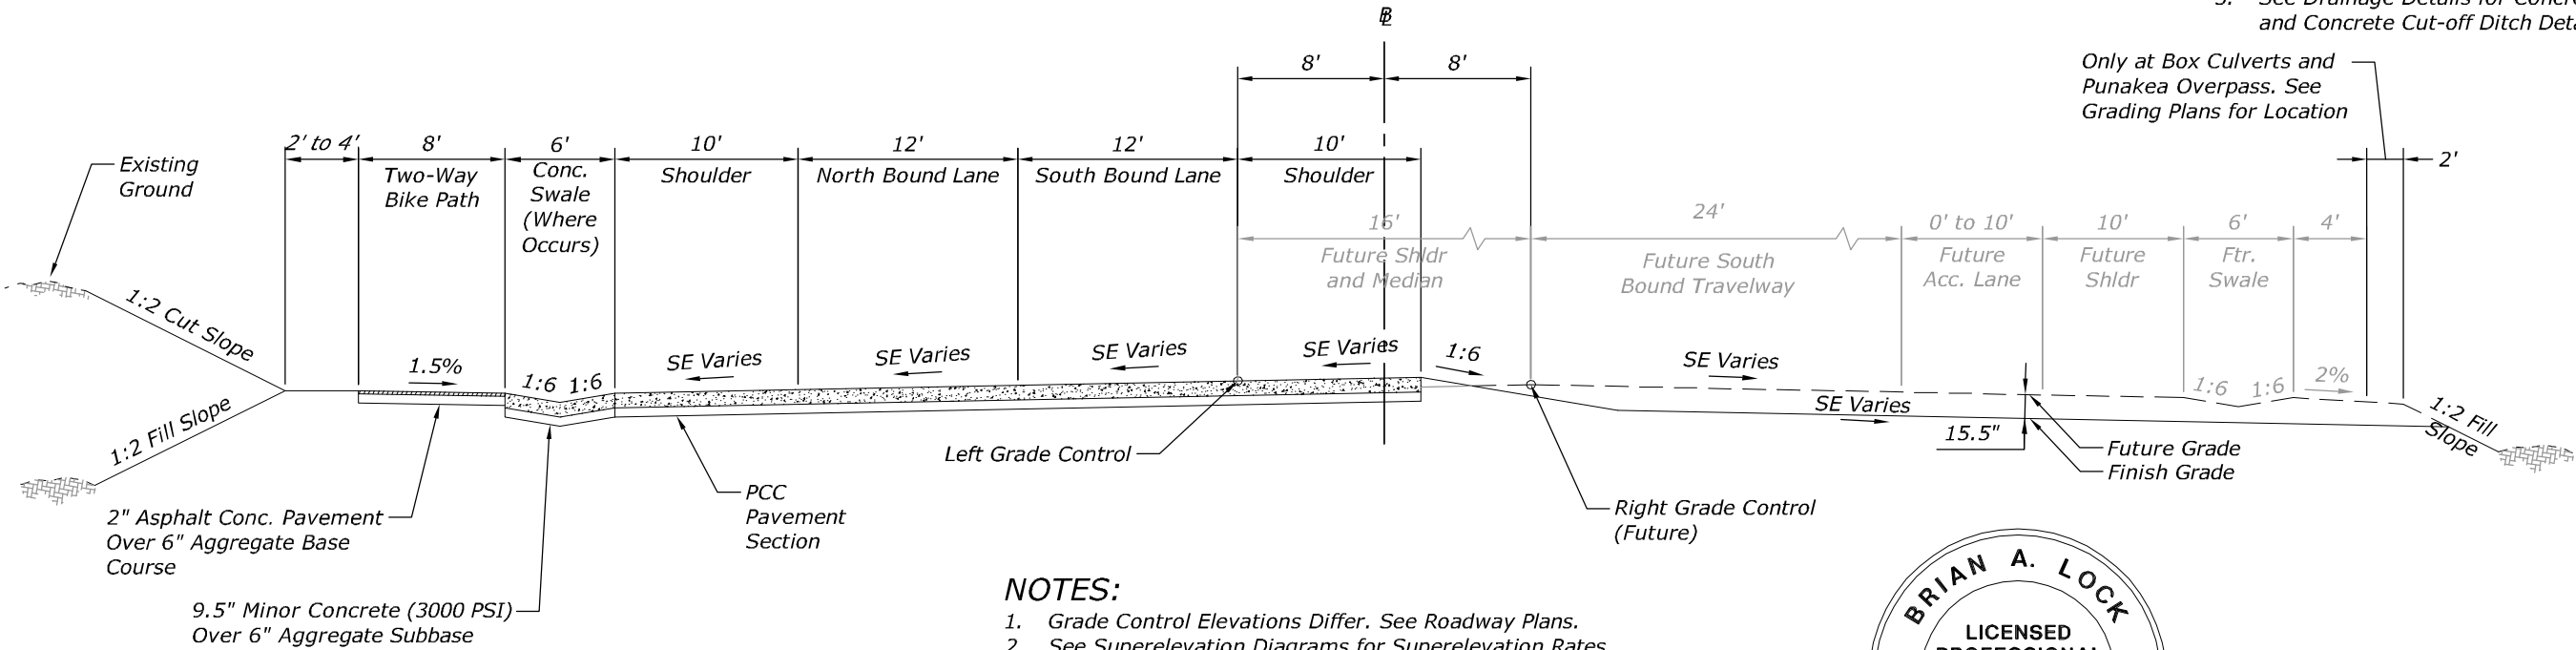

- NOTES:
1. Grade Control Elevations Differ. See Roadway Plans.
 2. See Superelevation Diagrams for Superelevation Rates.
 3. Grading off of Left Grade Control Ends at 509+00. Refer to Terminus Connector for Roadway Beyond 509+00
 4. See Drainage Details for Concrete Swale Detail.

TYPICAL SECTION
504+43.40 TO 509+00 LAHAINA BYPASS

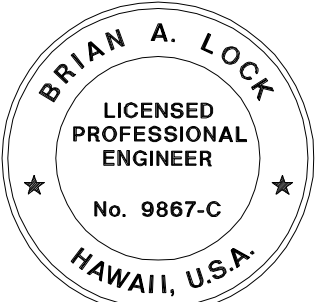


THIS WORK WAS PREPARED BY ME
OR UNDER MY SUPERVISION.
APRIL 30, 2020
WILSON OKAMOTO CORPORATION
LIC. EXP. DATE


U.S. DEPARTMENT OF TRANSPORTATION
FEDERAL HIGHWAY ADMINISTRATION
CENTRAL FEDERAL LANDS HIGHWAY DIVISION

U.S. CUSTOMARY


TYPICAL SECTIONS

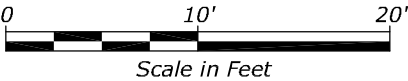

STATE	PROJECT	SHEET NO.
HI	HI STP SR 30(1)	A12

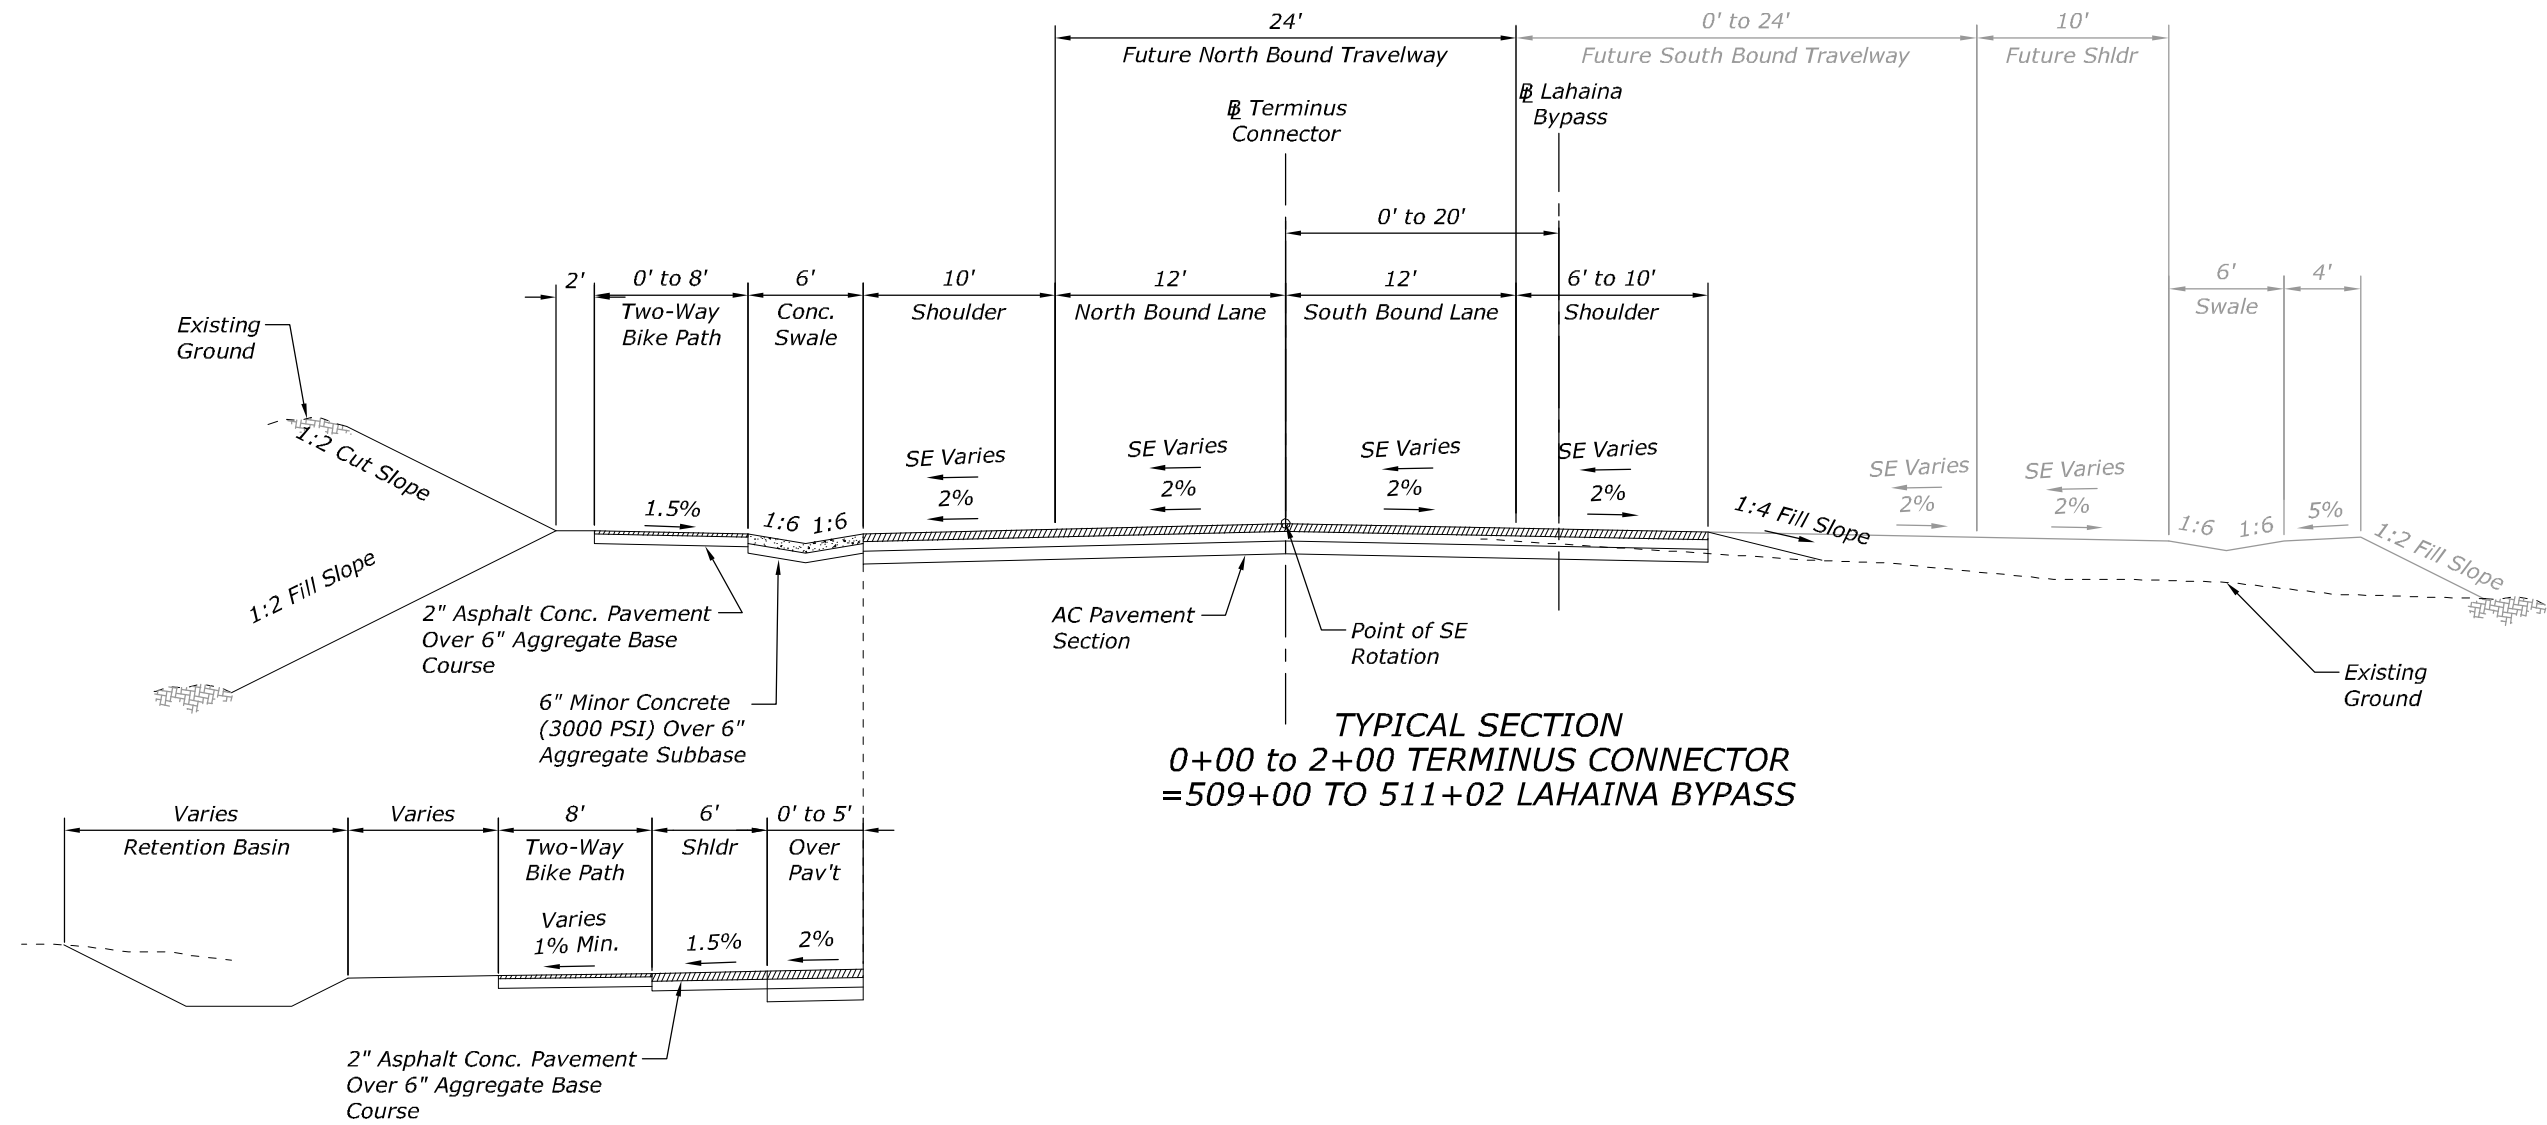

- NOTES:**
1. Mauka Shoulder Overpaved 5' for Traffic Control. See Roadway Plan & Profile and Traffic Control Plans.
 2. See Superelevation Diagrams for Superelevation Rates.
 3. Future Makai Travelway Grading Along Right Grade Control Ends at 510+00.
 4. See Drainage Details for Concrete Swale Detail.

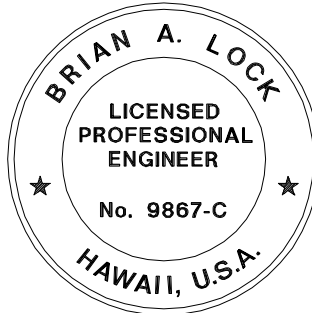


THIS WORK WAS PREPARED BY ME
OR UNDER MY SUPERVISION.

WILSON OKAMOTO CORPORATION APRIL 30, 2020
LIC. EXP. DATE


U.S. DEPARTMENT OF TRANSPORTATION
FEDERAL HIGHWAY ADMINISTRATION
CENTRAL FEDERAL LANDS HIGHWAY DIVISION

U.S. CUSTOMARY



TYPICAL SECTIONS

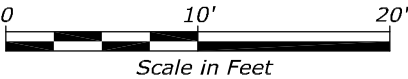

STATE	PROJECT	SHEET NO.
HI	HI STP SR 30(1)	A13

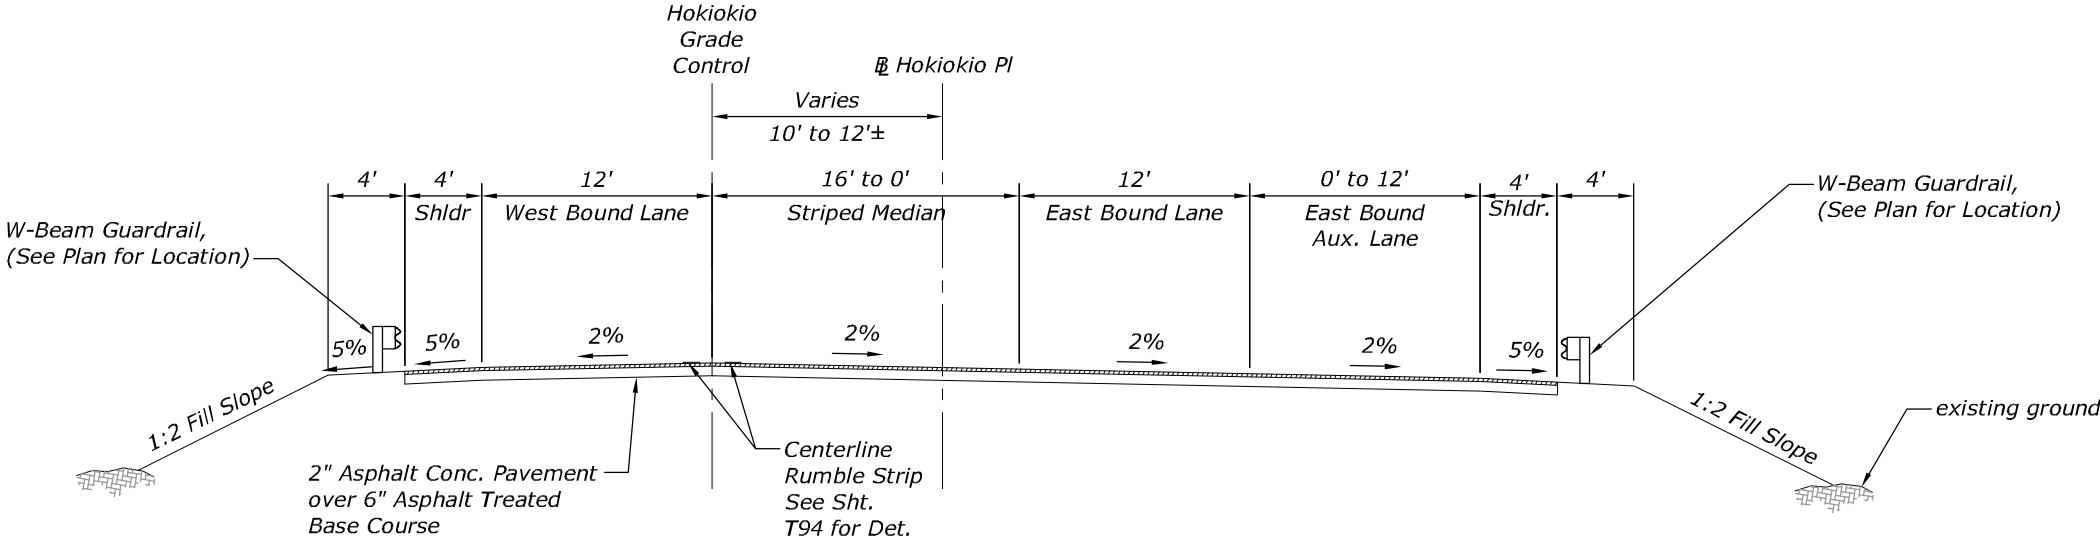

TYPICAL SECTION
11+00 TO 16+11 Hokiokio Place
=0+00 to 5+14.05 Hokiokio Grade Control

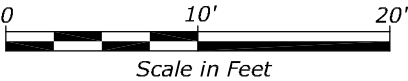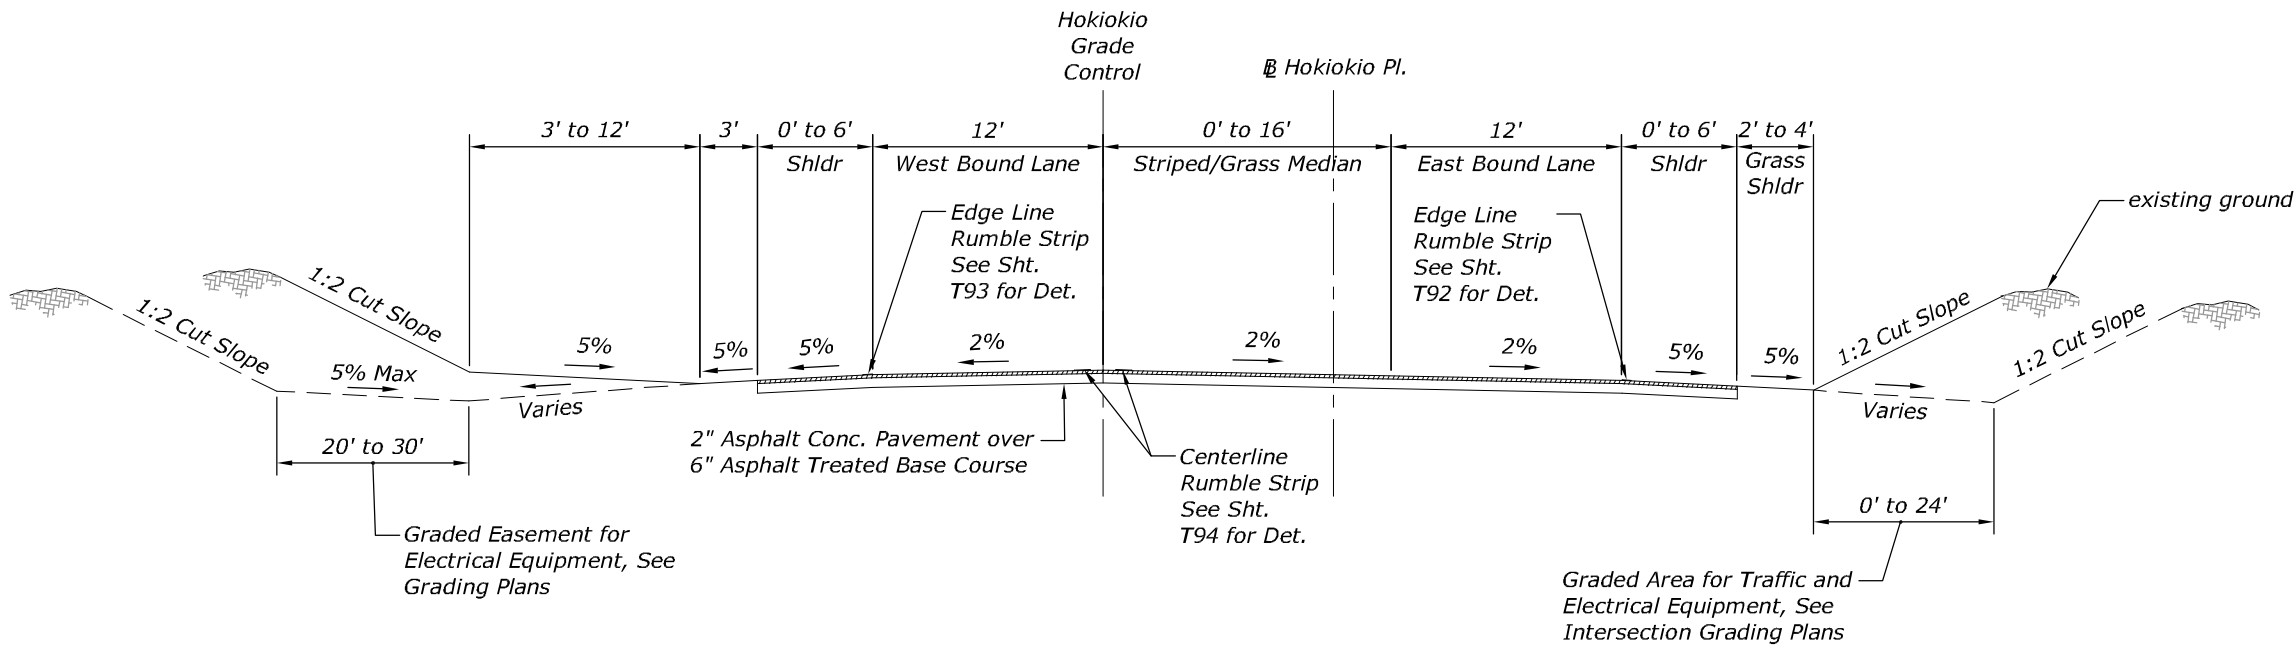

TYPICAL SECTION
18+02± to 19+23.87 Hokiokio Place
=7+05.60 to 8+26.41 Hokiokio Grade Control



THIS WORK WAS PREPARED BY ME
OR UNDER MY SUPERVISION.


WILSON OKAMOTO CORPORATION APRIL 30, 2020
LIC. EXP. DATE

U.S. DEPARTMENT OF TRANSPORTATION
FEDERAL HIGHWAY ADMINISTRATION
CENTRAL FEDERAL LANDS HIGHWAY DIVISION

U.S. CUSTOMARY

TYPICAL SECTIONS


STATE	PROJECT	SHEET NO.
HI	HI STP SR 30(1)	A14

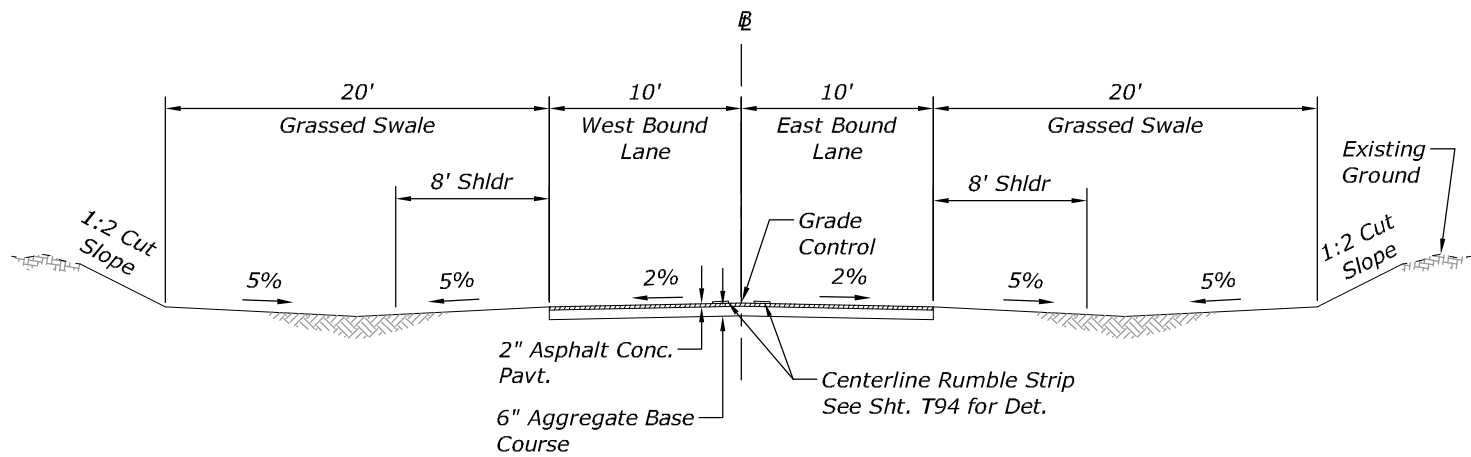


TYPICAL SECTION
6+90 TO 8+90.82 Punakea Street

NOTES:

- Scarify Subgrade A Min. of 8", Moisture-Conditioned to Above The Optimum Moisture Content, and Compact to Not Less Than 95% Relative Compaction

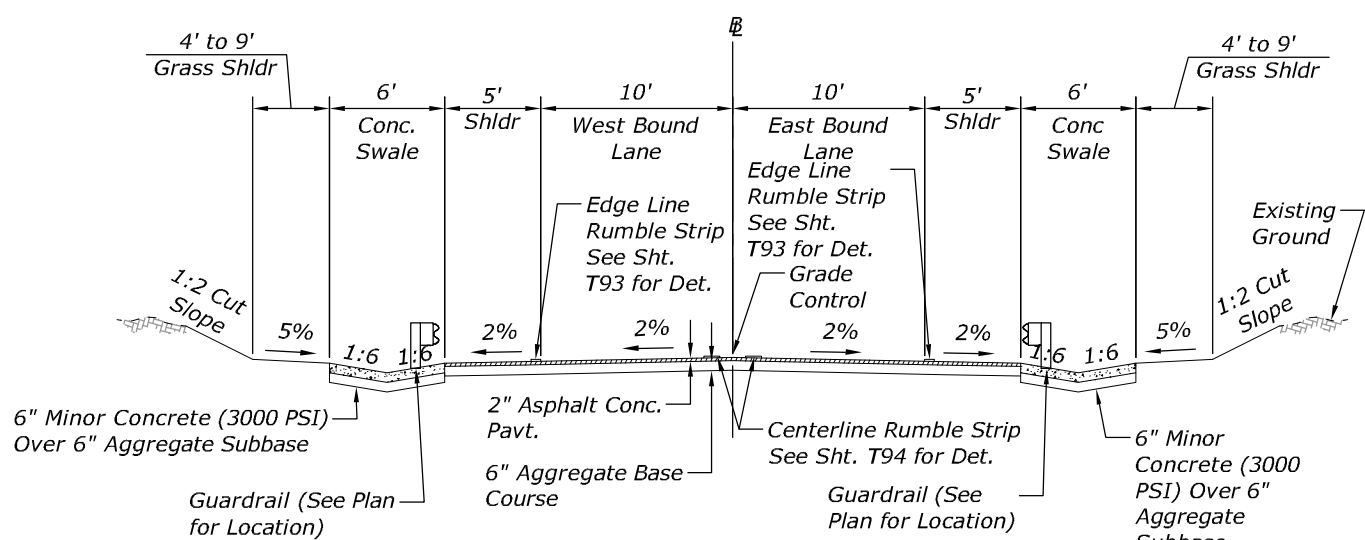


TYPICAL SECTION
8+90.82 TO 11+40 AND
12+70 TO 17+60.89 Punakea Street

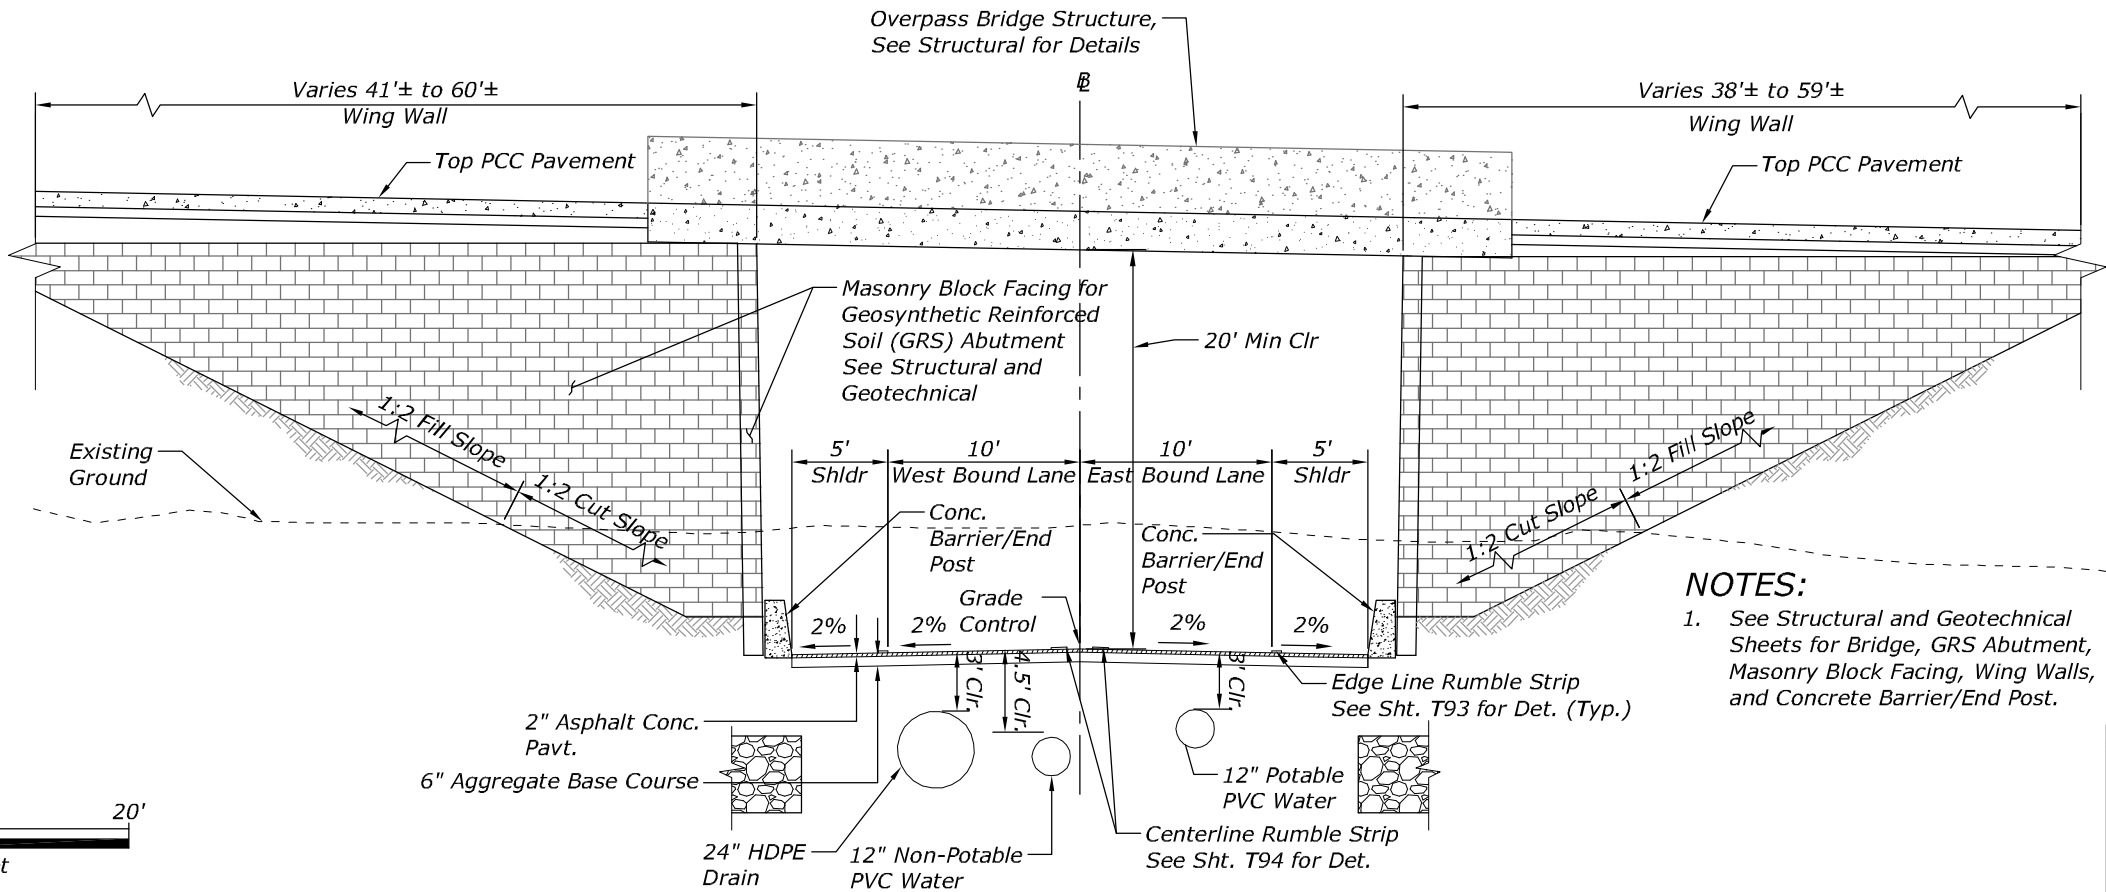

TYPICAL SECTION
At Punakea Street Overpass
11+40 to 12+70 PUNAKEA STREET

NOTES:

- See Structural and Geotechnical Sheets for Bridge, GRS Abutment, Masonry Block Facing, Wing Walls, and Concrete Barrier/End Post.

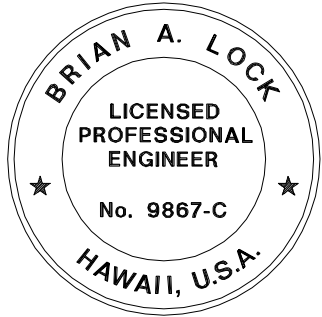

THIS WORK WAS PREPARED BY ME
OR UNDER MY SUPERVISION.


WILSON OKAMOTO CORPORATION APRIL 30, 2020
LIC. EXP. DATE

U.S. DEPARTMENT OF TRANSPORTATION
FEDERAL HIGHWAY ADMINISTRATION
CENTRAL FEDERAL LANDS HIGHWAY DIVISION

U.S. CUSTOMARY

TYPICAL SECTIONS


STATE	PROJECT	SHEET NO.
HI	HI STP SR 30(1)	A15

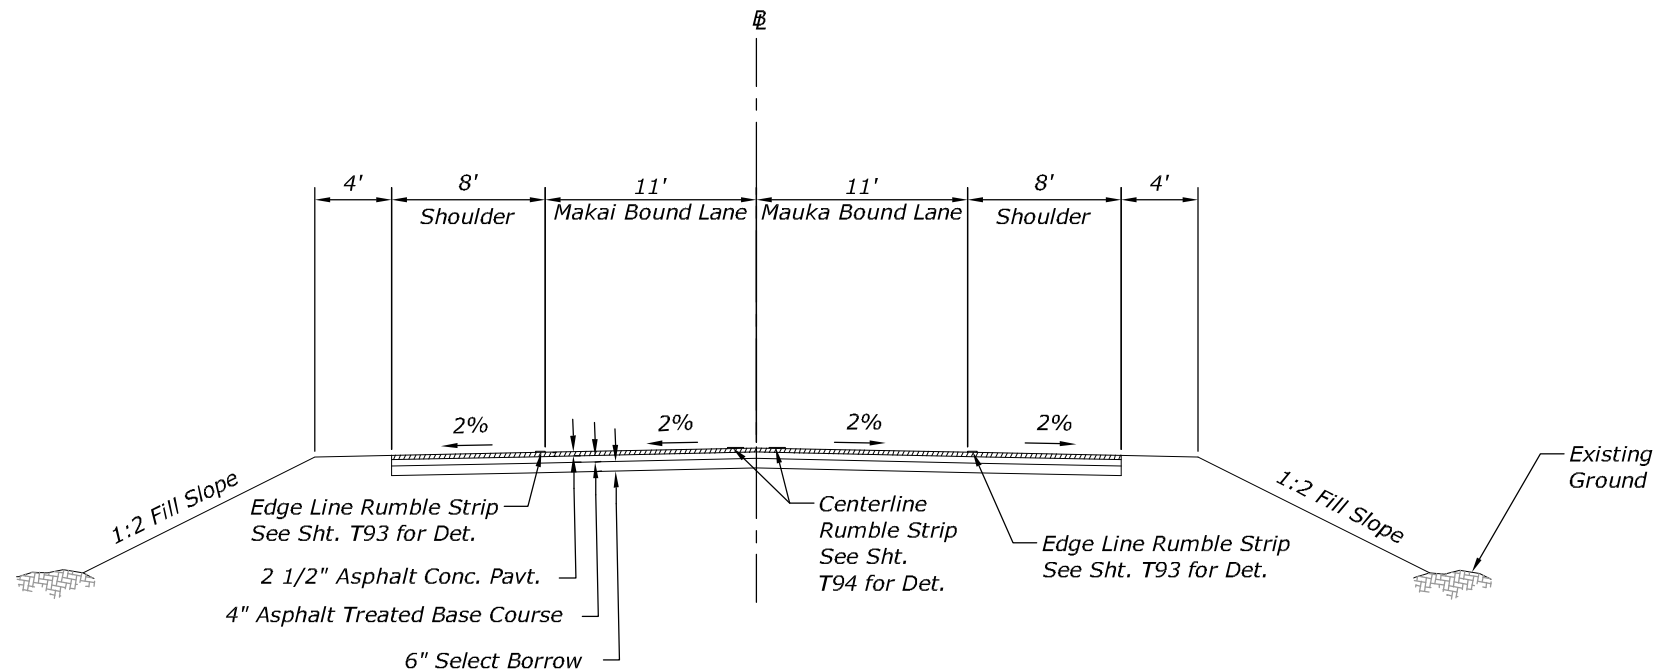



TYPICAL SECTION
0+50 TO 4+42 Kai Hele Ku Street

NOTES:

1. Grade Control Elevations Differ.
See Roadway Plan & Profile.
2. See Superelevation Diagram for
Superelevation Rates.

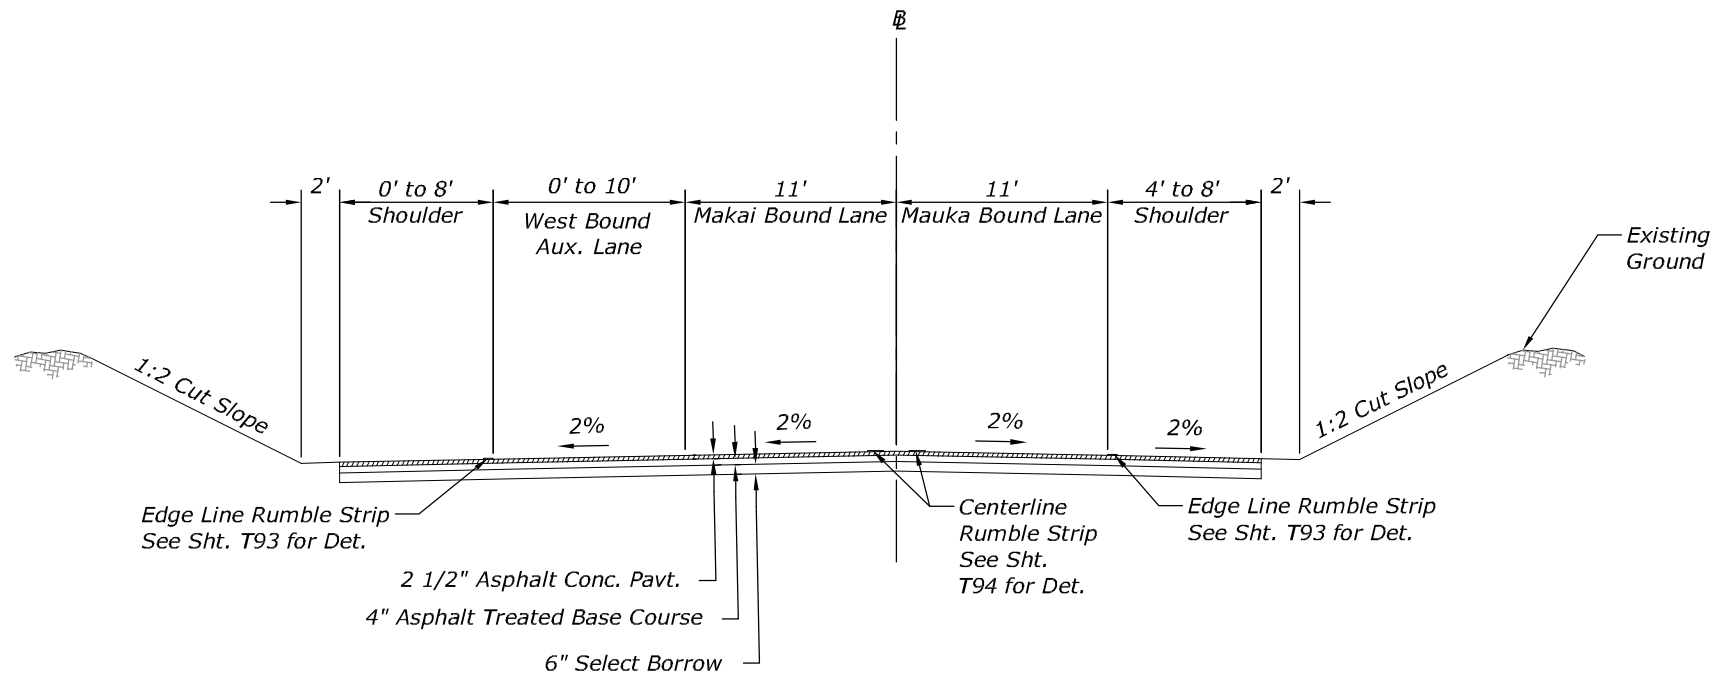

TYPICAL SECTION
7+24 TO 12+09.30 Kai Hele Ku Street

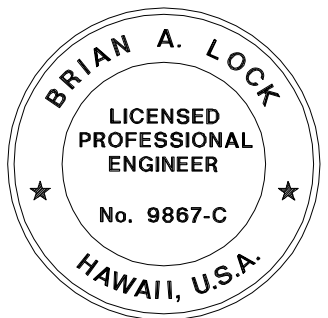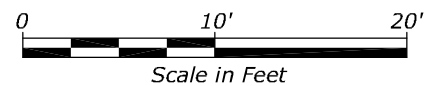

THIS WORK WAS PREPARED BY ME
OR UNDER MY SUPERVISION.


WILSON OKAMOTO CORPORATION
APRIL 30, 2020
LIC. EXP. DATE

U.S. DEPARTMENT OF TRANSPORTATION
FEDERAL HIGHWAY ADMINISTRATION
CENTRAL FEDERAL LANDS HIGHWAY DIVISION

U.S. CUSTOMARY


TYPICAL SECTIONS

STATE	PROJECT	SHEET NO.
HI	HI STP SR 30(1)	A16

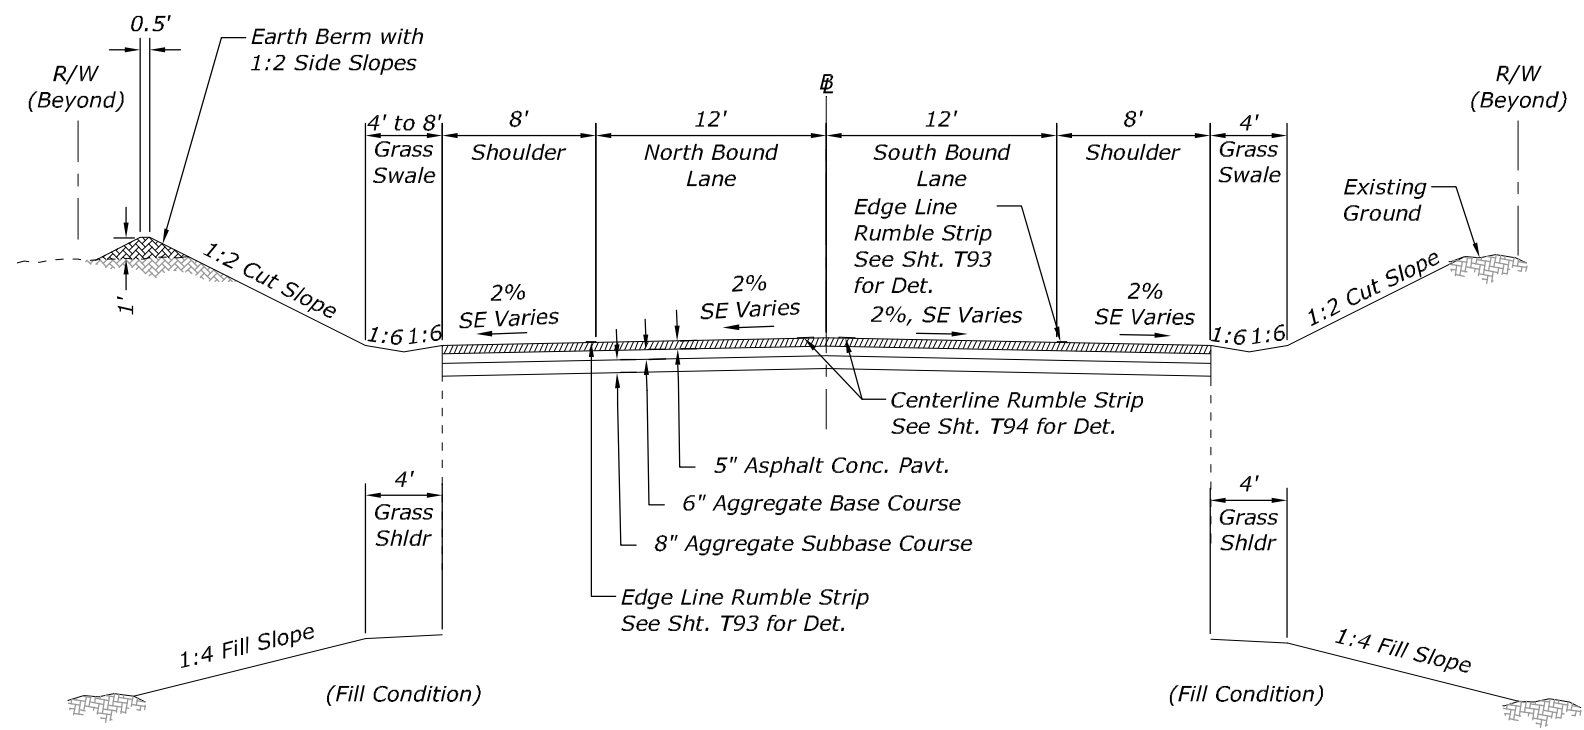


NOTE:
1. See Superelevation Diagrams for Superelevation Rates.

TYPICAL SECTION
3+07 TO 15+94.05 SOUTH CONNECTOR ROAD

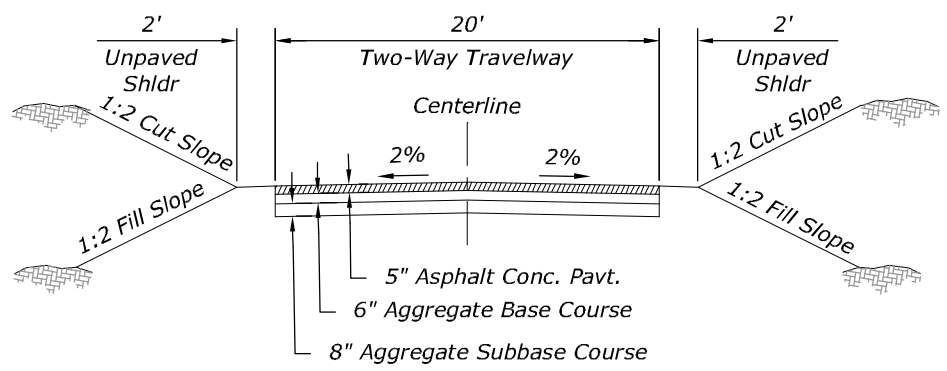

SHORELINE ACCESS
(FROM SOUTH CONNECTOR ROAD)

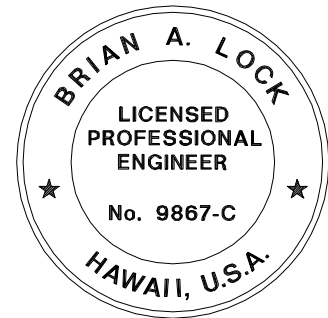

THIS WORK WAS PREPARED BY ME
OR UNDER MY SUPERVISION.

WILSON OKAMOTO CORPORATION APRIL 30, 2020
LIC. EXP. DATE

U.S. DEPARTMENT OF TRANSPORTATION
FEDERAL HIGHWAY ADMINISTRATION
CENTRAL FEDERAL LANDS HIGHWAY DIVISION

U.S. CUSTOMARY

TYPICAL SECTIONS

