



STATE	PROJECT	SHEET NO.
HI	HI STP SR 30(1)	T38

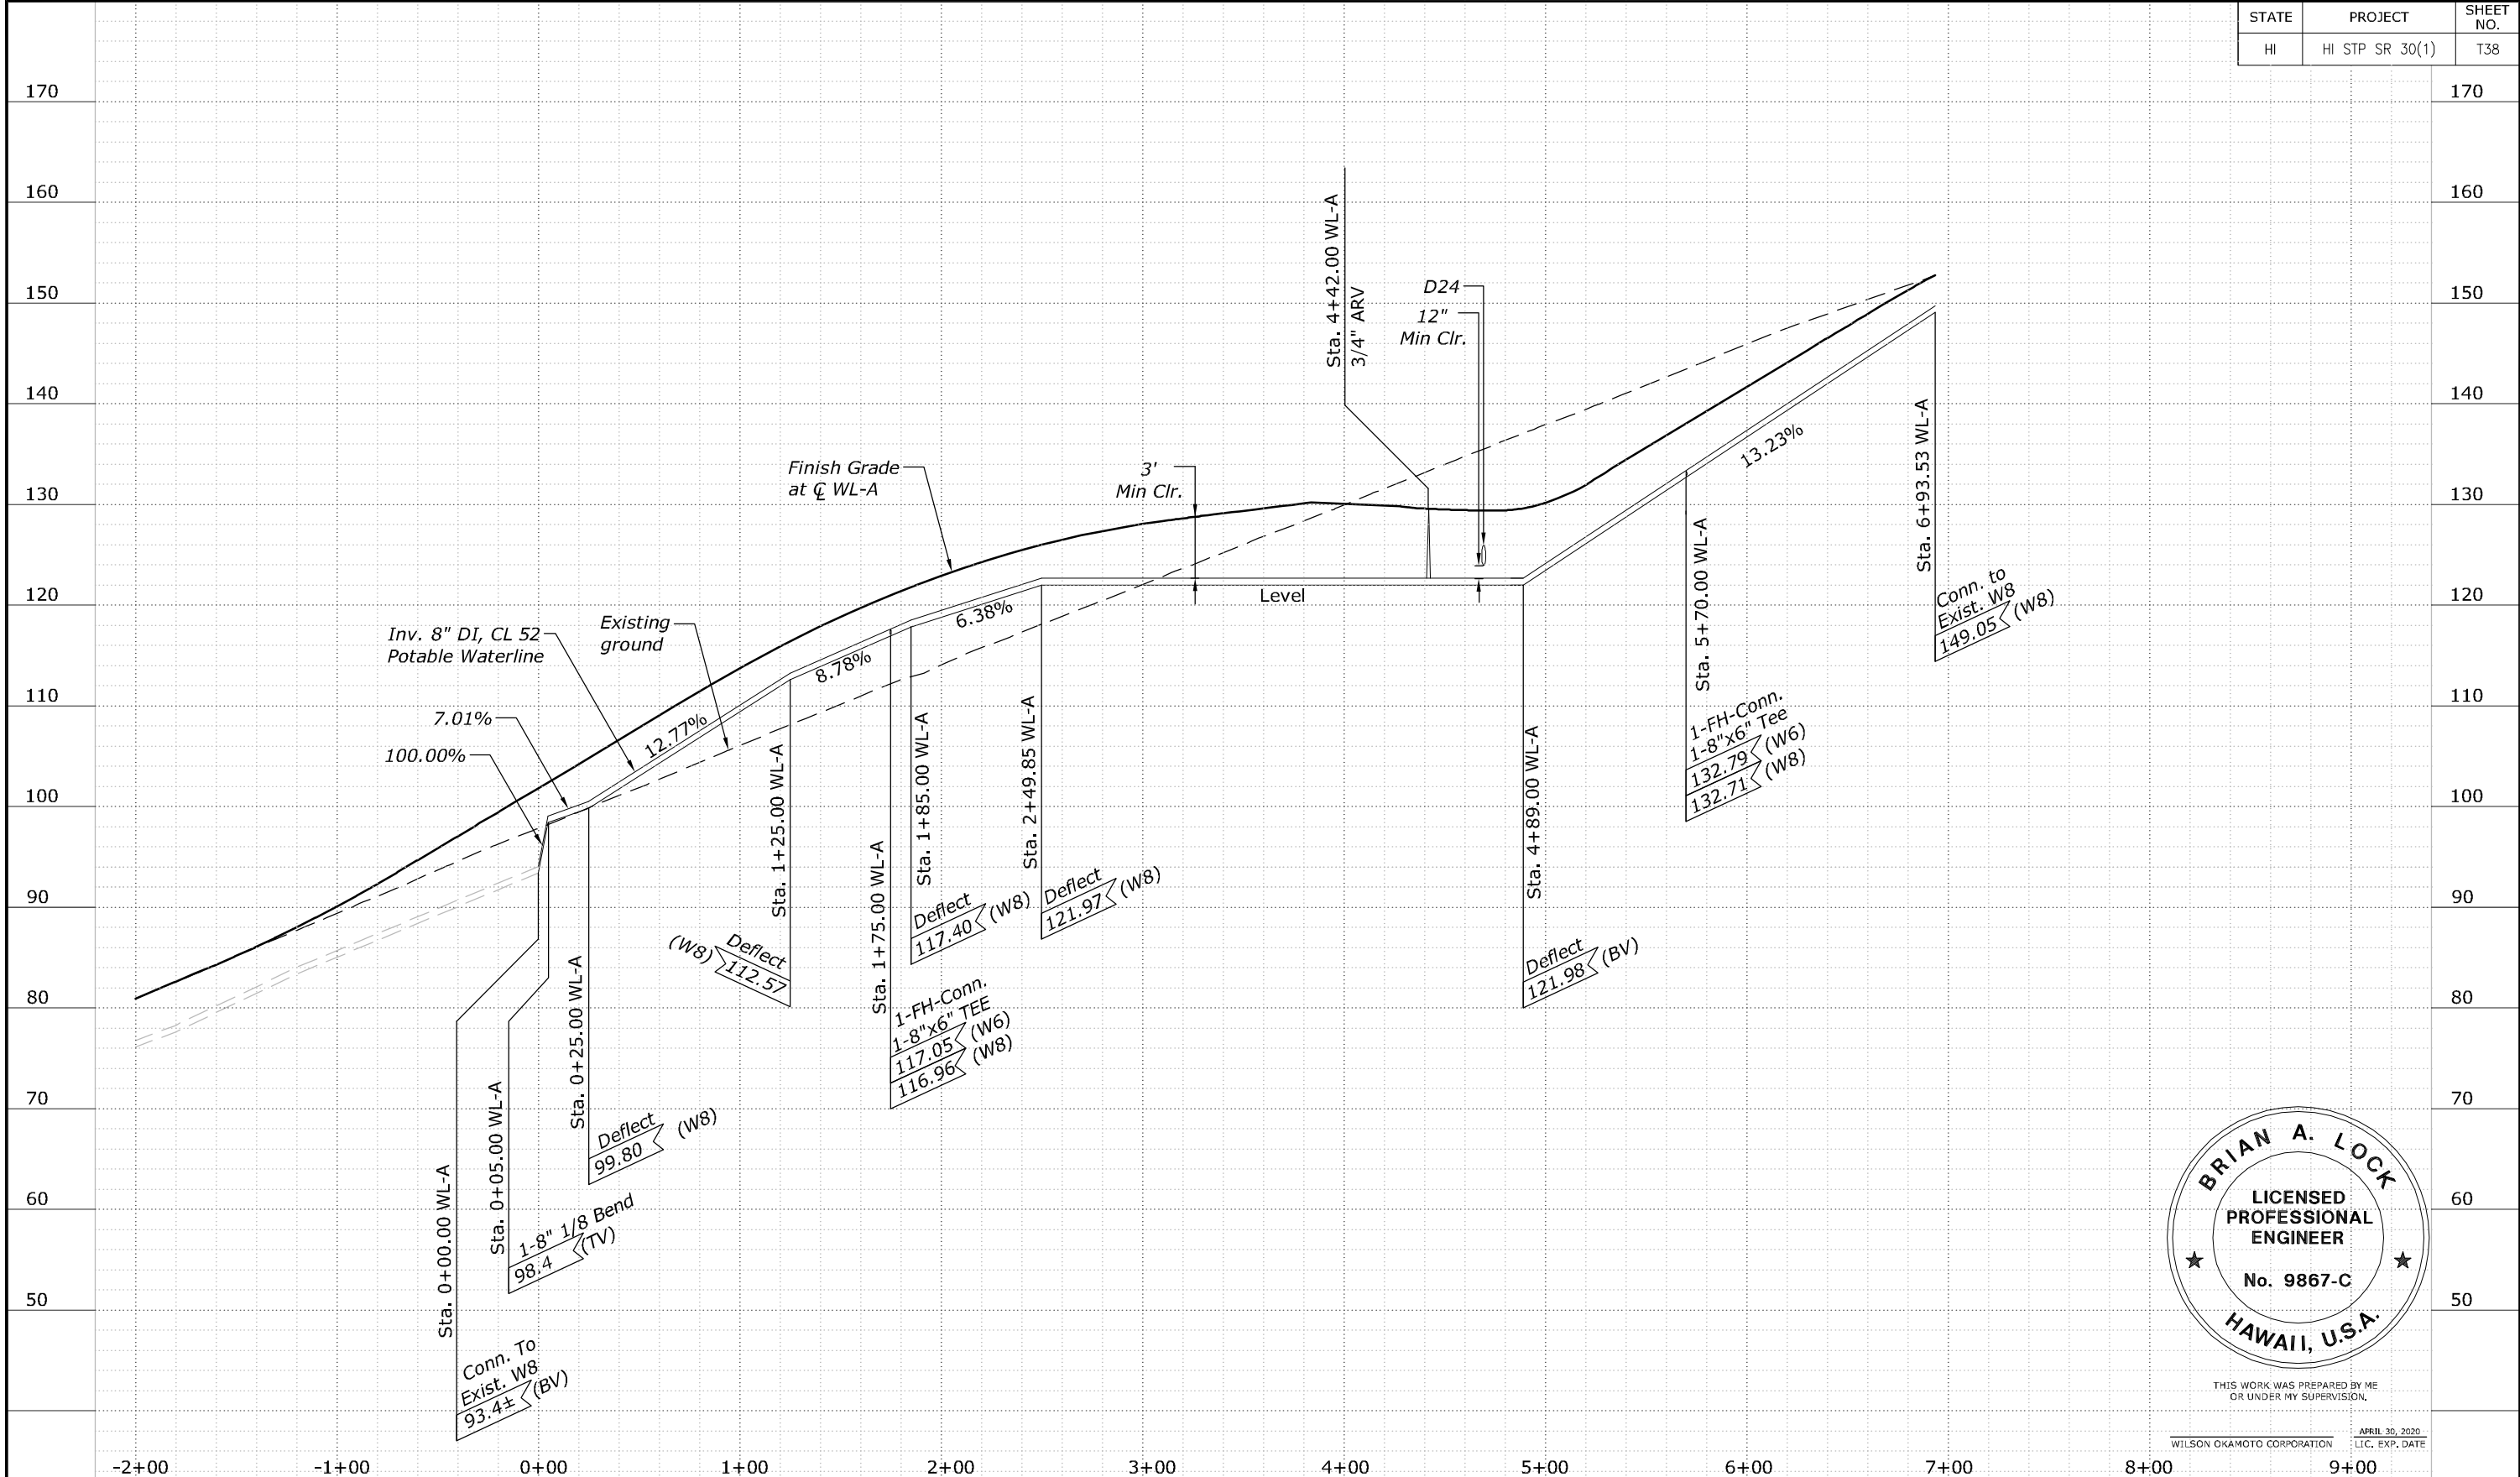


PROFILE - WATERLINE "A"
HOKIOKIO PLACE
Scale: V - 1" = 16'
Scale: H - 1" = 80'

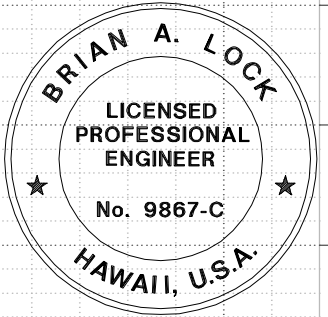


THIS WORK WAS PREPARED BY ME
OR UNDER MY SUPERVISION.
WILSON OKAMOTO CORPORATION
APRIL 30, 2020
LIC. EXP. DATE


STATE	PROJECT	SHEET NO.
HI	HI STP SR 30(1)	T39

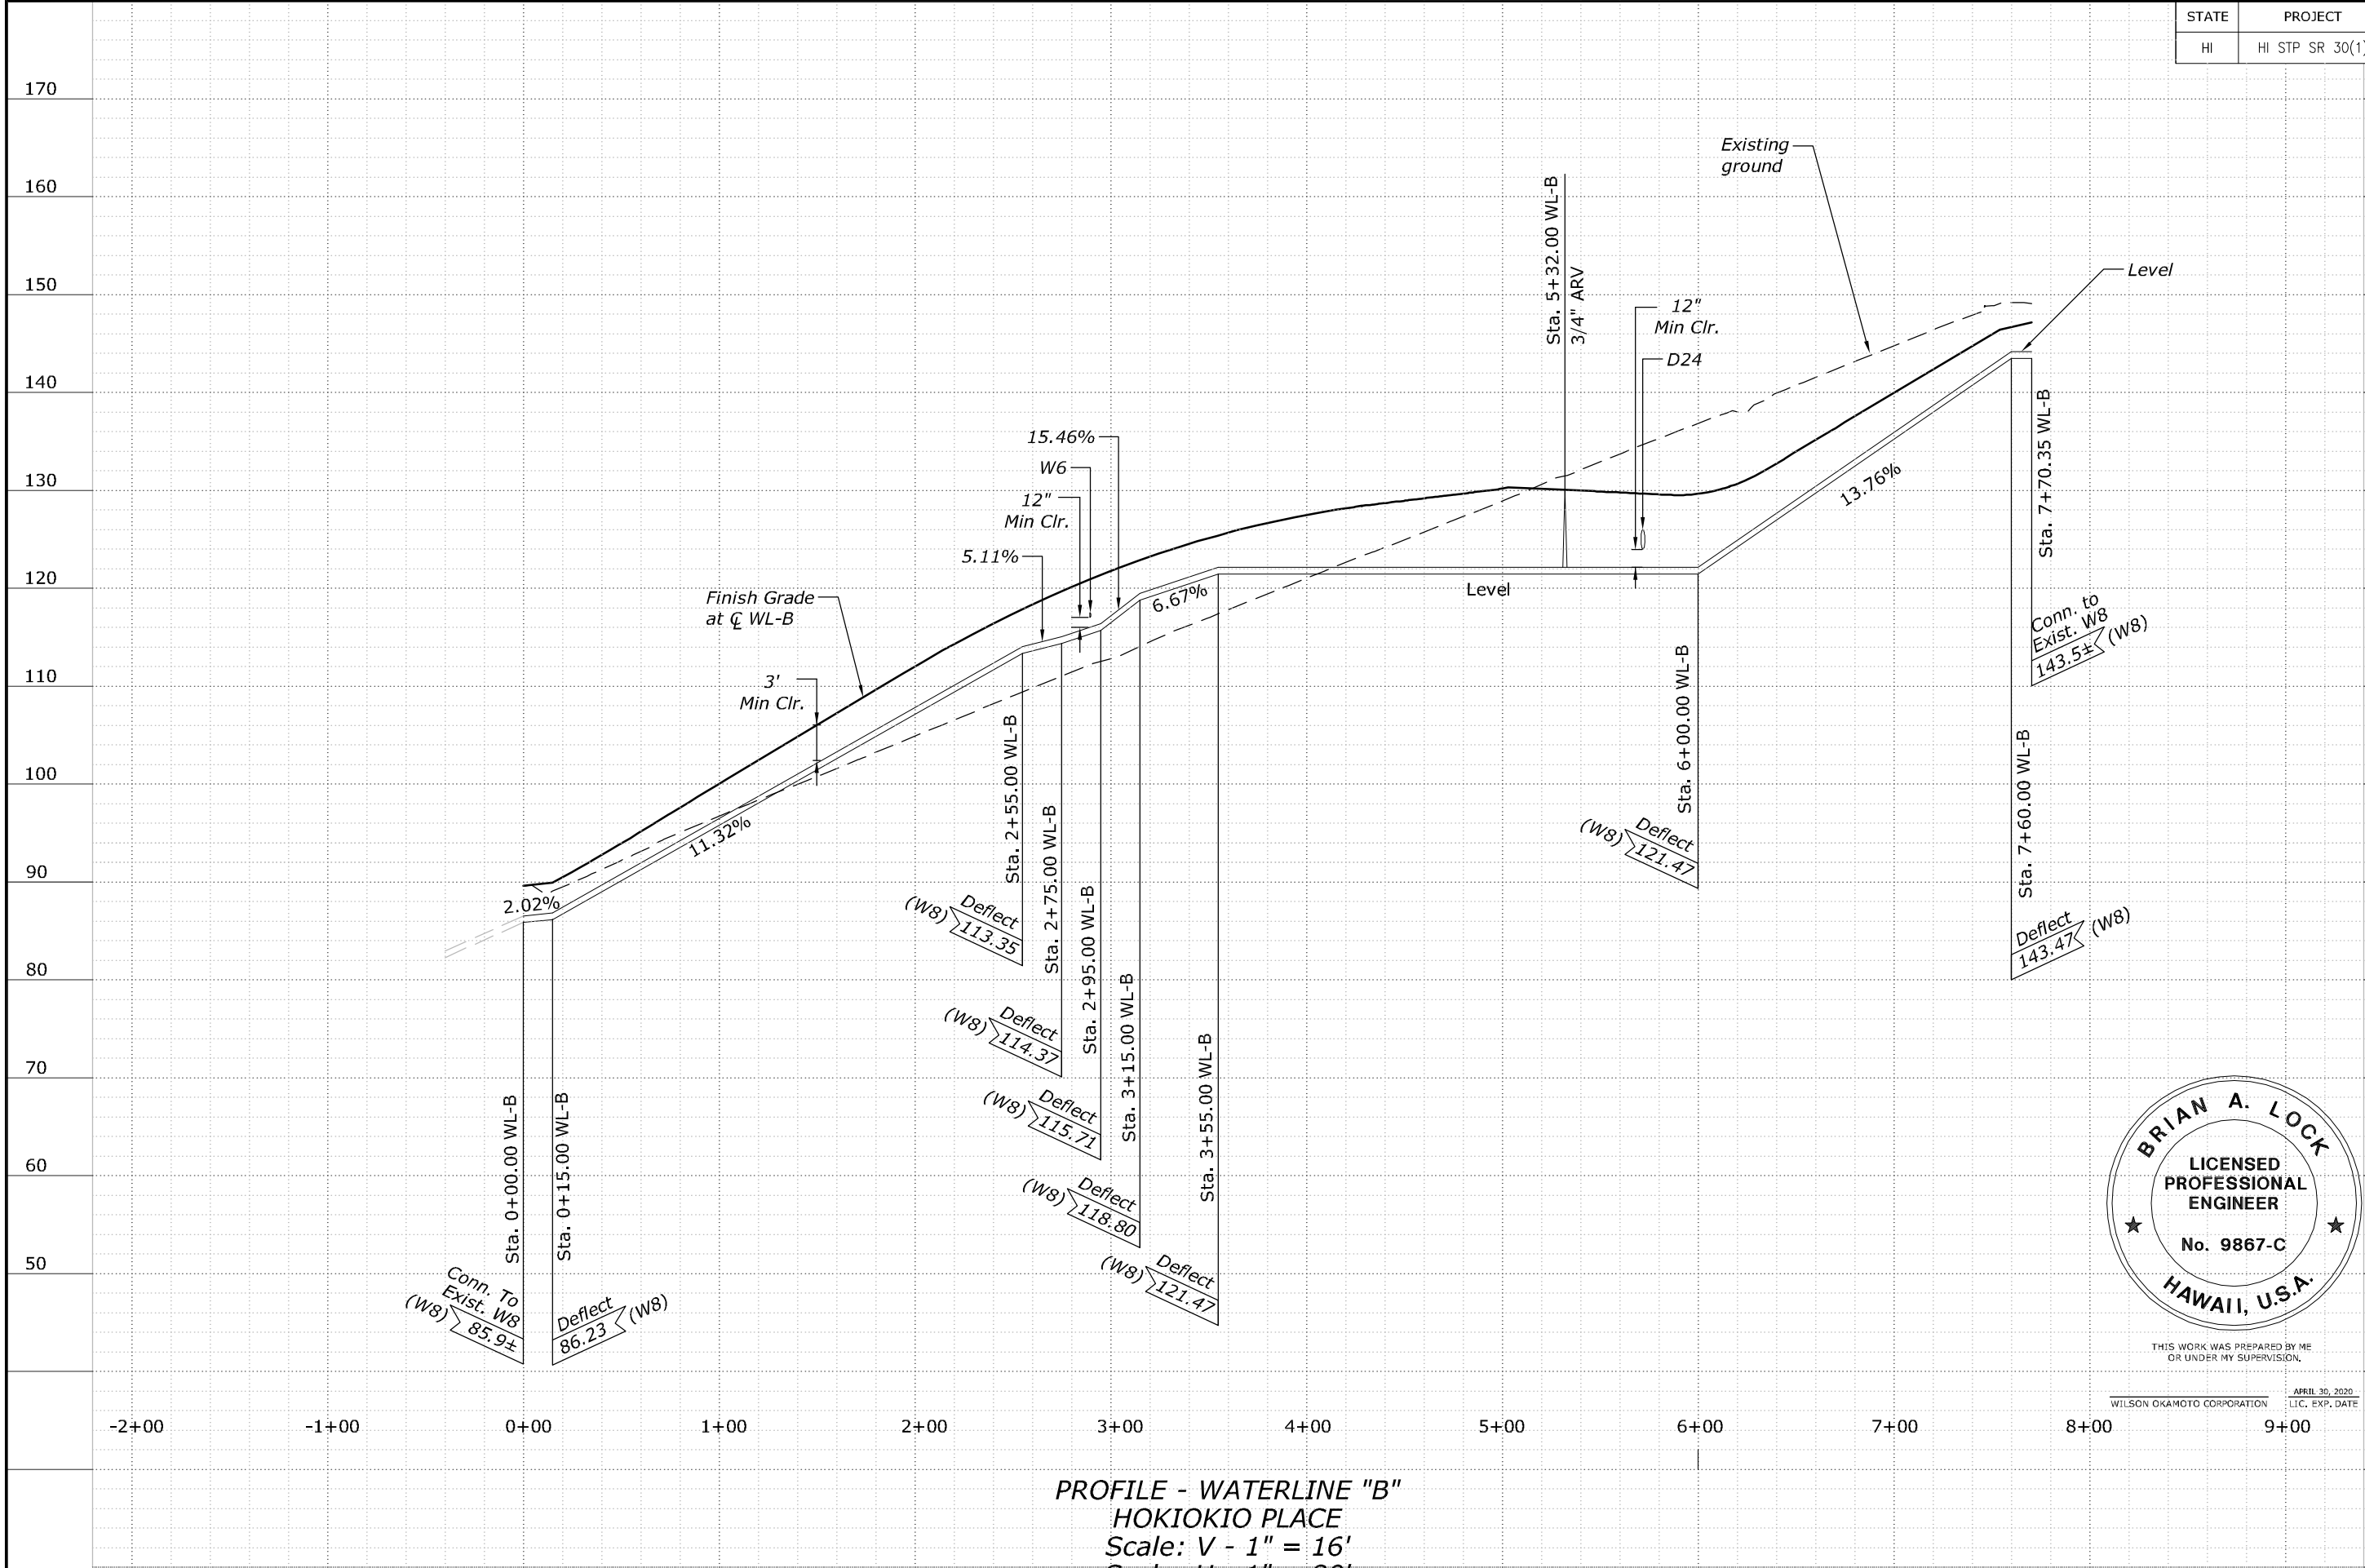


PROFILE - WATERLINE "B"
HOKIOKIO PLACE
Scale: V - 1" = 16'
Scale: H - 1" = 80'

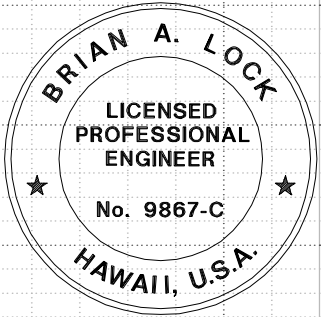


THIS WORK WAS PREPARED BY ME
OR UNDER MY SUPERVISION.
WILSON OKAMOTO CORPORATION
APRIL 30, 2020
LIC. EXP. DATE

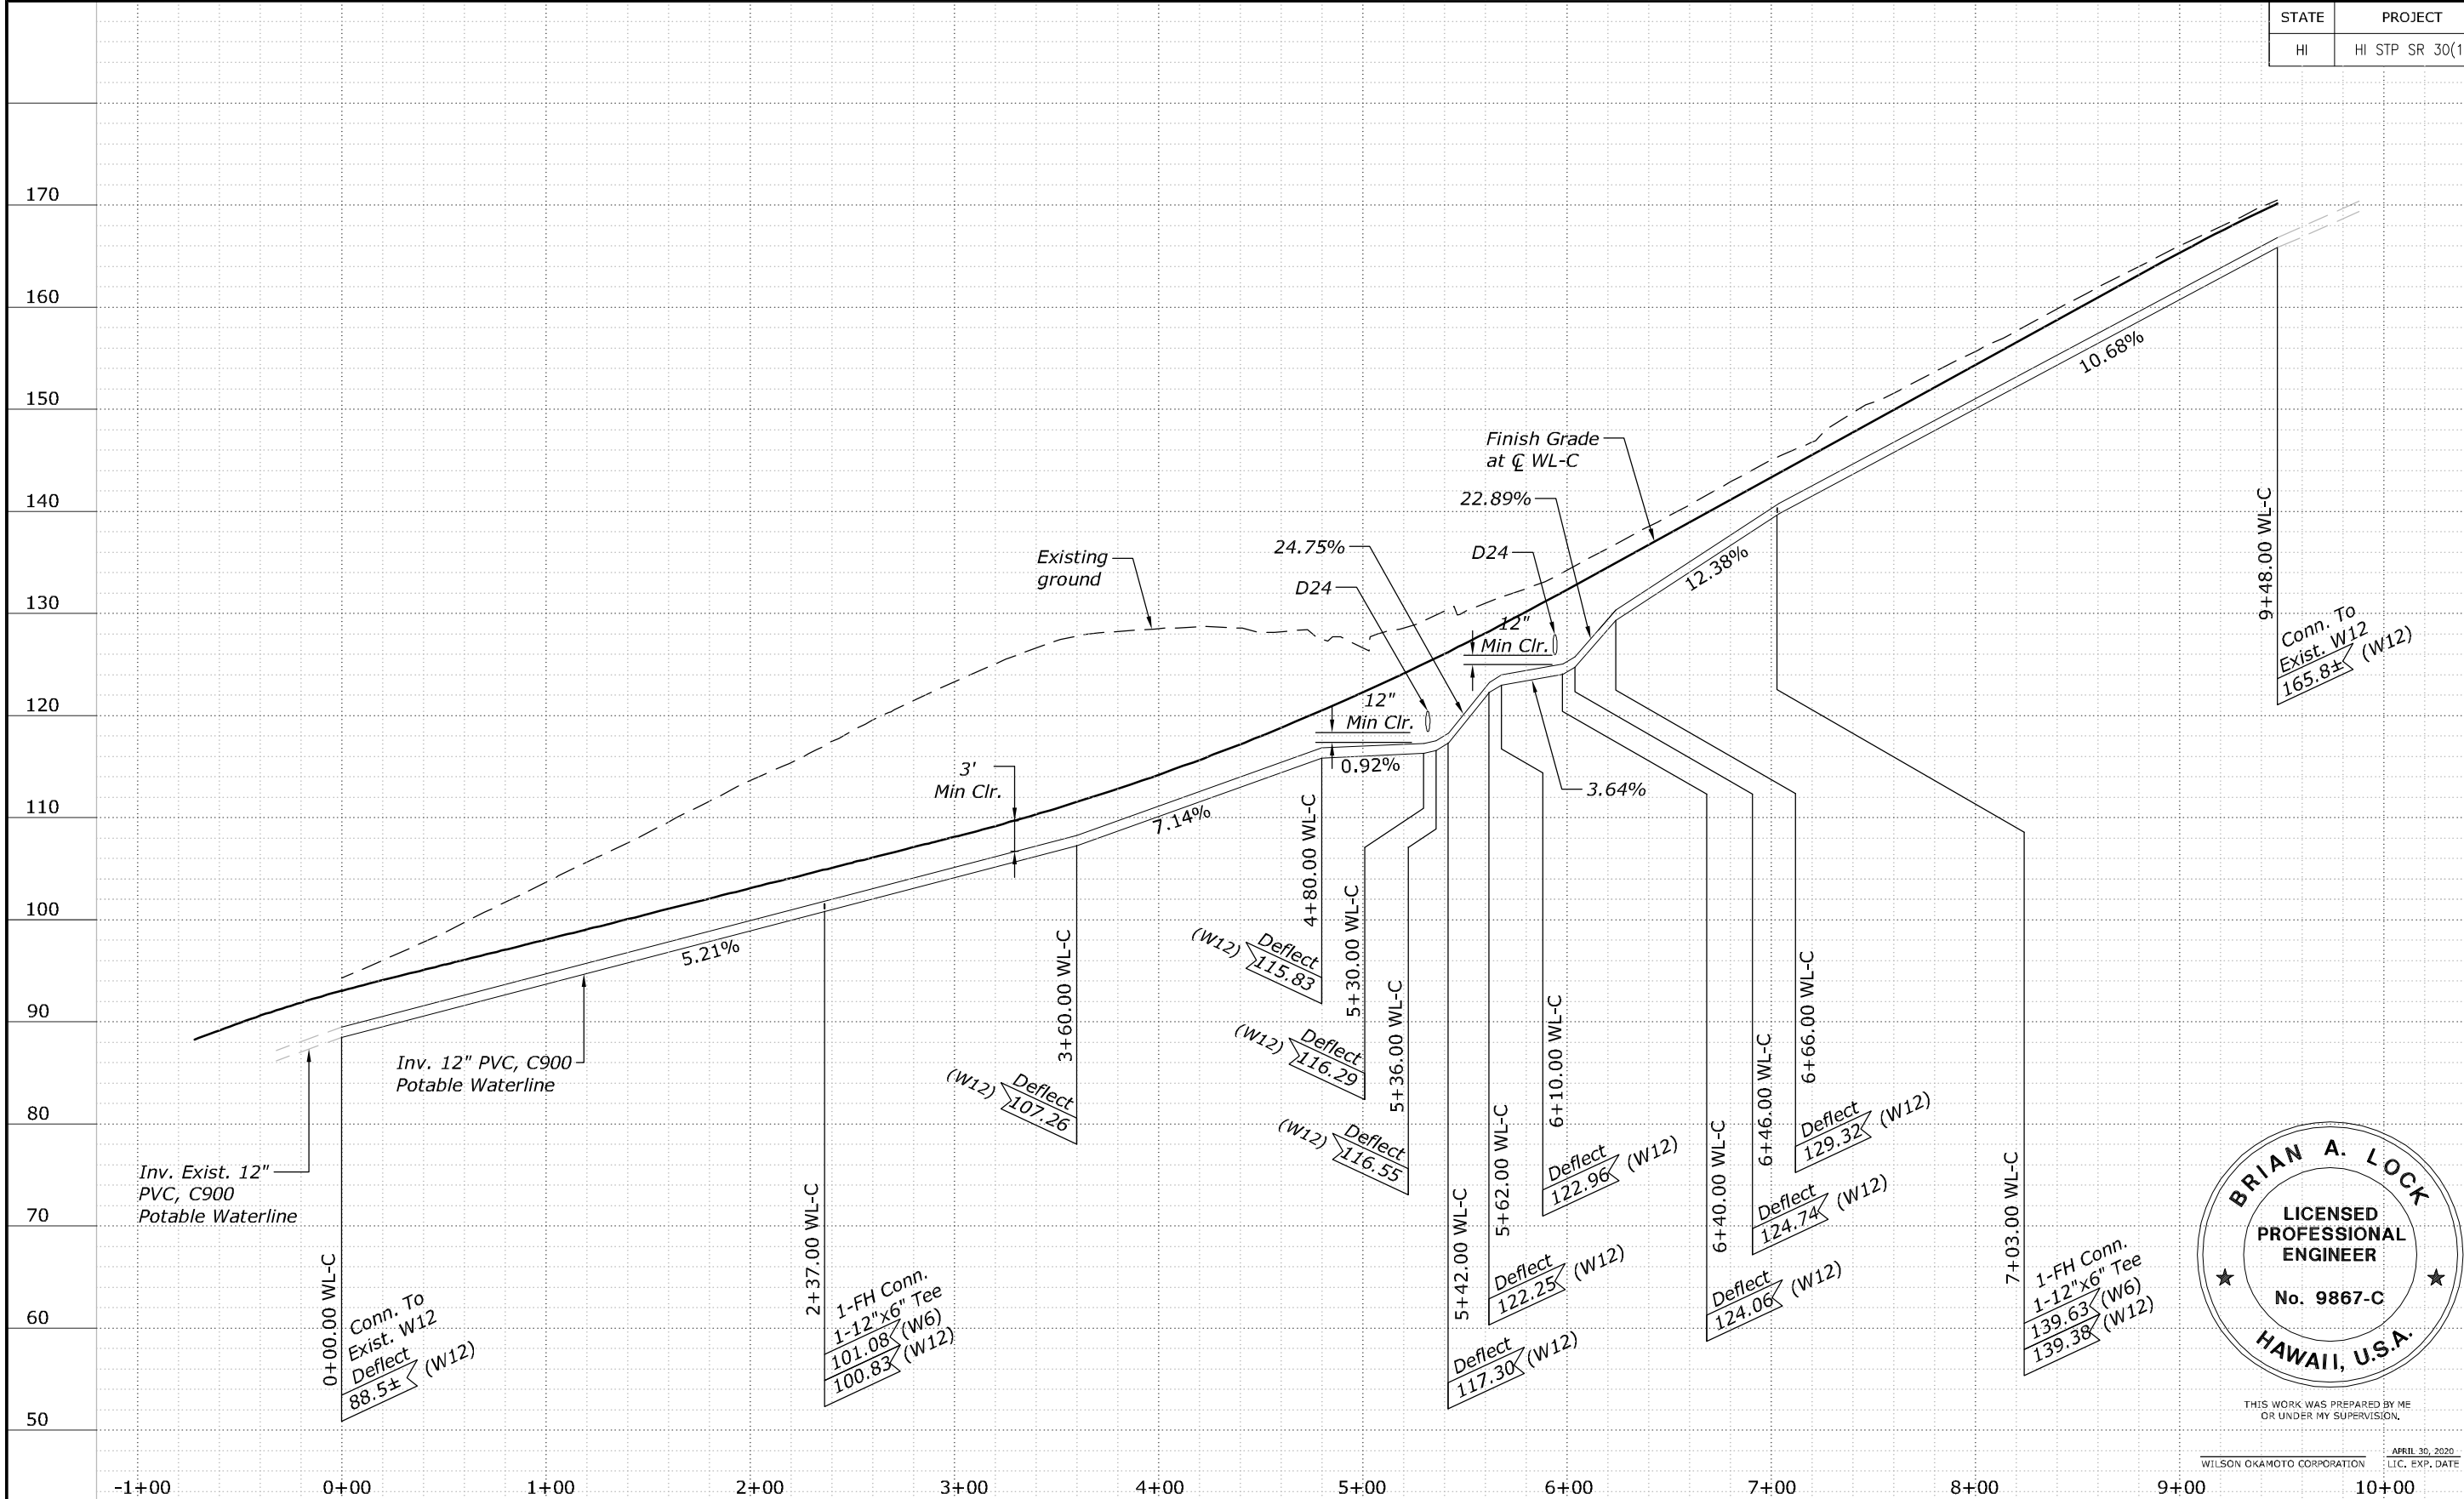


PROFILE - WATERLINE "C"
PUNAKEA LOOP
Scale: V - 1" = 16'
Scale: H - 1" = 80'

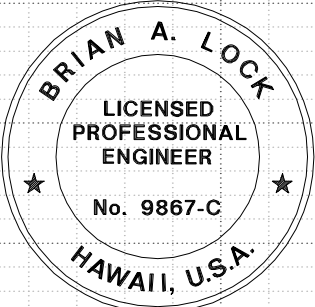


THIS WORK WAS PREPARED BY ME
OR UNDER MY SUPERVISION.
WILSON OKAMOTO CORPORATION
APRIL 30, 2020
LIC. EXP. DATE

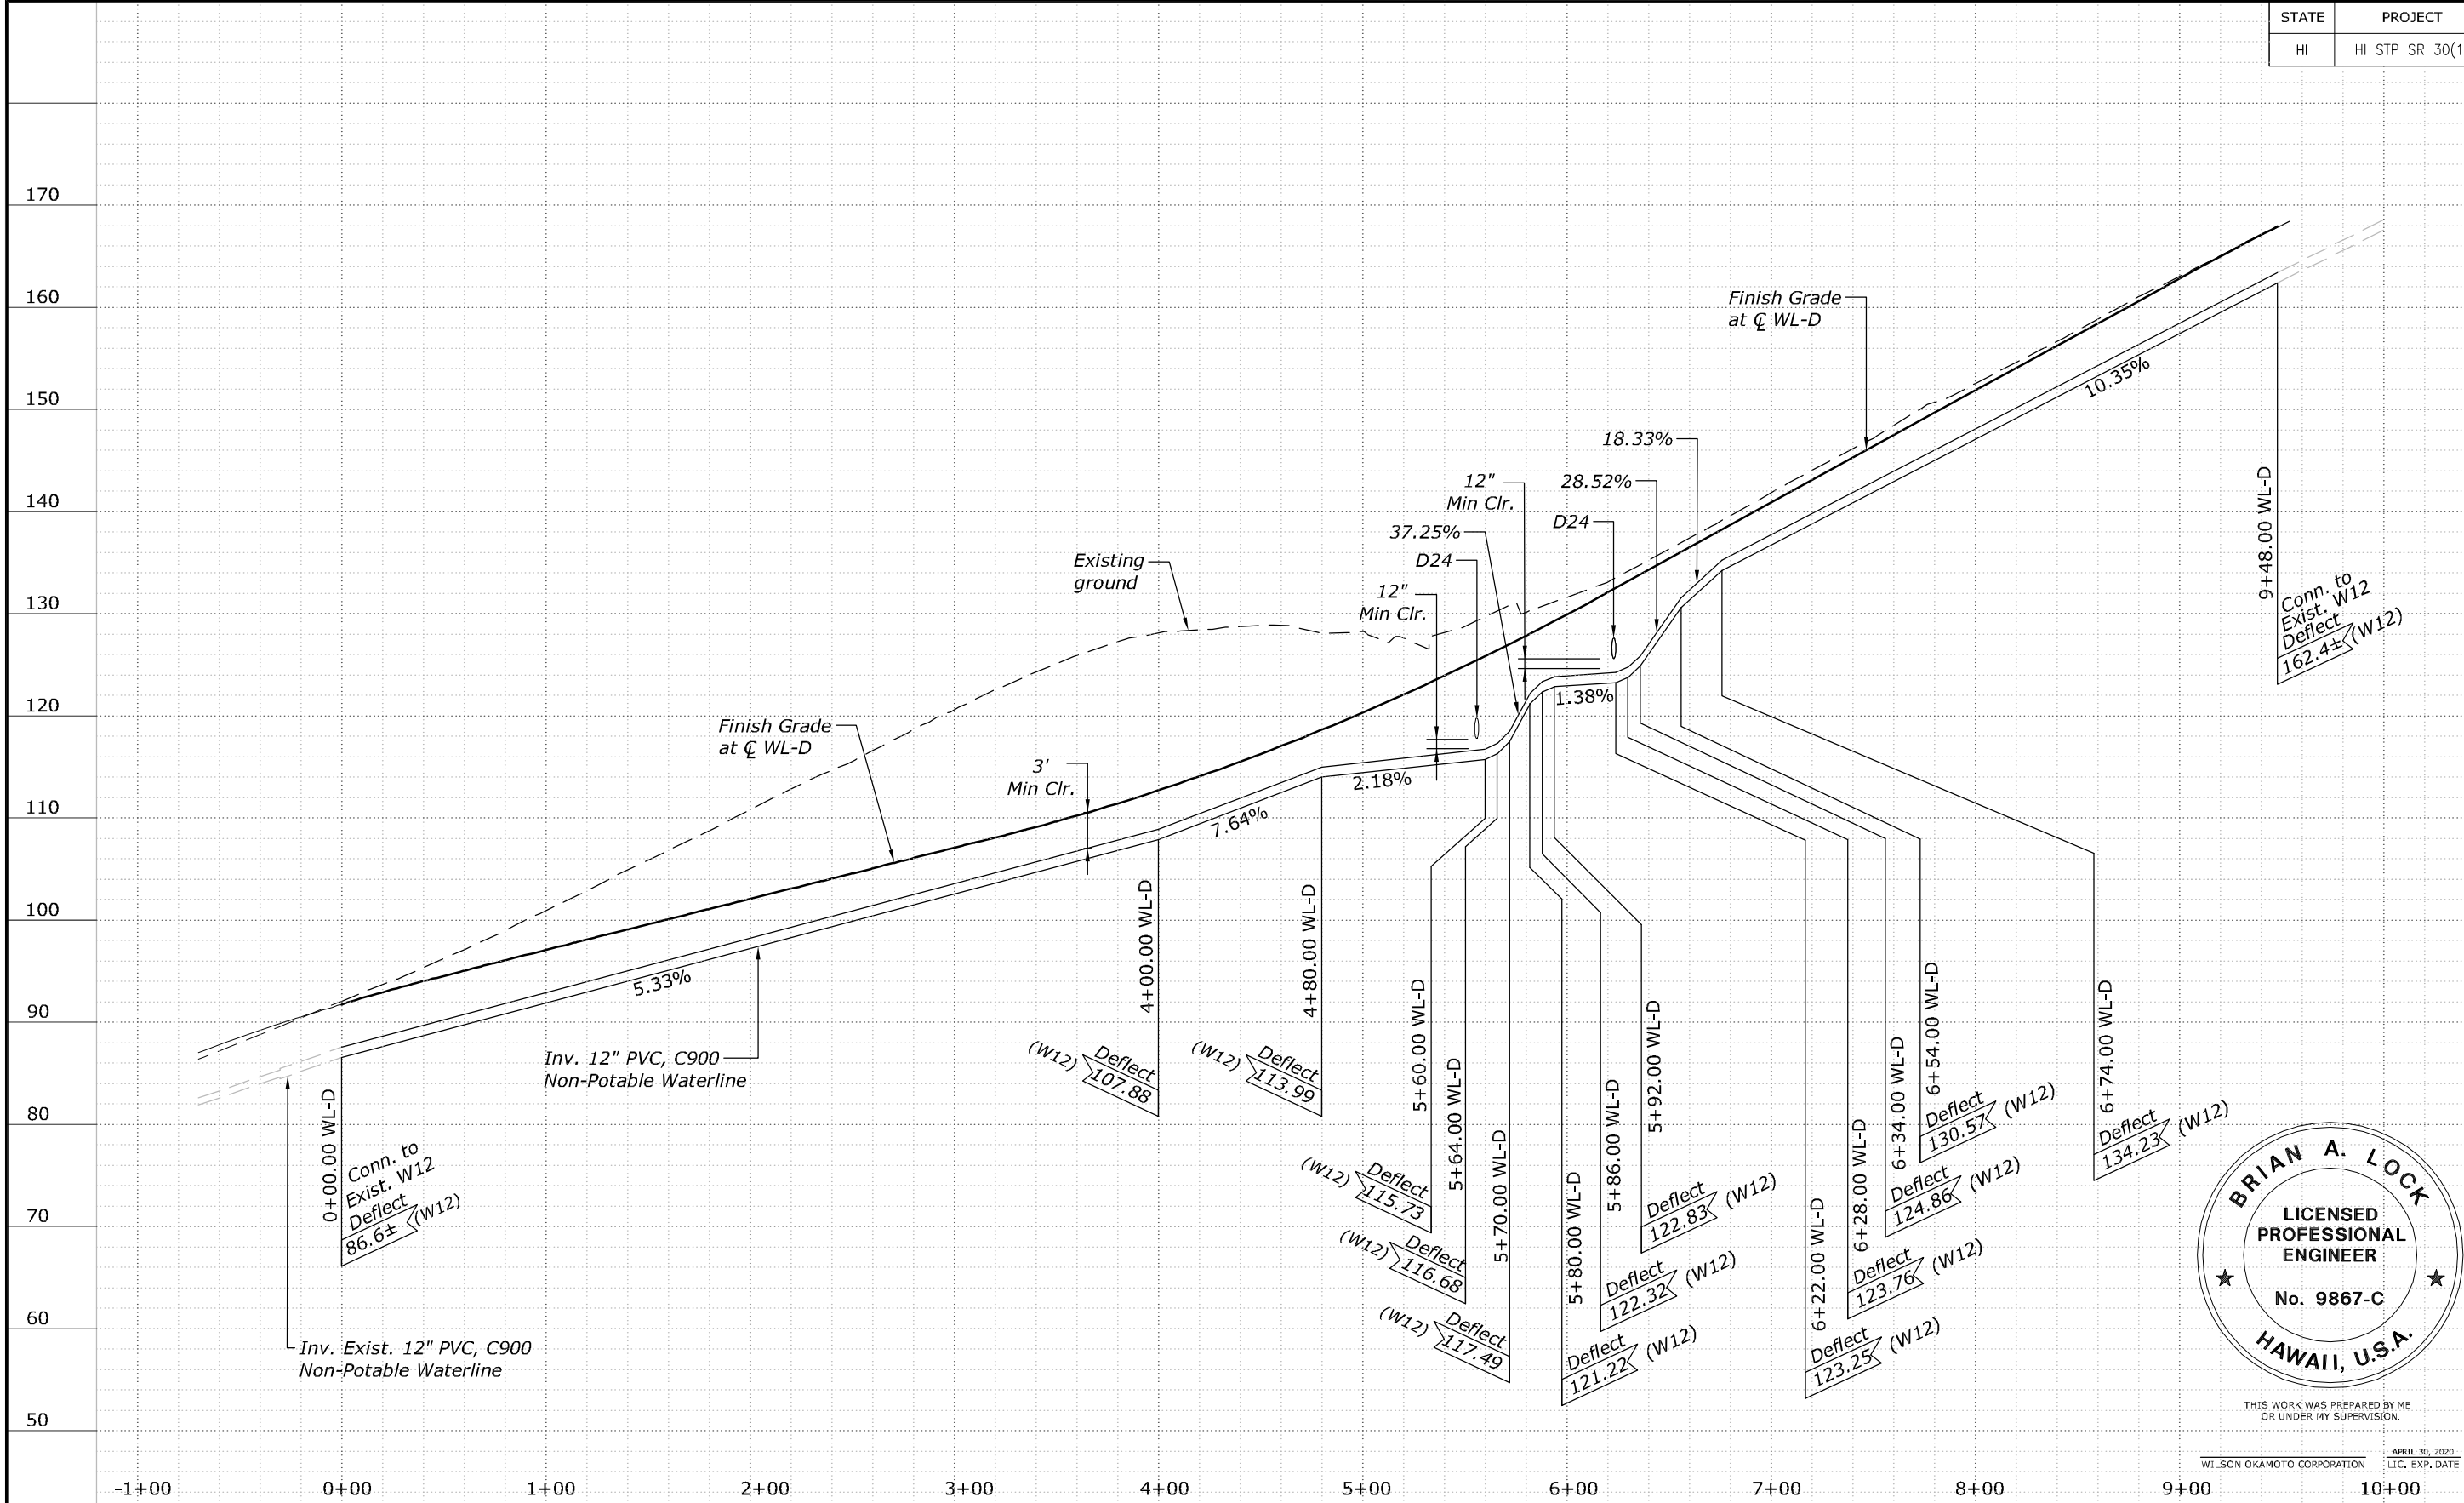


PROFILE - WATERLINE "D"
PUNAKEA LOOP
Scale: V - 1" = 16'
Scale: H - 1" = 80'

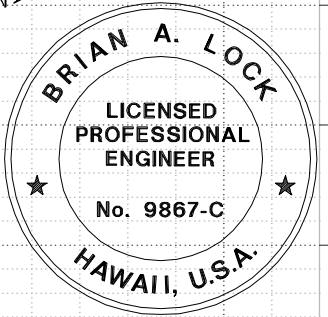



THIS WORK WAS PREPARED BY ME
OR UNDER MY SUPERVISION.
WILSON OKAMOTO CORPORATION
APRIL 30, 2020
LIC. EXP. DATE

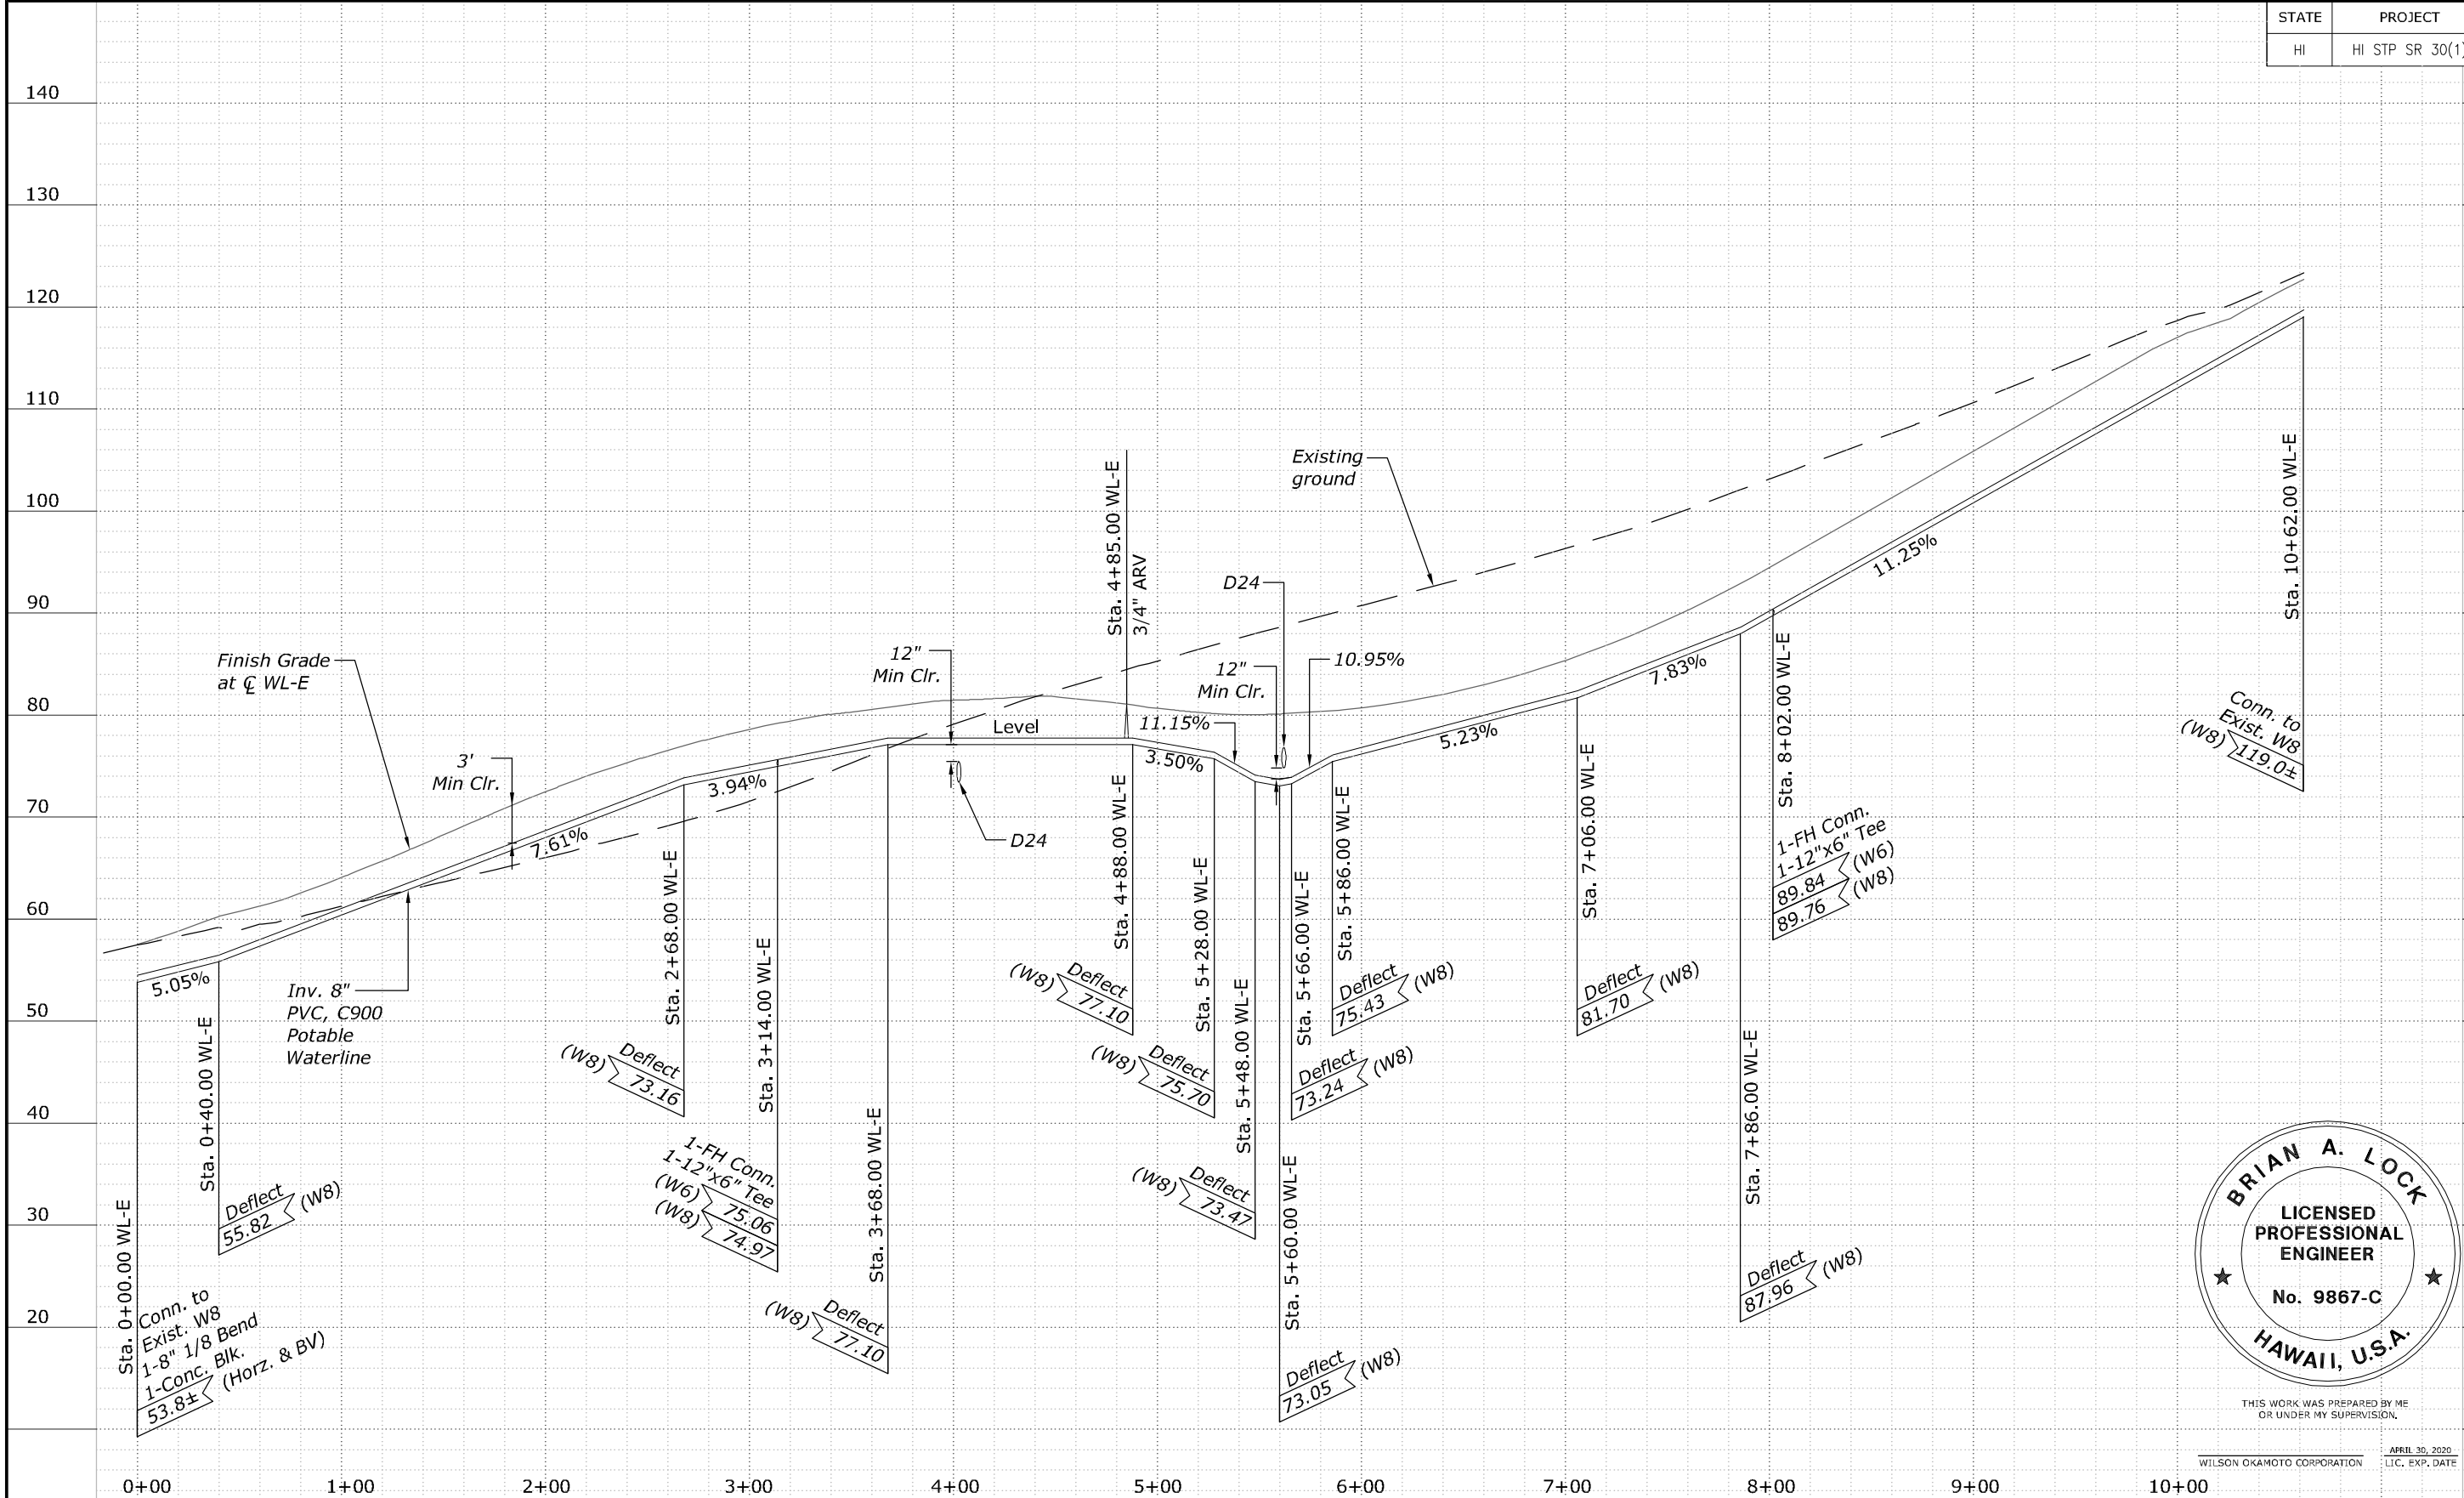

PROFILE - WATERLINE "E"
KAI HELE KU ST.
Scale: V - 1" = 16'
Scale: H - 1" = 80'

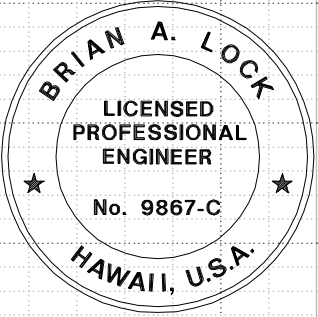


THIS WORK WAS PREPARED BY ME
OR UNDER MY SUPERVISION.
WILSON OKAMOTO CORPORATION
APRIL 30, 2020
LIC. EXP. DATE

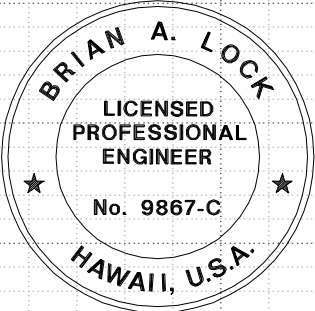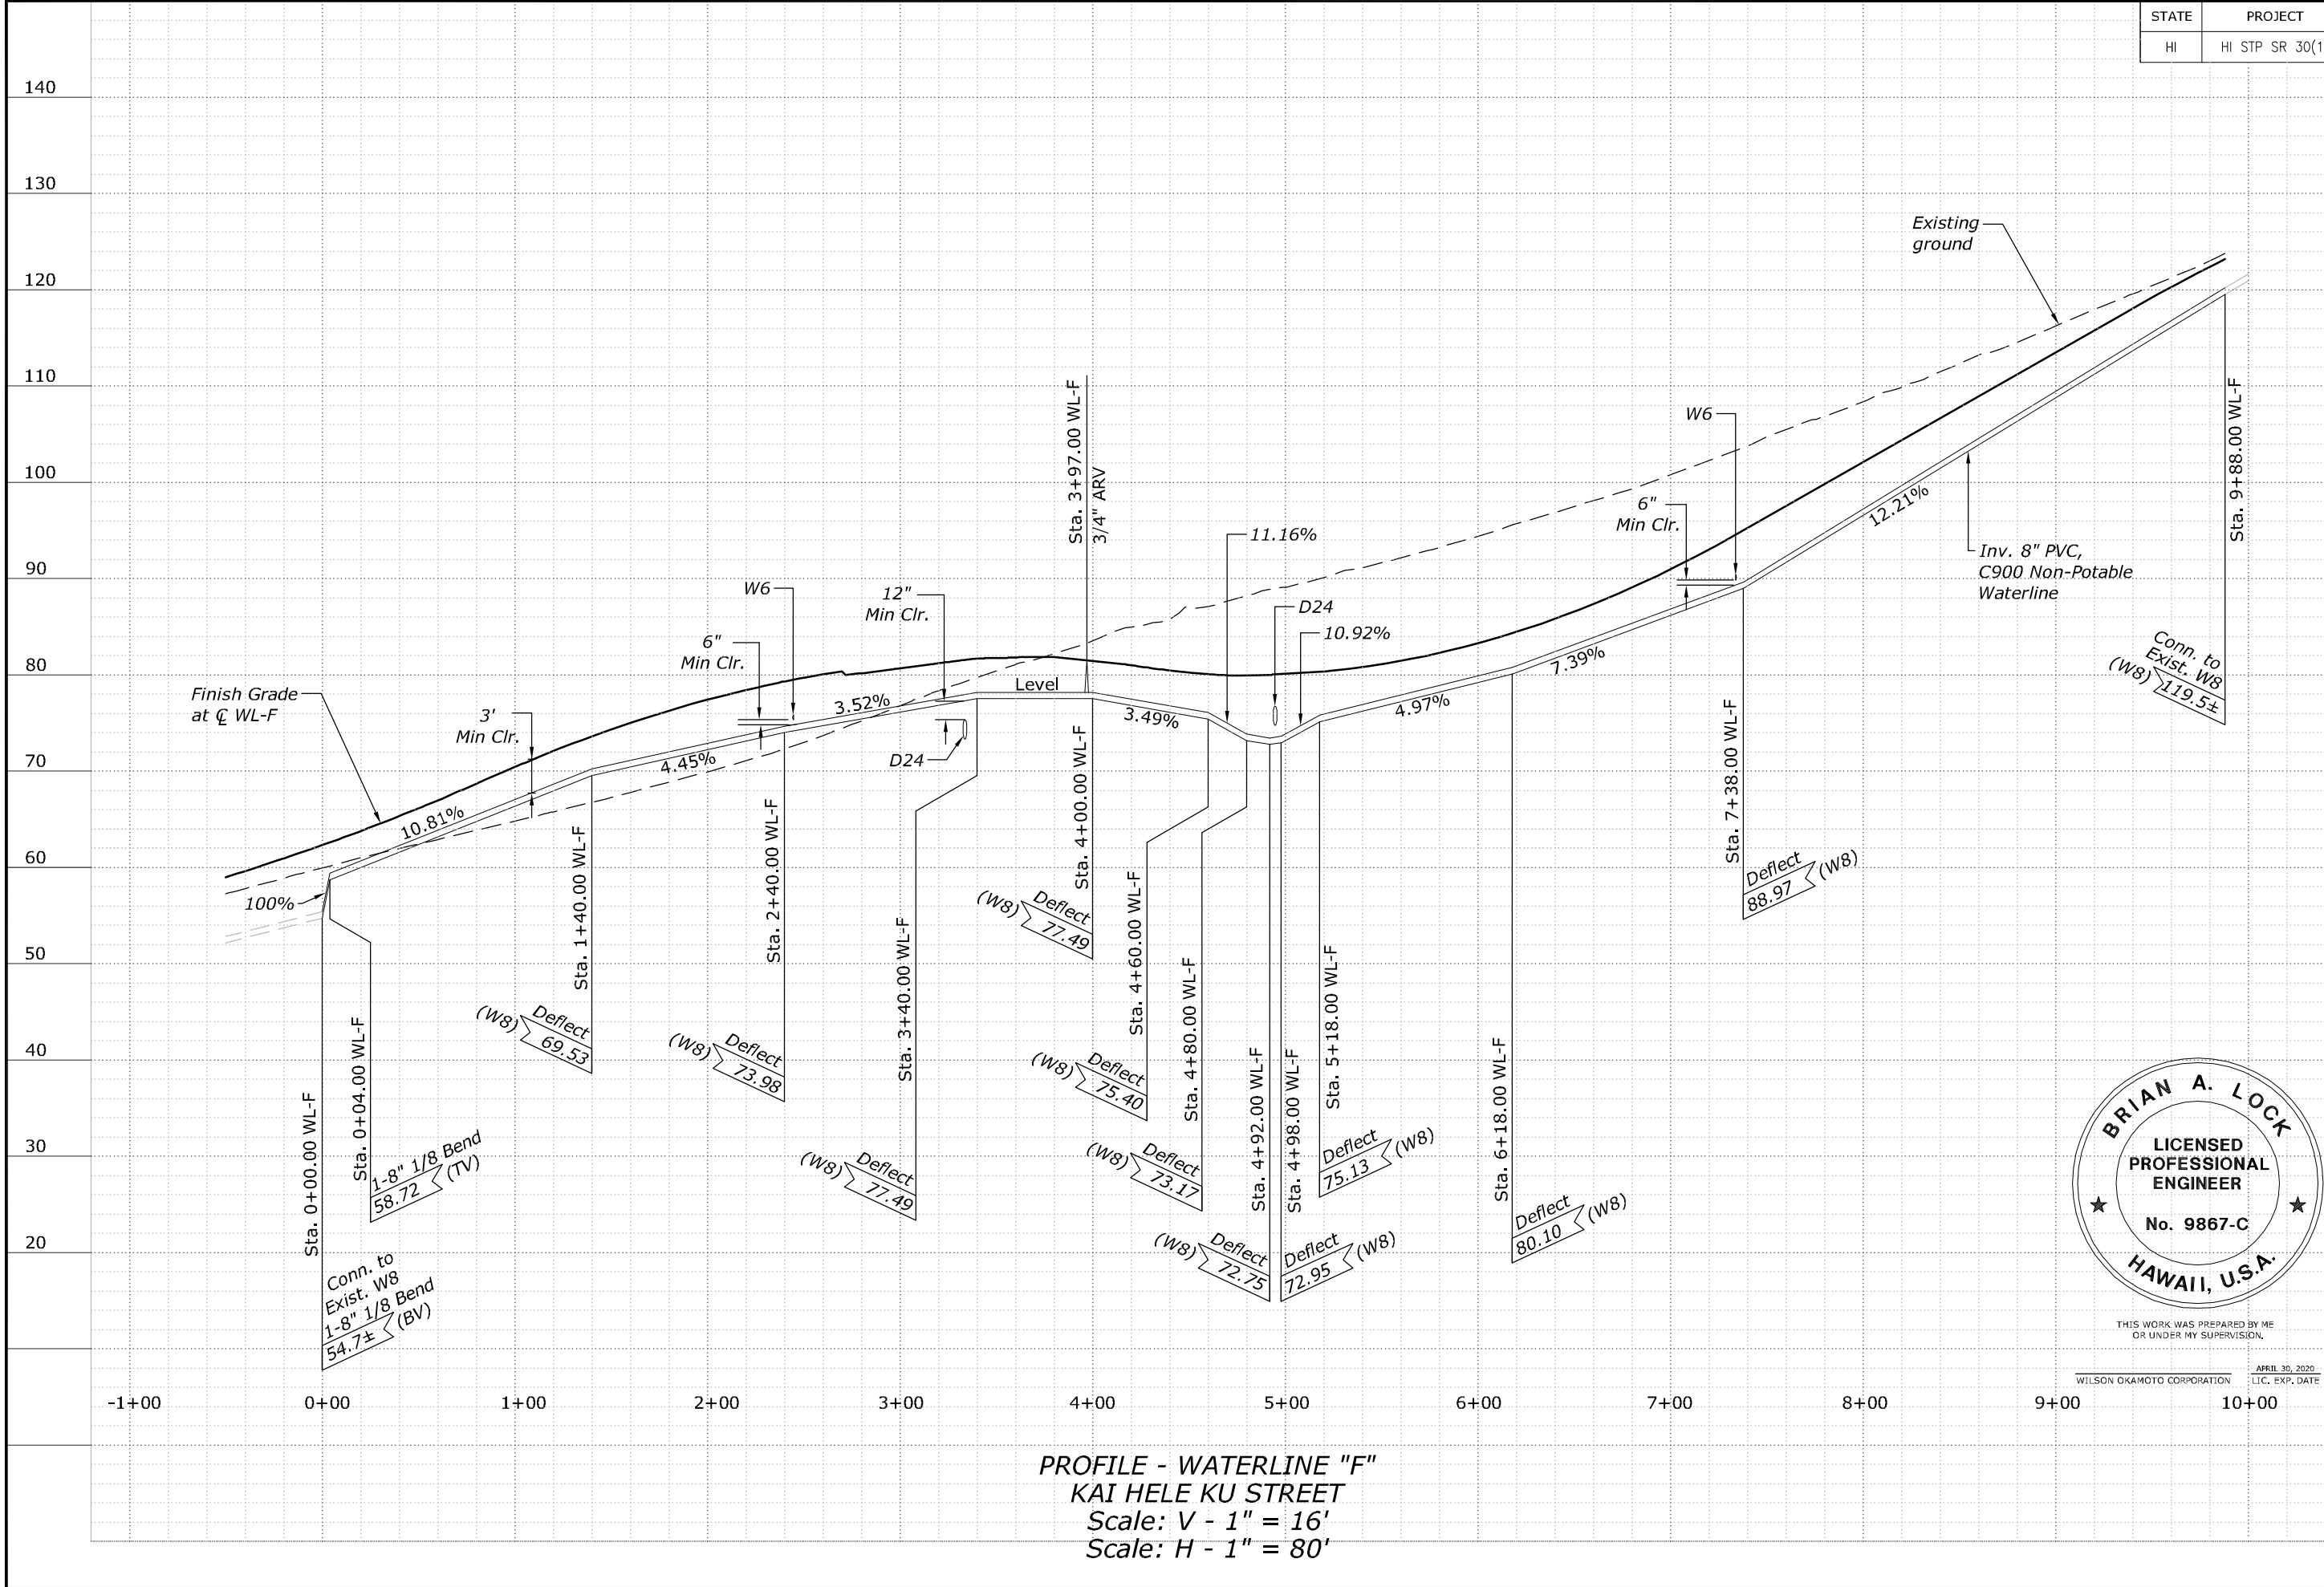


THIS WORK WAS PREPARED BY ME
OR UNDER MY SUPERVISION.
WILSON OKAMOTO CORPORATION
APRIL 30, 2020
LIC. EXP. DATE


STATE	PROJECT	SHEET NO.
HI	HI STP SR 30(1)	T44

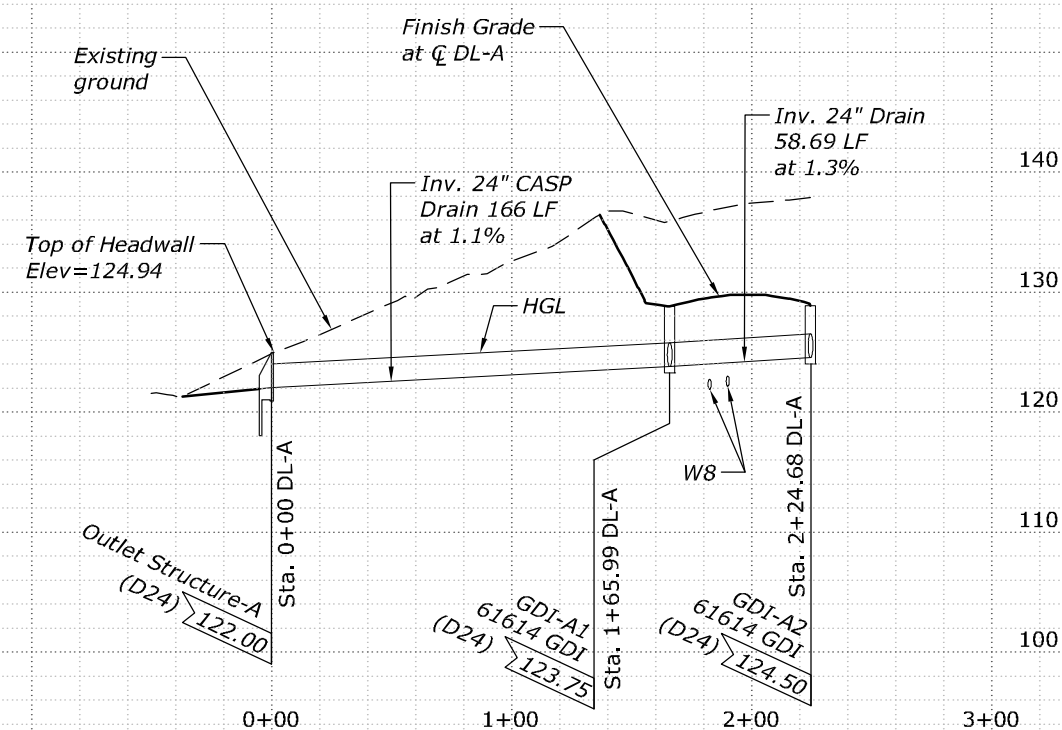


PROFILE - DRAINLINE "A"

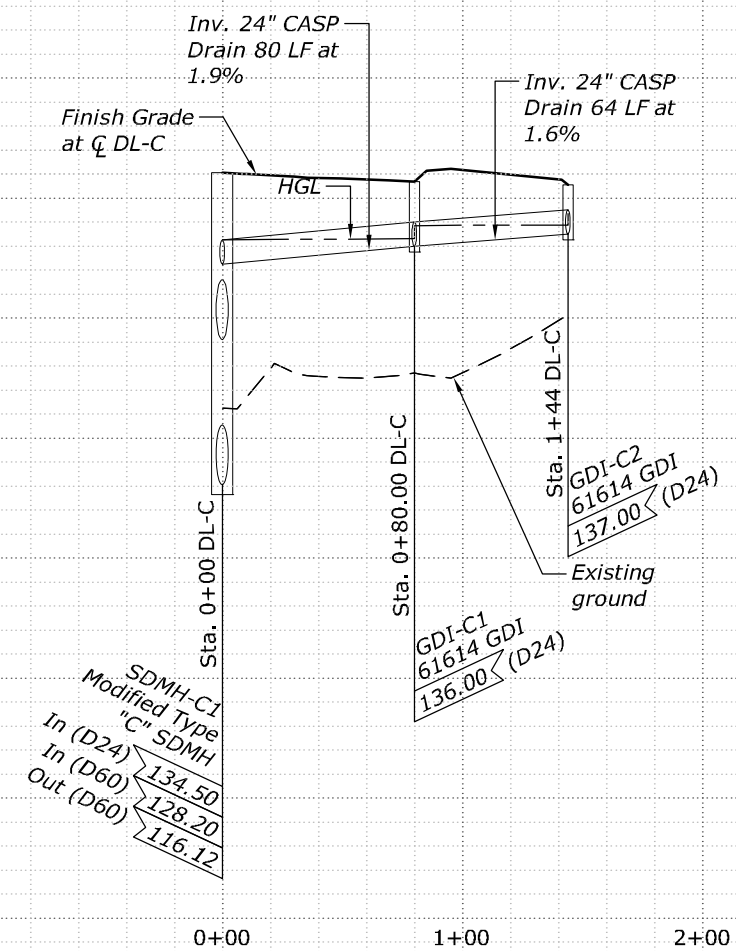


PROFILE - DRAINLINE "C"

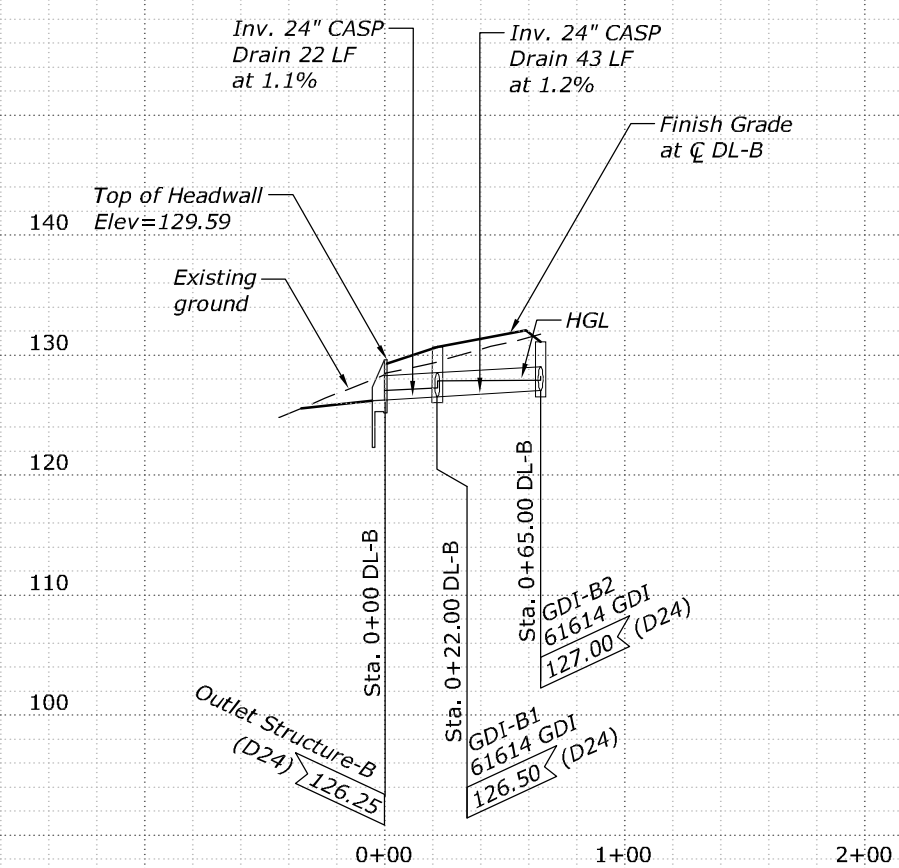


PROFILE - DRAINLINE "B"

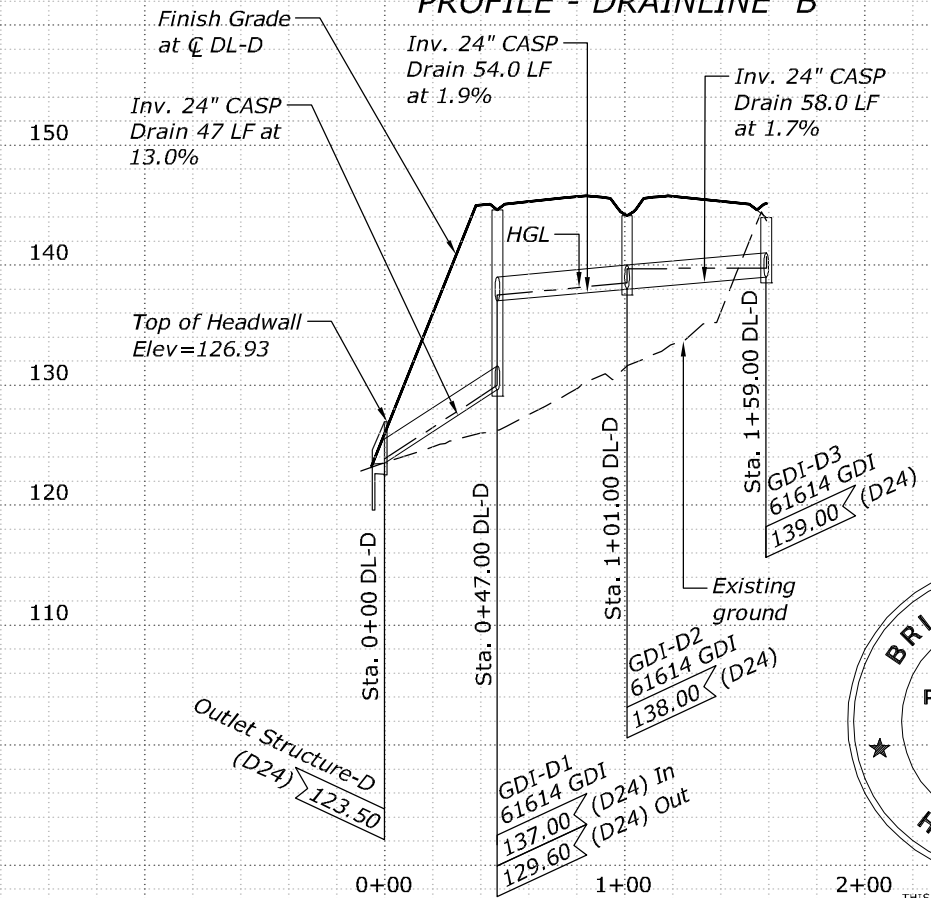


PROFILE - DRAINLINE "D"

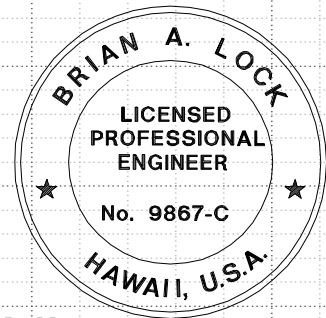


THIS WORK WAS PREPARED BY ME
OR UNDER MY SUPERVISION,
APRIL 30, 2020
WILSON OKAMOTO CORPORATION LIC. EXP. DATE

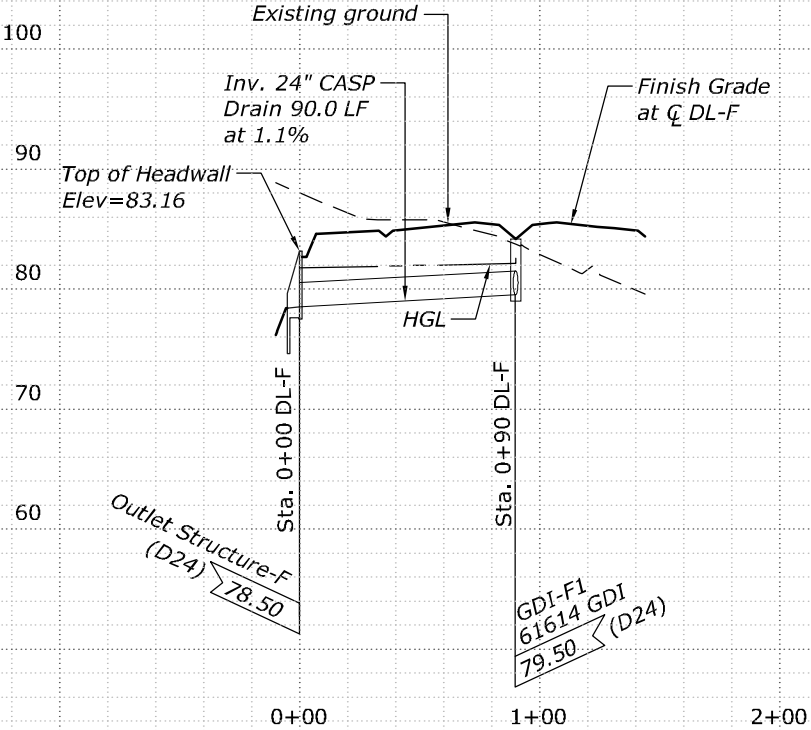


PROFILE - DRAINLINE "F"

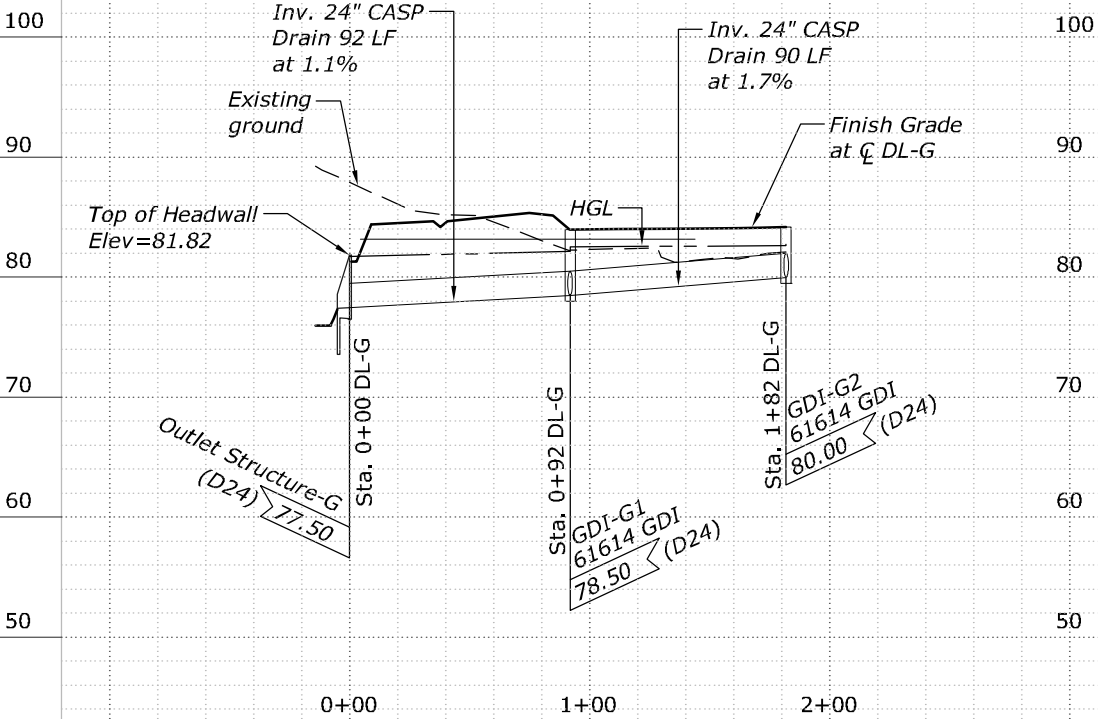

PROFILE - DRAINLINE "G"

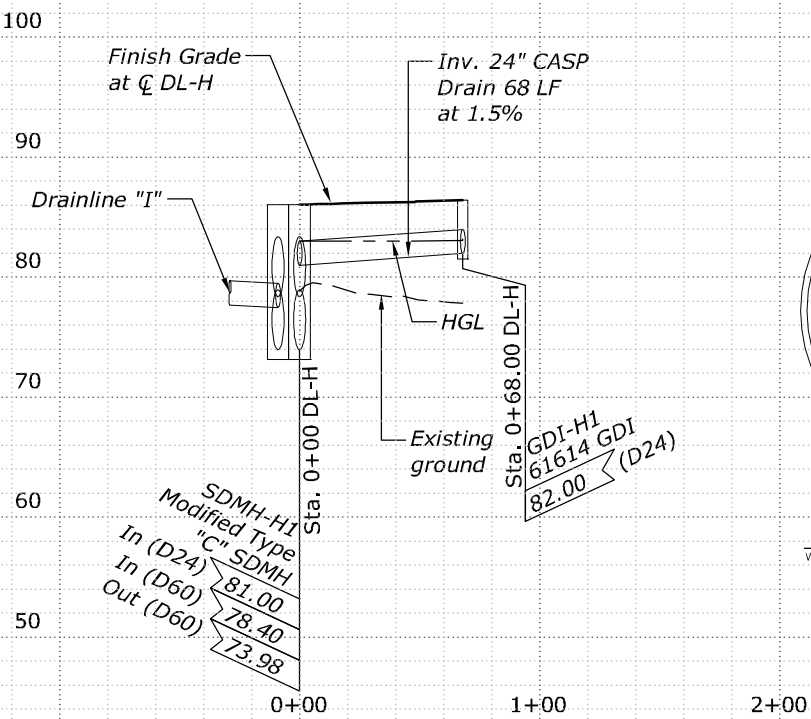


PROFILE - DRAINLINE "H"

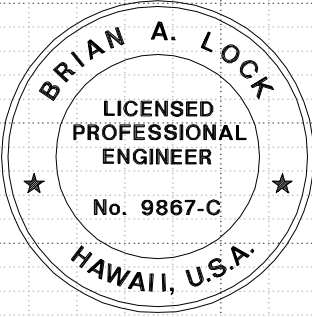


THIS WORK WAS PREPARED BY ME OR UNDER MY SUPERVISION.
WILSON OKAMOTO CORPORATION
APRIL 30, 2020
LIC. EXP. DATE

STATE	PROJECT	SHEET NO.
HI	HI STP SR 30(1)	T46

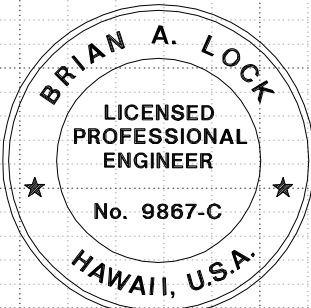


THIS WORK WAS PREPARED BY ME
OR UNDER MY SUPERVISION.


WILSON OKAMOTO CORPORATION
APRIL 30, 2020
LIC. EXP. DATE

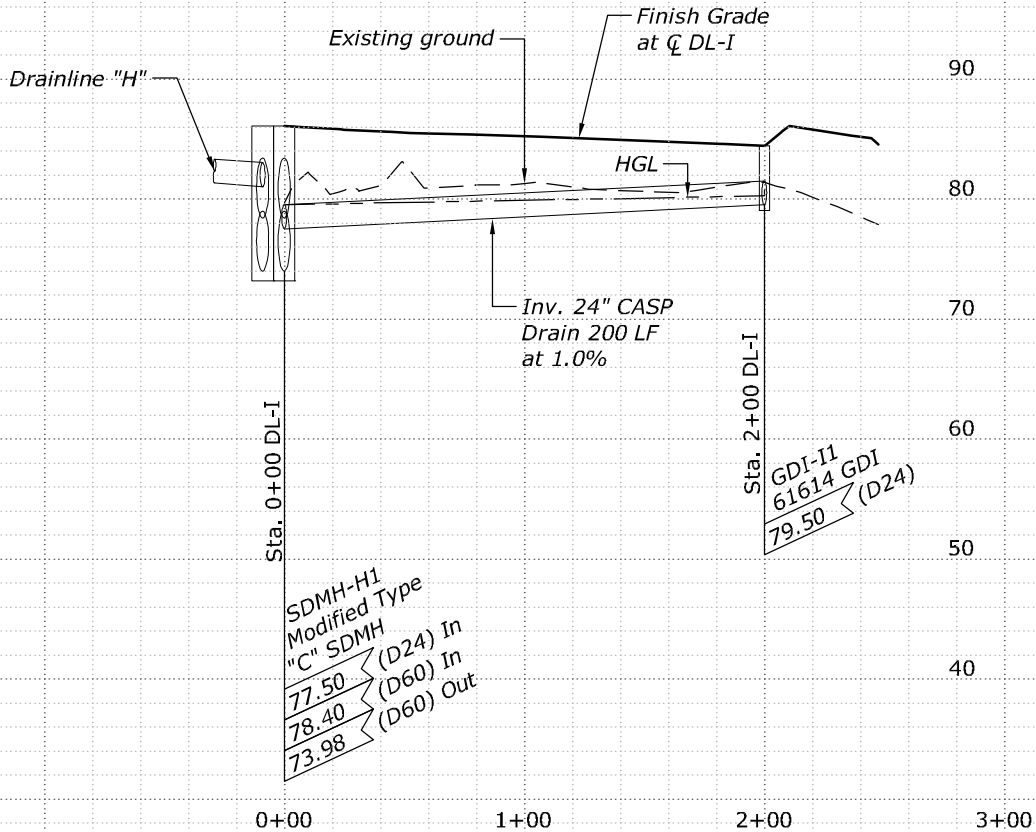


PROFILE - DRAINLINE "I"

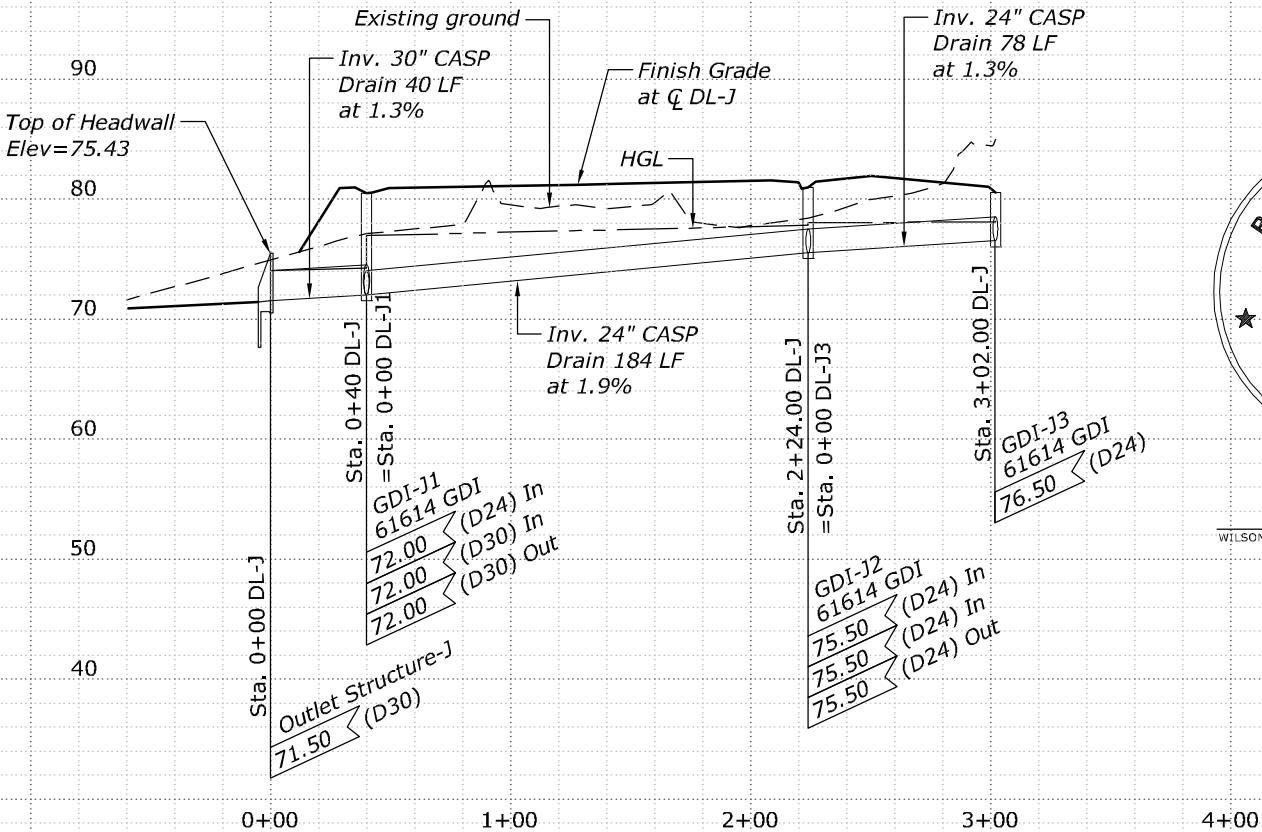


PROFILE - DRAINLINE "J"

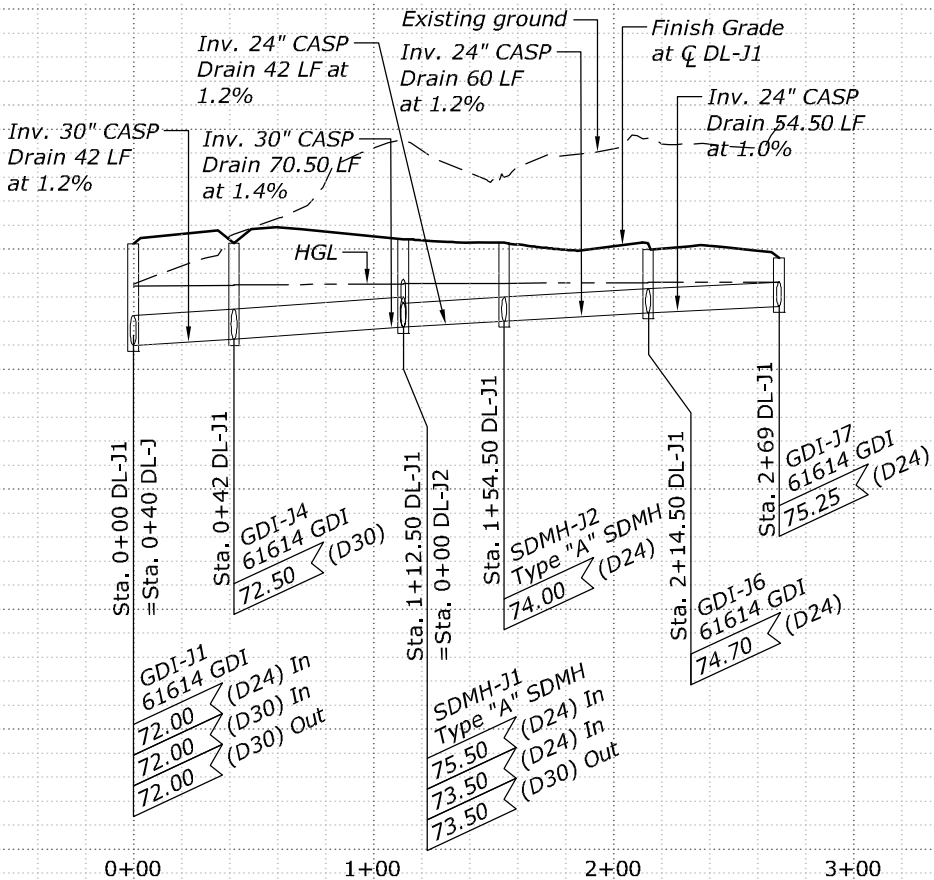




PROFILE - DRAINLINE "J1"

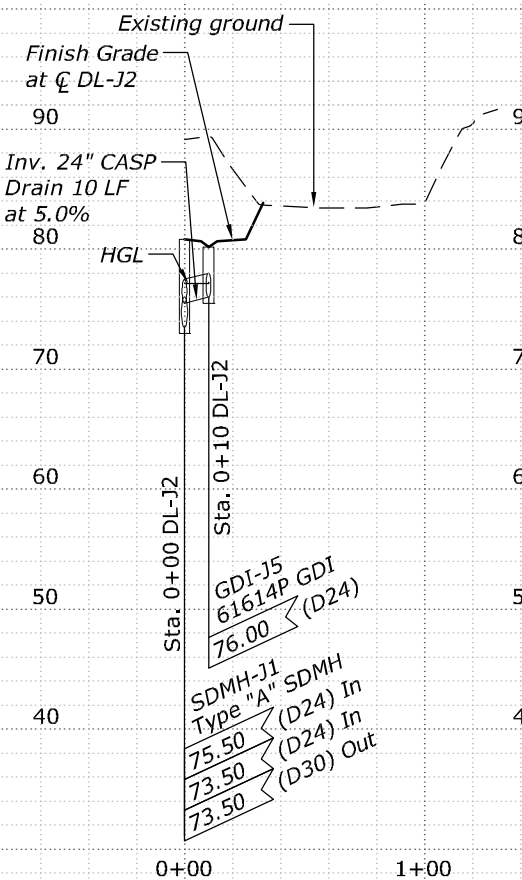

PROFILE - DRAINLINE "J2"

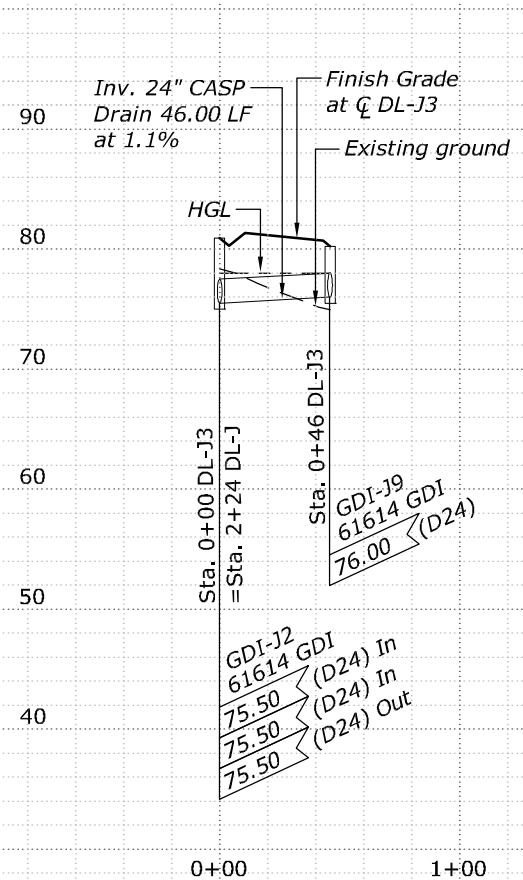


PROFILE - DRAINLINE "J3"

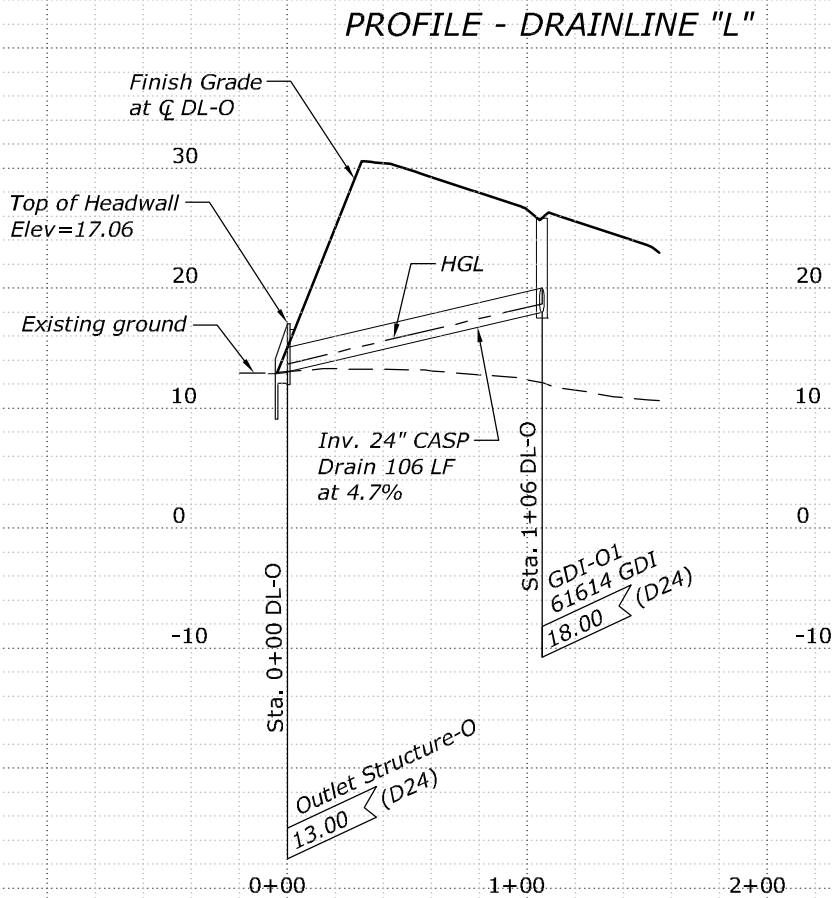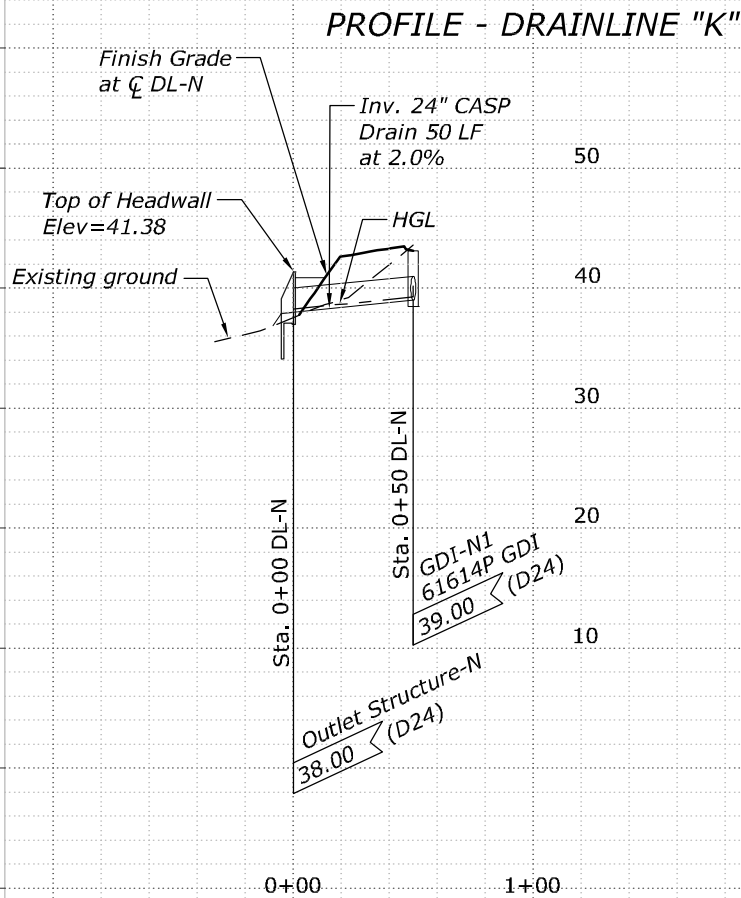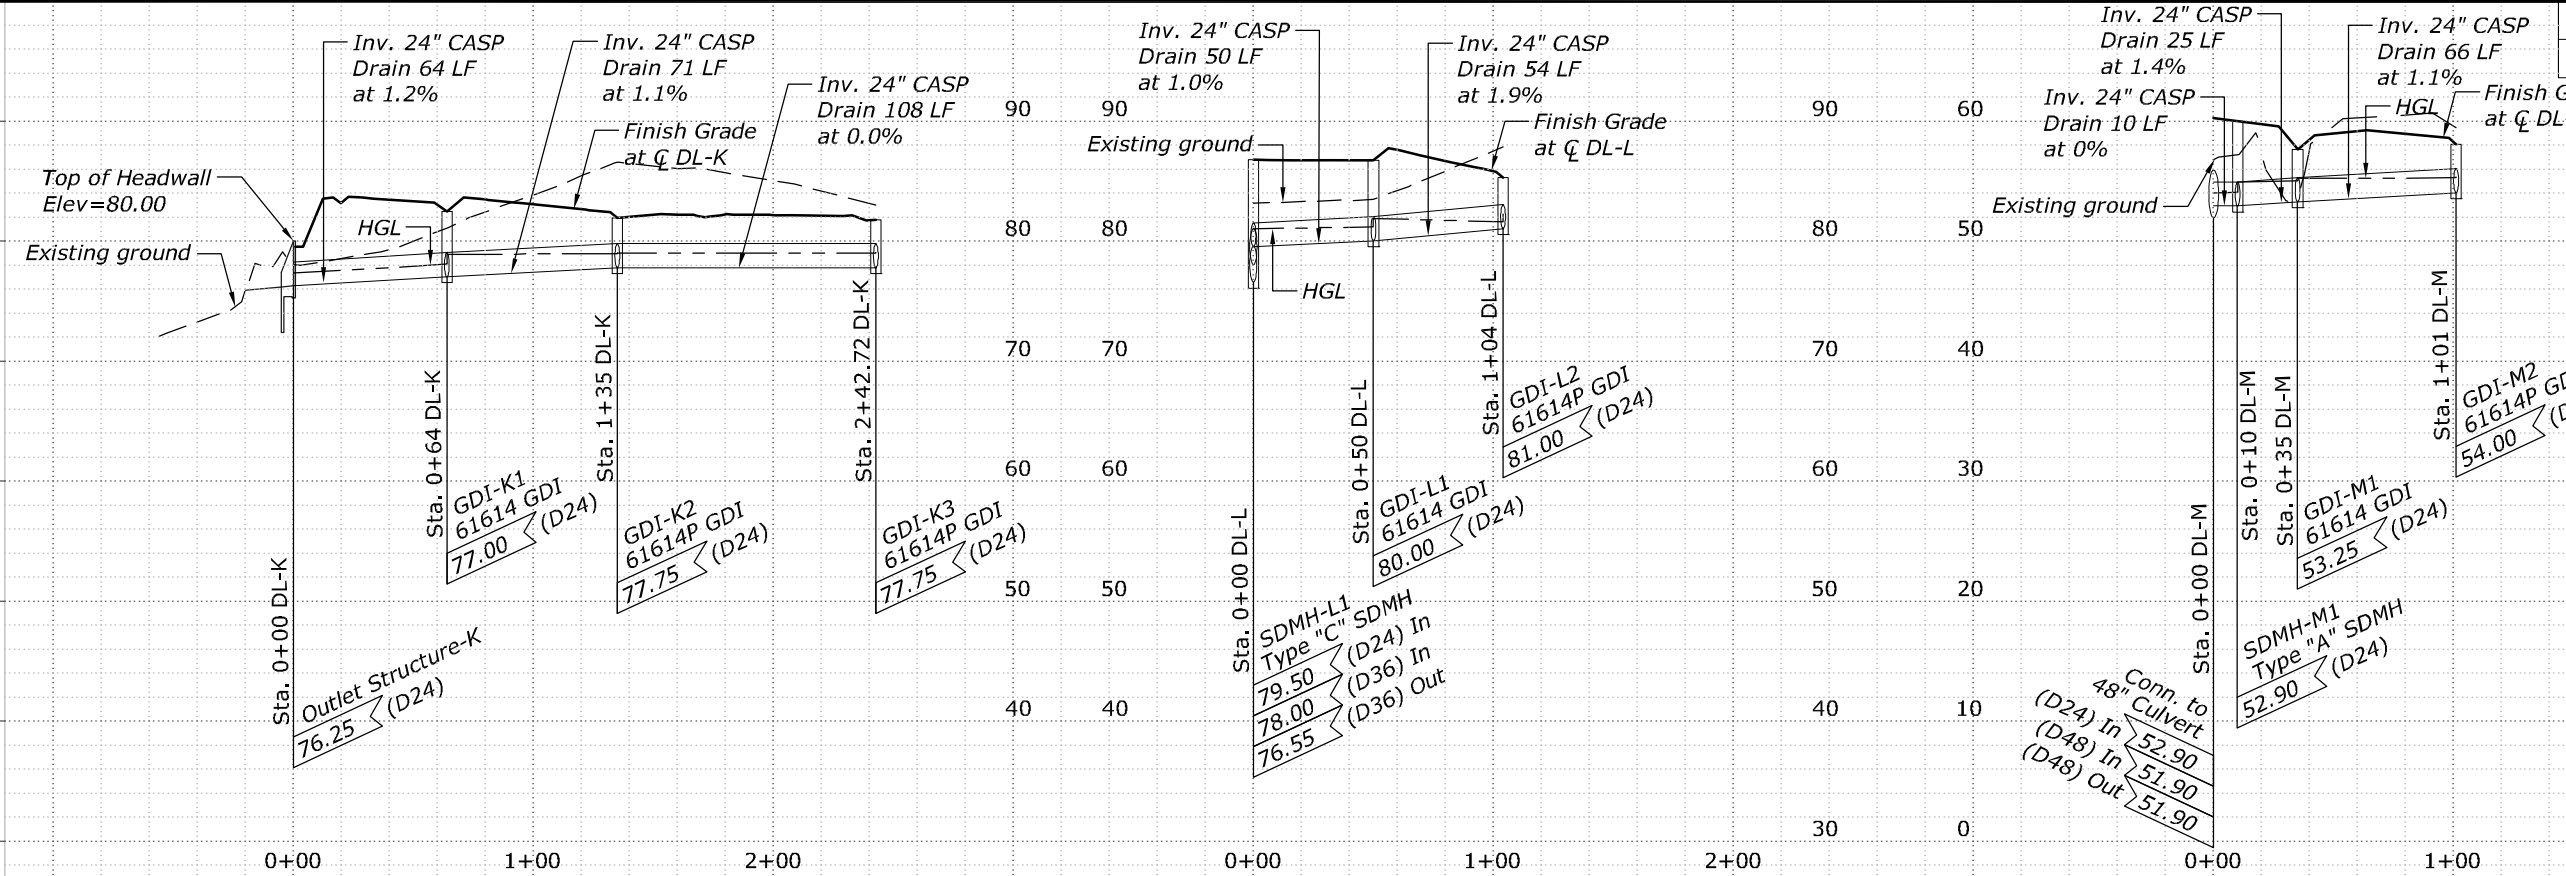


BRIAN A. LOCK
LICENSED PROFESSIONAL ENGINEER
No. 9867-C
HAWAII, U.S.A.

THIS WORK WAS PREPARED BY ME OR UNDER MY SUPERVISION.






WILSON OKAMOTO CORPORATION
APRIL 30, 2020
LIC. EXP. DATE

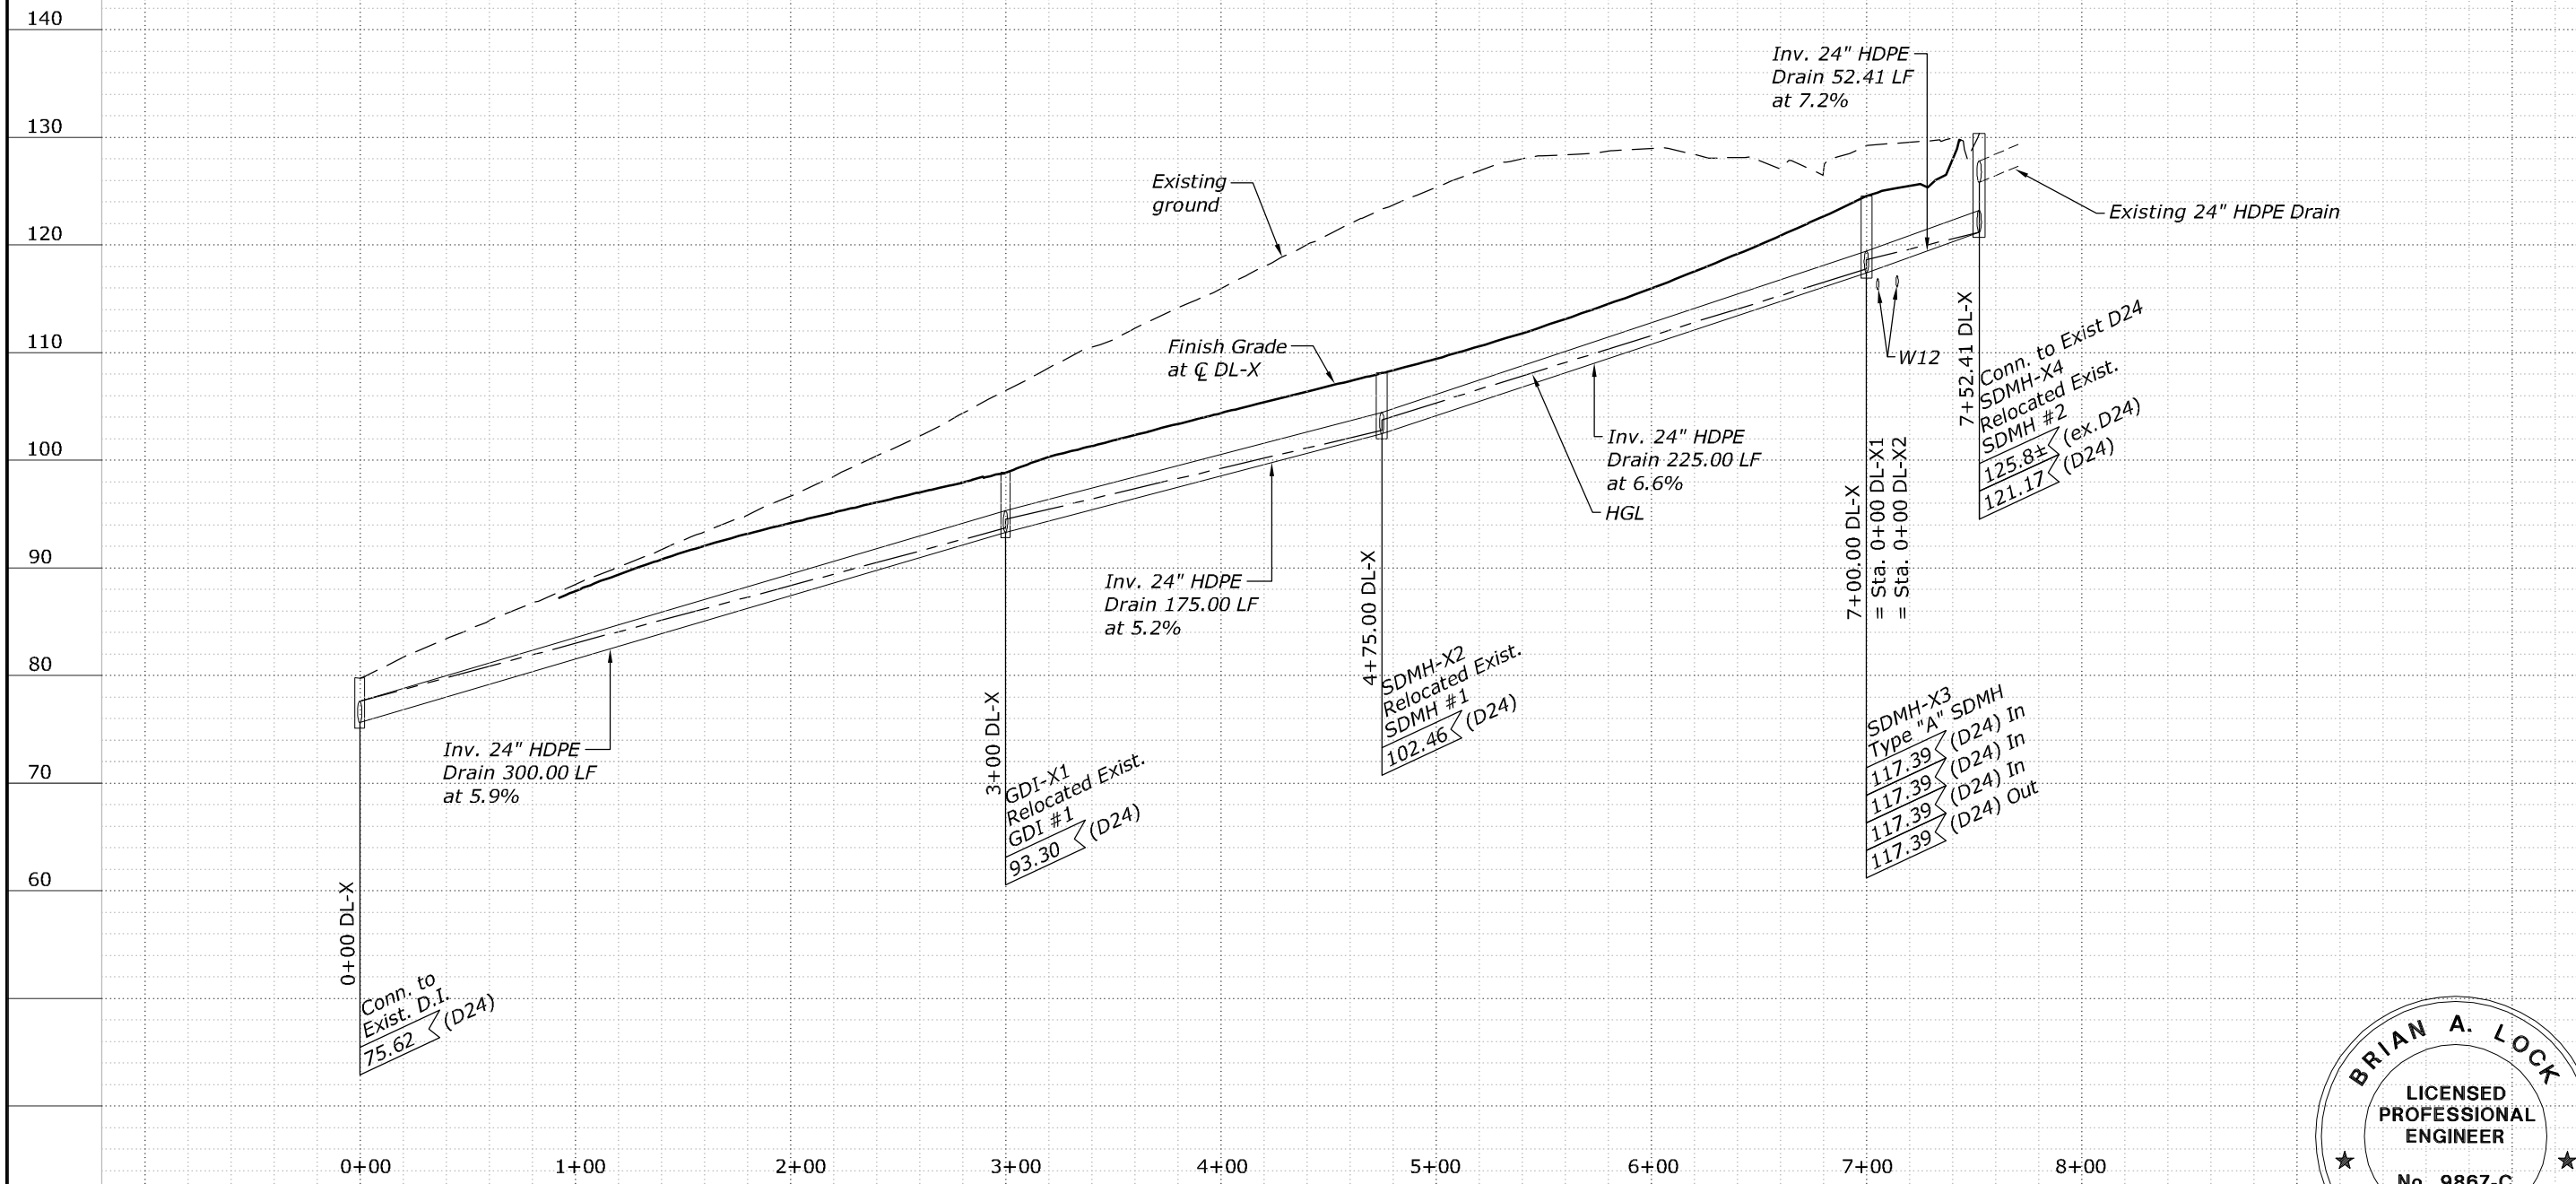

PROFILE - DRAINLINE "X"

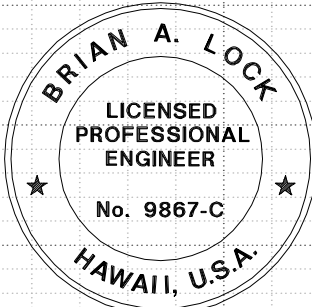

THIS WORK WAS PREPARED BY ME OR UNDER MY SUPERVISION.
WILSON OKAMOTO CORPORATION
APRIL 30, 2020
LIC. EXP. DATE

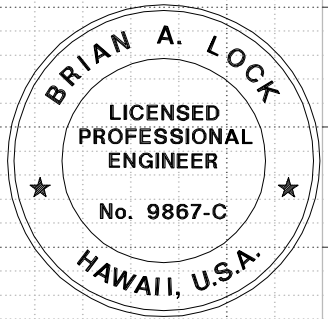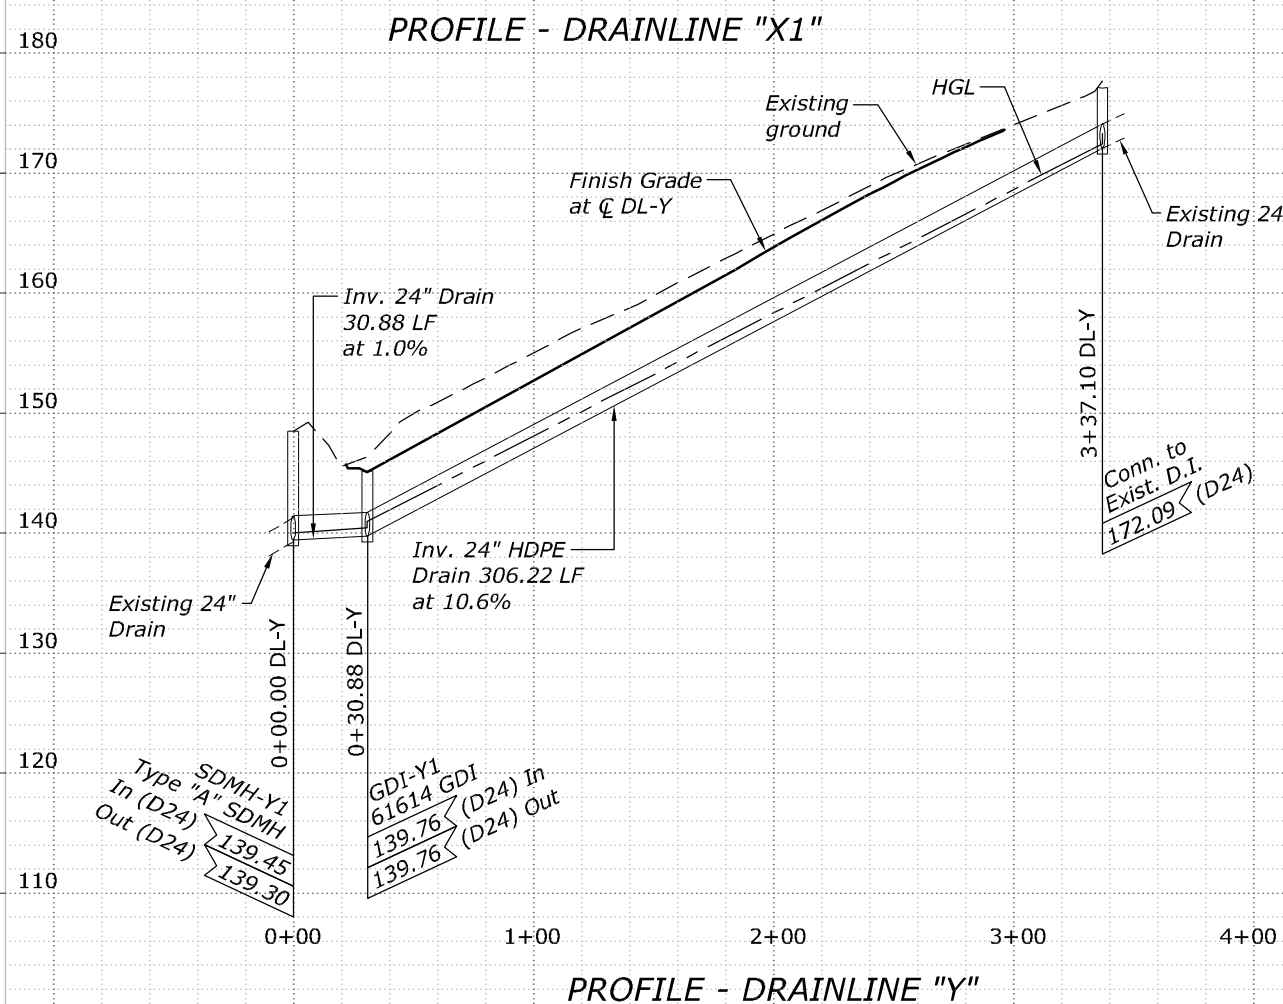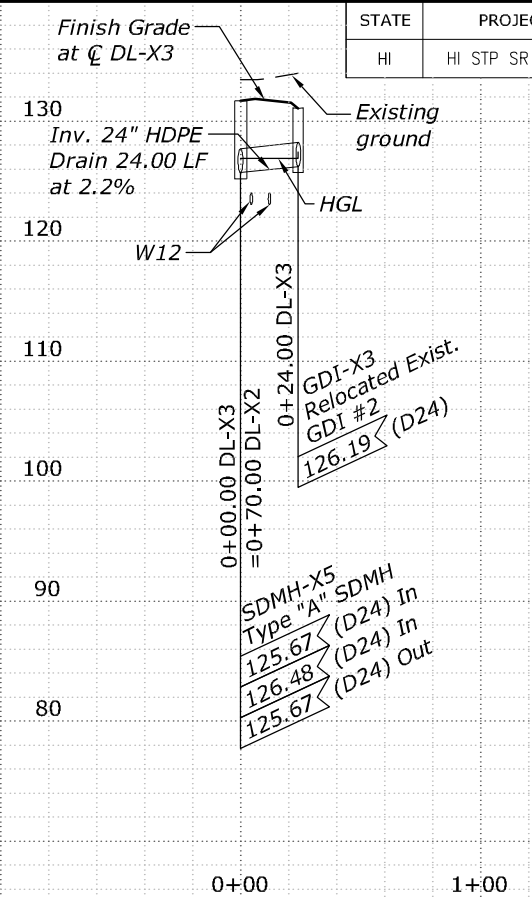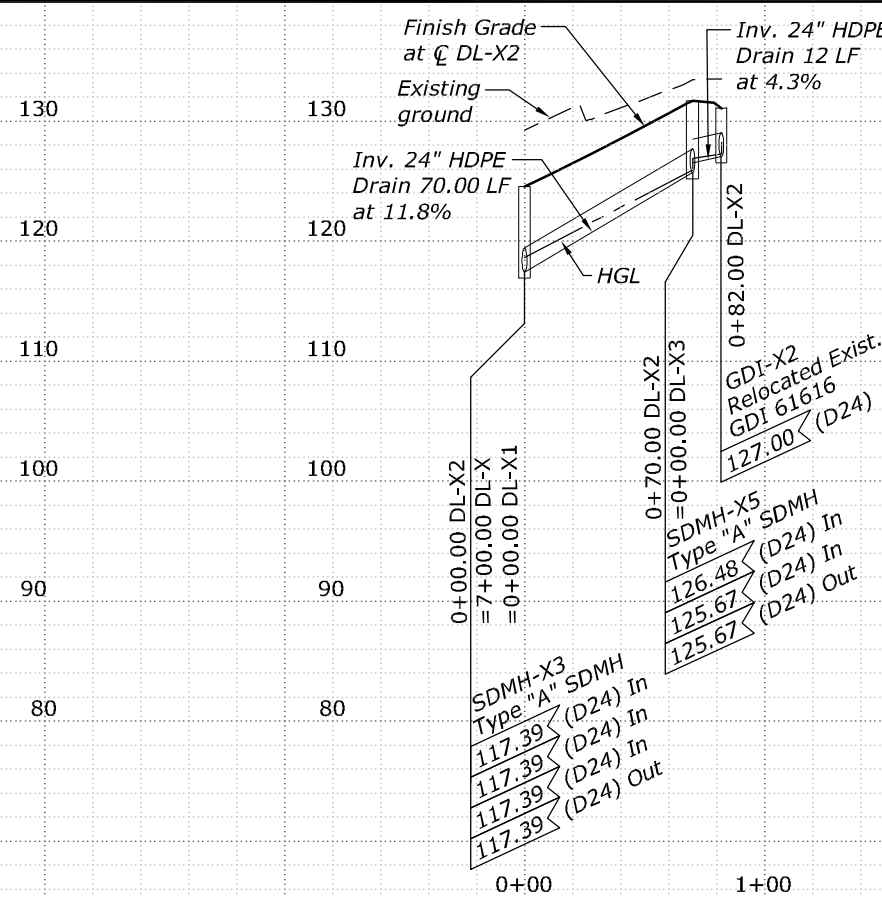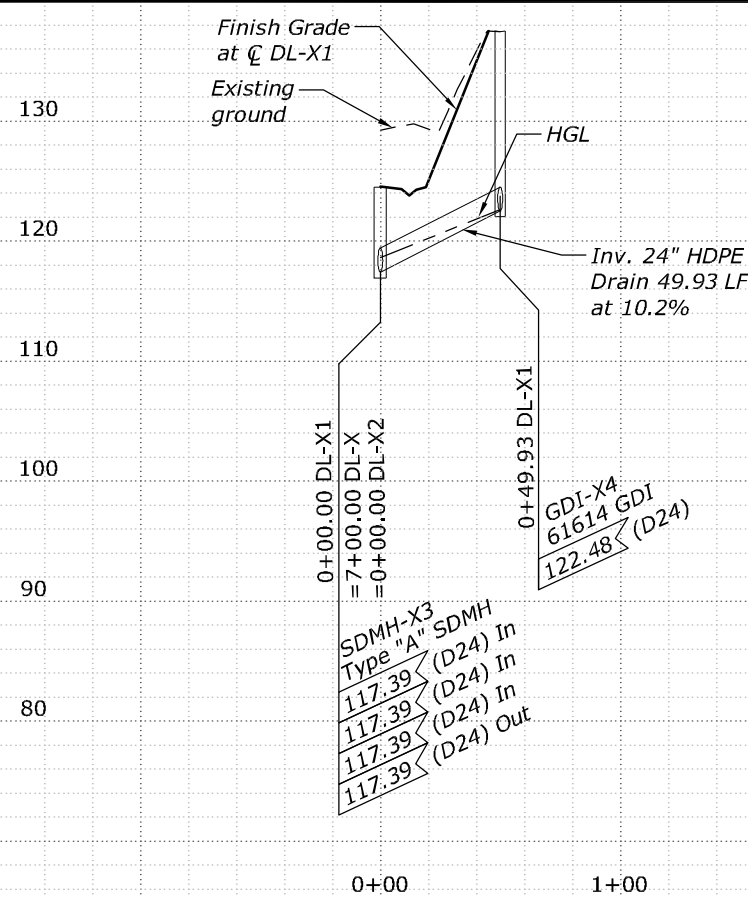

THIS WORK WAS PREPARED BY ME
OR UNDER MY SUPERVISION.
WILSON OKAMOTO CORPORATION
APRIL 30, 2020
LIC. EXP. DATE