


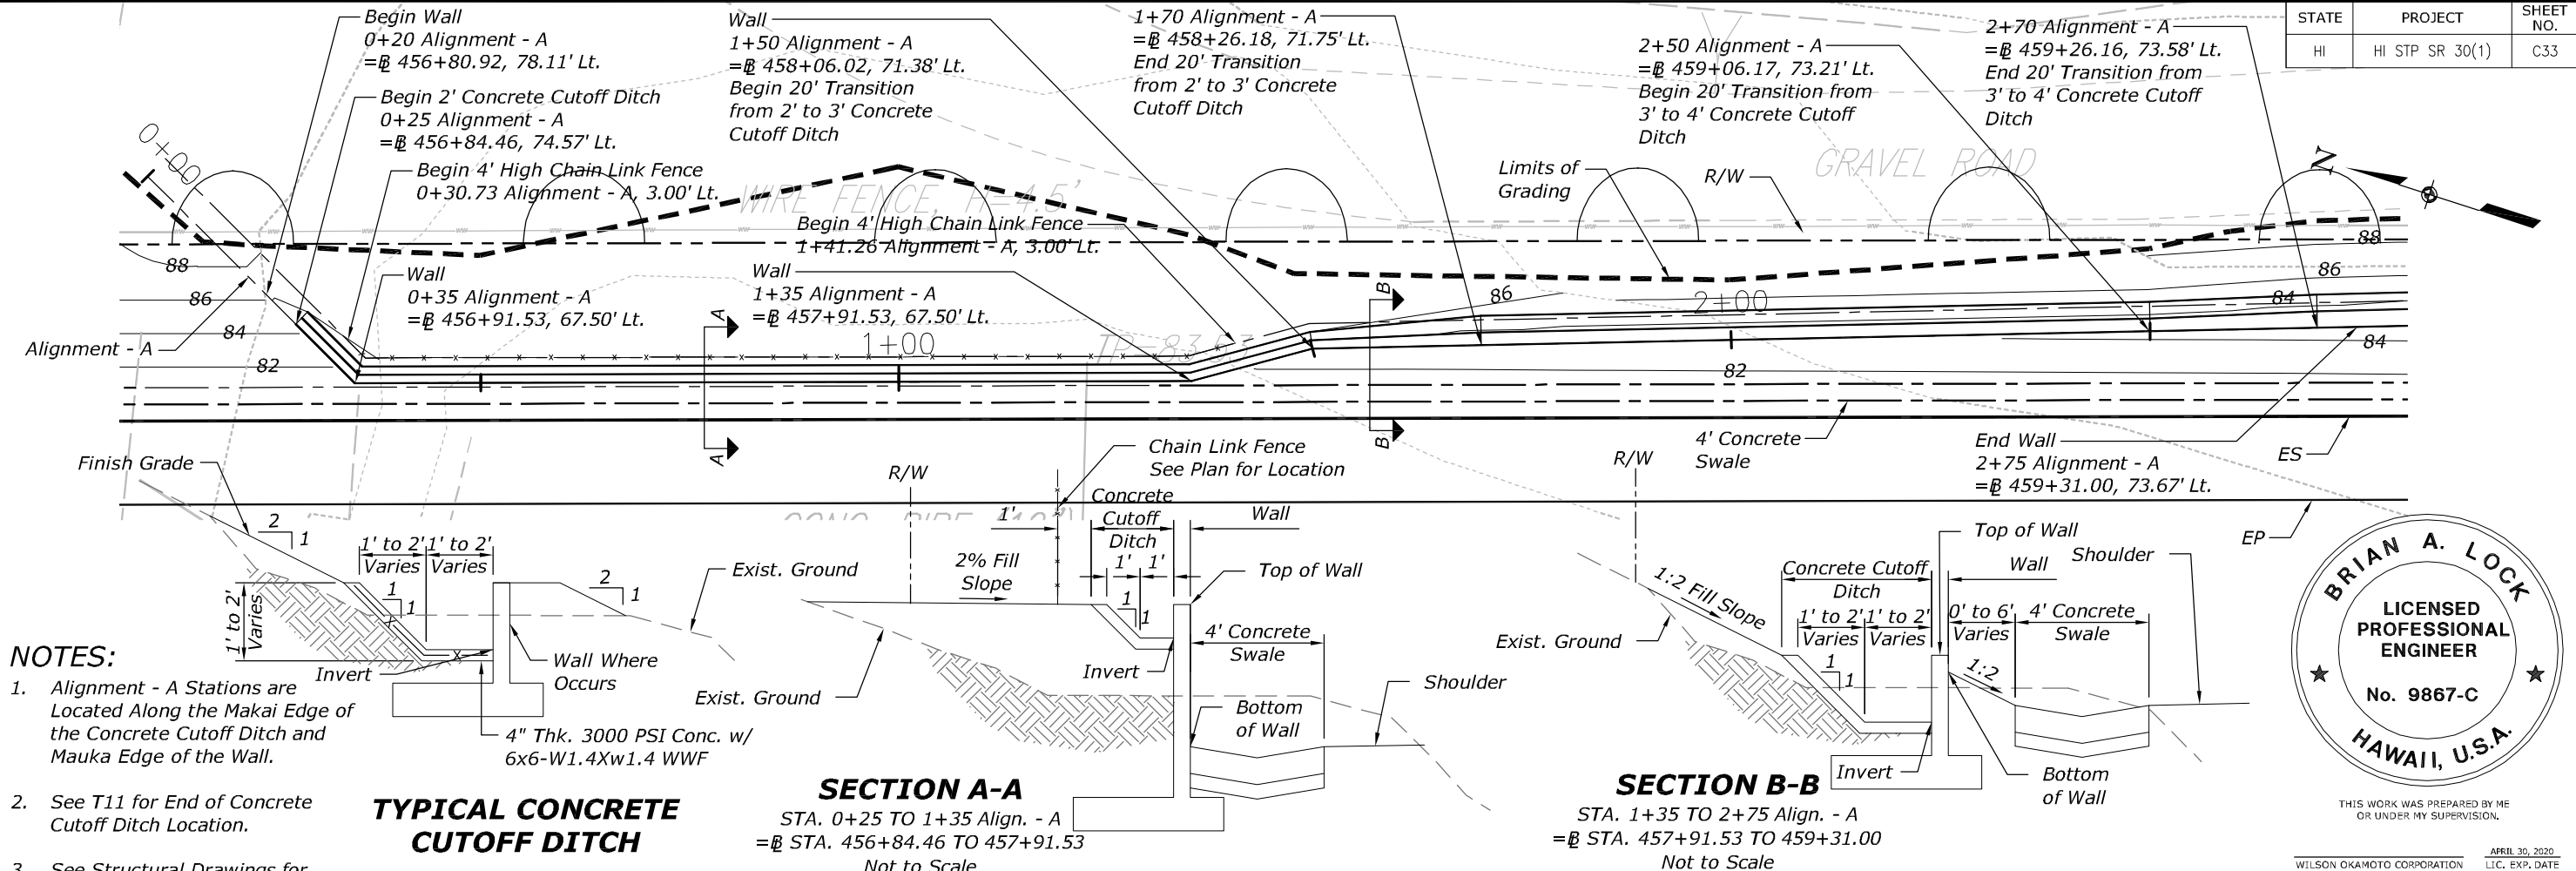


NOTES:

- Alignment - A Stations are Located Along the Makai Edge of the Concrete Cutoff Ditch and Mauka Edge of the Wall.
- See T11 for End of Concrete Cutoff Ditch Location.
- See Structural Drawings for Additional Details.
- See X-Series for Cross Sections



TYPICAL CONCRETE CUTOFF DITCH

SECTION A-A
STA. 0+25 TO 1+35 Align. - A
= STA. 456+84.46 TO 457+91.53
Not to Scale

SECTION B-B
STA. 1+35 TO 2+75 Align. - A
= STA. 457+91.53 TO 459+31.00
Not to Scale

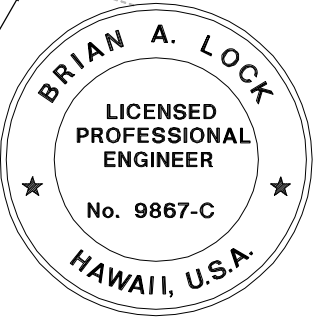

THIS WORK WAS PREPARED BY ME OR UNDER MY SUPERVISION.
APRIL 30, 2020
WILSON OKAMOTO CORPORATION
LIC. EXP. DATE

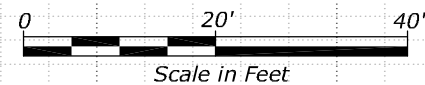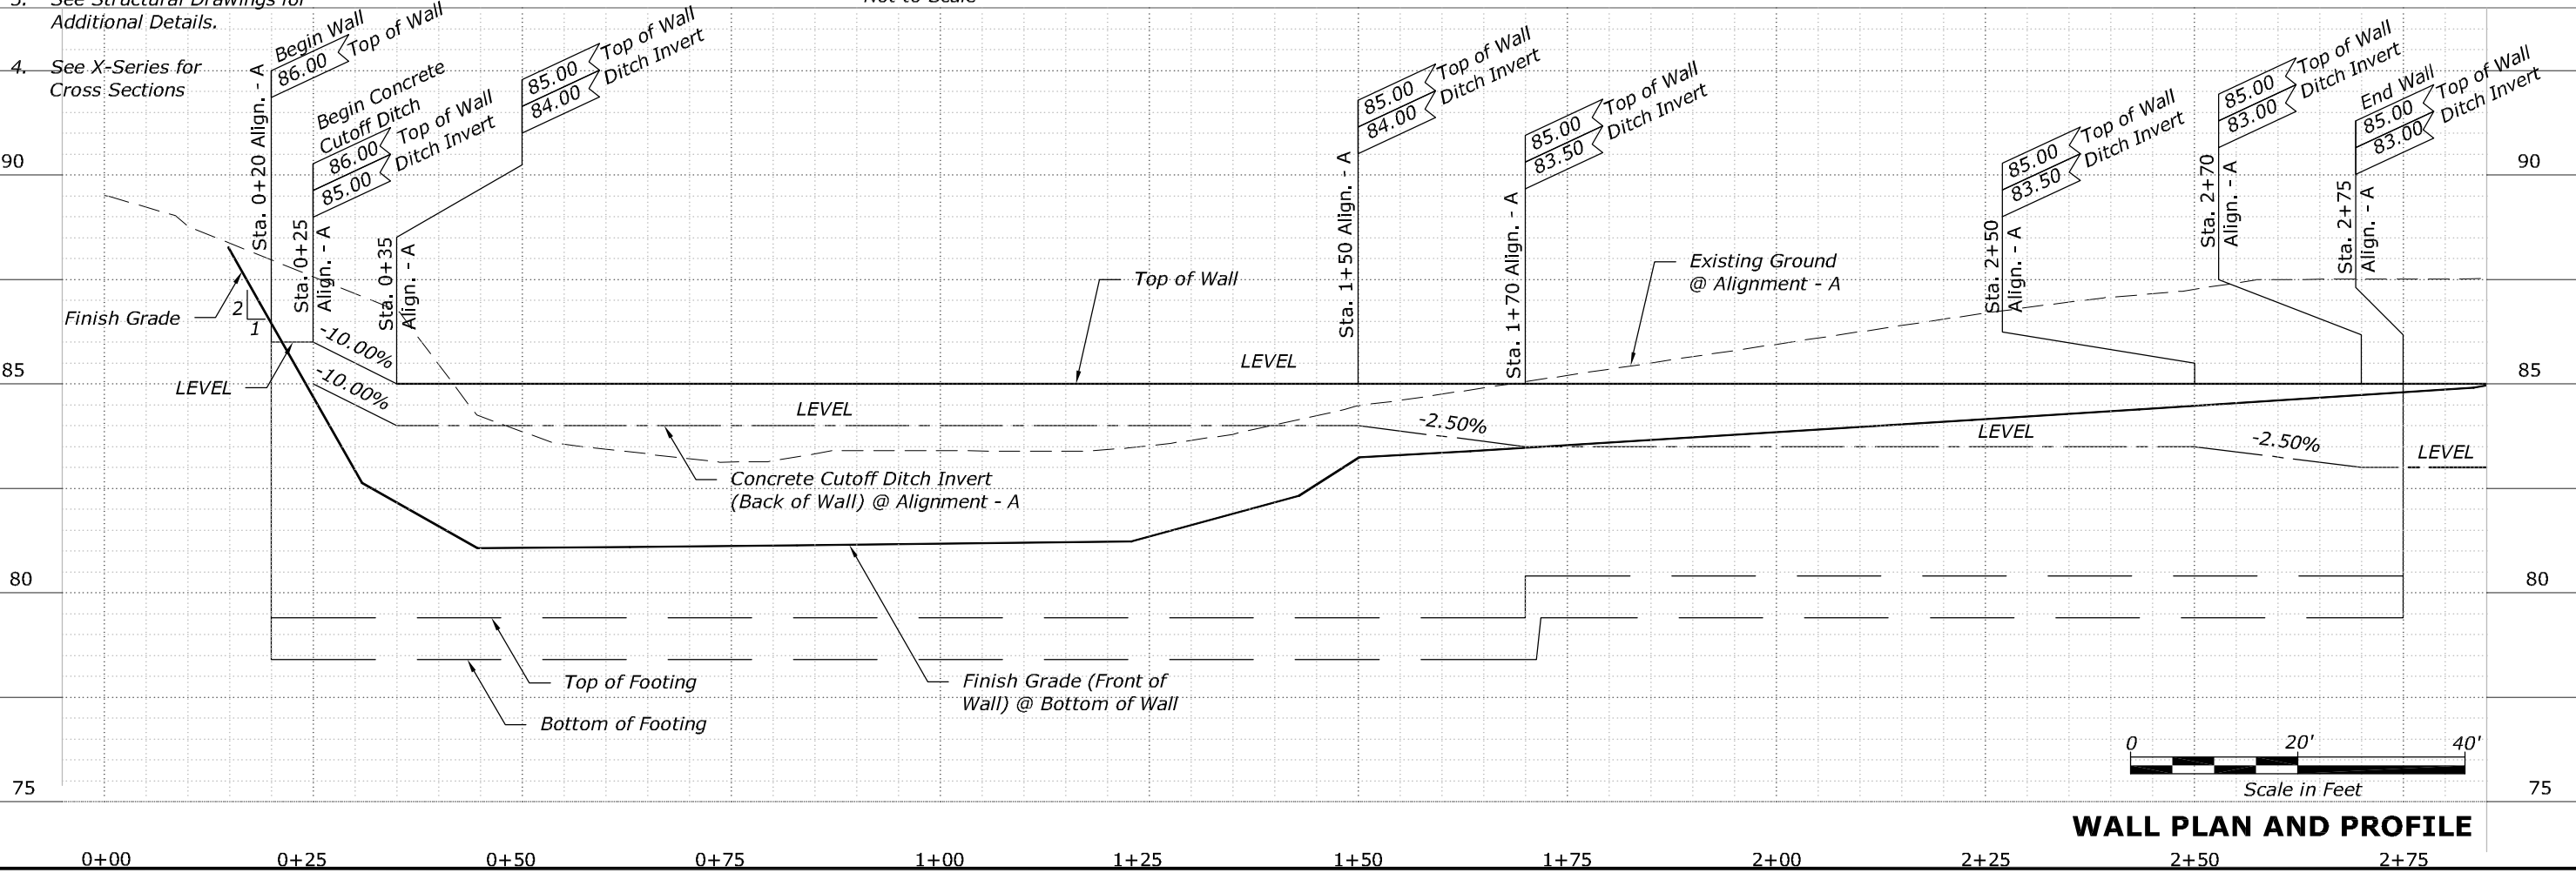

WALL PLAN AND PROFILE