

Patricia Choy


W:\10226-01\Civil\CADD\Site\DWGS\DRIVE - w\10226-01\Civil\CADD\Site\DWGS\X51 Wall Sections.dwg

16:58:15

January 10, 2019

NOTES:



1. Top Wall, Ditch Invert, and Exist Ground Elevations Shown are along Alignment - A. See C33 for Alignment Location.
2. Finish Grade Elevation shown is at the Bottom of Wall along the Back of Wall.

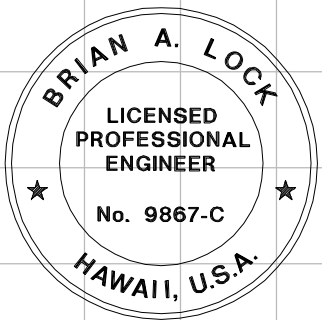

| STATE | PROJECT         | SHEET NO. |
|-------|-----------------|-----------|
| HI    | HI STP SR 30(1) | X51       |

THIS WORK WAS PREPARED BY ME  
OR UNDER MY SUPERVISION.

WILSON OKAMOTO CORPORATION  
APRIL 30, 2020  
LIC. EXP. DATE

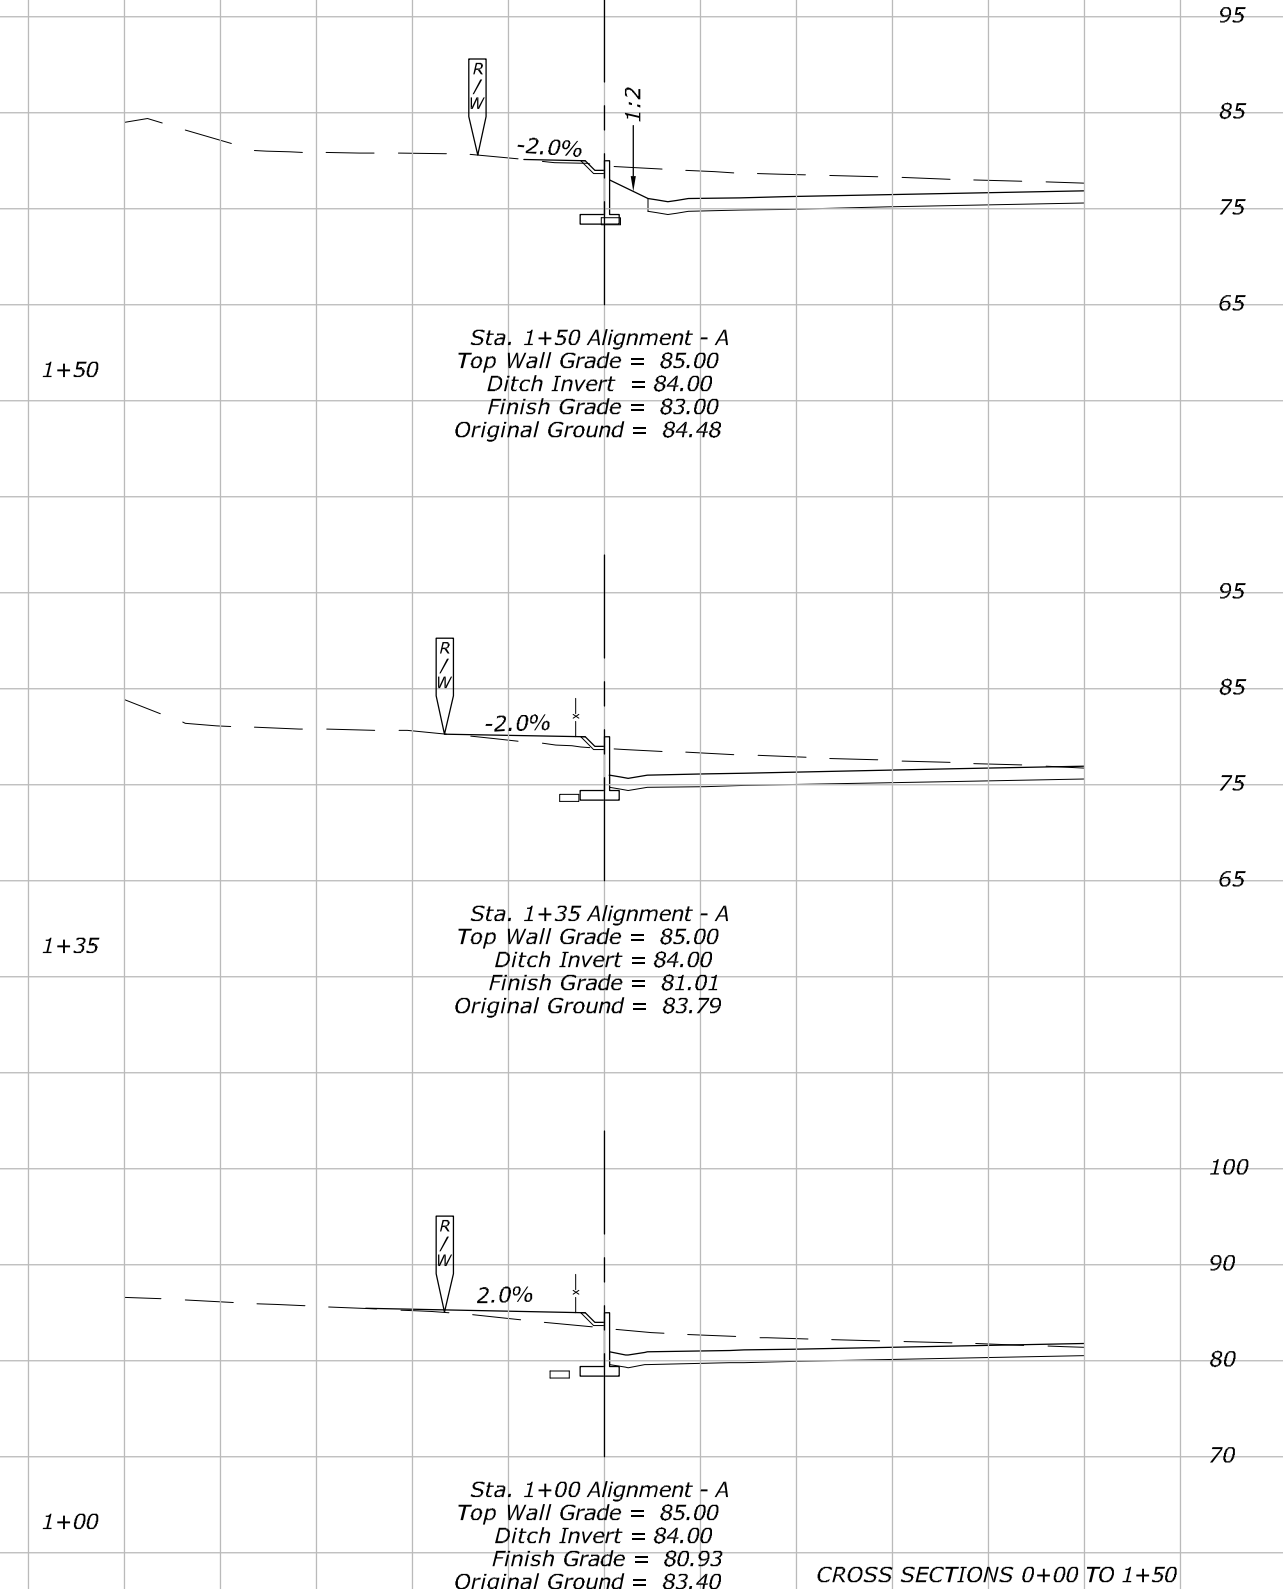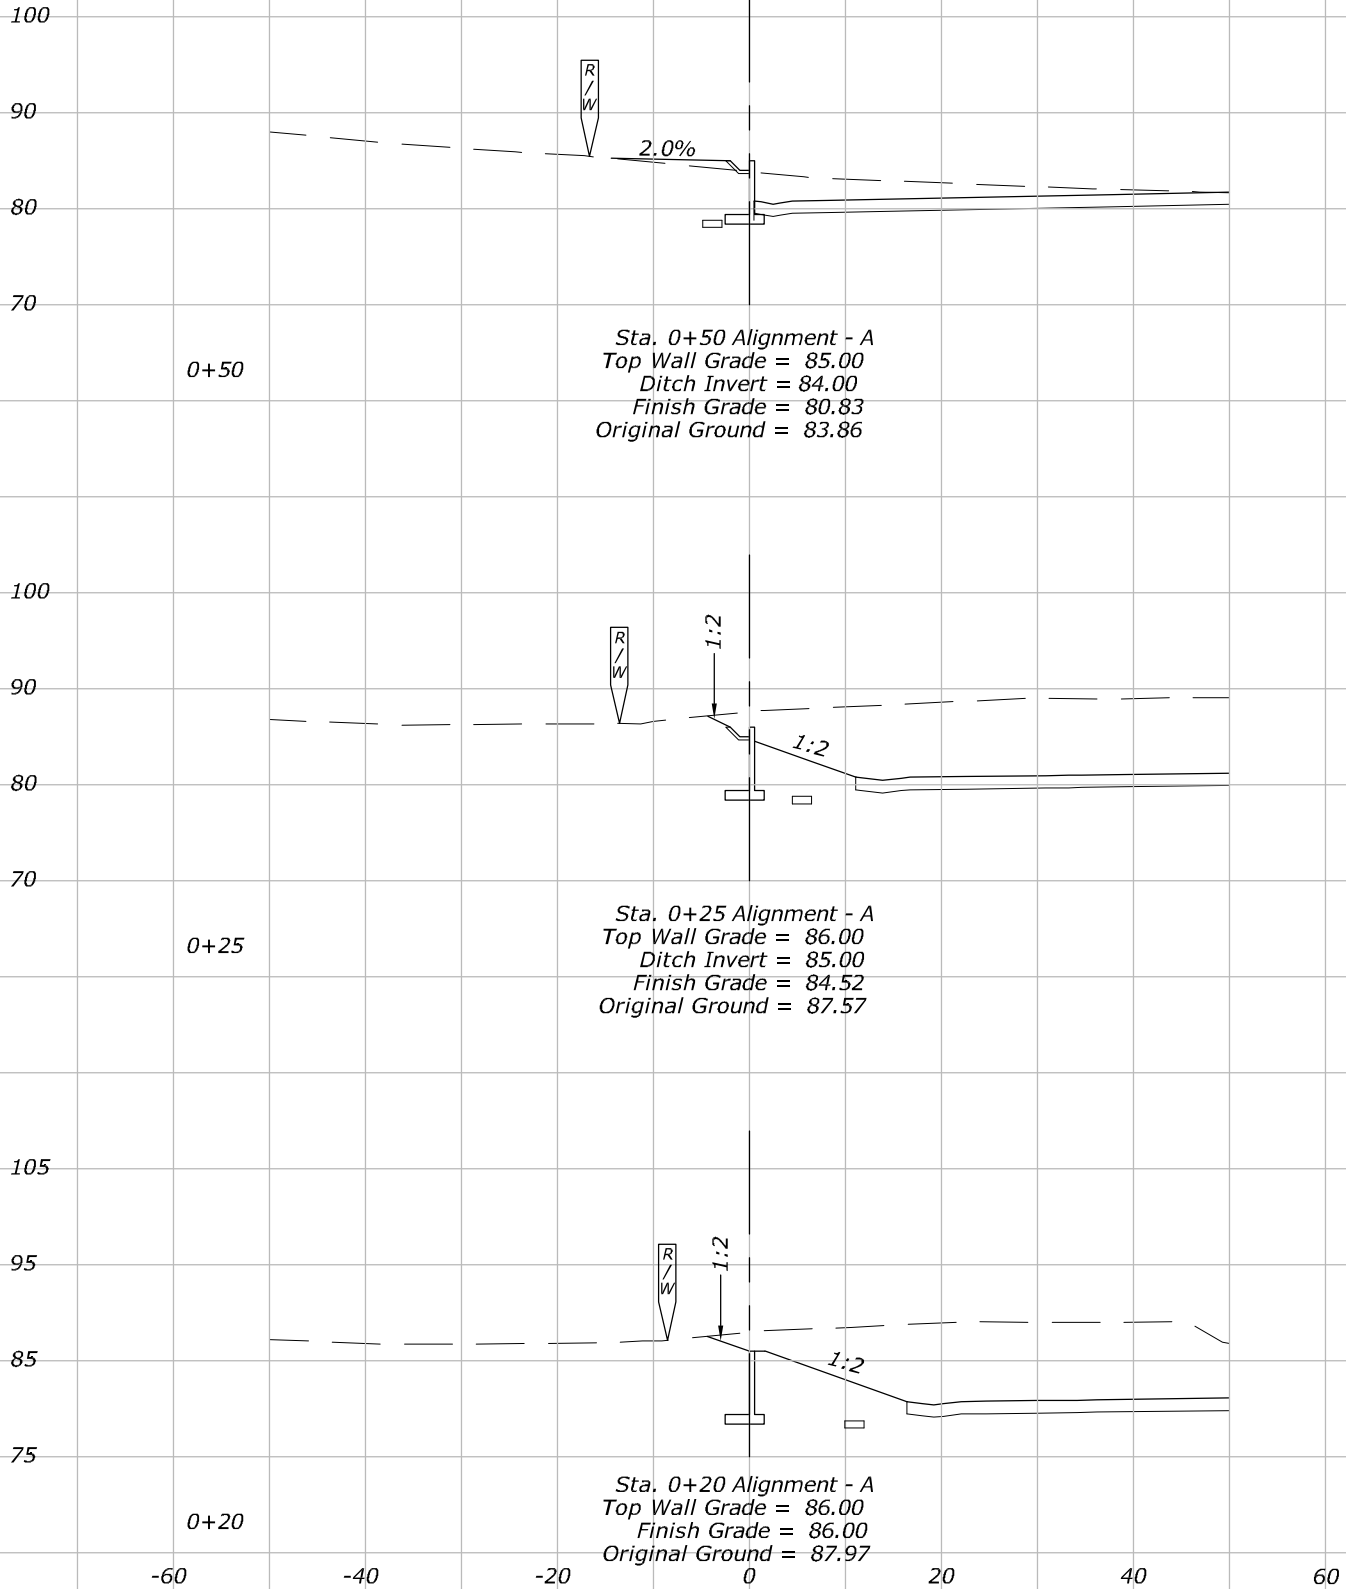

CROSS SECTIONS 0+00 TO 1+50

Patricia Choy


W:\102226-01\Civil\CADD\Site\DWGS\DRIVE - w\102226-01\Civil\CADD\Site\DWGS\X52 Wall Sections.dwg

16:58:23



January 10, 2019

NOTES:

1. Top Wall, Ditch Invert, and Exist Ground Elevations Shown are along Alignment - A. See C33 for Alignment Location.
2. Finish Grade Elevation shown is at the Bottom of Wall along the Back of Wall.

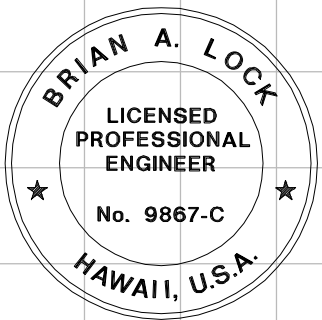

| STATE   | PROJECT         | SHEET NO.                        |
|---|-----------------|----------------------------------|
| HI  | HI STP SR 30(1) | X52                              |
| THIS WORK WAS PREPARED BY ME OR UNDER MY SUPERVISION. |                 |                                  |
| WILSON OKAMOTO CORPORATION                            |                 | APRIL 30, 2020<br>LIC. EXP. DATE |

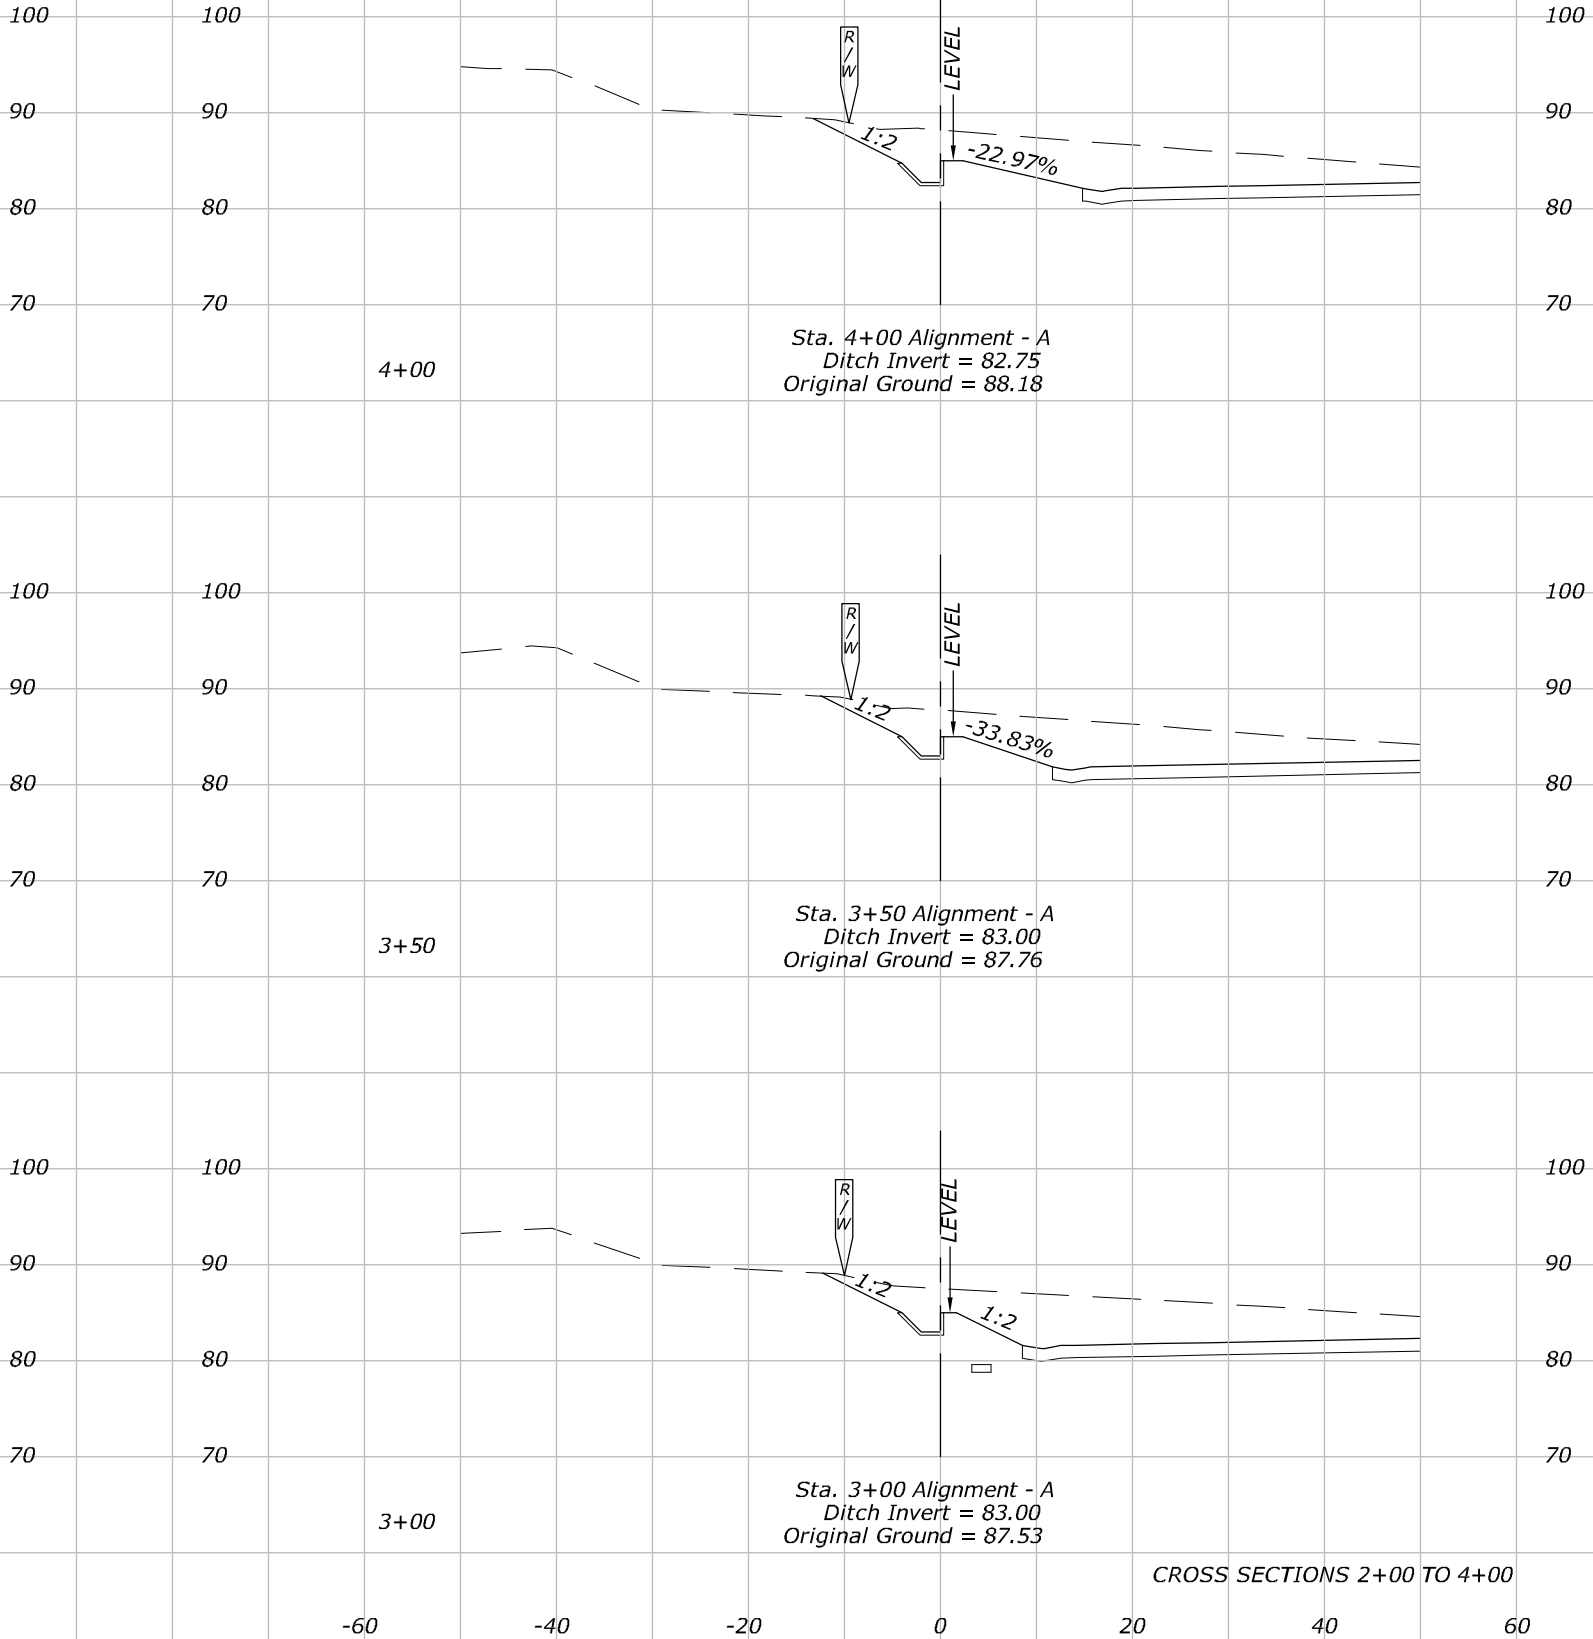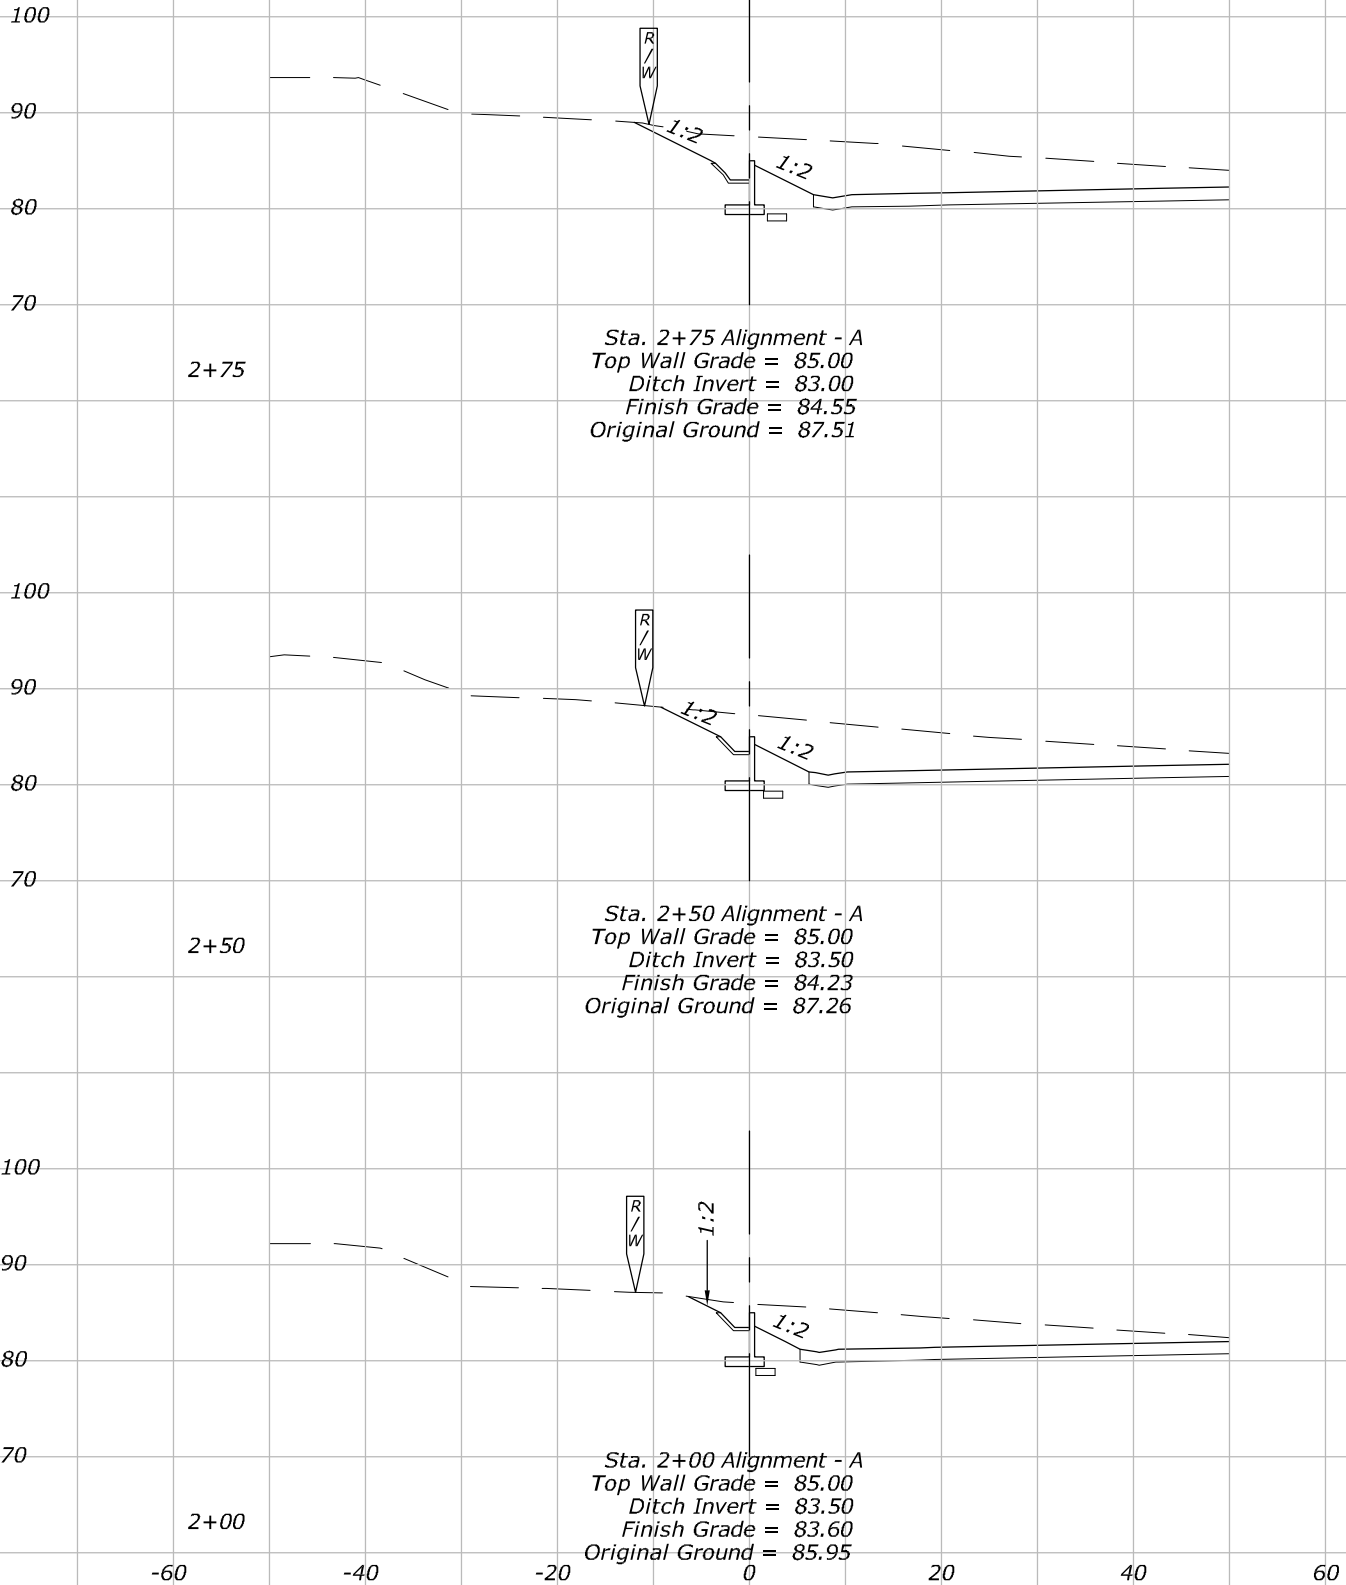

Patricia Choy


W:\102226-01\Civil\CADD\Site\DWGS\DRIVE\_w\102226-01\Civil\CADD\Site\DWGS\X53 Wall Sections.dwg

16:58:30

January 10, 2019

**NOTES:**

1. Ditch Invert and Exist Ground  
Elevations Shown are along  
Alignment - A. See C33 for  
Alignment Location.

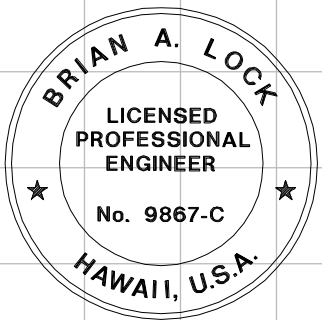


| STATE | PROJECT         | SHEET NO. |
|-------|-----------------|-----------|
| HI    | HI STP SR 30(1) | X53       |


THIS WORK WAS PREPARED BY ME  
OR UNDER MY SUPERVISION.

WILSON OKAMOTO CORPORATION


APRIL 30, 2020  
LIC. EXP. DATE

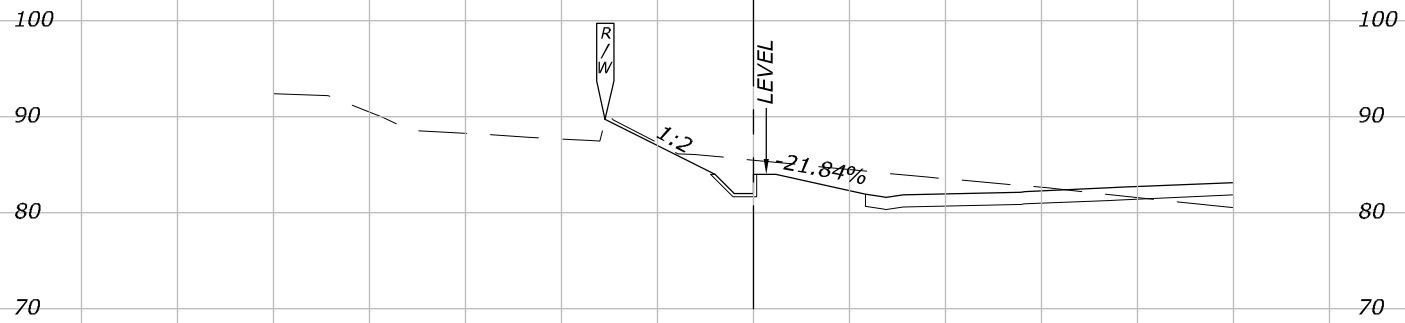

Sta. 5+50 Alignment - A  
Ditch Invert = 82.00  
Original Ground = 85.37

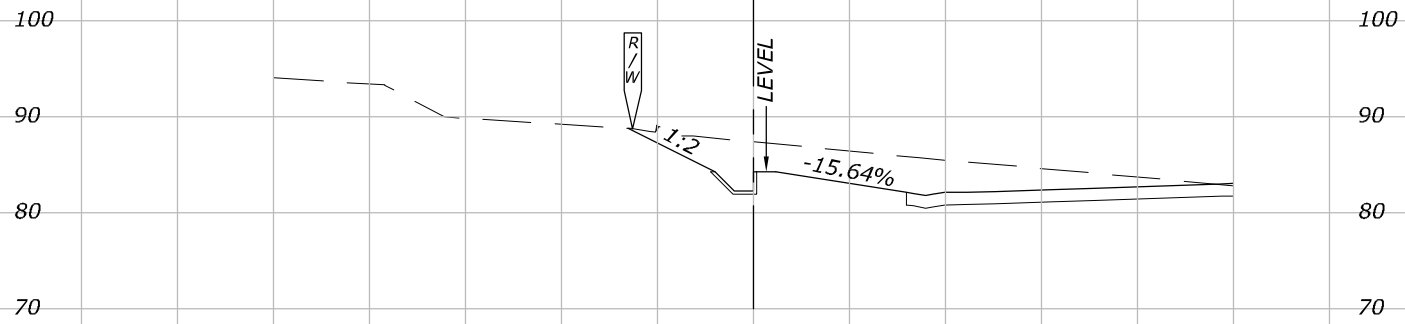

Sta. 5+00 Alignment - A  
Ditch Invert = 82.25  
Original Ground = 87.37

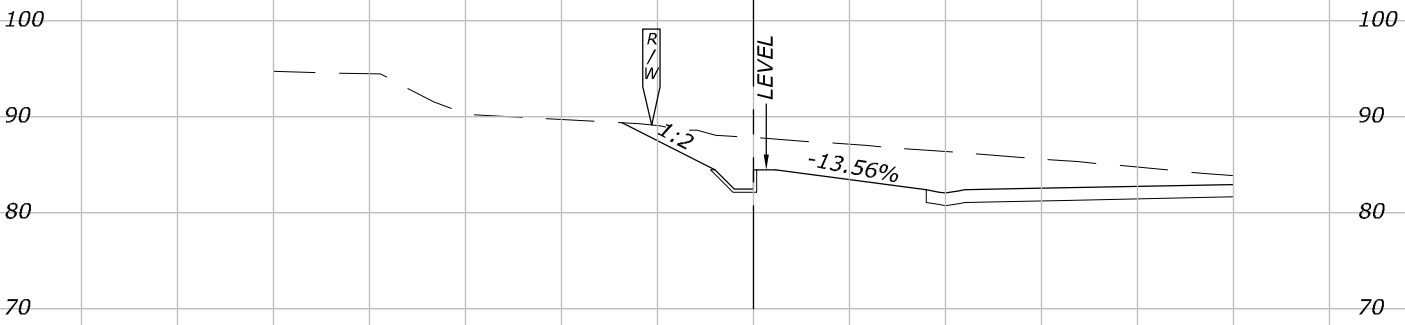

Sta. 4+50 Alignment - A  
Ditch Invert = 82.50  
Original Ground = 87.82

CROSS SECTIONS 4+50 TO 5+50

-60 -40 -20 0 20 40 60 -60 -40 -20 0 20 40 60