



- NOTES:
- 2500 psi Concrete.
 - Min. 2" Cover Over All Reinforcement
 - AWWA C153 Fittings Not Acceptable For This Application (Except DWS Hawaii).
 - Unless Otherwise Noted, All Reinforcing Bars Shall Be ASTM A615, Grade 60.
 - Megalug Restraint Glands Required On Top Vertical Bends.

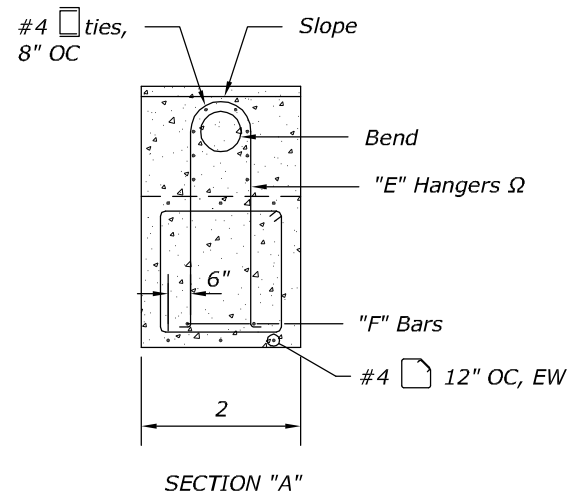


TOP VERTICAL THRUST BLOCK SCHEDULE							
SIZE	BEND	A	B	C	D	E	F
12"	1/4	6'-3"	6'-3"	6'-3"	5'-6"	(3)#7	(2)#7
	1/8	5'-6"	5'-6"	2'-9"	4'-6"	(2)#6	(2)#6
	1/16	5'-8"	4'-6"	3'-4"	2'-6"	(3)#4	(2)#4
	1/32	4'-3"	3'-9"	3'-3"	2'-0"	(2)#3	(2)#3
8"	1/4	5'-3"	5'-0"	5'-0"	5'-3"	(2)#6	(2)#6
	1/8	5'-3"	4'-9"	2'-3"	4'-0"	(2)#5	(2)#5
	1/16	5'-9"	3'-6"	2'-6"	2'-6"	(2)#4	(2)#4
	1/32	3'-6"	2'-4"	2'-6"	2'-6"	(2)#3	(2)#3

TYPICAL THRUST BLOCK AT TOP VERTICAL BENDS DETAIL

WATER MAIN TRENCH RESTORATION

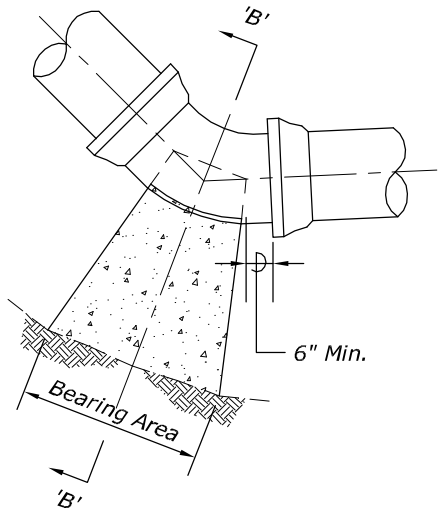


PLAN - BENDS

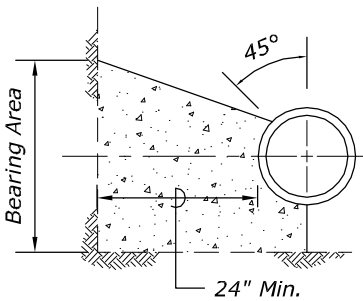

SECTION "B"

MINIMUM BEARING AREA (sq. ft.)					
SIZE	TEES, CAPS	1/4 BENDS	1/8 BENDS	1/16 BENDS	1/32 BENDS
12"	11.5	16.0	9.0	4.5	2.5
8"	6.5	9.0	5.0	2.5	1.5

TYPICAL THRUST BLOCK HORIZONTAL AND BOTTOM VERTICAL BENDS DETAIL

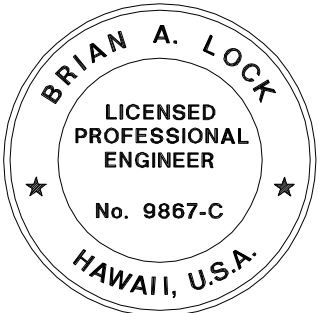

THIS WORK WAS PREPARED BY ME OR UNDER MY SUPERVISION.

WILSON OKAMOTO CORPORATION APRIL 30, 2020 LIC. EXP. DATE

NO SCALE

U.S. DEPARTMENT OF TRANSPORTATION
FEDERAL HIGHWAY ADMINISTRATION
CENTRAL FEDERAL LANDS HIGHWAY DIVISION

U.S. CUSTOMARY SPECIAL

WATER DETAILS

SPECIAL

