




| FED. ROAD DIST. NO. | STATE | FED. AID PROJ. NO. | FISCAL YEAR | SHEET NO. | TOTAL SHEETS |
|---------------------|-------|--------------------|-------------|-----------|--------------|
| HAWAII              | HAW.  | 527(1)             | 1948        | 3         | 10           |

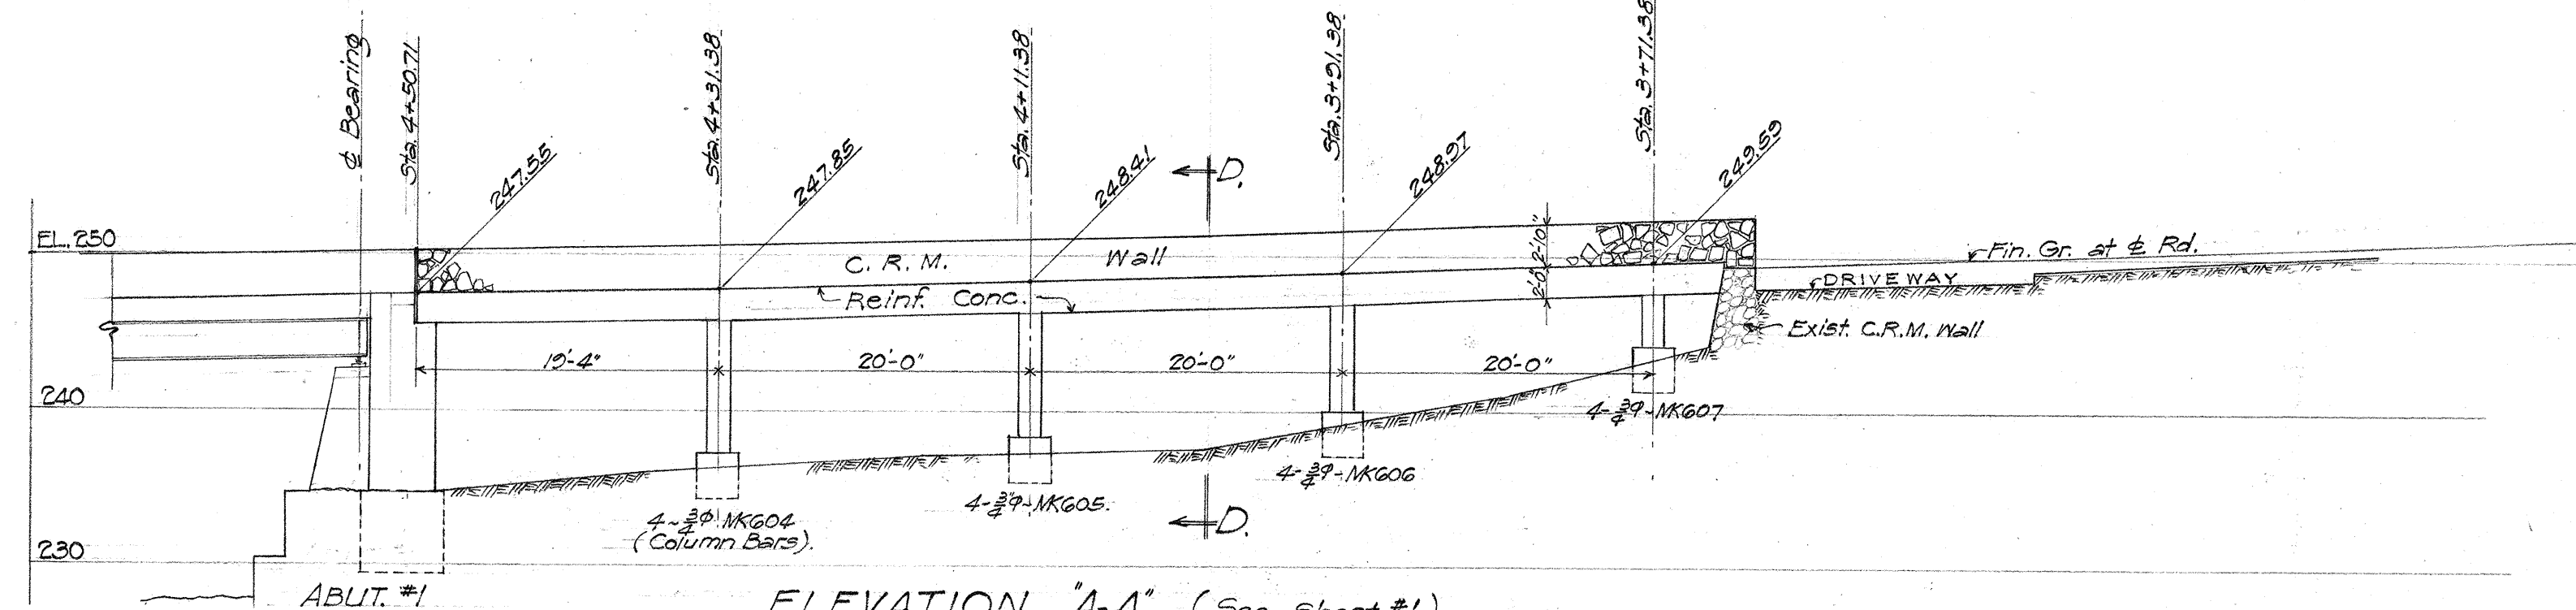


ELEVATION "A-A" (See Sheet #1)  
1" = 10'-0"

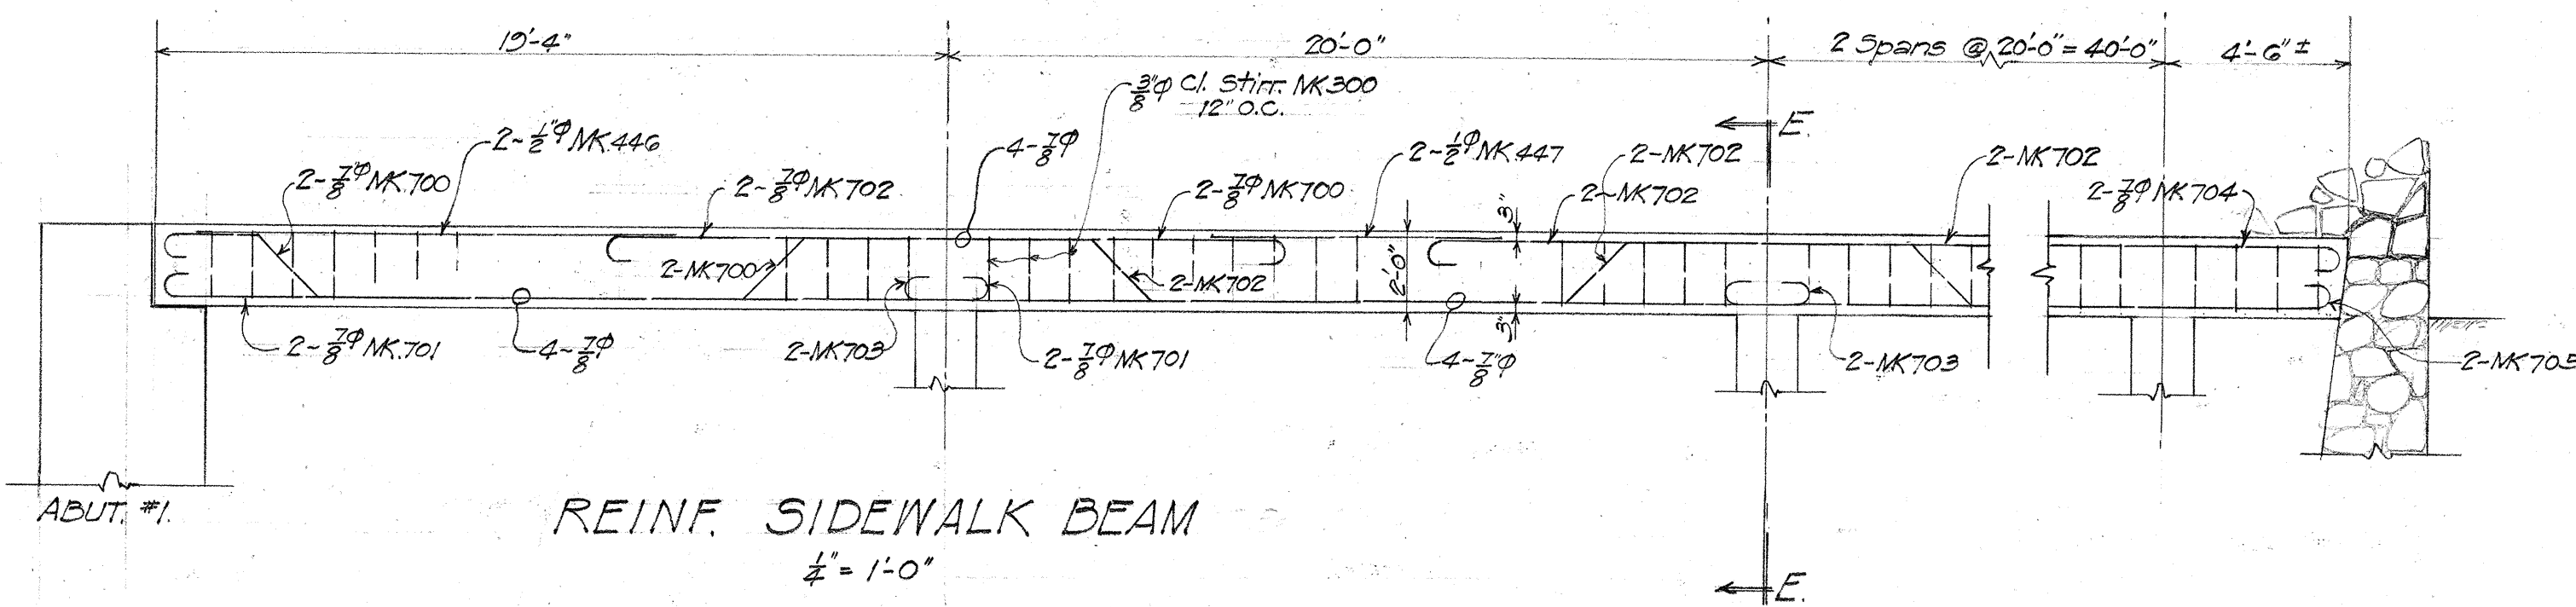


REINF. SIDEWALK BEAM  
1/2" = 1'-0"

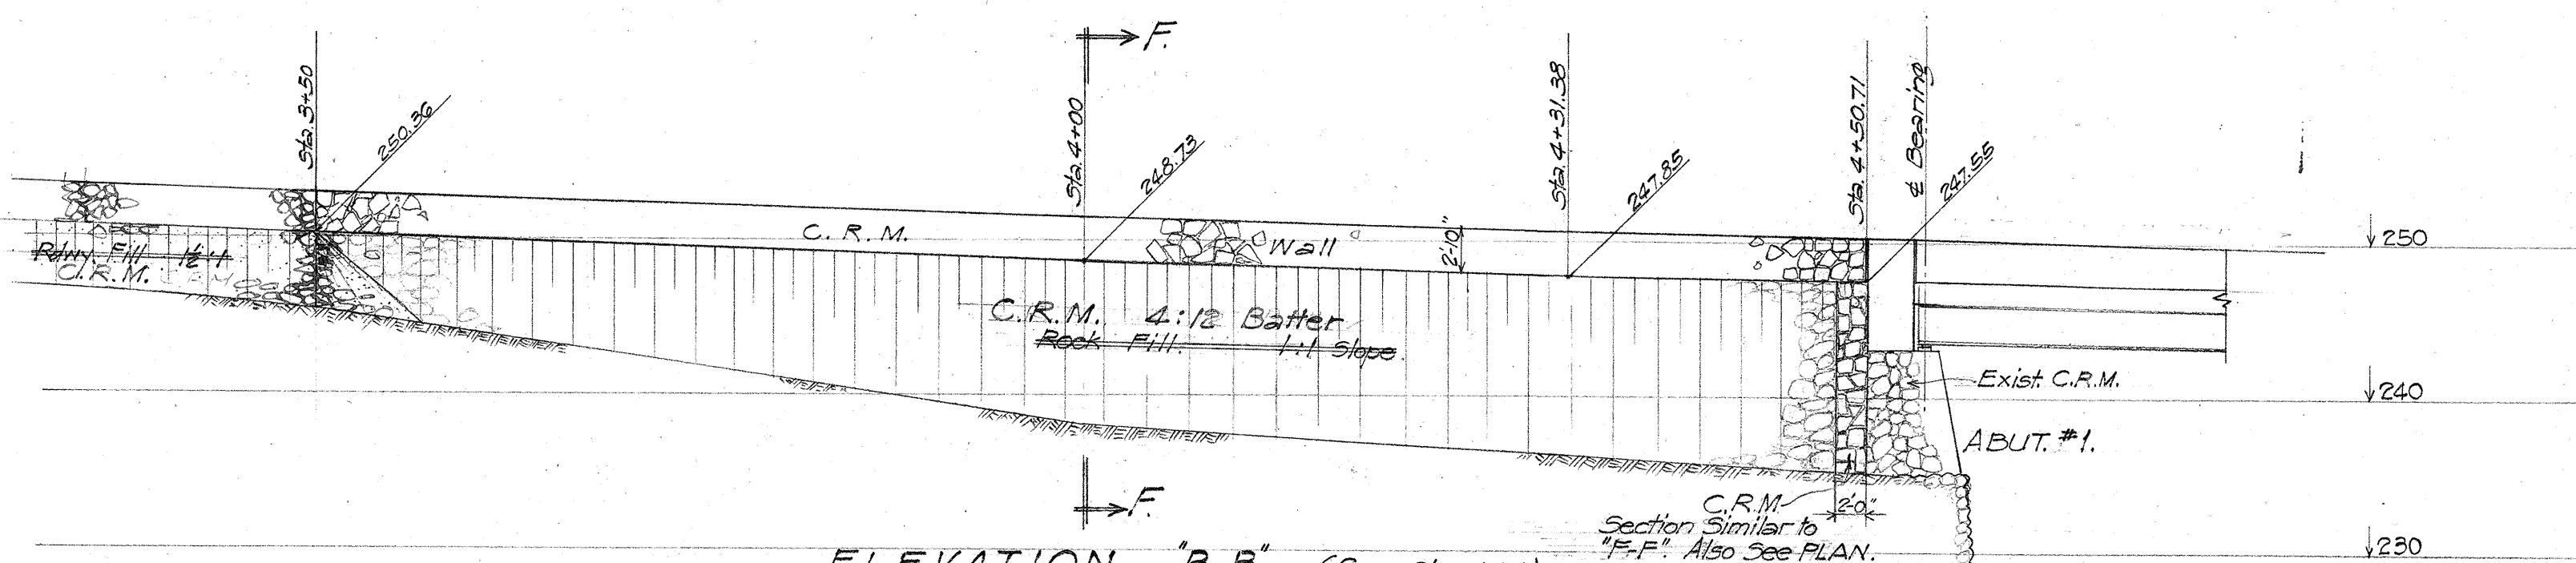


ELEVATION "B-B" (See Sheet #1)  
1" = 10'-0"

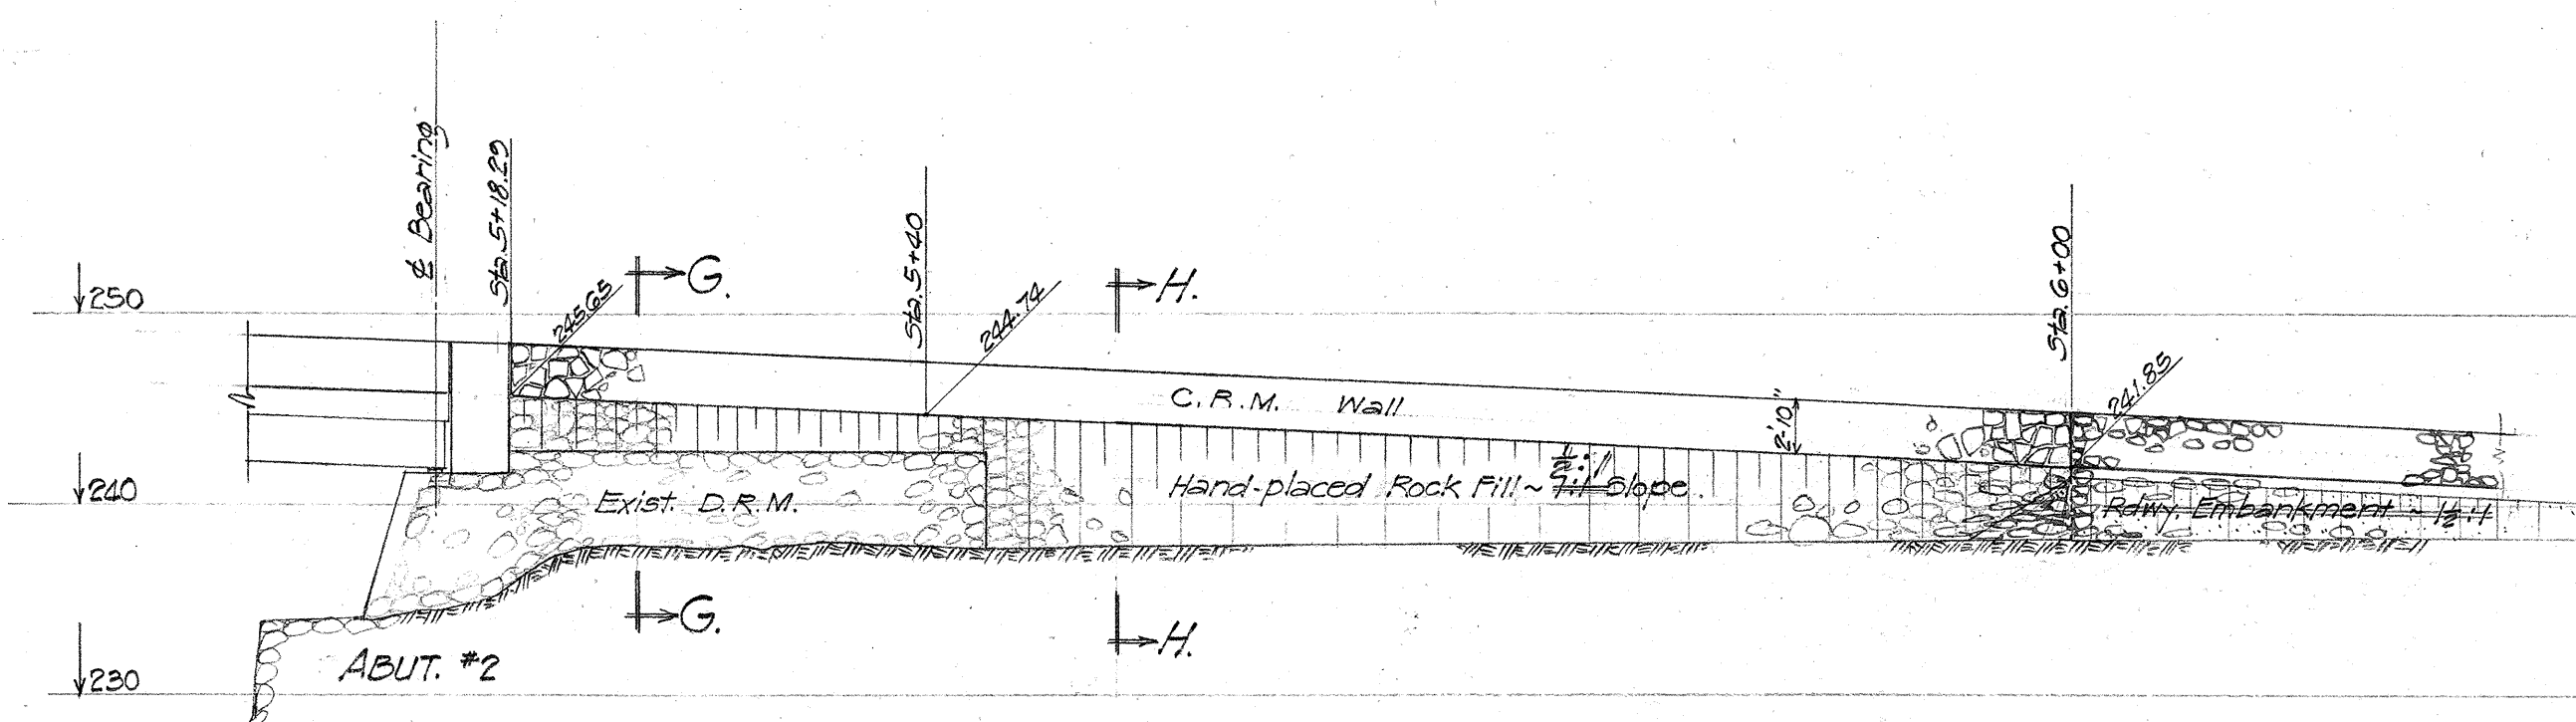


ELEVATION "C-C" (See Sheet #1)  
1" = 10'-0"

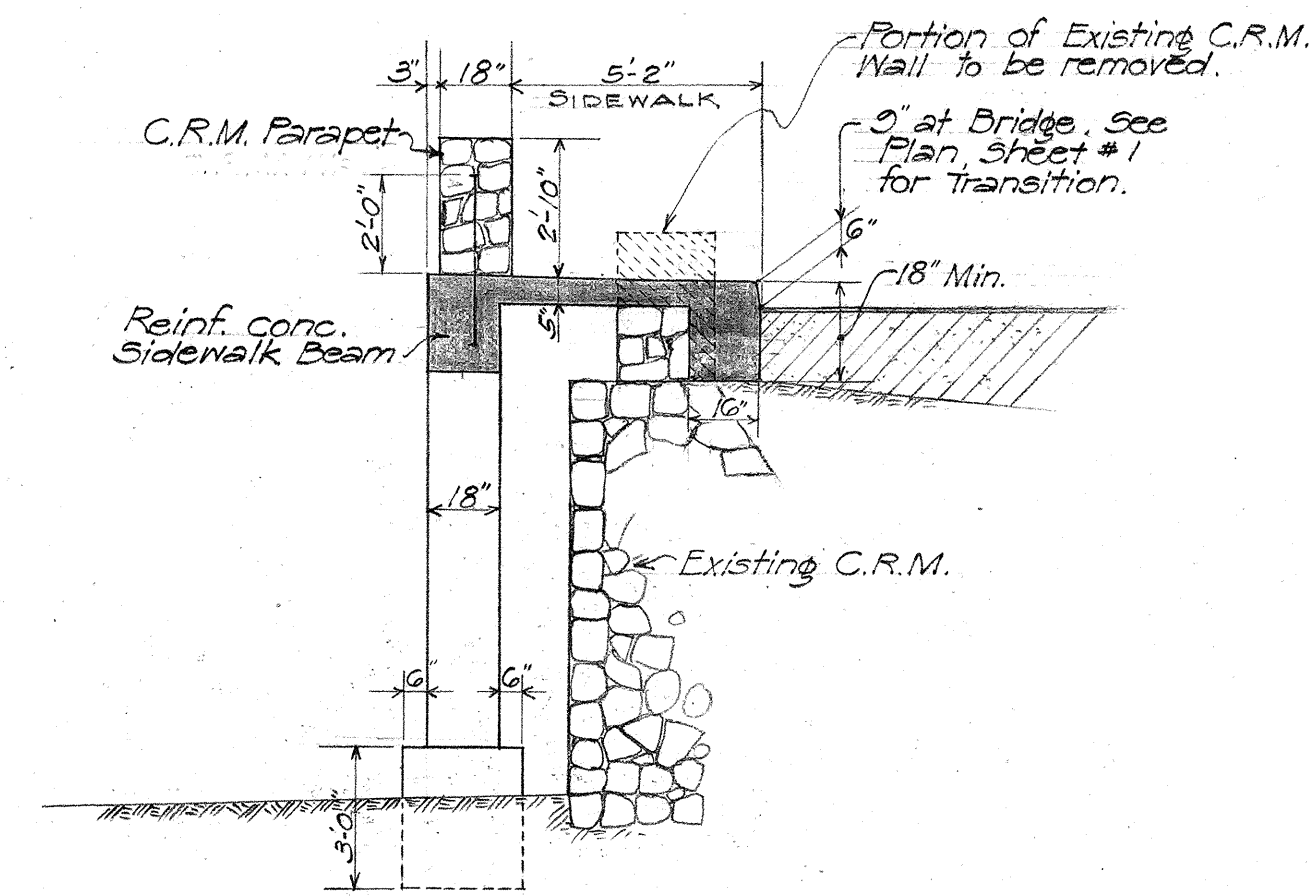


SECTION "D-D"  
1/2" = 1'-0"

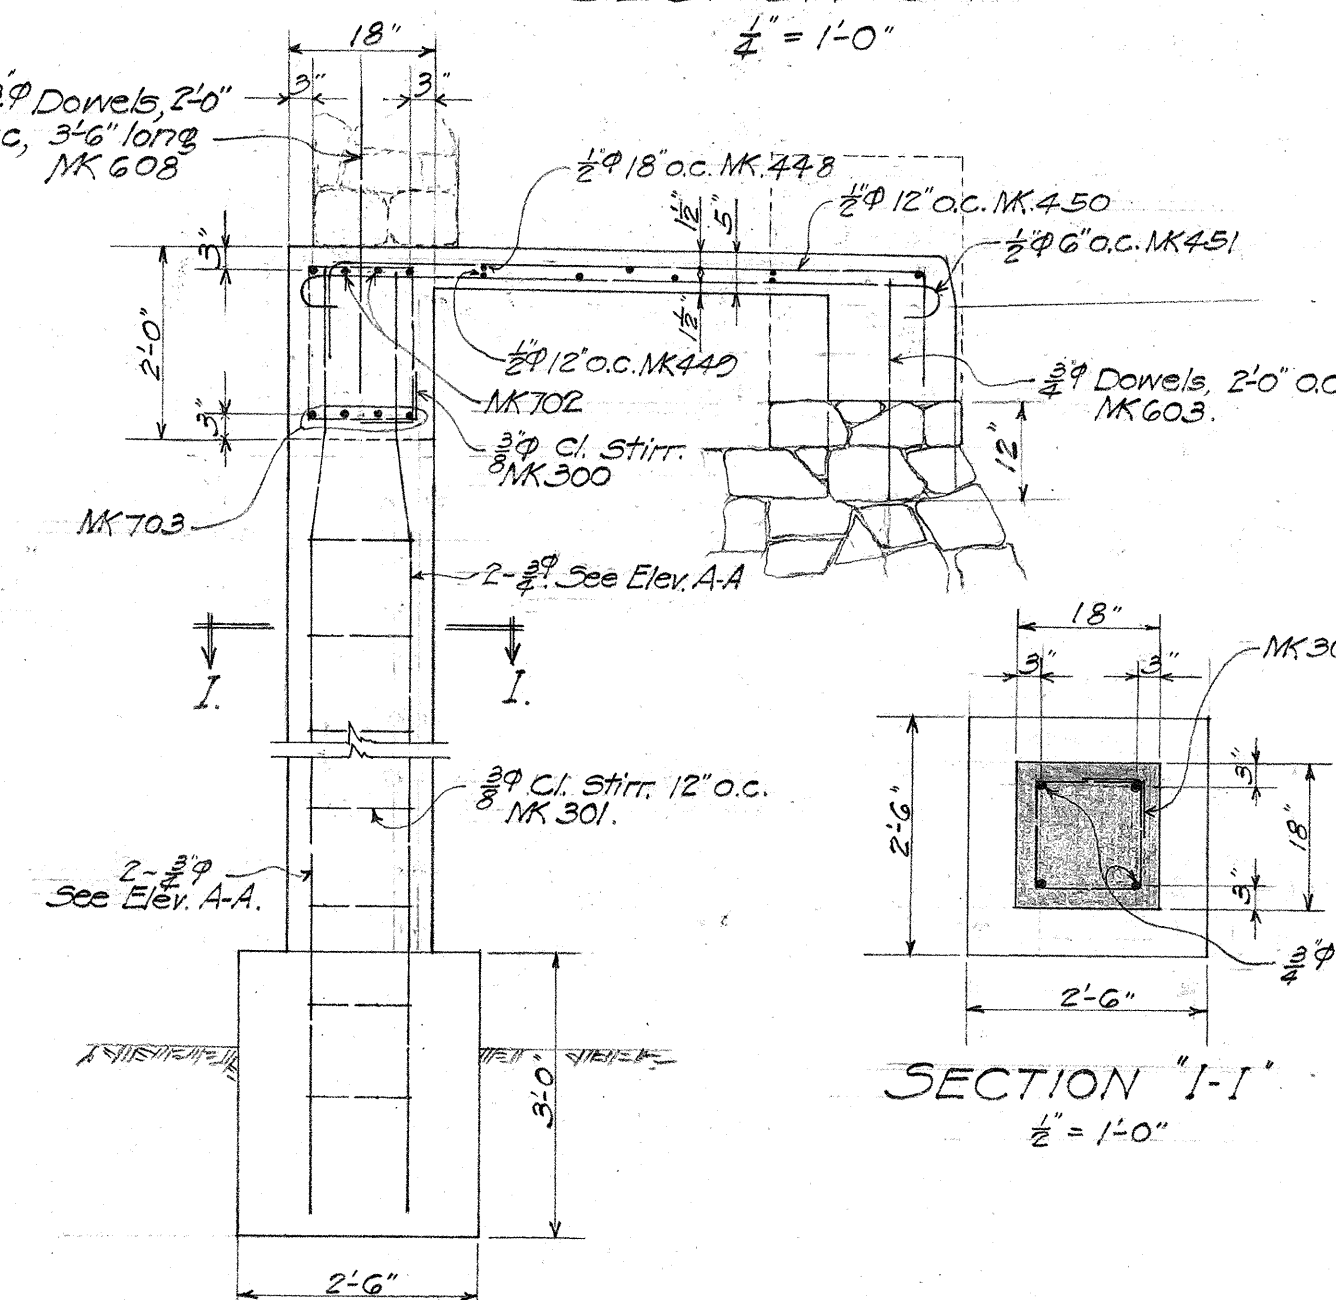


SECTION "E-E"  
1/2" = 1'-0"

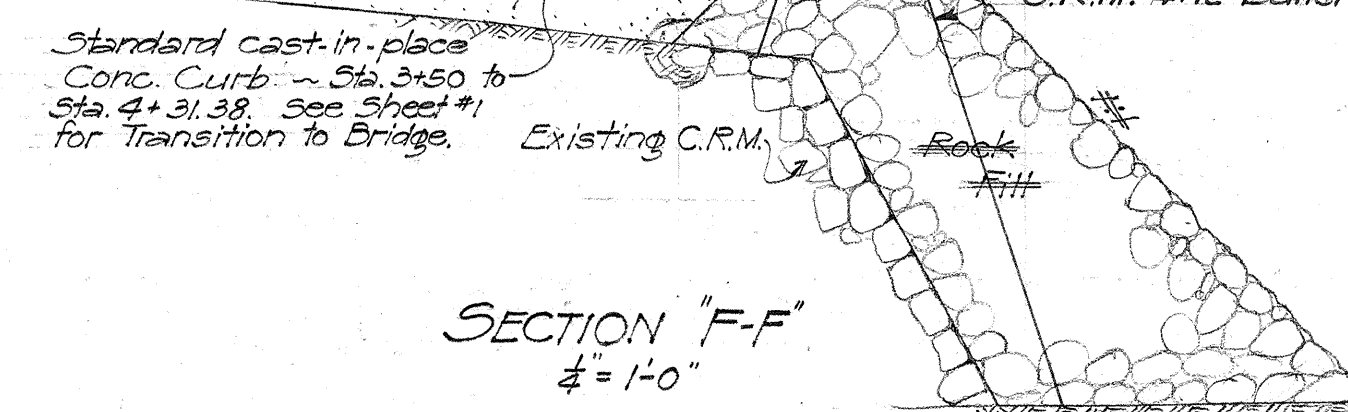



SECTION "F-F"  
1/2" = 1'-0"

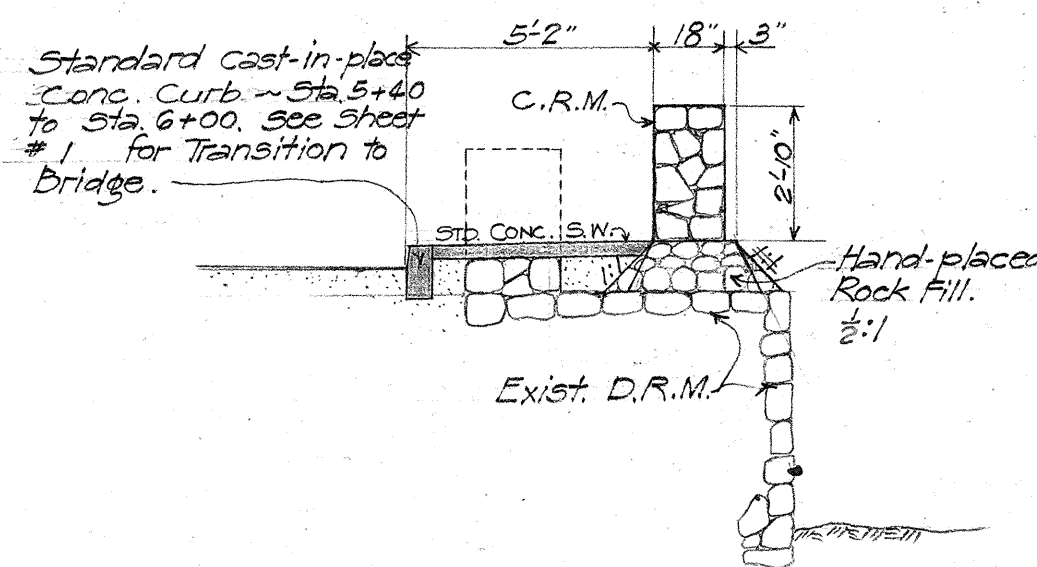

SECTION "G-G"  
1/2" = 1'-0"

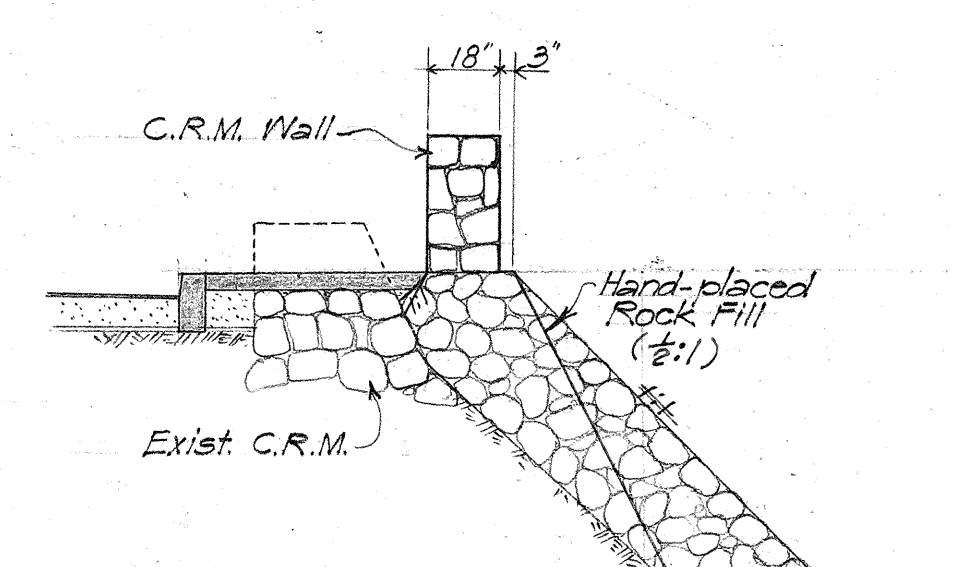

SECTION "H-H"  
1/2" = 1'-0"

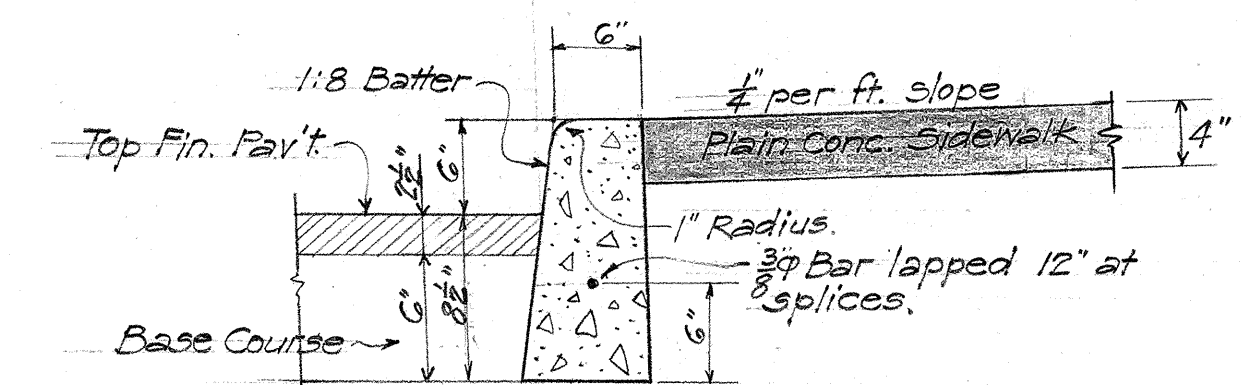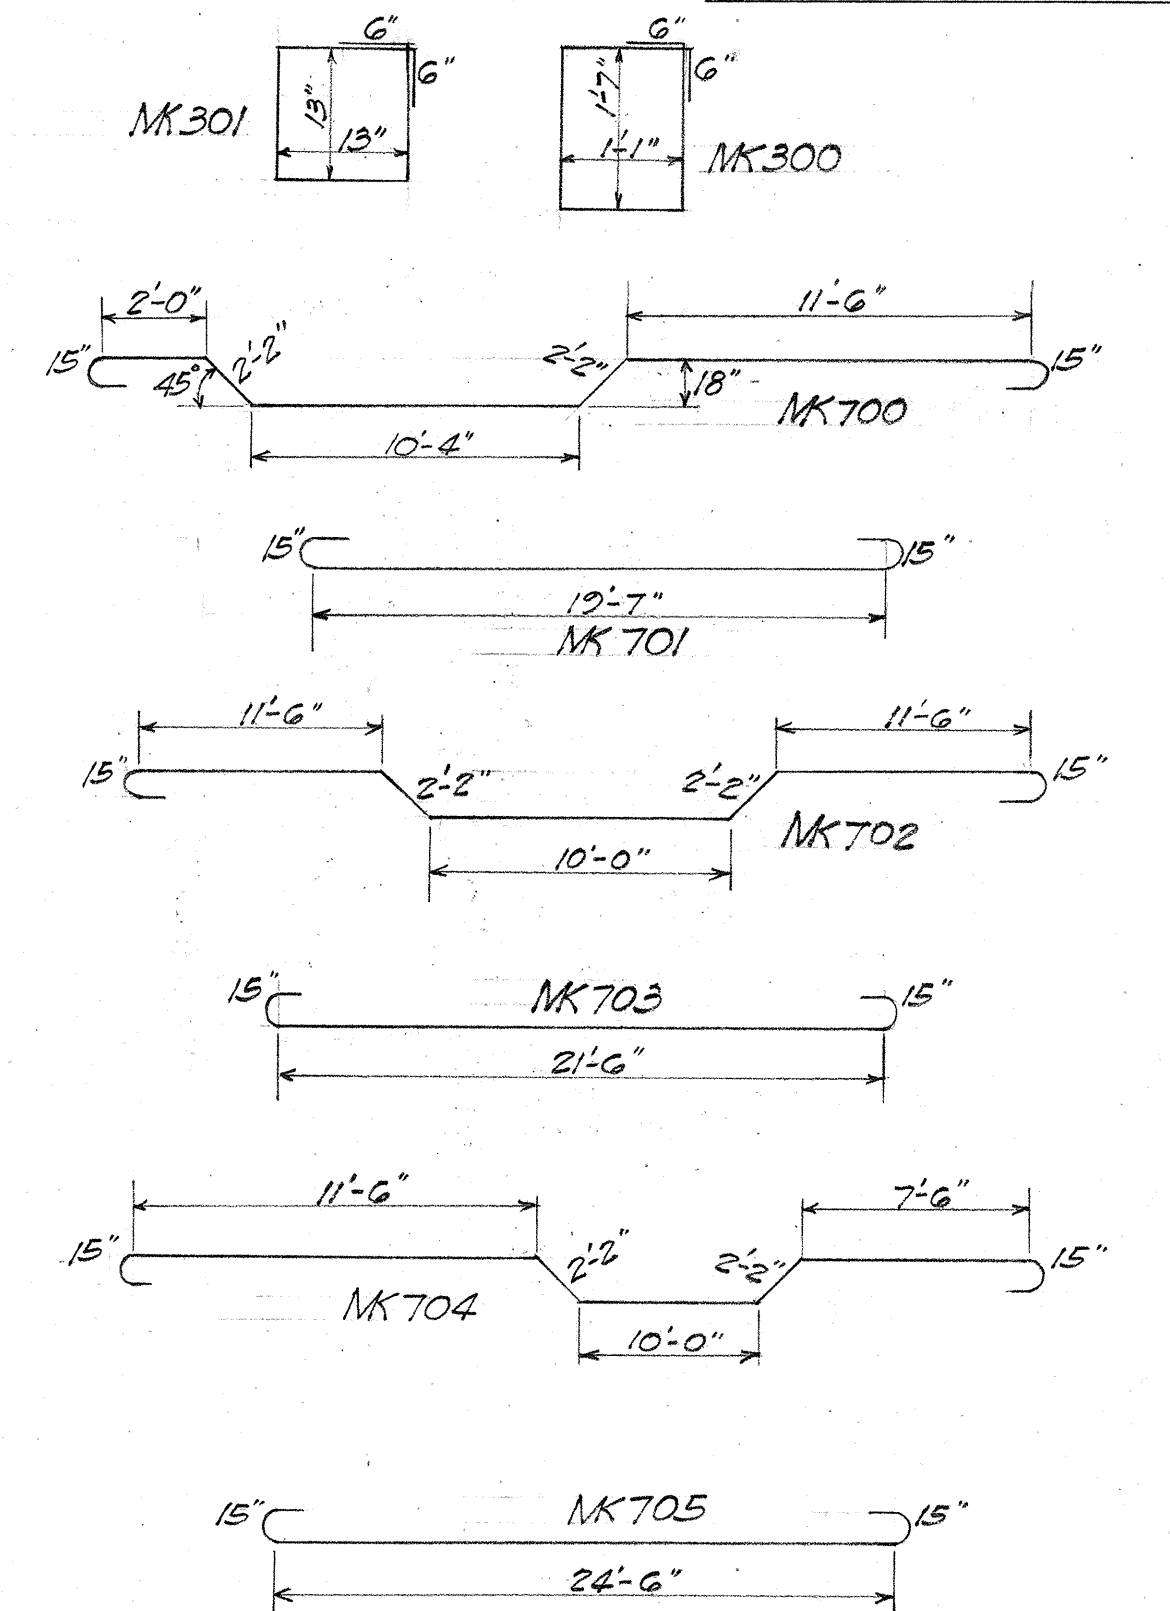

STD. CAST-IN-PLACE CONC. CURB  
1" = 1'-0"

| ESTIMATED QUANTS.     |            |
|-----------------------|------------|
| Class A-1 Conc.       | 26.60 C.Y. |
| Reinf. Steel          | 3,743 Lbs. |
| C. R. M.              | 45.0 C.Y.  |
| Rock Fill             | 171.3 C.Y. |
| Hand-placed Rock Fill | 62.1 C.Y.  |
| Structural Exc.       | 24 C.Y.    |

TERRITORIAL HIGHWAY DEPARTMENT  
TERRITORY OF HAWAII  
DETAILS OF STRUCTURES  
AT BRIDGE APPROACHES.  
WAILUKU, MAUI  
April, 1948

SHEET No. 3 OF 10 SHEETS

5309.3

ORIGINAL  
DESIGNED BY  
DRAWN BY  
CHECKED BY  
DATE  
1/23/48  
E. KAWAHARA  
1/23/48  
1/23/48  
1/23/48