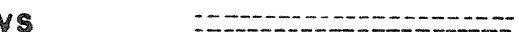
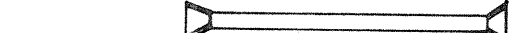
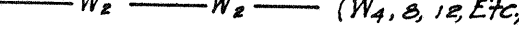
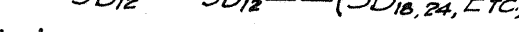
 
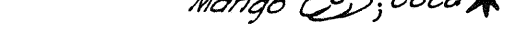


INDEX TO DRAWINGS	
SHEET NO	DESCRIPTION
1	TITLE SHEET
2	TYPICAL SECTION
3-4	PLAN & PROFILE
5-9	STANDARD DETAILS
10-	STANDARD BRIDGE DETAILS
11-23	IAO BRIDGE
24-26	CROSS SECTIONS

CONVENTIONAL SIGNS


Centerline	
Boundary Lines	
Fences (Named)	
Existing Roadways	
Circular Culvert	
Box Culvert	
Bridge	
Telephone Pole	
Electric Power Pole	
Water Main	
Storm Drain	
Concrete Drop Intake	
Standard Catch Basin	
Standard Manhole	
Sewer Manhole	
Telephone Manhole	
Fire Hydrant	
Trees (Named)	
Railroad	

TERRITORY OF HAWAII TERRITORIAL HIGHWAY DEPARTMENT HONOLULU, T. H.

PLANS OF IAO BRIDGE AND APPROACHES FEDERAL AID SECONDARY PROJECT NO. S 247(I) DISTRICT OF WAILUKU ISLAND OF MAUI

SCALE


PLAN	1 IN. = 50 FT.
PROFILE	HOR. 1 IN. = 50 FT. VER. 1 IN. = 5 FT.
X-SECTIONS	HOR. 1 IN. = 10 FT. VER. 1 IN. = 10 FT.

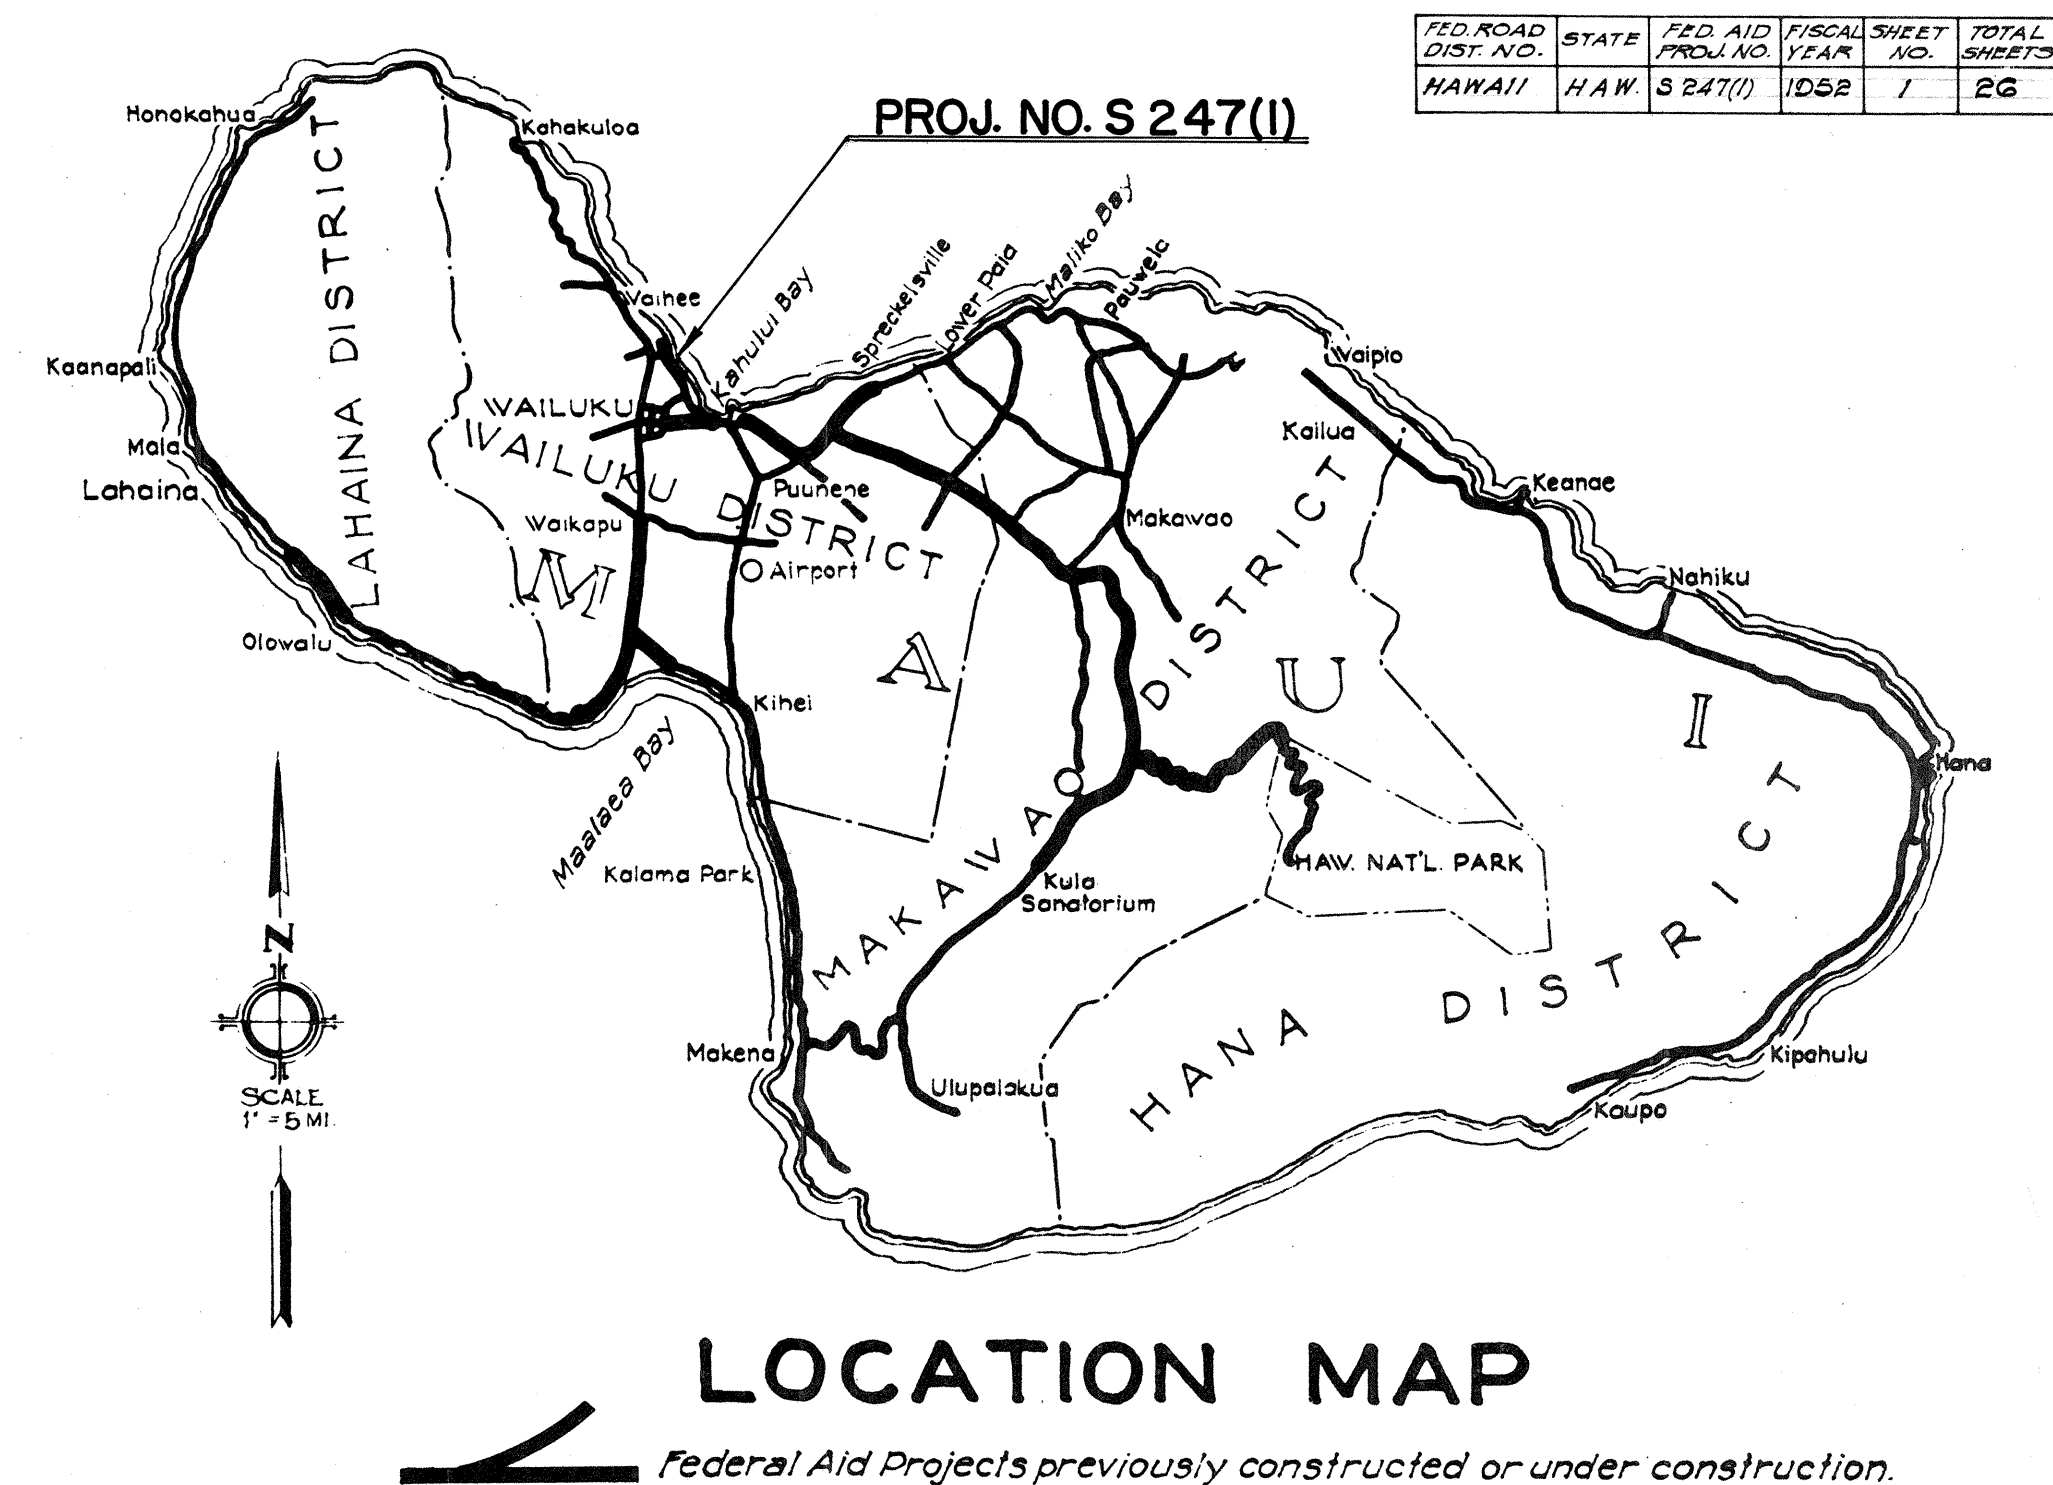

NOTE:

ALL CHANGES MADE DURING CONSTRUCTION
HAVE BEEN NOTED IN RED ON THESE
TRACINGS AND CHECKED BY:

[Signature]
DISTRICT ENGINEER
May 6, 1954
DATE

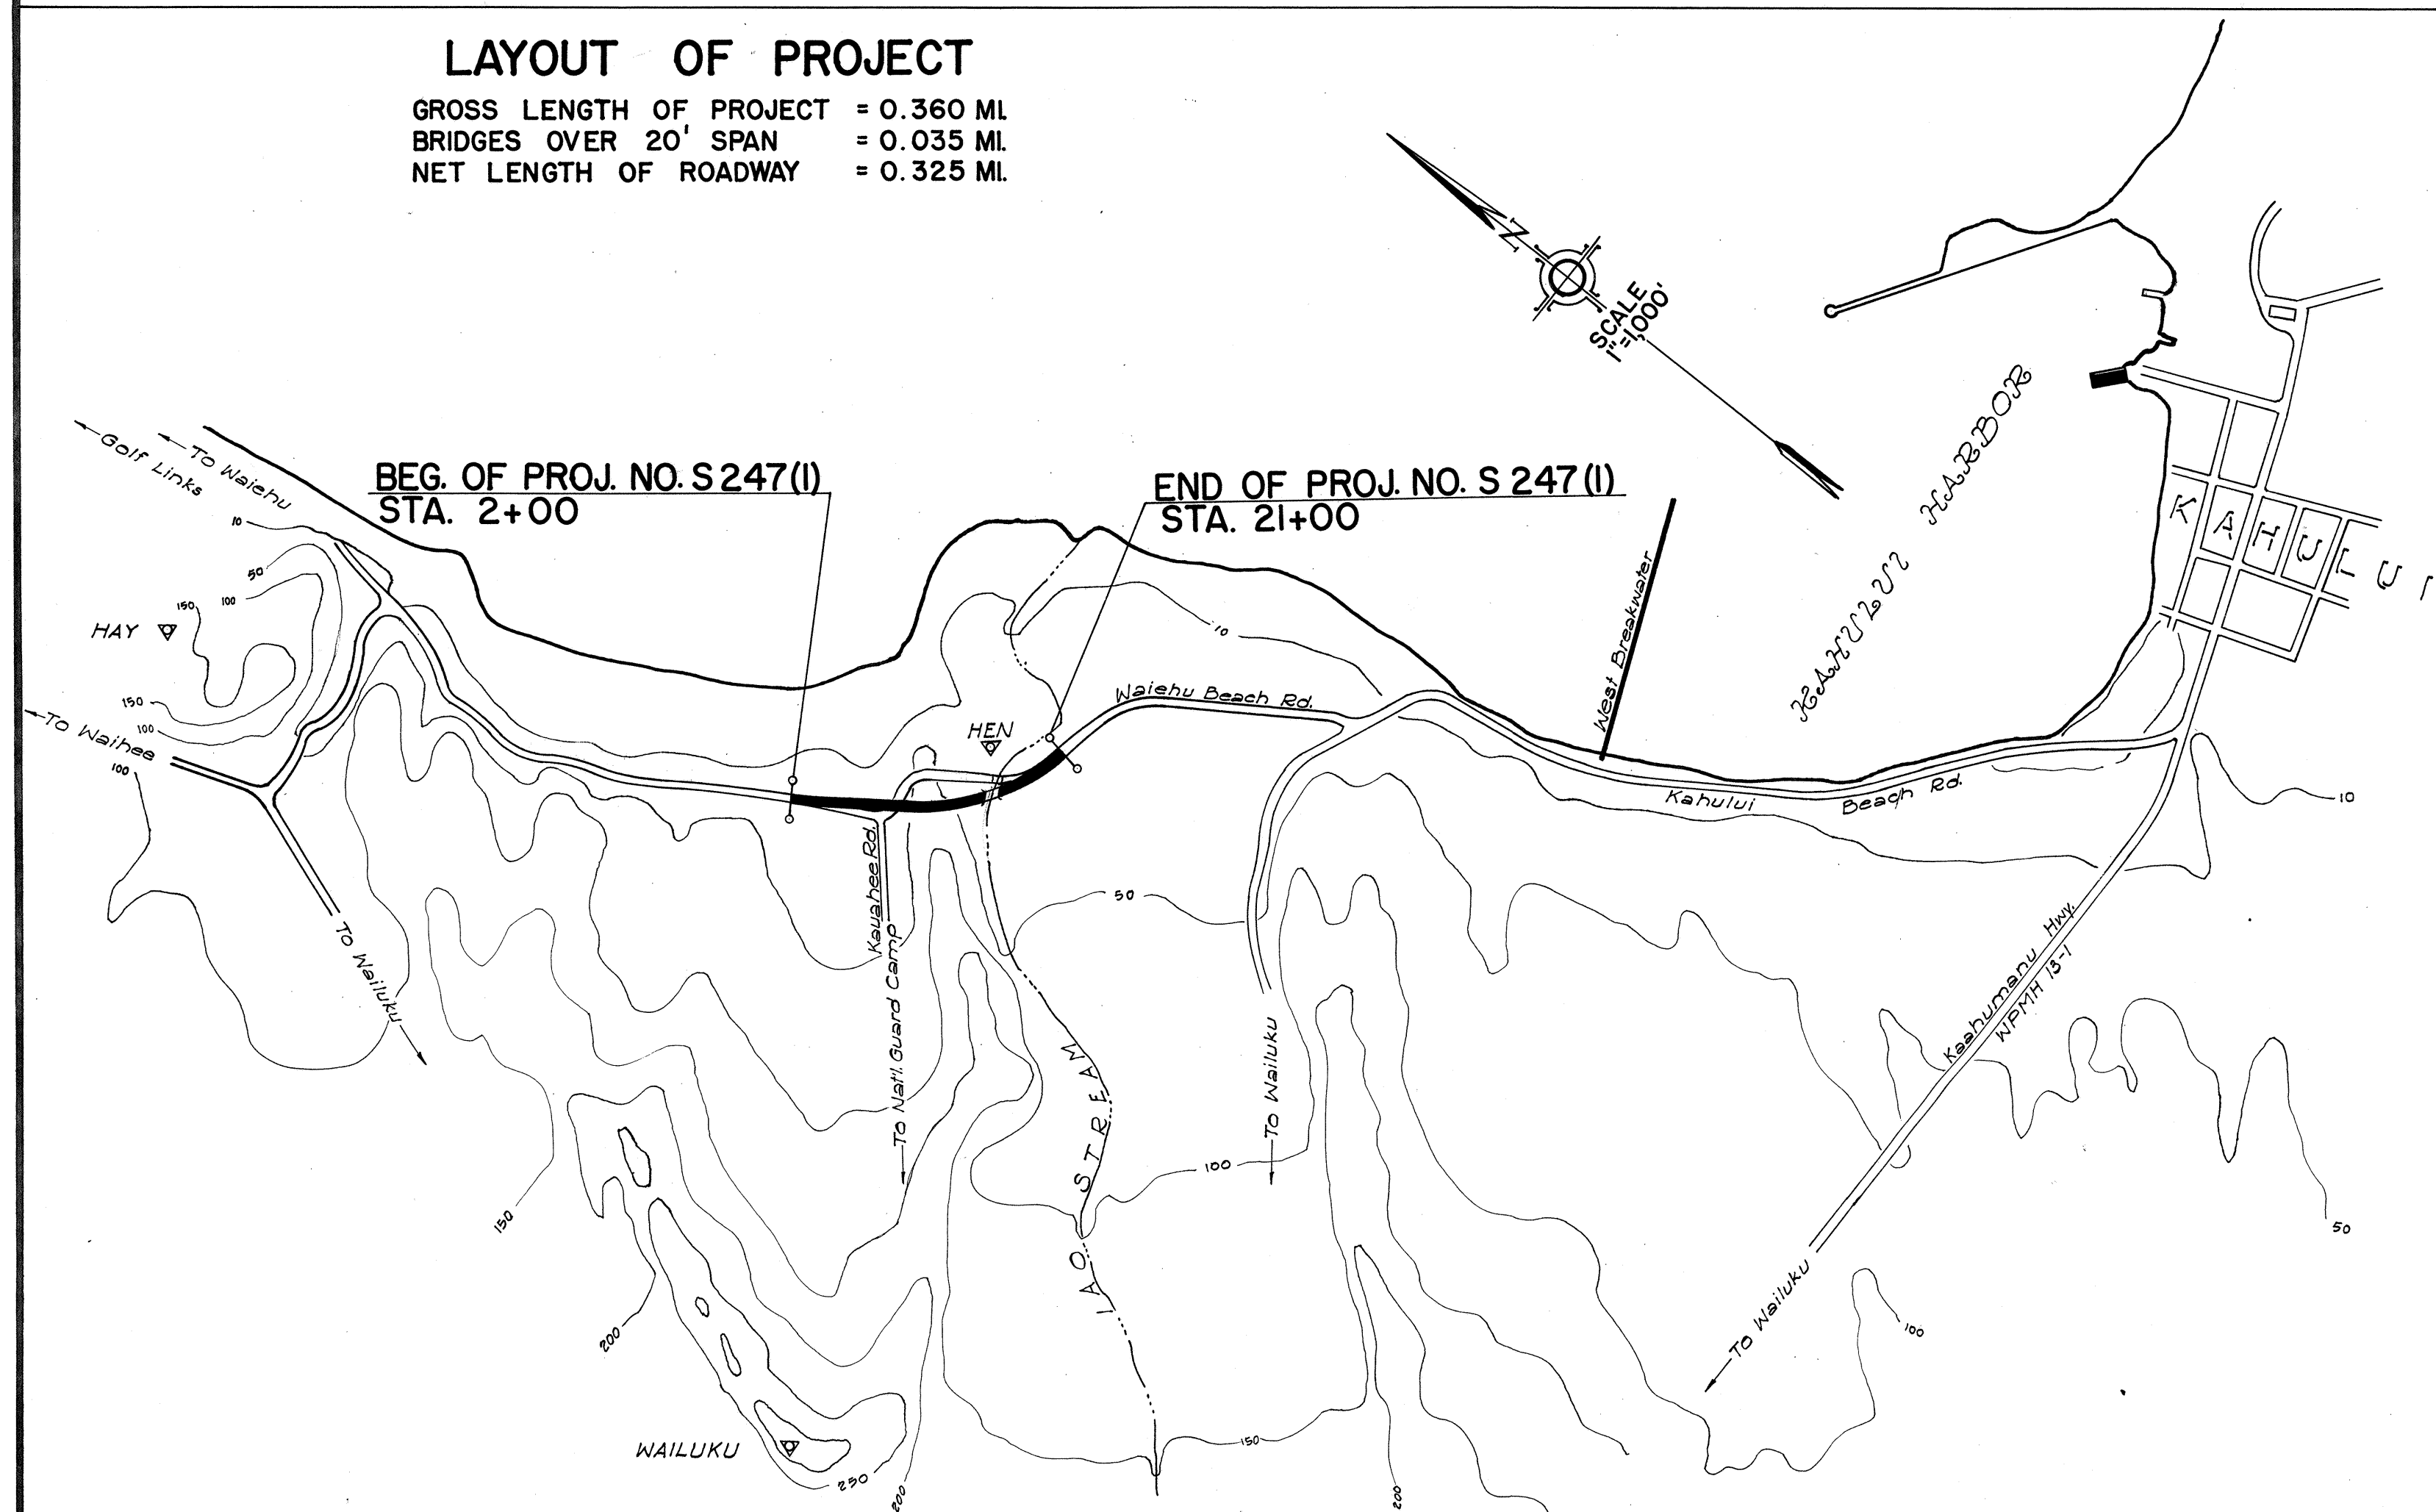

APPROVED: *[Signature]* DATE 12/22/52
TERRITORIAL HIGHWAY ENGINEER

DEPARTMENT OF COMMERCE BUREAU OF PUBLIC ROADS	
RECOMMENDED FOR APPROVAL:	
DISTRICT ENGINEER	DATE
APPROVED:	
DIVISION ENGINEER	DATE