

FINAL SURVEY NO. _____	BY _____	DATE _____	SURVEYED _____
			PLOTTED _____
			NOTE BOOK _____
			AREAS CHECKED _____

ORIGINAL SURVEY NO. _____	BY _____	DATE _____	SURVEYED _____
			PLOTTED _____
			NOTE BOOK _____
			AREAS CHECKED _____

FED. ROAD DIST. No.	STATE	FED. AID PROJ. No.	FISCAL YEAR	SHEET No.	TOTAL SHEETS
HAWAII	HAW.	503401	1955	19	29

(29)













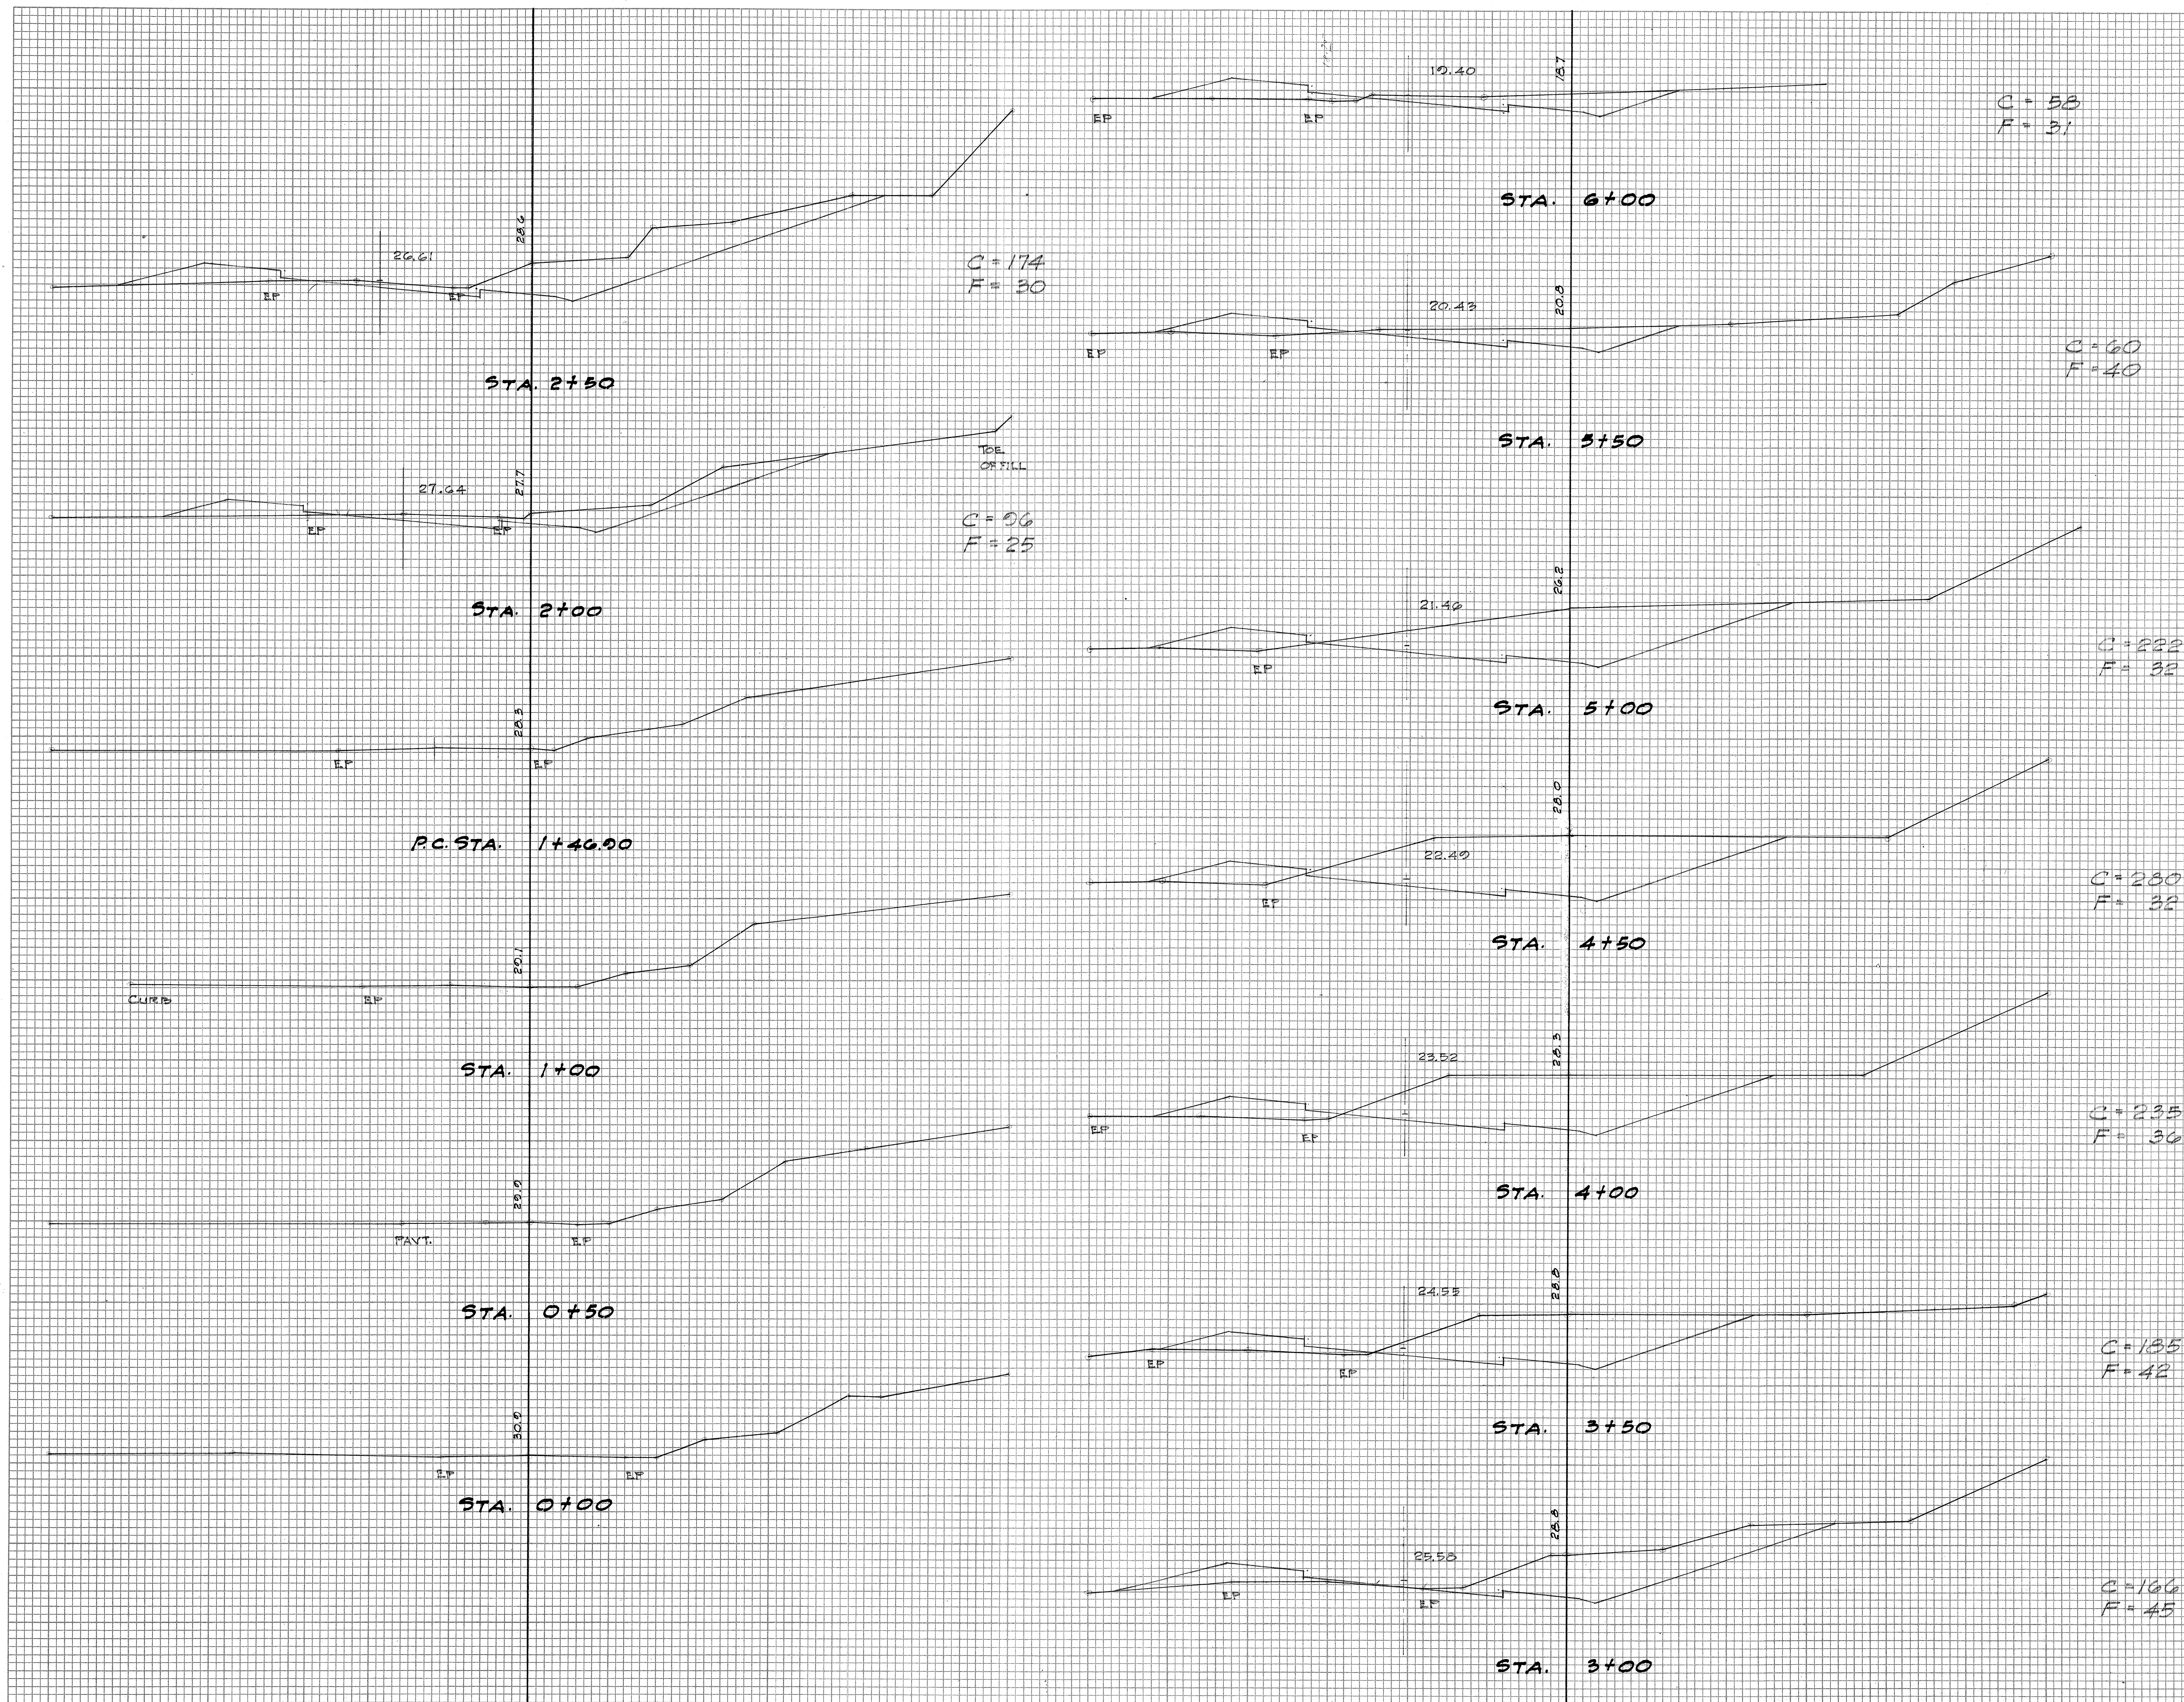


PLATE 3 CROSS SECTION O.P.R. & R.E. STANDARD
100% RAS PAPER-MADE AND PRINTED IN U. S. A.
EUGENE DIETZEN CO.

5547.19

FINAL SURVEY	DATE
SURVEYED	BY
NOTED	BY
TEMPERATURE	BY
WIND	BY
MOON	BY
AREAS CHECKED	BY
NO.	BY

ORIGINAL SURVEY	DATE
SURVEYED	BY
NOTED	BY
TEMPERATURE	BY
WIND	BY
MOON	BY
AREAS CHECKED	BY
NO.	BY

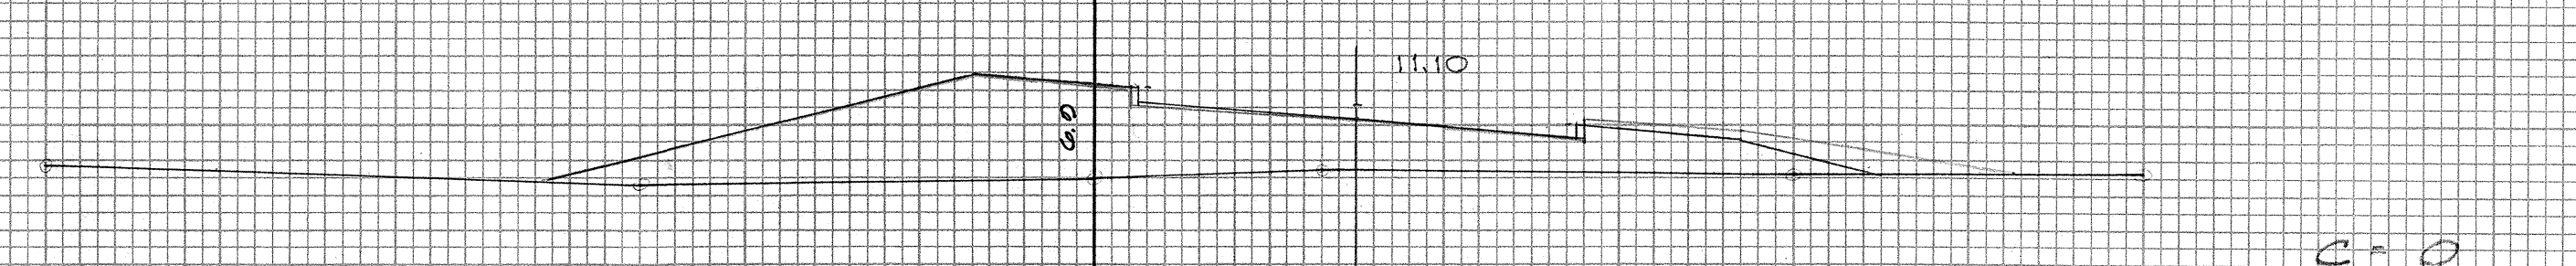
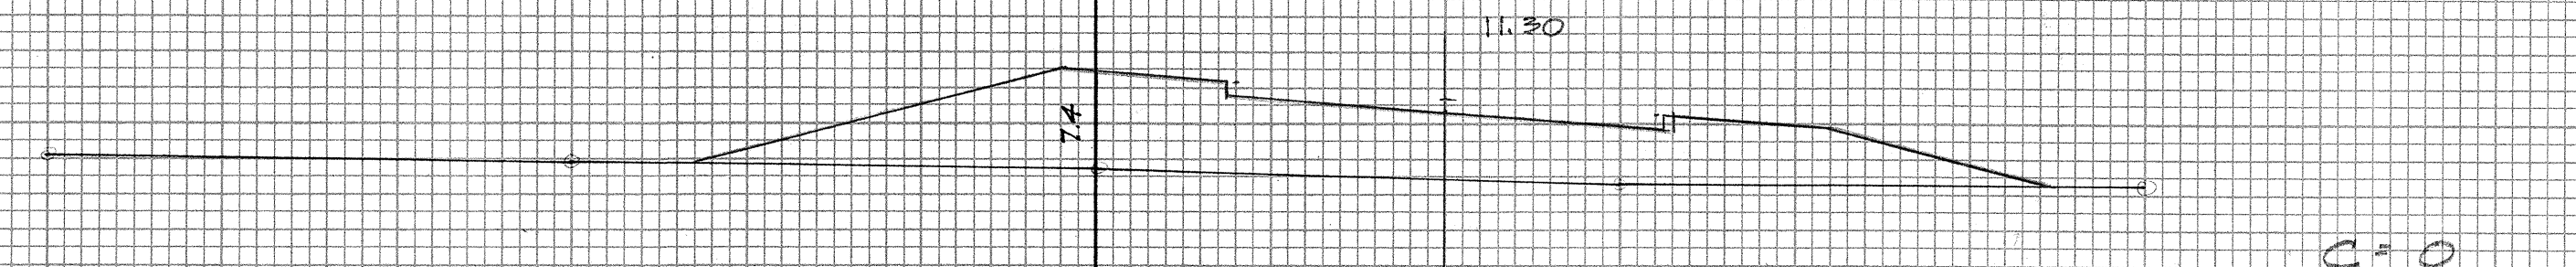
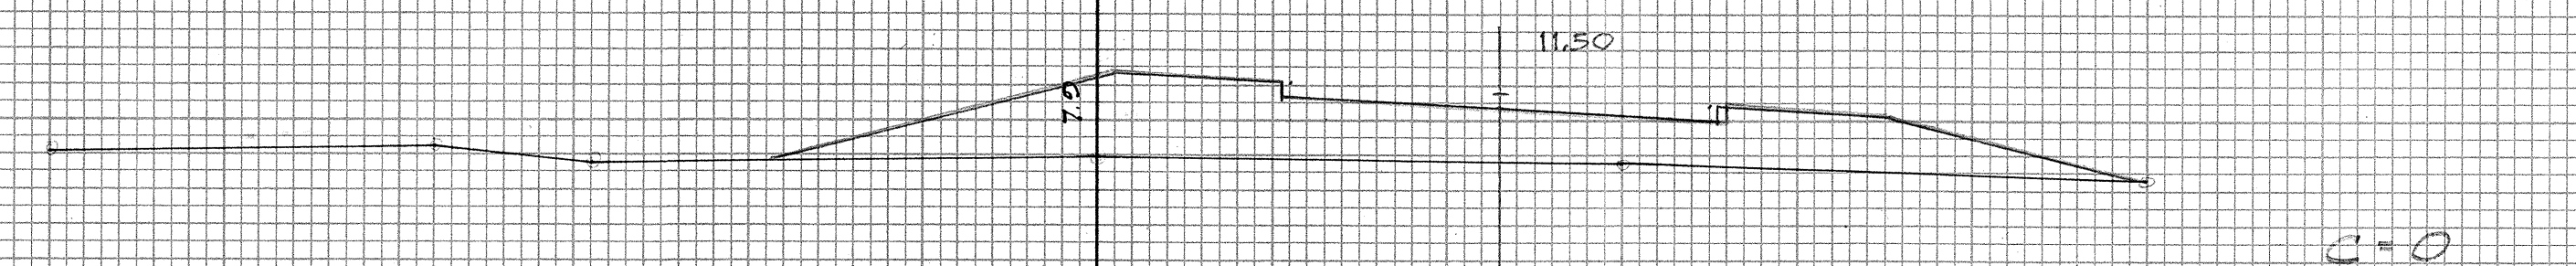
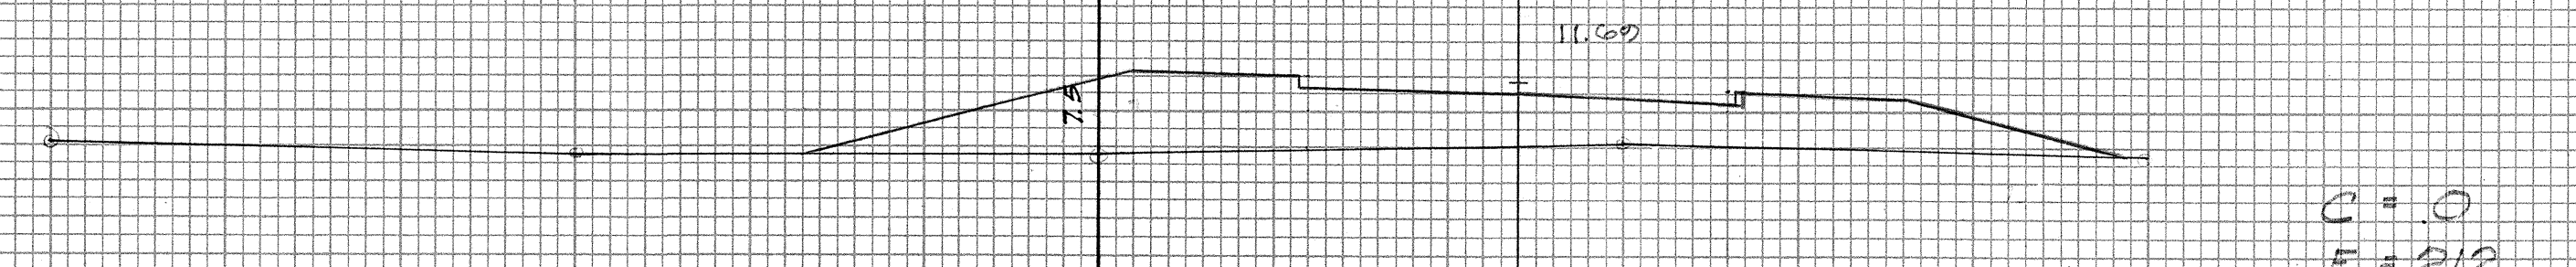
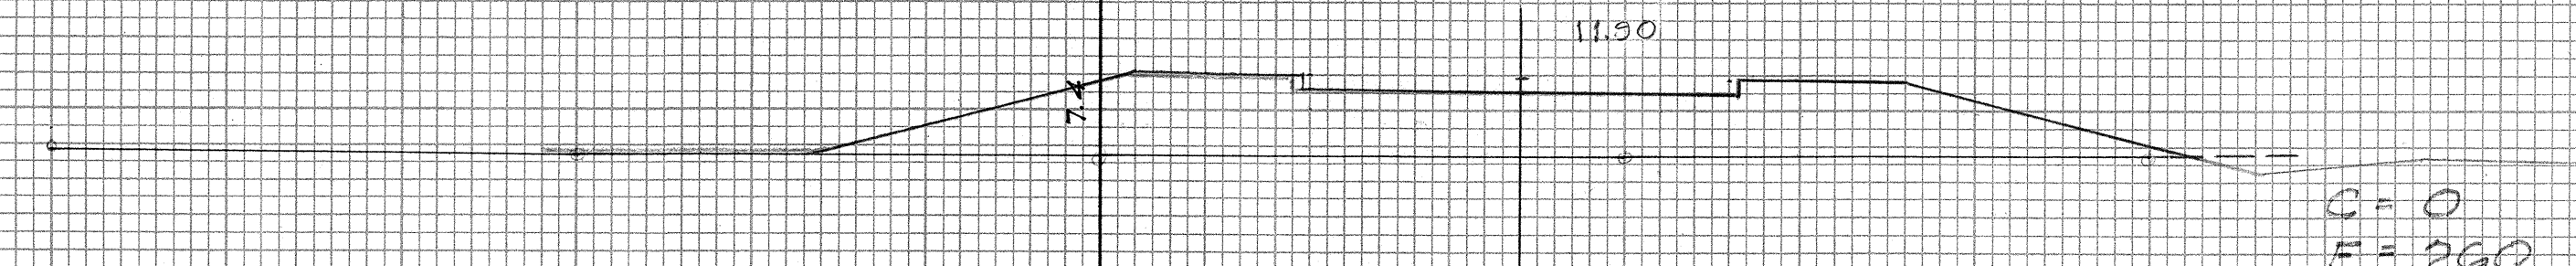
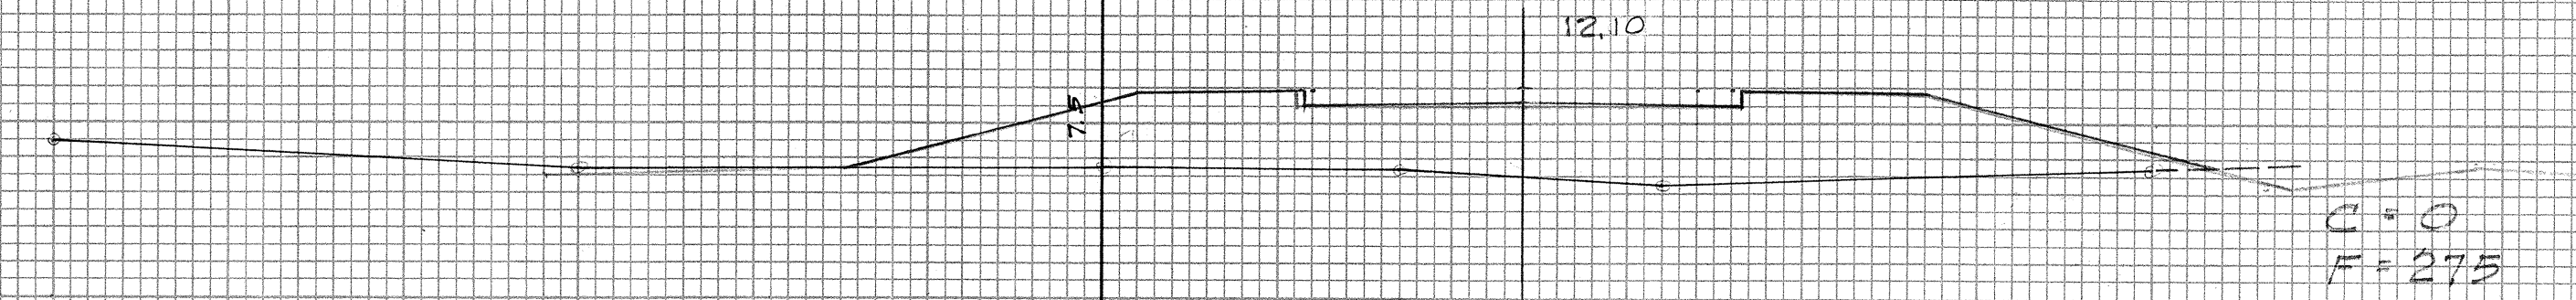
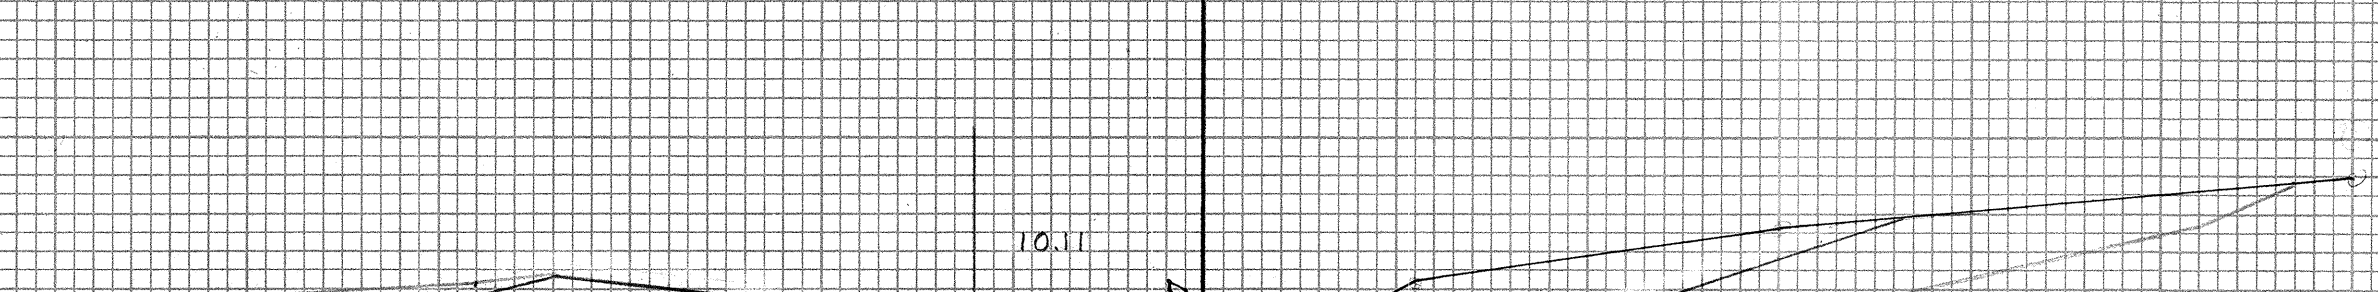
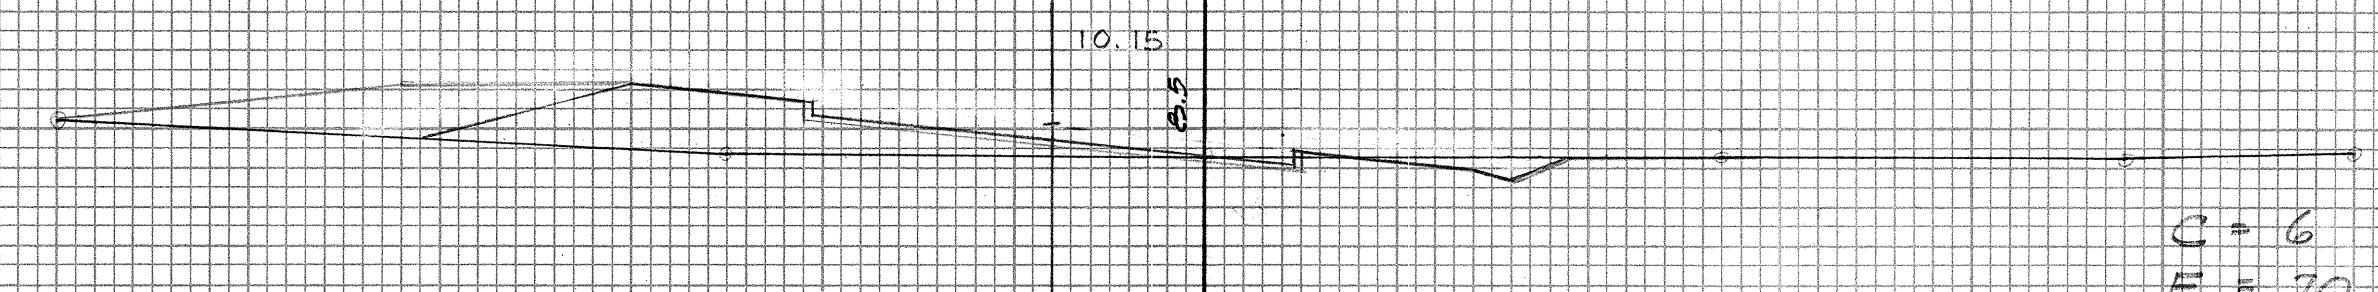
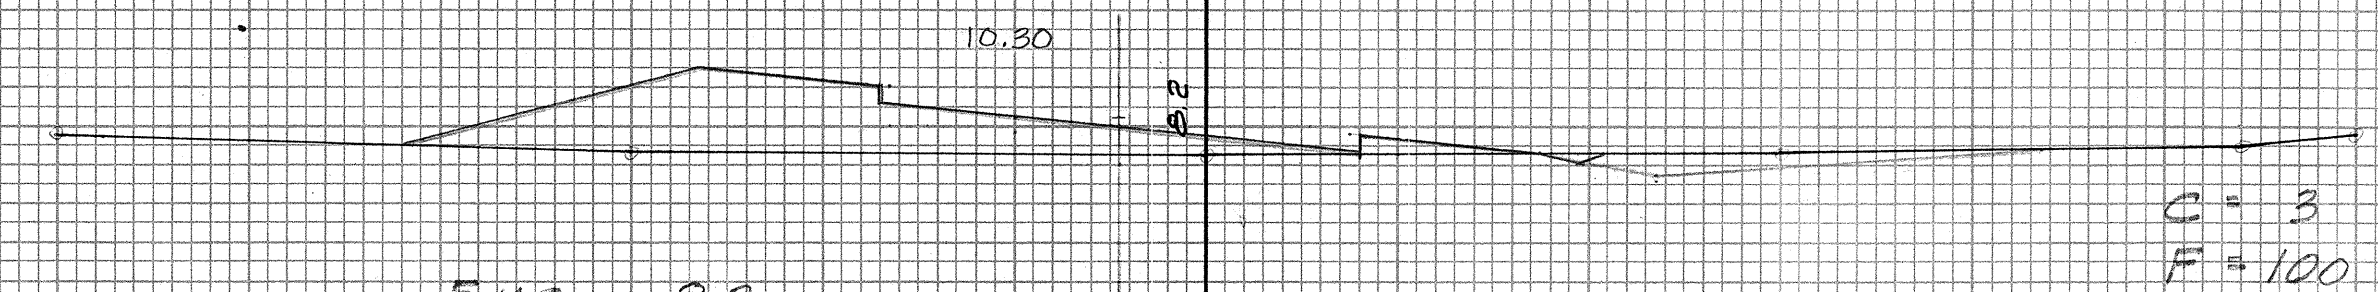
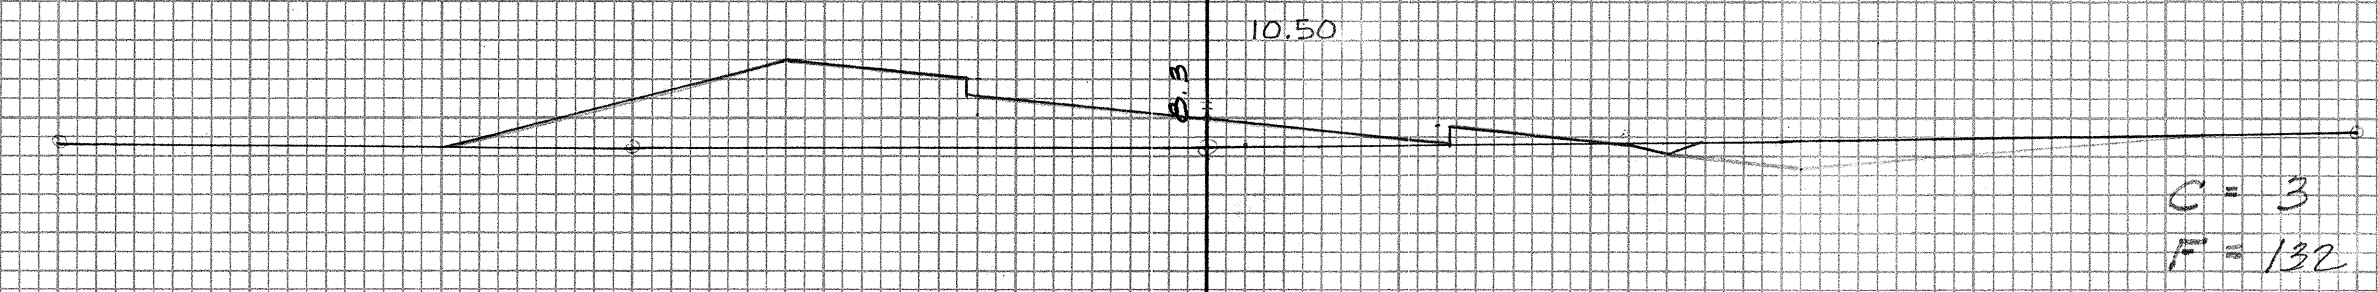
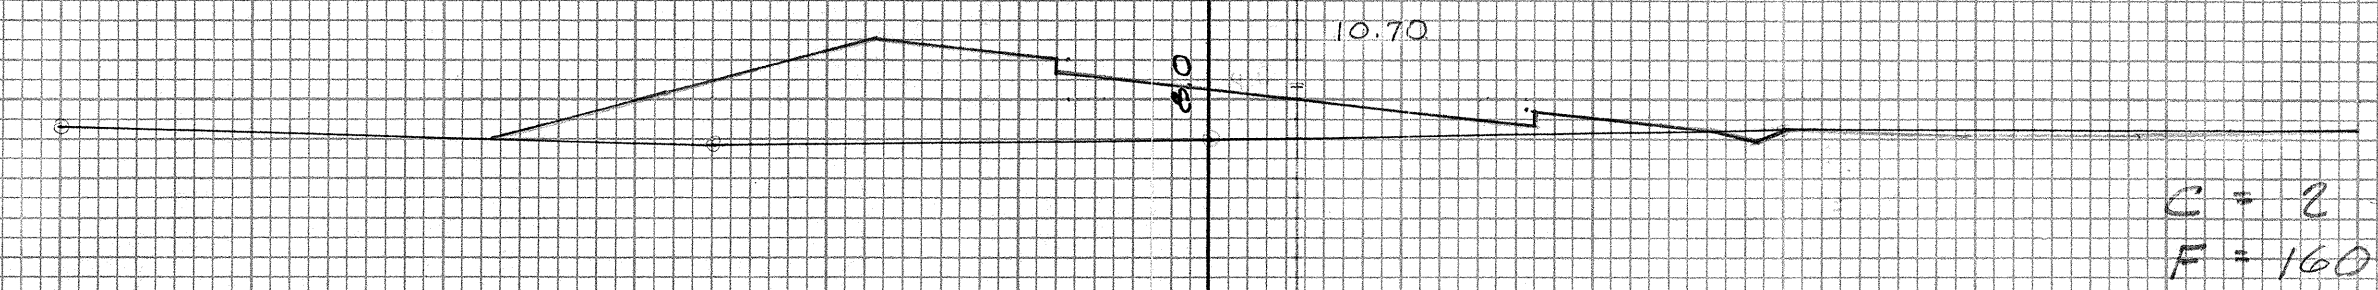
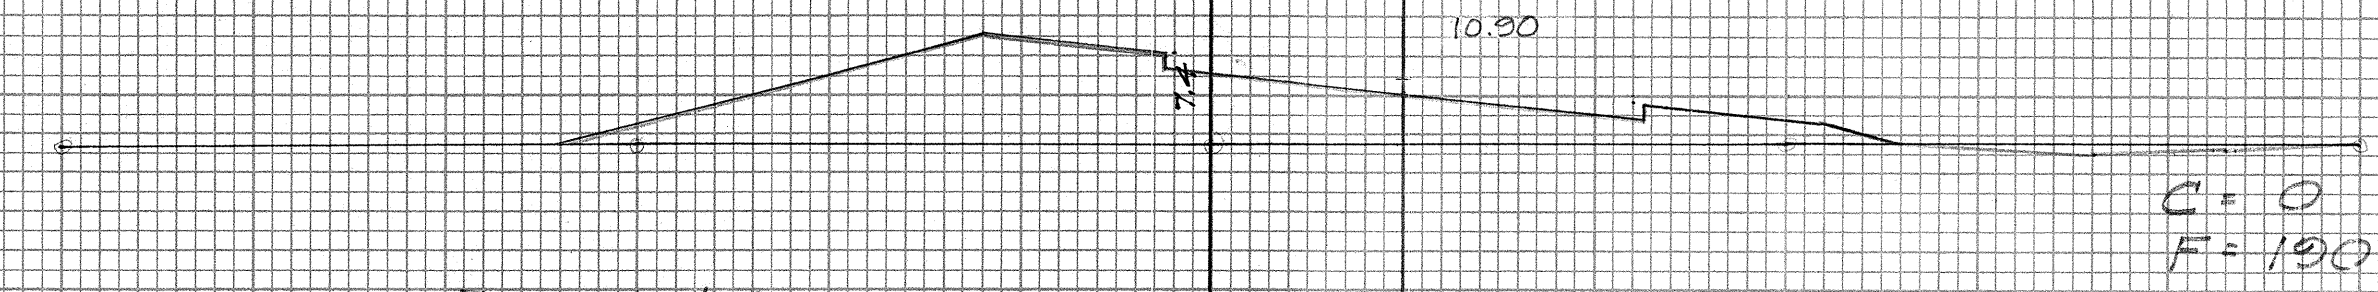


FINAL SURVEY	DATE	
	BY	
	SURVEYED	
	TEMPLATE	
	NO. BOOK	
	AREAS CHECKED	
	NO.	

ORIGINAL SURVEY	DATE	
	BY	
	SURVEYED	
	TEMPLATE	
	NO. BOOK	
	AREAS CHECKED	
	NO.	

FED. ROAD DIST. No.	STATE	FED. AID PROJ. No.	FISCAL YEAR	SHEET No.	TOTAL SHEETS
HAWAII	HAW.	5024011	1955	22	29

57

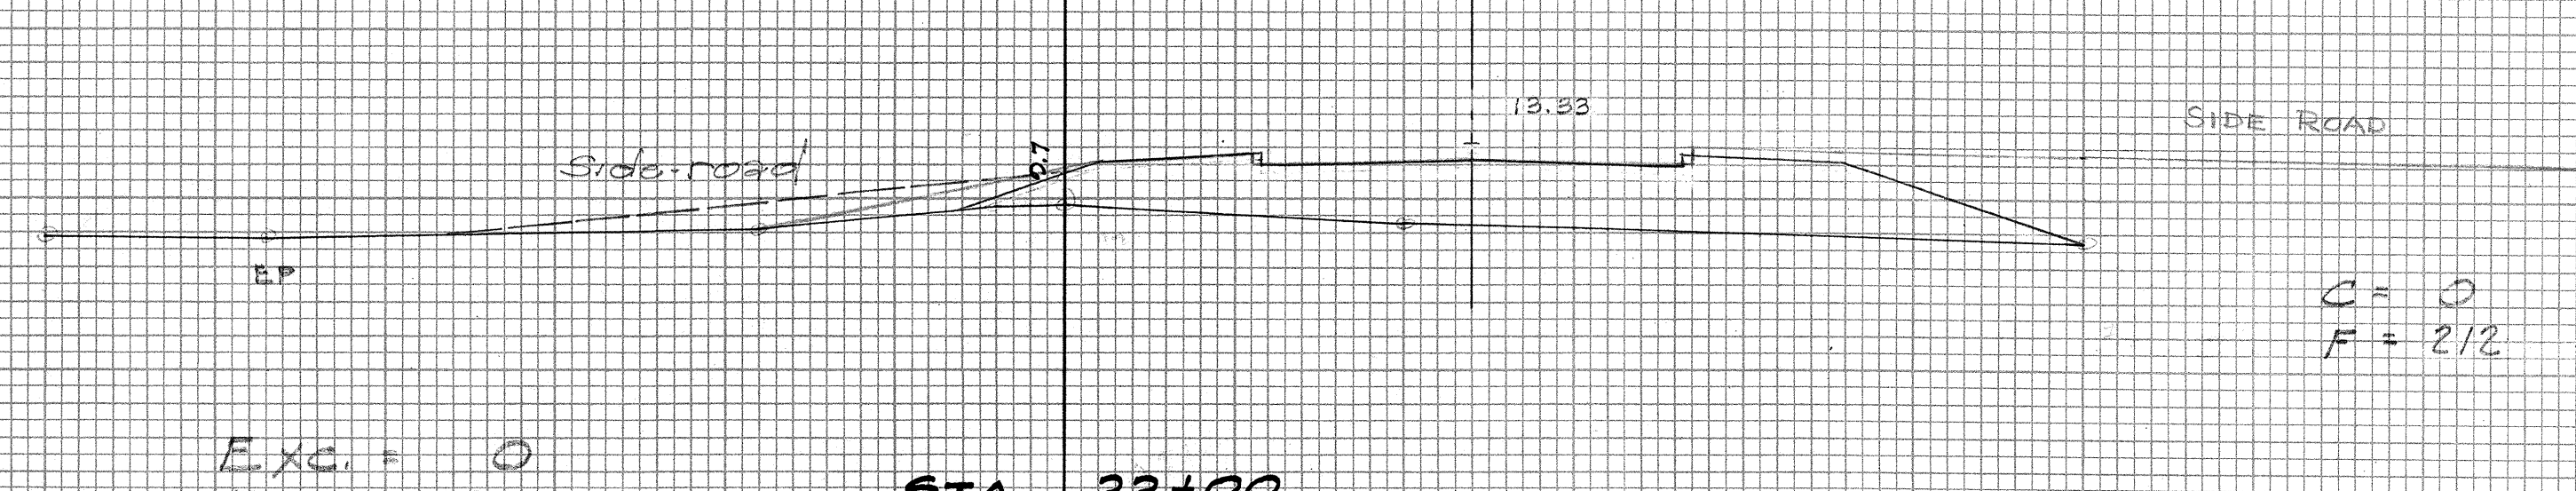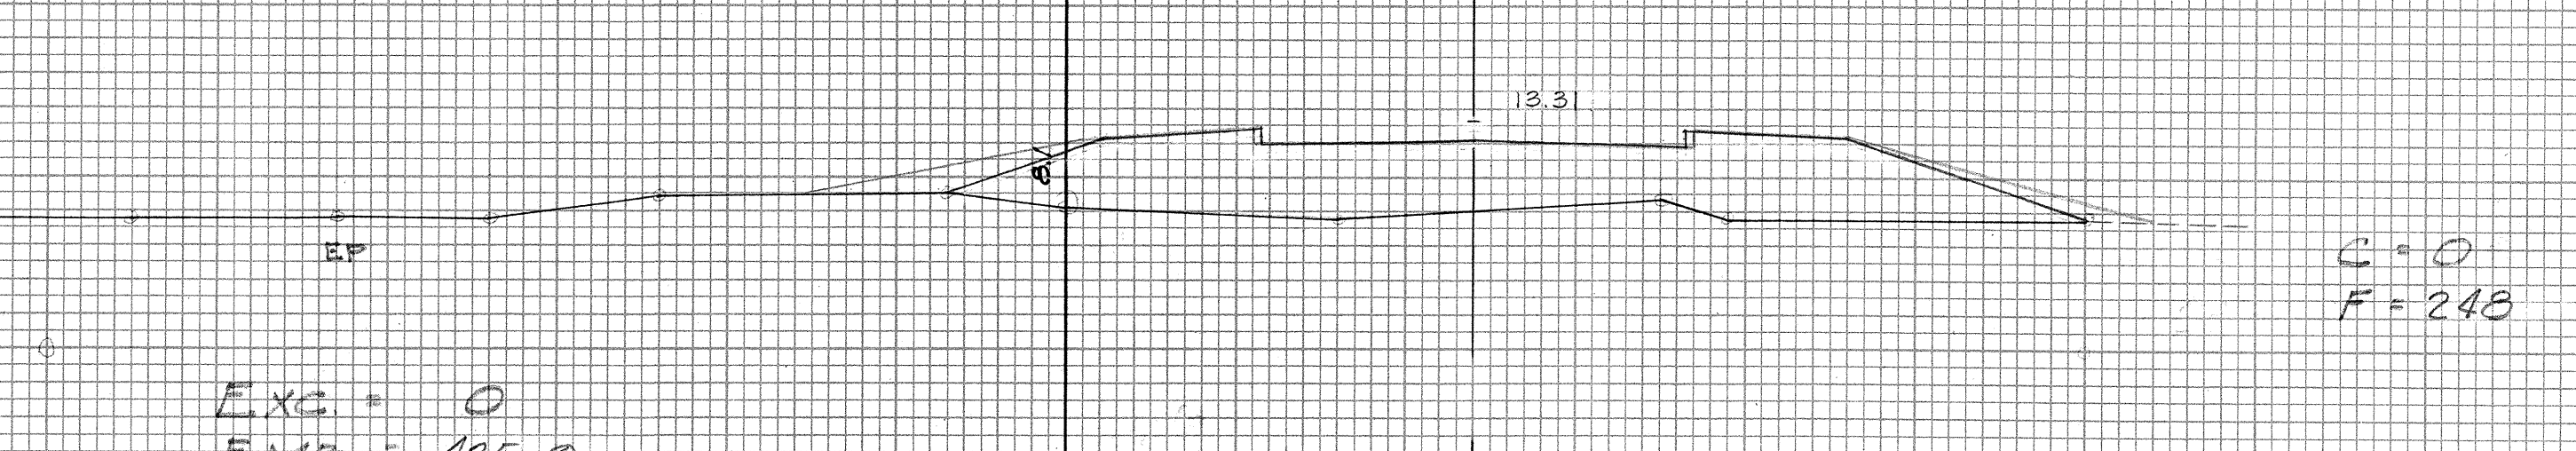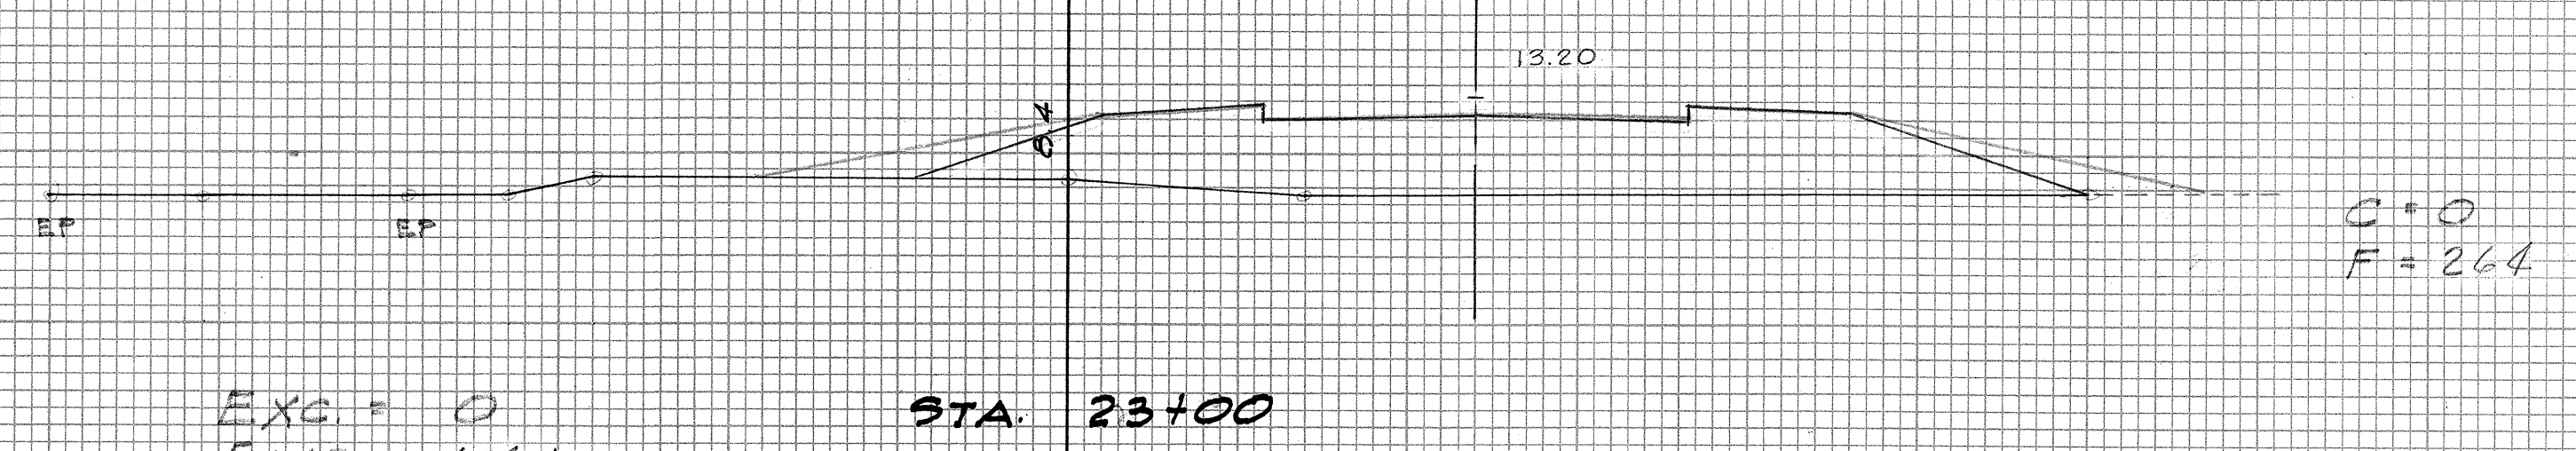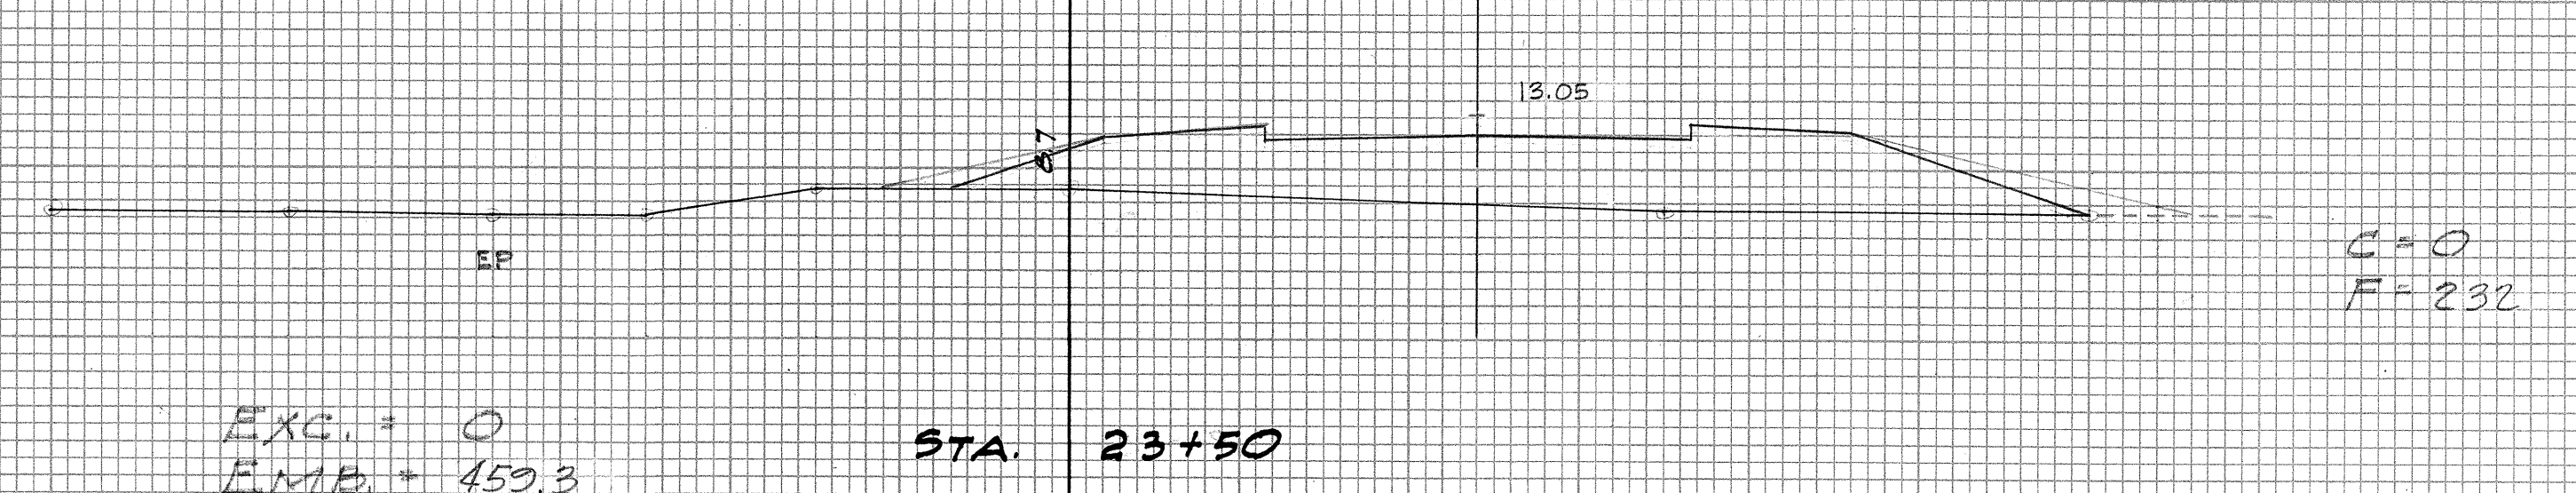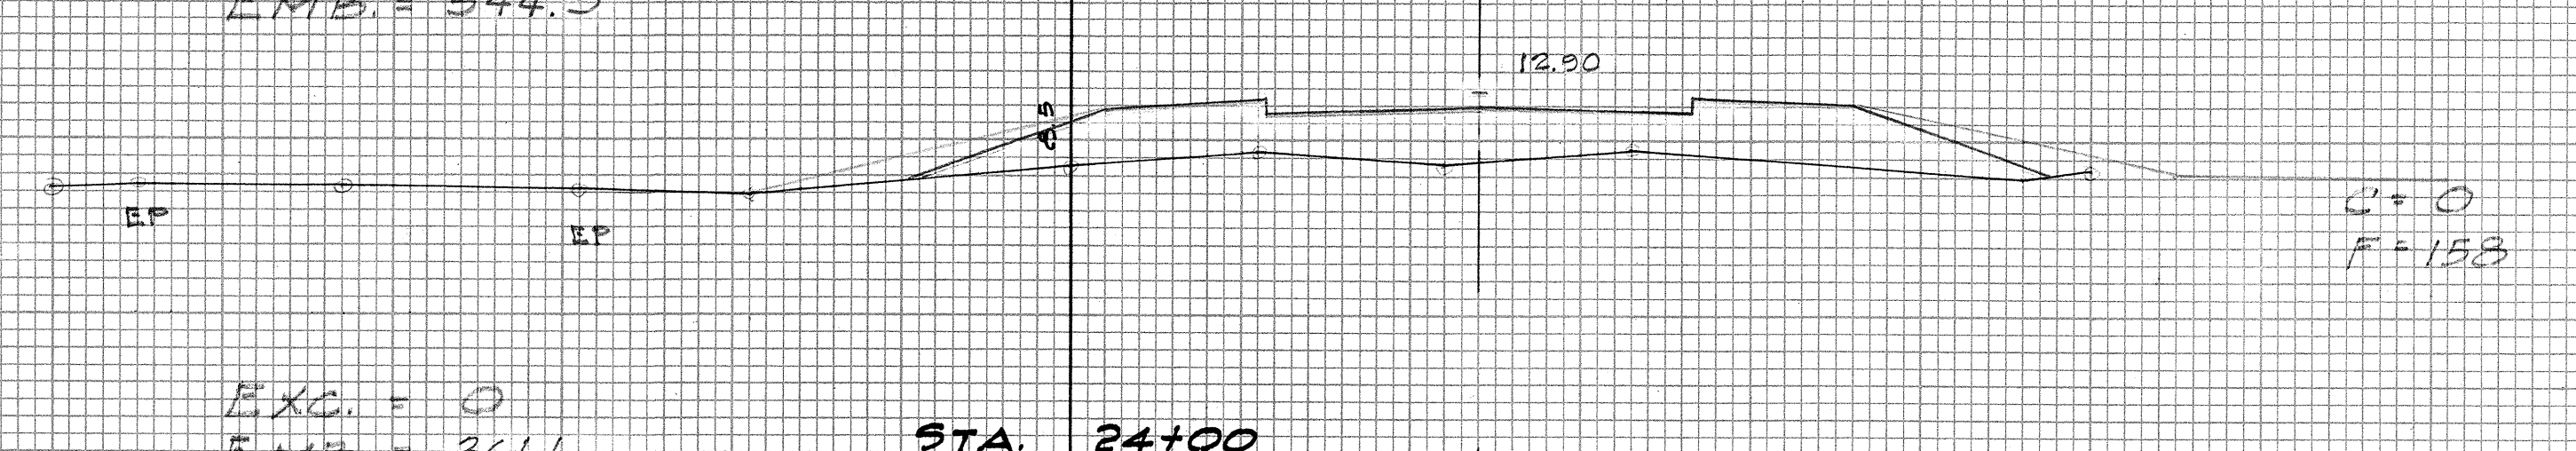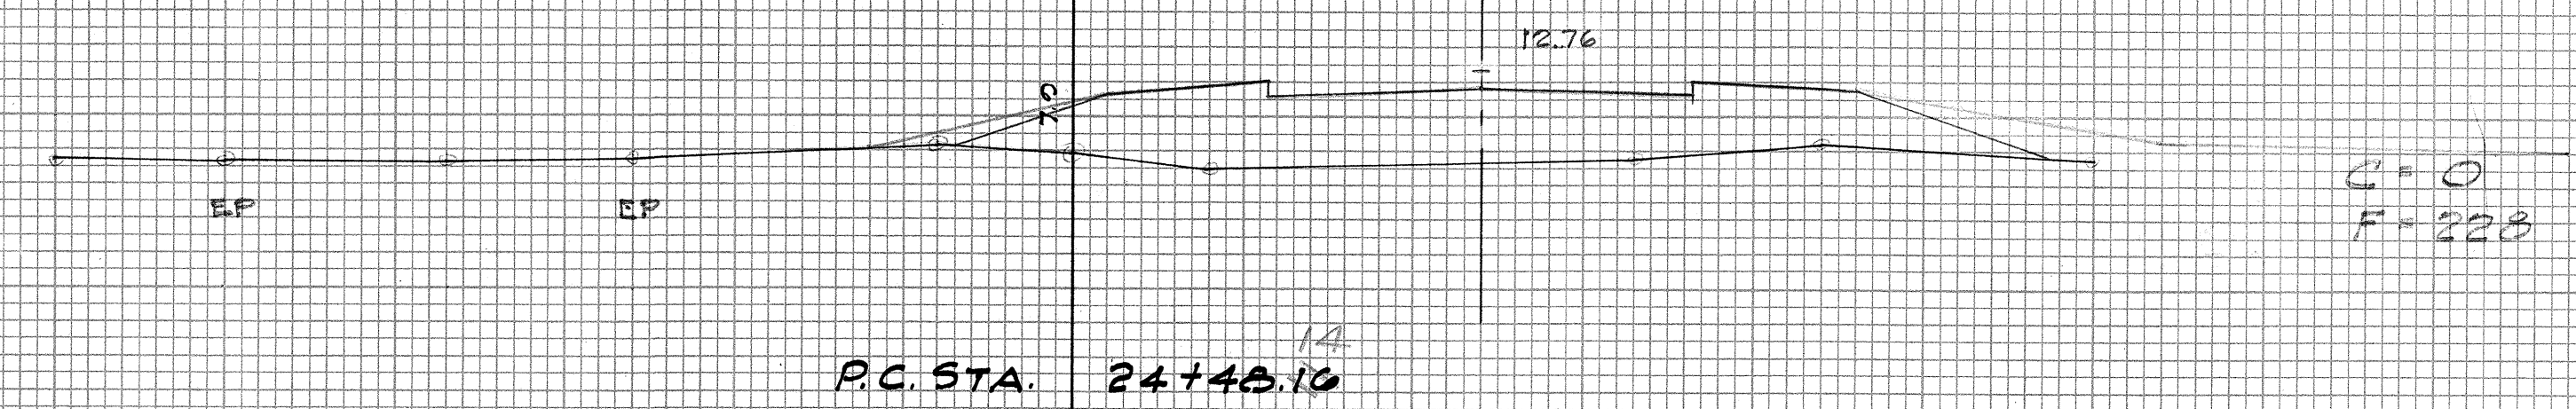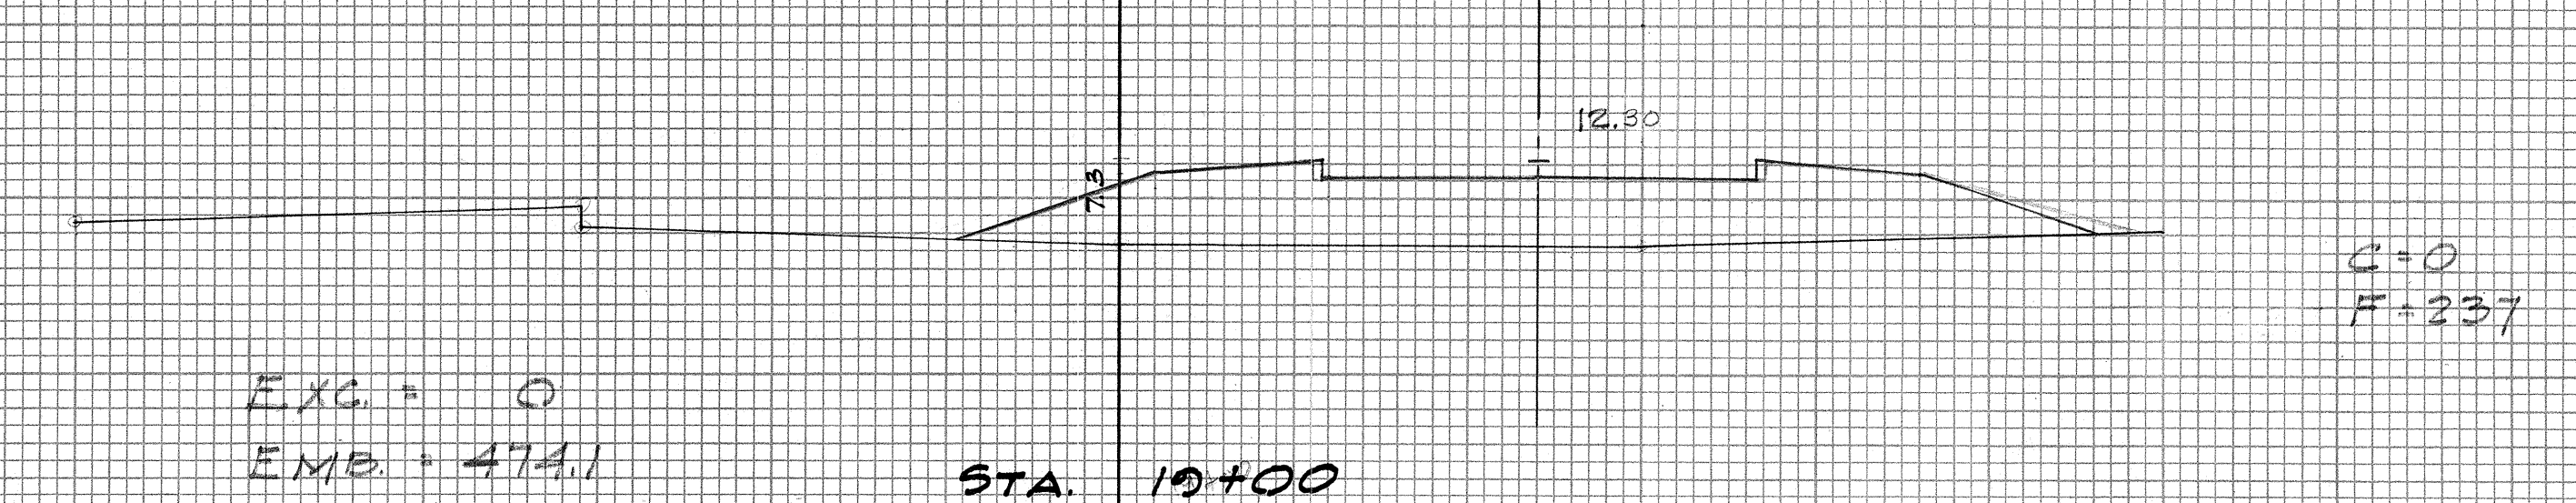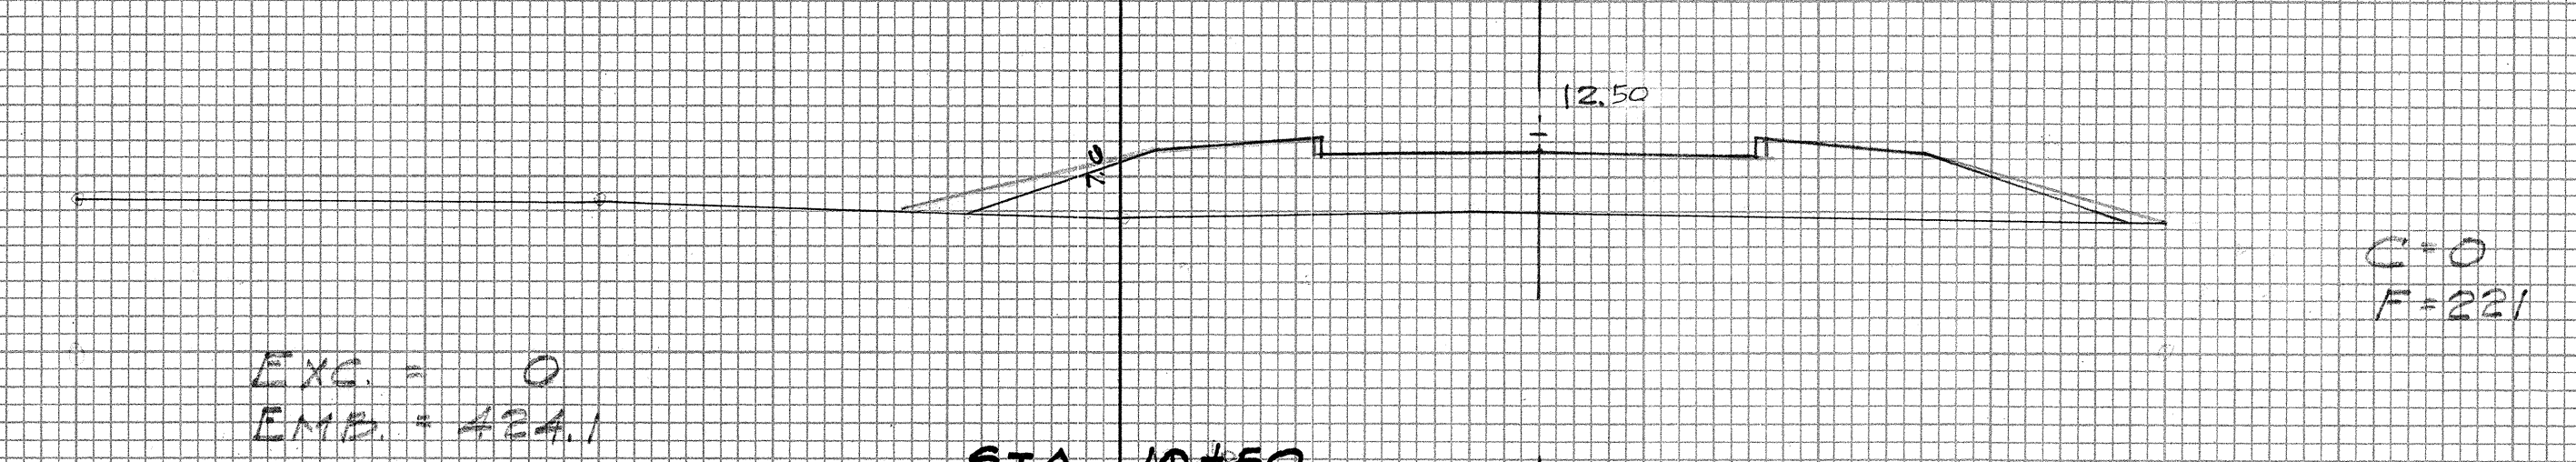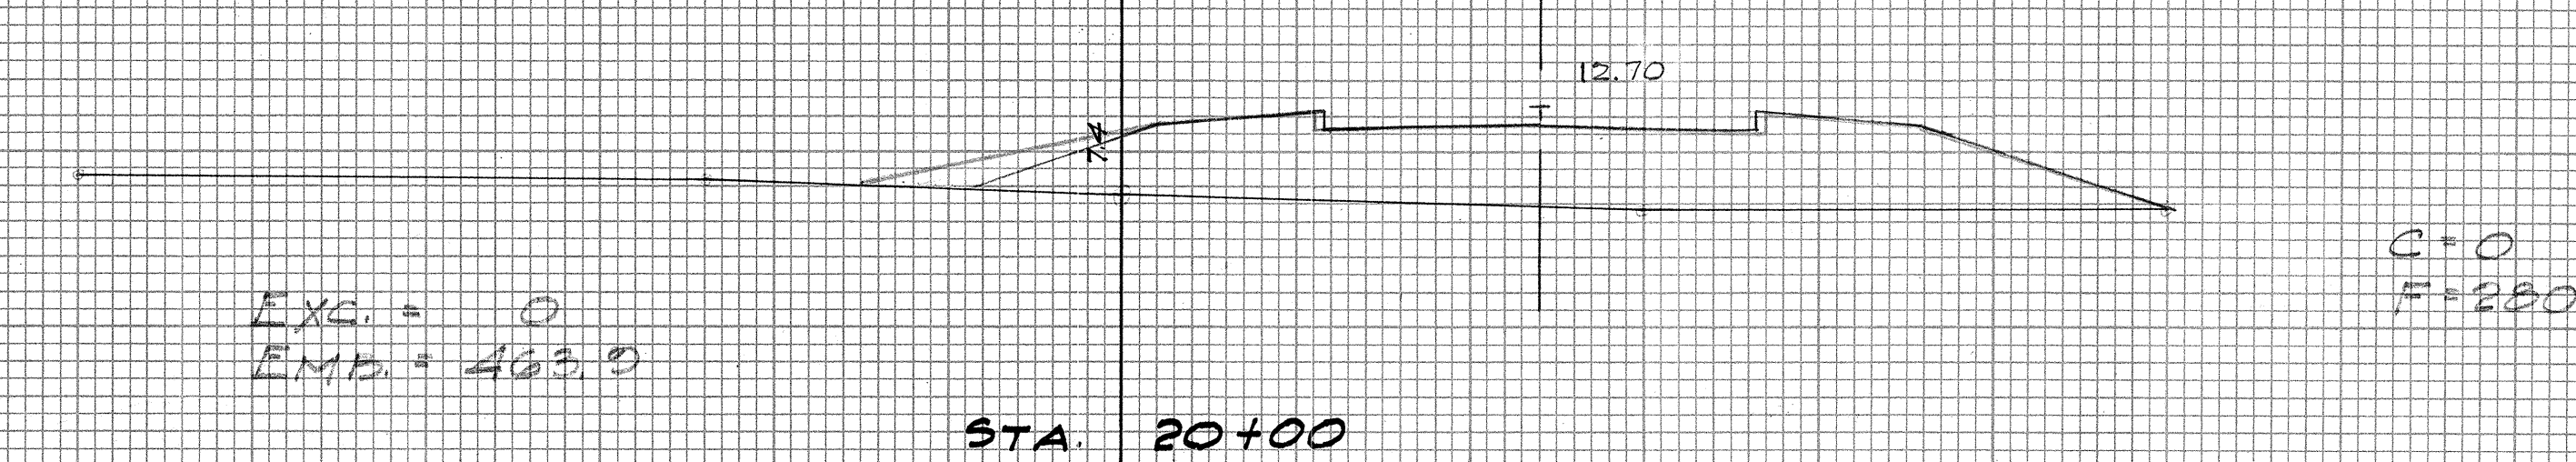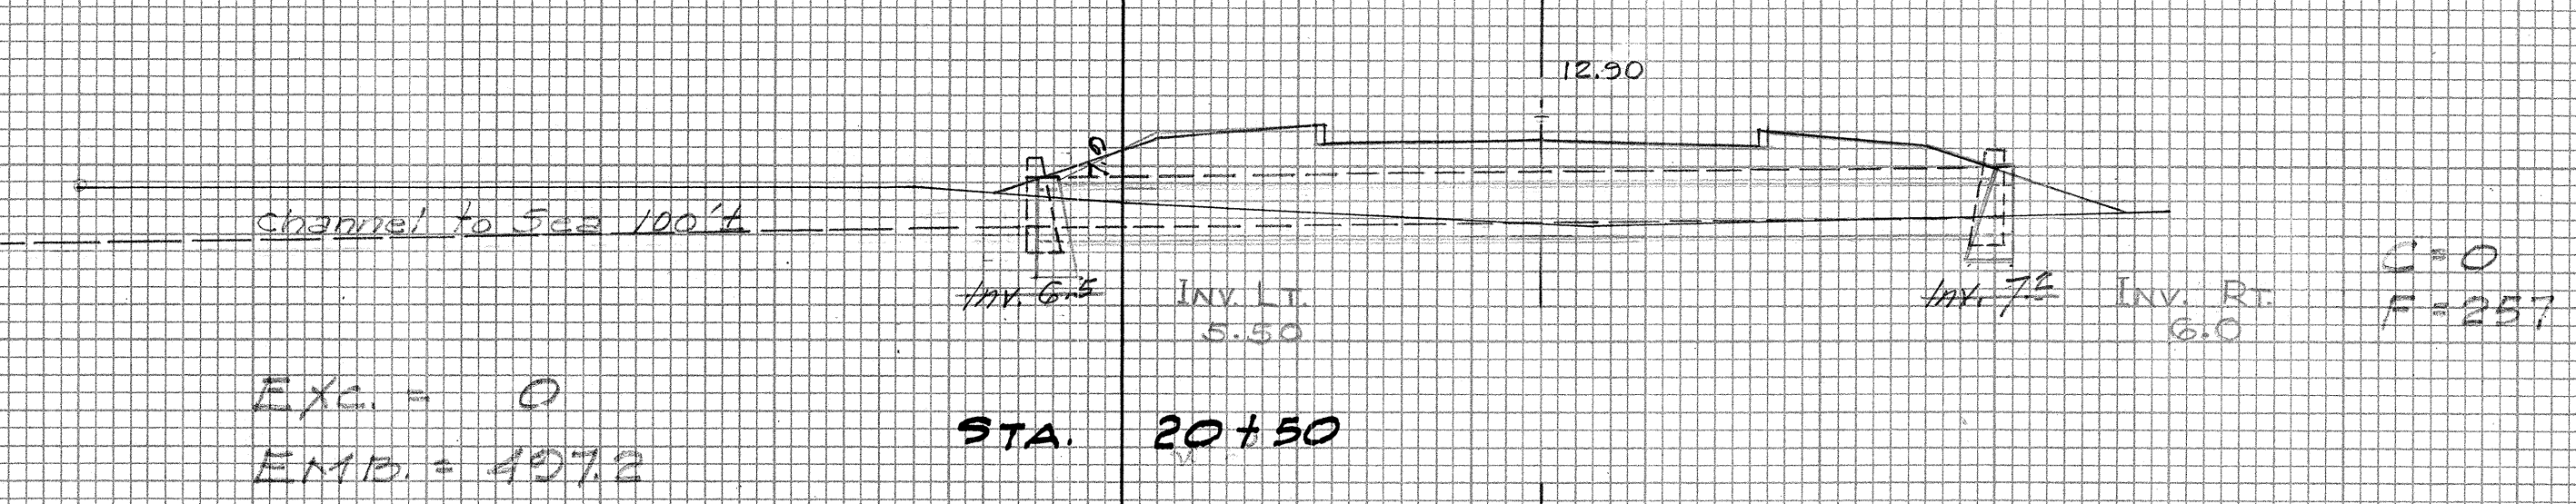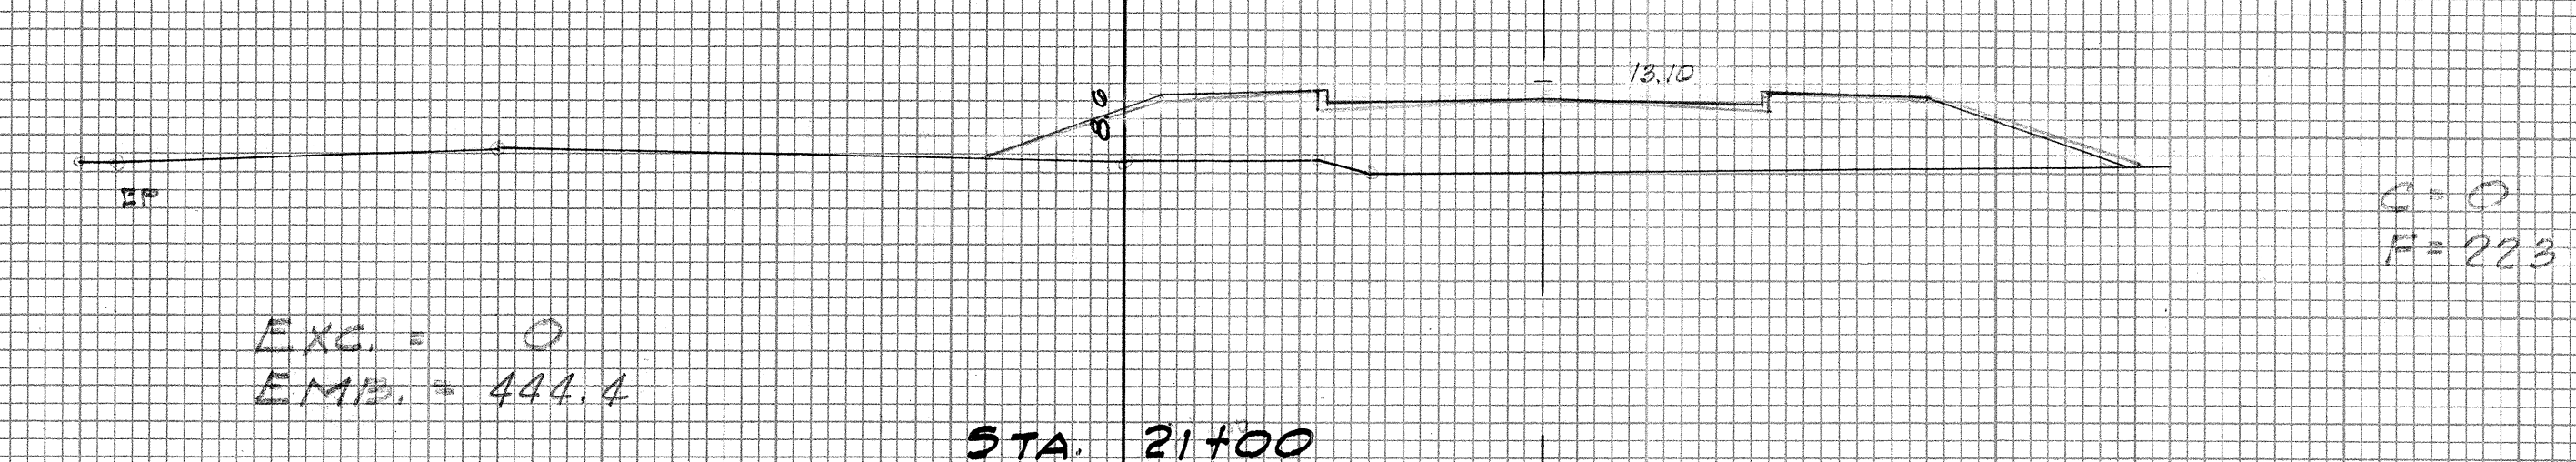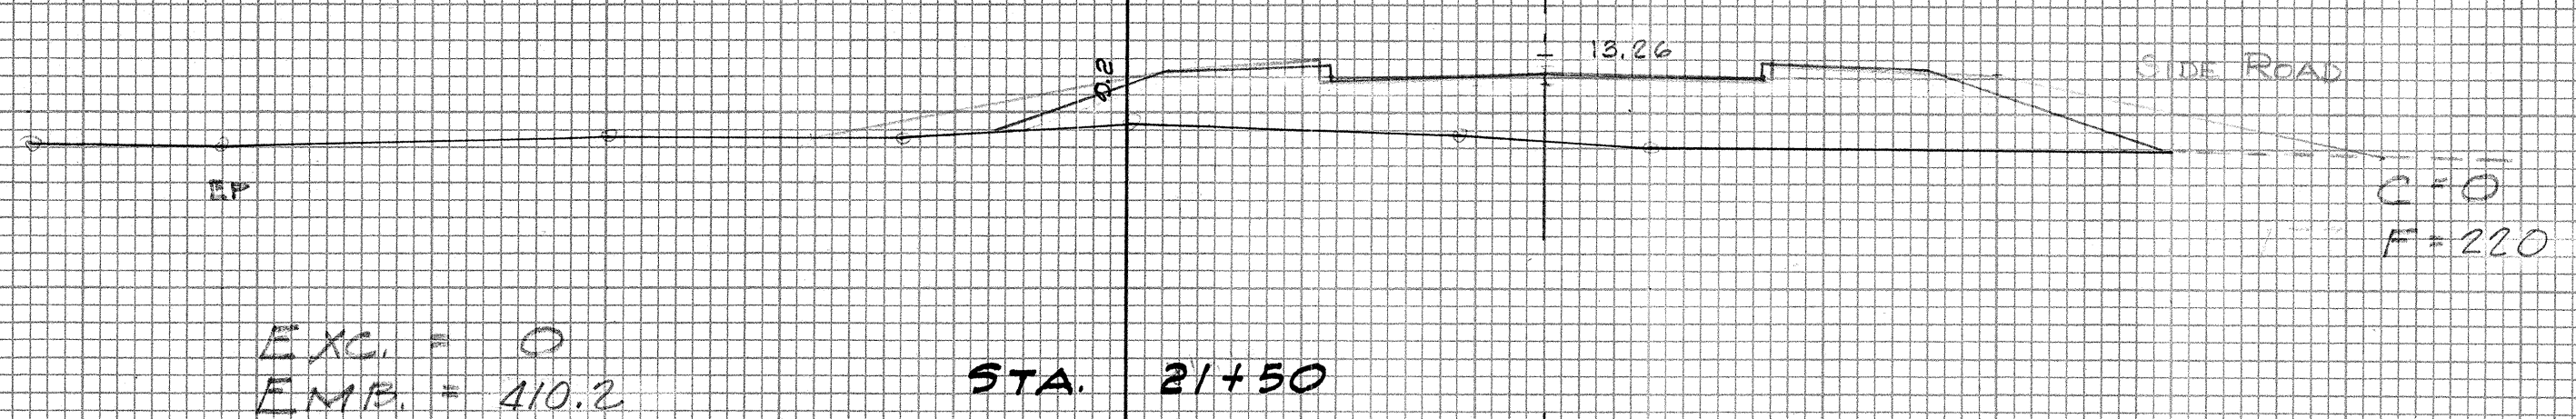


FED. ROAD DIST. NO.	STATE	FED. AID PROJ. NO.	FISCAL YEAR	SHEET NO.	TOTAL SHEETS
HAWAII	HAW.	5-0240(1)	1955	23	29

33

FINAL SURVEY	DATE	BY
SURVEYED		
PLOTTED		
NOTED		
AREAS CHECKED		
NO.		

ORIGINAL SURVEY	DATE	BY
SURVEYED		
PLOTTED		
NOTED		
AREAS CHECKED		
NO.		


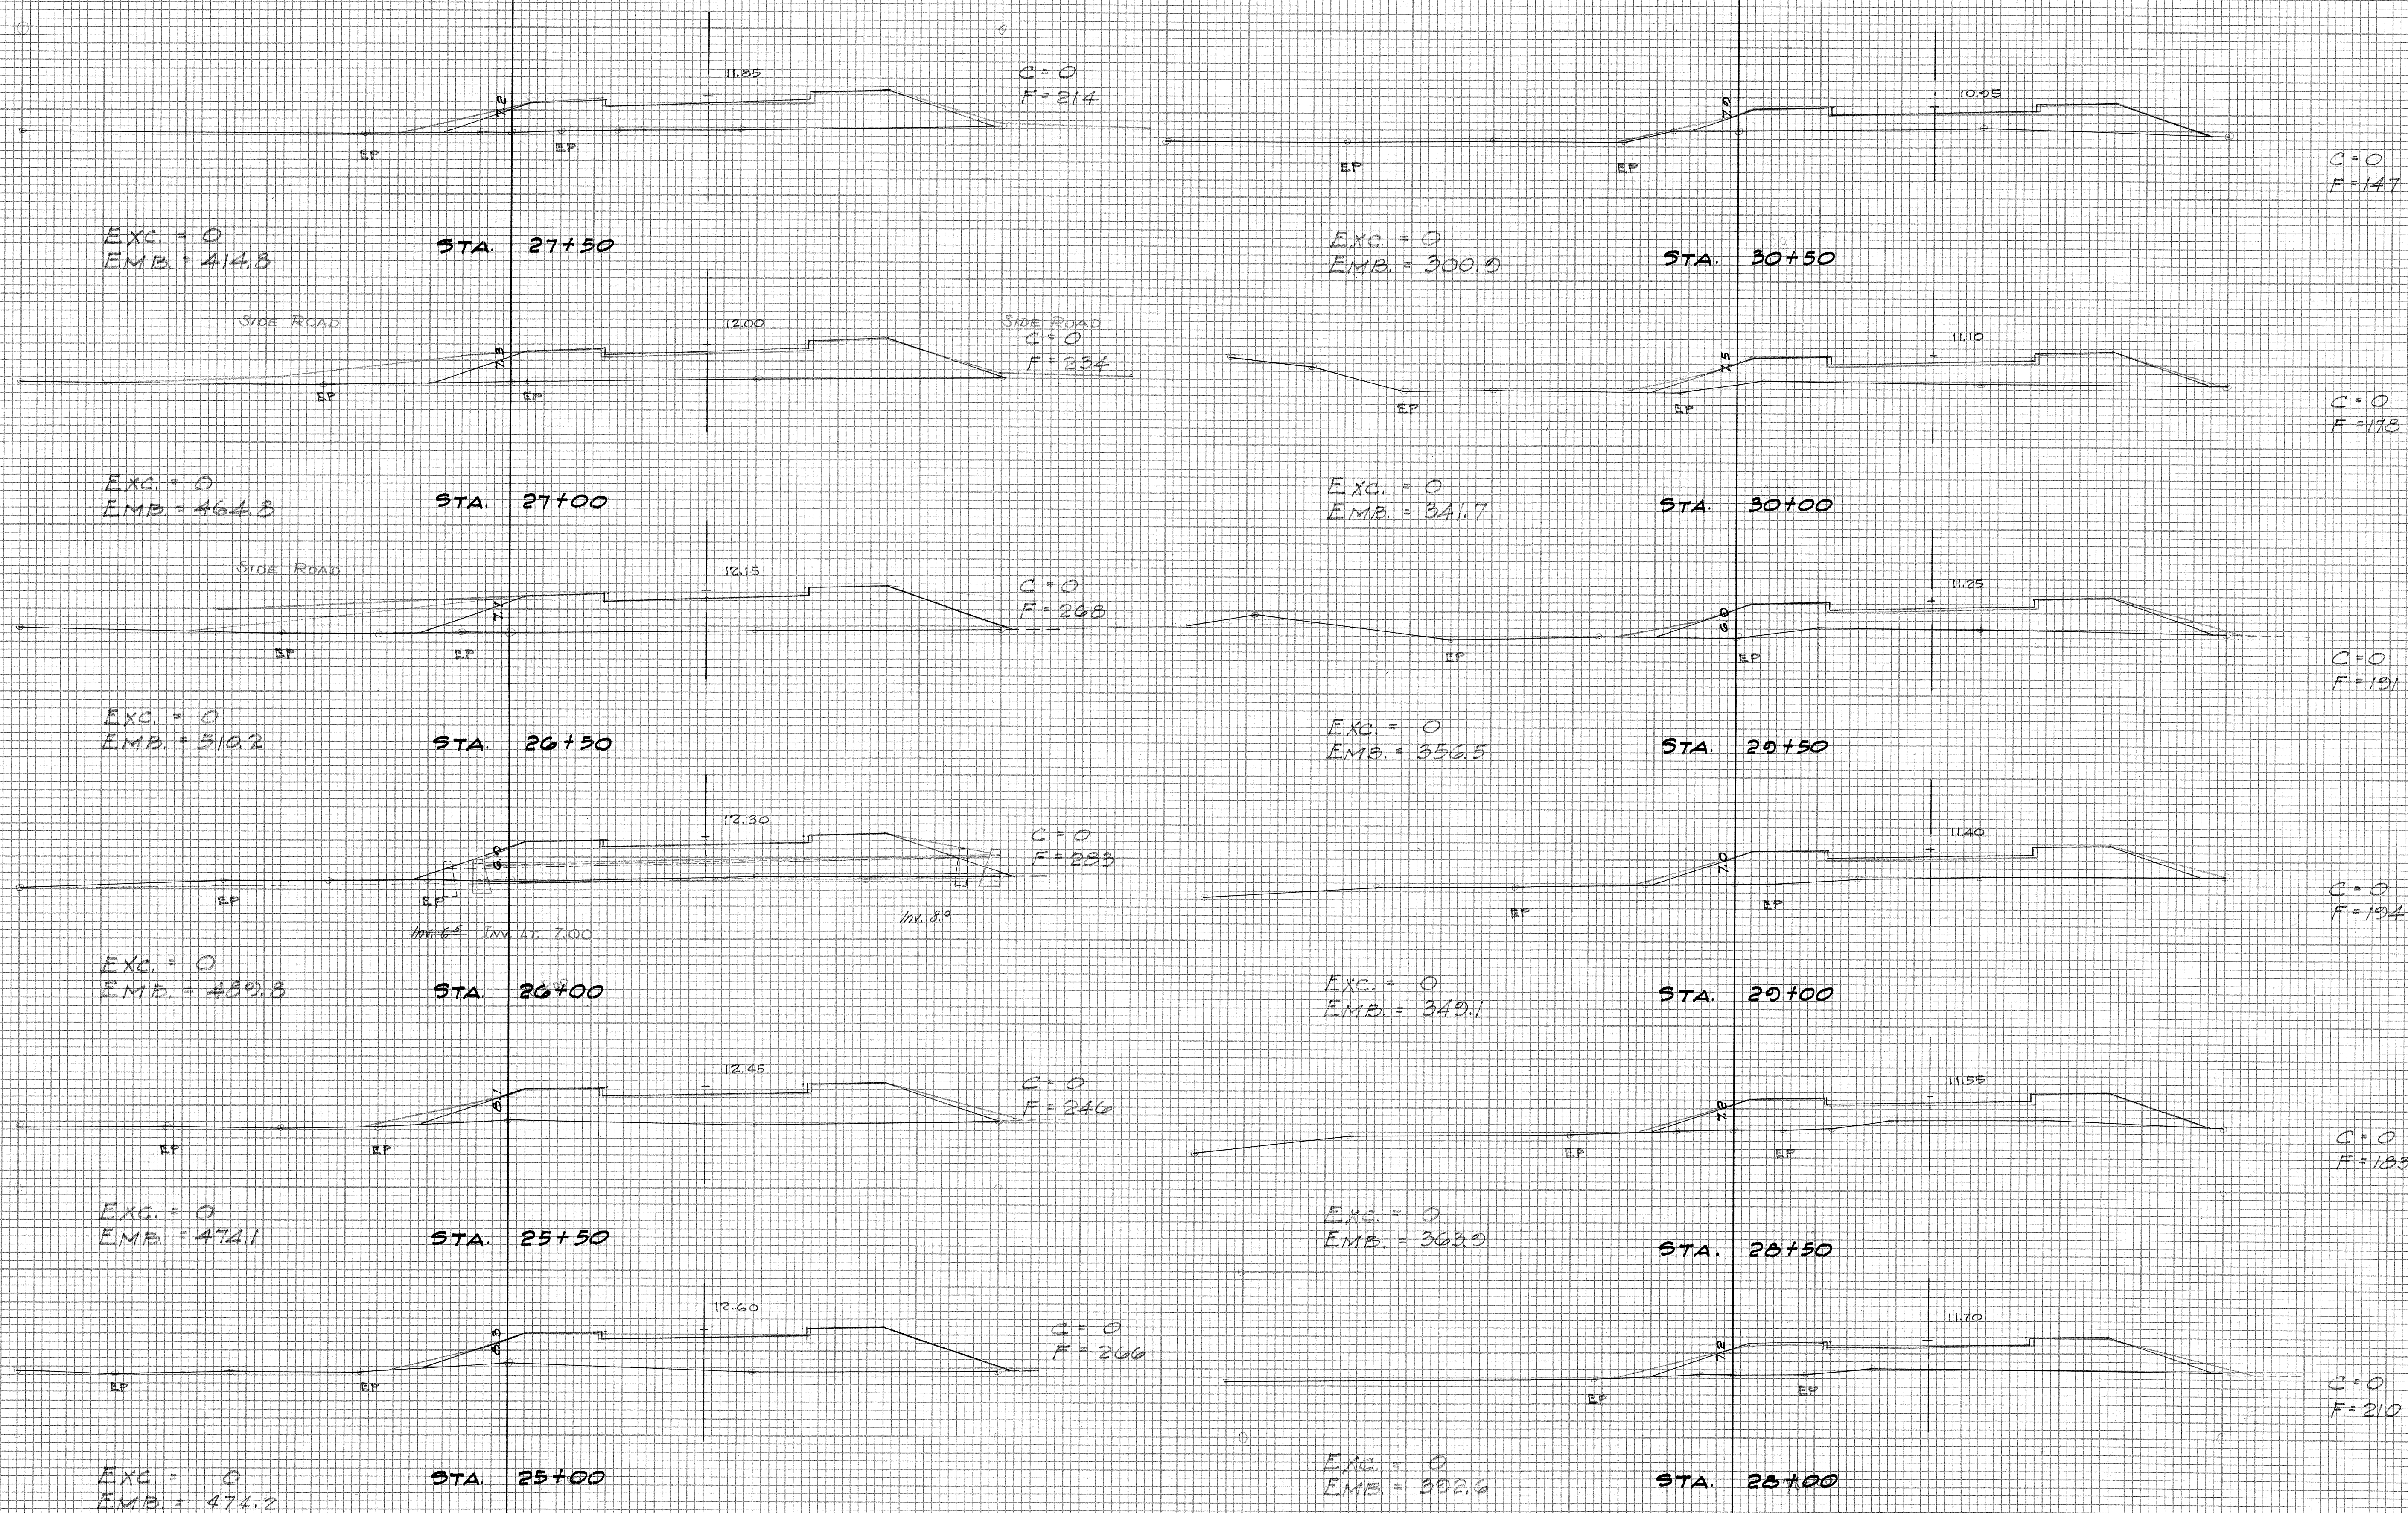


FED. ROAD DIST. NO.	STATE	FED. AID PROJ. NO.	FISCAL YEAR	SHEET NO.	TOTAL SHEETS
HAWAII	HAW.	5-0340(1)	1955	24	29

34

FINAL SURVEY	DATE
SURVEYED	BY
PLOTTED	
NOTE BOOK	
NO.	
AREAS CHECKED	

ORIGINAL SURVEY	DATE
SURVEYED	BY
PLOTTED	
NOTE BOOK	
NO.	
AREAS CHECKED	











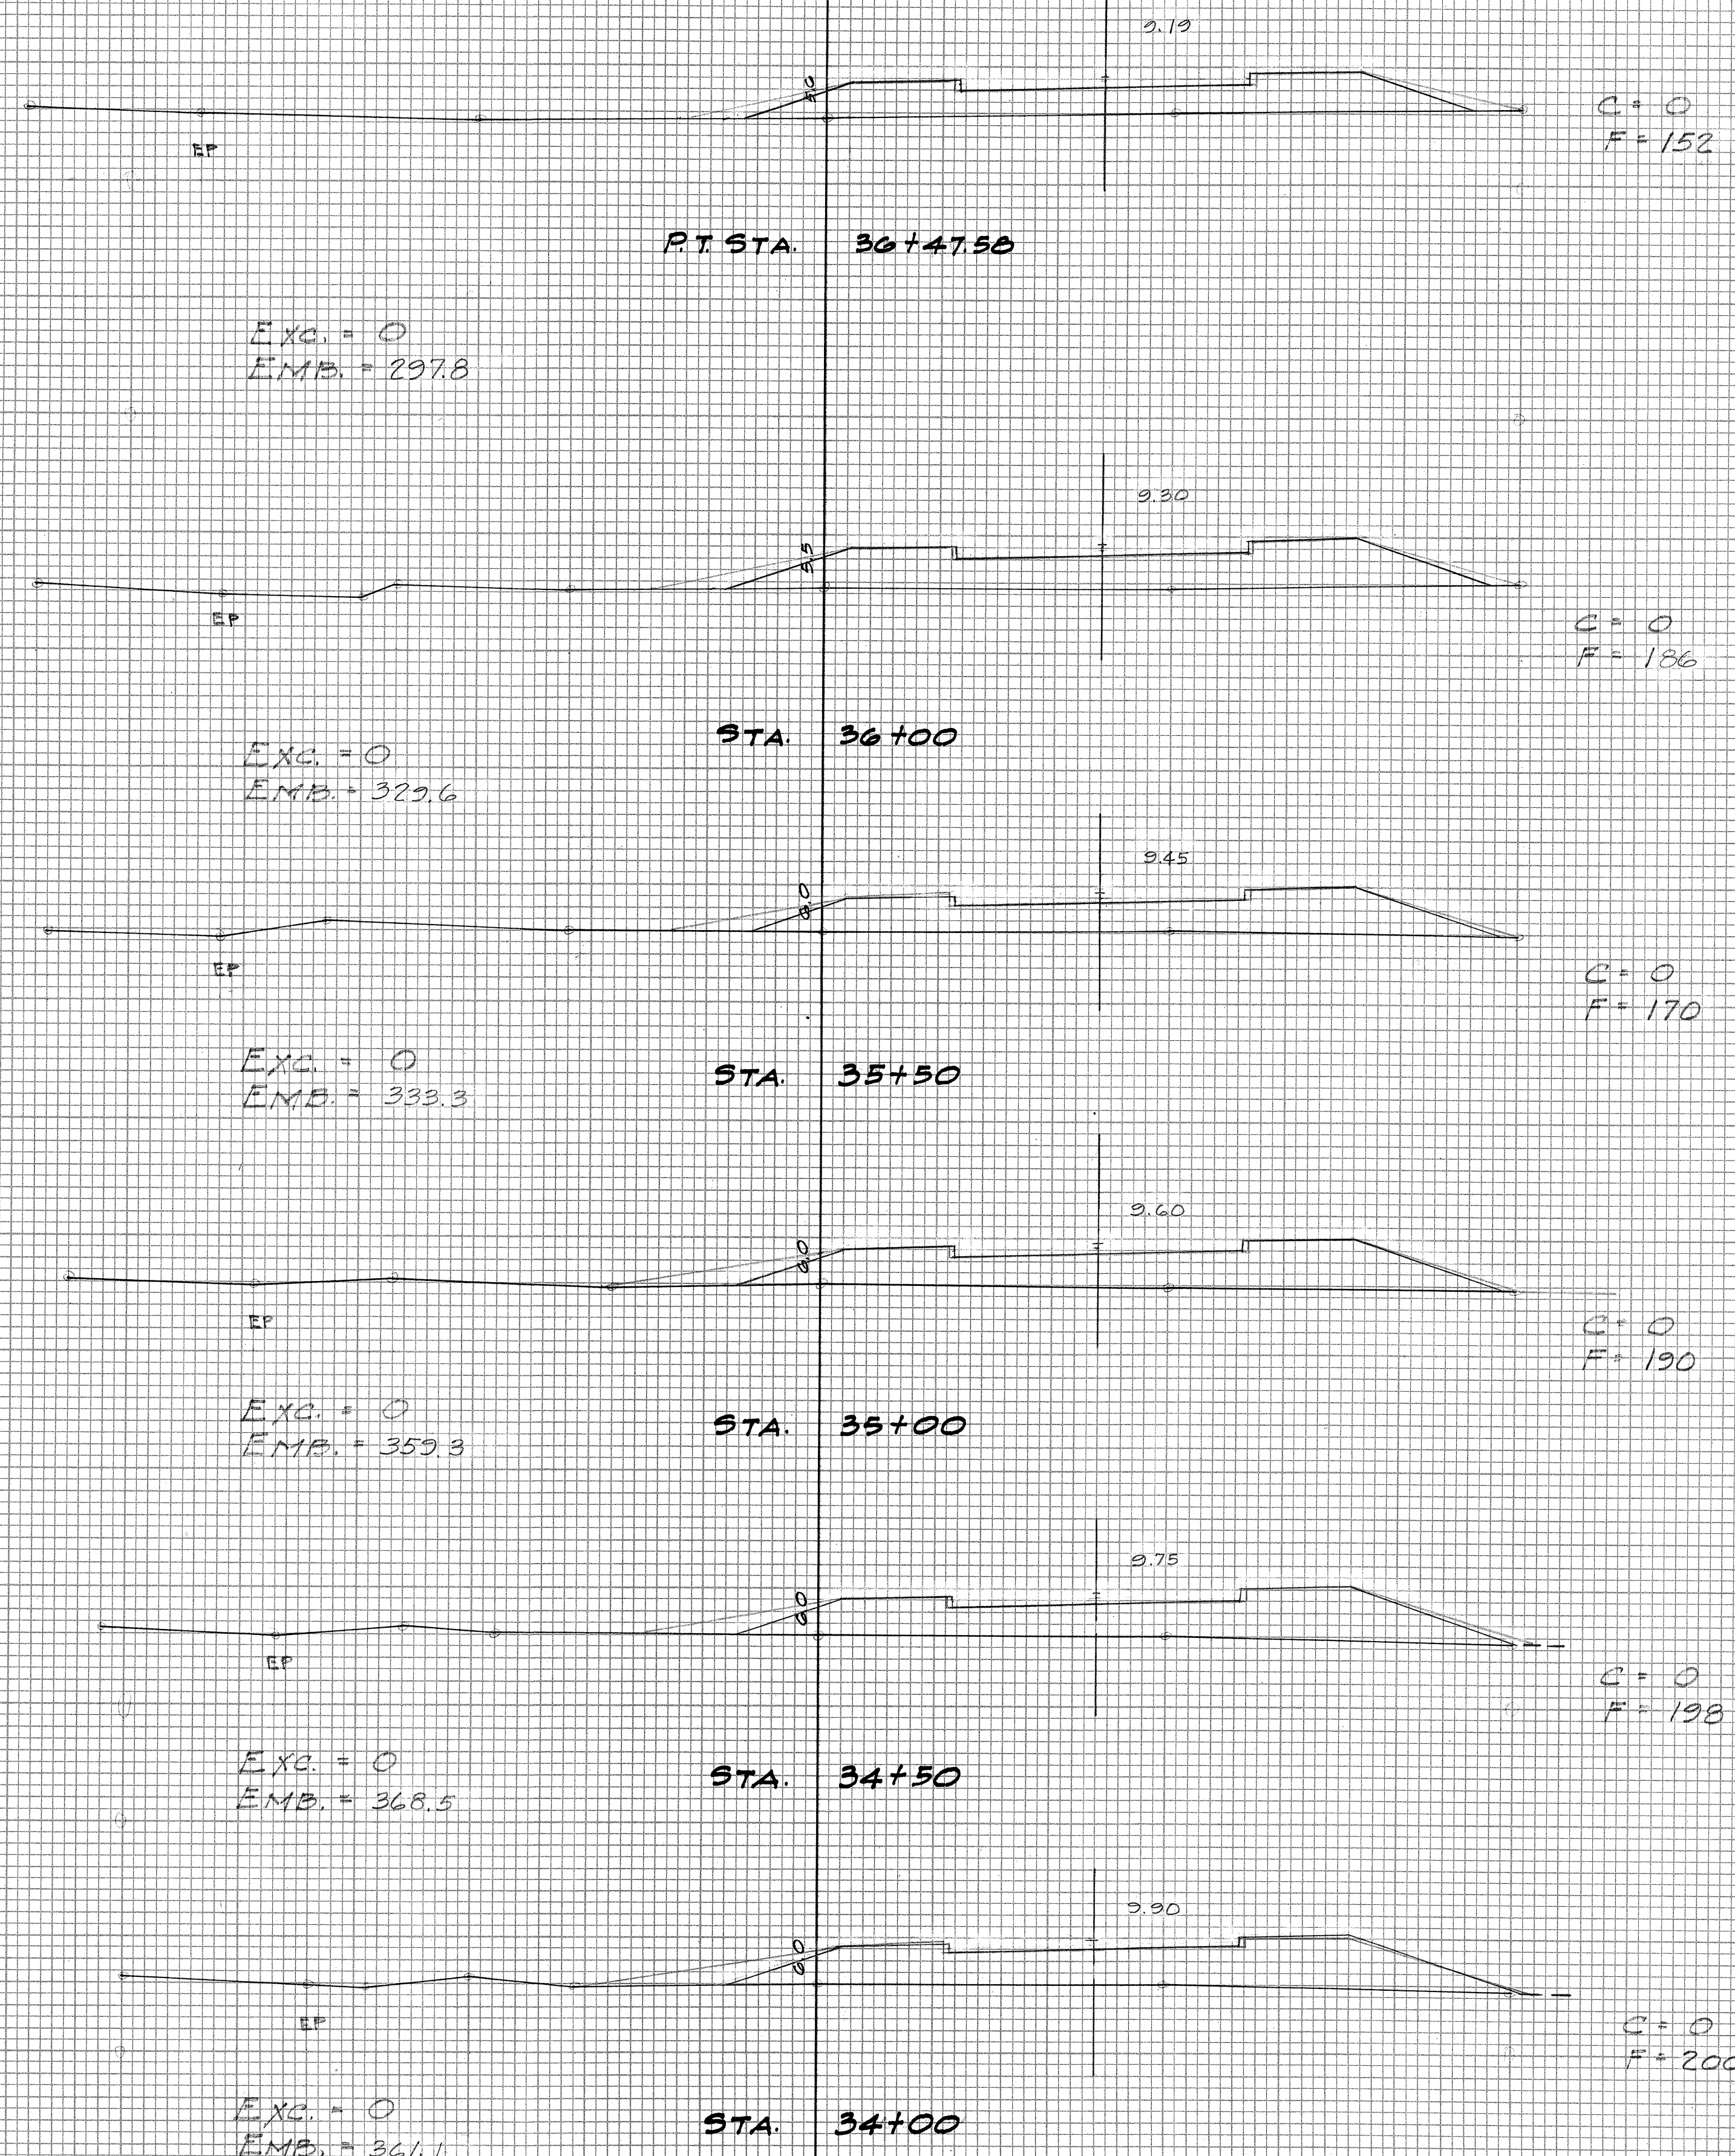
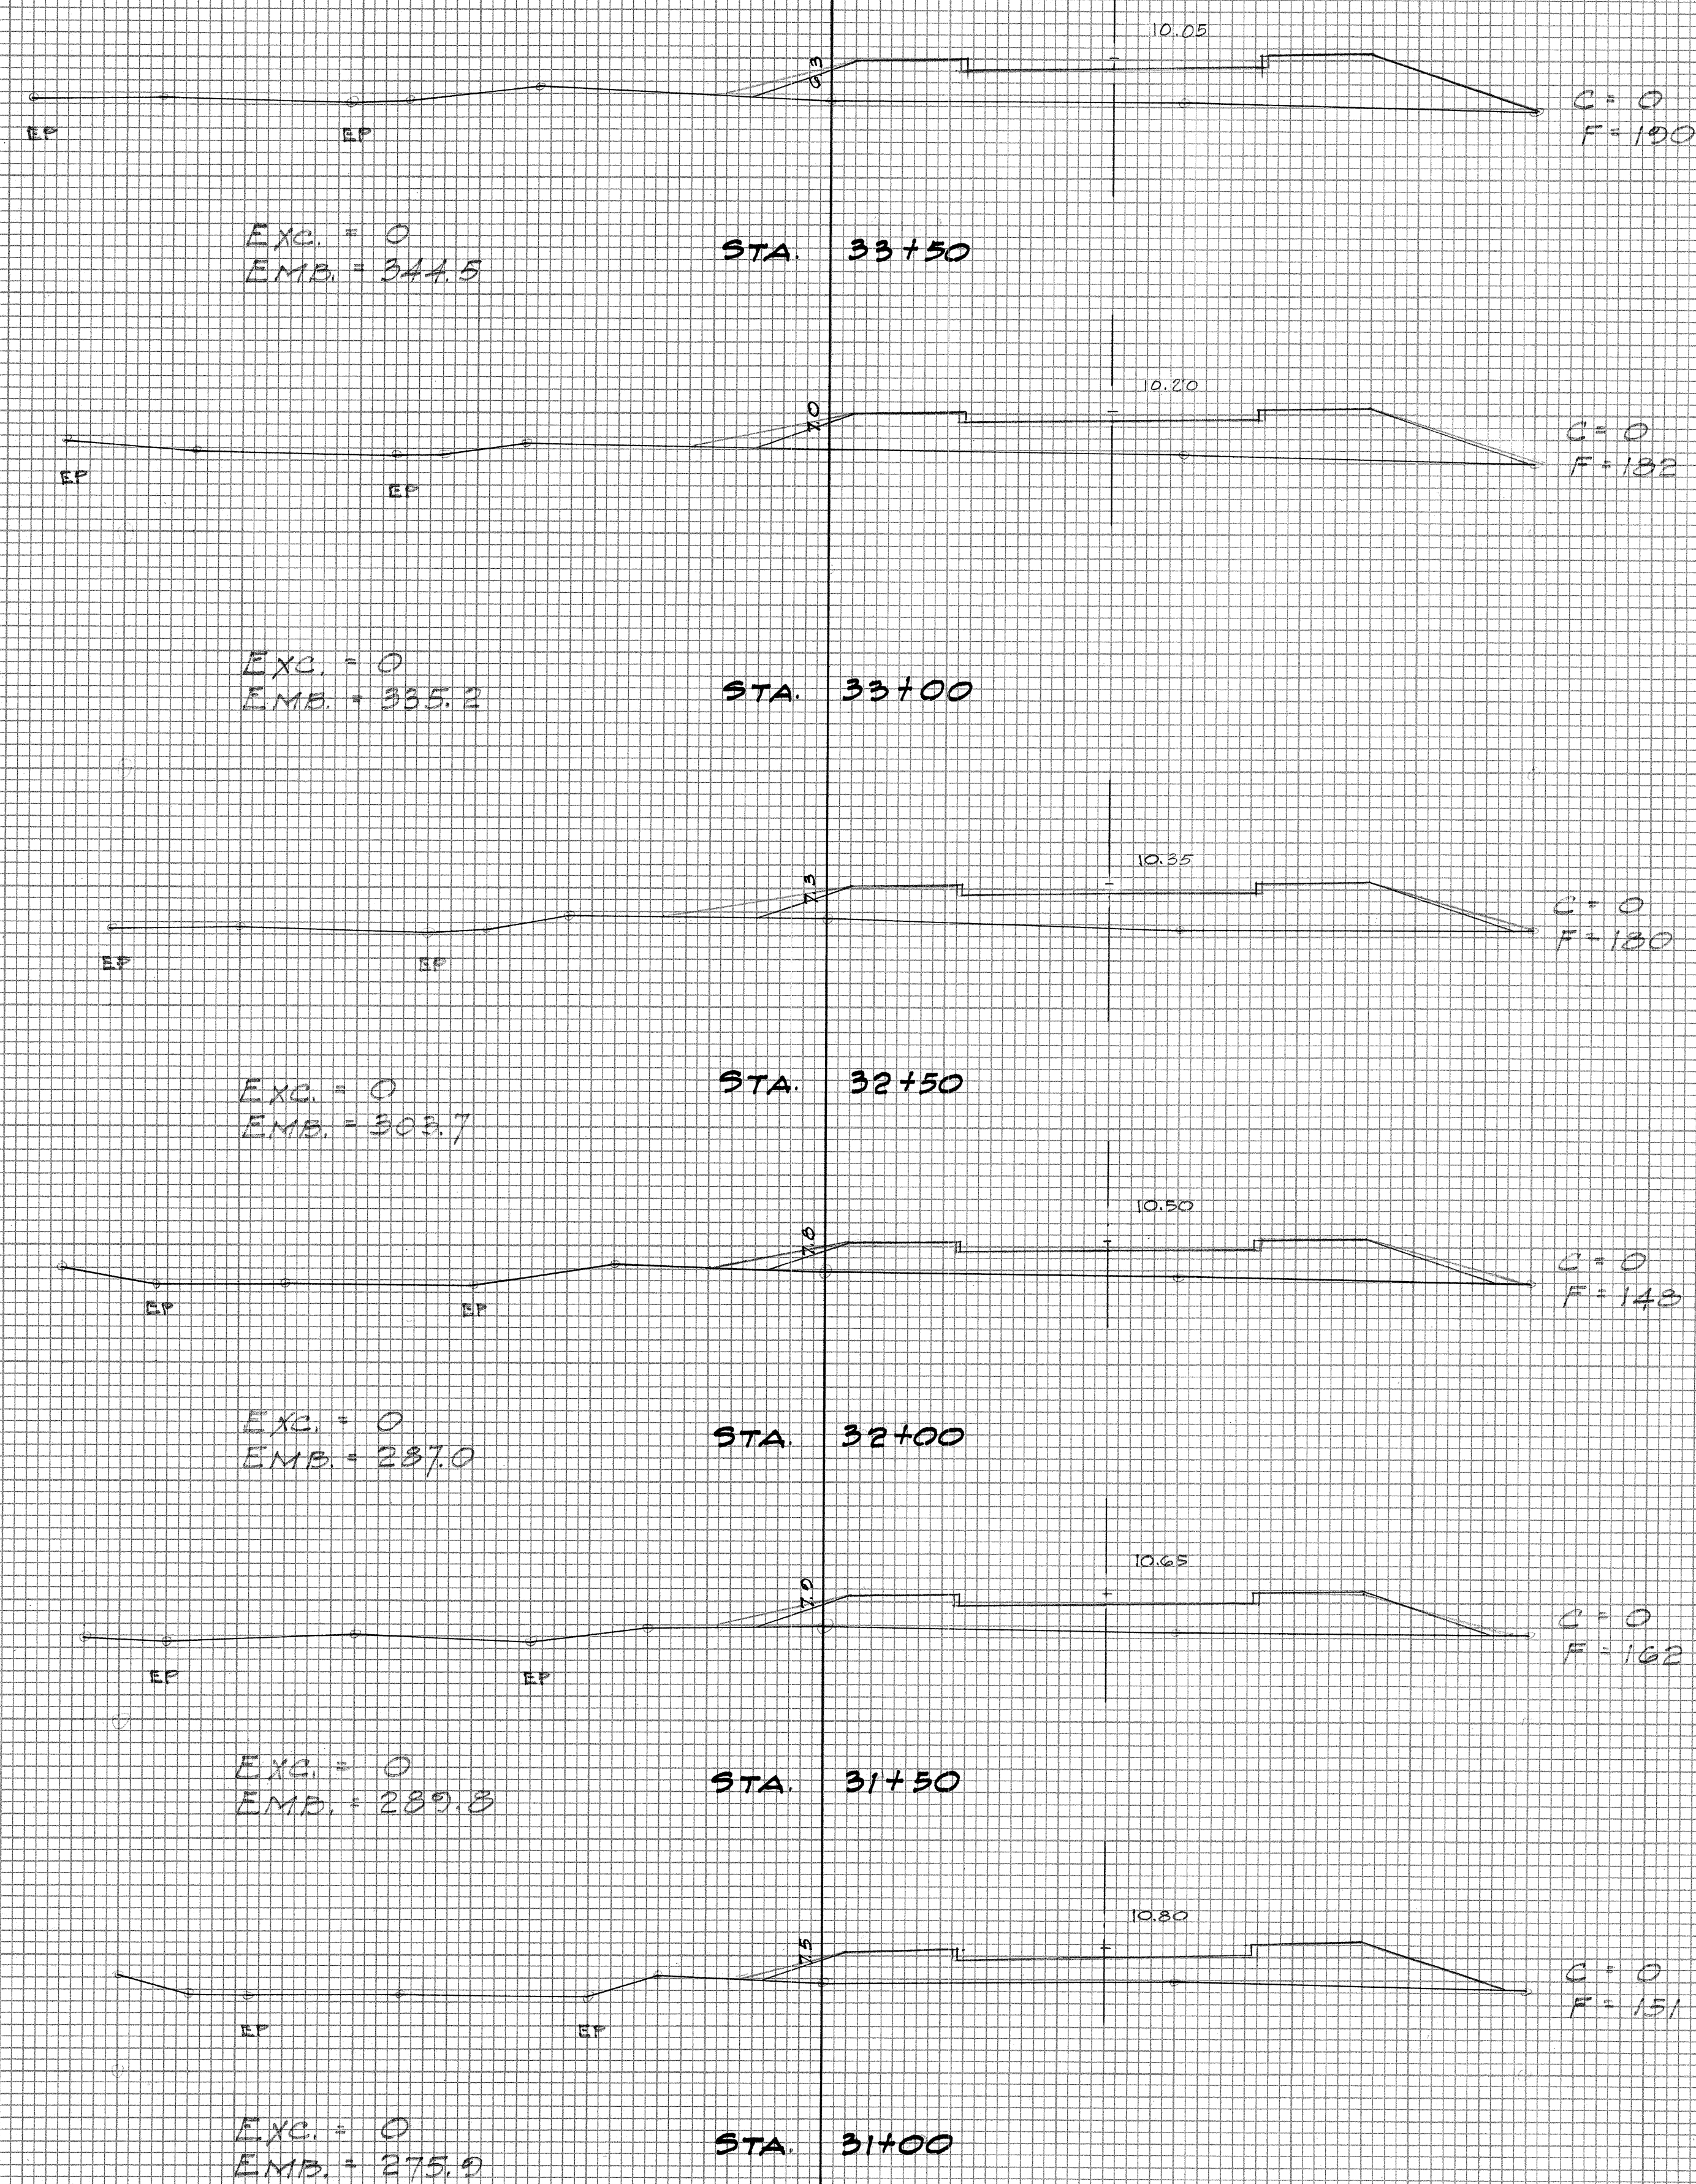


FINAL SURVEY	DATE	BY	SURVEYED	PLOTTED	CHECKED	NO.

ORIGINAL SURVEY	DATE	BY	SURVEYED	PLOTTED	CHECKED	NO.

FED. ROAD DIST. No.	STATE	FED. AID PROJ. No.	FISCAL YEAR	SHEET No.	TOTAL SHEETS
HAWAII	HAW.	S-0220(1)	1955	25	29


SIDE ROAD
C+O
F=165

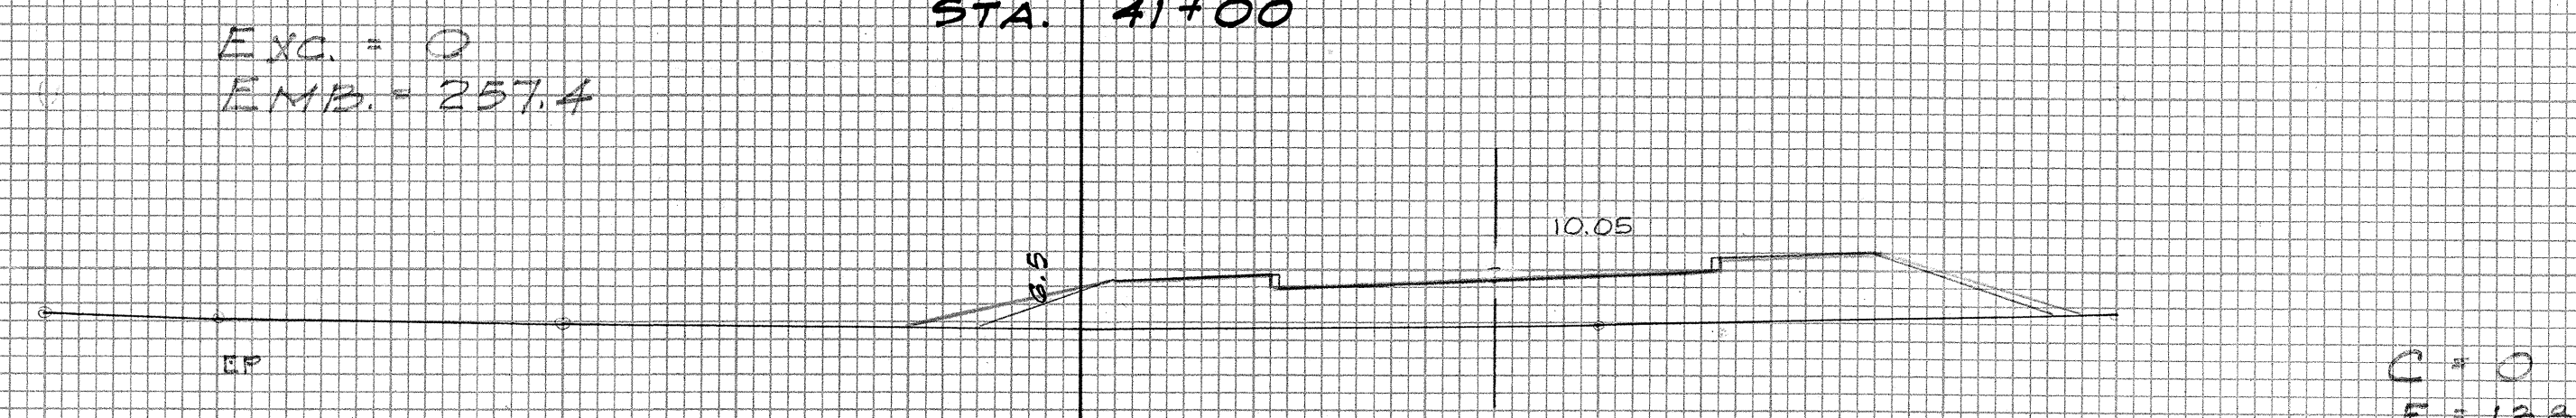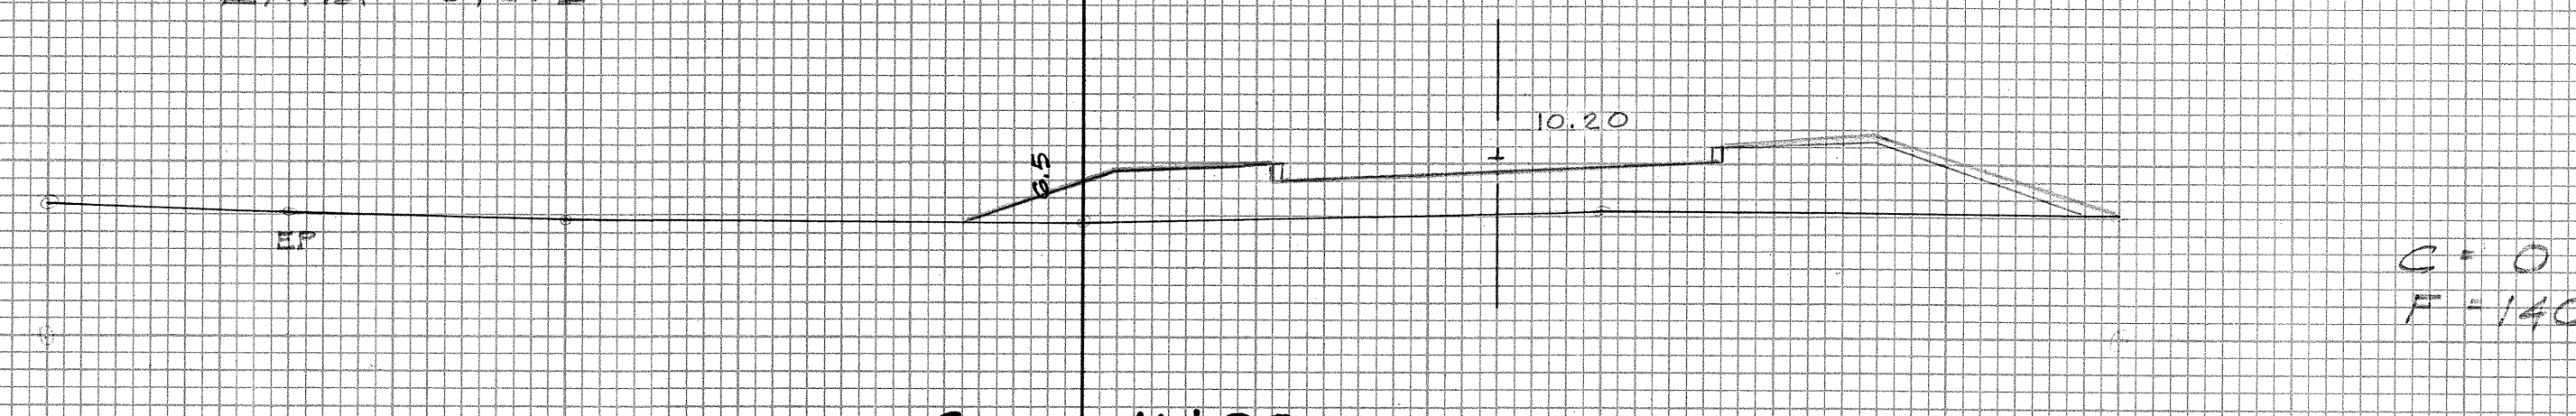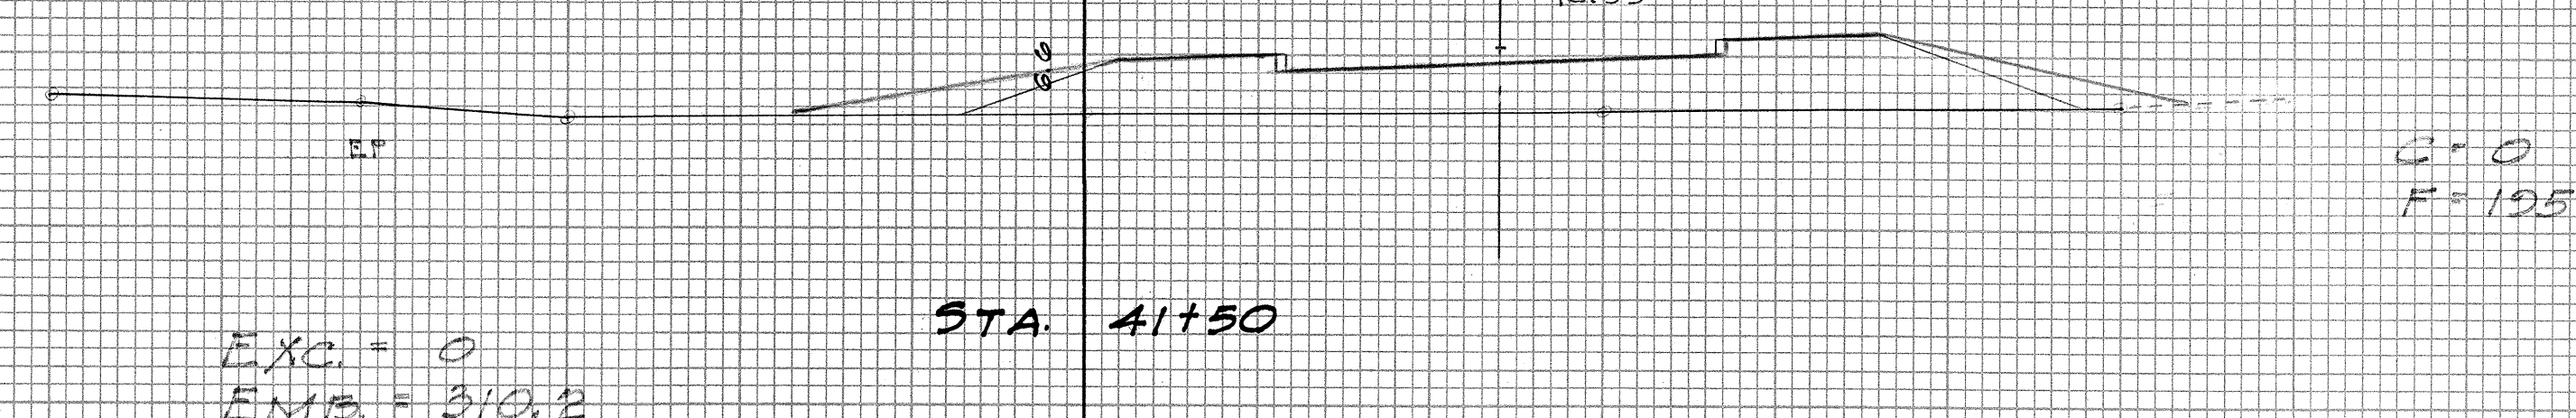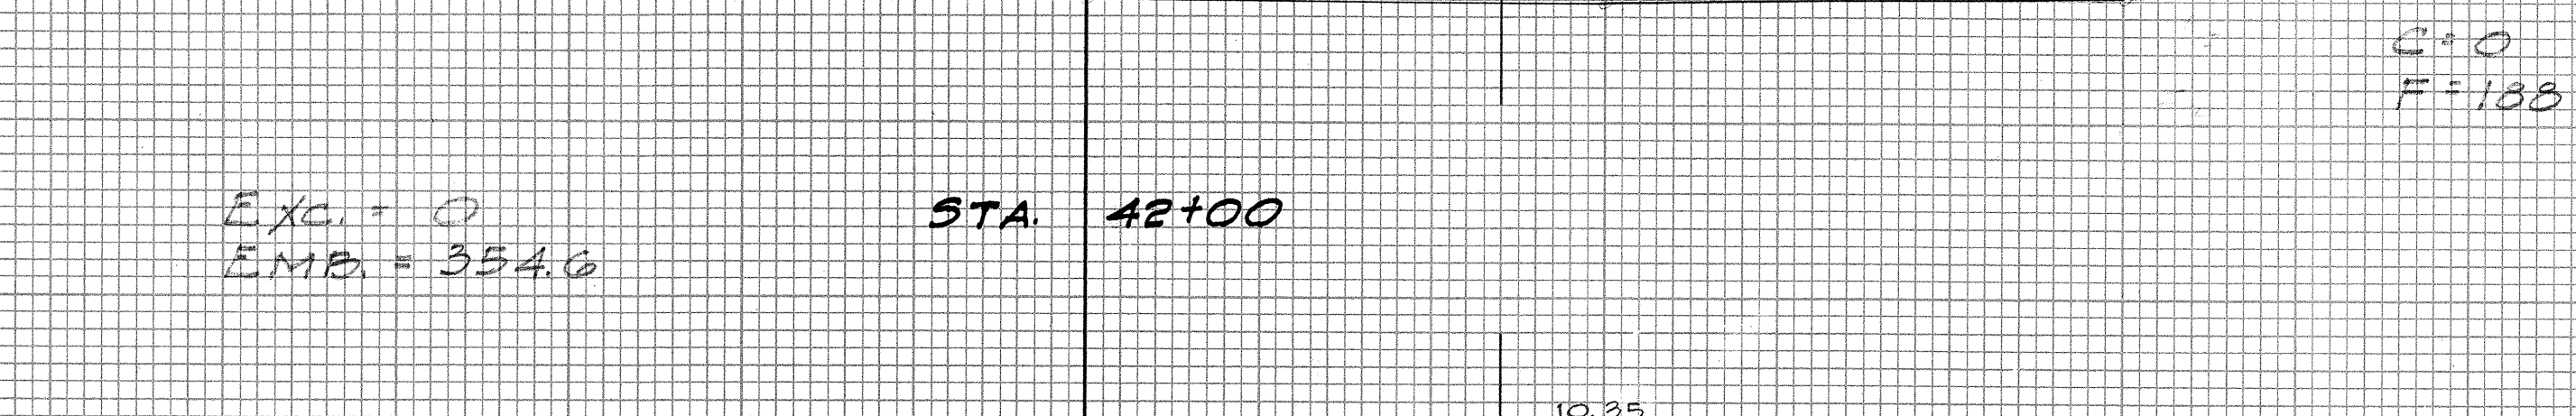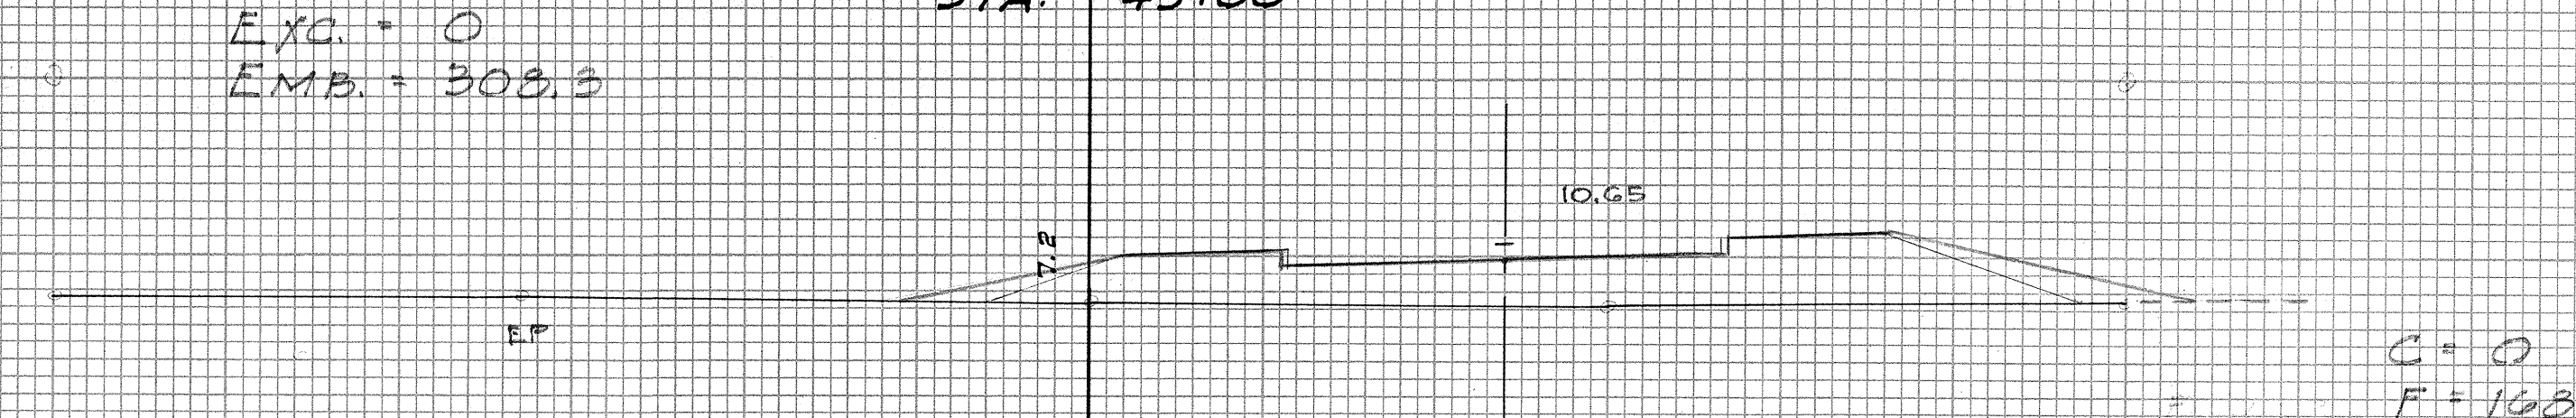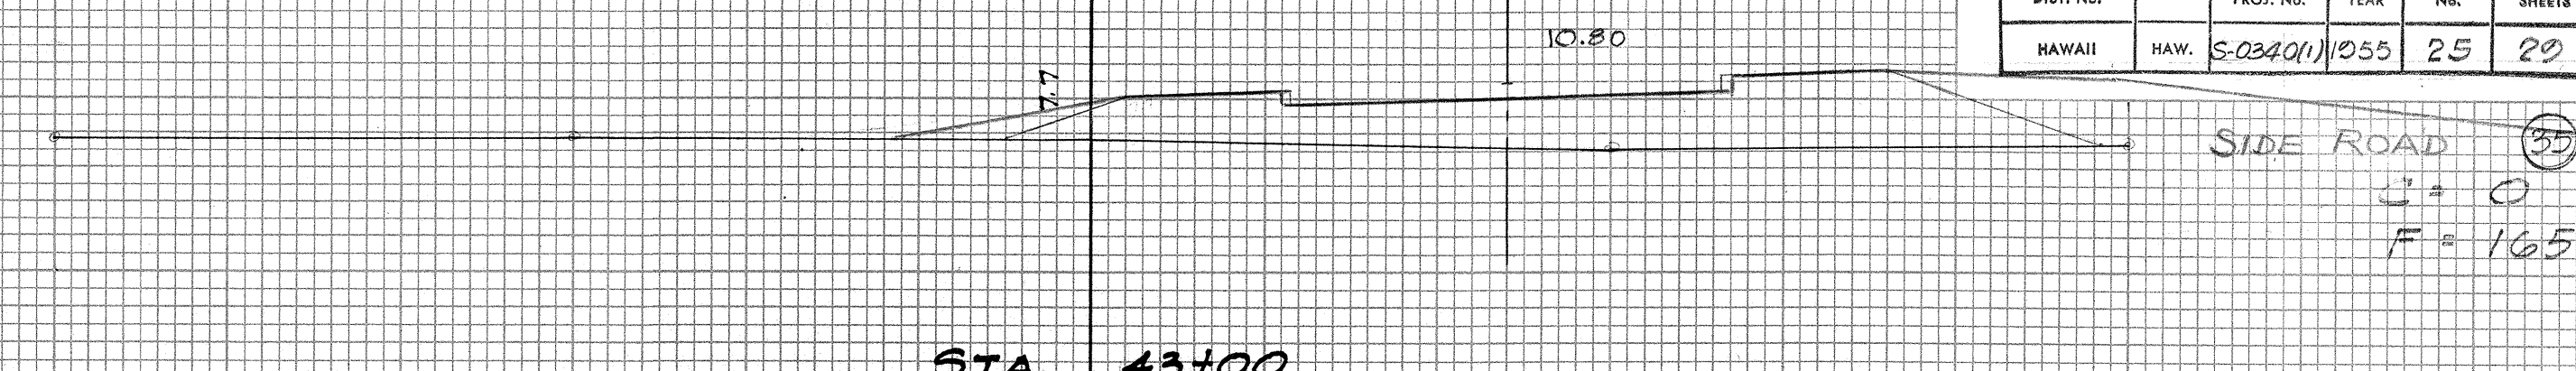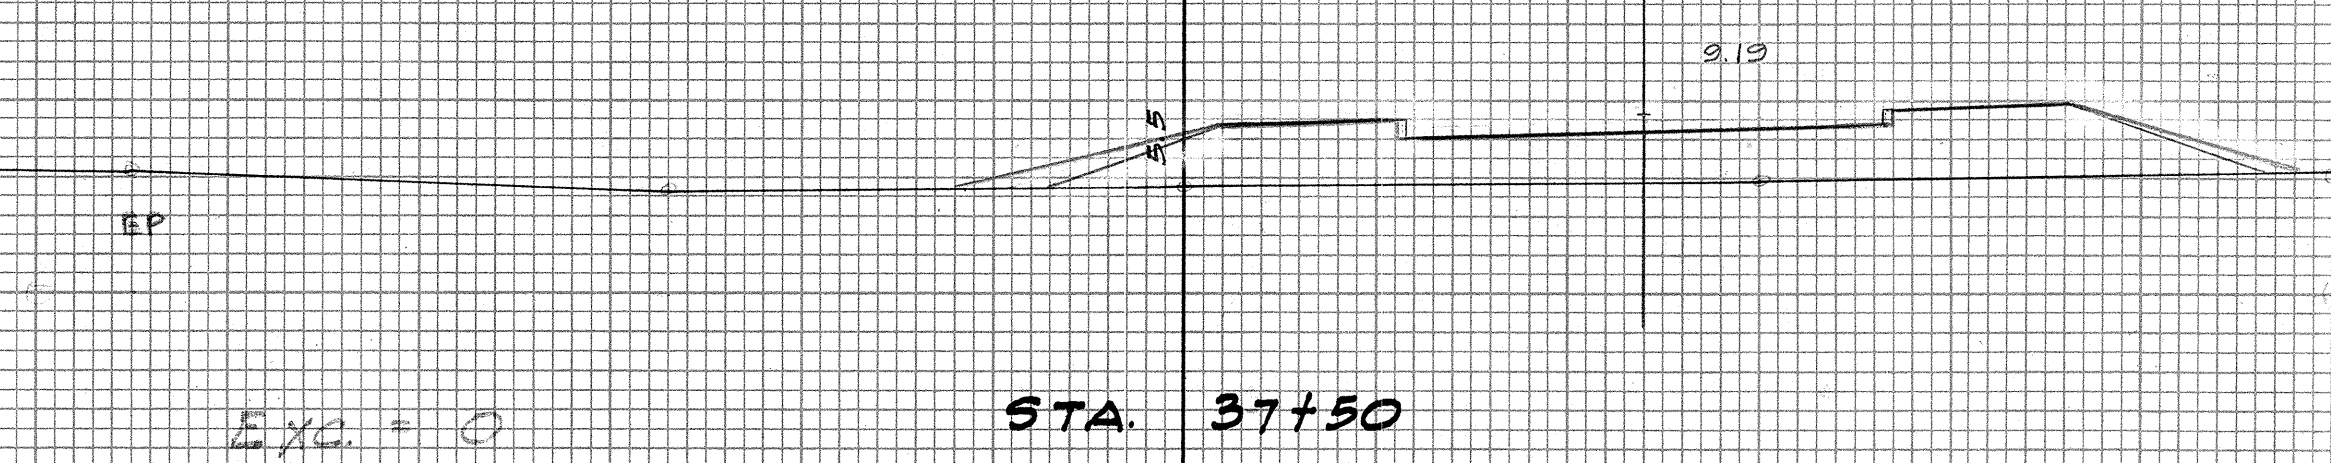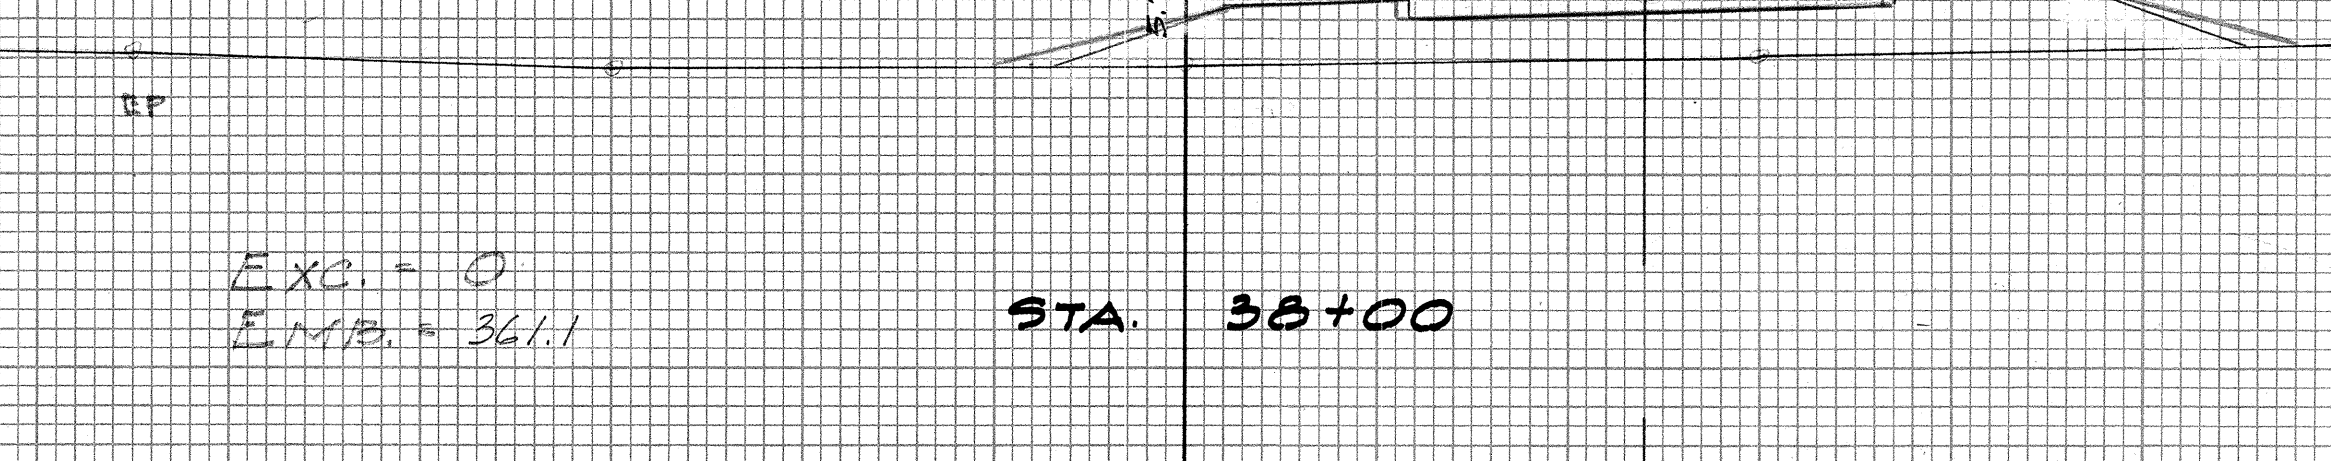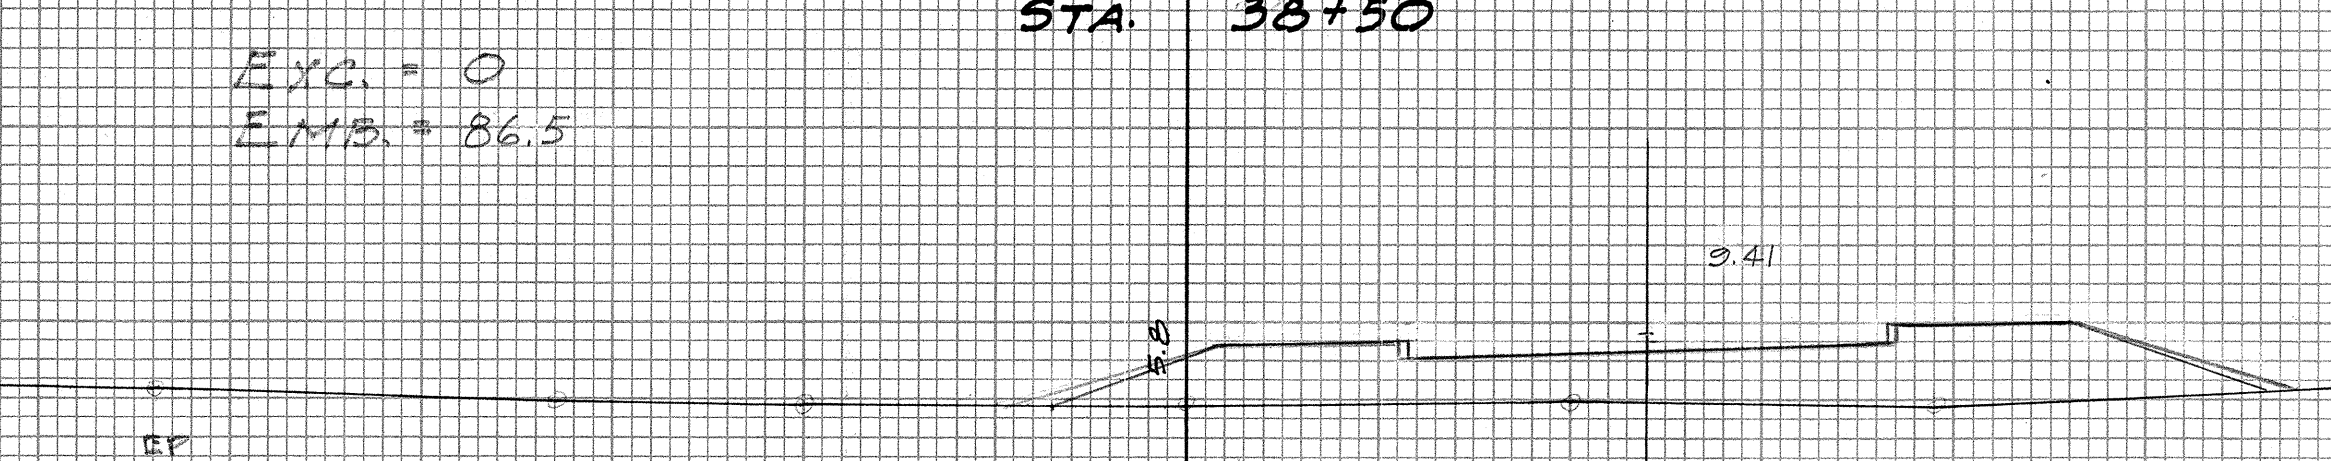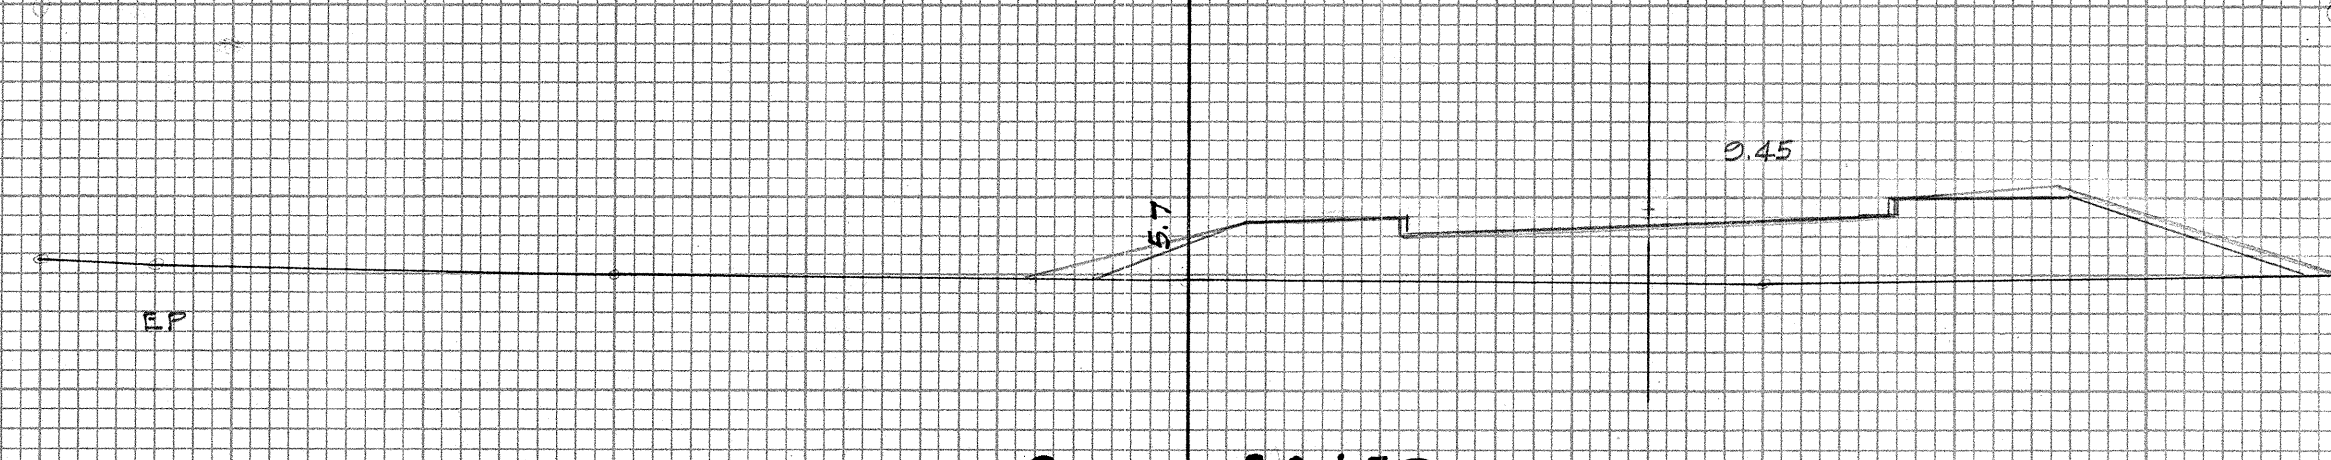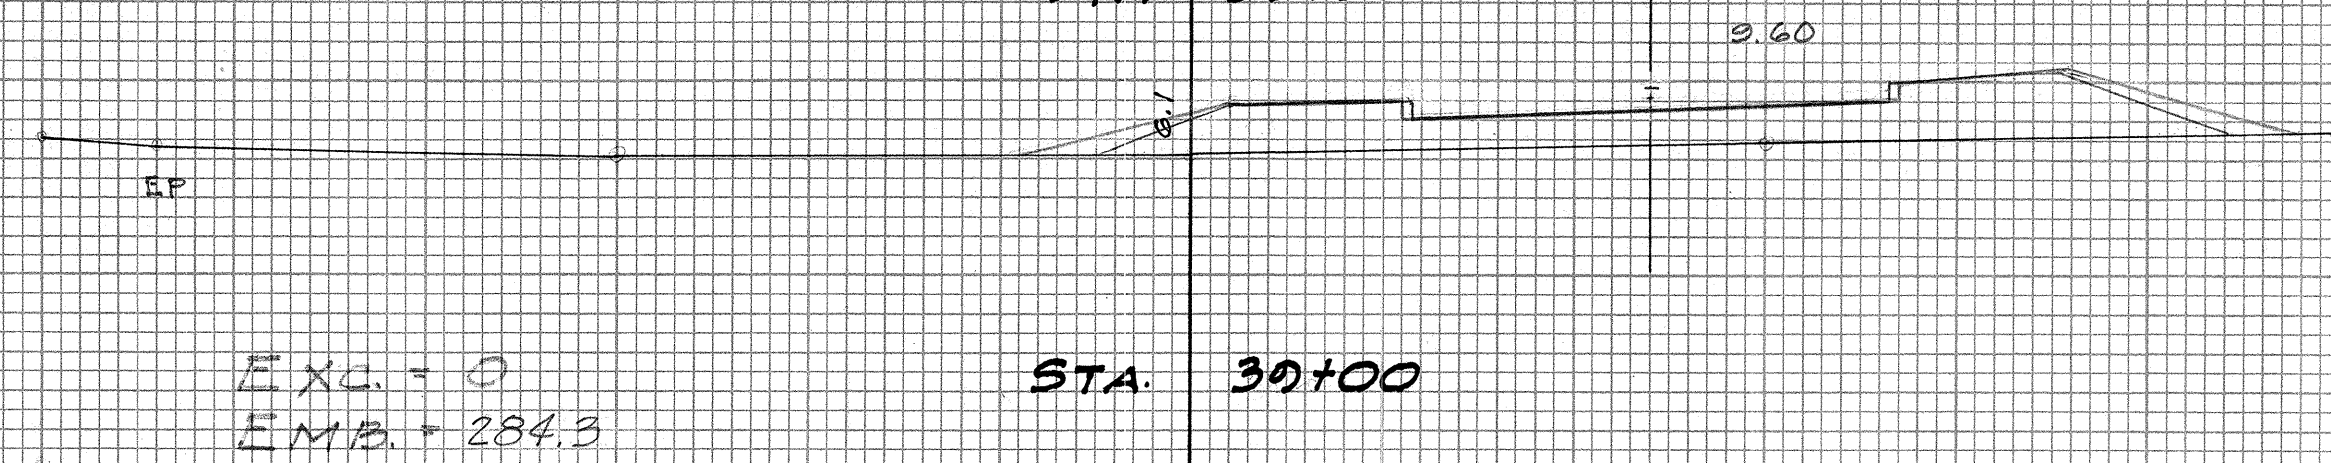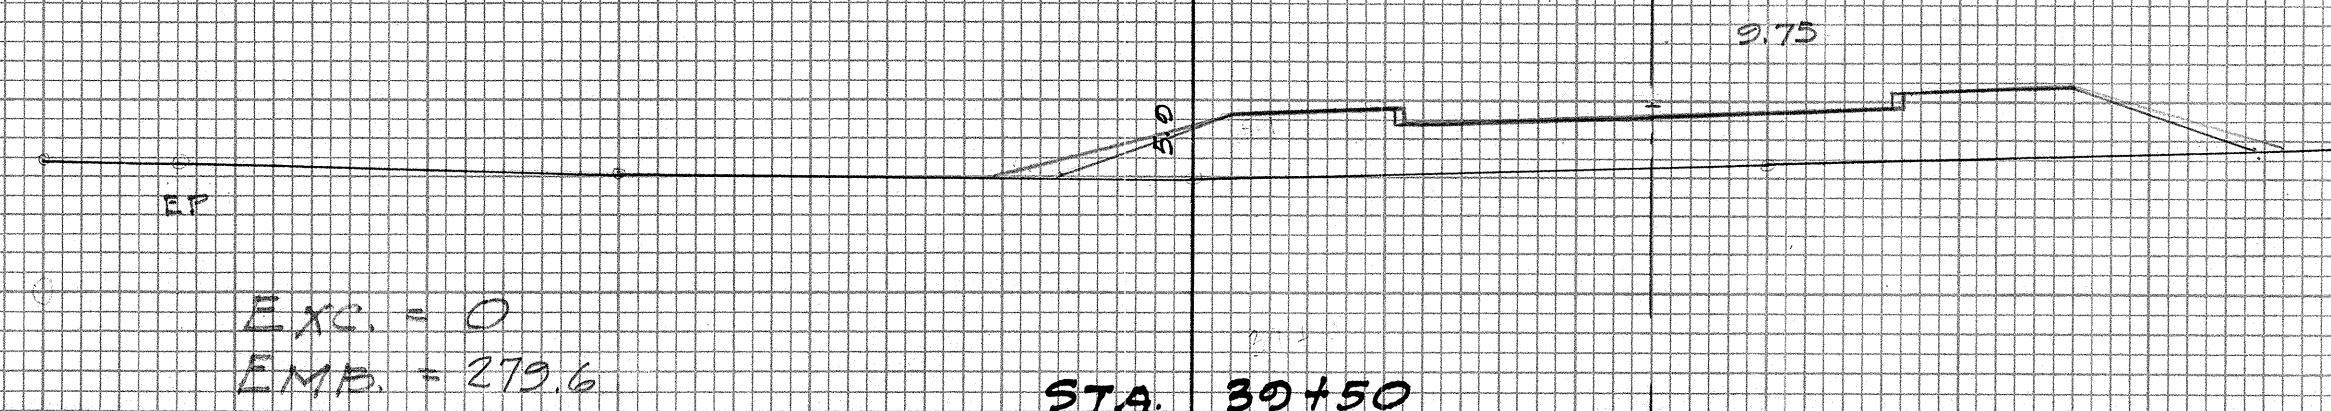

FED. ROAD DIST. NO.	STATE	FED. AID PROJ. NO.	FISCAL YEAR	SHEET NO.	TOTAL SHEETS
HAWAII	HAW.	5-03400	1955	26	29

DATE	BY	FINAL SURVEY	SURVEYED	PLOTTED	NOTED	BOOK	DATE	NO.

DATE	BY	ORIGINAL SURVEY	SURVEYED	PLOTTED	NOTED	BOOK	DATE	NO.

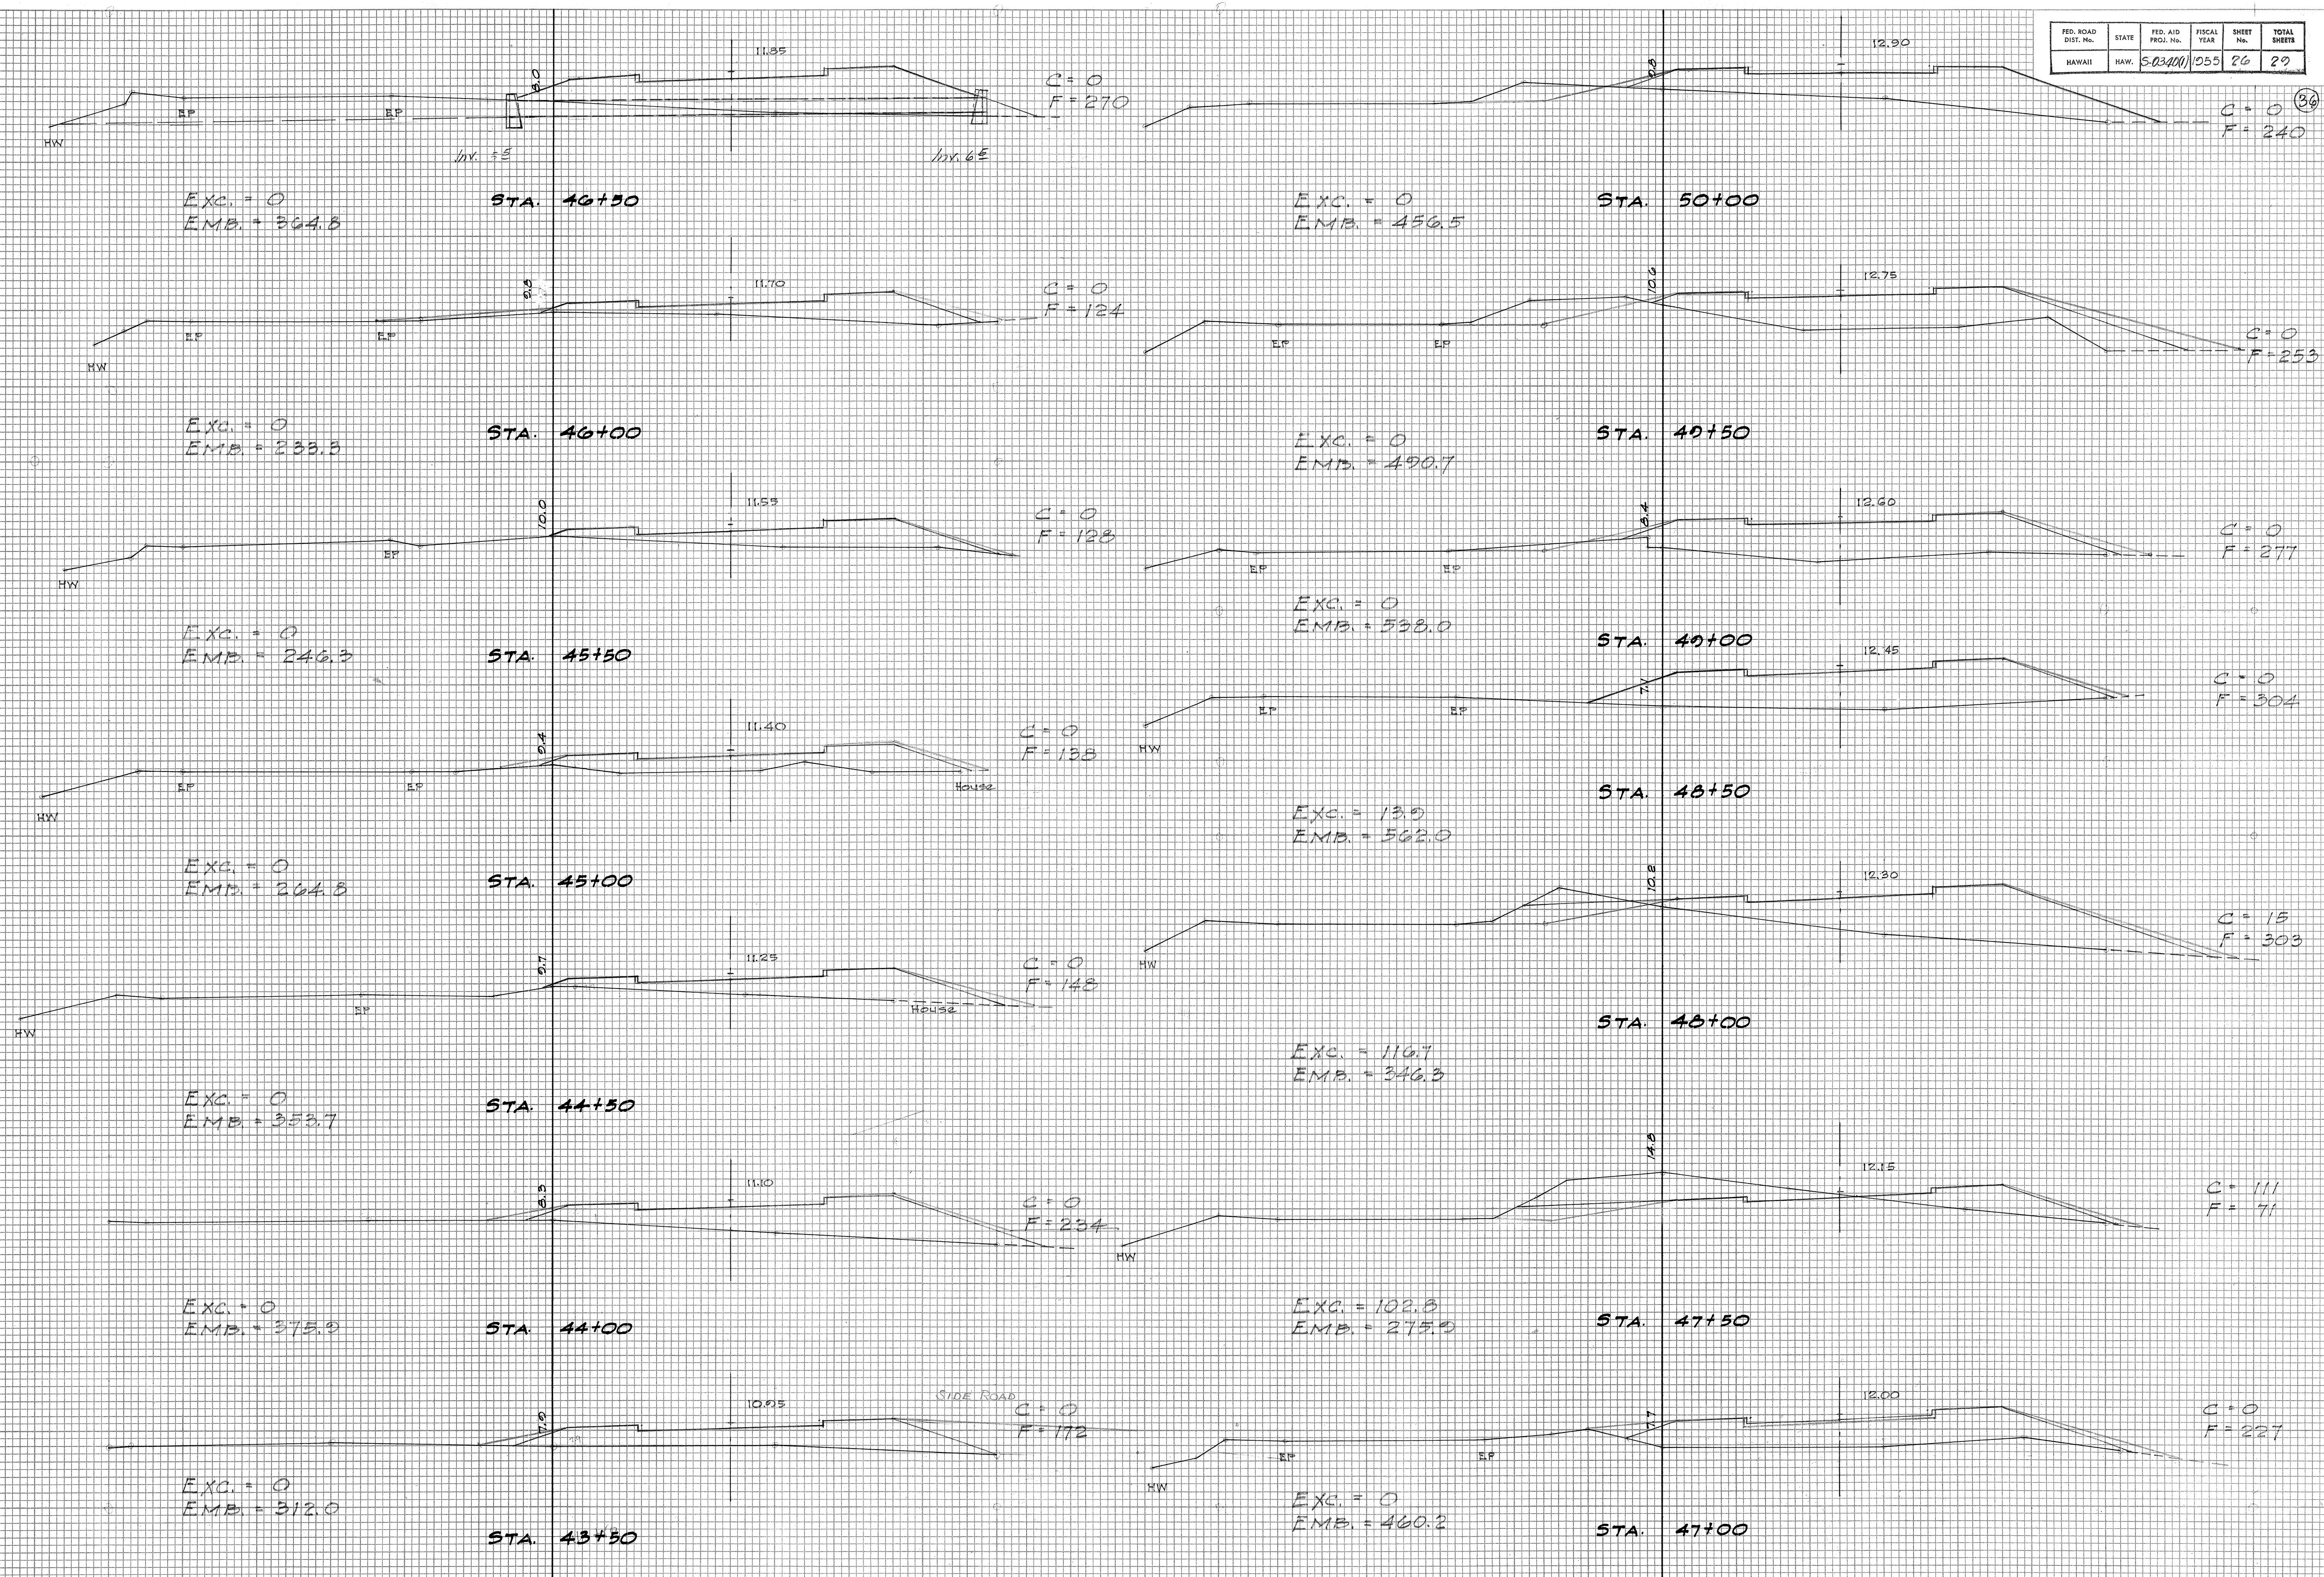


FED. ROAD DIST. No.	STATE	FED. AID PROJ. No.	FISCAL YEAR	SHEET No.	TOTAL SHEETS
HAWAII	HAW.	5-0340(1)	1955	27	27

(27)

C = 12
F = 14


FINAL SURVEY	DATE
BY	
REVISIONS	
PLOTTED	
NOTE BOOK	
NO.	
AREAS CHECKED	

ORIGINAL SURVEY	DATE
BY	
REVISIONS	
PLOTTED	
NOTE BOOK	
NO.	
AREAS CHECKED	

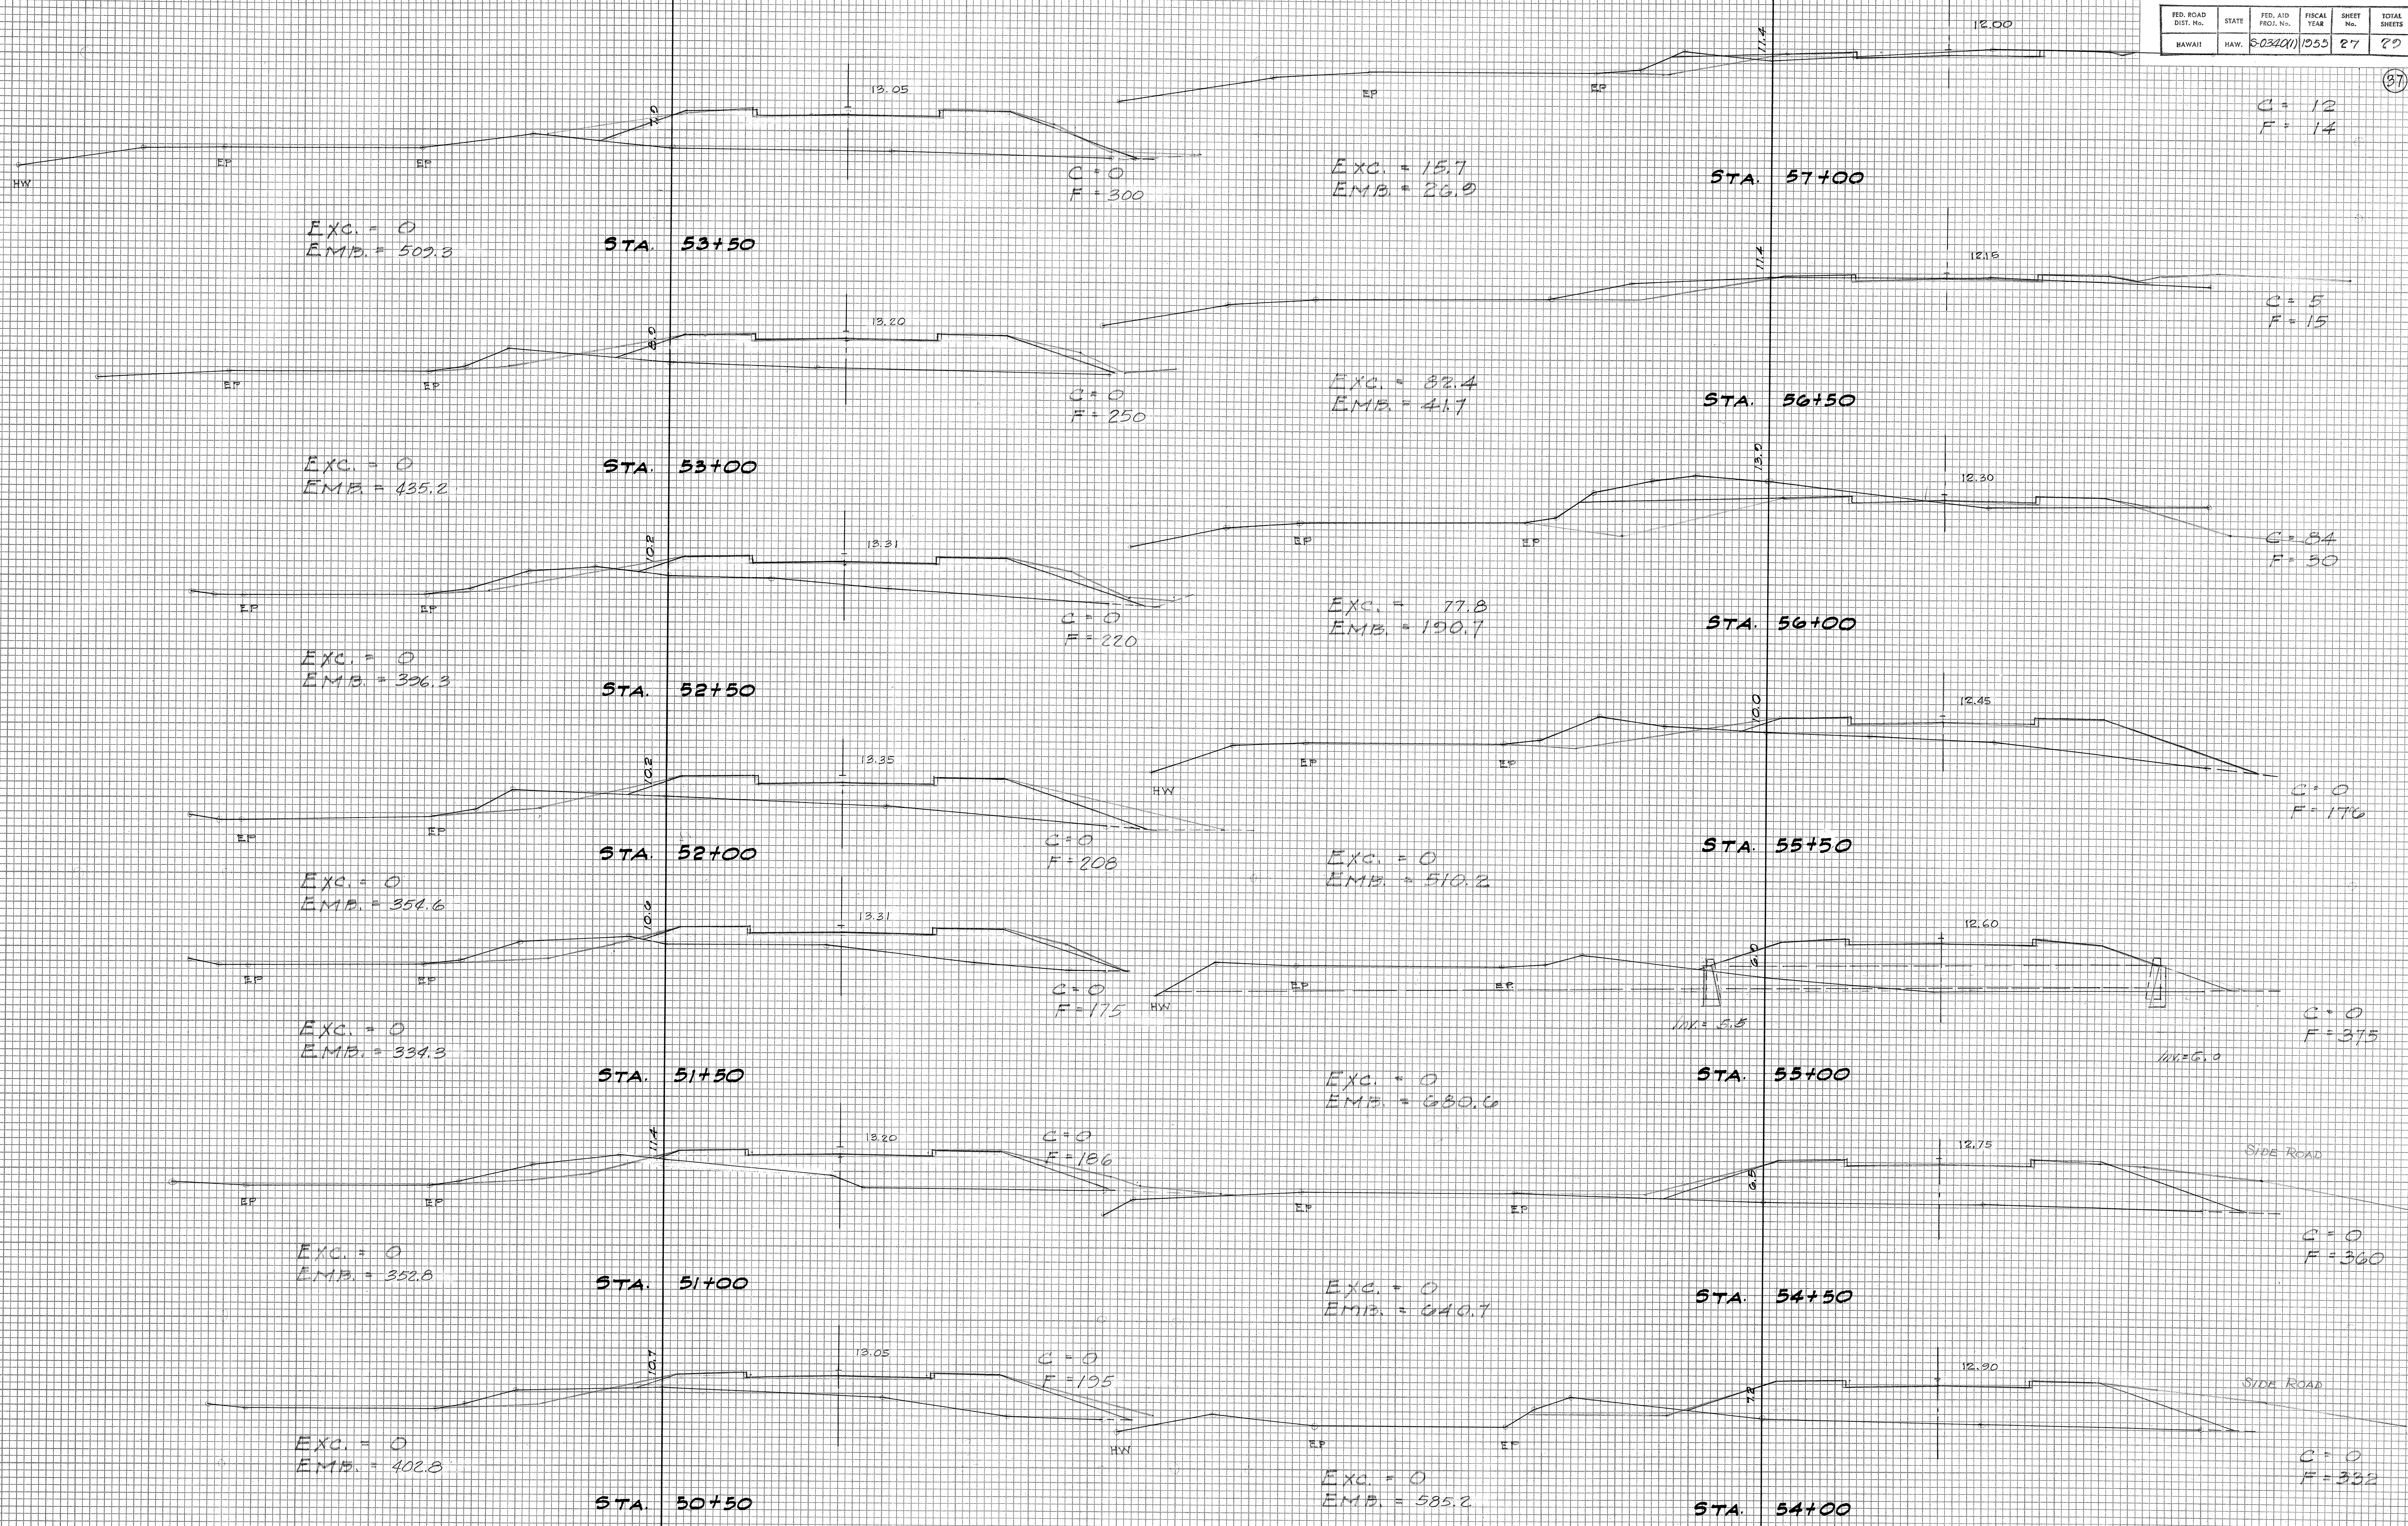

DATE	BY
FINAL SURVEY	
NOTED	
PLANNED	
DESIGNED	
CHECKED	
NO.	

DATE	BY
ORIGINAL SURVEY	
NOTED	
PLANNED	
DESIGNED	
CHECKED	
NO.	

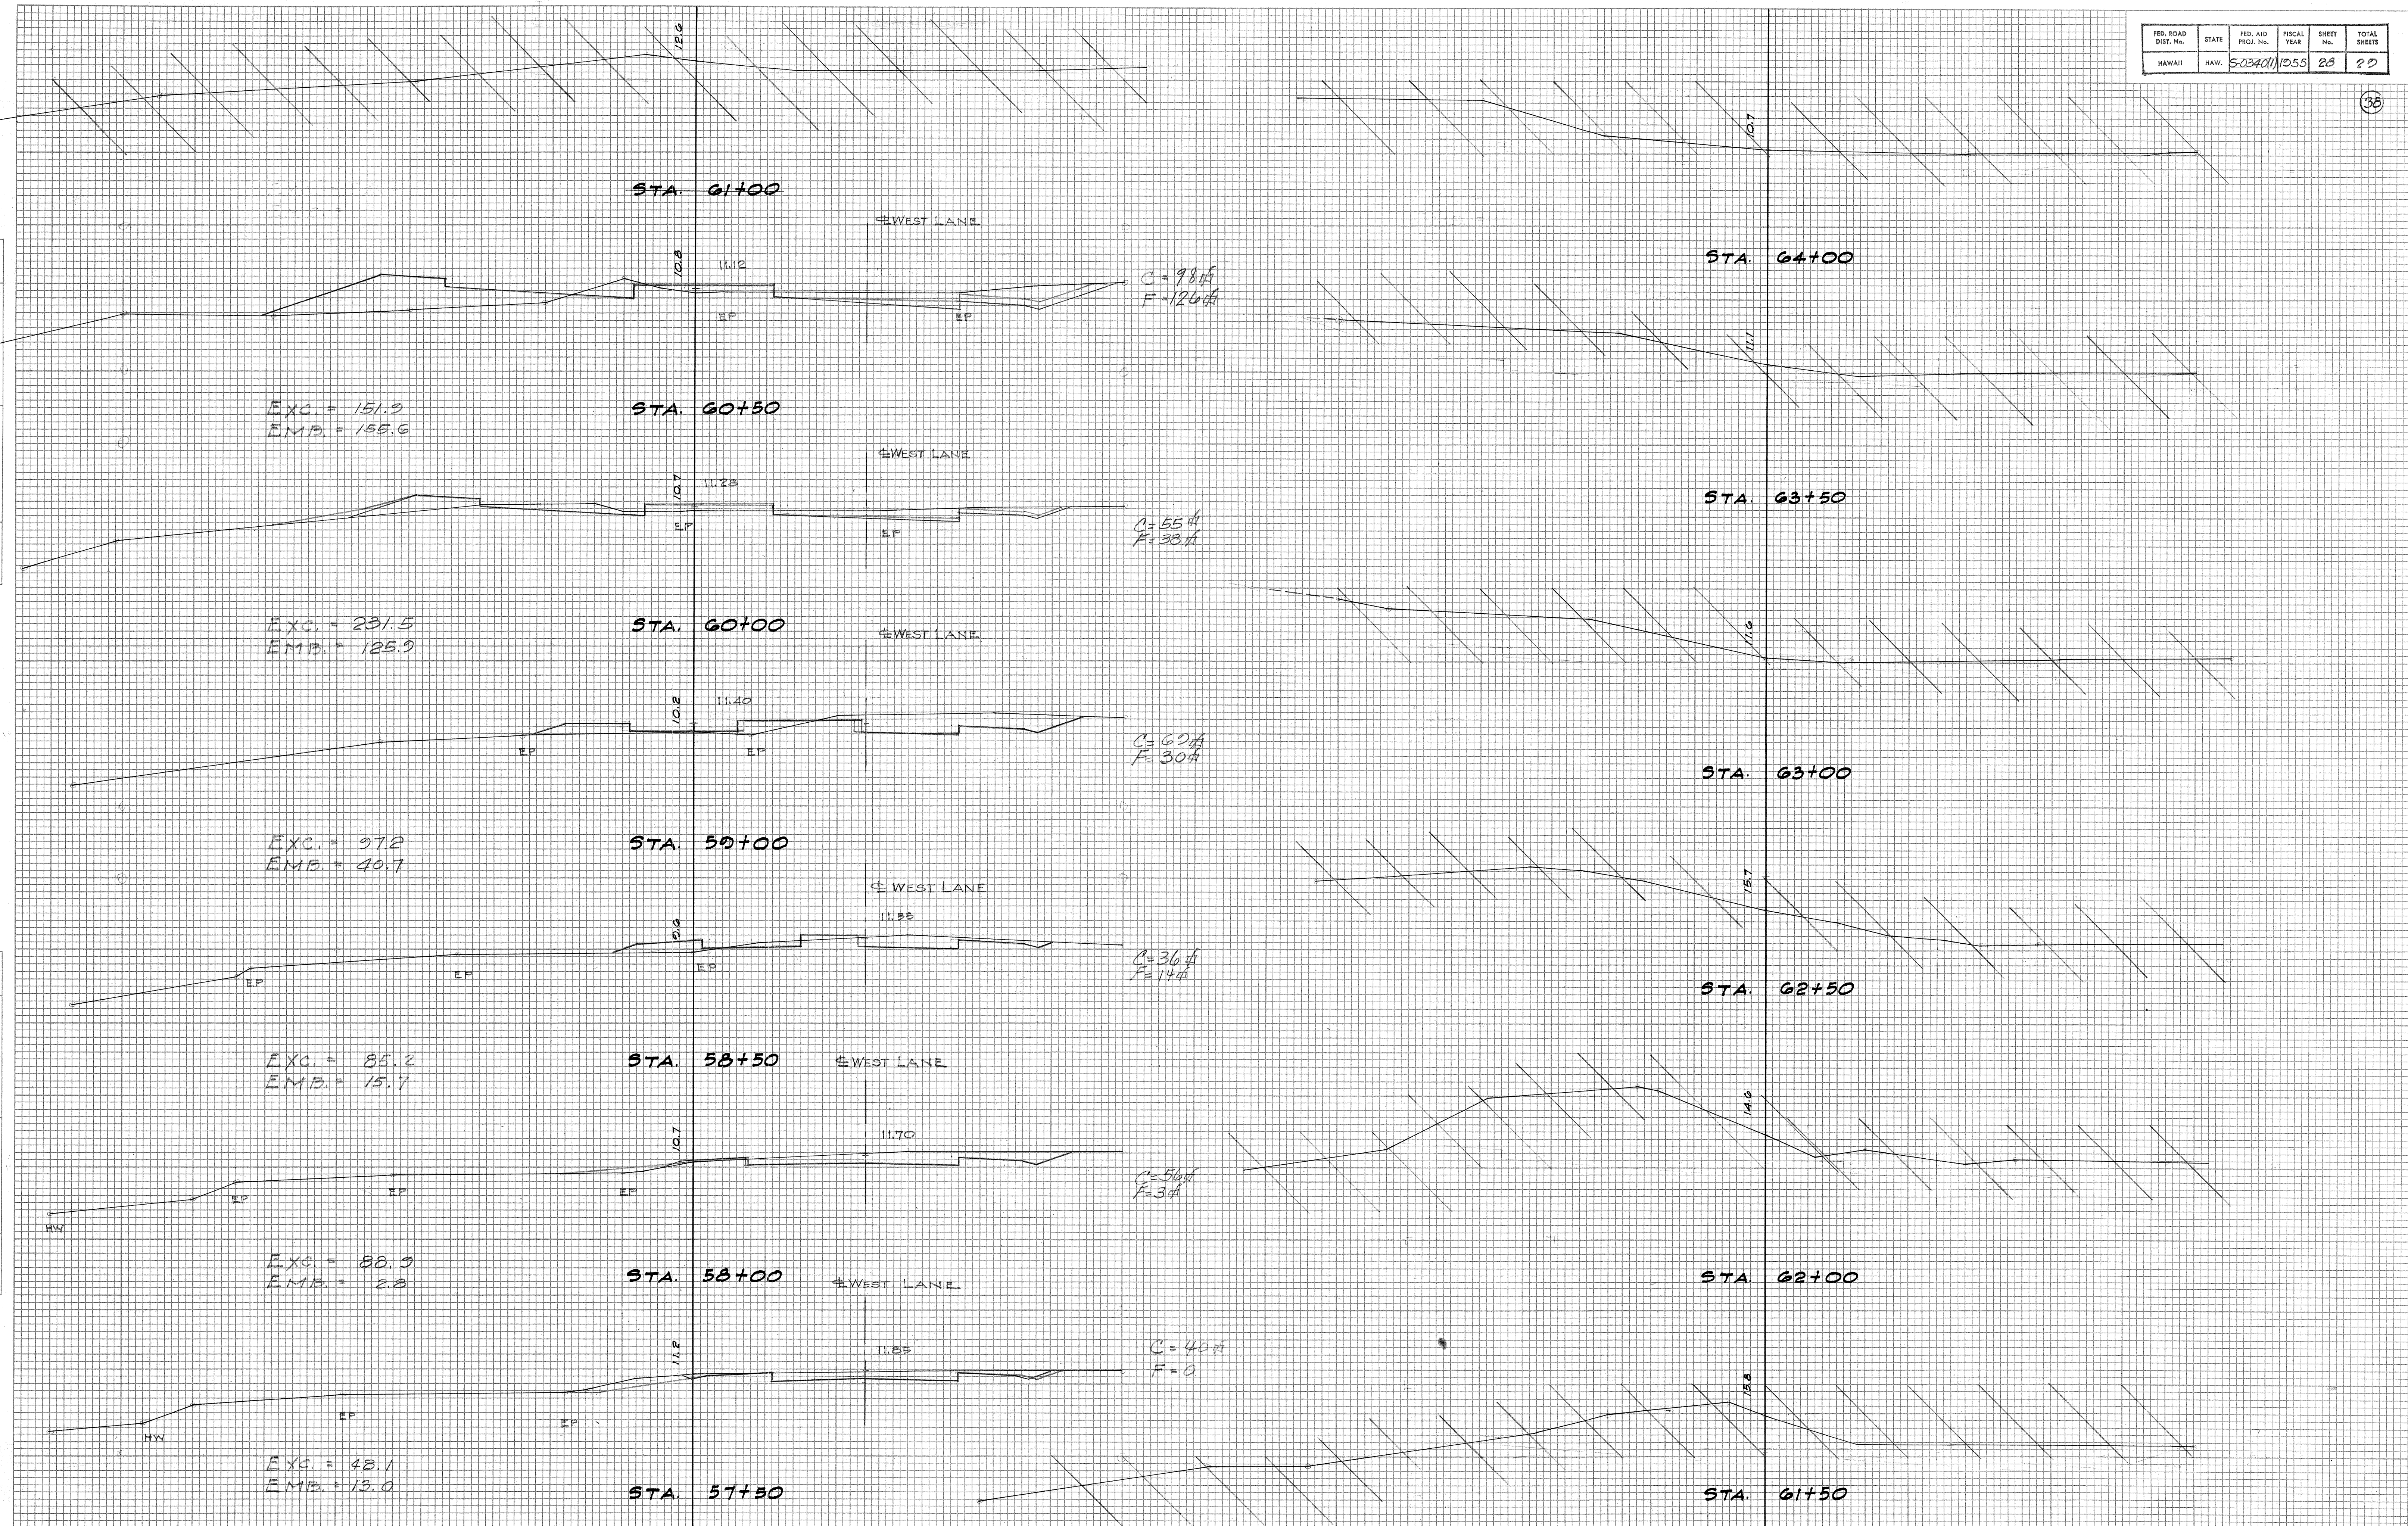

NEW - 661107 from STA. 1-60+96.00 to 68+00

FED. ROAD DIST. No.	STATE	FED. AID PROJ. No.	FISCAL YEAR	SHEET No.	TOTAL SHEETS
HAWAII	HAW.	S-034011	1955	29	29

39

DATE	BY	DATE	BY
3/10/55	C. E. D.		
SURVEYED		CHECKED	
NOTE BOOK		AREAS	
NO.		NO.	

DATE	BY	DATE	BY
SURVEYED		CHECKED	
NOTE BOOK		AREAS	
NO.		NO.	

