

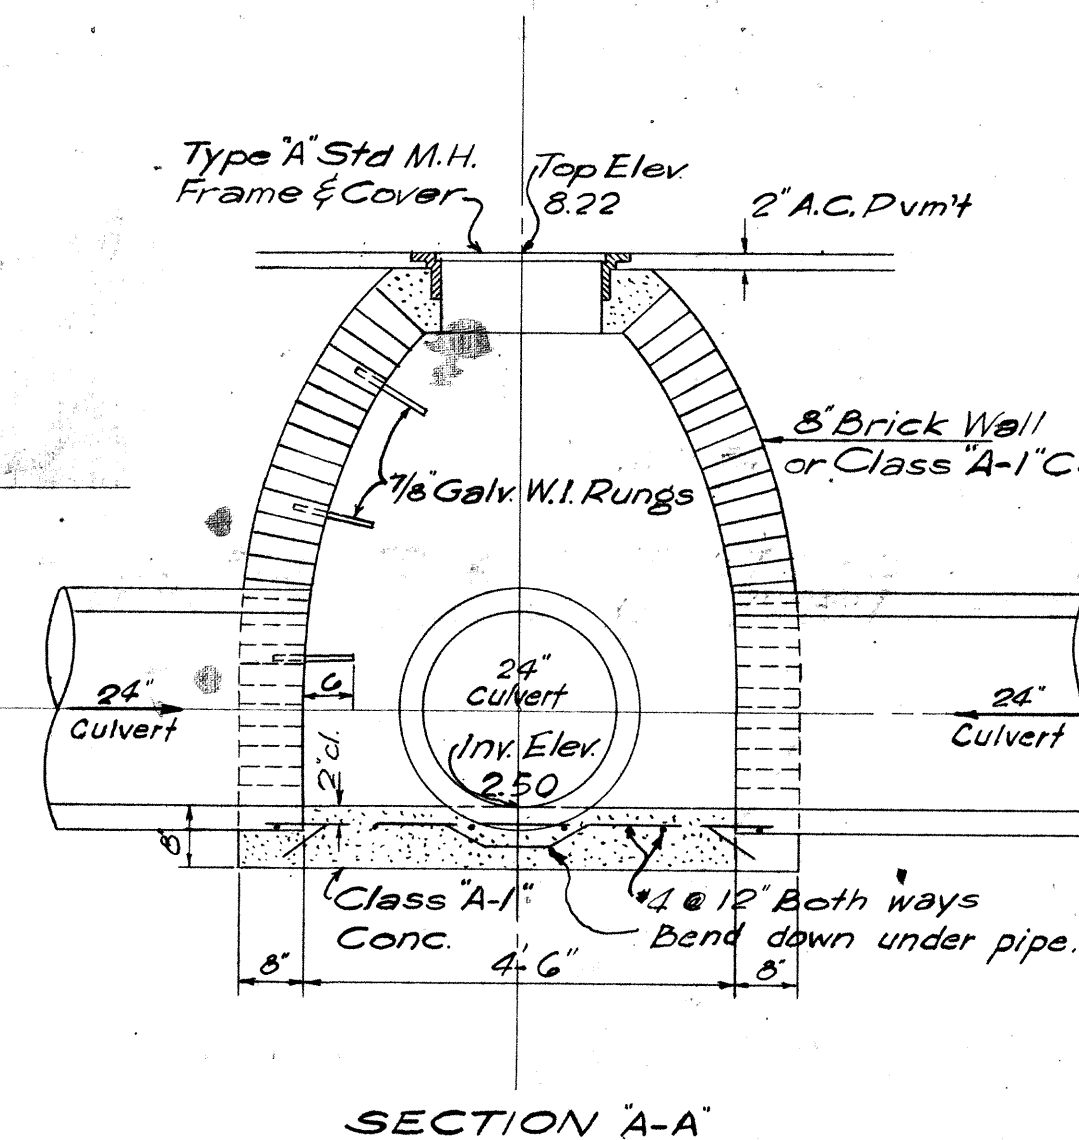
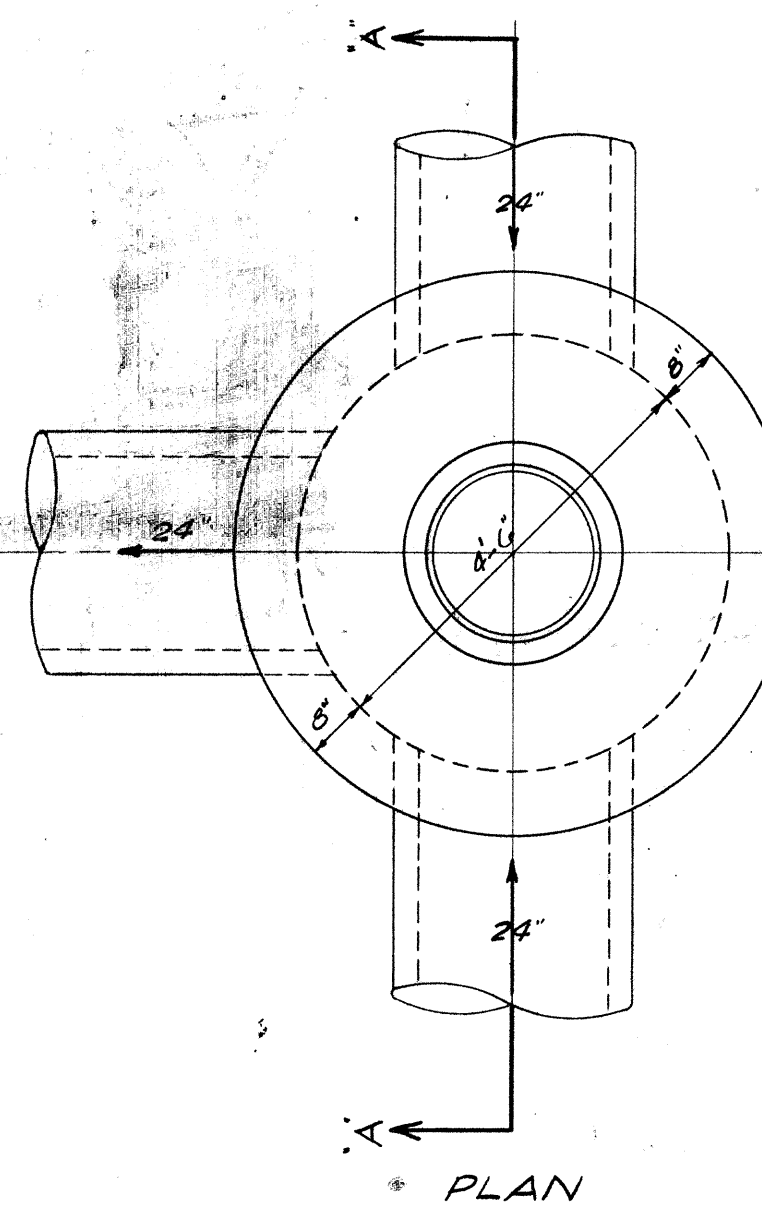


PLAN	SURVEYED	BY	DATE
NO.	PLOTTED		
	ALIGNED		
	CHECKED		
	BY		
	DATE		

PROFILE	SURVEYED	BY	DATE
NO.	PLOTTED		
	ALIGNED		
	CHECKED		
	BY		
	DATE		


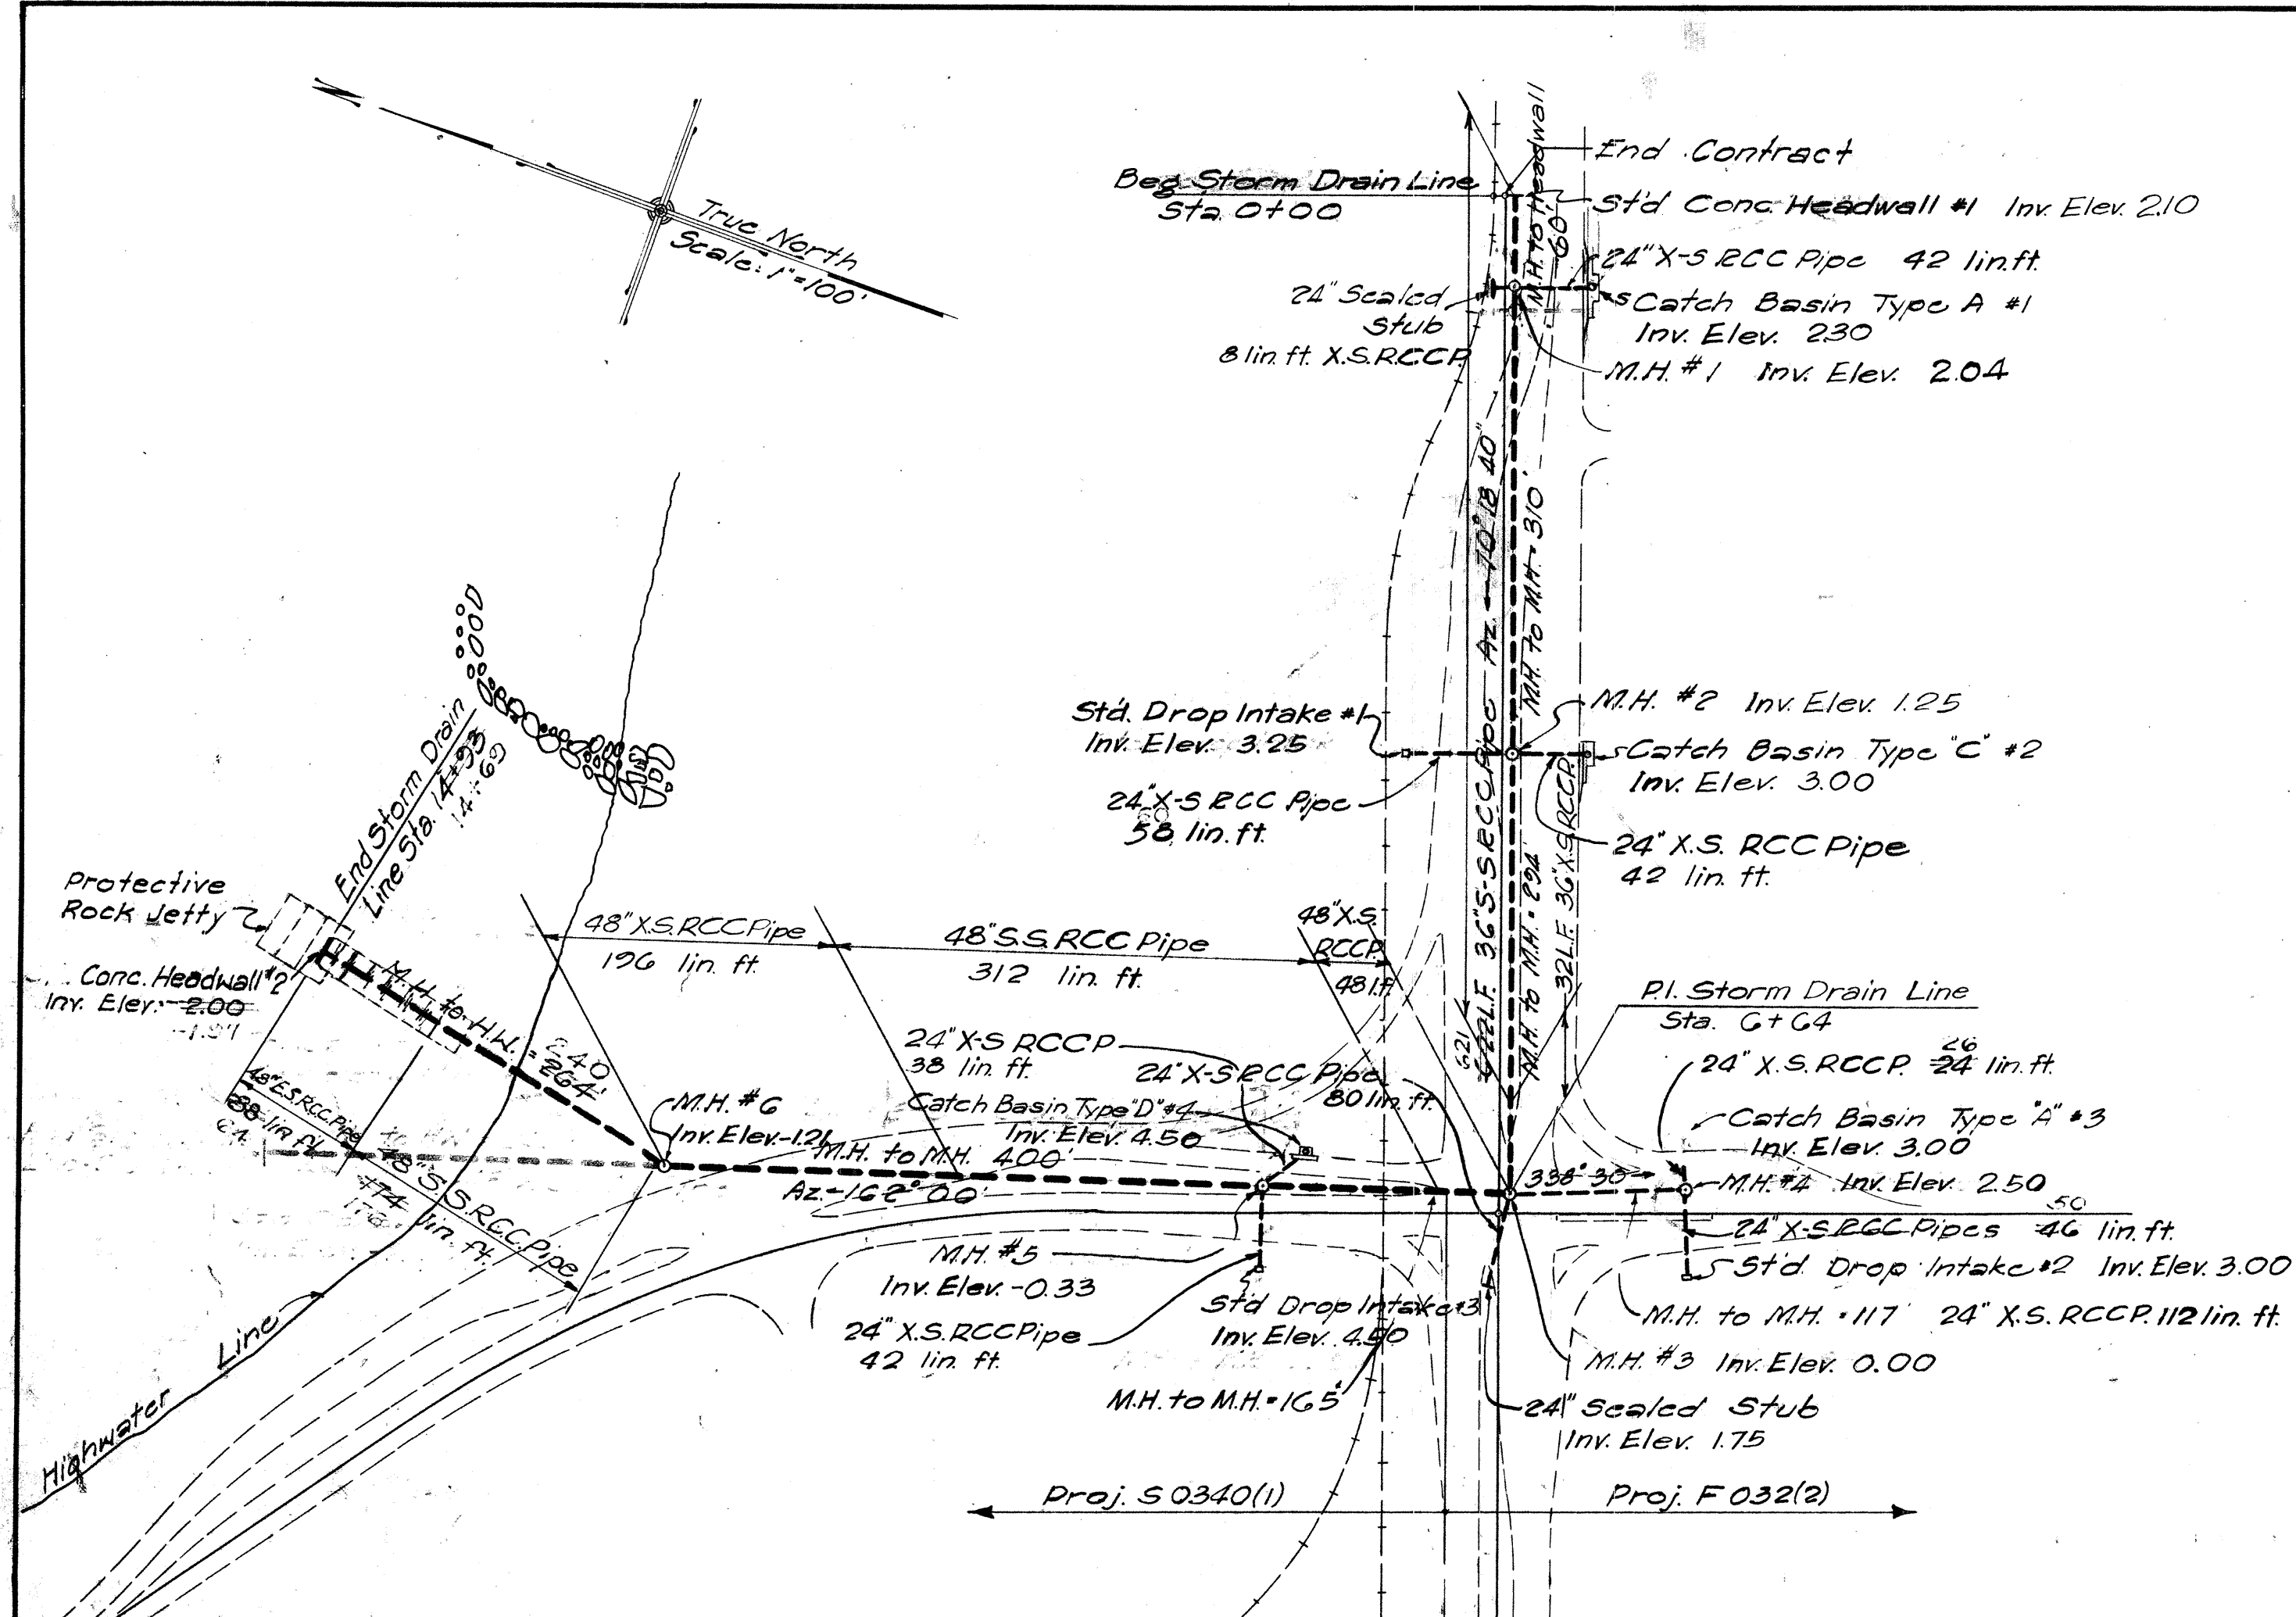


NOTE: If brick is used exterior surface of wall shall be plastered with 1" thickness of 1:2 cement mortar.

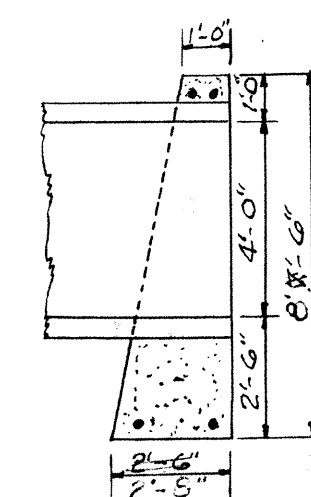



NOTE: For details of Special Manholes Nos. 1, 2, 3, 5, 6 See Sheet No. 5748.9 Crush Rock Cushion Under Culvert outfall to be Paid for Under Item No. 20. Special Rock Fill.

SECTION THROUGH HEADWALL #2
Scale: 1/4" = 1'-0"
Note: All other dimensions Standard

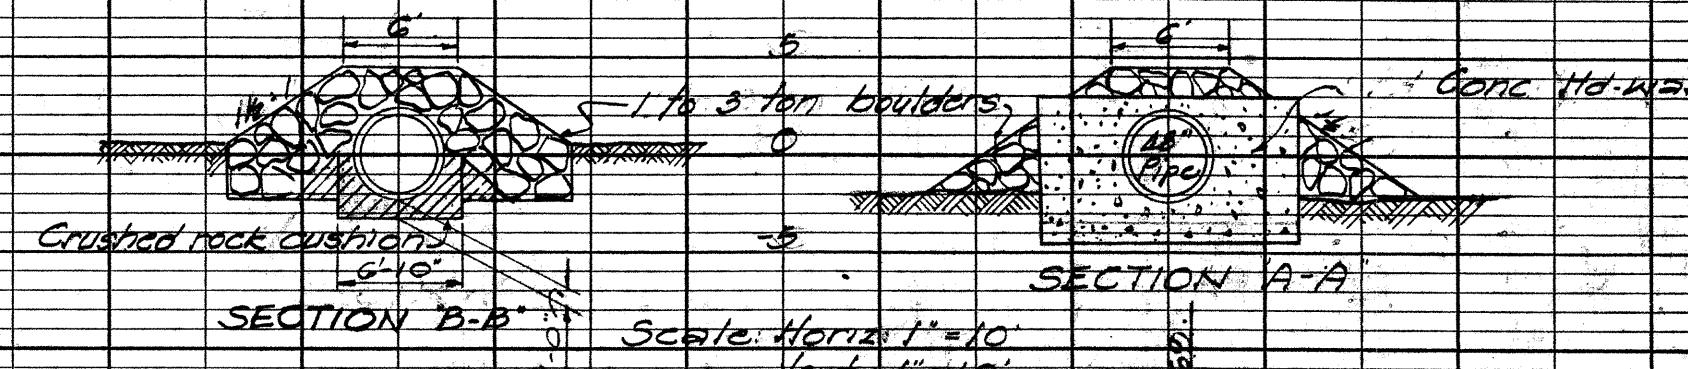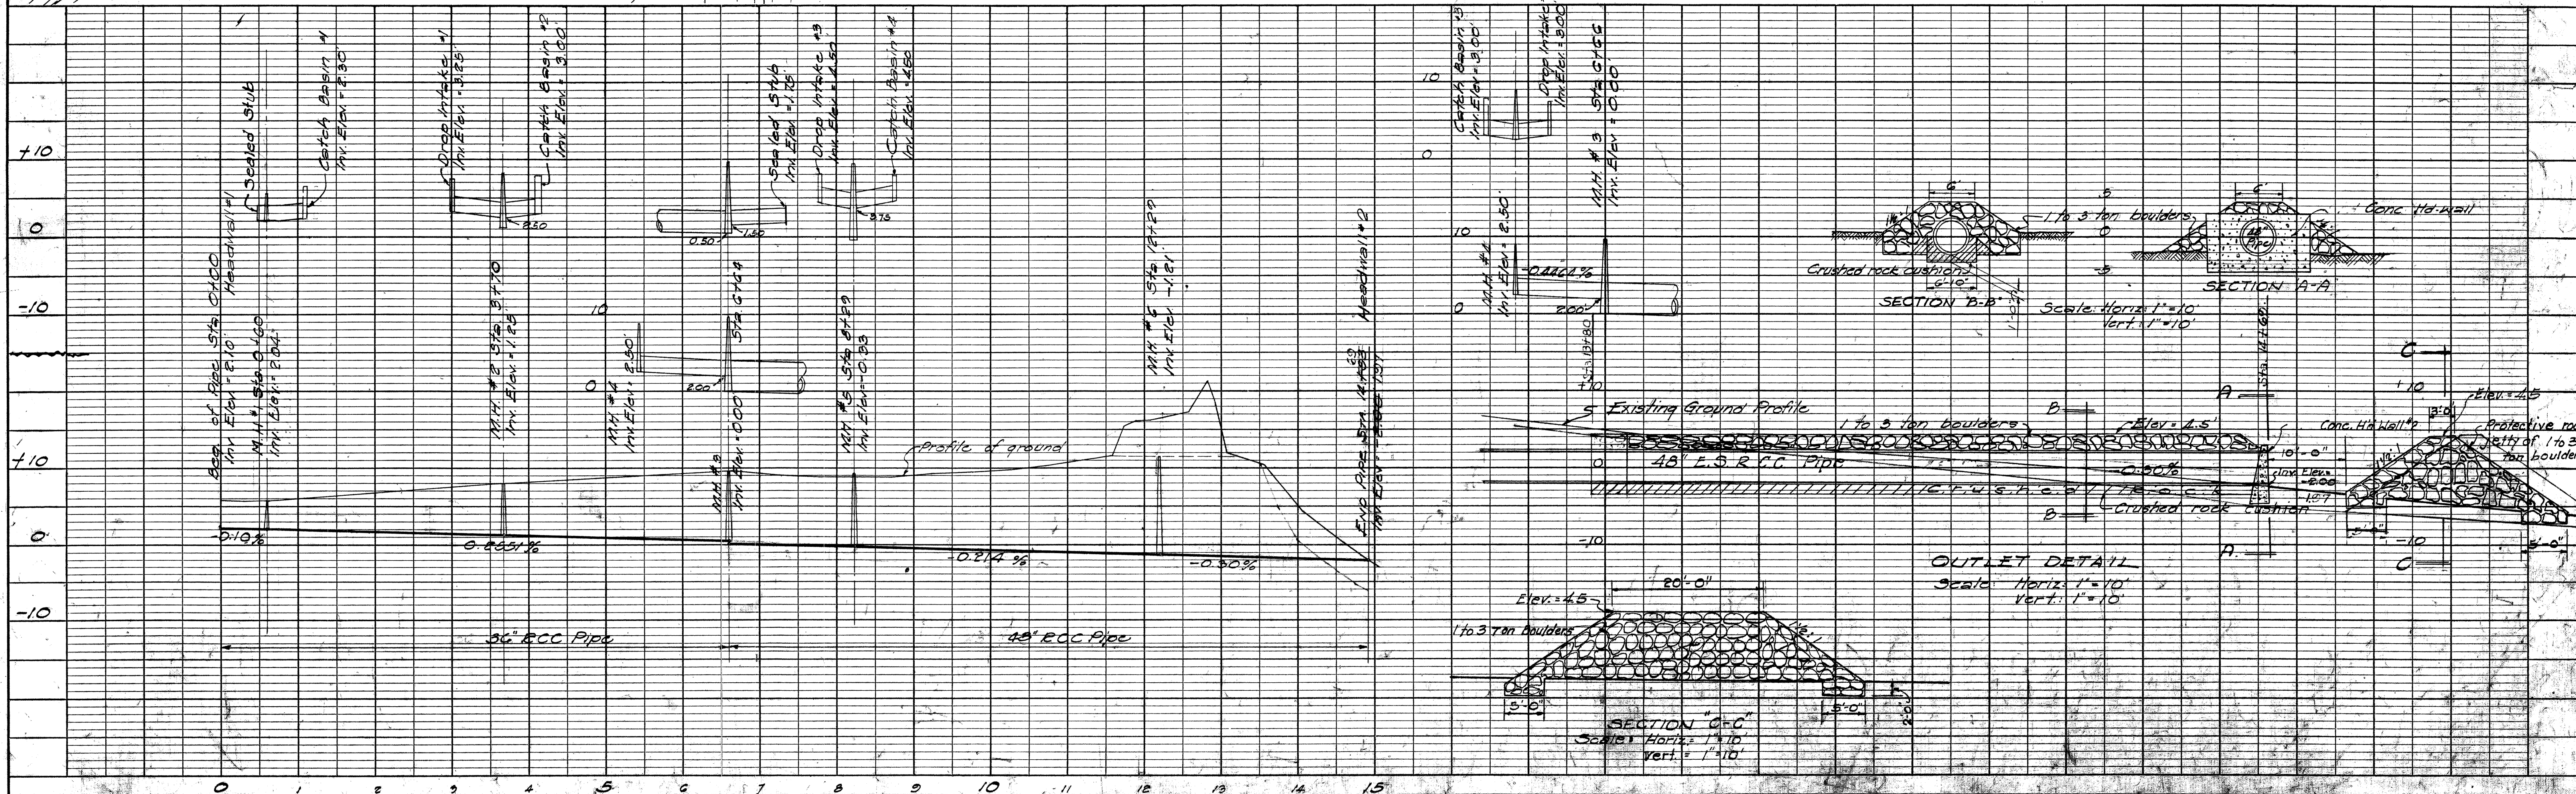


OUTLET DETAIL
Scale: Horiz. 1" = 10' Vert. 1" = 10'

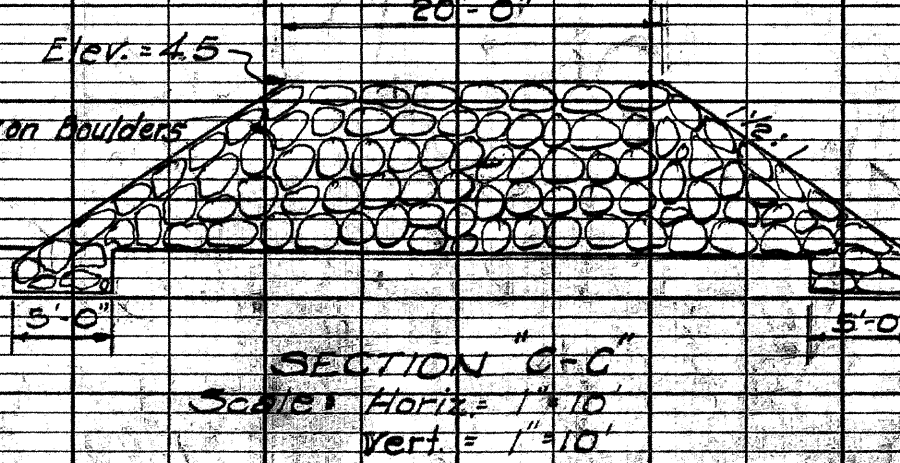


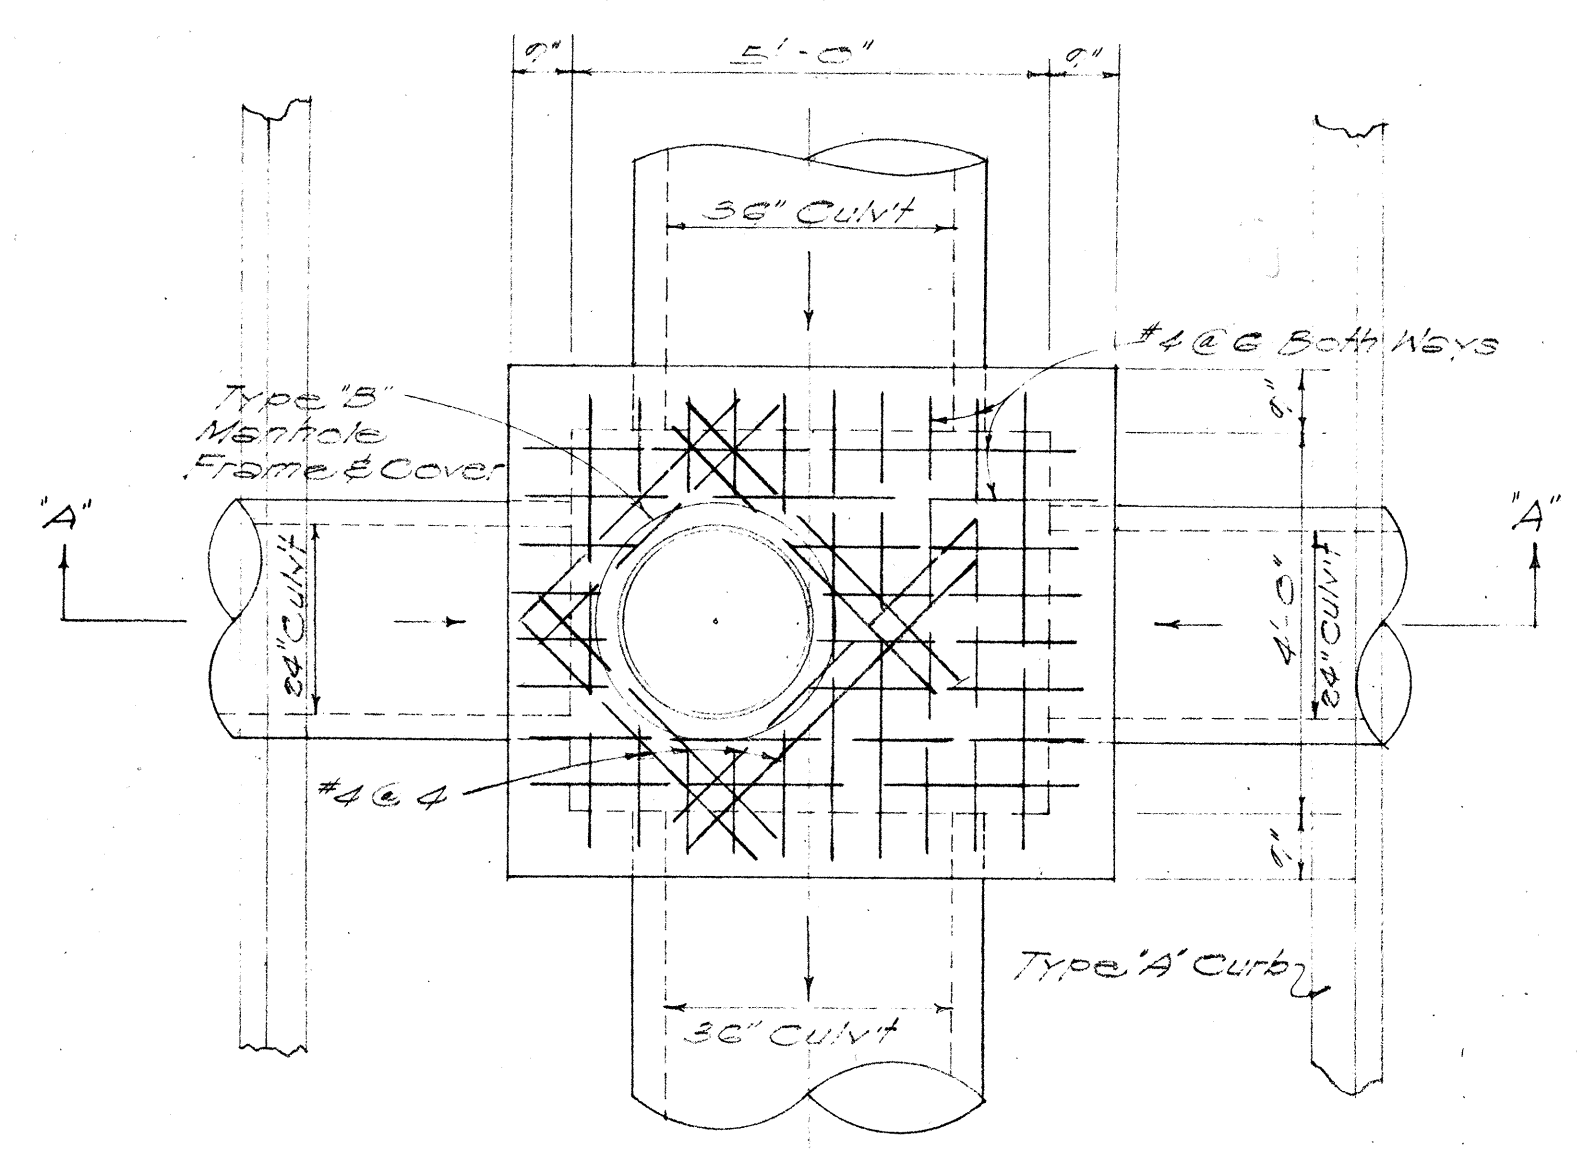


PLAN MH#1

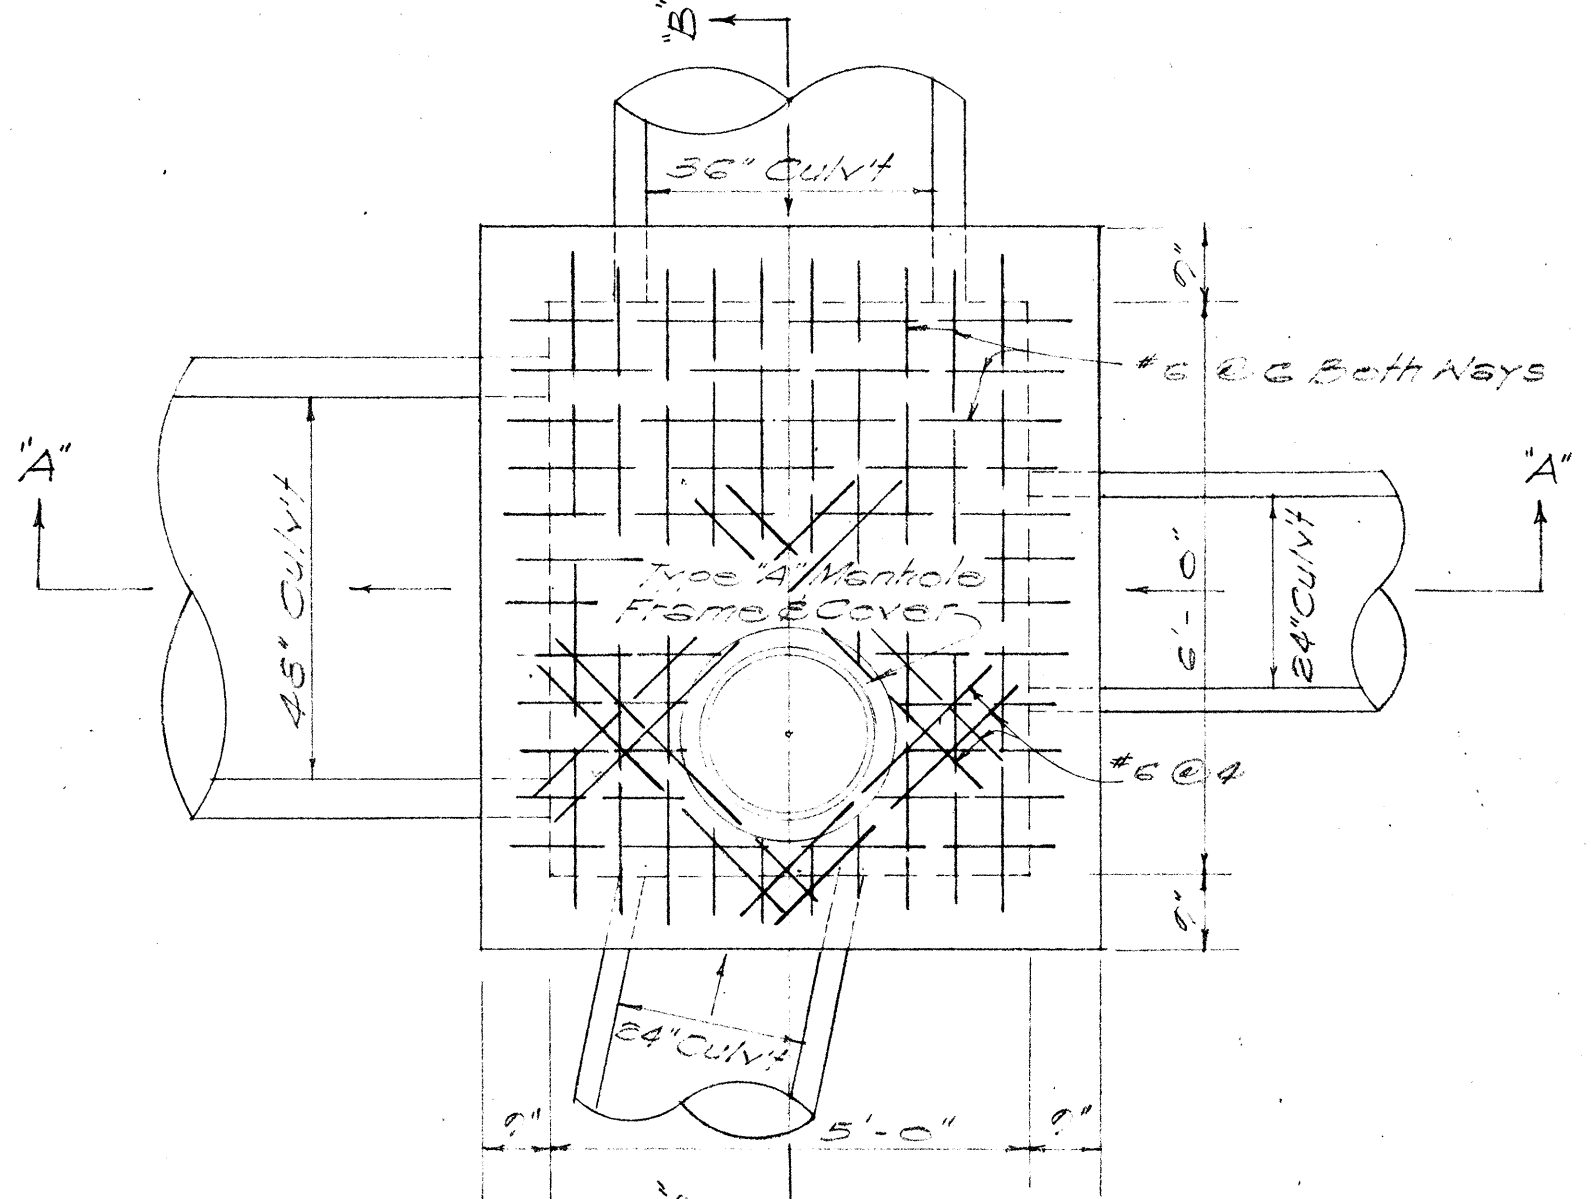


PLAN

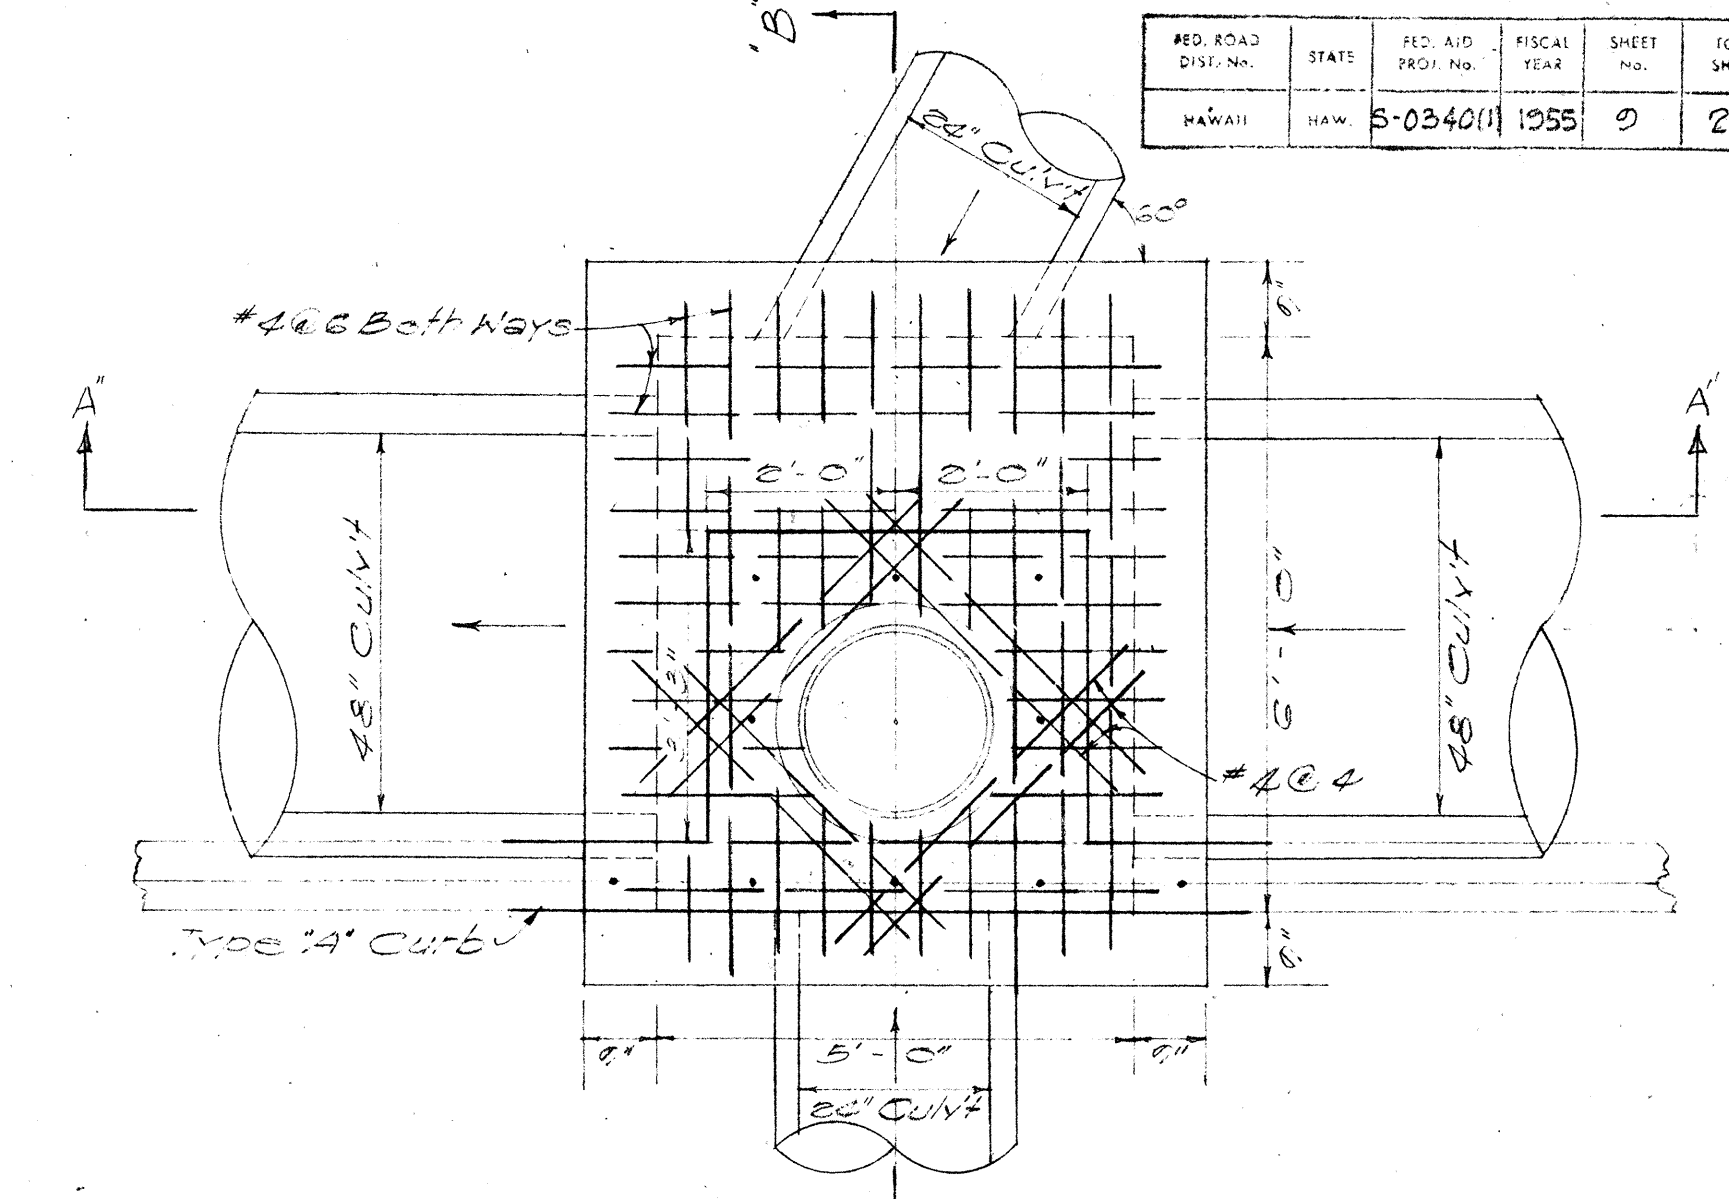


PLAN MH#3

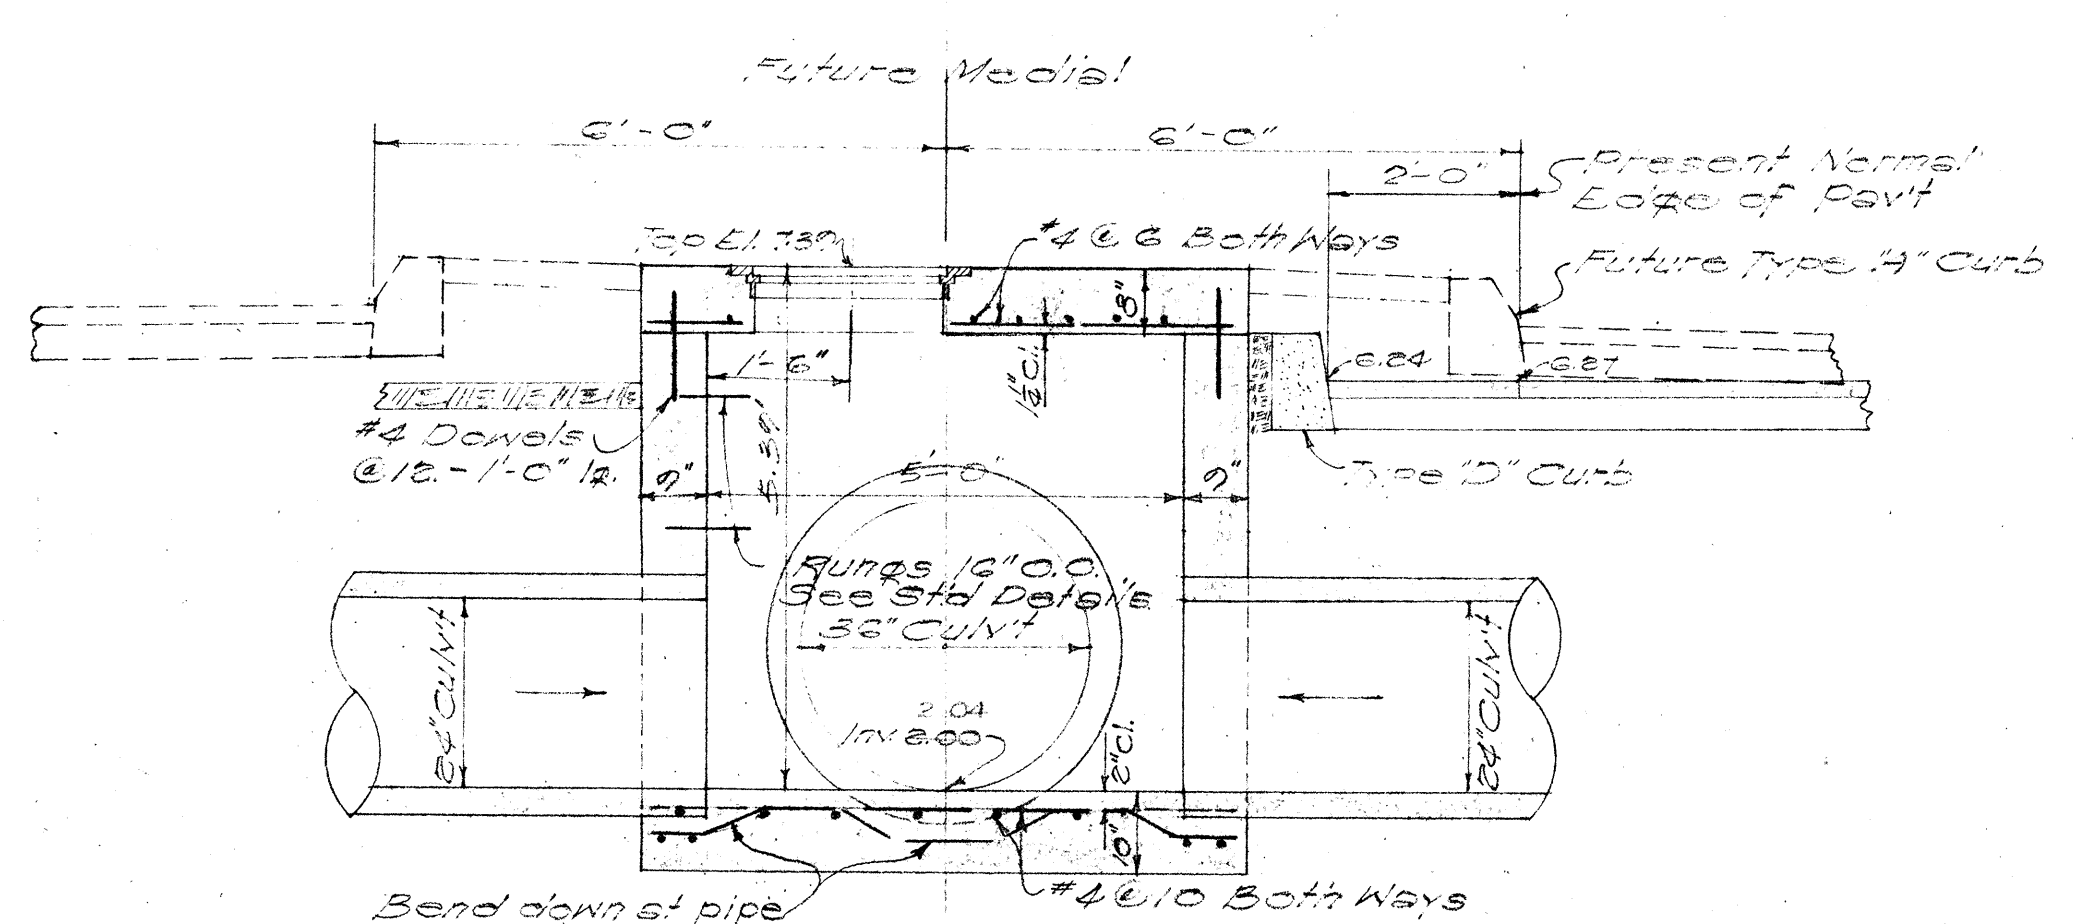


SECTION A-A MH#1

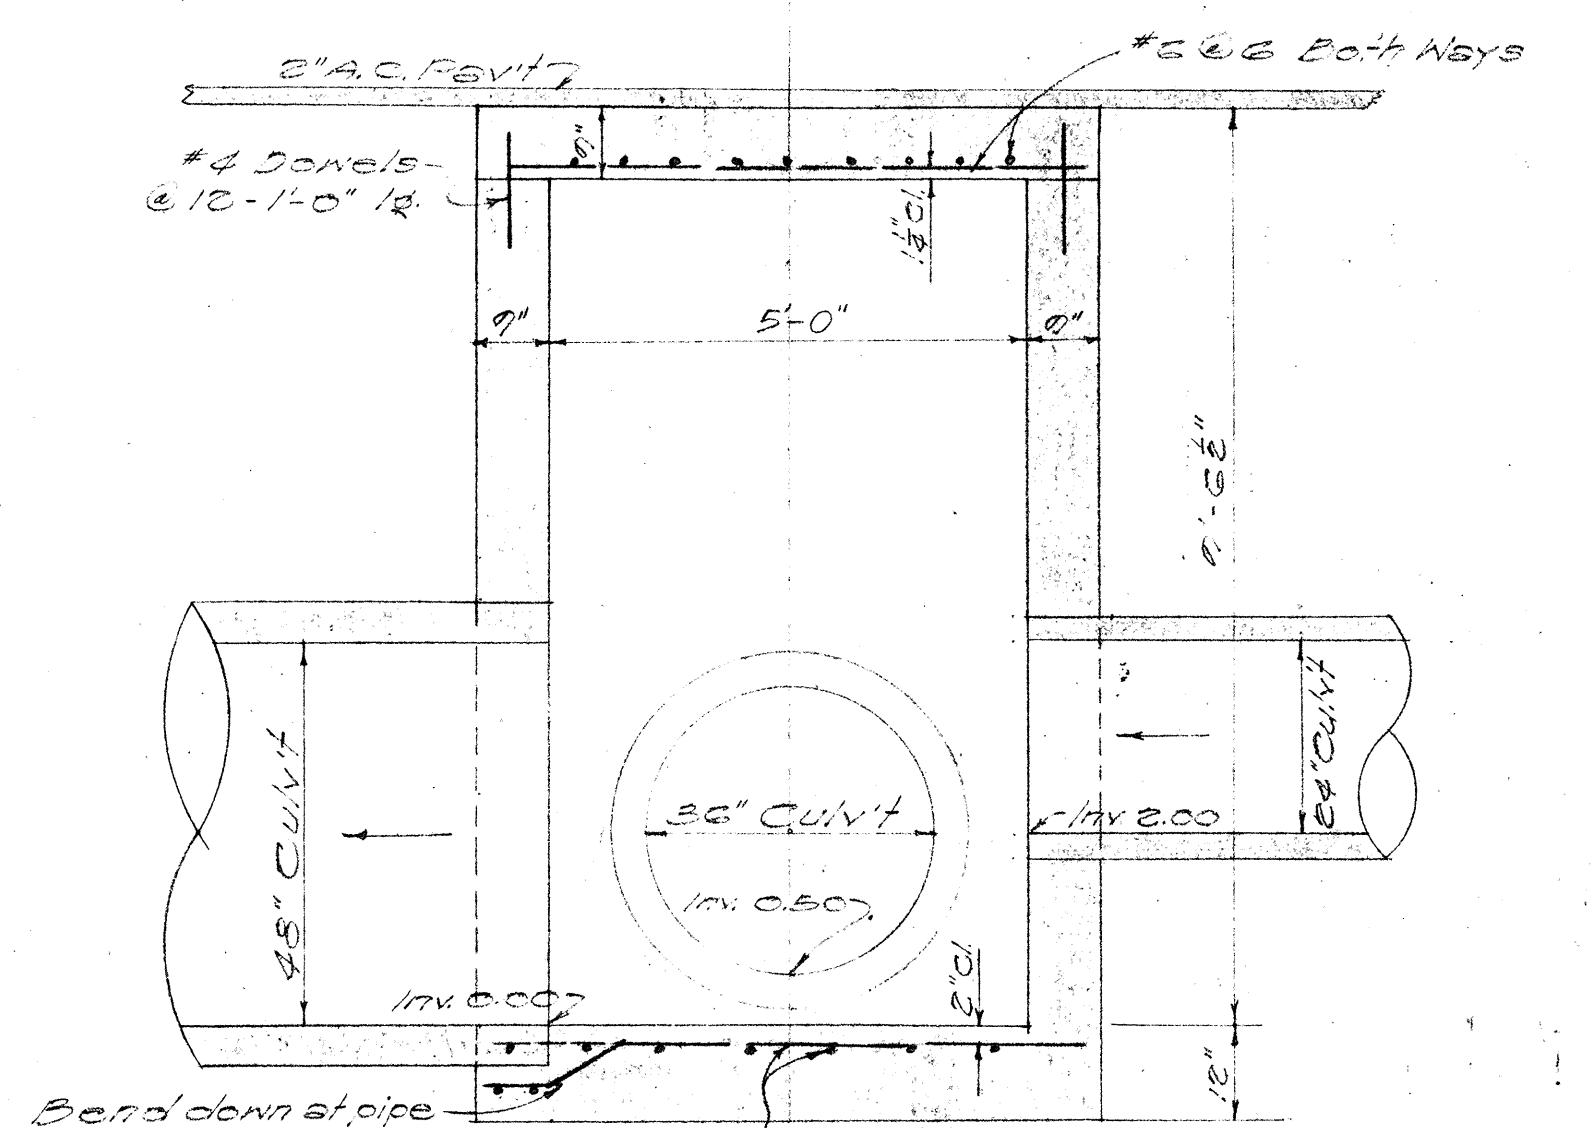


SECTION A-A

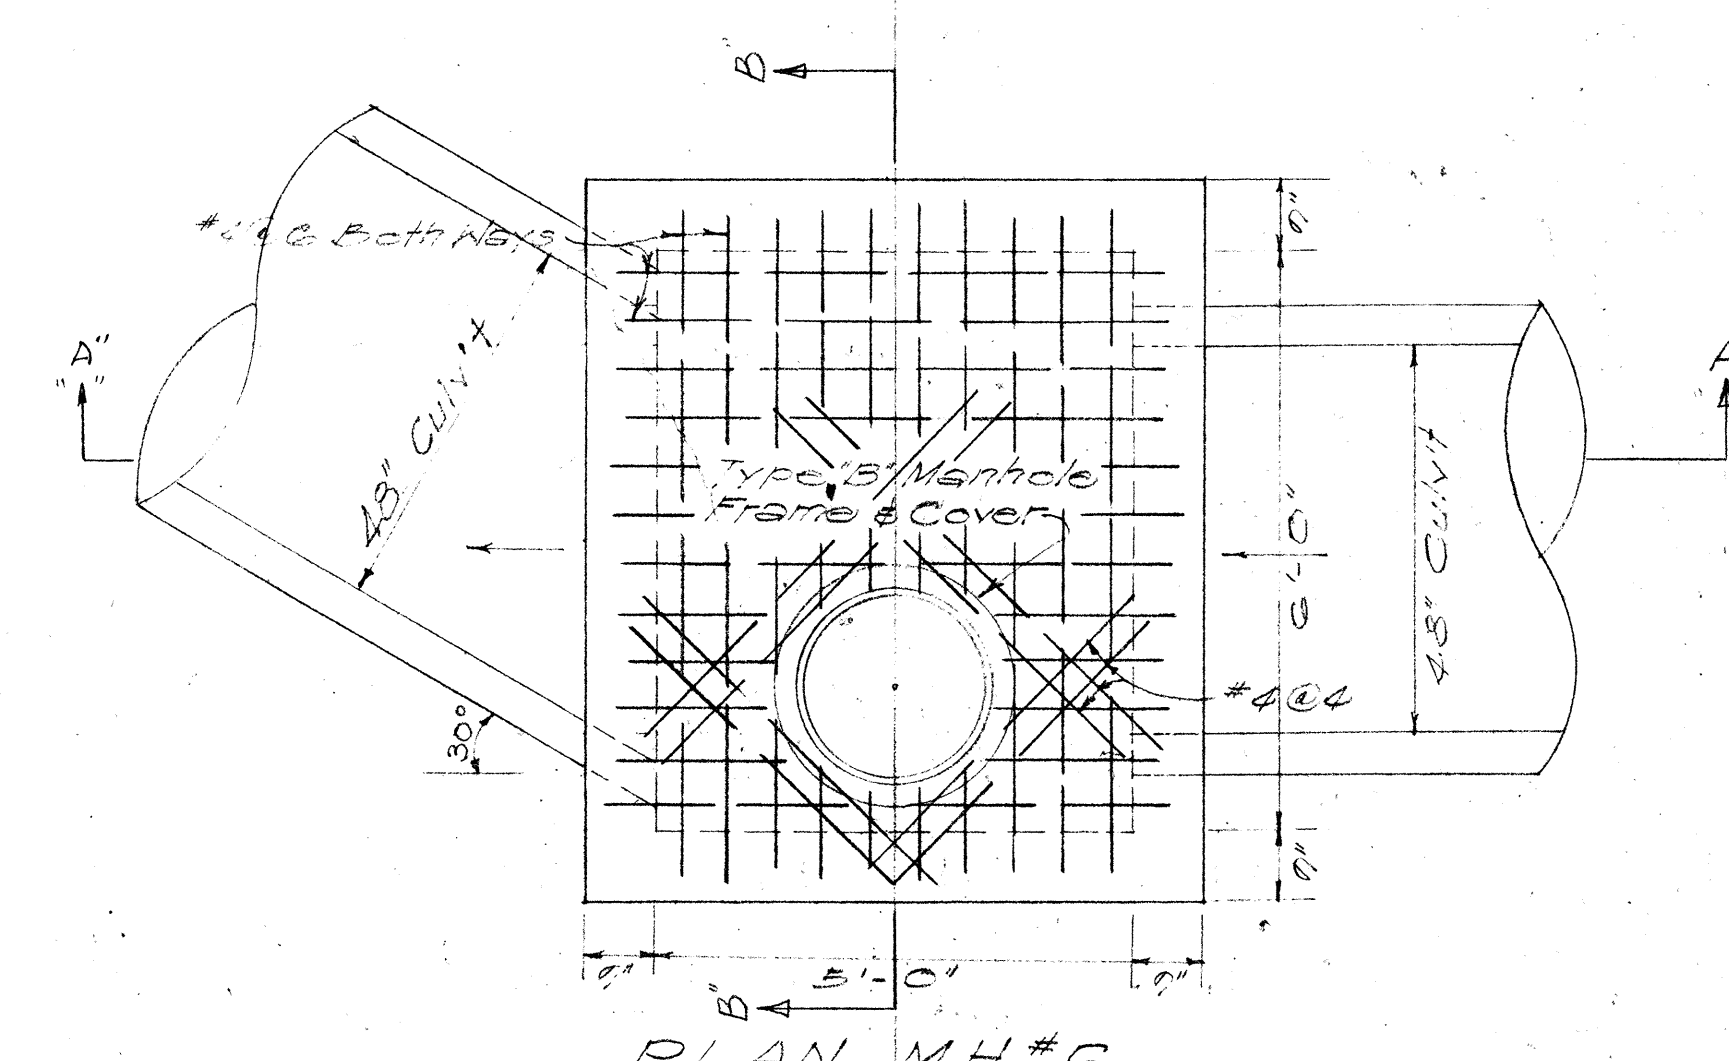


PLAN MH#4

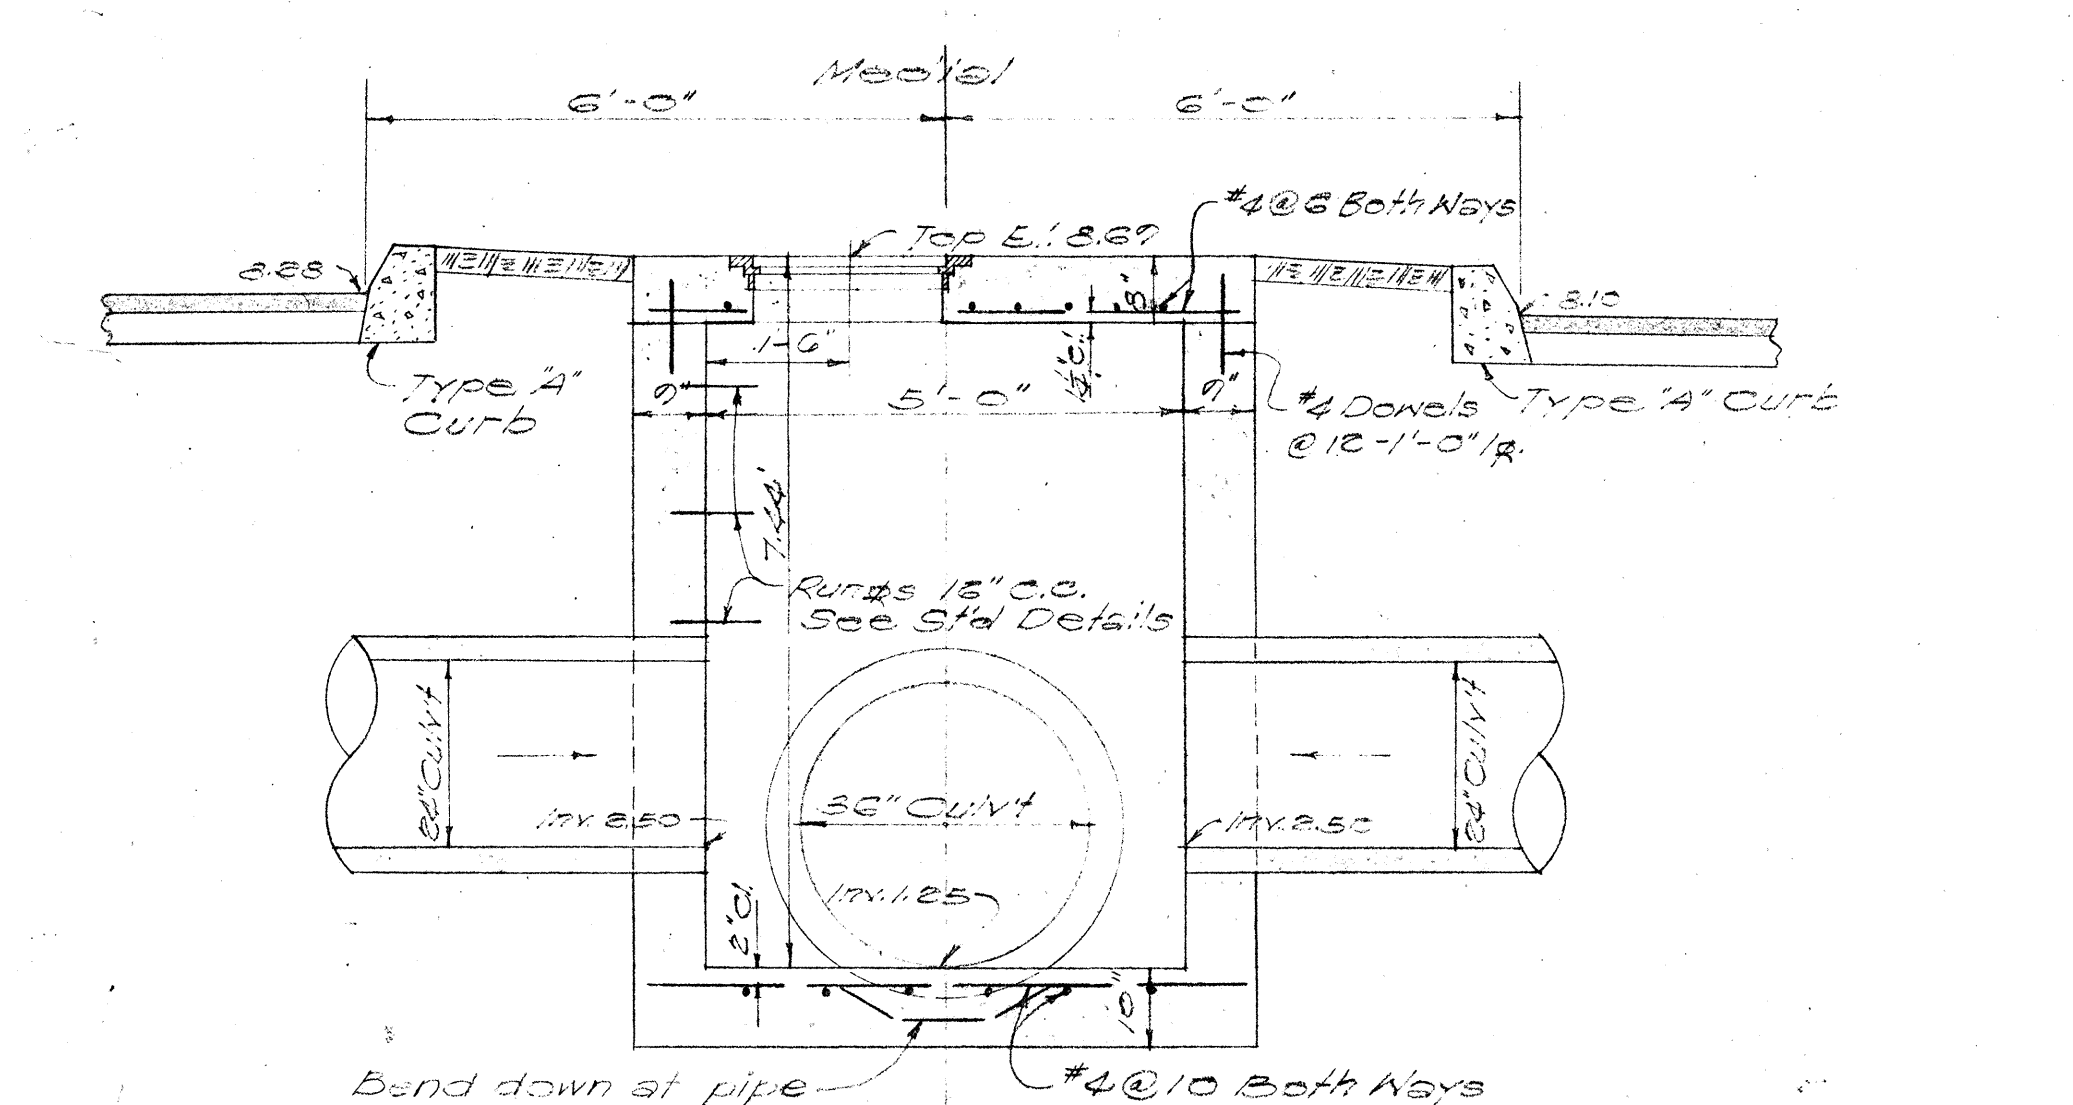


SECTION A-A MH#2

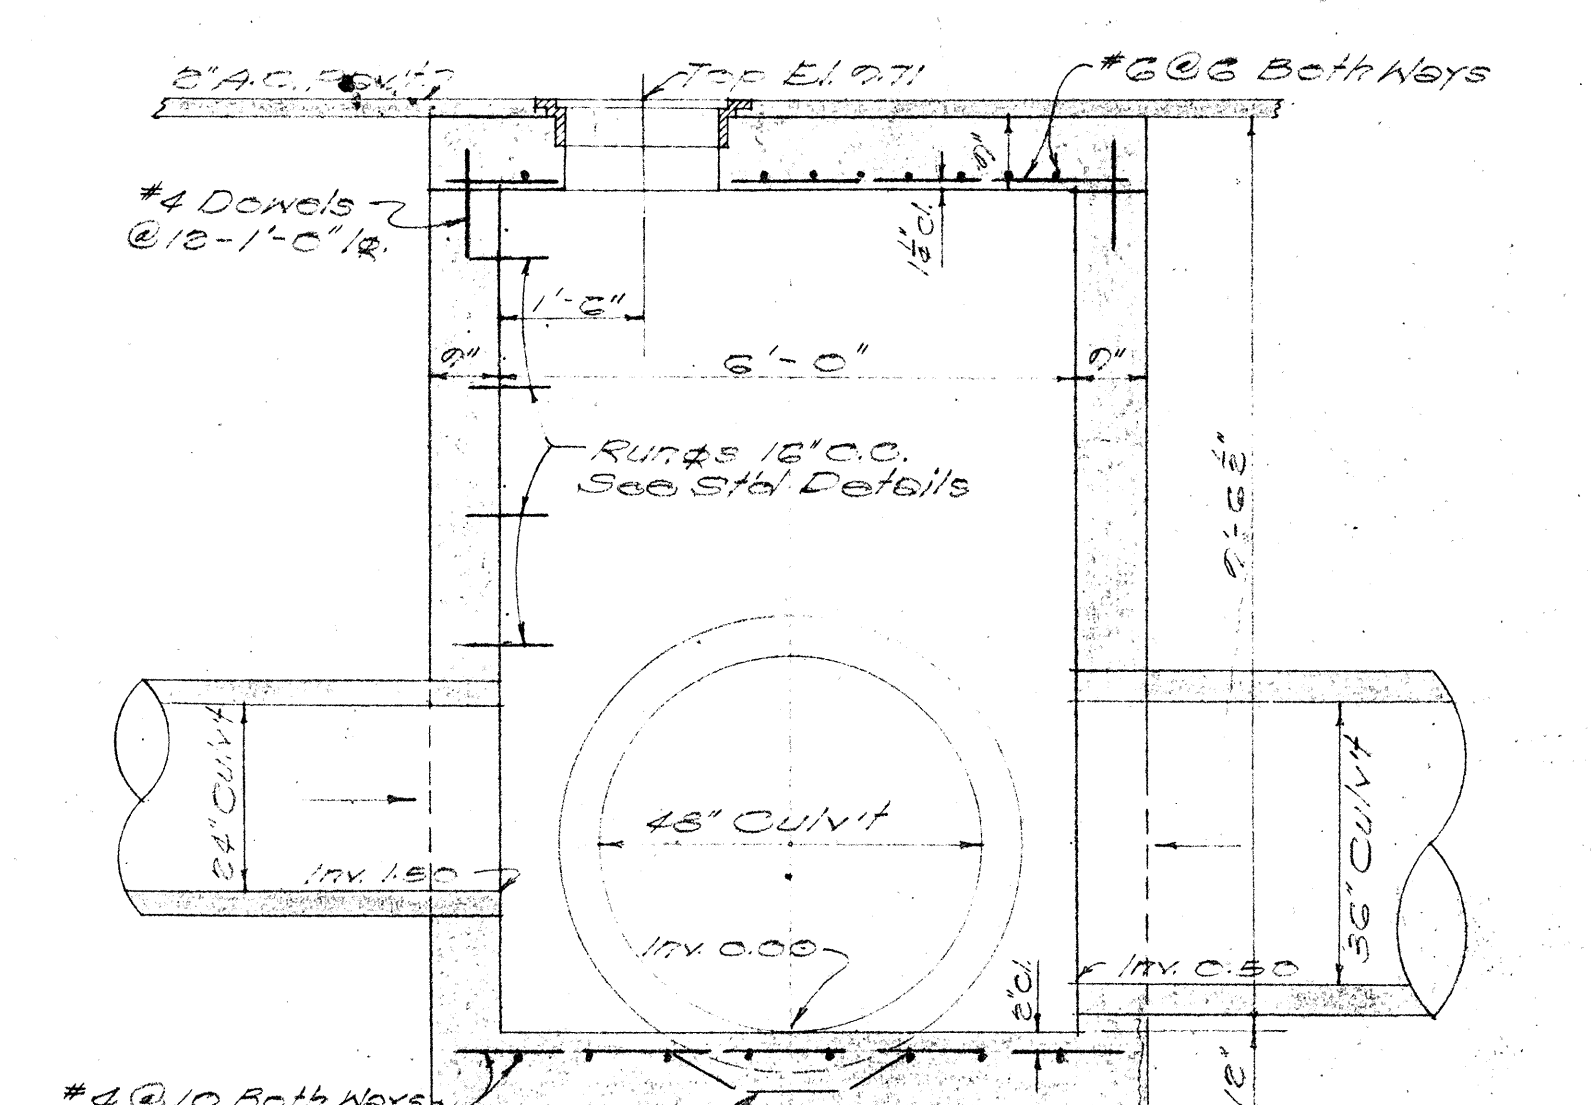

DETAIL OF MH#3

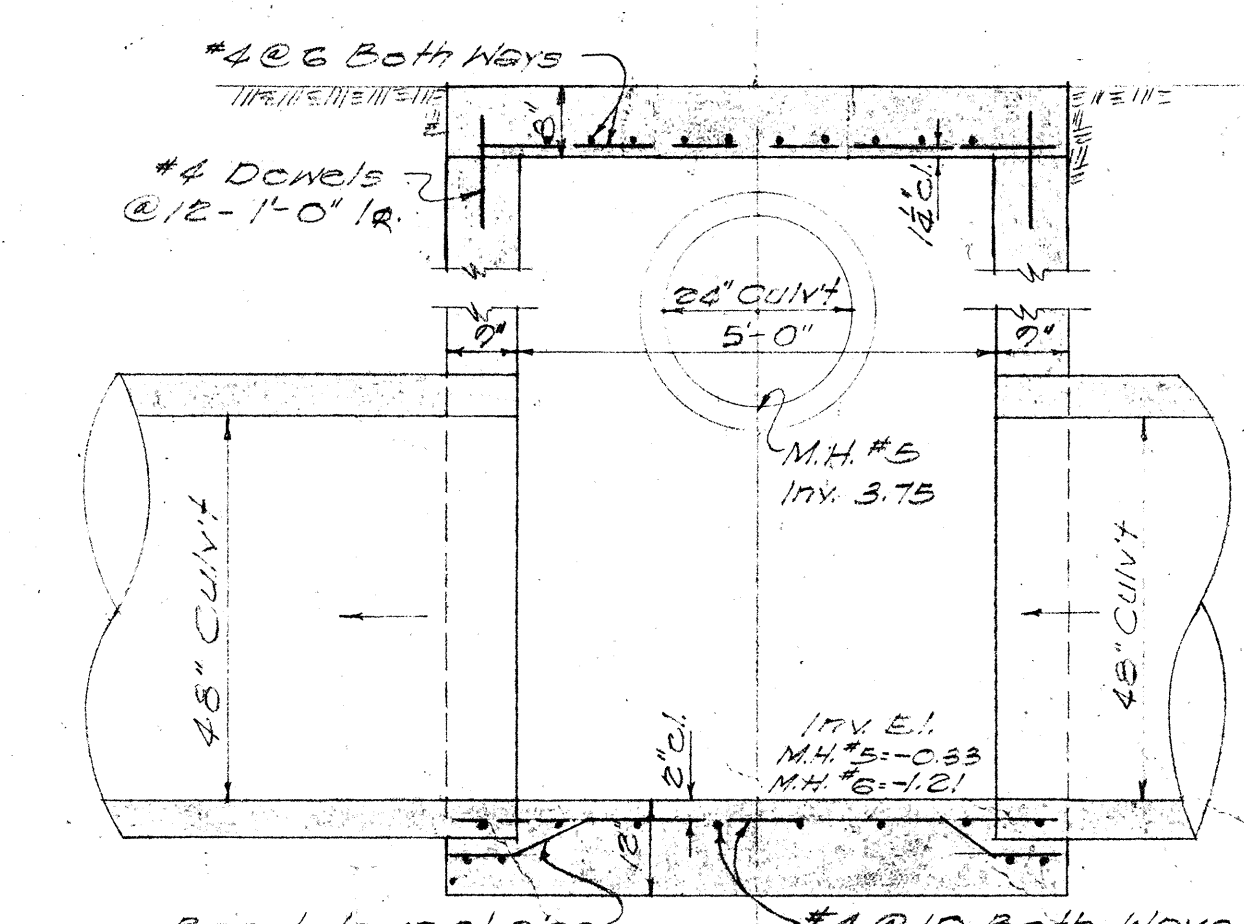

SECTION A-A MH#5

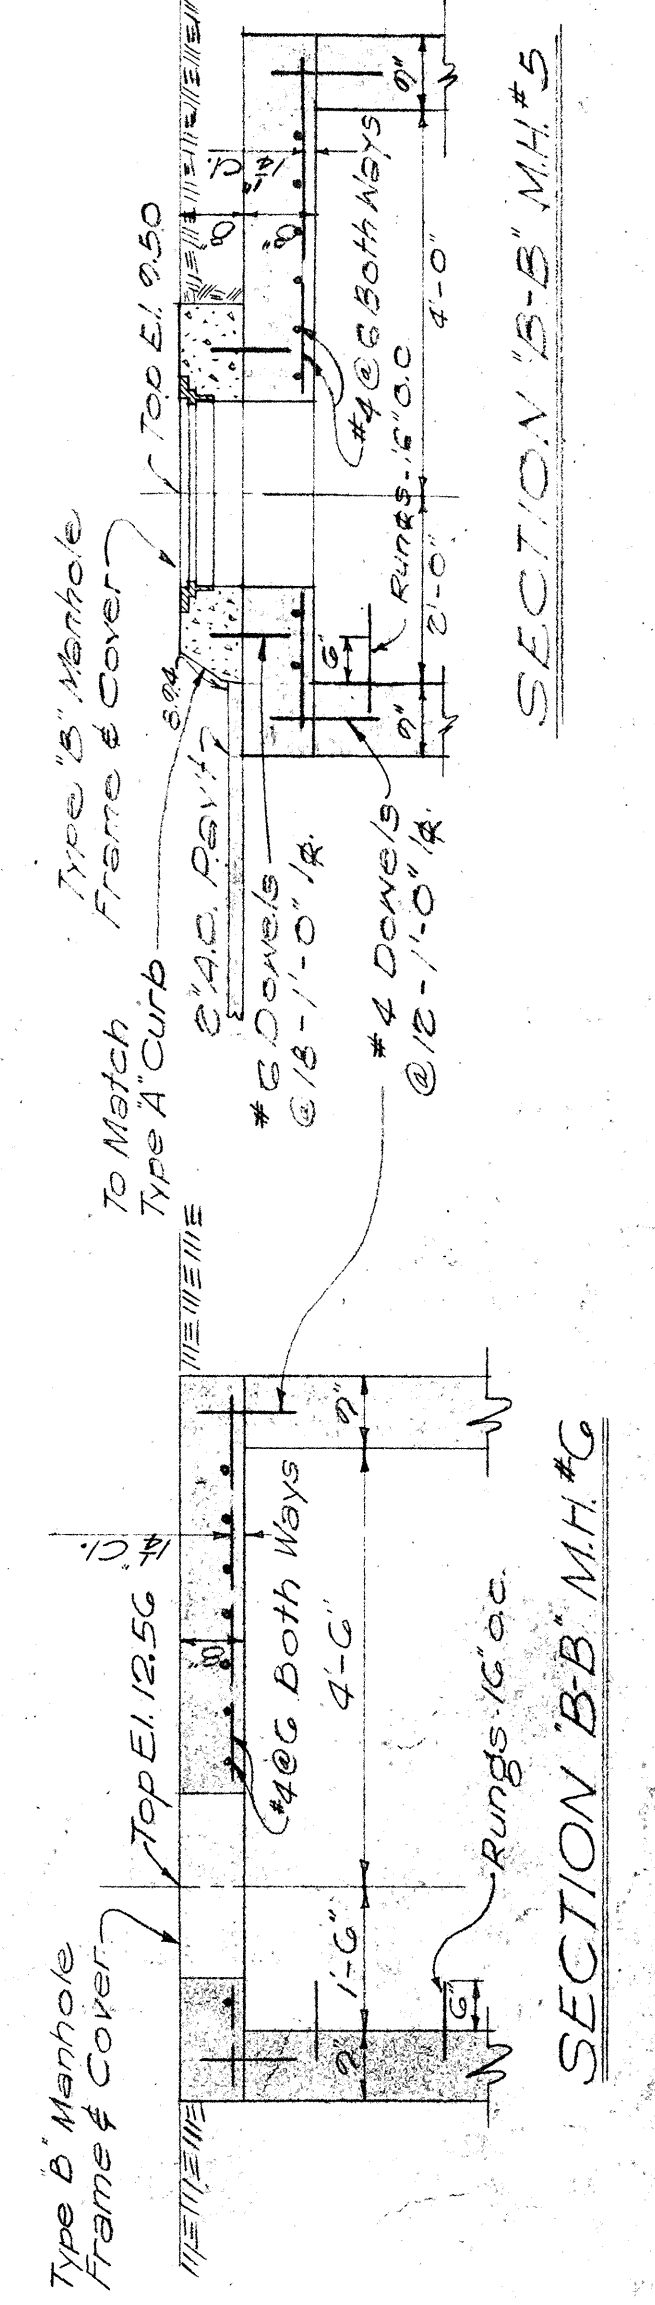

SECTION B-B MH#5

QUANTITY SUMMARY					
M.H. No.	Struct. Exc. C.Y.	A-1 Conc. C.Y.	Reinf. Steel lbs.	M.H. Frame & Cover Type "A"	Type "B"
1	98.3	3.8	140		1
2	181.4	5.0	140		1
3	273.3	5.1	280	1	
5	29.7	7.8	120		1
6	437.5	11.0	185		1

TERRITORIAL HIGHWAY DEPARTMENT
TERRITORY OF HAWAII
S.D. MANHOLES
Nos. 1, 2, 3, 5 & 6
KAHULUI BEACH ROAD
KAHUMANU AVE. - MAIN ST.
PROJ. NO. S-0340(1)
PROJ. NO. F-0340(2)
Scale: 1/2" = 1'-0"
May 1955

SURVEY PLOTTED BY: _____
DATE: _____
ORIGINAL PLAN DRAWN BY: _____
NOTE BOOK NO. _____
QUANTITIES CHECKED BY: _____