


INDEX TO DRAWINGS	
SHEET NO	DESCRIPTION
1	TITLE SHEET
2	TYPICAL SECTION
3	BORROW PIT SITE
4-6	PLAN & PROFILE
7	DETAIL PLAN
8-9	DRAINAGE SYSTEM
10	TRAFFIC SIGNS
11-18	STANDARD DETAILS
19-29	CROSS SECTIONS

CONVENTIONAL SIGNS

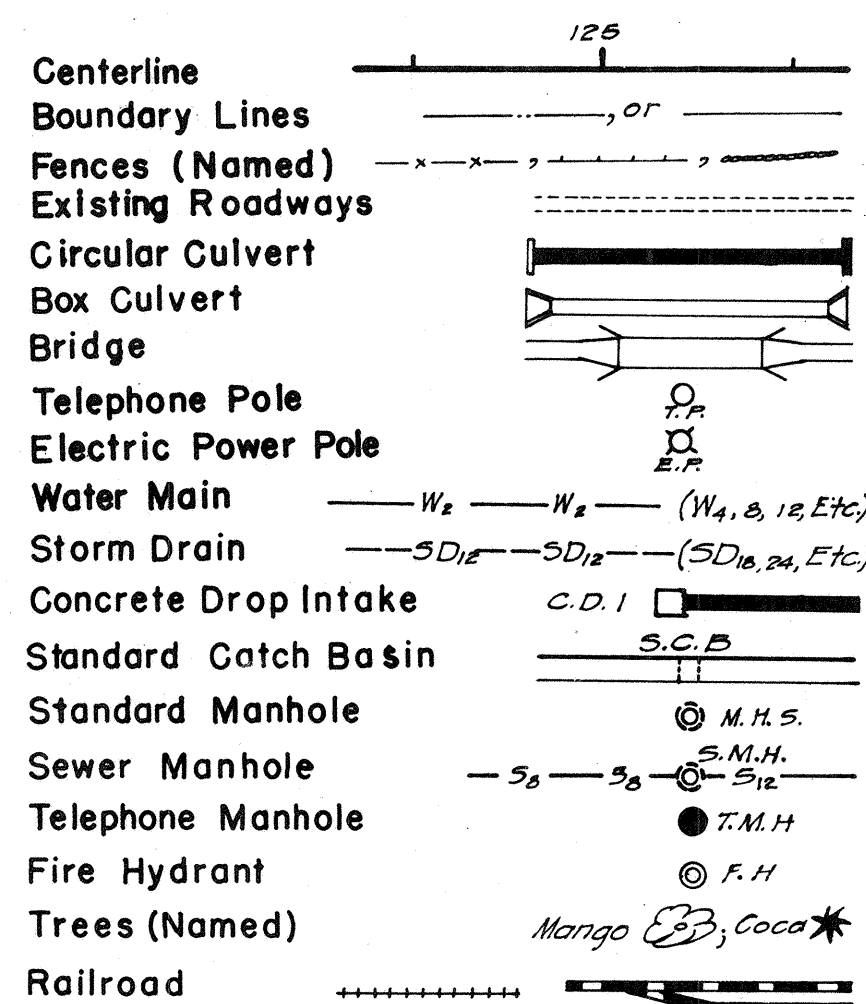


TERRITORY OF HAWAII TERRITORIAL HIGHWAY DEPARTMENT HONOLULU, T. H.

PLANS OF KAHULUI BEACH ROAD FEDERAL AID SECONDARY PROJECT No. S0340(1) DISTRICT OF WAILUKU ISLAND OF MAUI


SCALE

PLAN	1 IN. = 100 FT.
PROFILE	HOR. 1 IN. = 100 FT. VER. 1 IN. = 10 FT.
X-SECTIONS	HOR. 1 IN. = 10 FT. VER. 1 IN. = 10 FT.

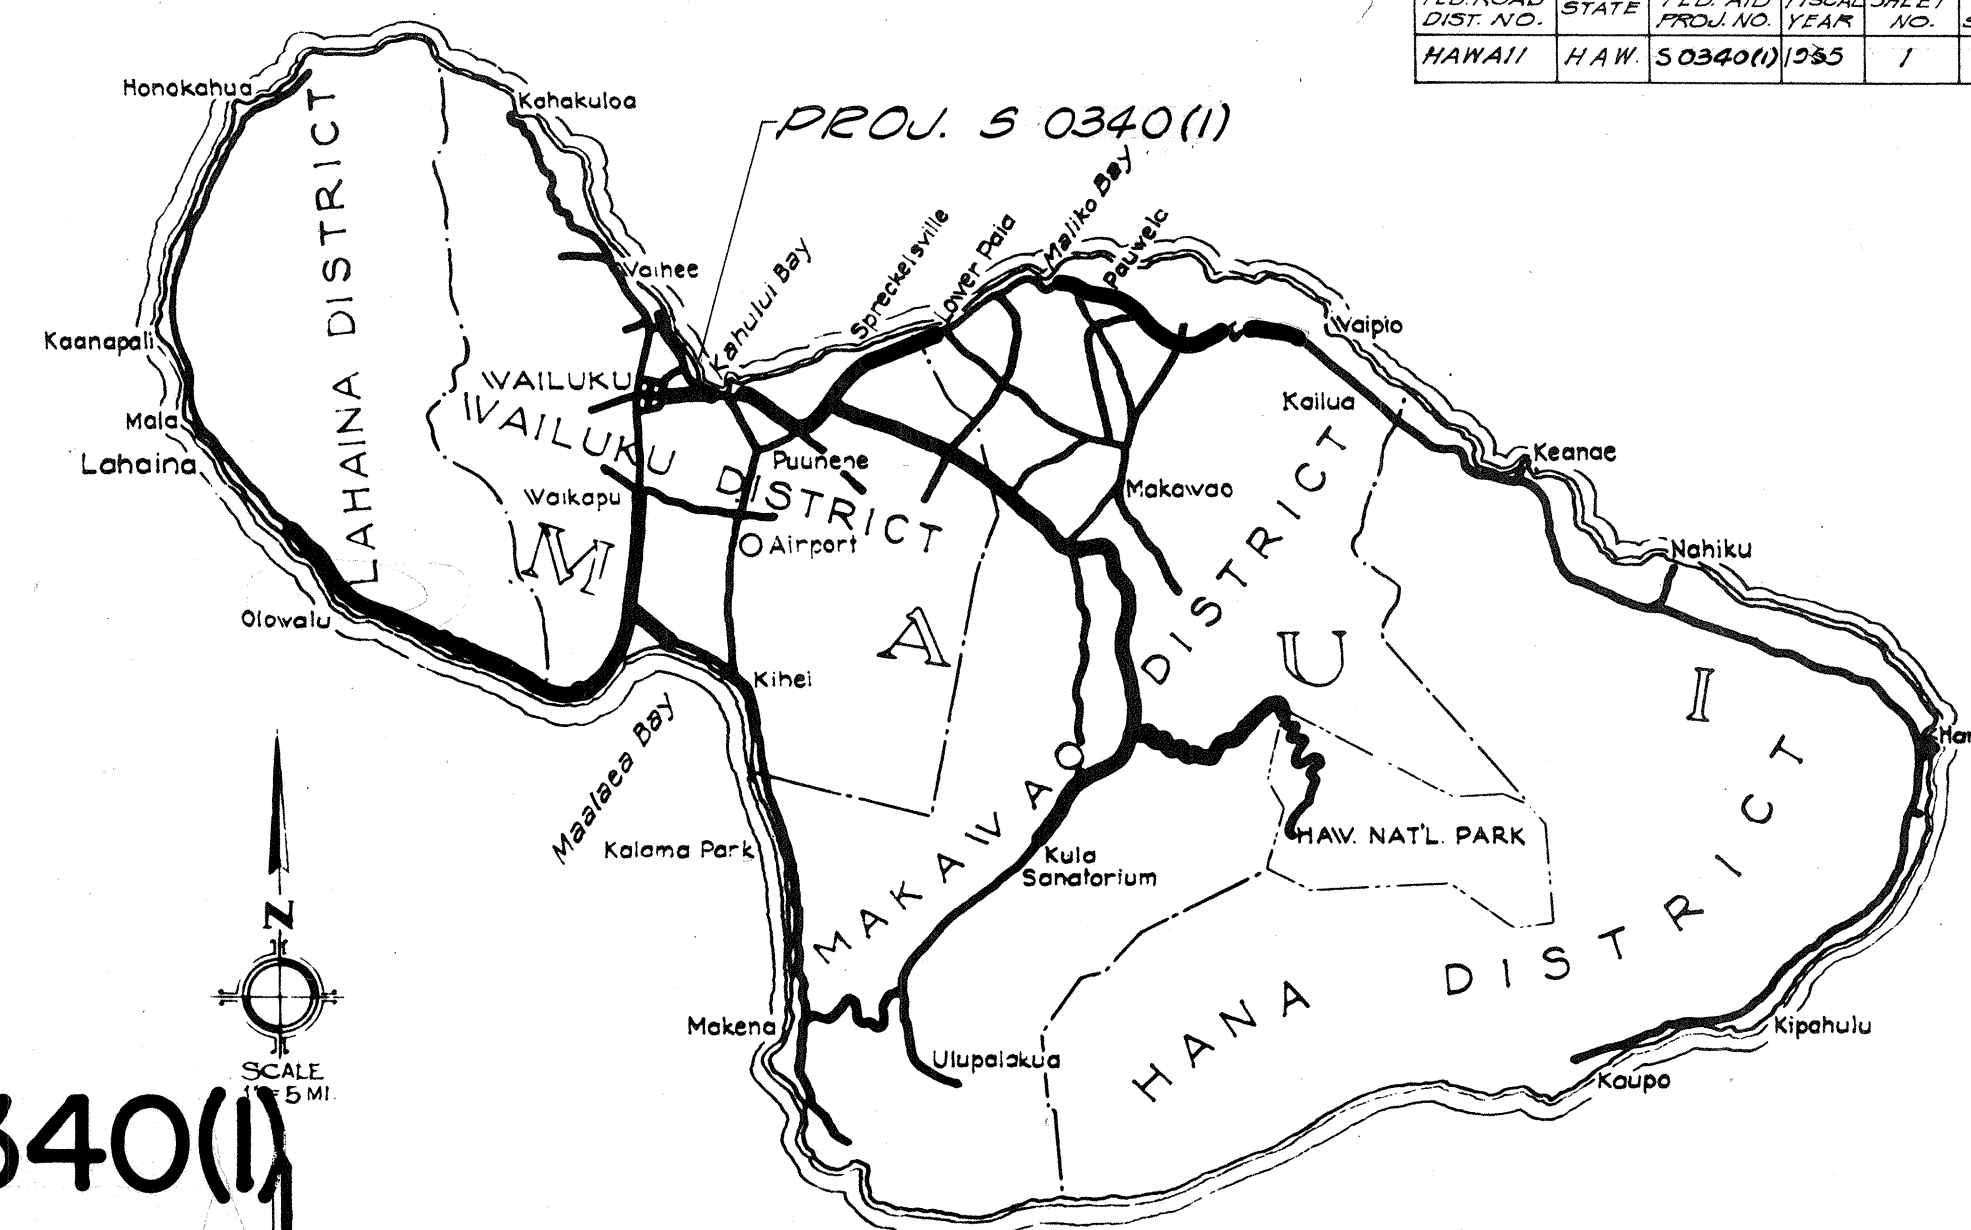

LOCATION MAP

Federal Aid Projects previously constructed or under construction.

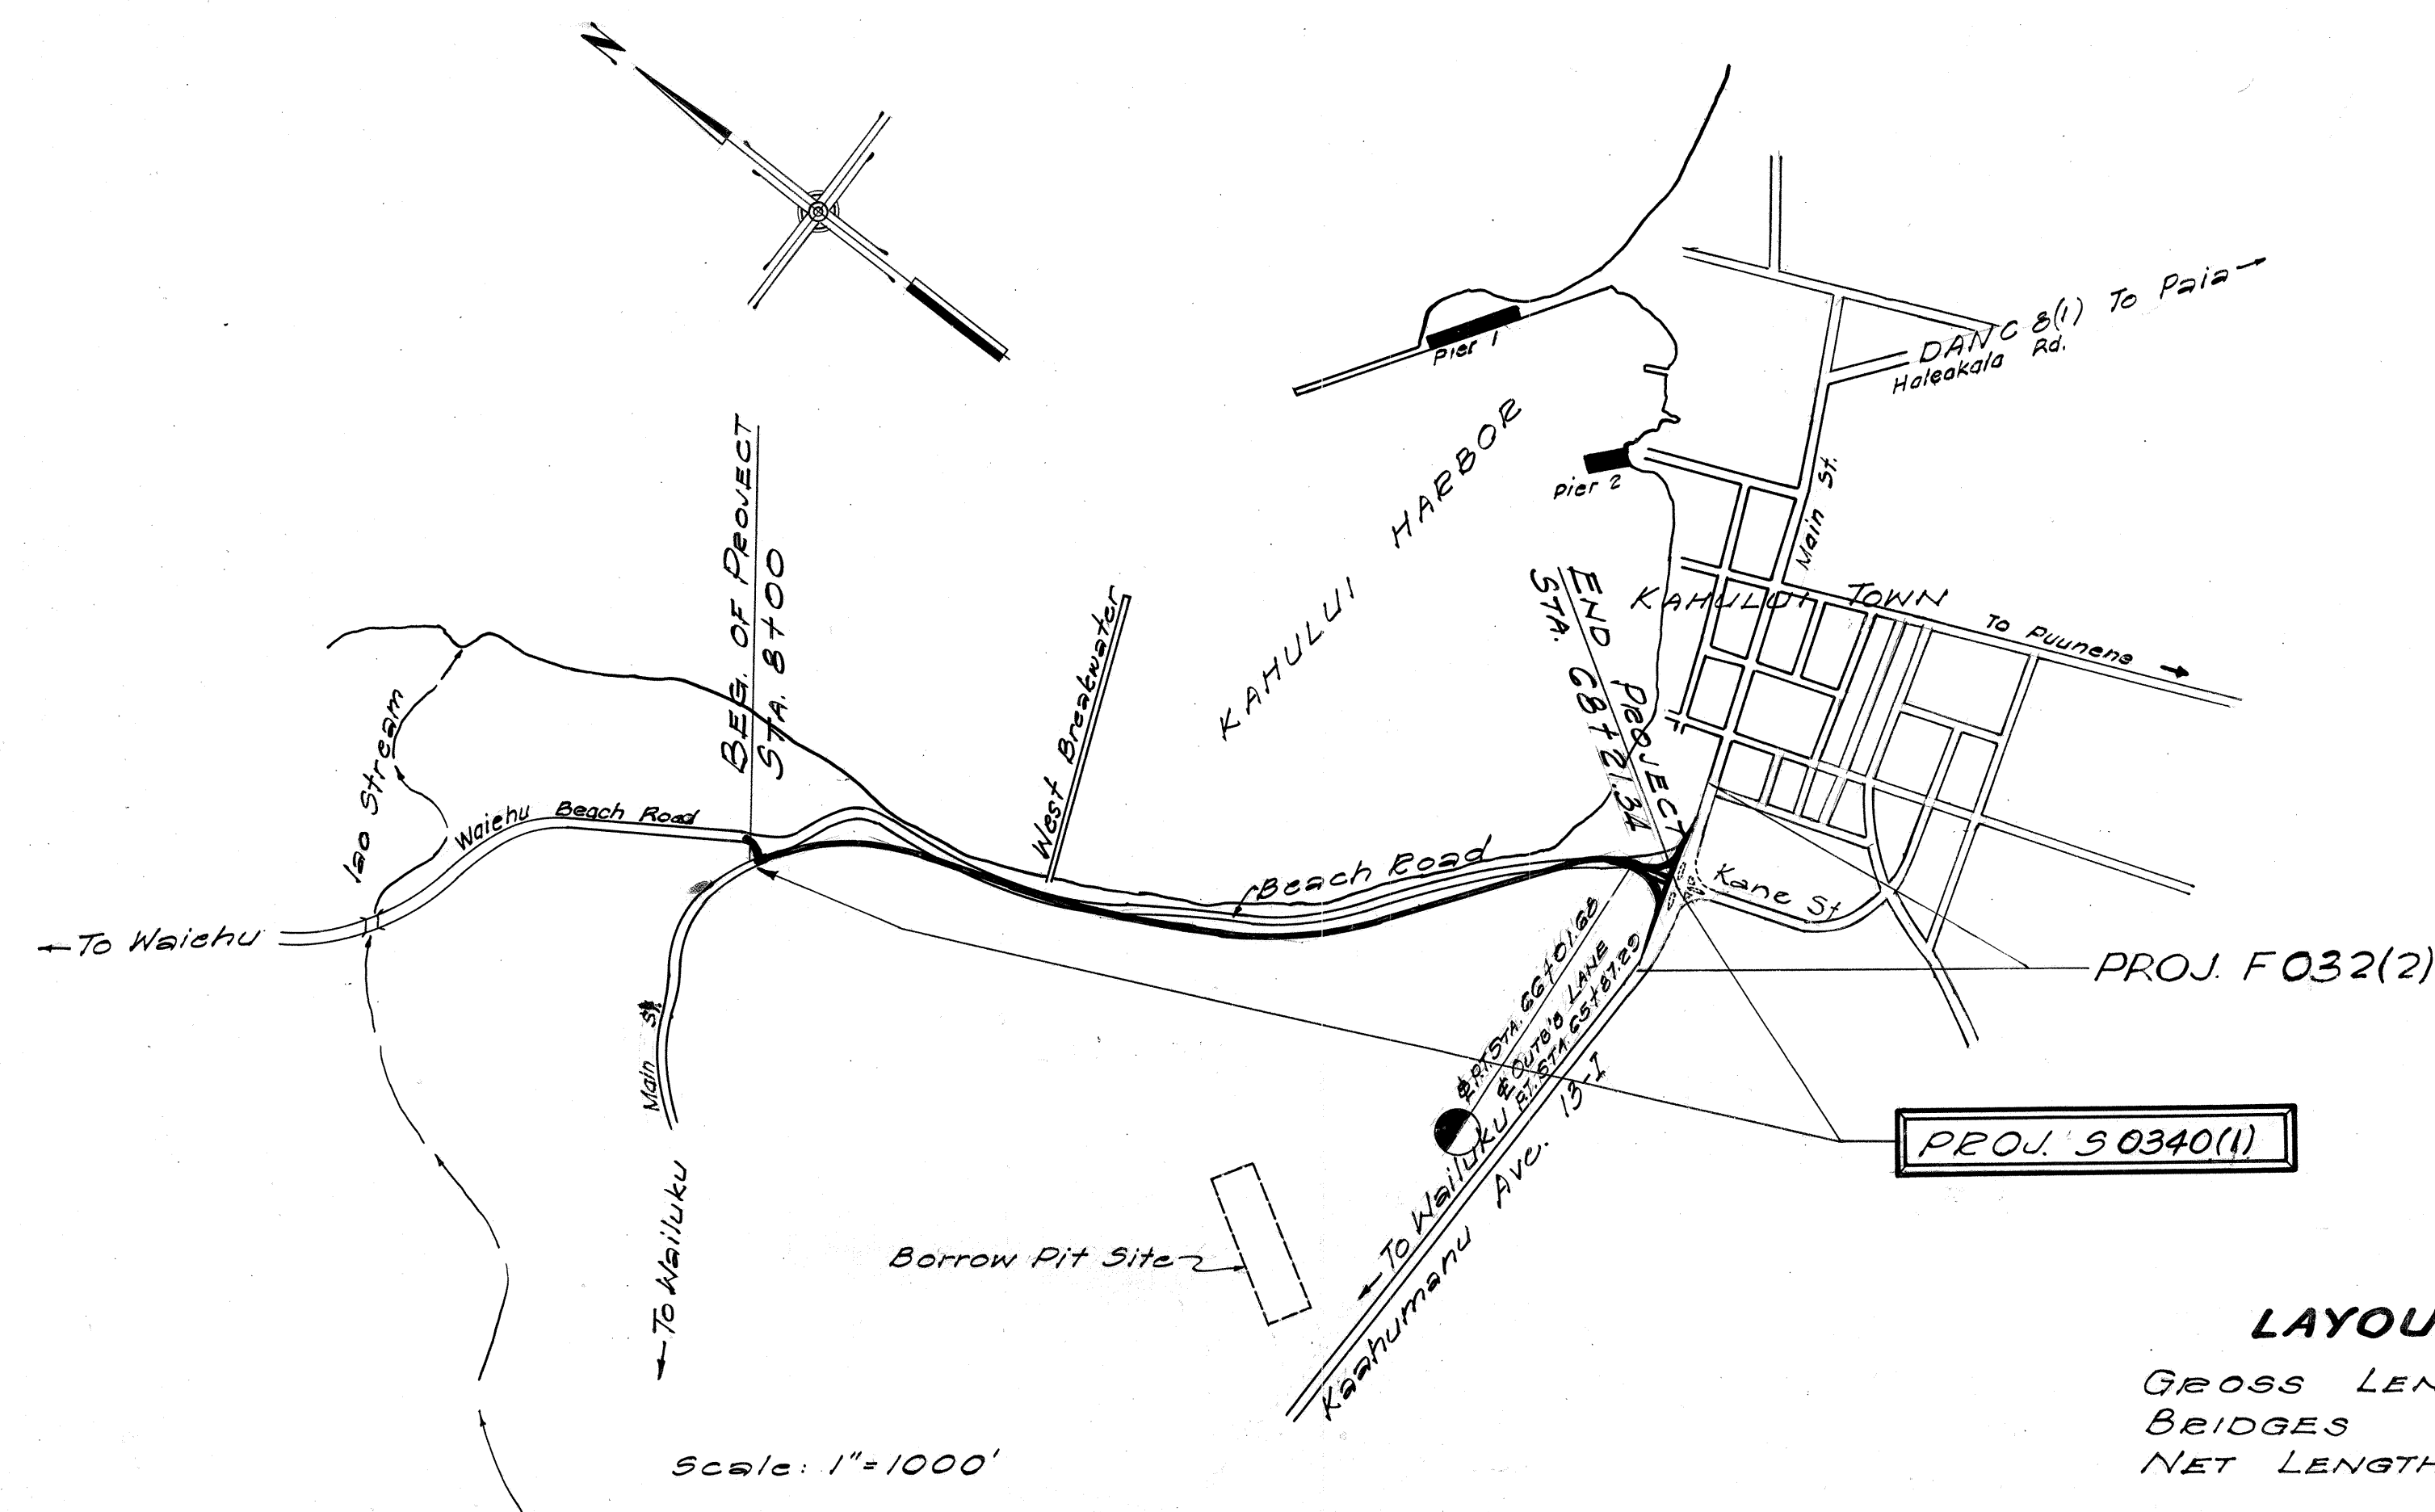

NOTE:

ALL CHANGES MADE DURING CONSTRUCTION
HAVE BEEN NOTED IN RED ON THESE
TRACINGS AND CHECKED BY:

R. M. O'Brien
DISTRICT ENGINEER

1/23/57
DATE

APPROVED: *B. E. Nutter*
TERRITORIAL HIGHWAY ENGINEER

DEPARTMENT OF COMMERCE
BUREAU OF PUBLIC ROADS
APPROVED: _____
DISTRICT ENGINEER DATE

LAYOUT OF PROJECT

GROSS LENGTH OF PROJECT = 1.143 mi.
BRIDGES = 0
NET LENGTH OF PROJECT = 1.143 mi.