





R-18 E

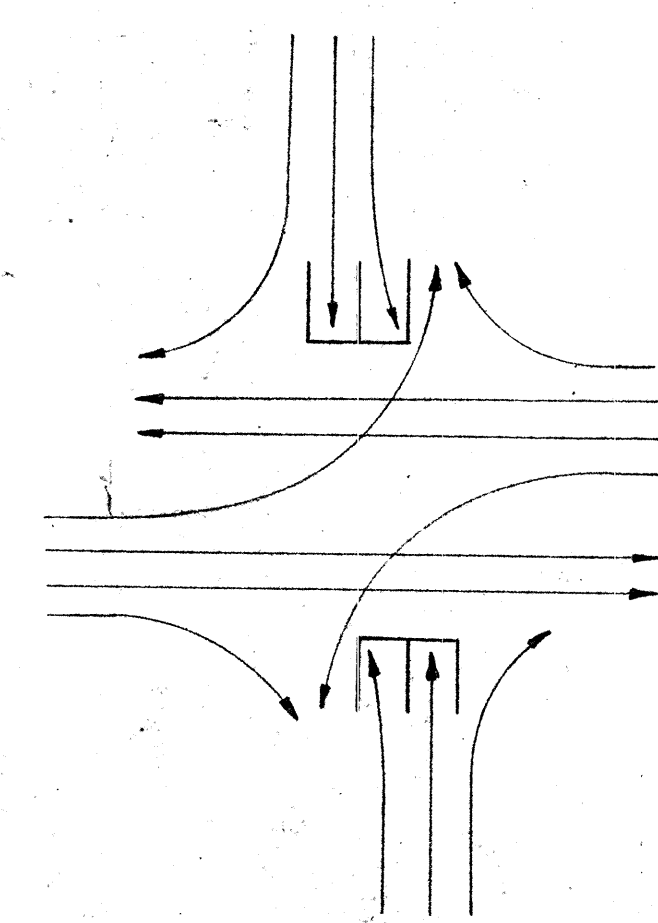

PHASE I

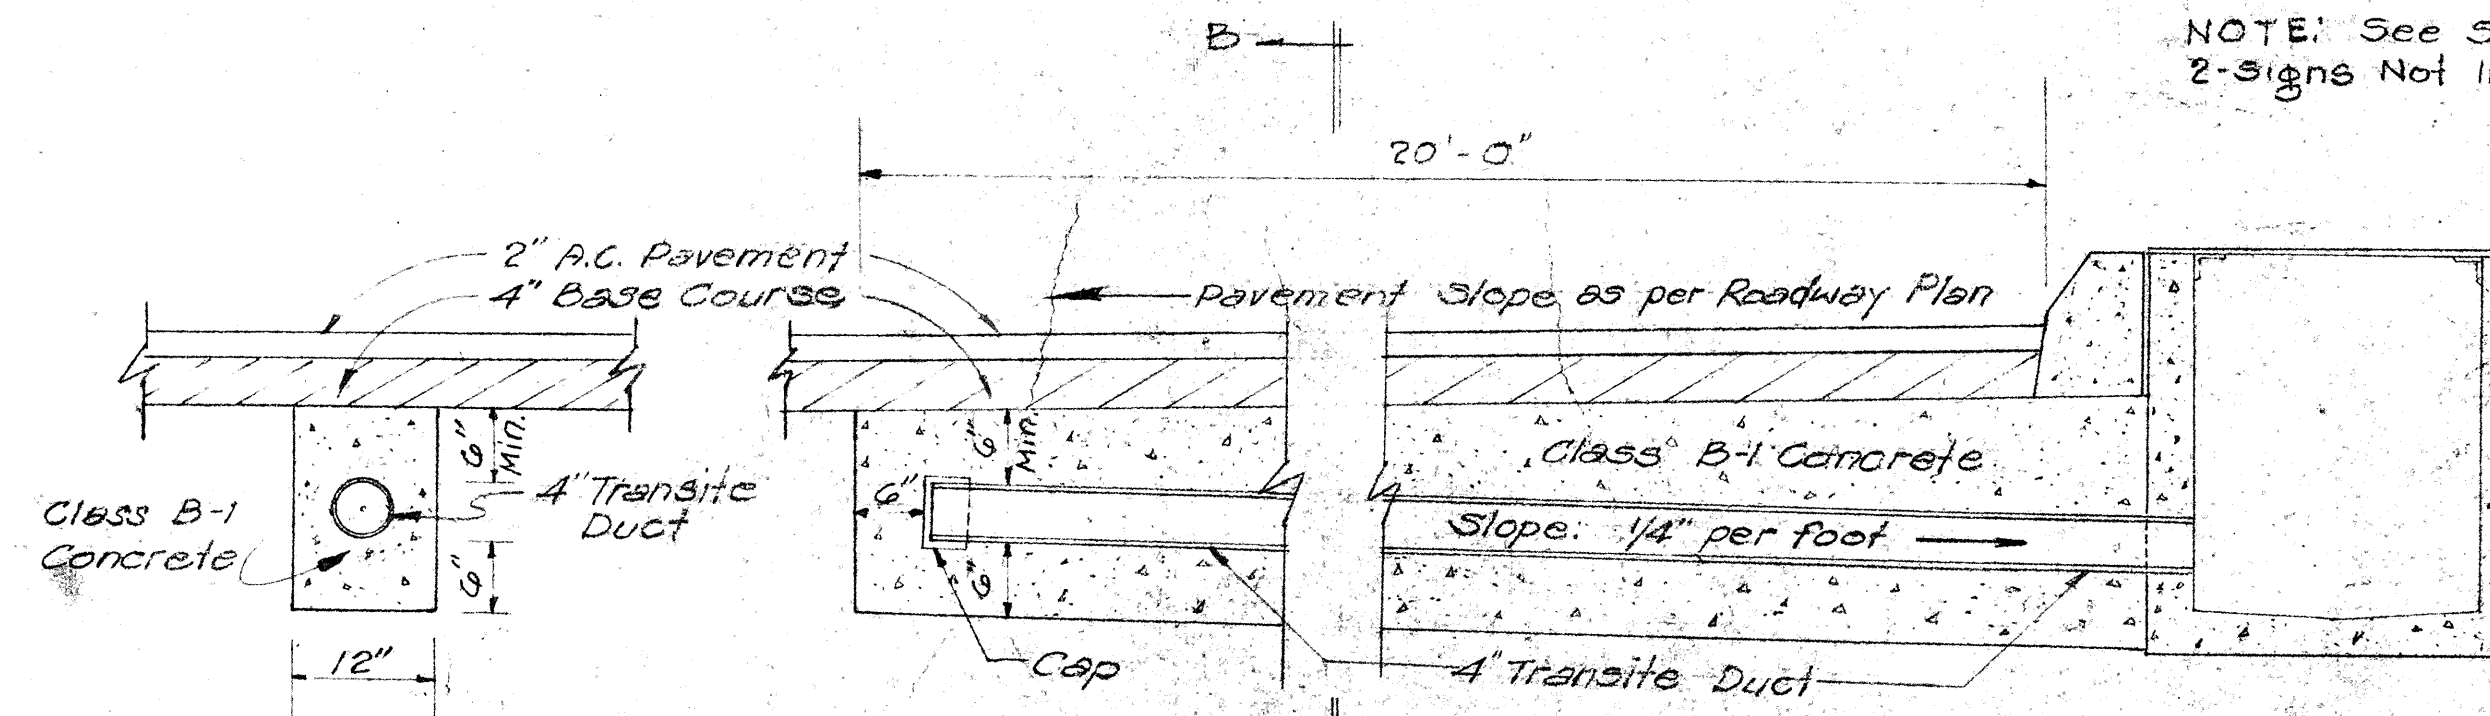

Scale: $\frac{3}{4}" = 1' - 0"$

Scale: $\frac{3}{4}" = 1' - 0"$

NOTE: See Sheet No. 5748.12 for
2-signs Not Included In This Schedule.

004501