



STATE OF HAWAII  
DEPARTMENT OF TRANSPORTATION  
HIGHWAYS DIVISION  
"AS BUILT" PLANS OF  
CONSTRUCTION OF ROCK REVETMENT  
ALONG KAHULUI BEACH  
PROJECT NO. 340A-01-67

DISTRICT OF WAILUKU  
ISLAND OF MAUI

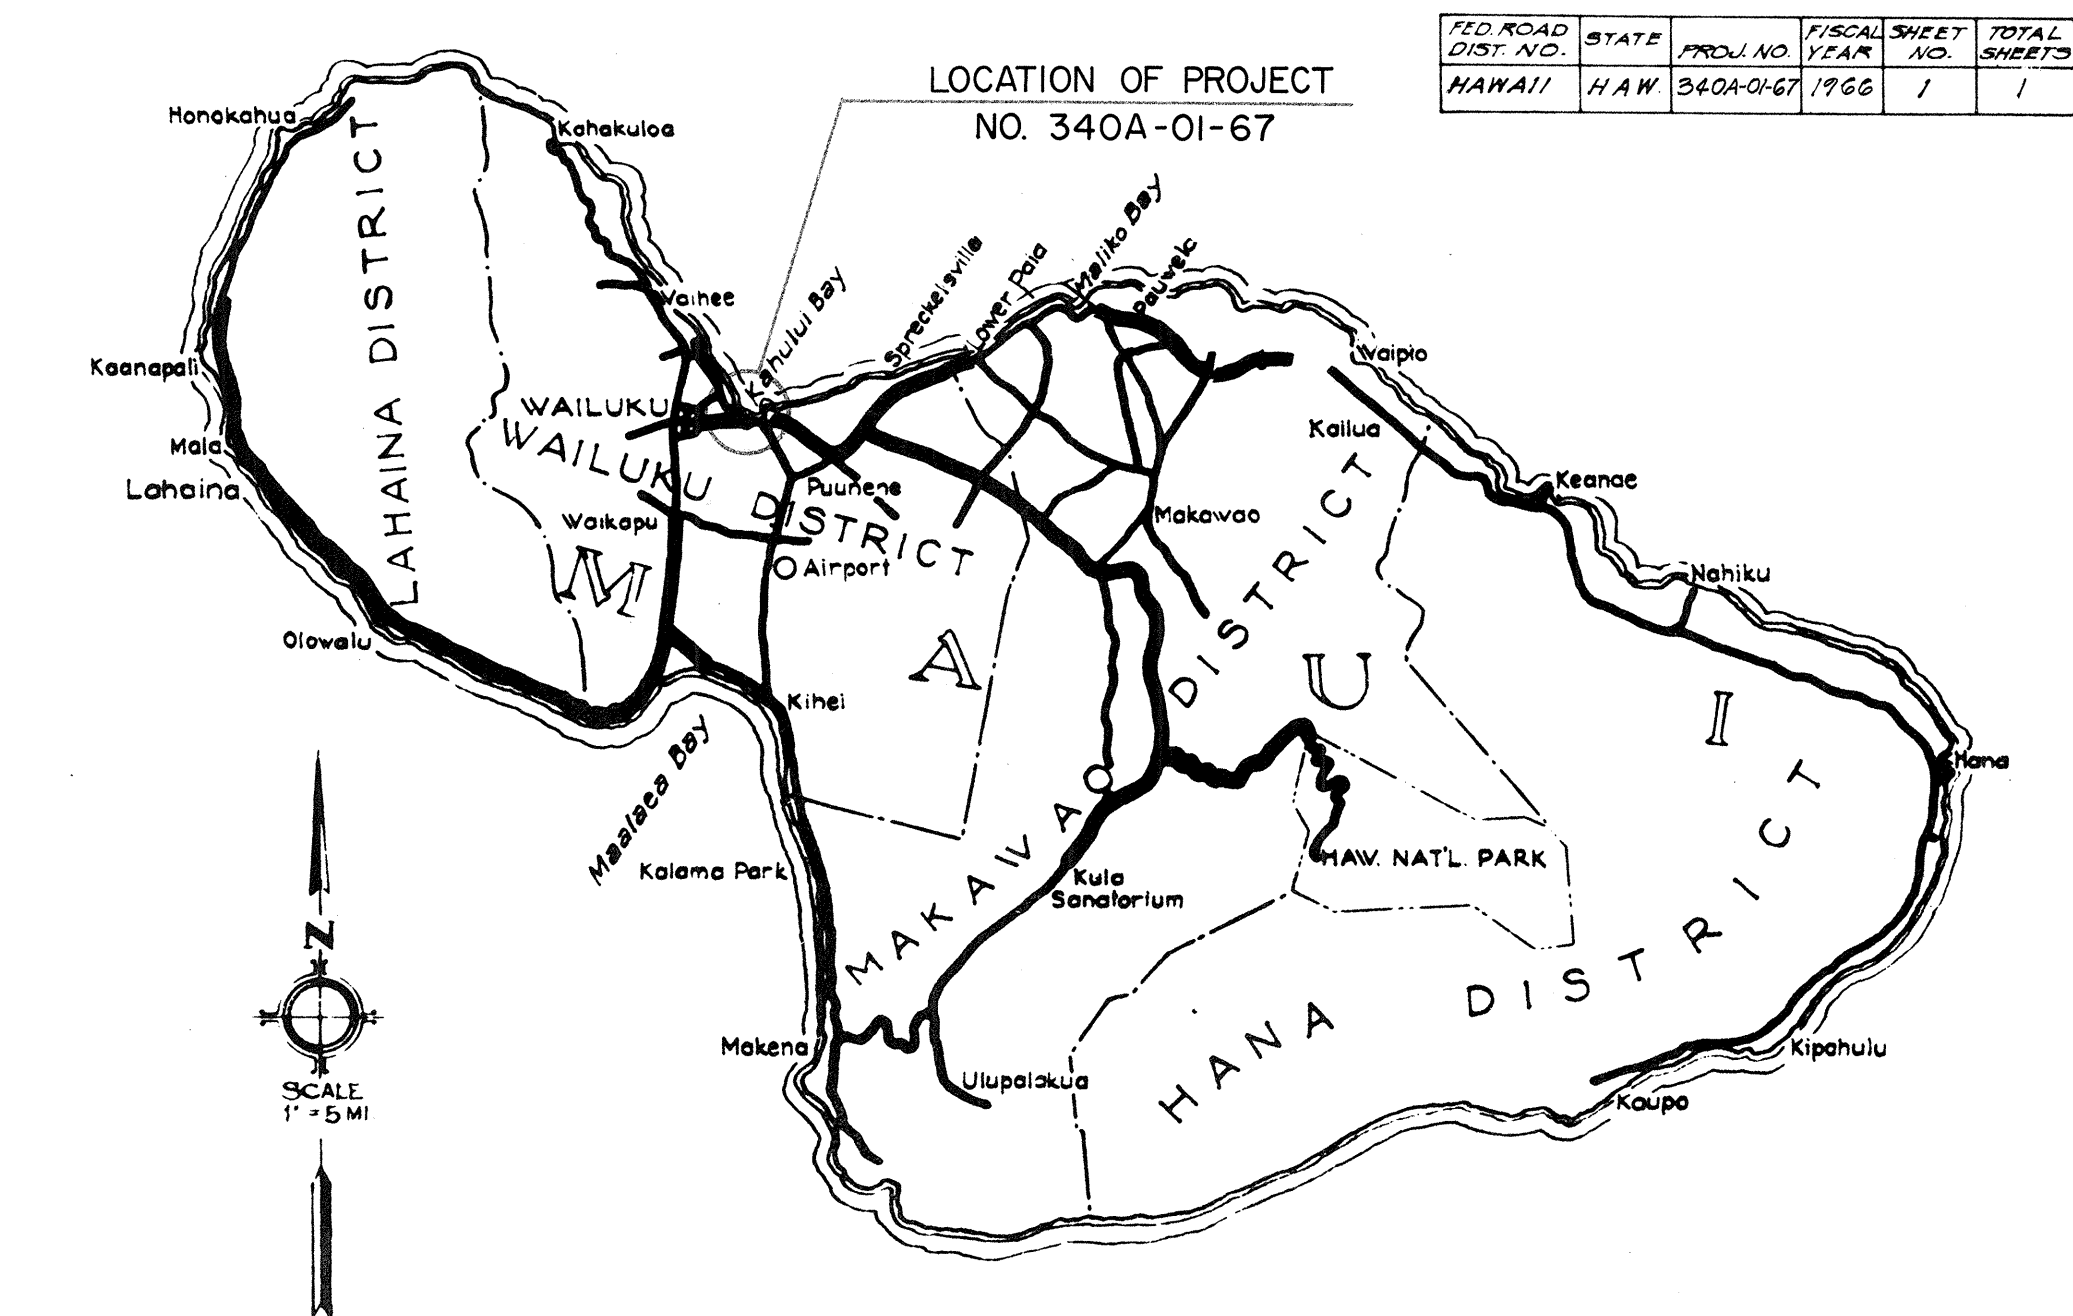

LOCATION MAP

Federal Aid Projects previously constructed or under construction.

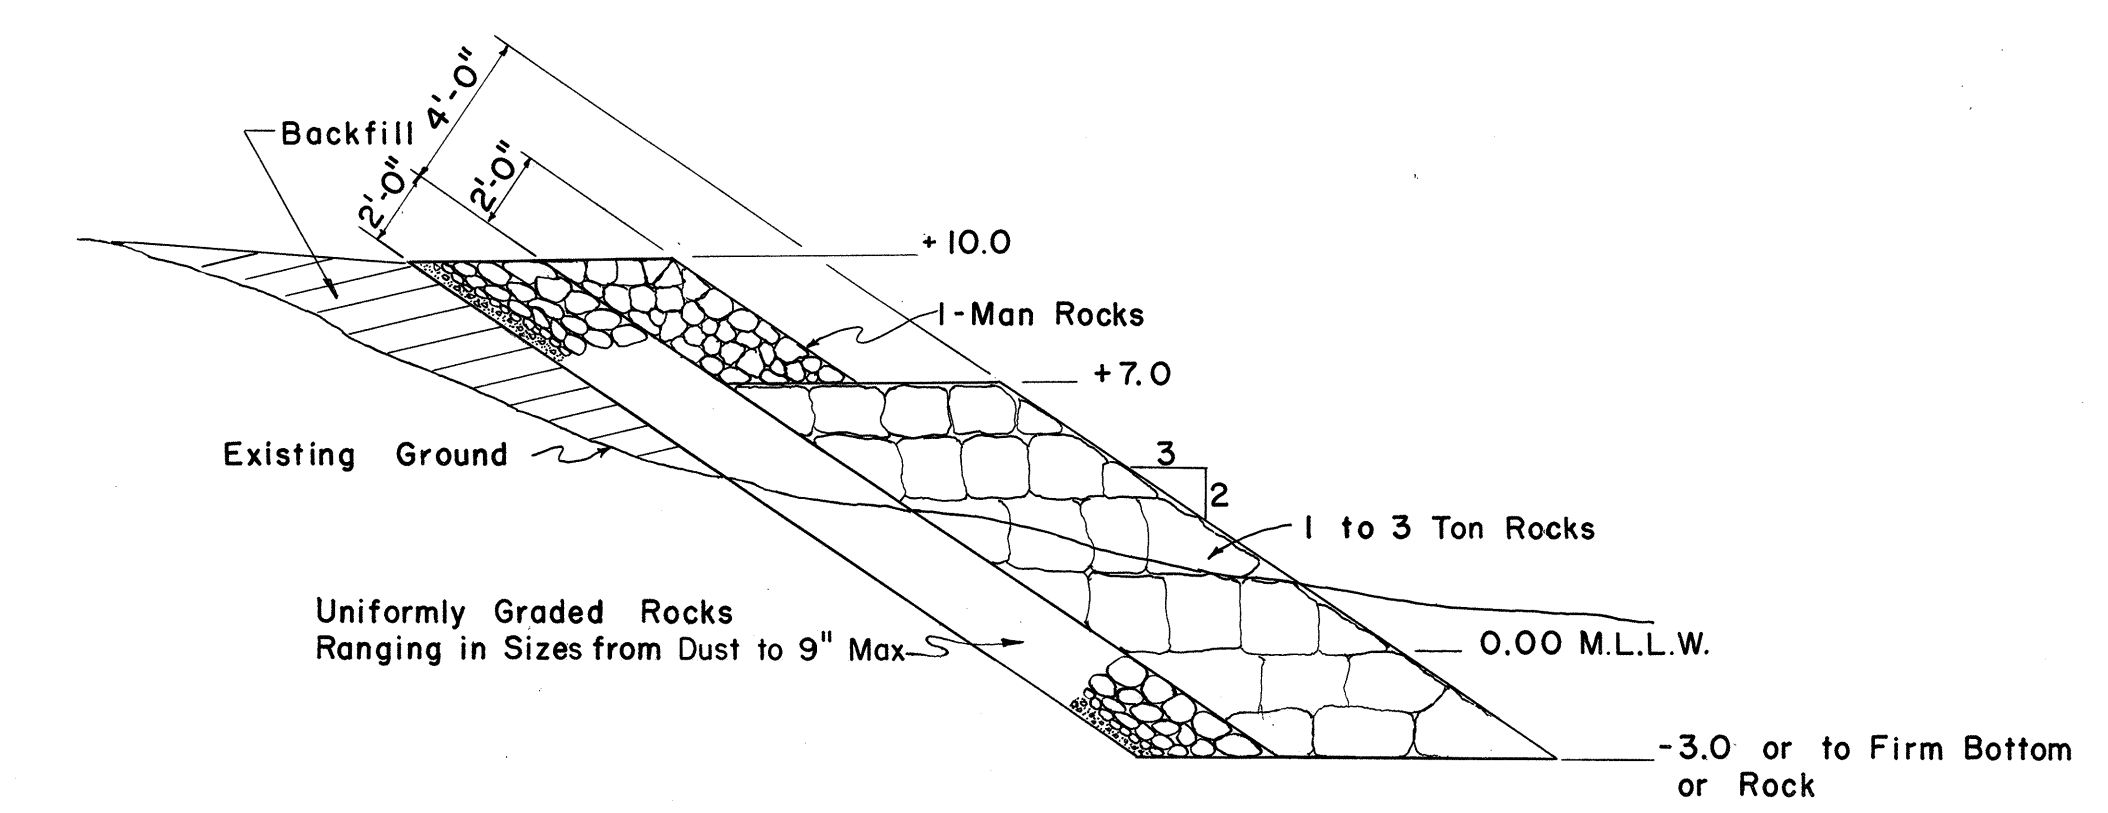

TYPICAL SECTION  
ROCK REVETMENT


Scale: 1" = 5'

NOTE:

ALL CHANGES MADE DURING CONSTRUCTION  
HAVE BEEN NOTED IN RED ON THESE  
TRACINGS AND CHECKED BY:

*Stanley S. Gosh*  
PROJECT ENGINEER  
11-3-67  
DATE

*John K. Lee*  
DIRECTOR OF TRANSPORTATION  
11-10-67  
DATE

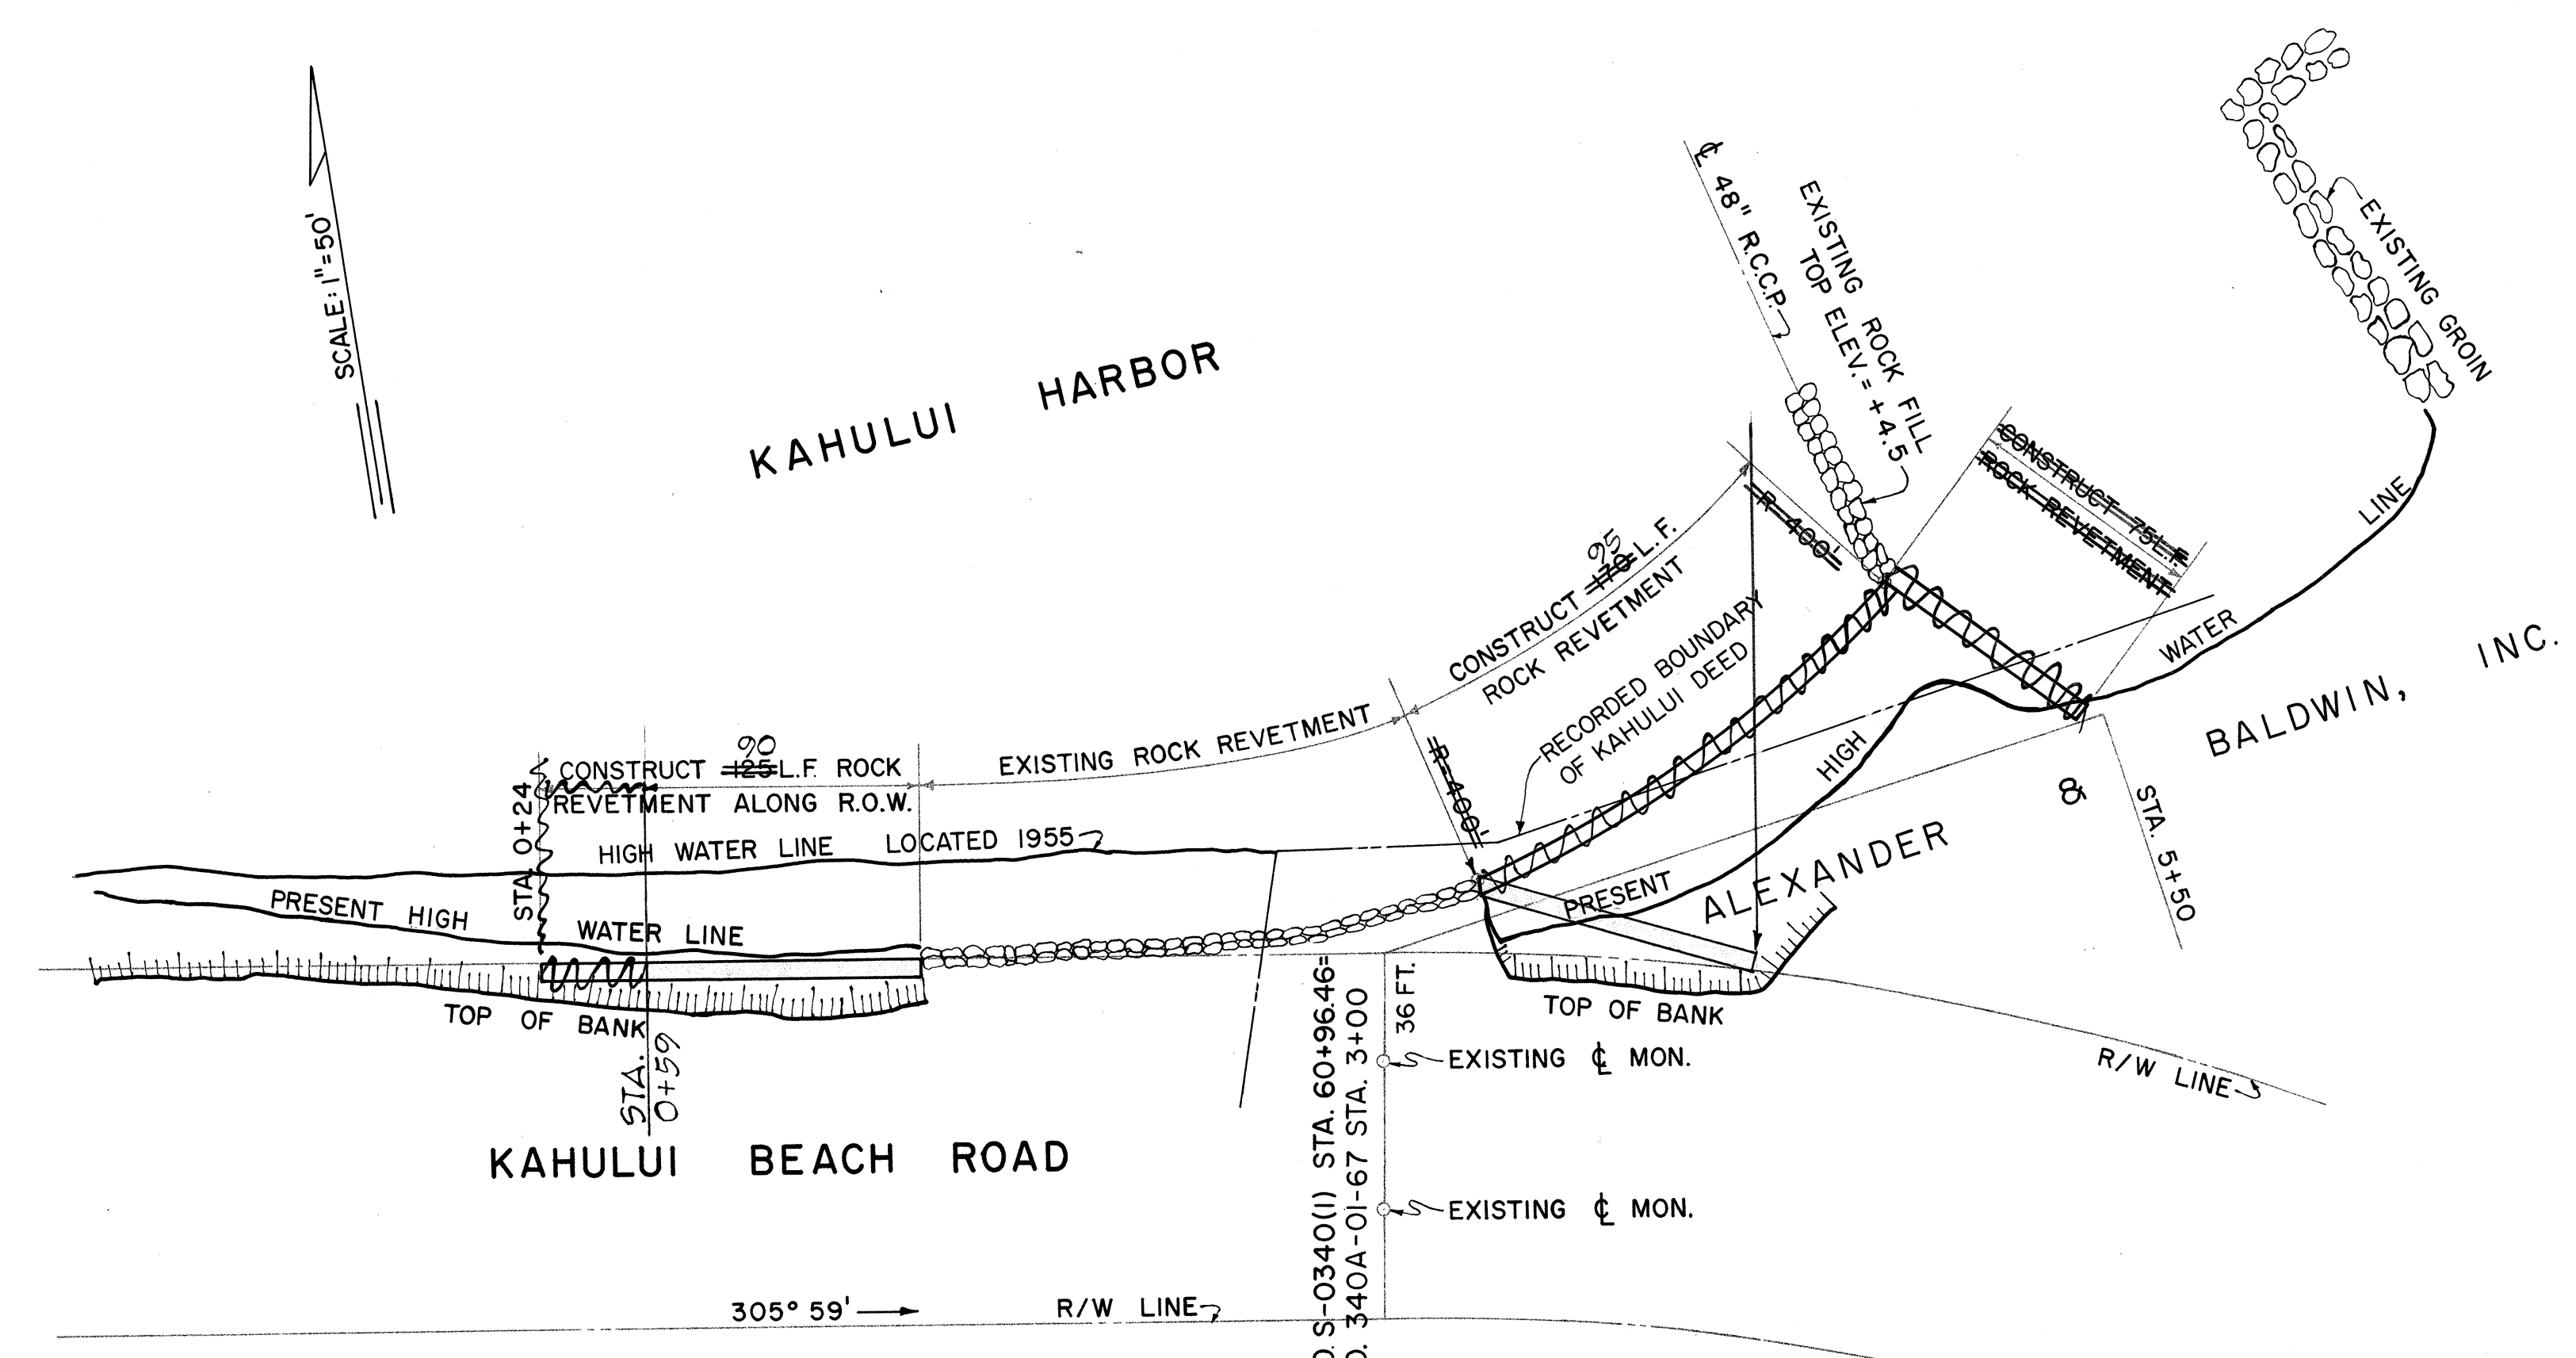

LAYOUT PLAN

NOTE: All elevation referred to  
mean low low water. Areas in  
back of new revetments to be filled  
with material approved by the  
Engineer.

DESIGNED BY: A. MARUTANI  
CHECKED BY: J. K. LEE  
DATE: AUG. '66