

FED. ROAD DIST. NO.	STATE	PROJ. NO.	FISCAL YEAR	SHEET NO.	TOTAL SHEETS
HAWAII	HAW.	3400AB0179M	1979	3	14

Notes:

1. Pavement on the bridge to be slurry sealed.
2. Scarification and removal of existing pavement will be considered incidental to new A.C. Pavement.

Scarify & remove exist'g pavement. Replace with new A.C. pavement to meet exist'g. bridge grade. No paving on bridge.

4" Double Yellow
Stripe & Transverse
Lines w/Type "H"
Markers @ 20'-0"
o.c. (Flush Median
Island.)

LEGEND

 Feather A.C. Pavement

Reg. of Proj.
No. 3400AB-01-79M
Sta. 0+00

True North
Scale: 1"=50'

4 ea. Type "J"
Markers

-Type "D" Markers

4" Double Yellow
Stripe w/Type "D"
Markers at 20'-0" o.c.

- Water valve covers to be raised

True North
Scale: 1" = 50

Channelizing Island

4" White
Guide Line

Water valve cover
to be raised

4" White Guide Line

- 4" Double yellow
Stripe w/ Type D
Markers @ 20' O.C.

4" Double Yellow
Stripe w/Type "D"
Markers @ 20'-0" o.c.

STATE OF HAWAII
DEPARTMENT OF TRANSPORTATION
HIGHWAYS DIVISION

PLAN

RESURFACING KAHULUI AND WAIHEHU BEACH ROADS


Kaahumanu Avenue To
Paukukalo (Hawaiian Homes)
PROJECT NO. 3400AB-01-79M

Scale: 1" = 50' Date: July, 1978


SHEET No. 1 OF 4 SHEETS

3

ORIGINAL PLAN	SURVEY PLOTTED BY _____ DATE _____	
	DRAWN BY _____	" "
	TRACED BY _____	" "
NOTE BOOK	DESIGNED BY _____	" "
	QUANTITIES BY _____	" "
No. _____	CHECKED BY _____	" "

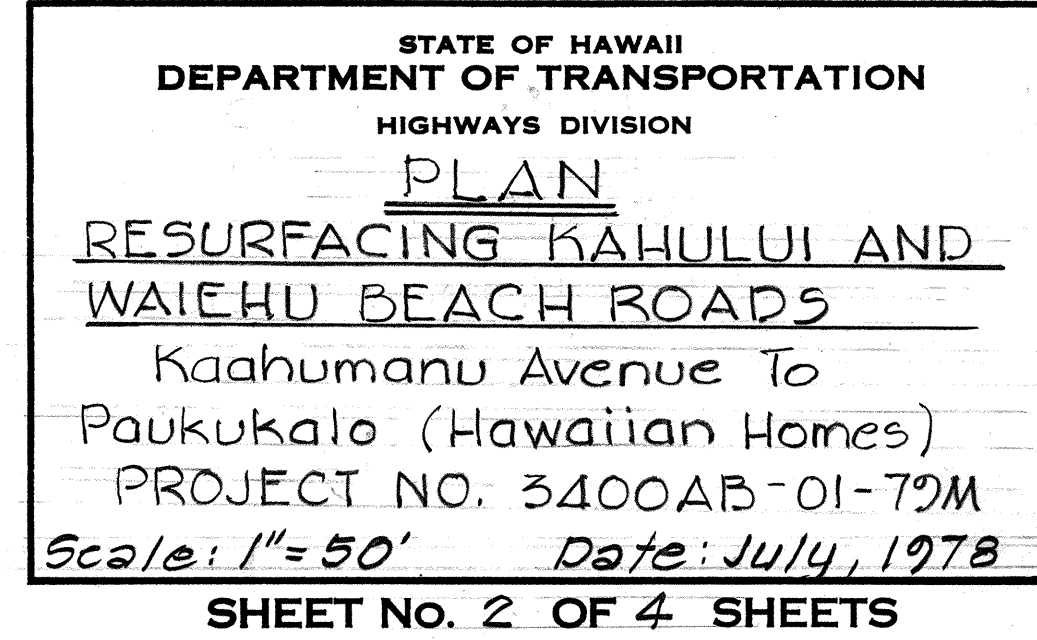

FED. ROAD DIST. NO.	STATE.	PROJ. NO.	FISCAL YEAR	SHEET NO.	TOTAL SHEETS
HAWAII	HAW.	3400AB-01-79M	1979	5	14

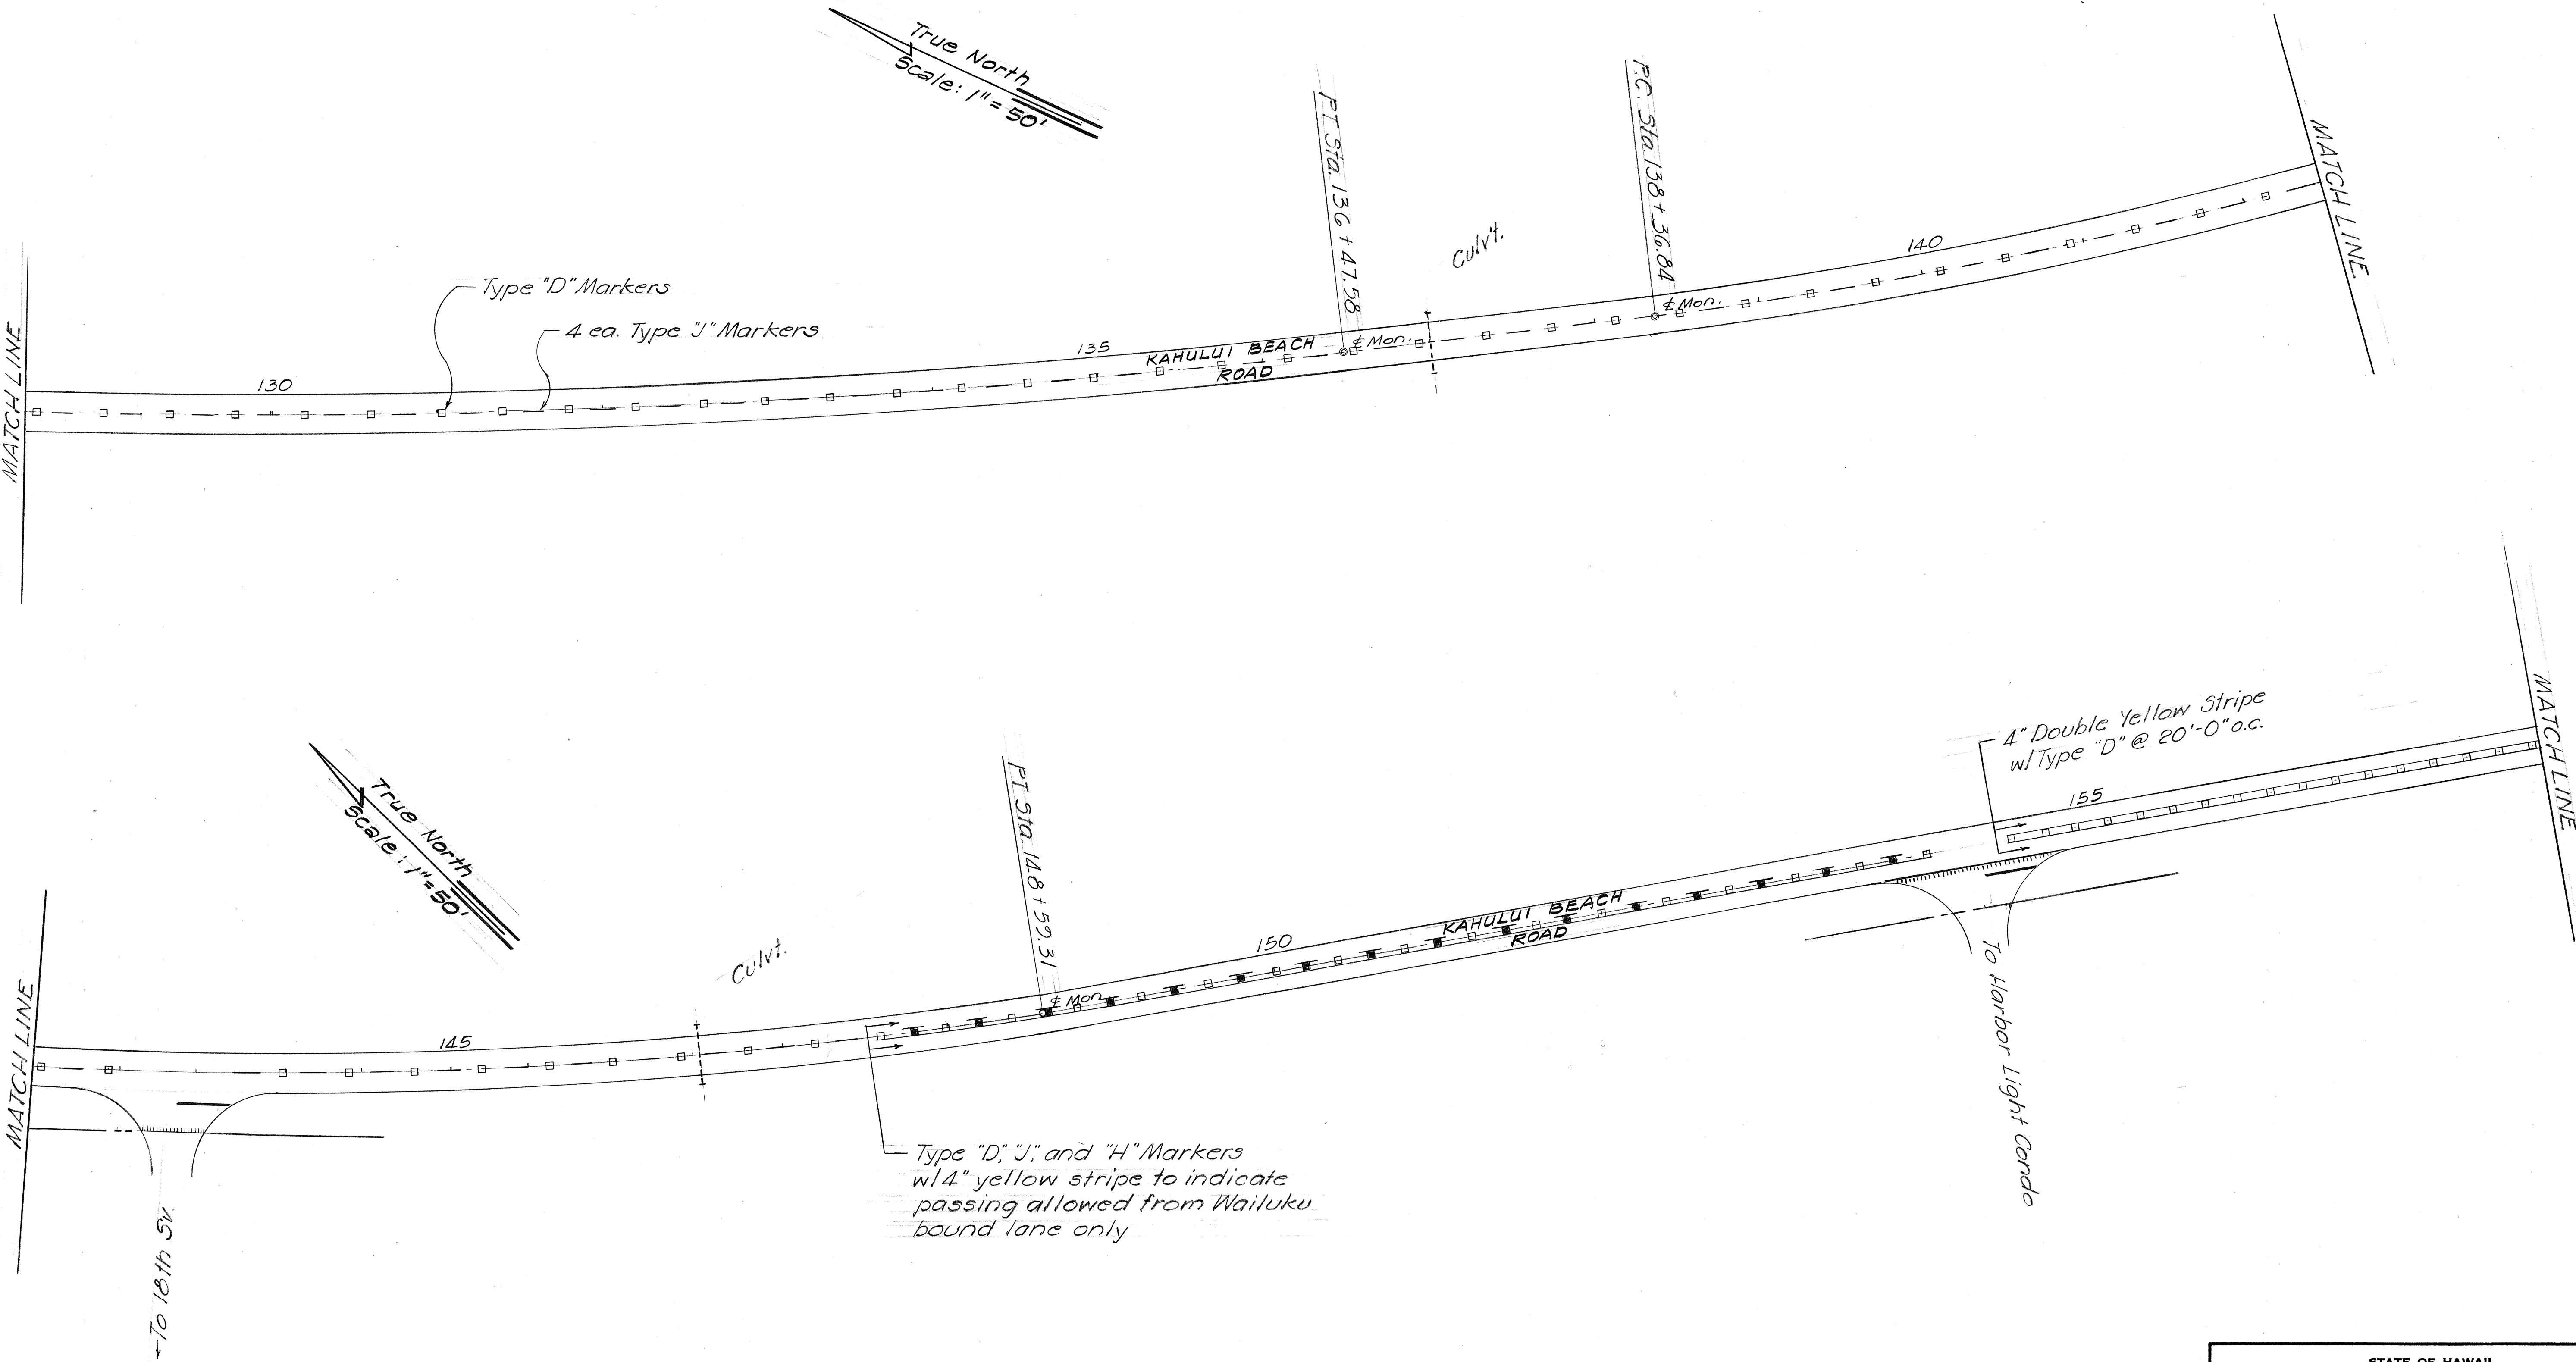


ORIGINAL PLAN	DATE
DESIGNED BY	
NOTED BY	
CHECKED BY	
NO.	

STATE OF HAWAII
DEPARTMENT OF TRANSPORTATION
HIGHWAYS DIVISION

PLAN
RESURFACING KAHULUI AND
WAIHEHU BEACH ROADS
Kaaumanu Avenue To
Paukukalo (Hawaiian Homes)
PROJECT NO. 3400AB-01-79M
Scale: 1" = 50' Date: July, 1978
SHEET NO. 3 OF 4 SHEETS

FED. ROAD DIST. NO.	STATE	PROJ. NO.	FISCAL YEAR	SHEET NO.	TOTAL SHEETS
HAWAII	HAW.	3400AB-01-79M	1979	6	14

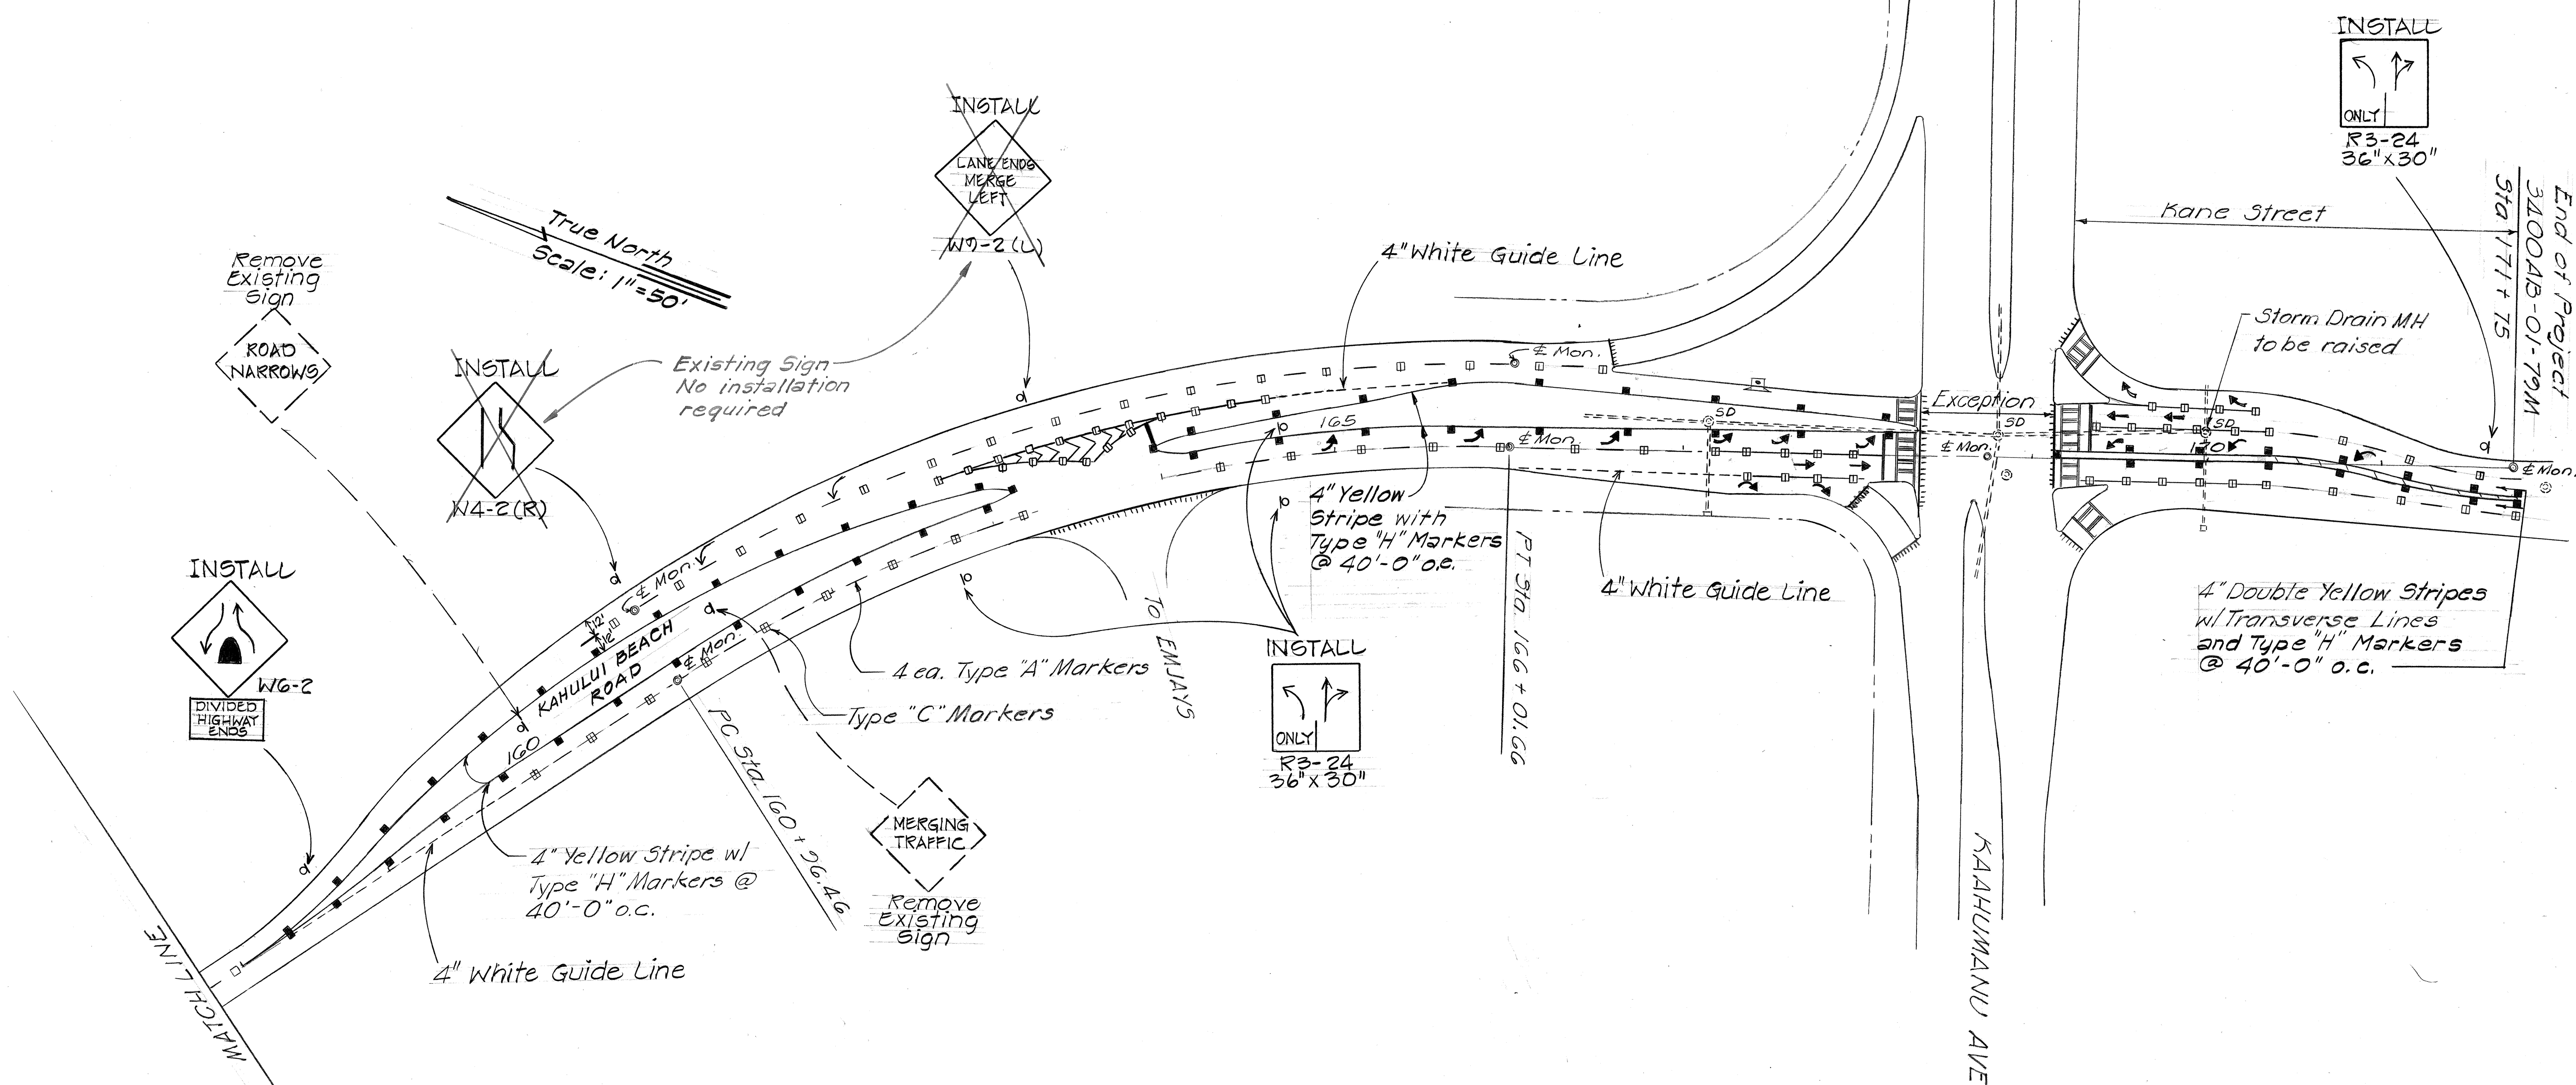

Note
 1. Signs R3-30 and R3-24 are variations of sign R3-8; Plate and arrow details shall conform to sign R3-8.

DATE	_____
SURVEY PLOTTED BY	_____
DESIGNED BY	_____
NOTED BY	_____
QUANTITIES BY	_____
CHECKED BY	_____
ORIGINAL PLAN No.	_____

STATE OF HAWAII
DEPARTMENT OF TRANSPORTATION
HIGHWAYS DIVISION

PLAN

RESURFACING KAHULUI AND
WAIERU BEACH ROADS

Kaahumanu Avenue To
Paukukalo (Hawaiian Homes)

PROJECT NO. 3400AB-01-79M

Scale: 1" = 50' Date: July, 1978

SHEET No. 4 OF 4 SHEETS