

INDEX TO DRAWINGS	
SHEET NO	DESCRIPTION
1	TITLE SHEET
2	TYPICAL SHEET
3 - 6	PLAN SHEETS
7 - 14	STANDARD DETAIL SHTS.

CONVENTIONAL SIGNS


STATE OF HAWAII
DEPARTMENT OF TRANSPORTATION
LAND TRANSPORTATION FACILITIES DIVISION
HONOLULU, HAWAII
"AS-BUILT"
PLANS FOR

RESURFACING KAHULUI AND WAIEHU BEACH ROADS
KAAHUMANU AVENUE TO PAUKUKALO (HAWAIIAN HOMES)
PROJECT NO. 3400AB-01-79M

SCALES

PLAN	1 IN. =	FT.
PROFILE	HOR. 1 IN. =	FT.
	VER. 1 IN. =	FT.
X-SECTIONS	HOR. 1 IN. =	FT.
	VER. 1 IN. =	FT.

DISTRICT OF WAILUKU
ISLAND OF MAUI

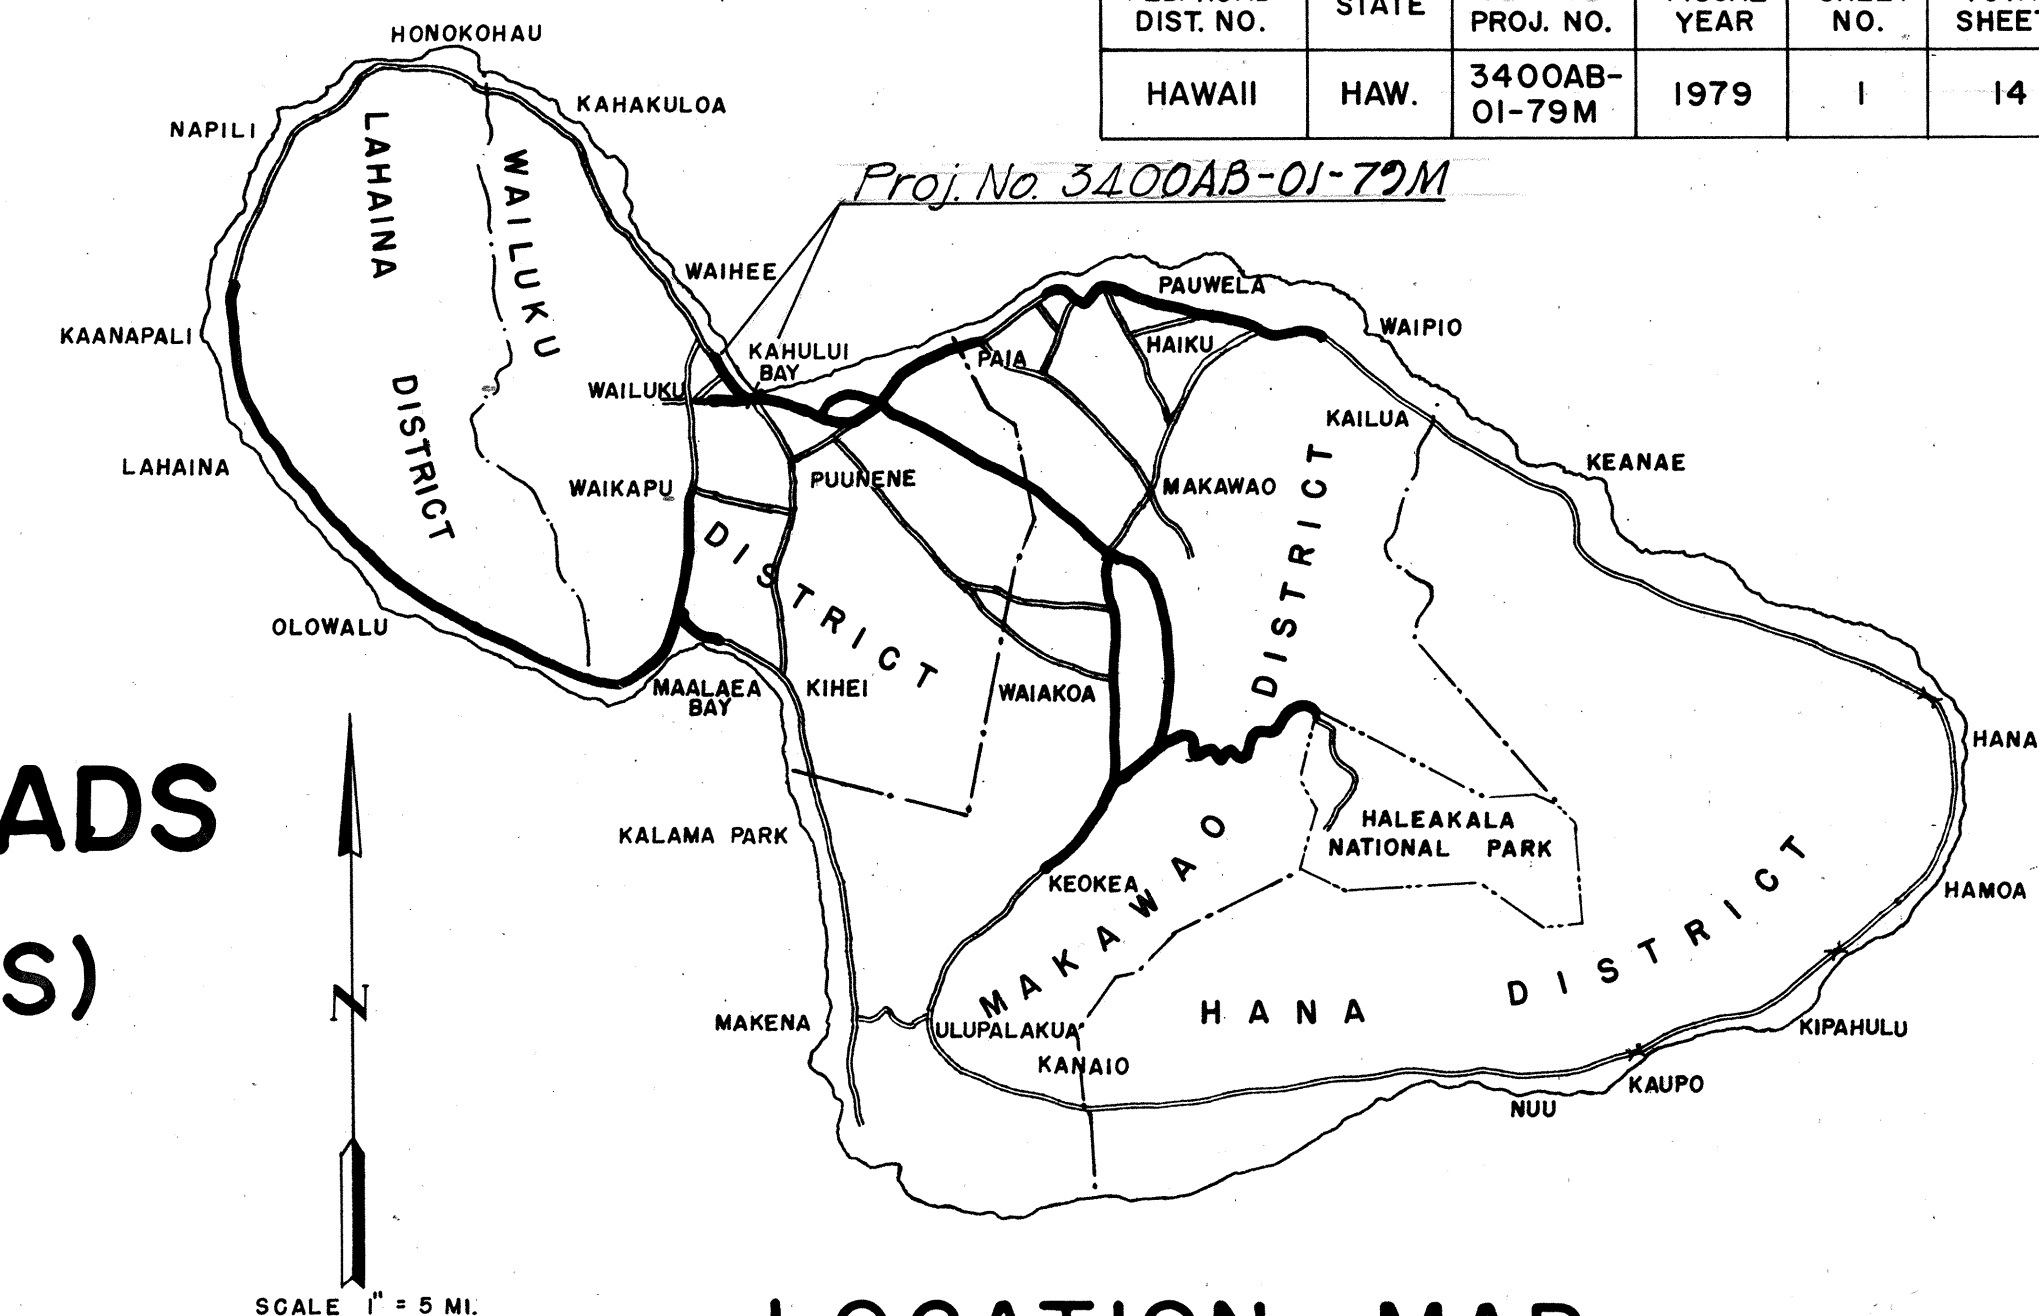

LOCATION MAP


— FEDERAL AID PROJECTS PREVIOUSLY CONSTRUCTED OR UNDER CONSTRUCTION

ALL CHANGES MADE DURING CONSTRUCTION
HAVE BEEN NOTED IN RED ON THESE TRACINGS
AND CHECKED BY

Donna J. Card
RESIDENT ENGINEER

5/3/79
DATE

Beg. of Proj.
No. 3400AB-01-79M

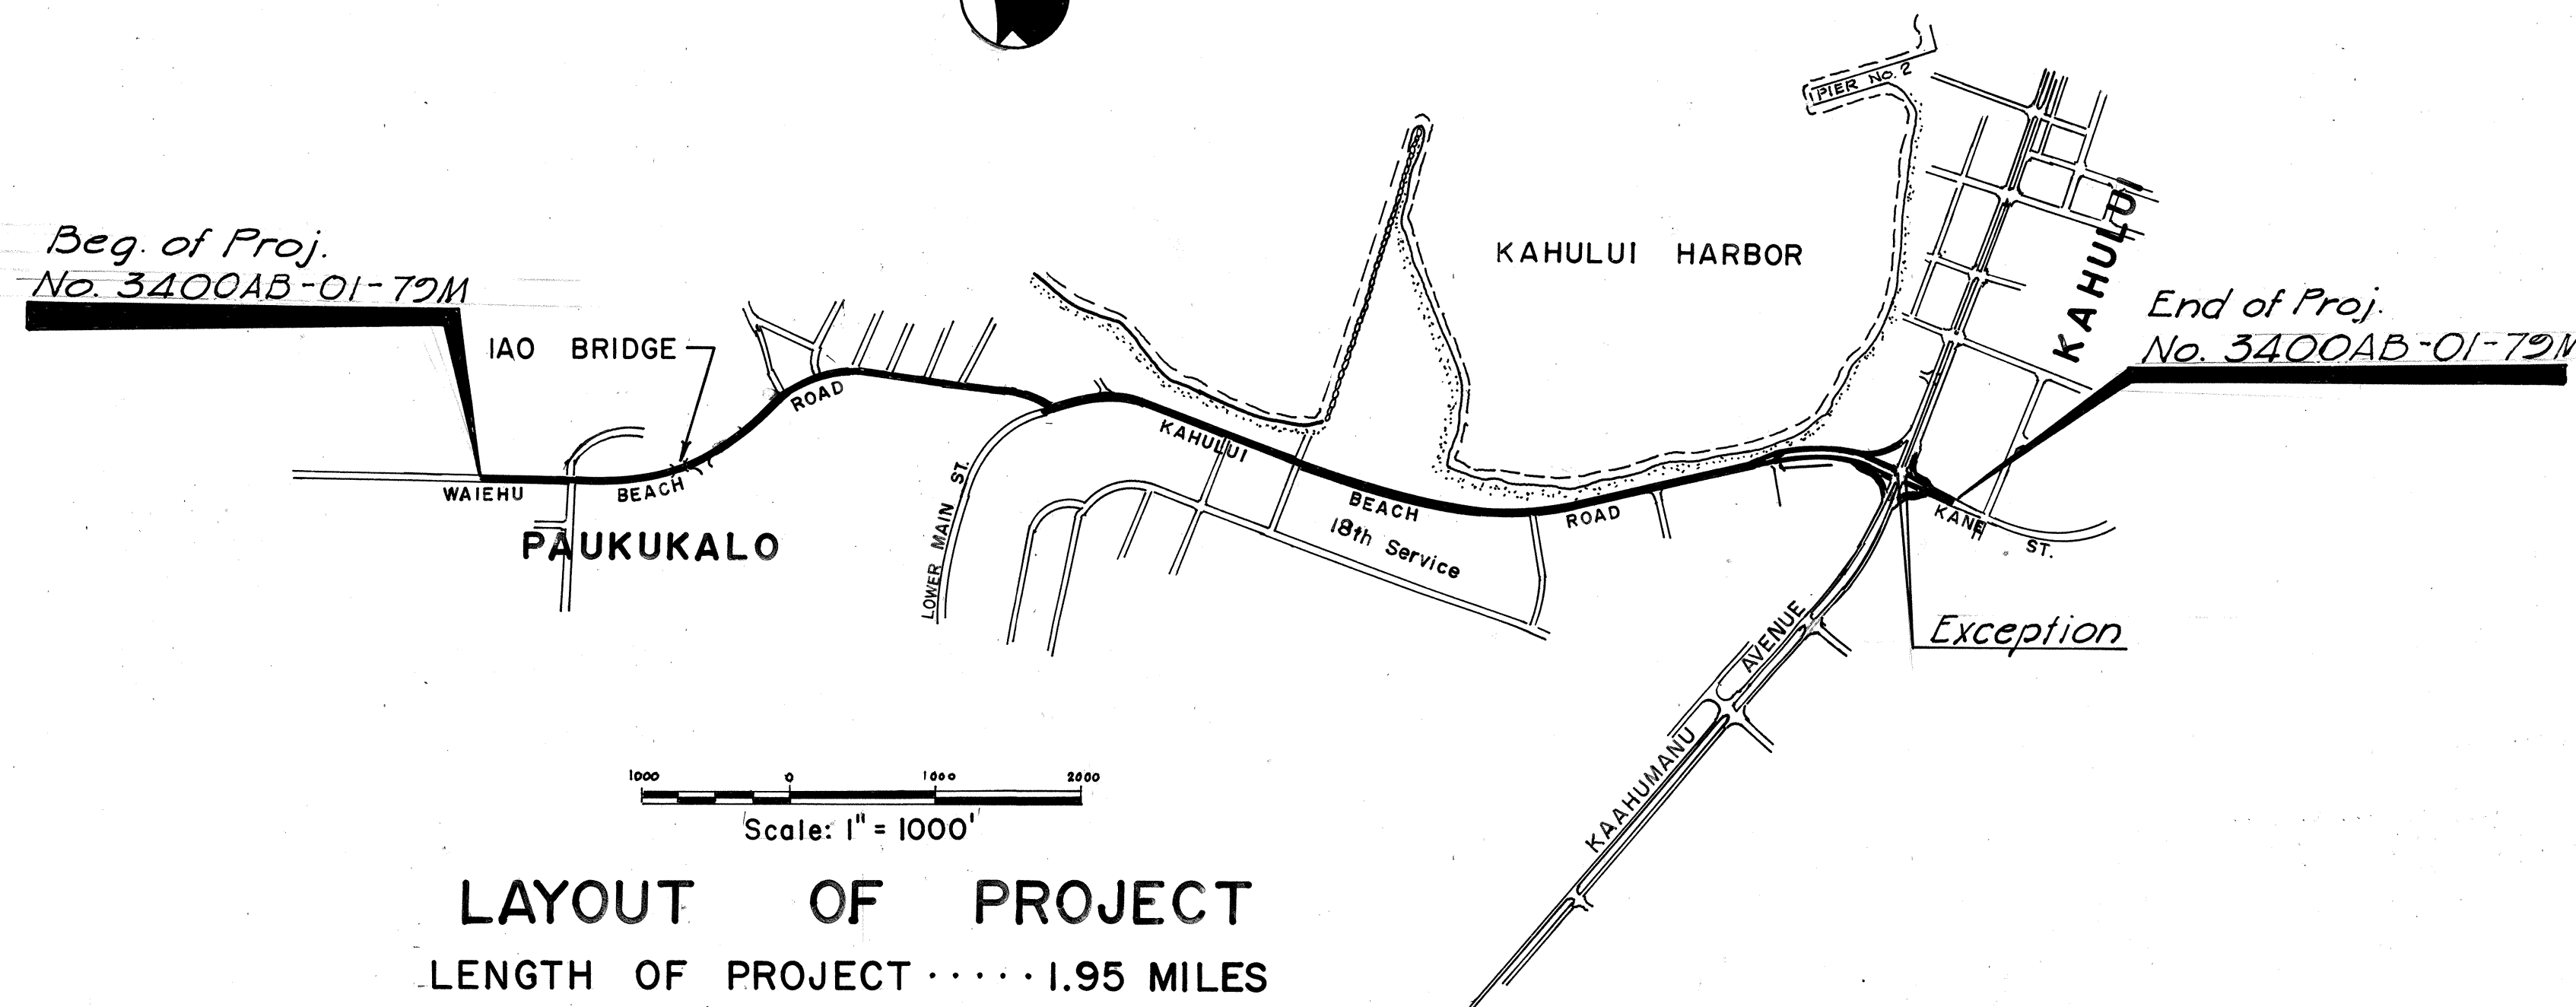

LAYOUT OF PROJECT
LENGTH OF PROJECT1.95 MILES

APPROVED: *Robert H. Higashionna*
DIRECTOR OF TRANSPORTATION

DATE August 7, 1978