


FED. ROAD DIST. NO.	STATE	FED. AID PROJ. NO.	FISCAL YEAR	SHEET NO.	TOTAL SHEETS
HAWAII	HAW.	M-3400(1)	1984	3	8

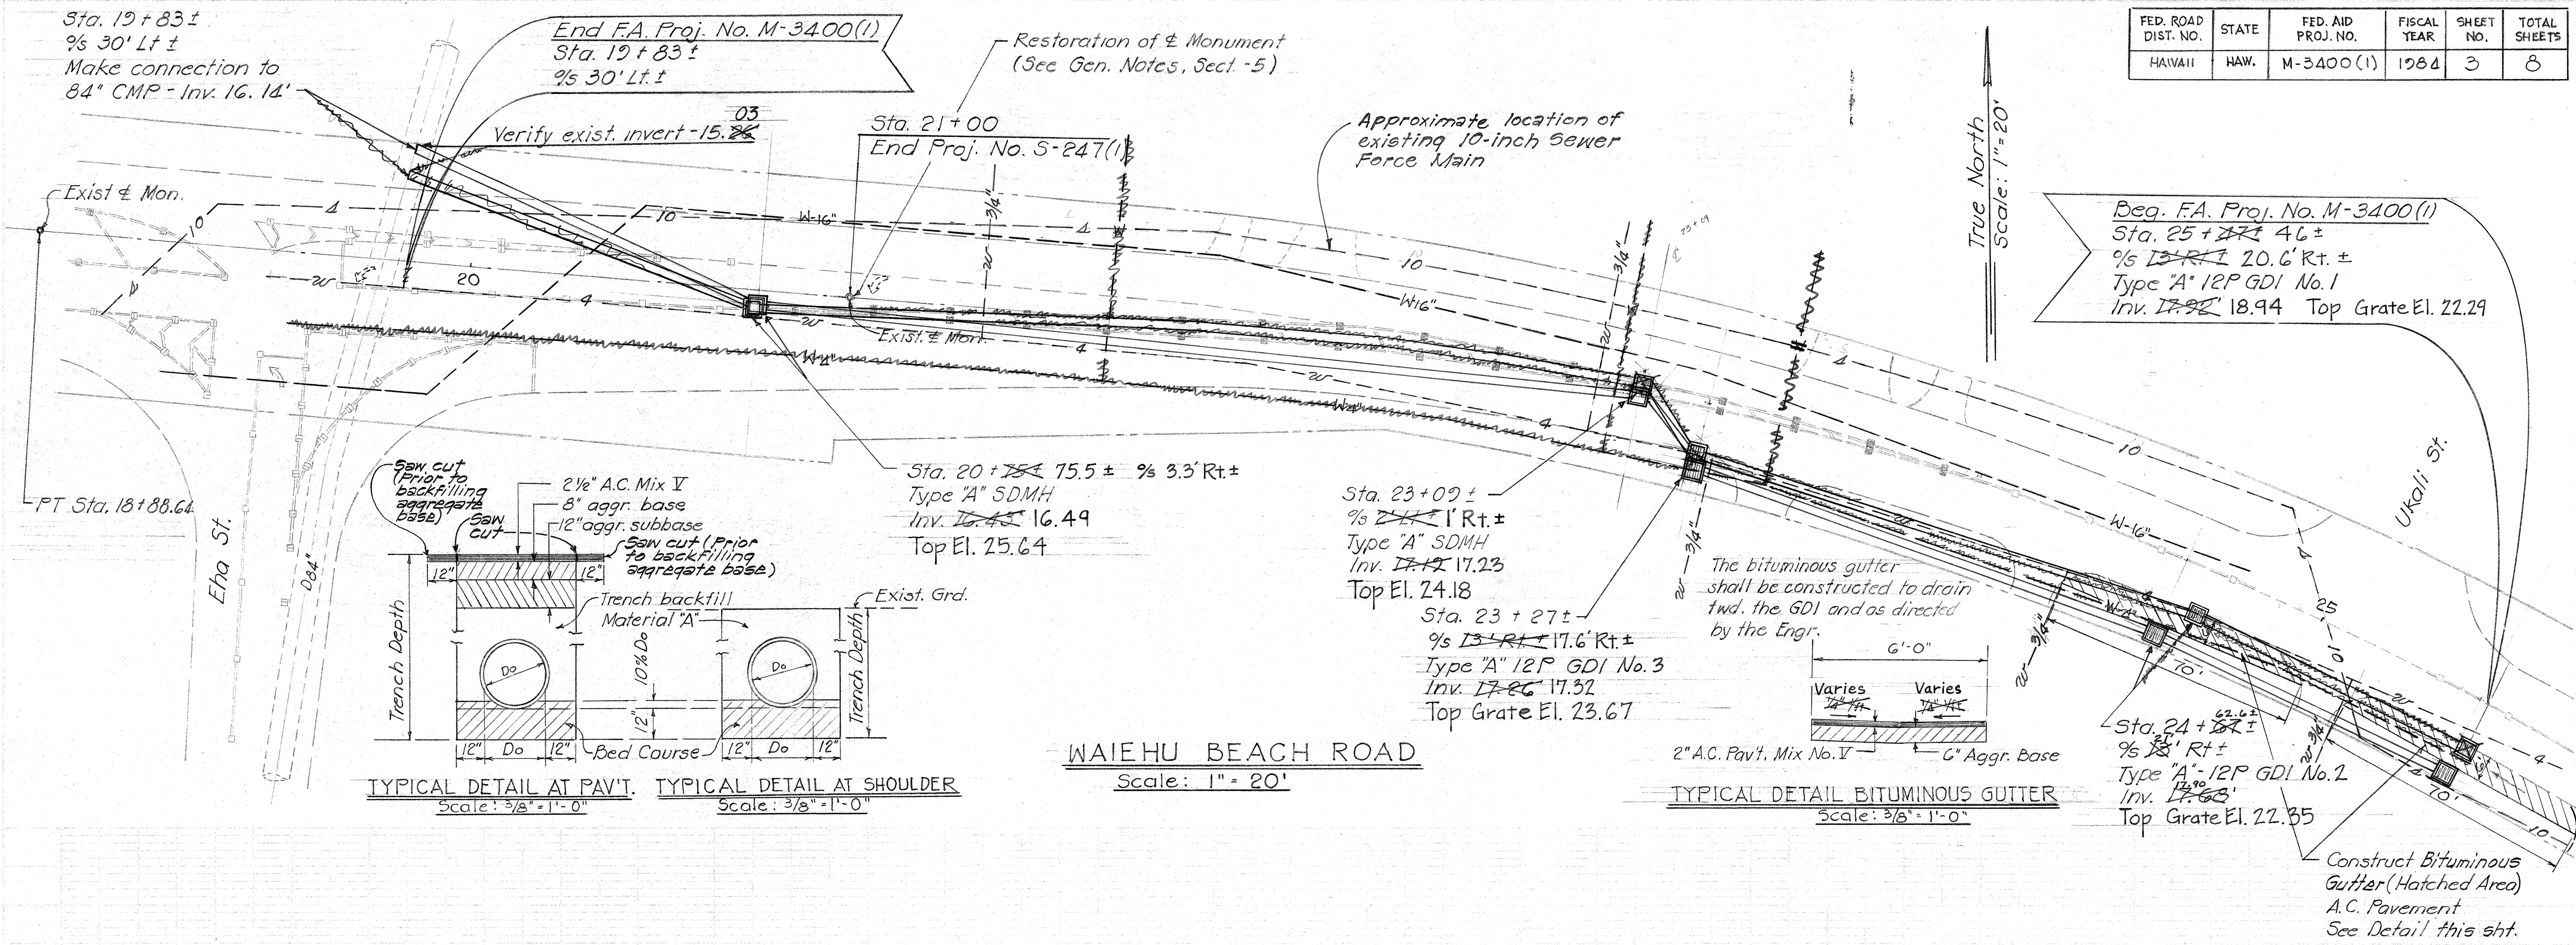

TYPICAL DETAIL AT PAV'T.
Scale: 3/8" = 1'-0"

TYPICAL DETAIL AT SHOULDER
Scale: 3/8" = 1'-0"

WAIERU BEACH ROAD
Scale: 1" = 20'

TYPICAL DETAIL BITUMINOUS GUTTER
Scale: 3/8" = 1'-0"

