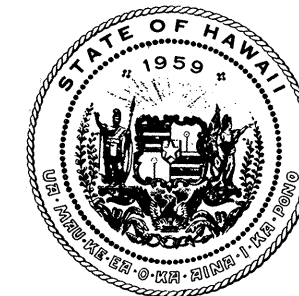


[illegible][illegible]

STATE OF HAWAII
DEPARTMENT OF TRANSPORTATION
HIGHWAYS DIVISION
"AS - BUILT"
PLANS OF
WAIEHU BEACH ROAD
DRAINAGE IMPROVEMENTS, UKALI STREET TO EHA STREET
FEDERAL AID PROJECT NO. M-3400(1)

DEPARTMENT OF TRANSPORTATION

HIGHWAYS DIVISION

"AS-BUILT" PLANS OF



WAIEHU BEACH ROAD

DRAINAGE IMPROVEMENTS, UKALI STREET TO EHA STREET

FEDERAL AID PROJECT NO. M-3400(I)

DISTRICT OF WAILUKU
ISLAND OF MAUI

FED. ROAD DIST. NO.	STATE	FED. AID PROJ. NO.	FISCAL YEAR	SHEET NO.	TOTAL SHEETS
HAWAII	HAW.	M-3400(I)	1984	1	8

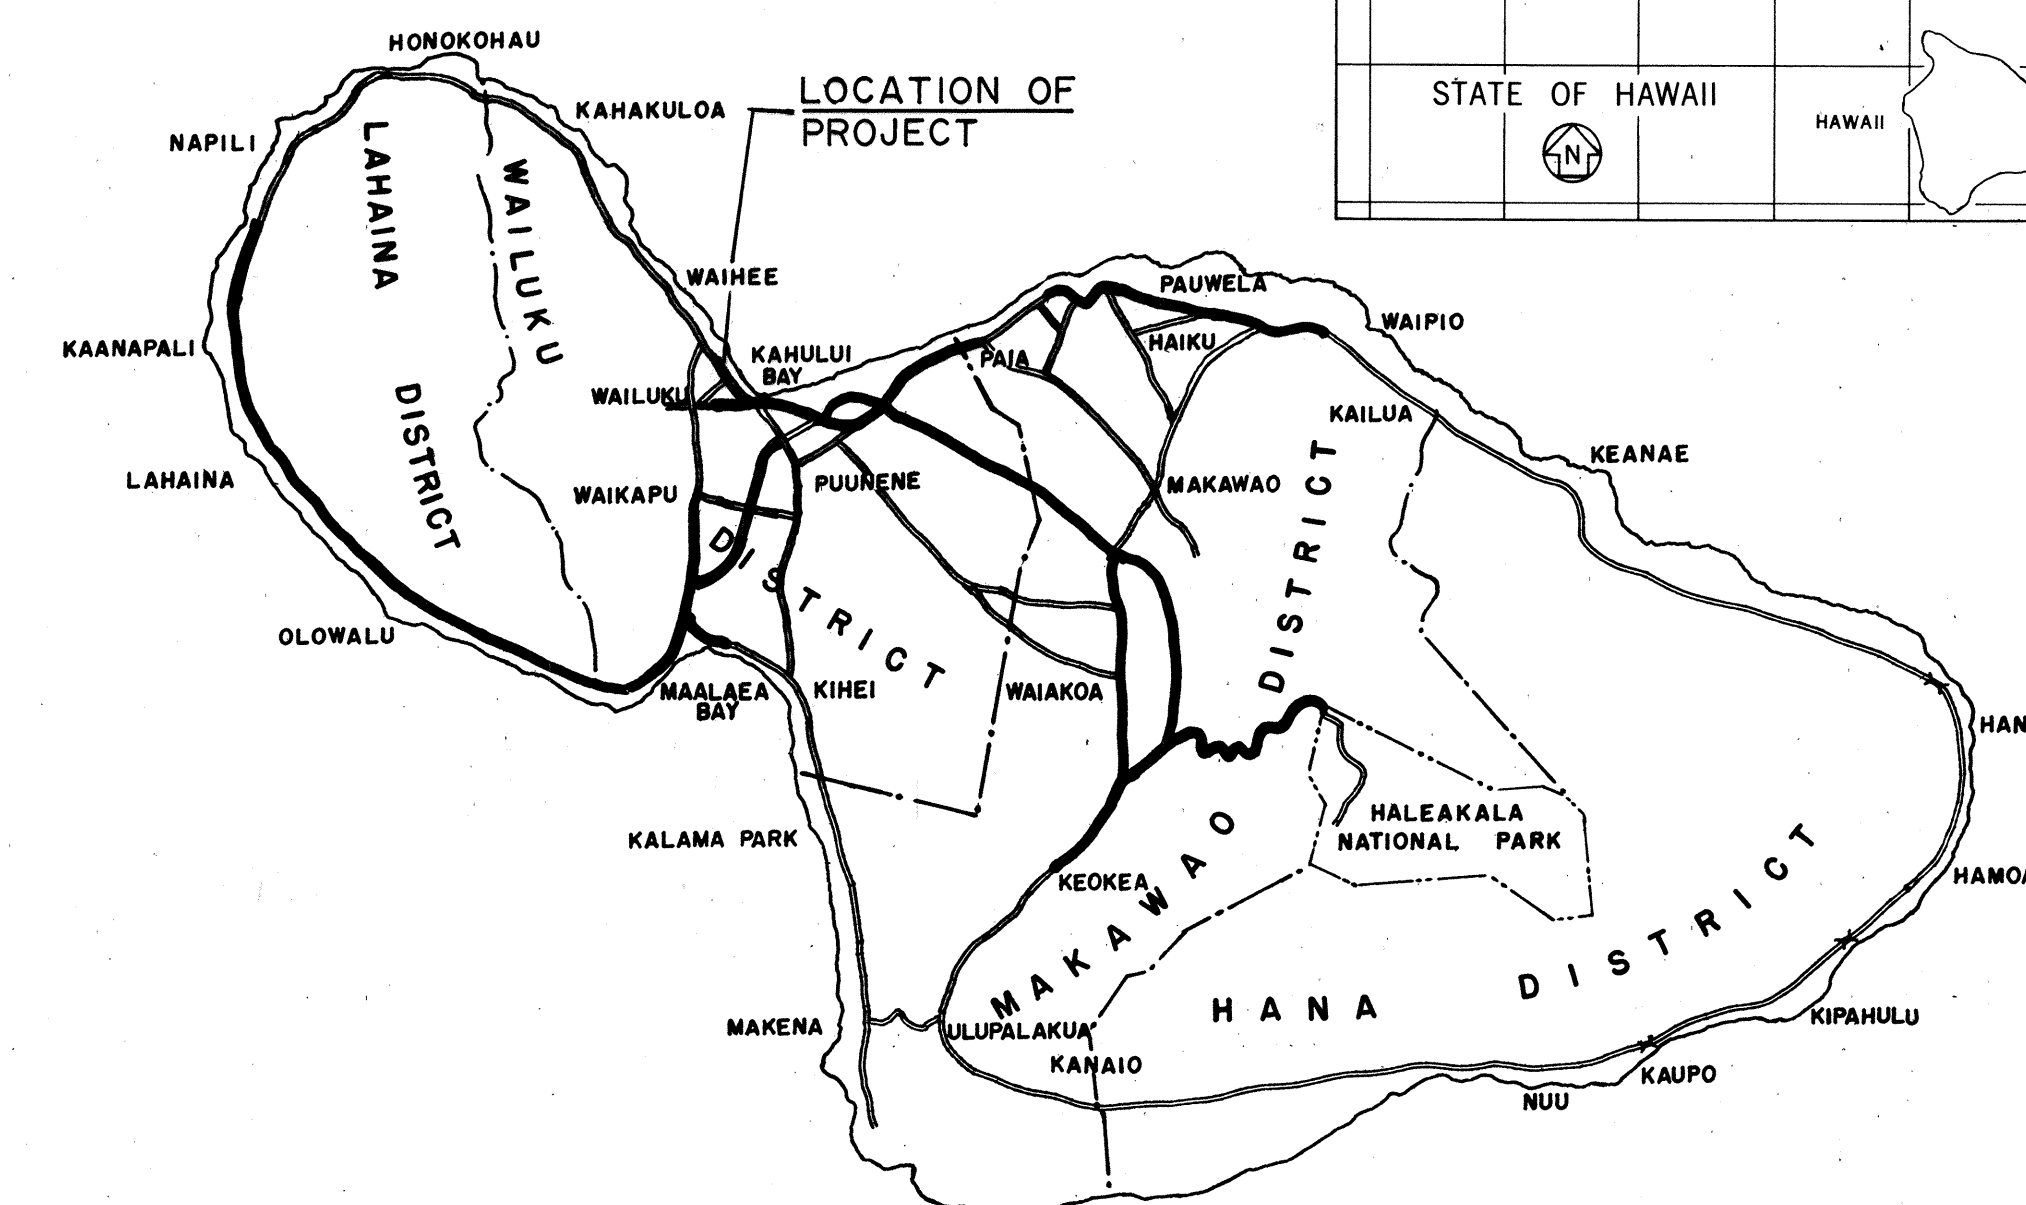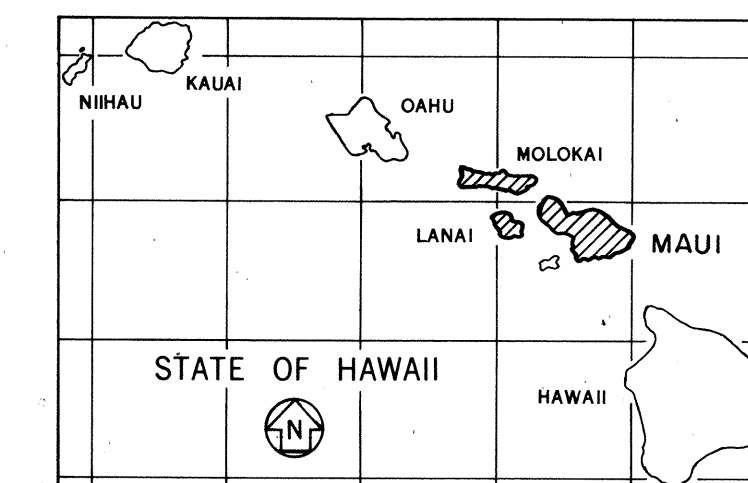

5 0 5 10

SCALE IN MILES


FEDERAL AID PROJECTS PREVIOUSLY CONSTRUCTED
OR UNDER CONSTRUCTION

DESIGN DESIGNATION

ADT (1983) 6,980
V (Posted) 30 mph

CHANGES MADE DURING CONSTRUCTION HAVE BEEN INCORPORATED ON THESE PLANS EXCEPT CHANGES IN THE ORIGINAL THEORETICAL QUANTITIES. FOR ACTUAL QUANTITIES, REFER TO PROJECT LEDGER AND/OR COMPUTATION BOOK.

Feldman Capital 9-7-84
RESIDENT ENGINEER DATE

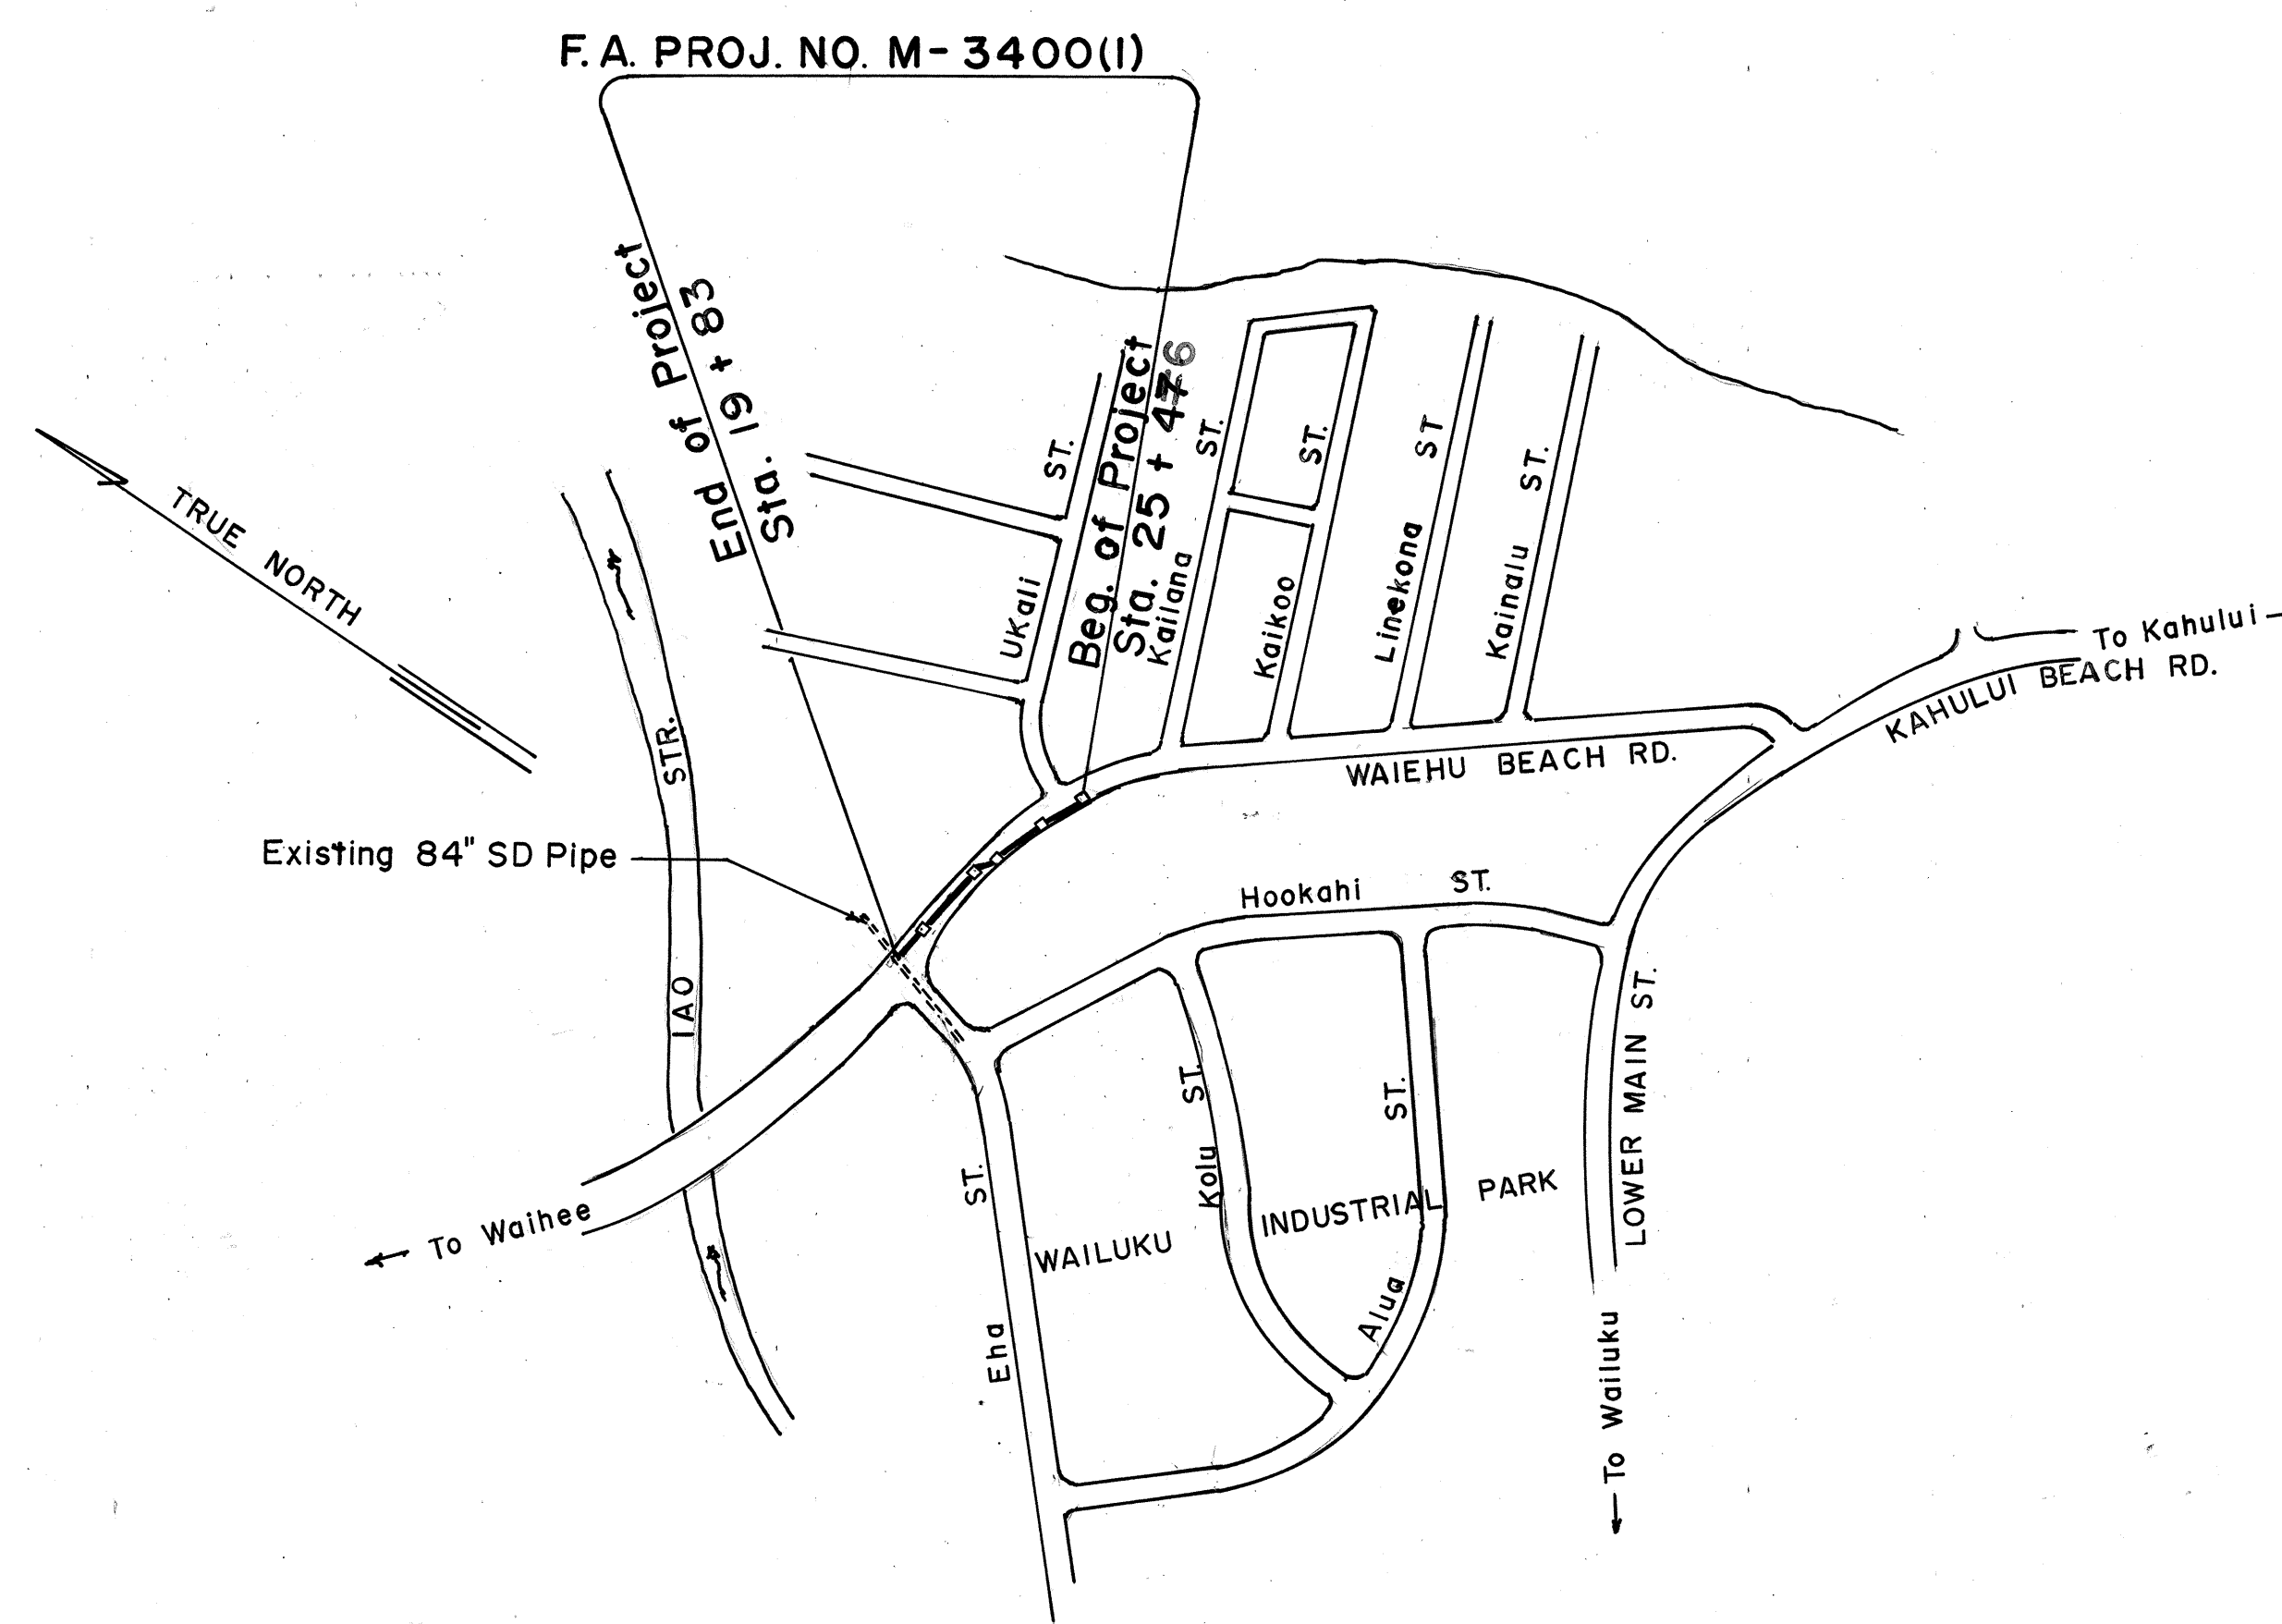

LAYOUT PLAN
SCALE: 1" = 400'
LENGTH OF PROJECT 0.107 Mi.

HWY-M
DESIGNED BY

A. Nishimura
P. S. & E. BY

548-7490
PHONE

Sept., 1983
DATE

DEPARTMENT OF TRANSPORTATION FEDERAL HIGHWAY ADMINISTRATION	
APPROVED:	
<i>W. L. ...</i>	12/22/8
<u>DIVISION ADMINISTRATOR</u>	<u>DATE</u>

DEPARTMENT OF TRANSPORTATION STATE OF HAWAII	
APPROVED:  _____ DIR. OF TRANSPORTATION	DATE 12/13/93