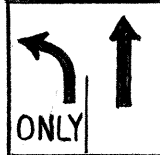
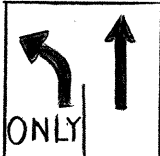


FED. ROAD DIST. NO.	STATE	FED. AID PROJ. NO.	FISCAL YEAR	SHEET NO.	TOTAL SHEETS
HAWAII	HAW.	M-3400(2)	1984	8	19

PAYEMENT MARKINGS SUMMARY

DESCRIPTION	QUANTITY
PAYEMENT STRIPING (PAINT)	11,350 L.F.
PAYEMENT ARROWS (PAINT)	8 EA.
PAYEMENT MARKERS - TYPE A	12 EA.
PAYEMENT MARKERS - TYPE C	25 EA.
PAYEMENT MARKERS - TYPE D	52 EA.
PAYEMENT MARKERS - TYPE H	150 EA.

TRAFFIC SIGNS SUMMARY

LOCATION STA.	TYPE	DESCRIPTION	INSTALL W/ POST	RELOCATE
17+40		MILE POST MARKER		1
18+70 Lt.	W1-2L	CURVE SIGN		1
24+70 Lt.		 30"x30"	1	
26+20 Lt.	R1-1	STOP SIGN		1
28+90 Lt.		 30"x30"	1	

NOTE: Relocation of signs and markers will not be measured or paid for separately, but shall be considered incidental to Item No. G21.5100, Regulatory and Warning Sign (10 sq. ft. or less) with post.

STATE OF HAWAII

DEPARTMENT OF TRANSPORTATION

LAND TRANSPORTATION FACILITIES DIVISION

PAYEMENT MARKINGS AND

SIGNS SUMMARIES

KAHULUI BEACH RD. INTERSECTION


IMPROVEMENTS AT KANALOA AVE.

F.A. PROJ. NO. M-3400(2)

SCALE: NONE



OCT. 1983

SHEET No. 1 OF 1 SHEETS

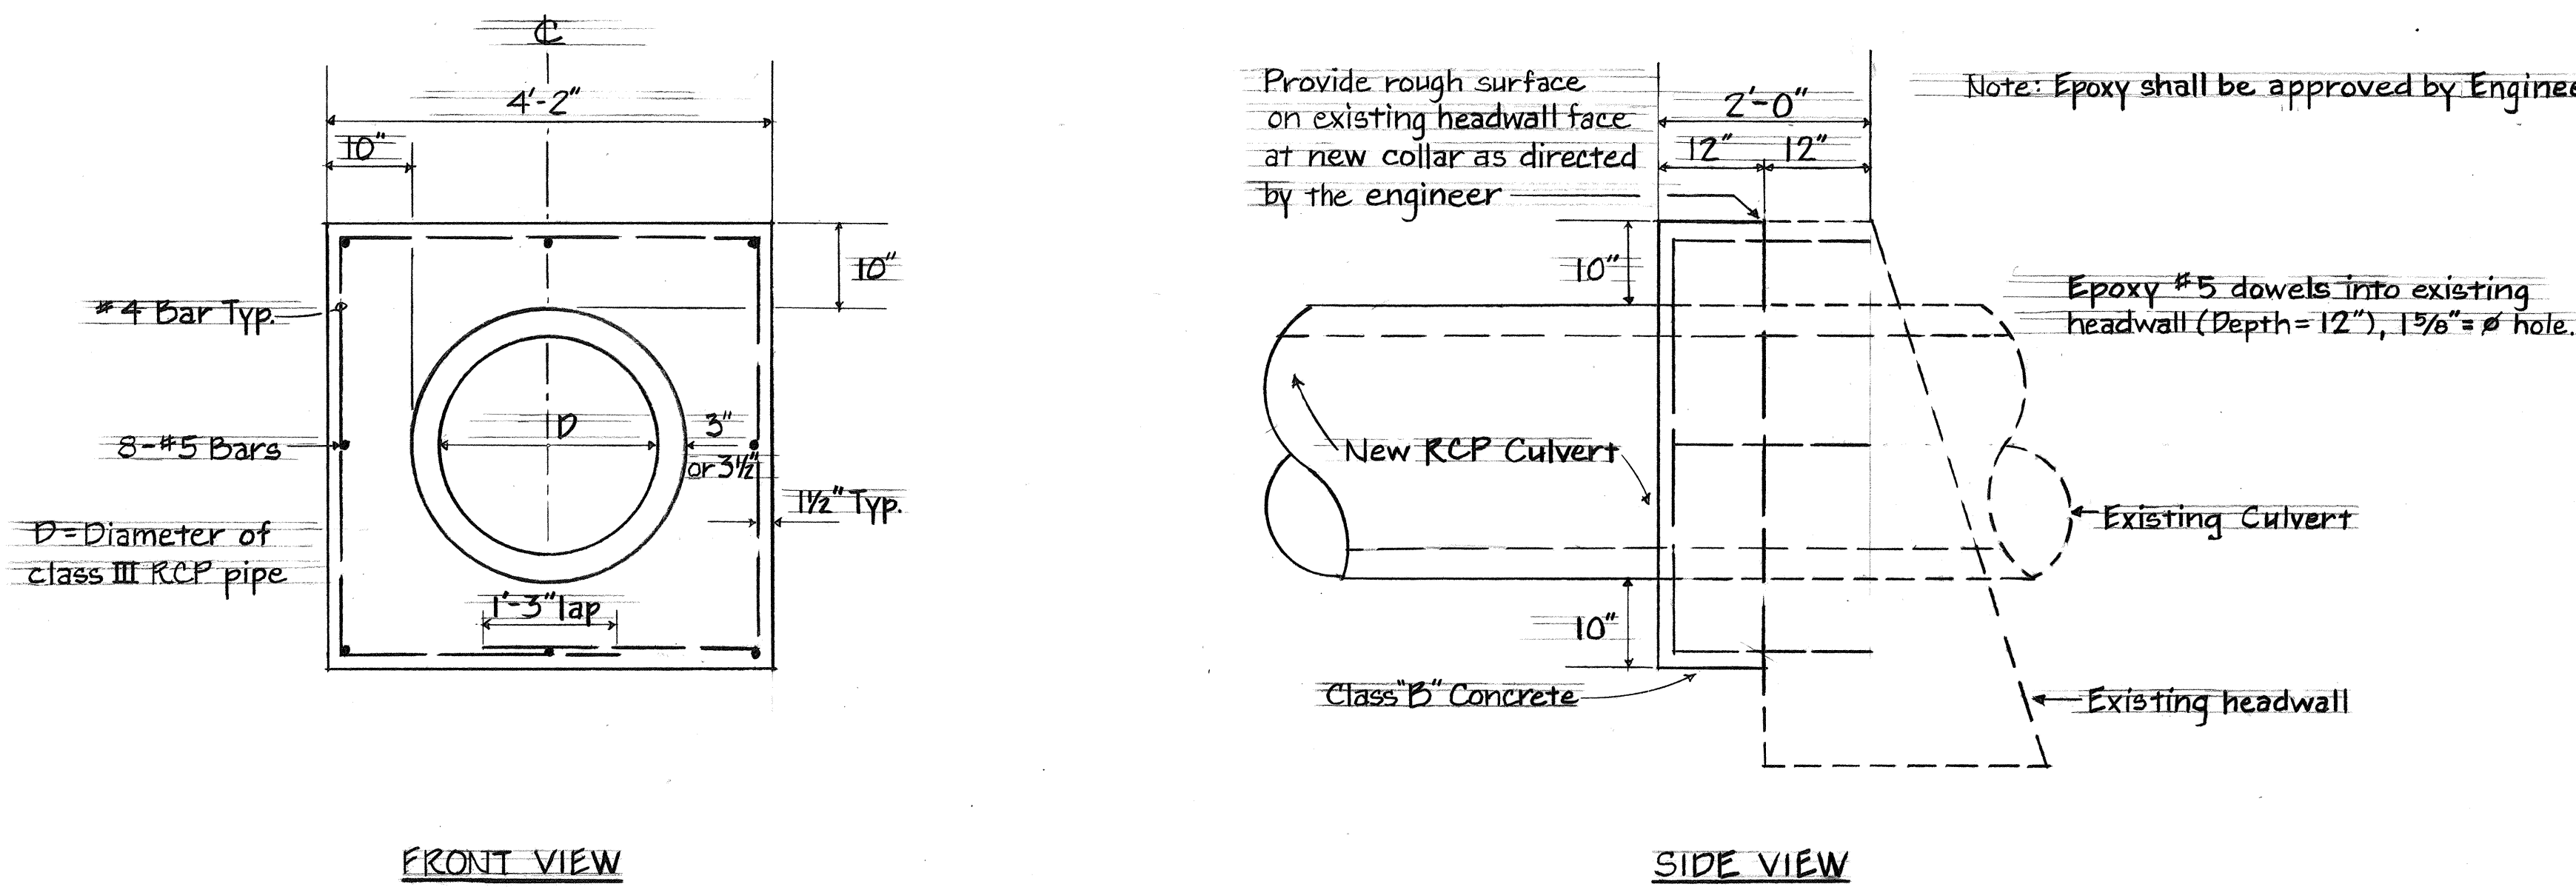

TYPICAL CONCRETE COLLAR DETAIL, CCO No. 1
Scale: 3/4"=1'-0"

NOTE: THIS PORTION OF THE PLANS WAS PREPARED DURING "AS-BUILT" POSTING.

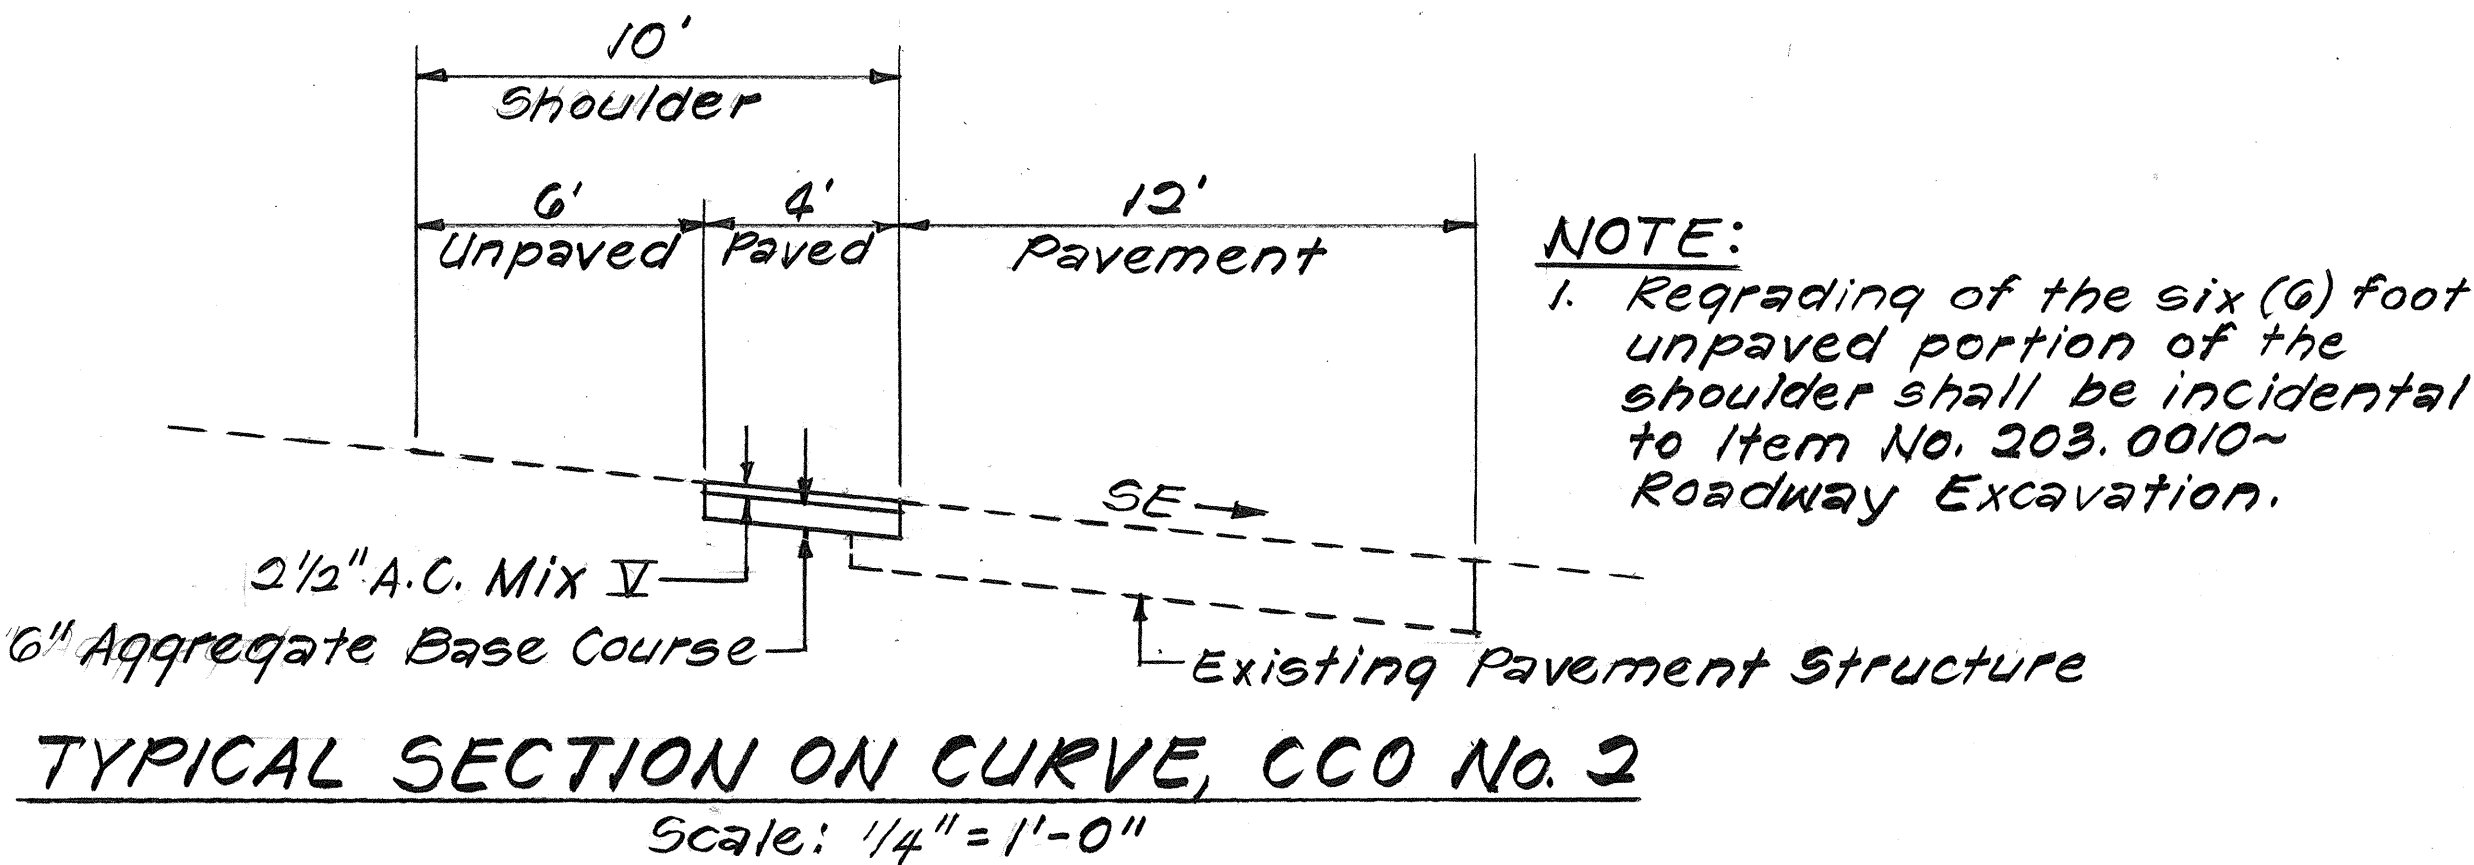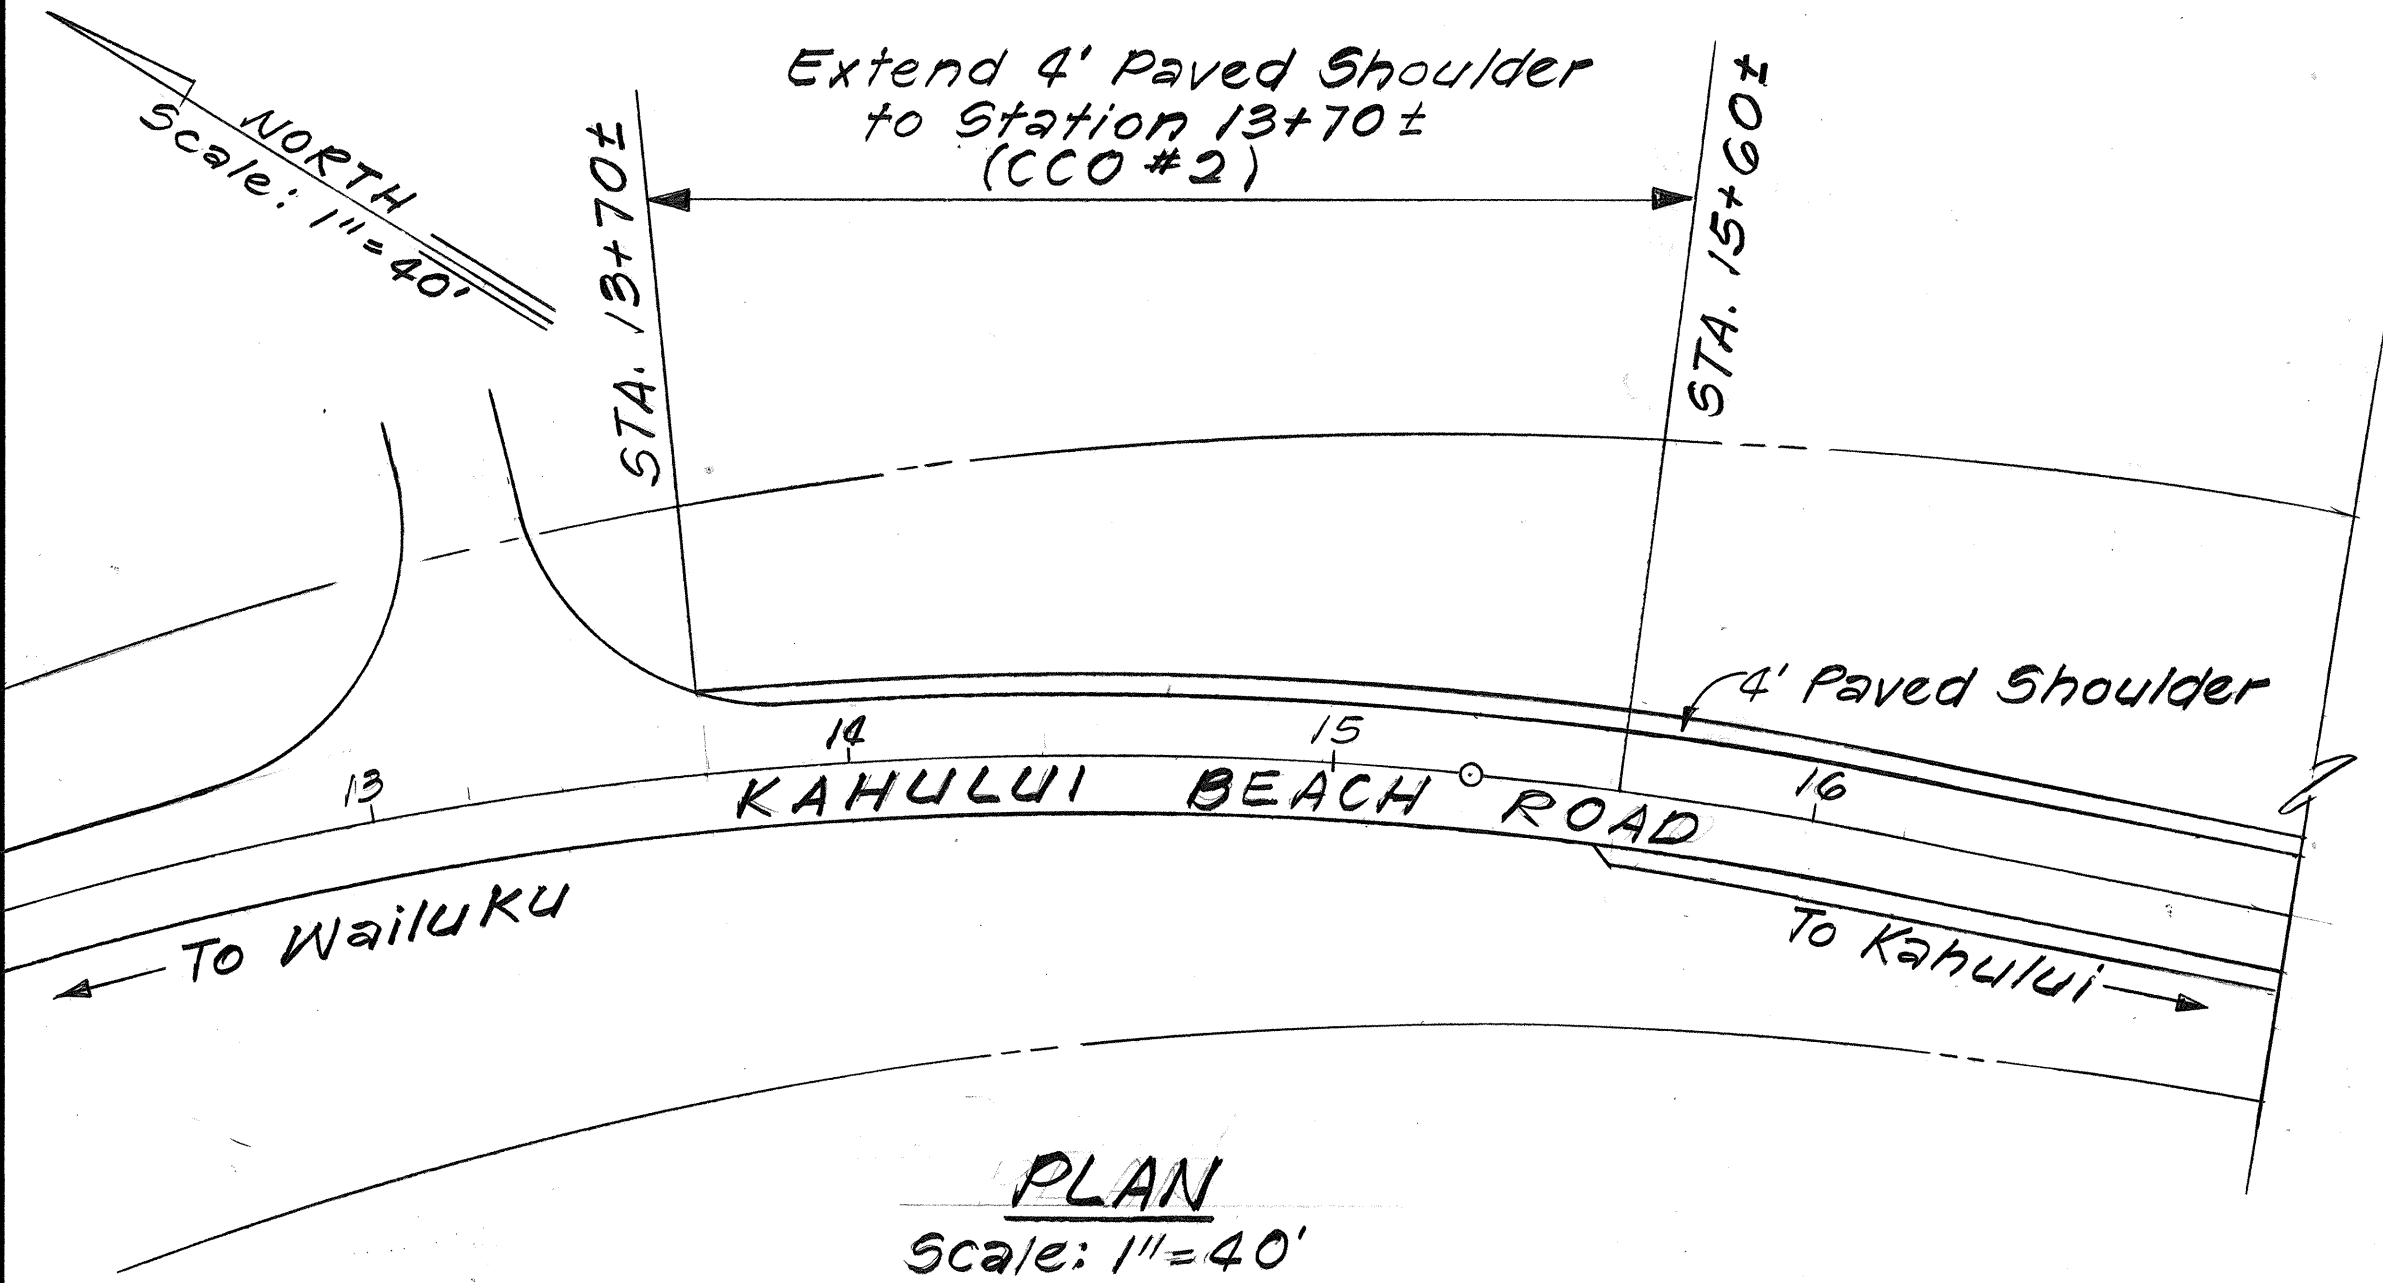

SURVEY PLOTTED BY	DATE
DRAWN BY	
TRACED BY	
NOTED BY	
CHECKED BY	
ORIGINAL PLAN	
NOTE BOOK	
No.	