


| FED. ROAD DIST. NO. | STATE | FED. AID PROJ. NO. | FISCAL YEAR | SHEET NO. | TOTAL SHEETS |
|---------------------|-------|--------------------|-------------|-----------|--------------|
| HAWAII              | HAW.  | M-3400(2)          | 1984        | 3         | 12           |

CONTOUR LEGEND

Existing ---5---  
New ---5---

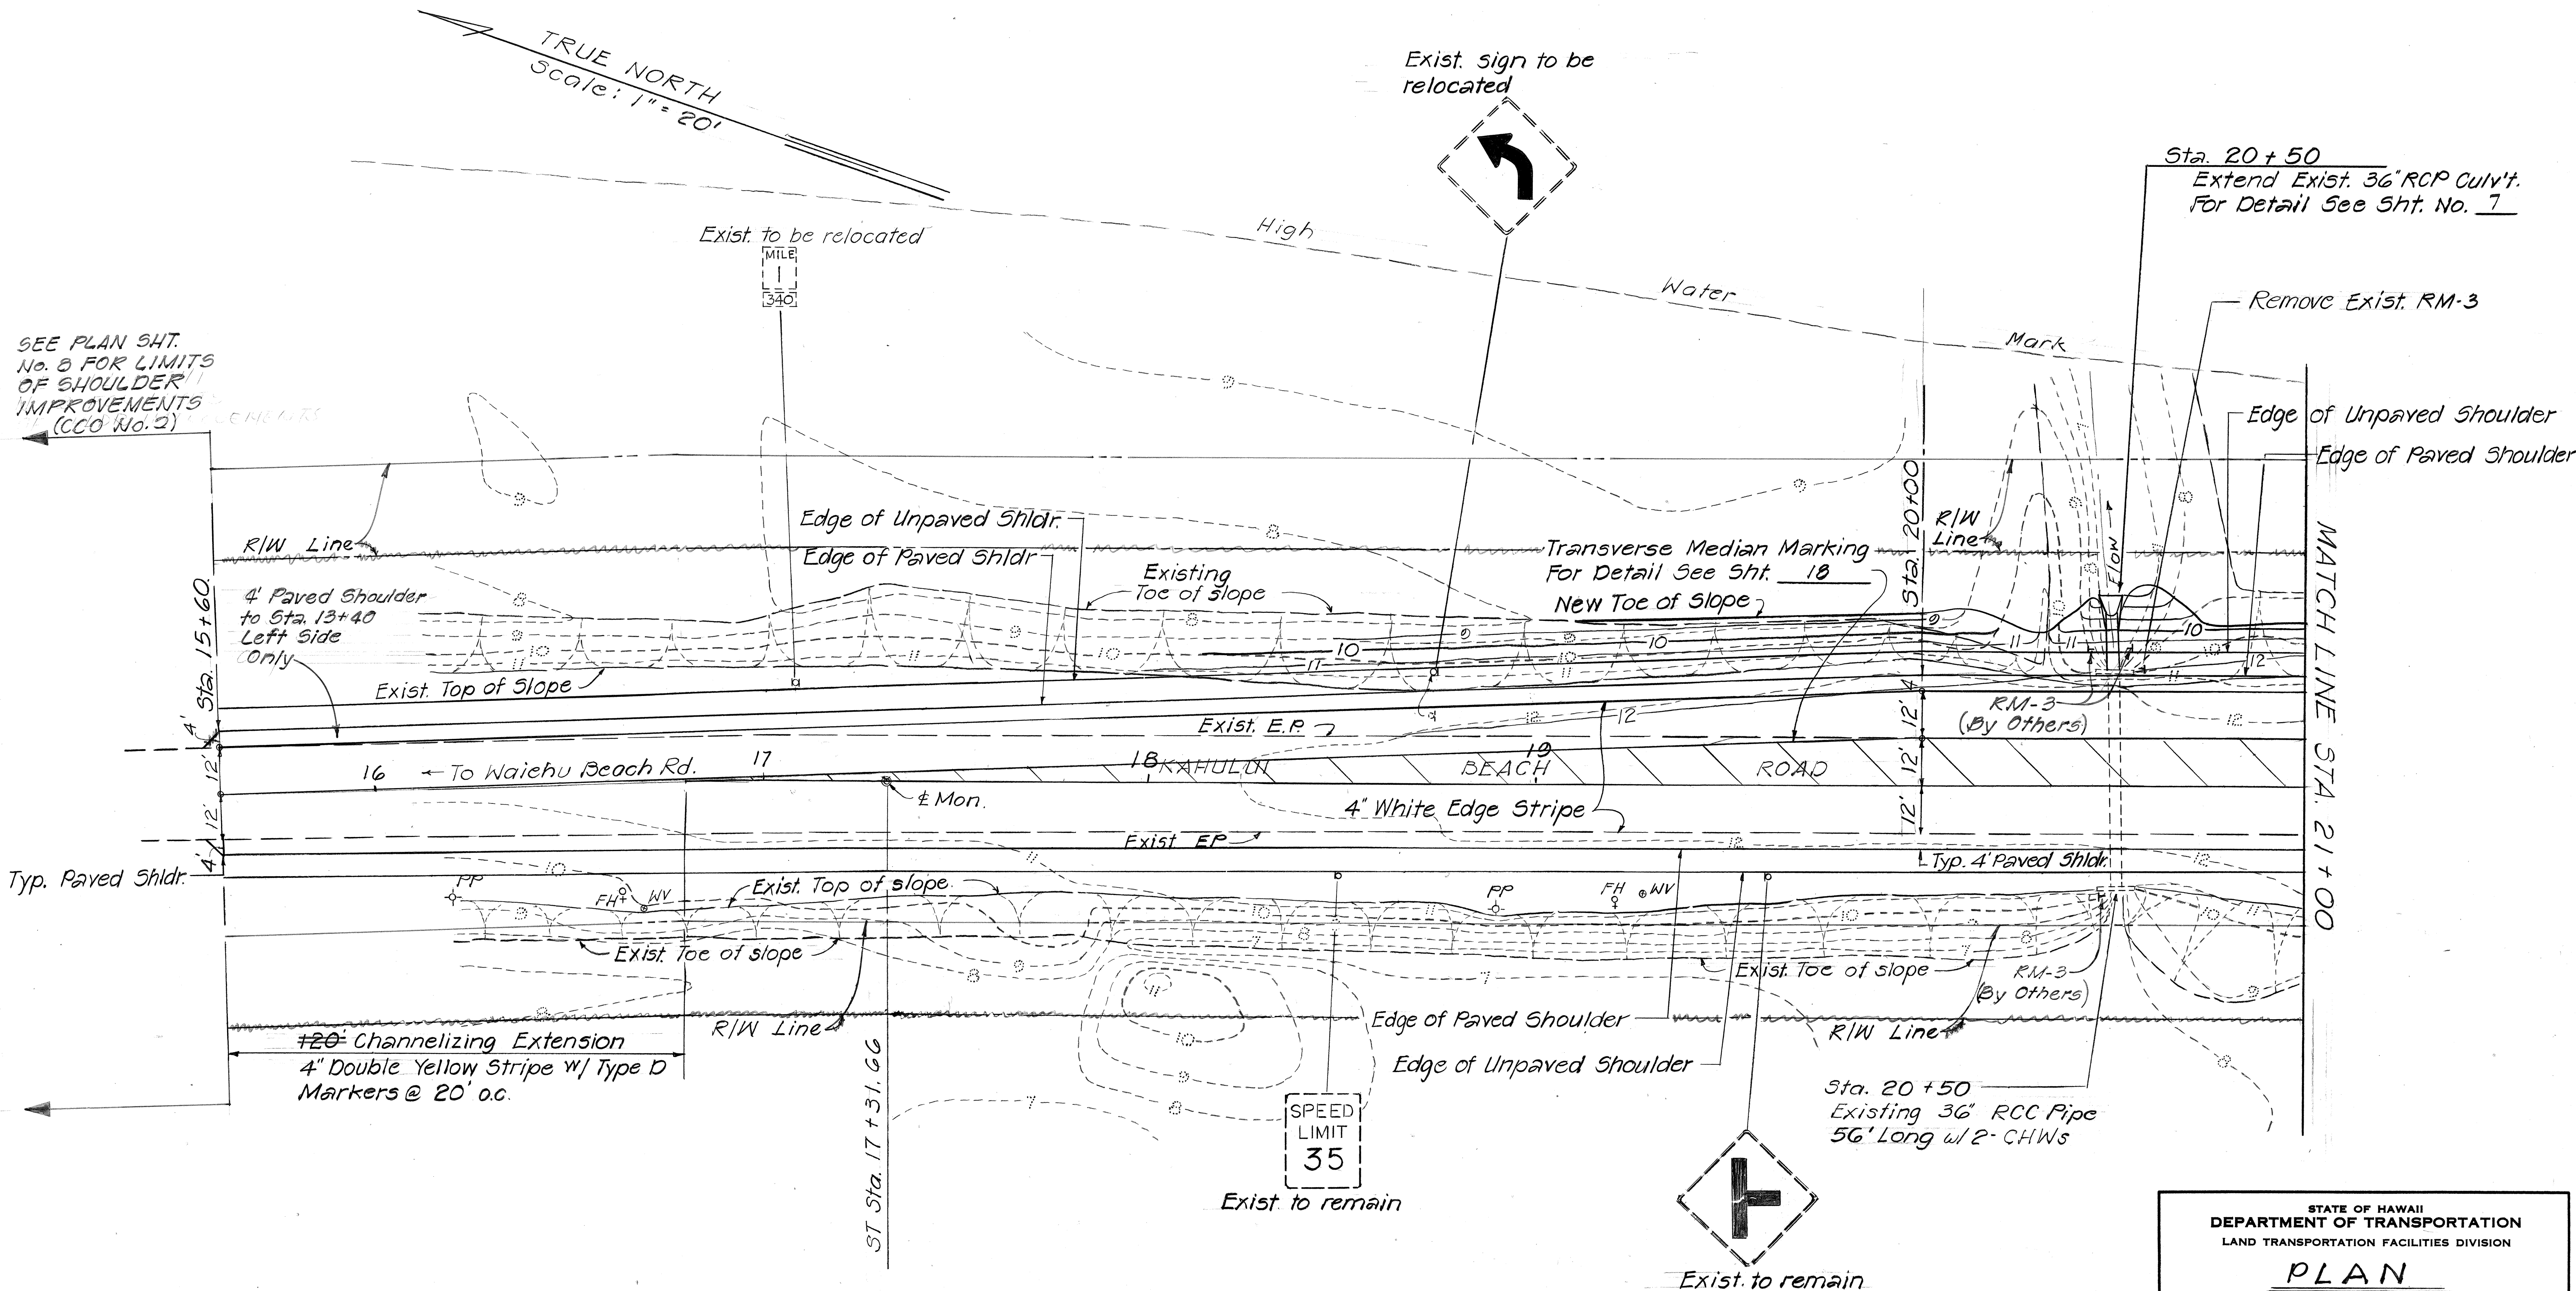

|                   |      |
|-------------------|------|
| SURVEY PLOTTED BY | DATE |
| DRAWN BY          |      |
| TRACED BY         |      |
| DESIGNED BY       |      |
| CHECKED BY        |      |
| ORIGINAL PLAN     |      |
| NOTE BOOK         |      |
| No.               |      |

STATE OF HAWAII  
DEPARTMENT OF TRANSPORTATION  
LAND TRANSPORTATION FACILITIES DIVISION


### PLAN

KAHULUI BEACH RD., INTERSECTION  
IMPROVEMENTS AT KANALOA AVE.  
F.A. PROJ. NO. M-3400(2)

SCALE: AS SHOWN      JUNE 1983

SHEET NO. 1 OF 4 SHEETS

| FED. ROAD DIST. NO. | STATE | FED. AID PROJ. NO. | FISCAL YEAR | SHEET NO. | TOTAL SHEETS |
|---------------------|-------|--------------------|-------------|-----------|--------------|
| HAWAII              | HAW.  | M-3400(2)          | 1984        | 4         | 12           |

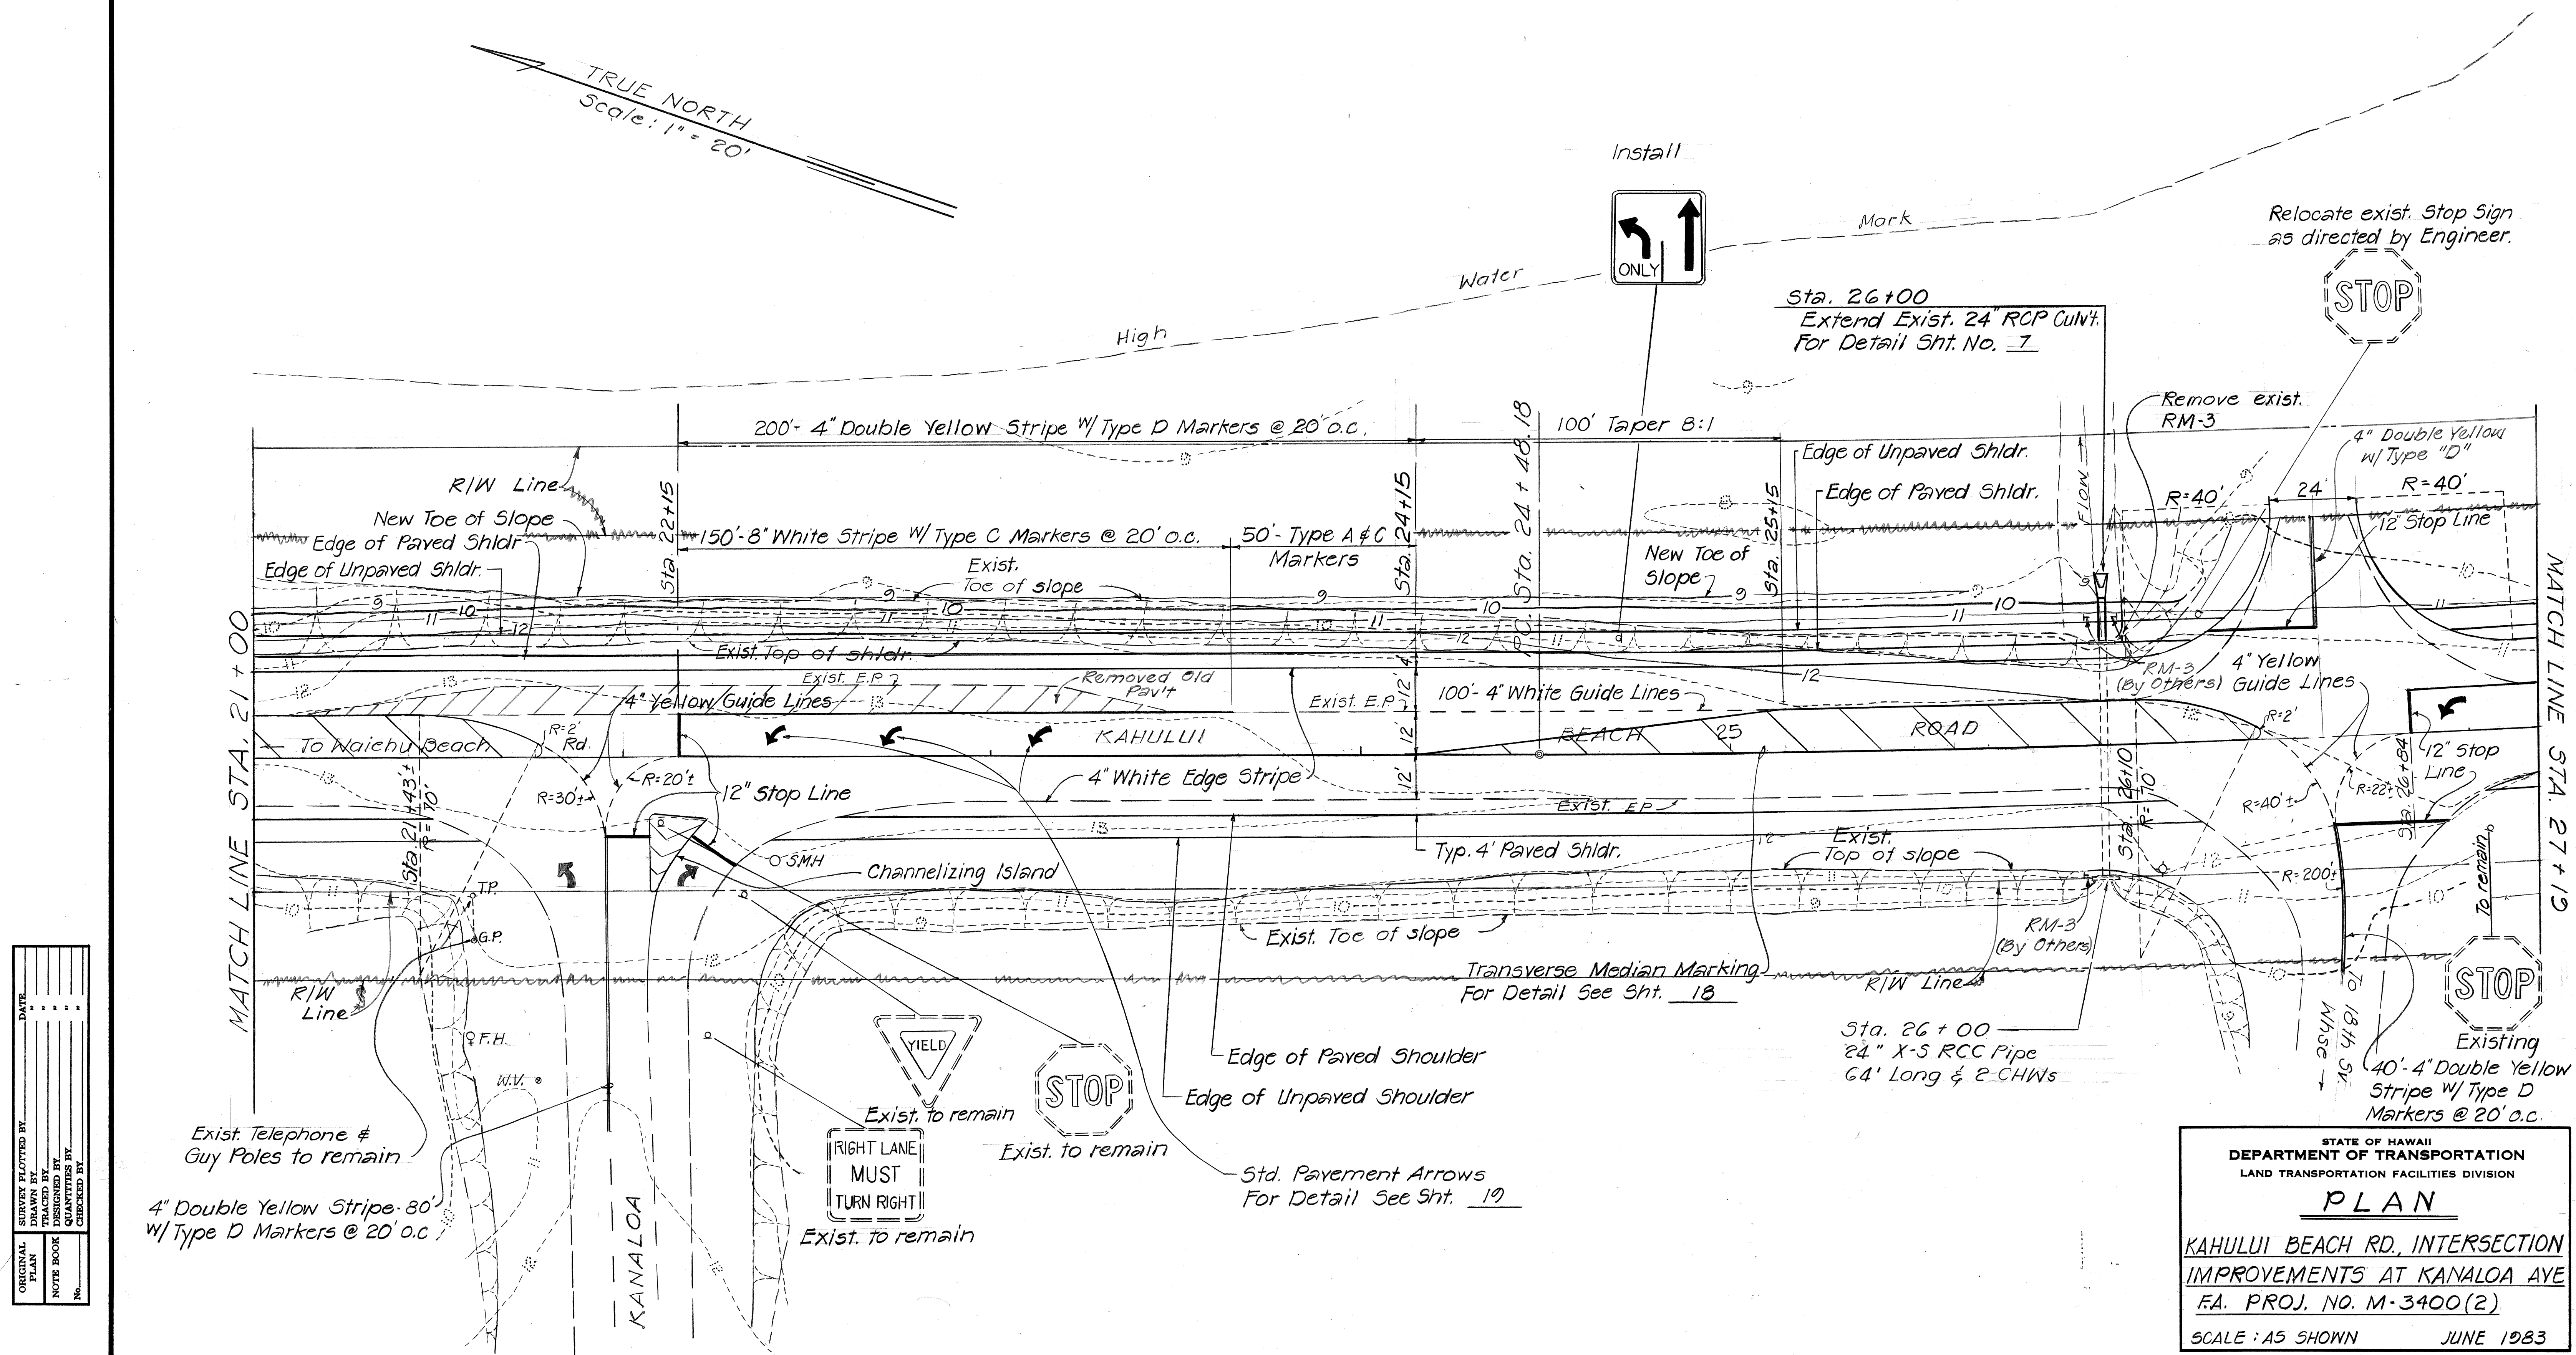


STATE OF HAWAII  
DEPARTMENT OF TRANSPORTATION  
LAND TRANSPORTATION FACILITIES DIVISION

**PLAN**

KAHULUI BEACH RD., INTERSECTION  
IMPROVEMENTS AT KANALOA AVE  
F.A. PROJ. NO. M-3400(2)

SCALE: AS SHOWN      JUNE 1983  
SHEET NO. 2 OF 4 SHEETS

| FED. ROAD DIST. NO. | STATE | FED. AID PROJ. NO. | FISCAL YEAR | SHEET NO. | TOTAL SHEETS |
|---------------------|-------|--------------------|-------------|-----------|--------------|
| HAWAII              | HAW.  | M-3400(2)          | 1984        | 5         | 19           |

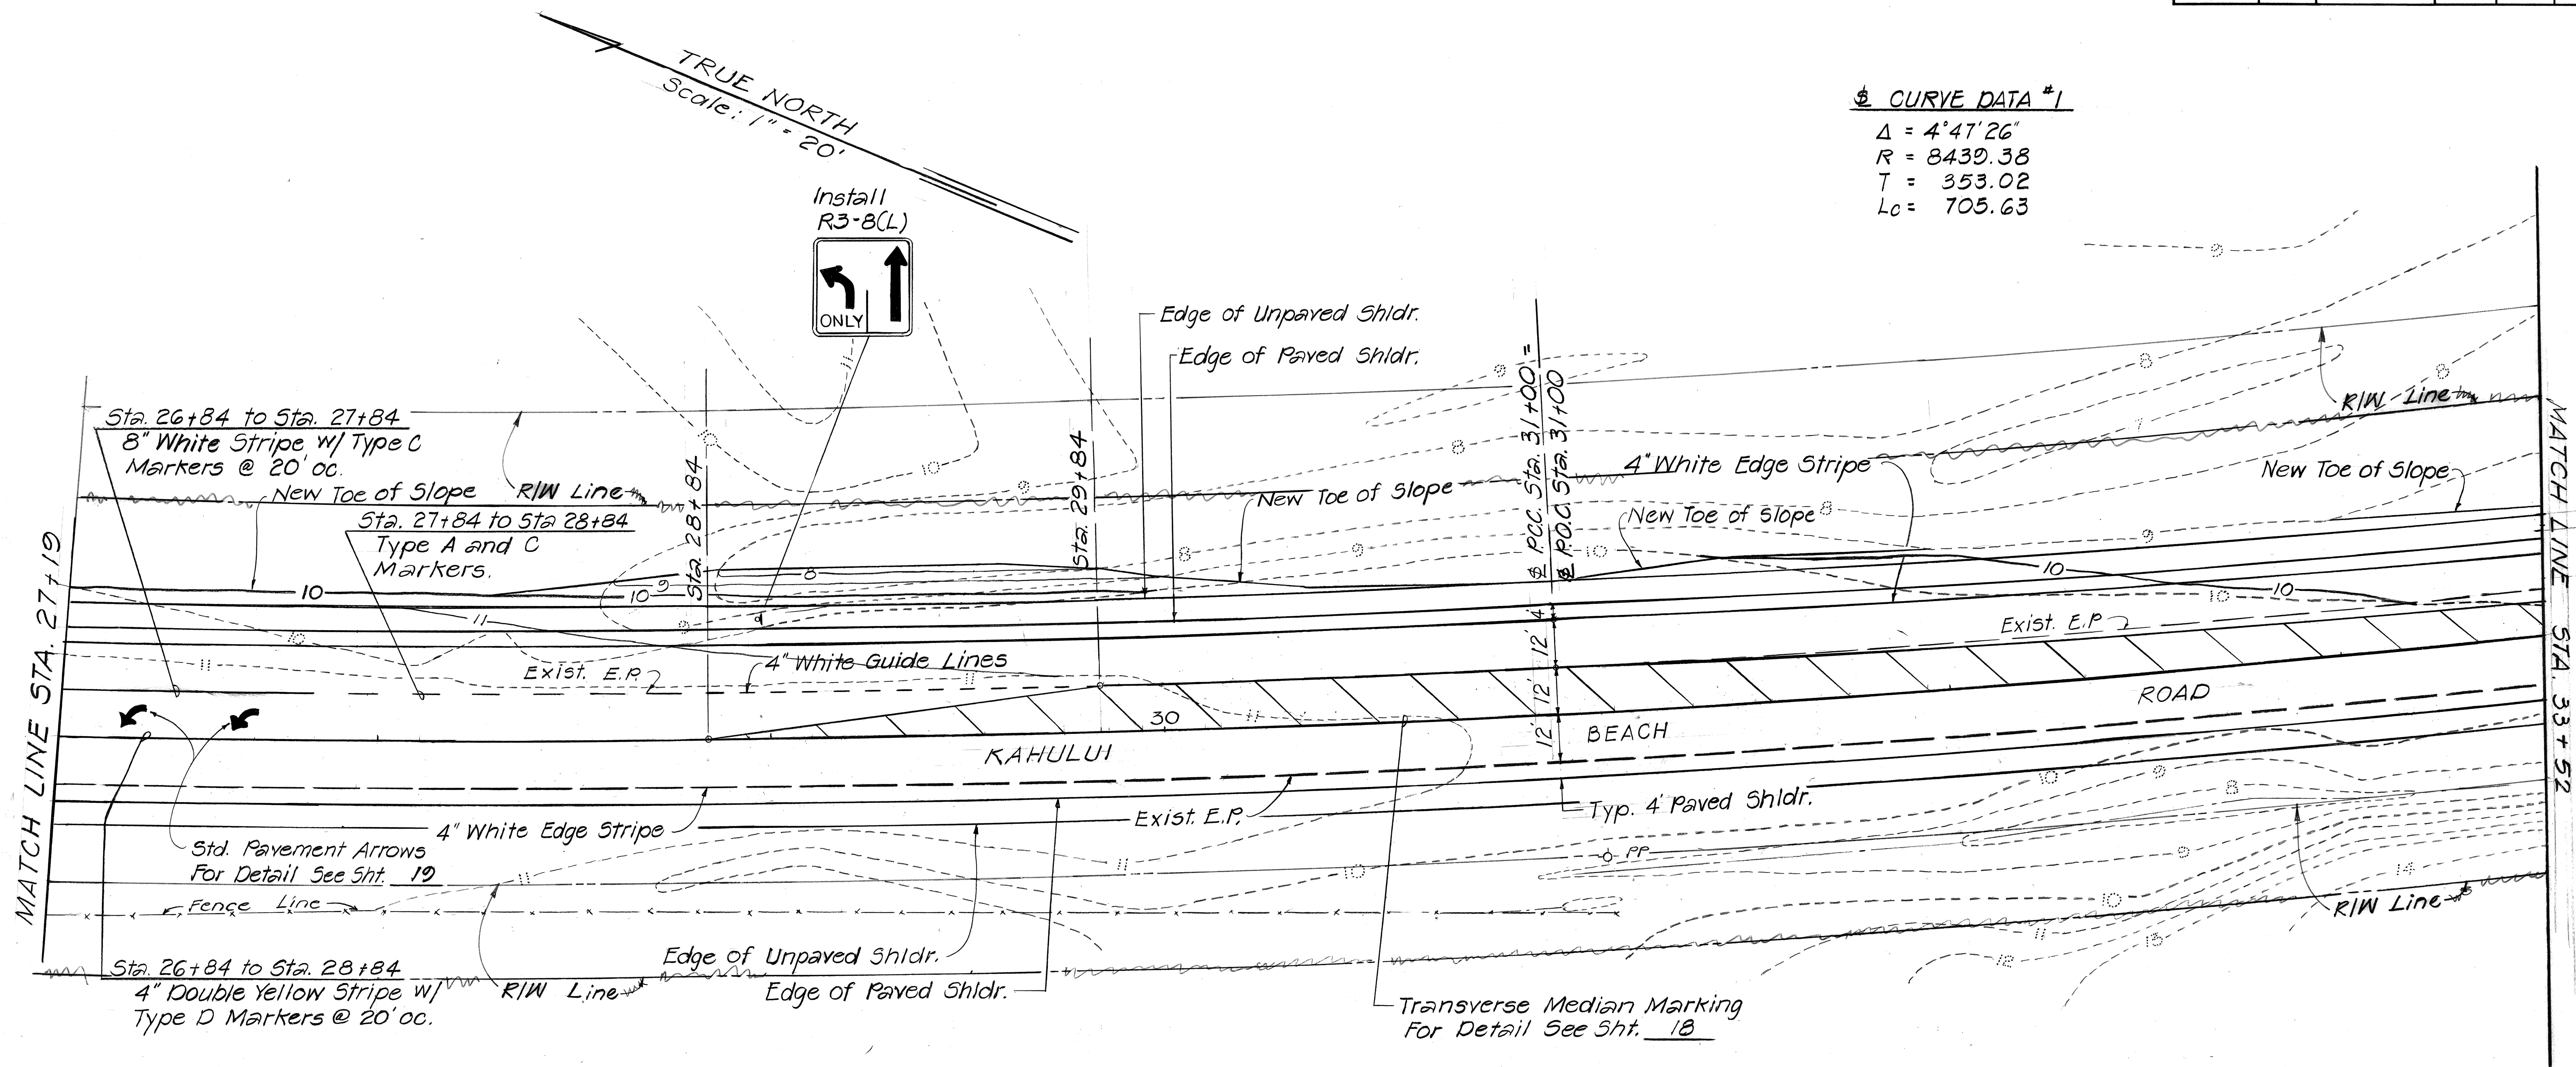

|               |                   |      |
|---------------|-------------------|------|
| ORIGINAL PLAN | SURVEY PLOTTED BY | DATE |
| NO. 1         | DRAWN BY          |      |
|               | TRACED BY         |      |
|               | CHECKED BY        |      |
|               | DATE              |      |

STATE OF HAWAII  
DEPARTMENT OF TRANSPORTATION  
LAND TRANSPORTATION FACILITIES DIVISION

**PLAN**


KAHULUI BEACH RD. INTERSECTION  
IMPROVEMENTS AT KANALOA AVE.  
F.A. PROJ. NO. M-3400(2)

SCALE: AS SHOWN JUNE 1983  
SHEET NO. 3 OF 4 SHEETS

| FED. ROAD DIST. NO. | STATE | FED. AID PROJ. NO. | FISCAL YEAR | SHEET NO. | TOTAL SHEETS |
|---------------------|-------|--------------------|-------------|-----------|--------------|
| HAWAII              | HAW.  | M-3400(2)          | 1984        | 6         | 19           |

# § CURVE DATA #2

$\Delta = 0^\circ 41' 07''$   
 $R = 2546.48'$   
 $T = 15.23'$   
 $L_c = 30.45'$

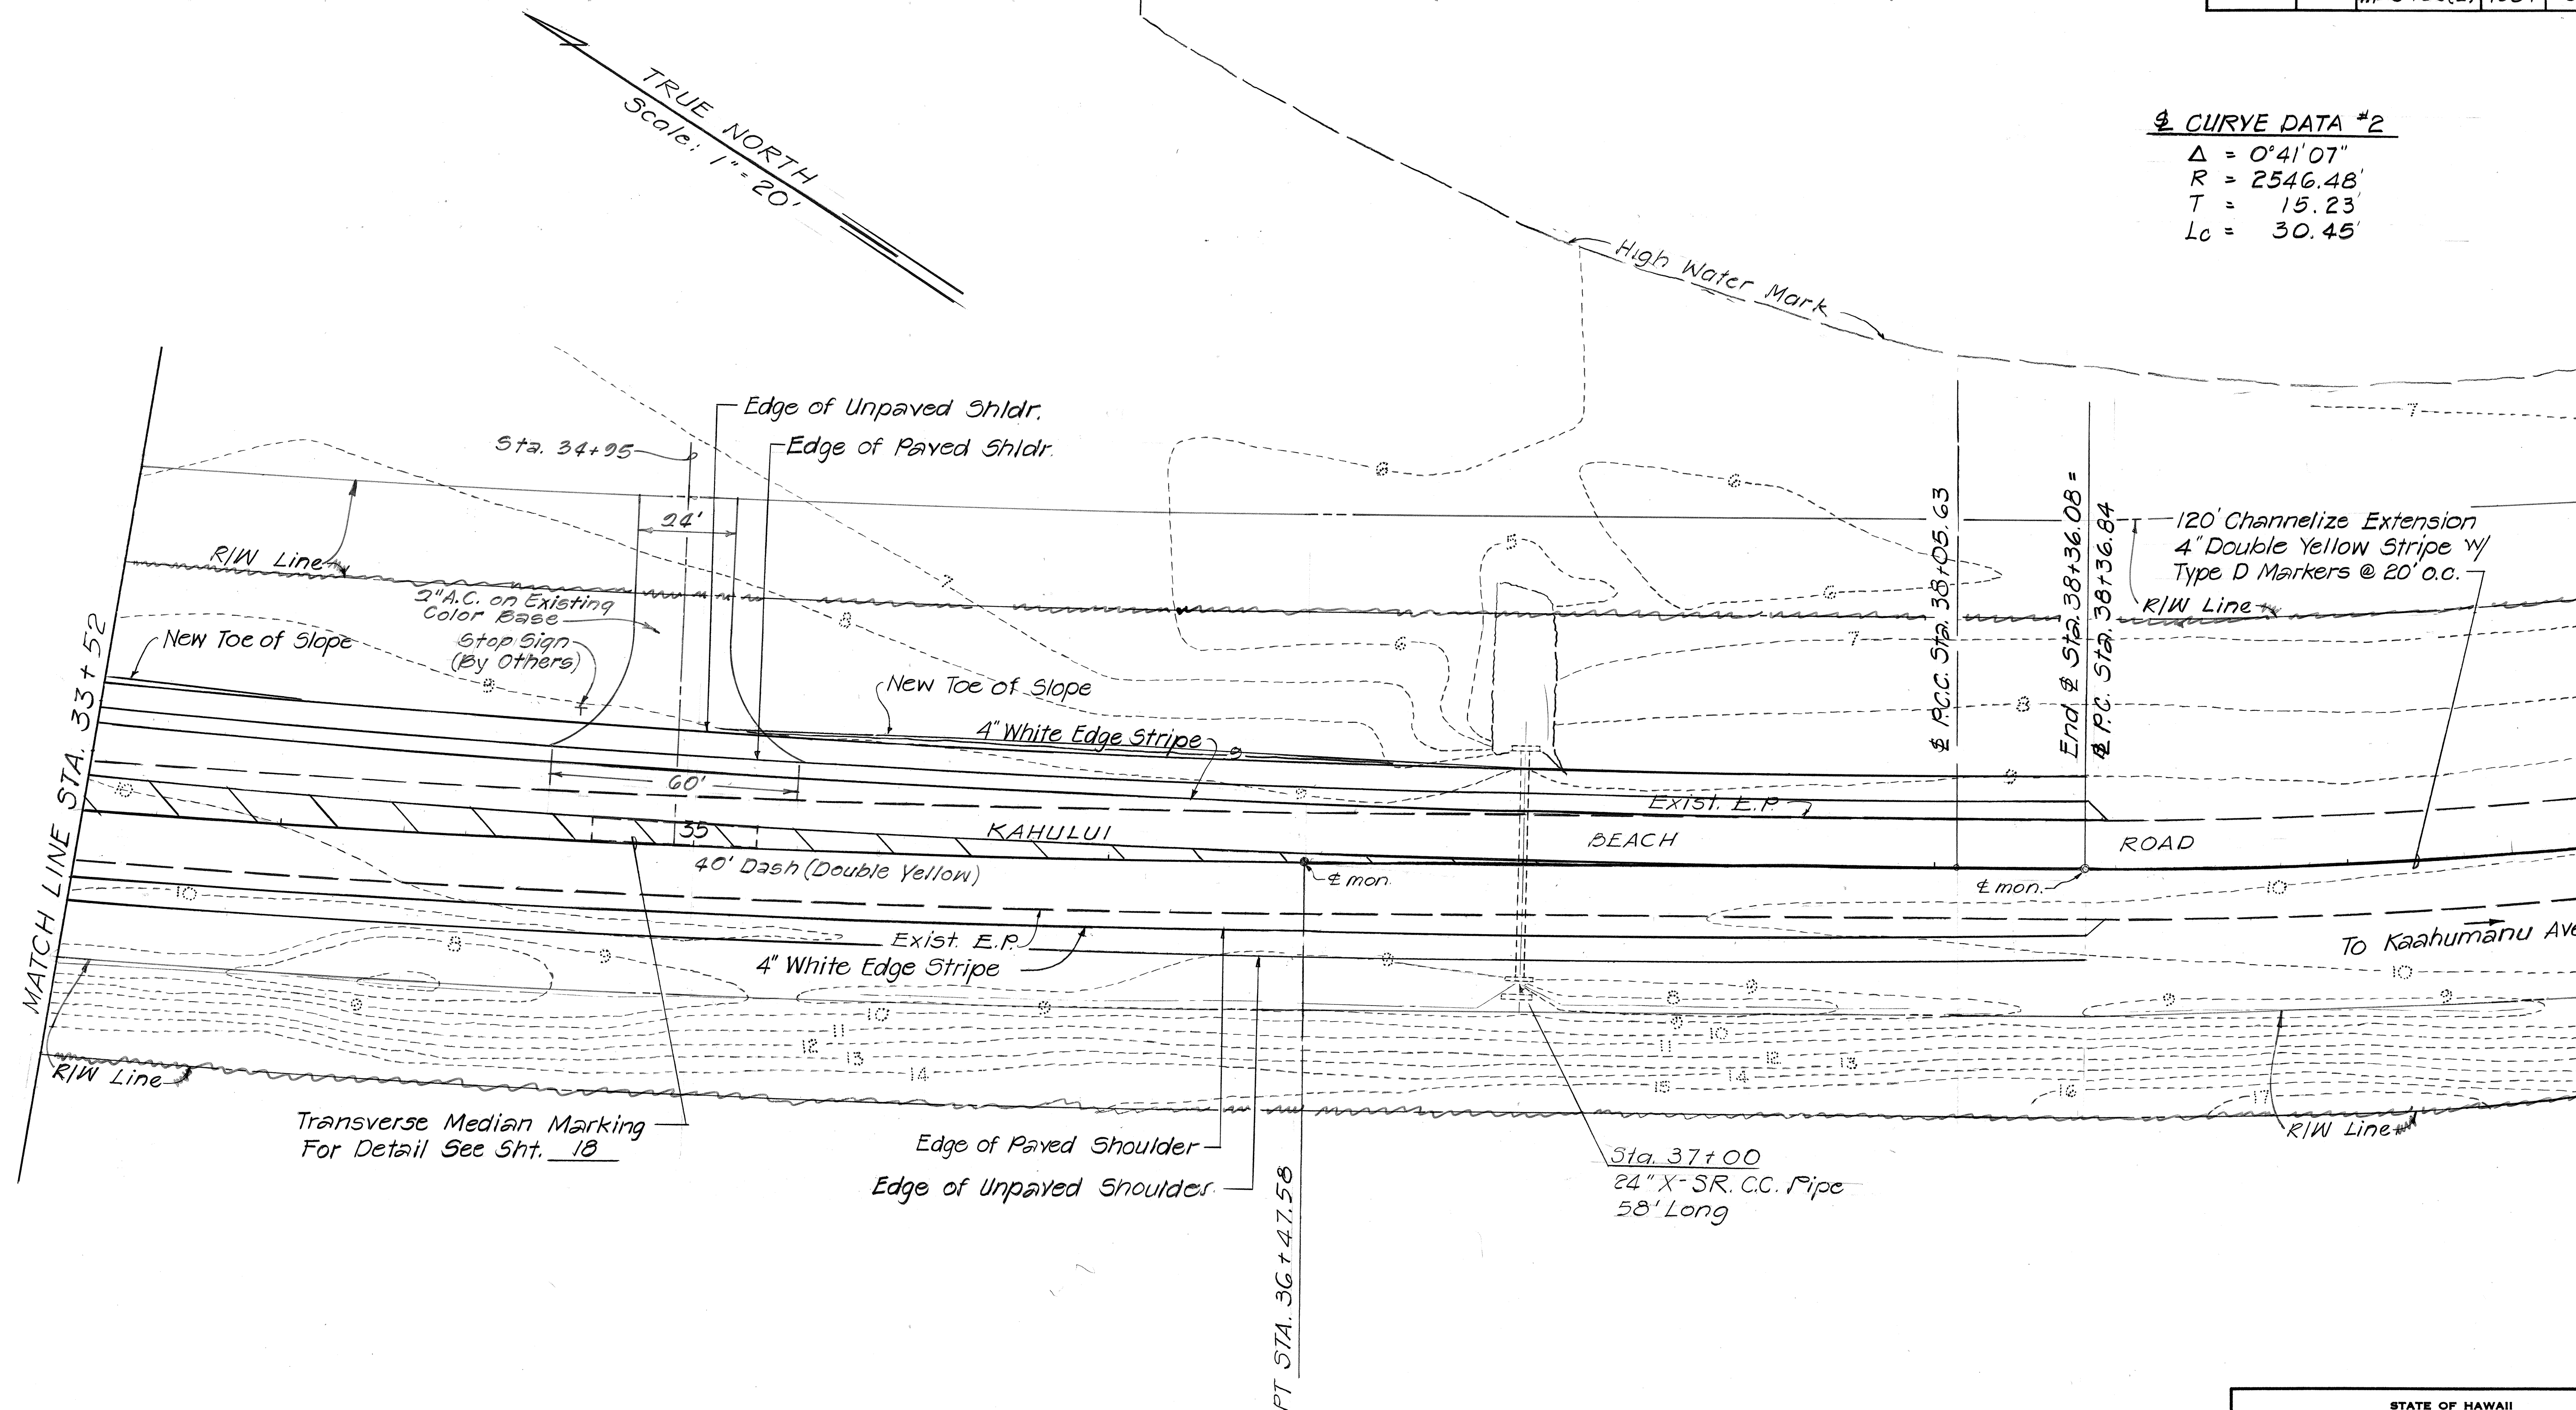

|               |                   |      |
|---------------|-------------------|------|
| ORIGINAL PLAN | SURVEY PLOTTED BY | DATE |
| NO. 1         | DRAWN BY          |      |
|               | DESIGNED BY       |      |
|               | CHECKED BY        |      |

STATE OF HAWAII  
DEPARTMENT OF TRANSPORTATION  
LAND TRANSPORTATION FACILITIES DIVISION

**PLAN**

KAHULUI BEACH RD. INTERSECTION  
IMPROVEMENTS AT KANALOA AVE.  
F.A. PROJ. NO. M-3400(2)

SCALE: AS SHOWN JUNE 1983  
SHEET NO. 4 OF 4 SHEETS