	INDEX TO DRAWINGS
SHEET NO.	DESCRIPTION
1	Title Sheet
2	Typical Section & General
	Notes
3-6	Plan
27 m 17 m	Drainage Details, Plan &
	Profile, General Notes,
	Concrete Collar and Trench
şi .	Details
8	Pavement Markings & Signs
	Summaries
9-10	Cross Sections
11-19	Standard Details
:	Park Control of the C

DEC., 1983 DATE

548-7490 PHONE

NISHIMURA
P. S. & E. BY

HWY-M DESIGNED BY



STATE OF HAWAII


DEPARTMENT OF TRANSPORTATION

HIGHWAYS DIVISION "AS-BUILT"

PLANS OF

## KAHULUI BEACH ROAD, INTERSECTION IMPROVEMENTS AT KANALOA AVENUE F.A. PROJECT NO. M-3400(2)


DISTRICT OF WAILUKU
ISLAND OF MAUI

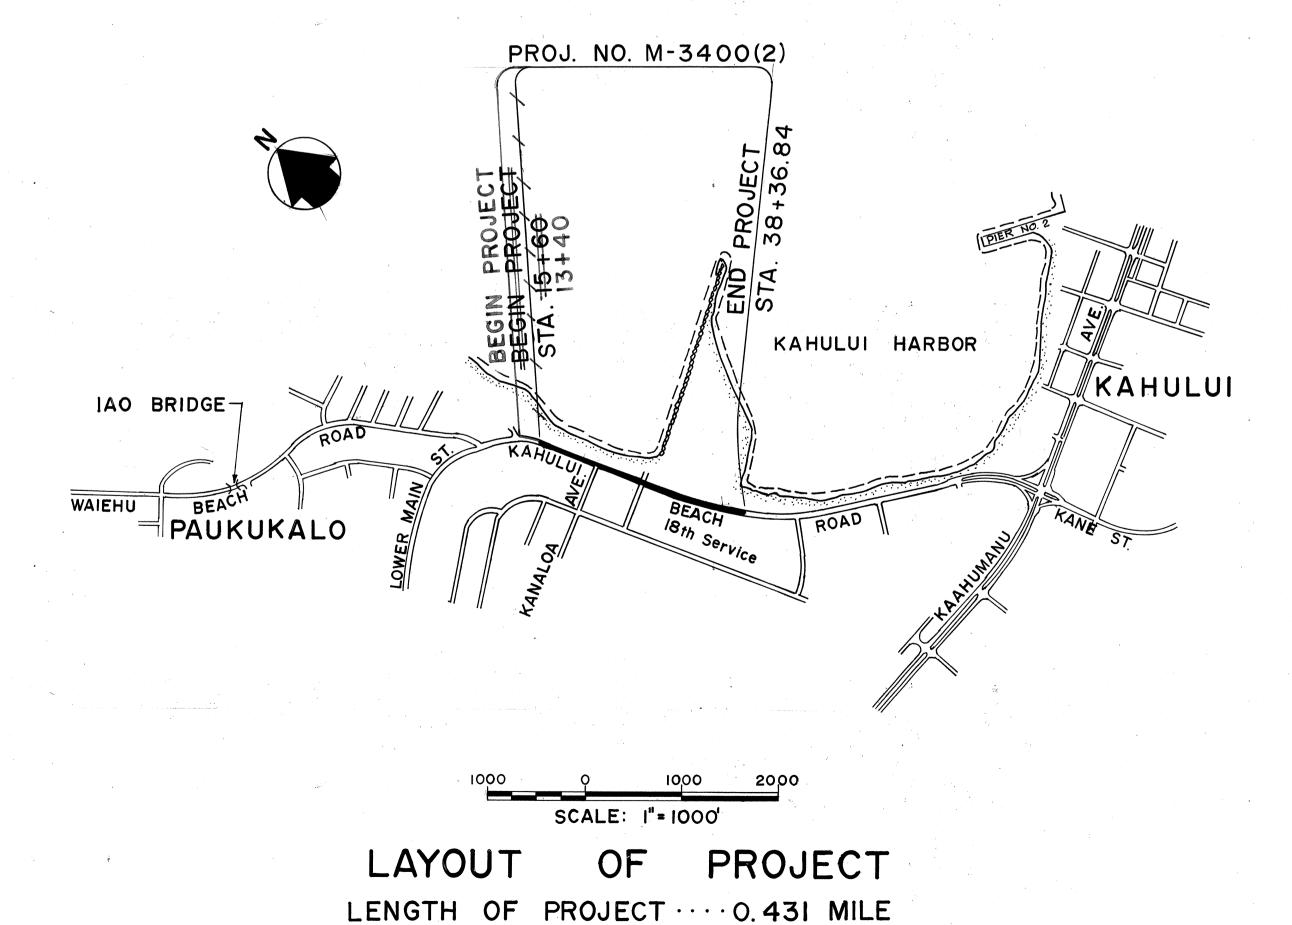

631

FED. ROAD DIST. NO. STATE FED. AID PROJ. NO. FISCAL SHEET NO. SHEETS

HAWAII HAW. M-3400(2) 1984 I 19

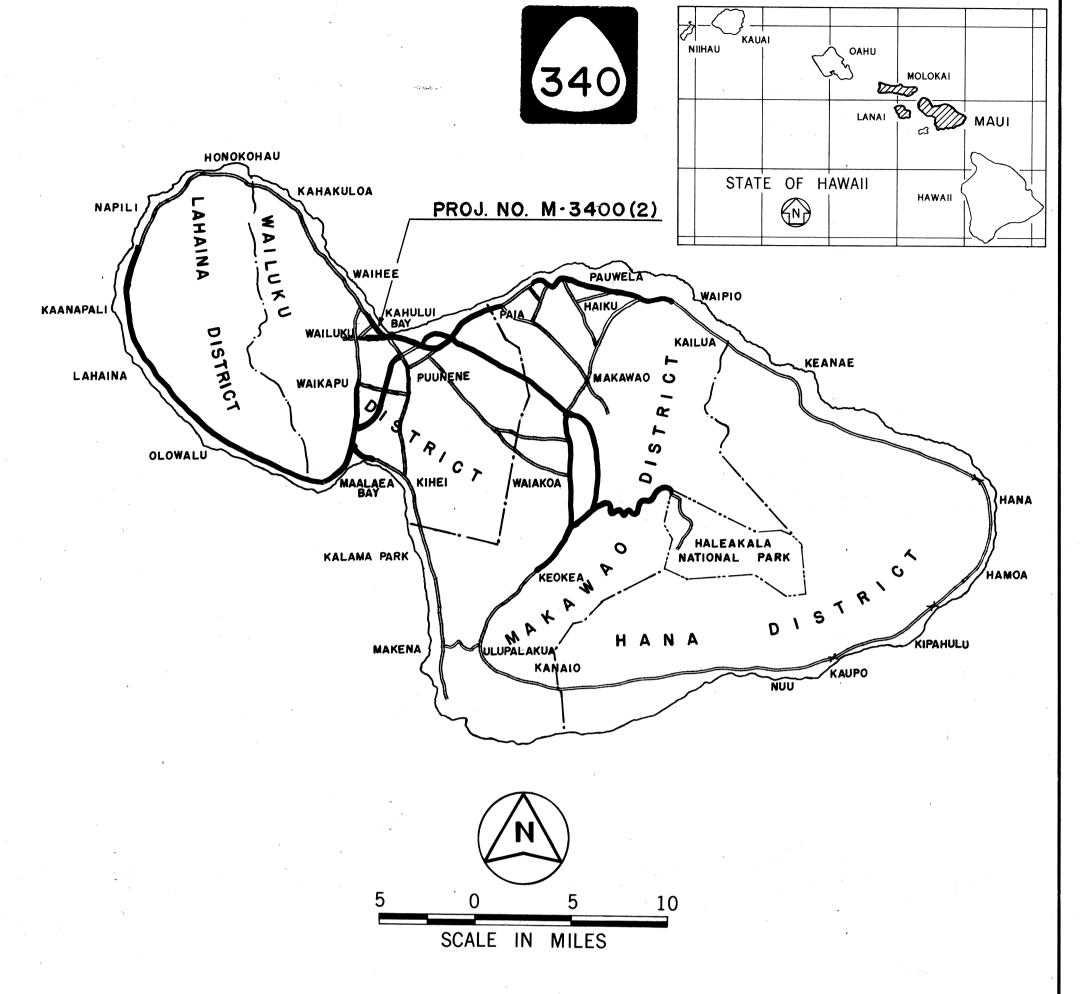

FEDERAL AID PROJECTS PREVIOUSLY CONSTRUCTED OR UNDER CONSTRUCTION

## DESIGN DESIGNATION

CHANGES MADE DURING CONSTRUCTION HAVE BEEN INCORPORATED ON THESE PLANS EXCEPT CHANGES IN THE ORIGINAL THEORETICAL QUANTITIES. FOR ACTUAL QUANTITIES, REFER TO PROJECT LEDGER AND/OR COMPUTATION BOOK.

Cary Garrashita RESUDENT ENGINEER

9-1-84 DATE

DEPARTMENT OF TRANSPORTATION
FEDERAL HIGHWAY ADMINISTRATION

APPROVED:

| 12/22/83 |
| JUNISION ADMINISTRATOR DATE

DEPARTMENT OF TRANSPORTATION
STATE OF HAWAII

APPROVED:

Charyl D Foon 12/20/83

JOIN. OF TRANSPORTATION DATE