



FED. ROAD DIST. NO.	STATE	FED. AID PROJ. NO.	FISCAL YEAR	SHEET NO.	TOTAL SHEETS
HAWAII	HAW.	M-3400(2)	1984	2	19

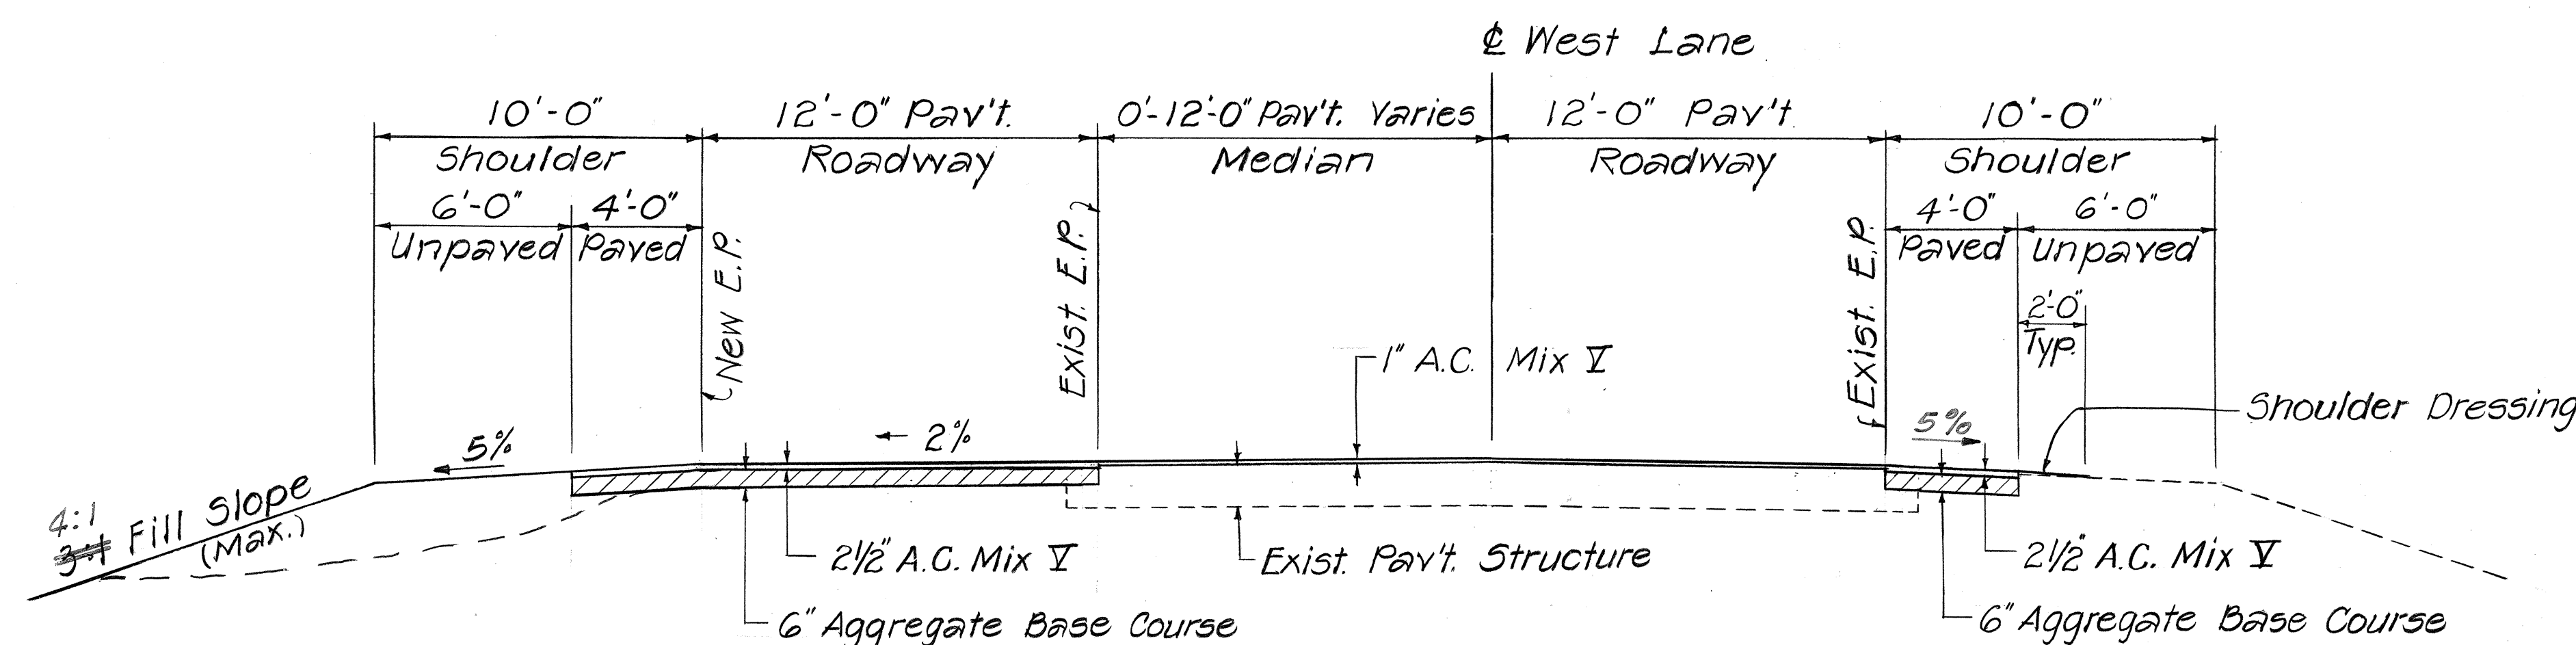


TYPICAL SECTION ON TANGENT

Scale: 1/4" = 1'-0"

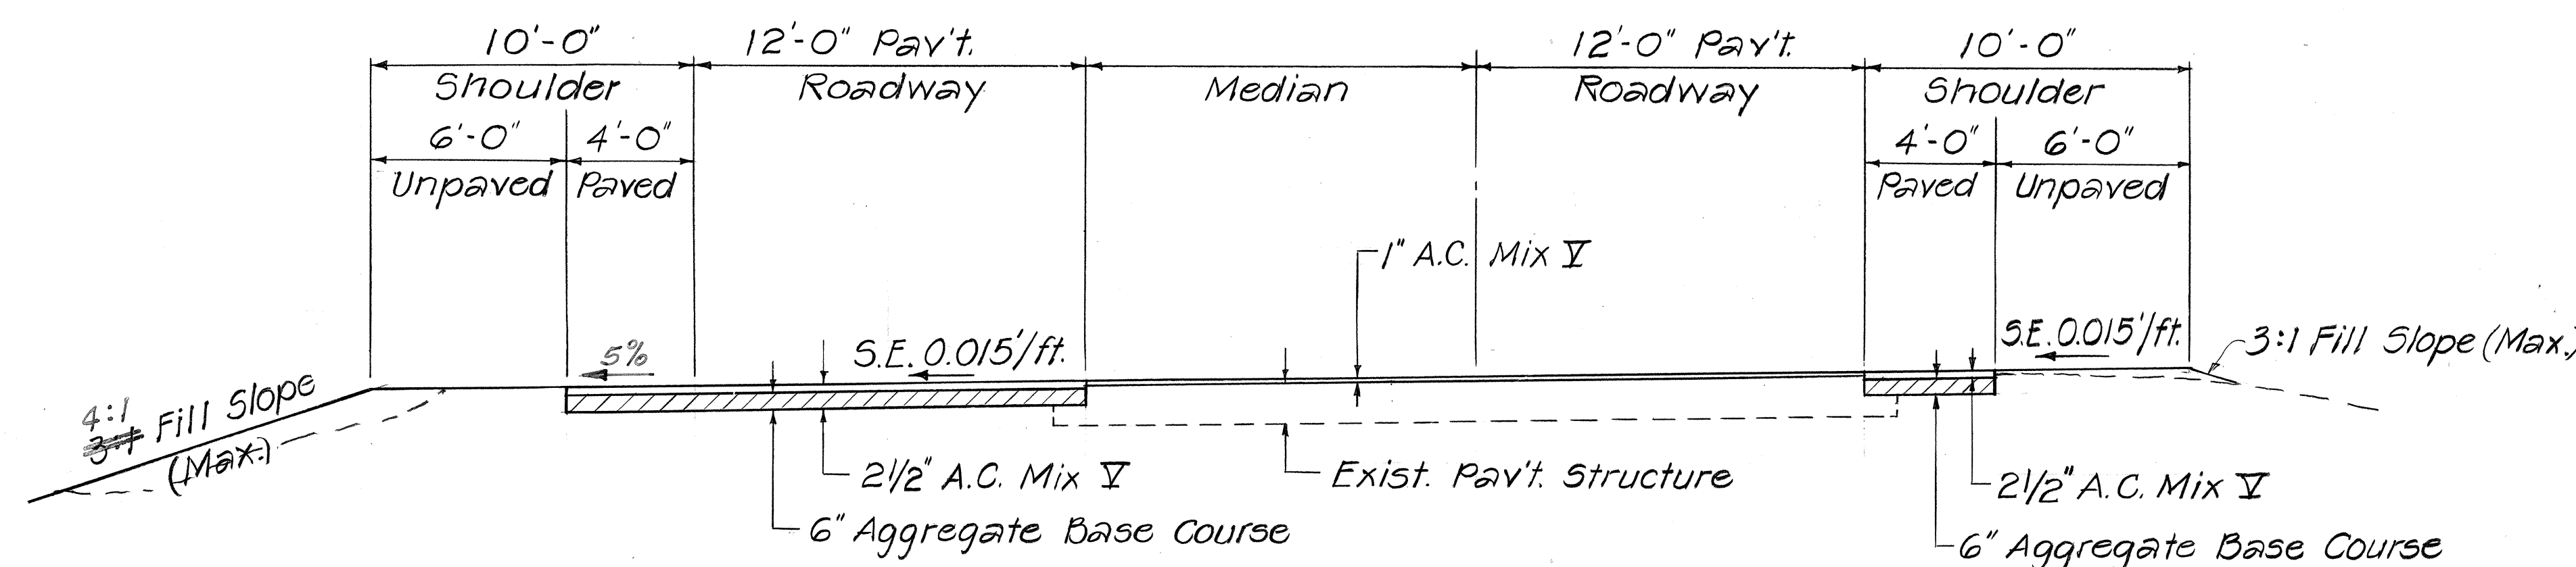

TYPICAL SECTION ON CURVE

Scale: 1/4" = 1'-0"

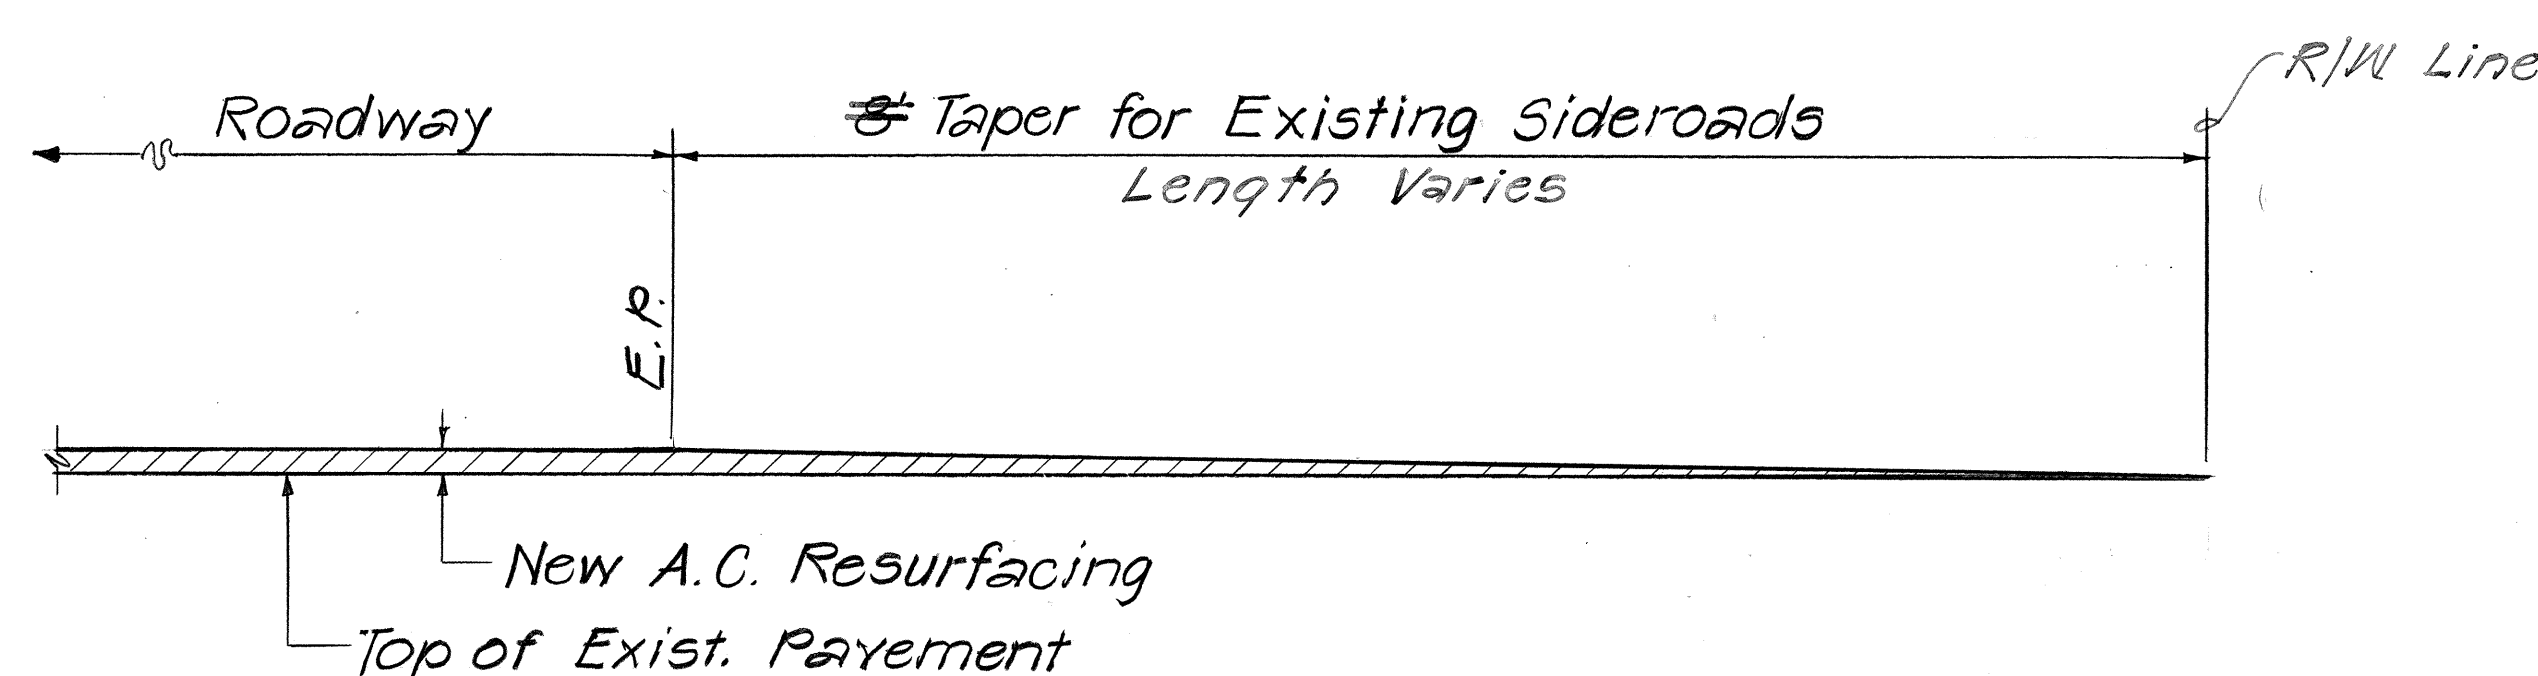

TYPICAL SECTION OF SIDEROAD CONNECTION

Scale: 1" = 1'-0"

GENERAL NOTES

- The scope of work for this project consists of widening the existing travel way to accommodate left turn lanes, construction of four feet wide stabilized shoulders, construction of embankment, base course, asphalt concrete pavement, resurfacing of existing roadway, adjusting survey monuments, installing pavement markers, striping, signs, and reflector markers, extension of culverts, construction of culvert headwalls.
- Elevations of culverts and grades to be verified by contractor.
- Contractor shall saw cut the existing edge of pavement prior to construction of extra lane or pavement widening. Saw cutting shall be considered incidental to item no. 401.0500, A.C. Pavement Mix No. V.
- Smooth riding connections shall be constructed at the beginning and the end of the project, at all connecting approaches, and at the widening. Payment for this work shall be made under item no. 401.0500, A.C. Pavement Mix No. V.
- The contractor's attention is directed to subsection 104.04 of the Standard Specifications concerning maintenance of traffic and Section 645 of the Special Provisions concerning Traffic Control.
- Before resurfacing, the contractor shall remove and dispose of existing raised pavement markers. This work shall be considered incidental to item no. 401.0500, A.C. Pavement Mix No. V.
- All construction signs shall be left in place until all construction items are completed.
- Stop Lines shall be paid under item no. 629.1010, Pavement Striping (Paint). Final placement of new stop bars shall be approved by the Engineer.
- All pavement striping shall be paint. All pavement markings shall meet the requirements of subsection 708.06 of the Standard Specifications.
- Dressing of shoulder shall be considered incidental to Item No. 203.0100 Imported Borrow.

DATE	_____
SURVEY PLOTTED BY	_____
DRAWN BY	_____
TRACED BY	_____
DESIGNED BY	_____
CHECKED BY	_____
ORIGINAL PLAN	_____
NOTE BOOK	_____
No.	_____

STATE OF HAWAII DEPARTMENT OF TRANSPORTATION LAND TRANSPORTATION FACILITIES DIVISION
TYPICAL SECTIONS & GEN. NOTES
KAHULUI BEACH RD. INTERSECTION IMPROVEMENTS AT KANALOA AVE. F.A. PROJ. NO. M-3400(2)
SCALE: AS SHOWN OCT. 1983
SHEET NO. 1 OF 1 SHEETS