
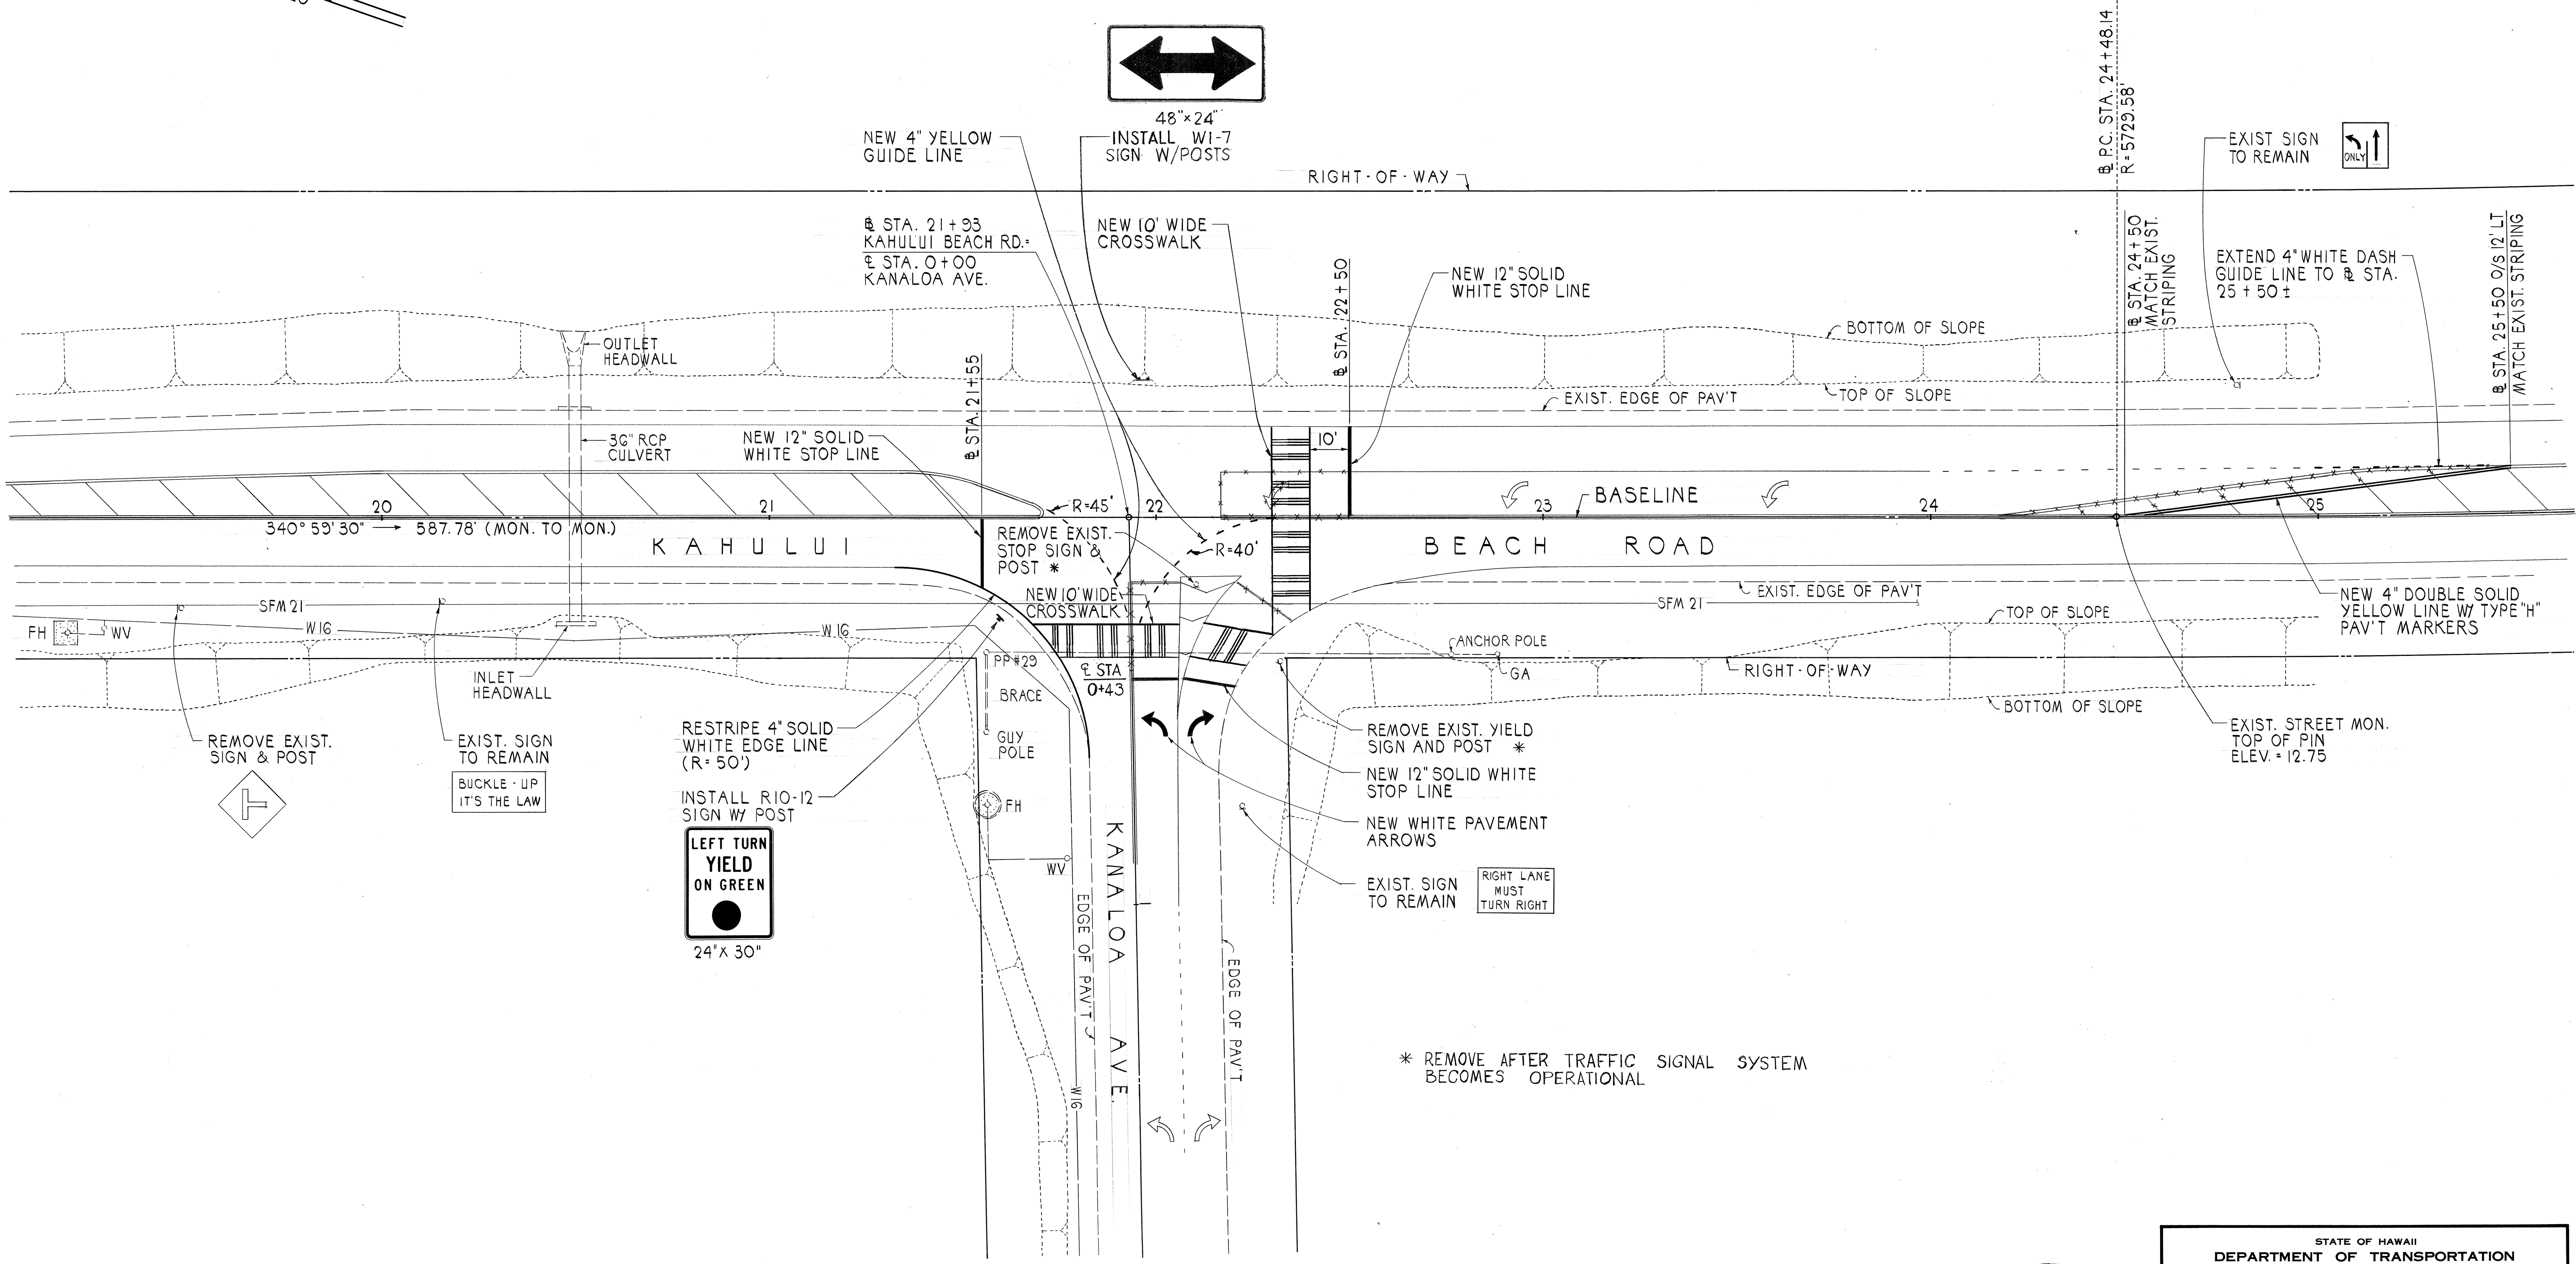



FED. ROAD DIST. NO.	STATE	FED. AID PROJ. NO.	FISCAL YEAR	SHEET NO.	TOTAL SHEETS
HAWAII	HAW.	MG-3400 (4)	1989	4	6

TRUE NORTH
SCALE: 1"=20'

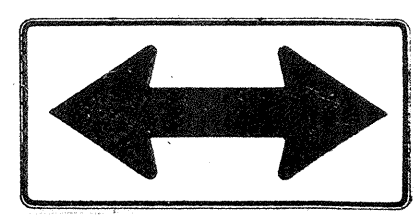

* REMOVE AFTER TRAFFIC SIGNAL SYSTEM BECOMES OPERATIONAL

DATE	
SURVEY PLOTTED BY	
DRAWN BY	
DESIGNED BY	
QUANTITIES BY	
CHECKED BY	
NOTE BOOK	
No.	

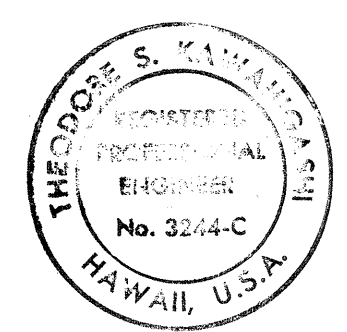

THIS WORK WAS PREPARED BY ME
OR UNDER MY SUPERVISION
Theodore S. Kawachi

STATE OF HAWAII
DEPARTMENT OF TRANSPORTATION
HIGHWAYS DIVISION

GEOMETRICS AND STRIPING PLAN

KAHULUI BEACH ROAD
TRAFFIC SIGNALS AT KANALOA AVENUE
FA PROJECT NO. MG-3400 (4)

SCALE: AS NOTED
DATE: 8/88

SHEET NO. 4 OF 6 SHEETS