	,
	INDEX TO DRAWINGS
SHEET NO.	DESCRIPTION
ı	TITLE SHEET
2	STANDARD PLAN SUMMARY
3	LEGEND AND NOTES
4	GEOMETRICS AND STRIPING PLAN
<b>₩</b> 5	TRAFFIC SIGNAL PLAN
6	LOOP DETECTOR DETAILS
•	
	-
1	

₩ NOTE:

PLAN SHEET NO.5R ADDED DURING "AS-BUILT" POSTING. STATE OF HAWAII


DEPARTMENT OF TRANSPORTATION
HIGHWAYS DIVISION
"AS-BUILT"
PLANS FOR


KAHULUI BEACH ROAD

TRAFFIC SIGNALS AT KANALOA AVENUE

F.A. PROJECT NO. MG.-3400 (4)

DISTRICT OF WAILUKU
ISLAND OF MAUI

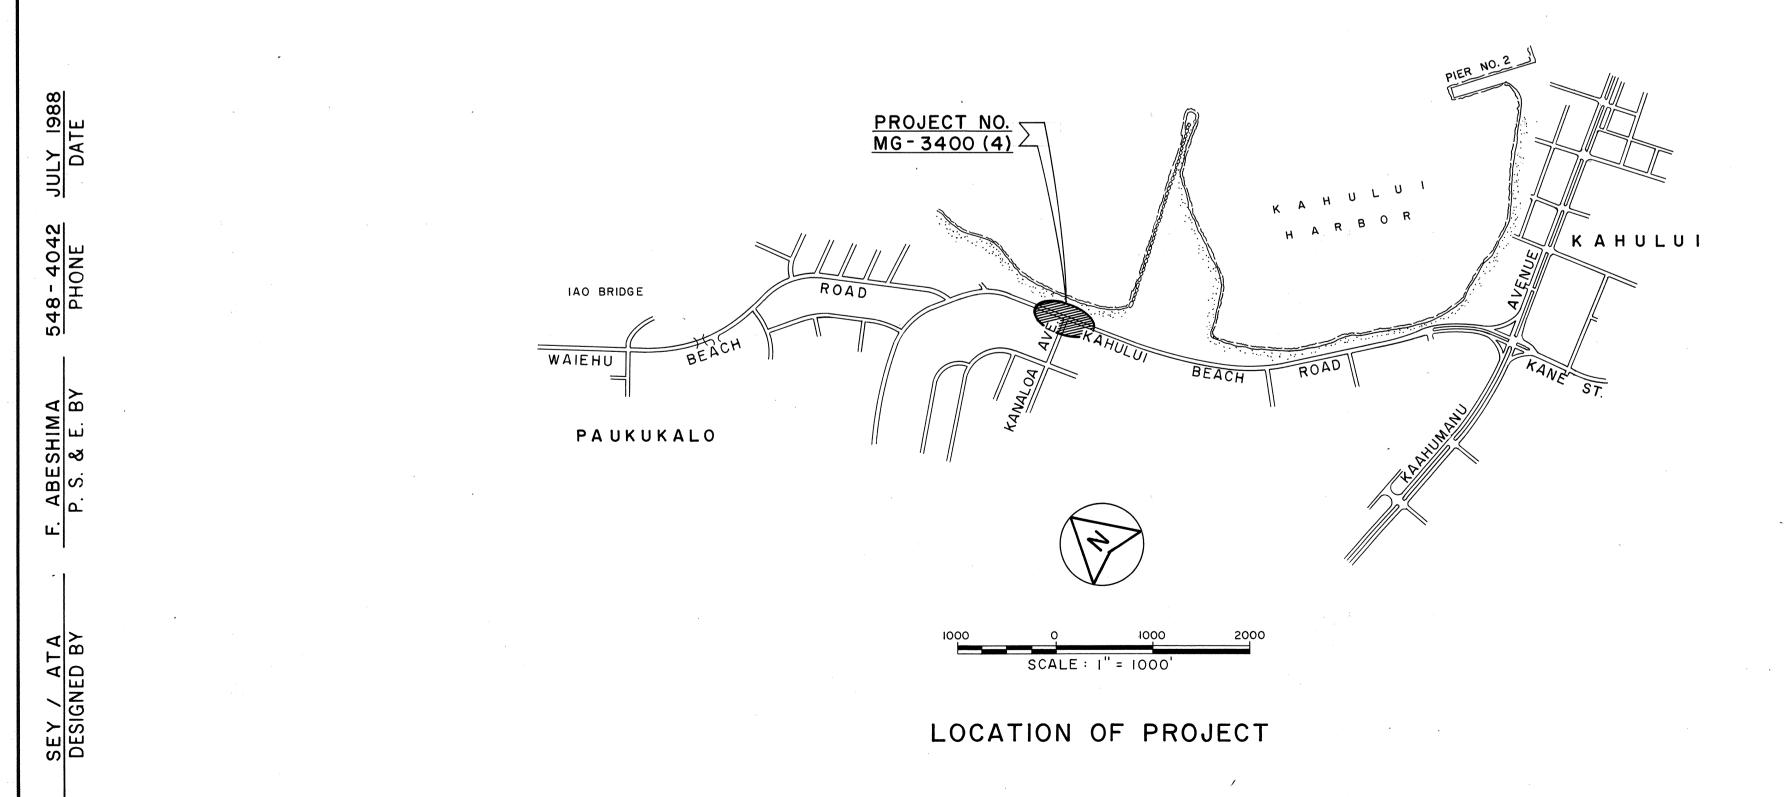

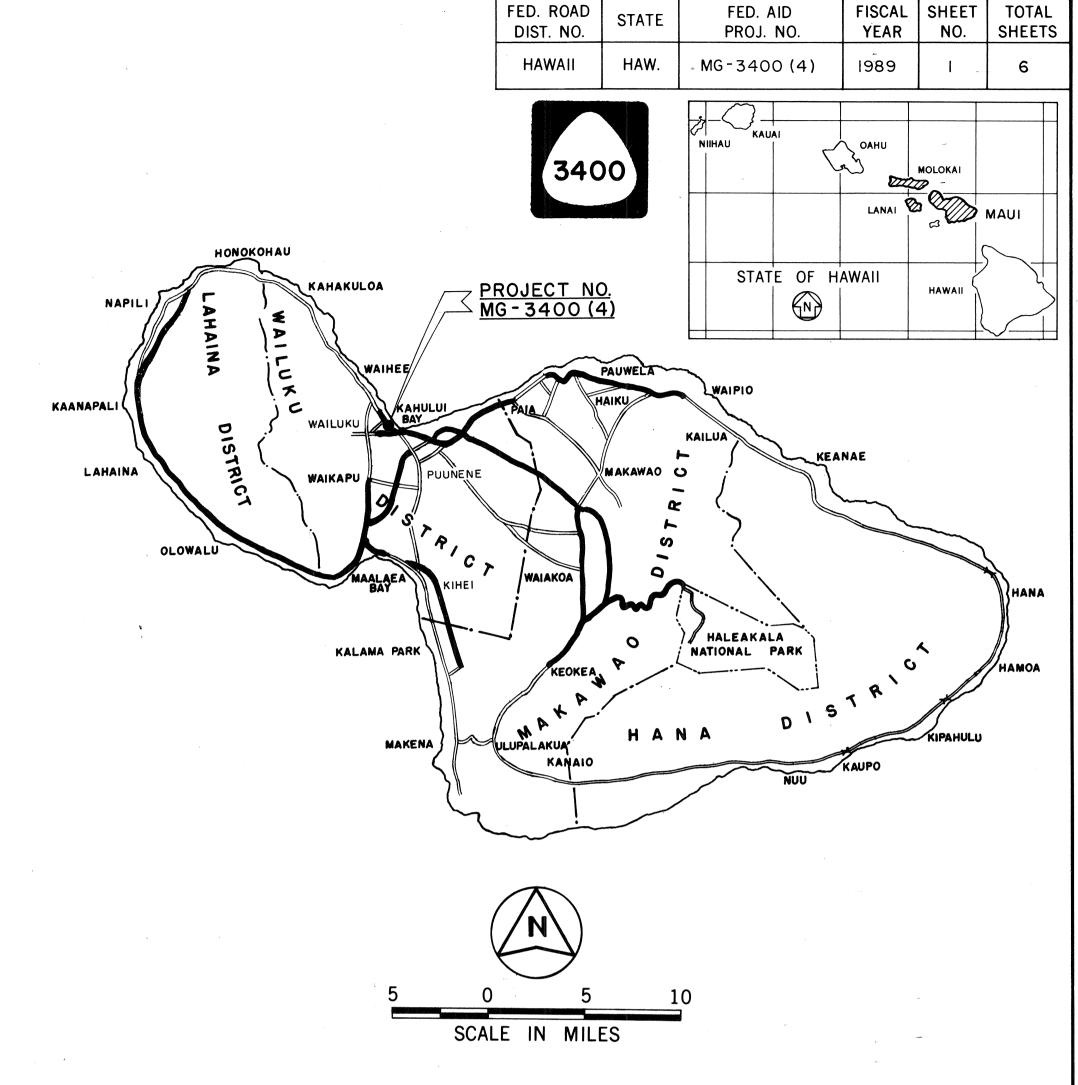

FEDERAL AID PROJECTS PREVIOUSLY CONSTRUCTED OR UNDER CONSTRUCTION

CHANGES MADE DURING CONSTRUCTION HAVE BEEN INCORPORATED ON THESE PLANS EXCEPT CHANGES IN THE ORIGINAL THEORETICAL QUANTITIES. FOR ACTUAL QUANTITIES, REFER TO PROJECT LEDGER AND/OR COMPUTATION BOOK.

RESIDENT ENGINEER DATE

DEPARTMENT OF TRANSPORTATION
FEDERAL HIGHWAY ADMINISTRATION
APPROVED:

| Julian | 9/23/88 |
| DIVISION ADMINISTRATOR DATE

DEPARTMENT OF TRANSPORTATION
STATE OF HAWAII

APPROVED:

| Making 9/15/88

DIR. OF TRANSPORTATION DATE