
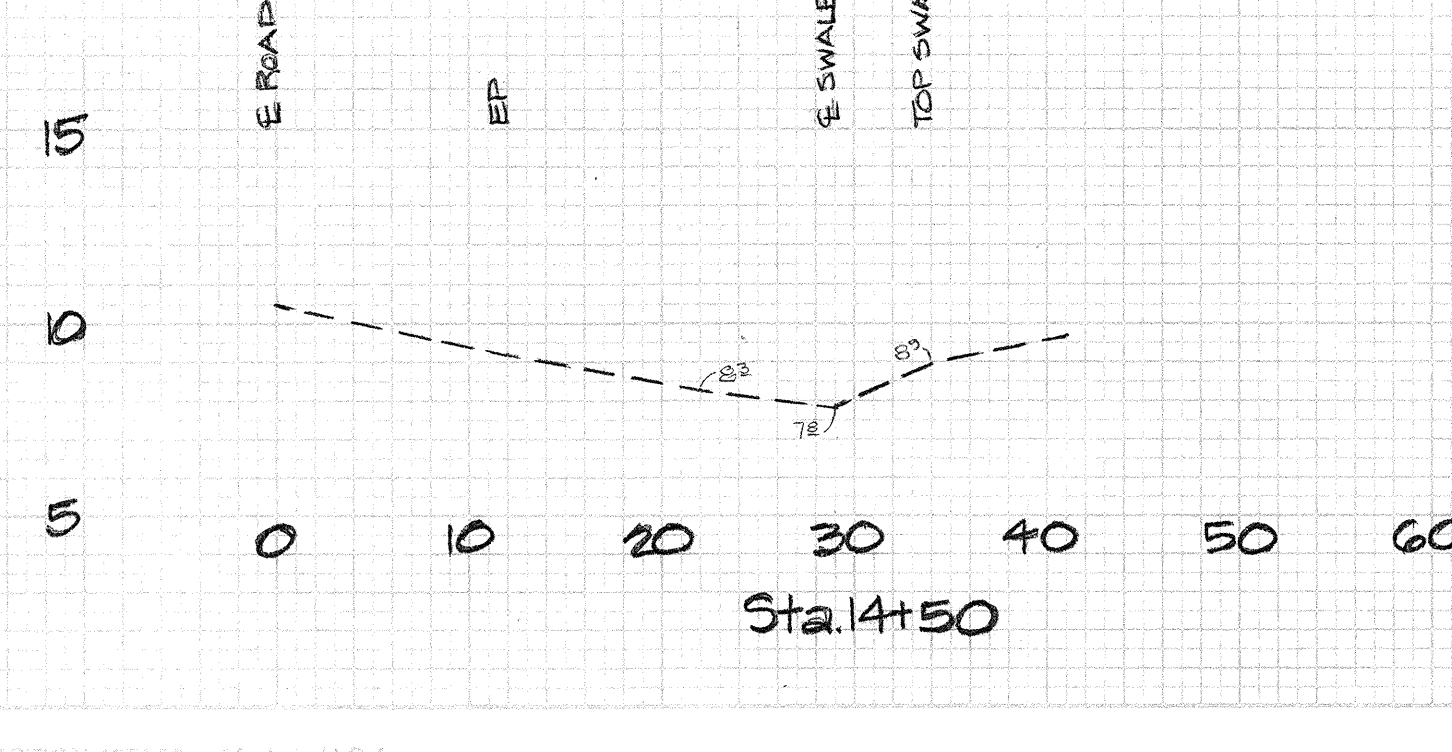
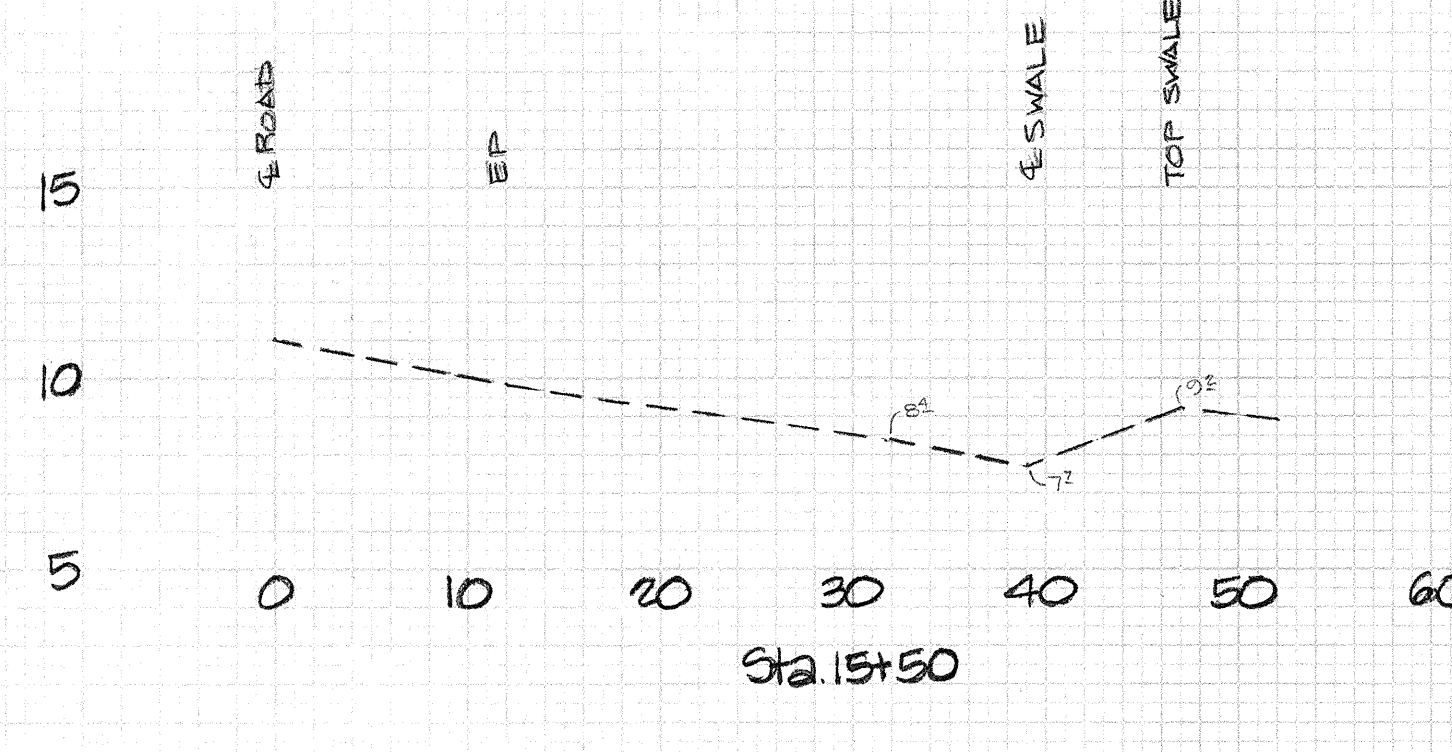
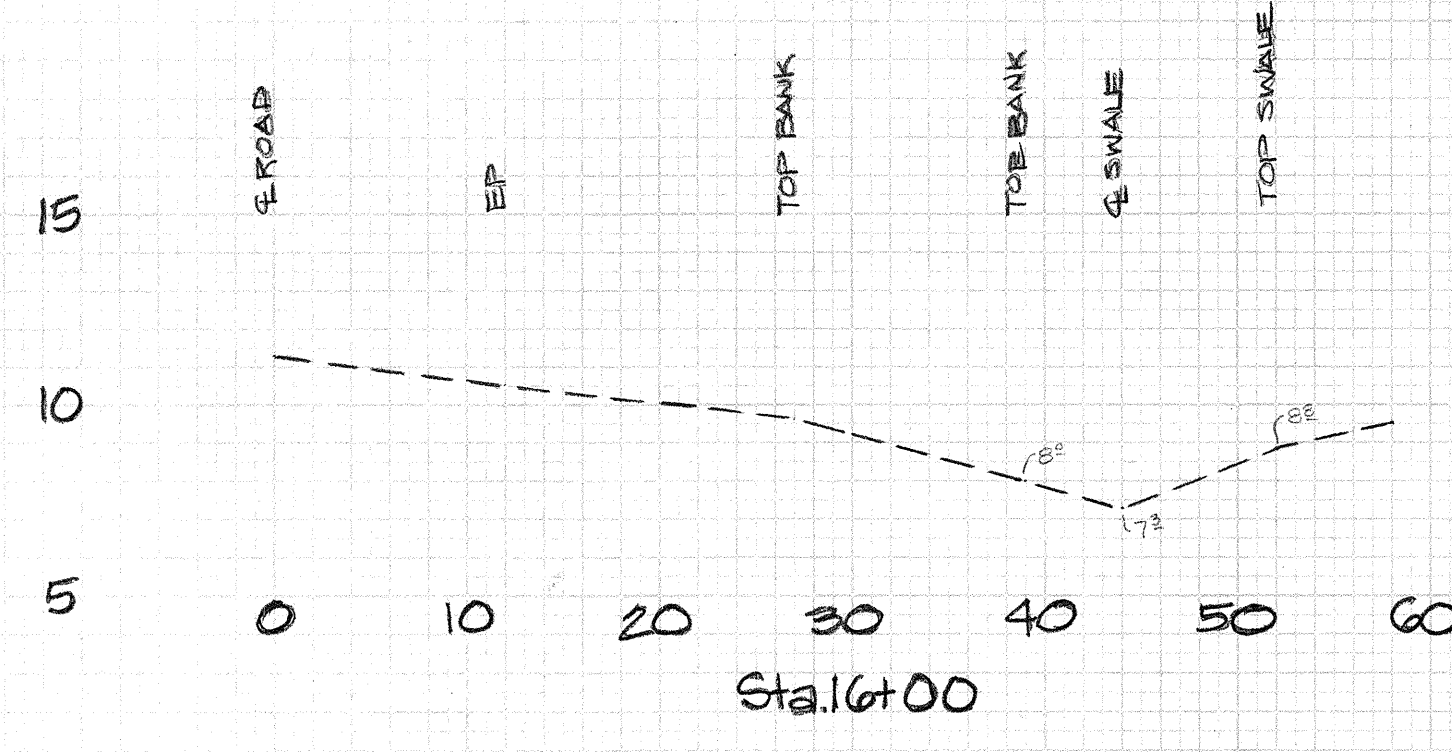
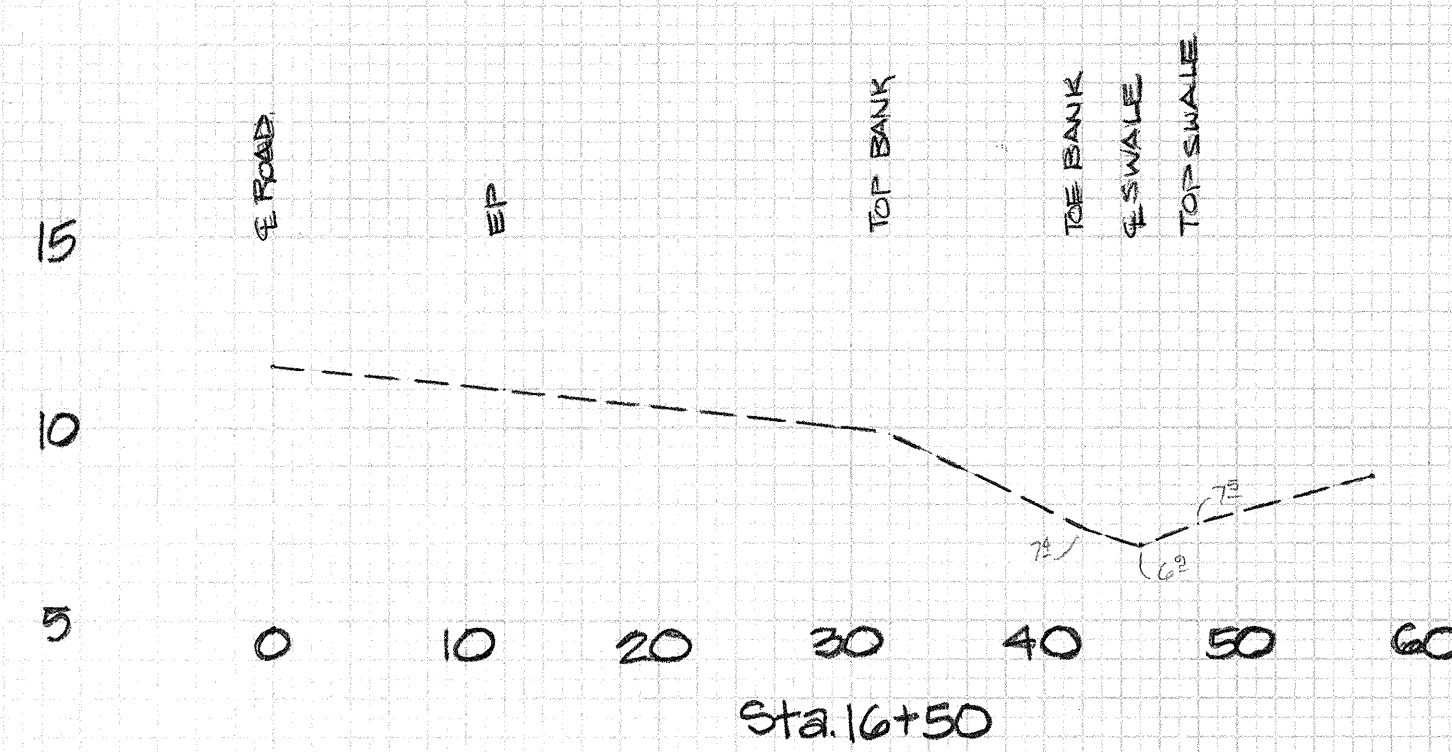
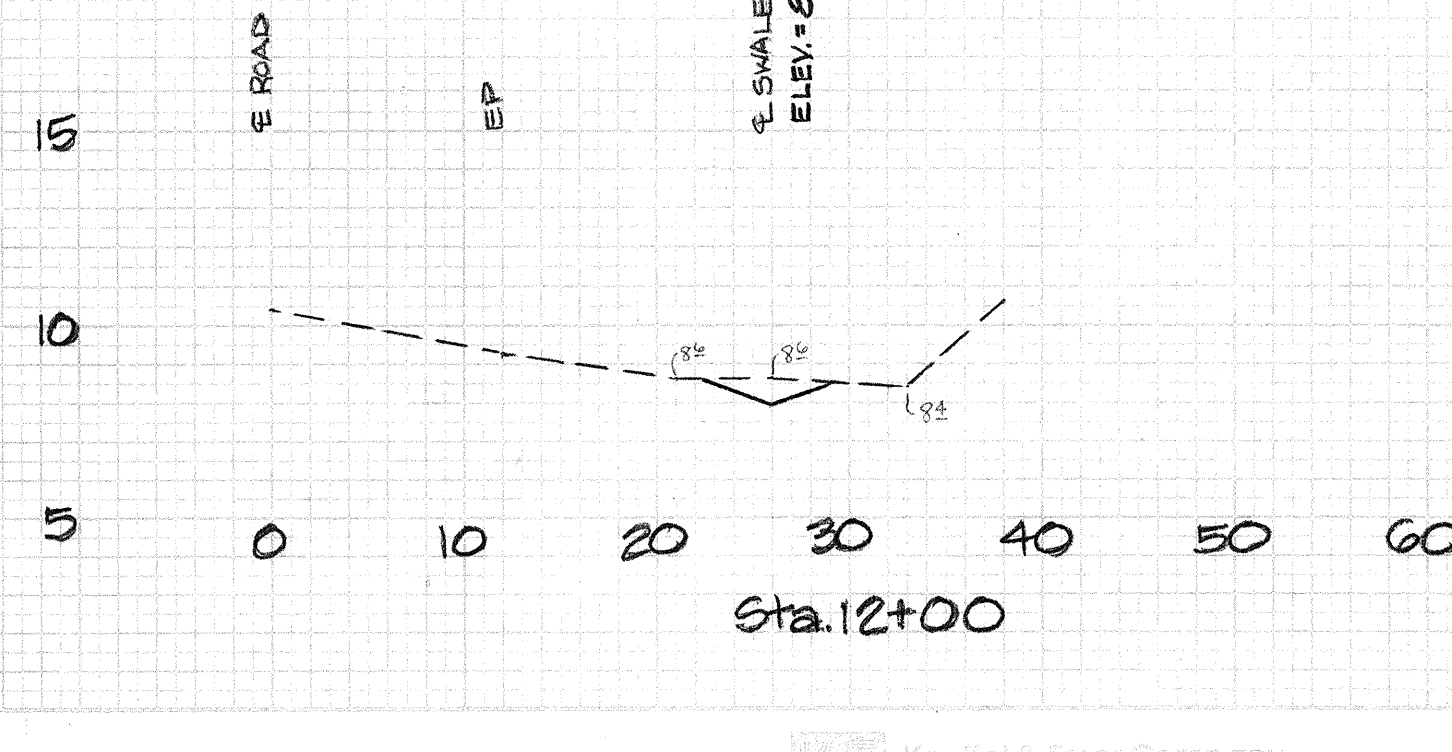
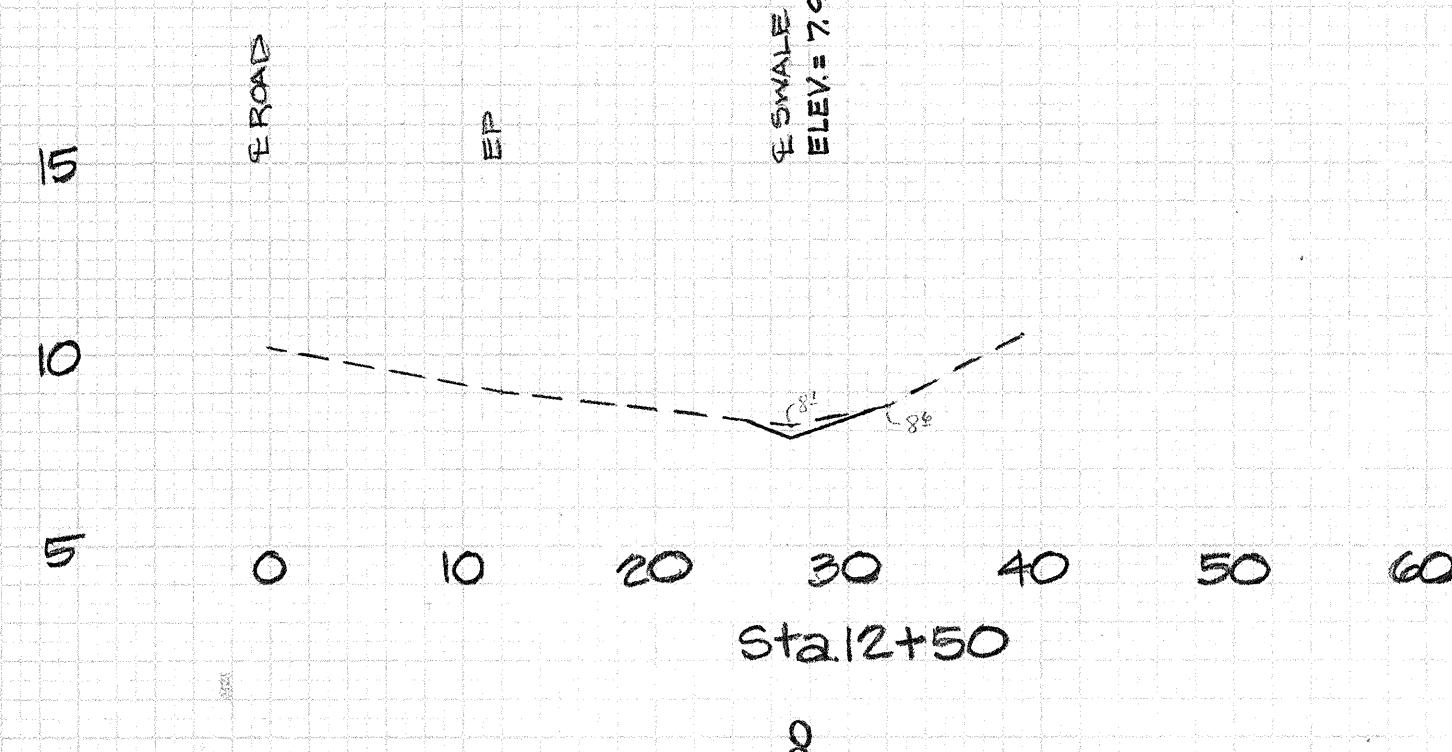
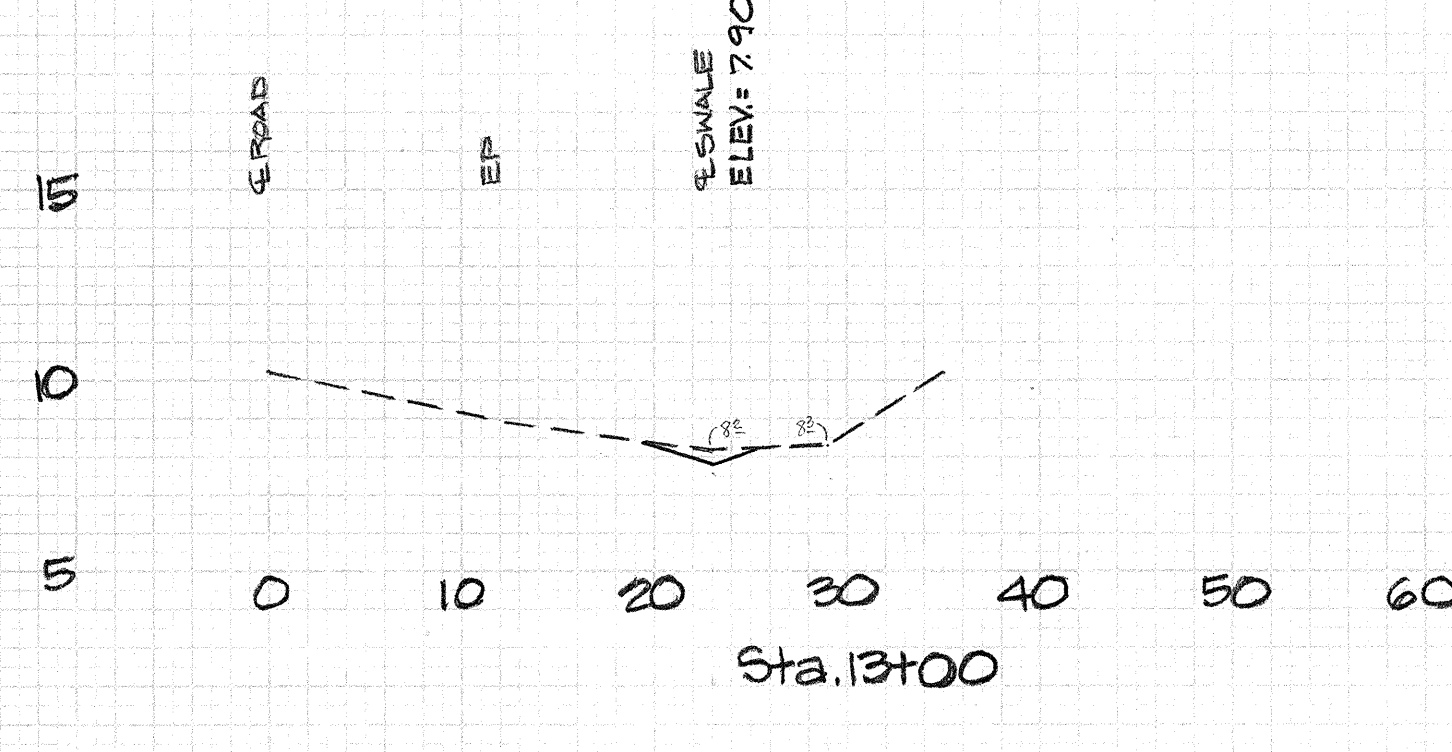
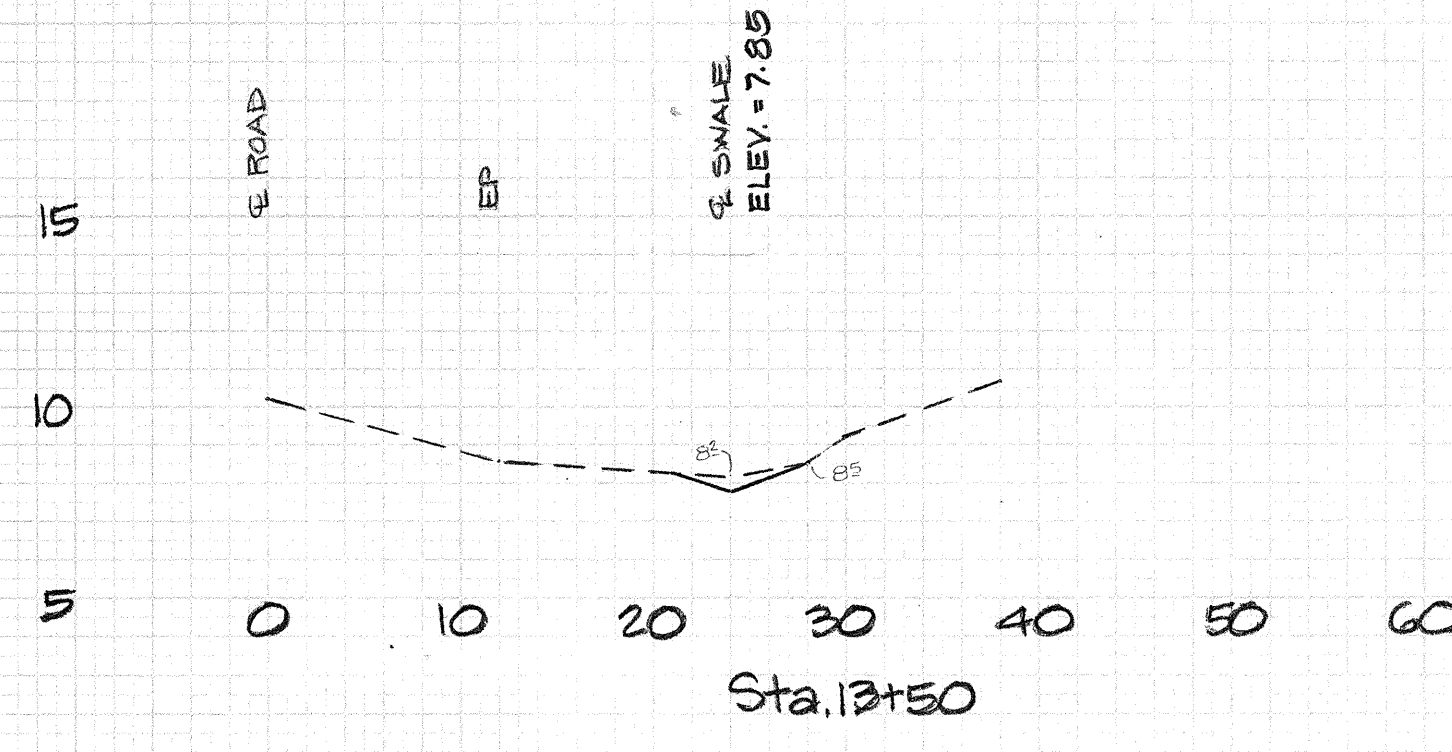
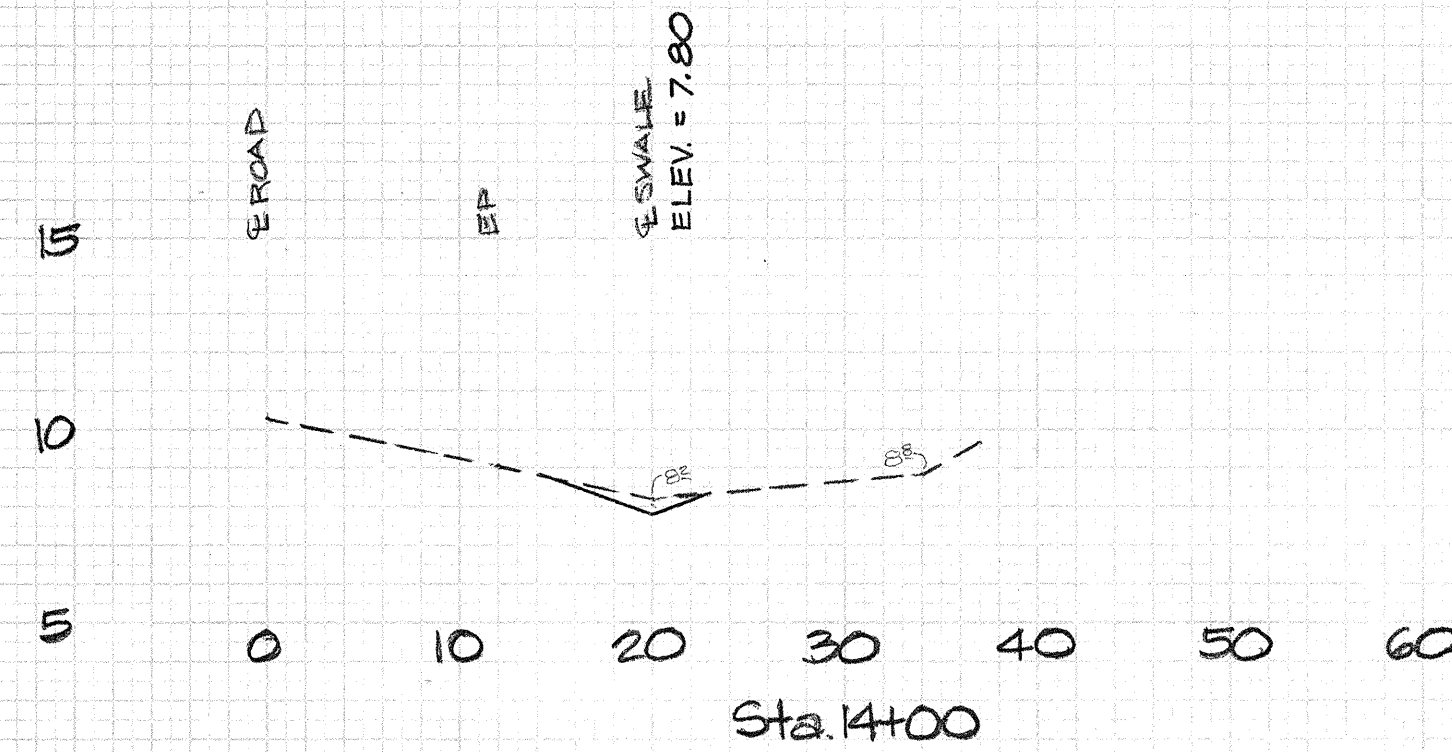
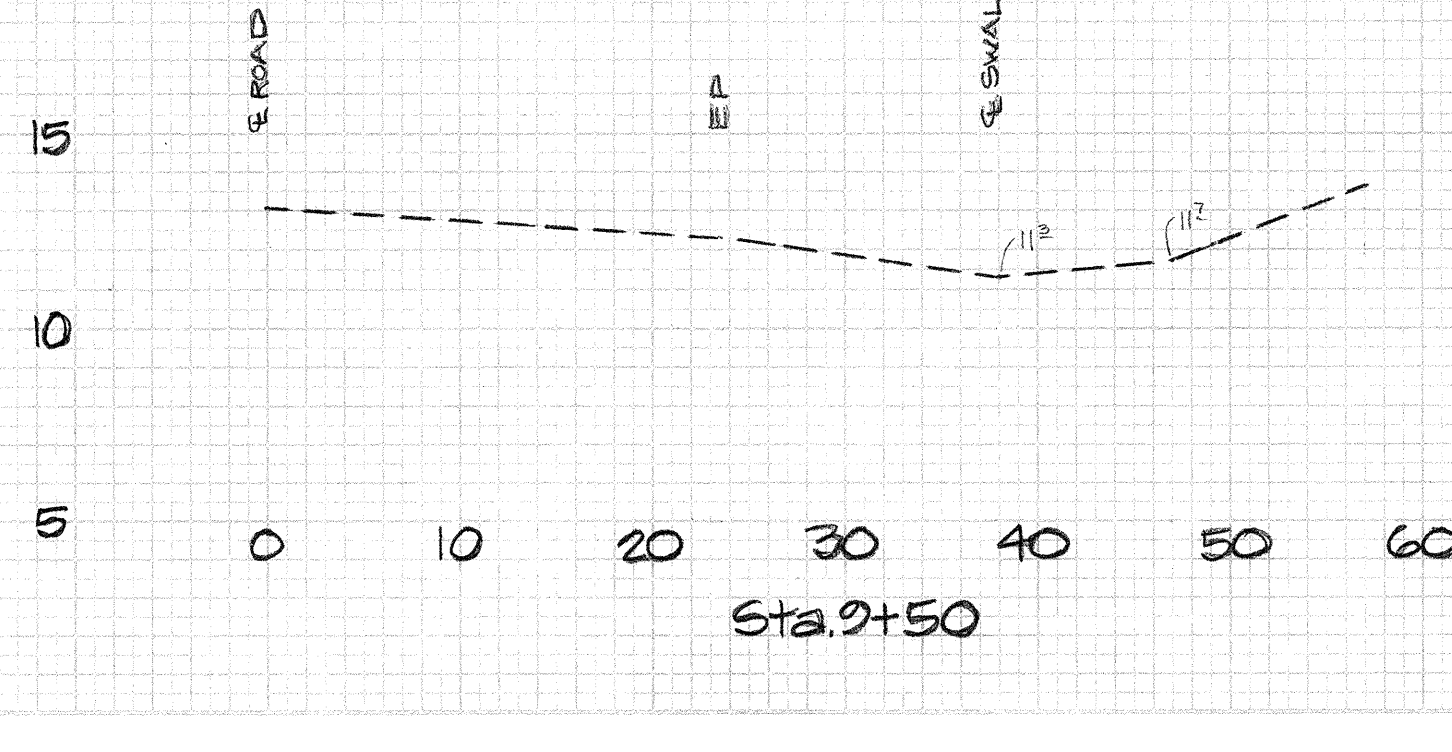
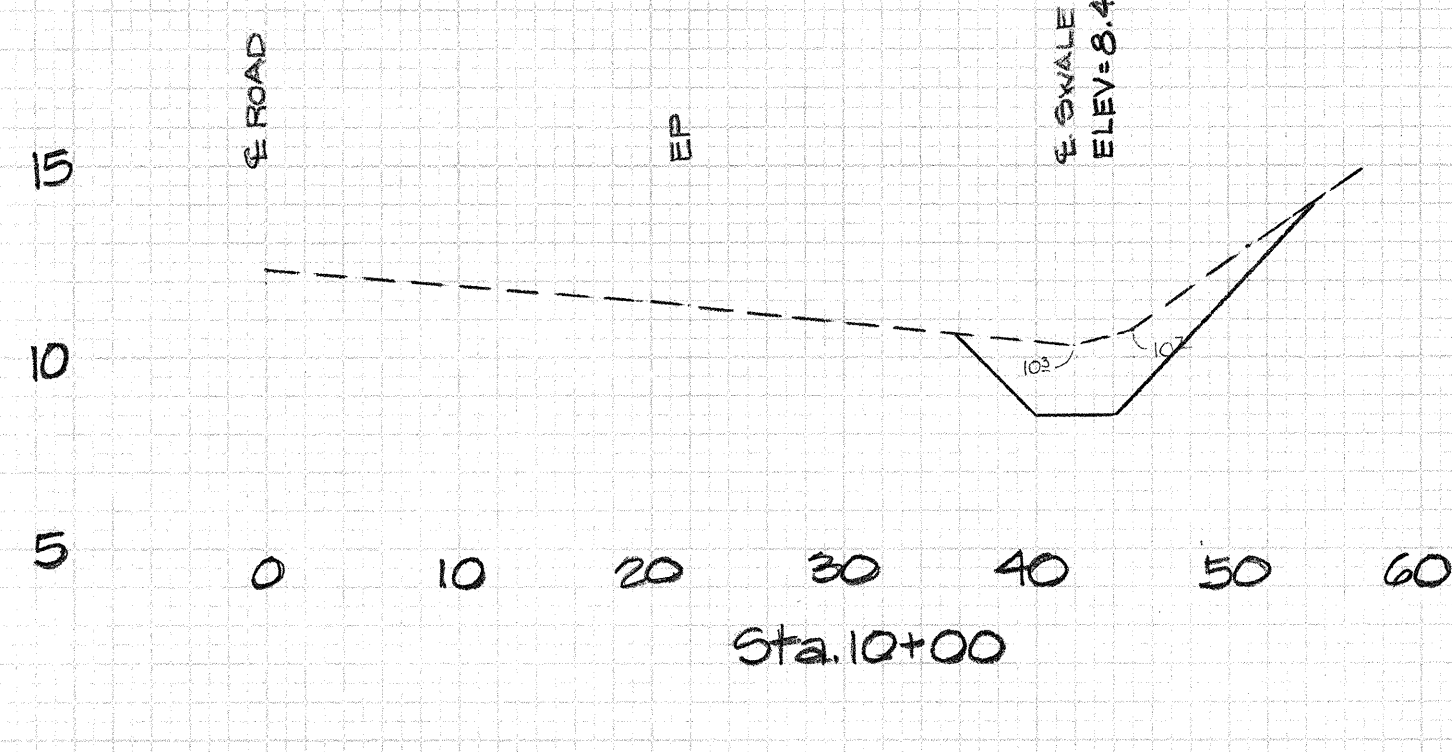
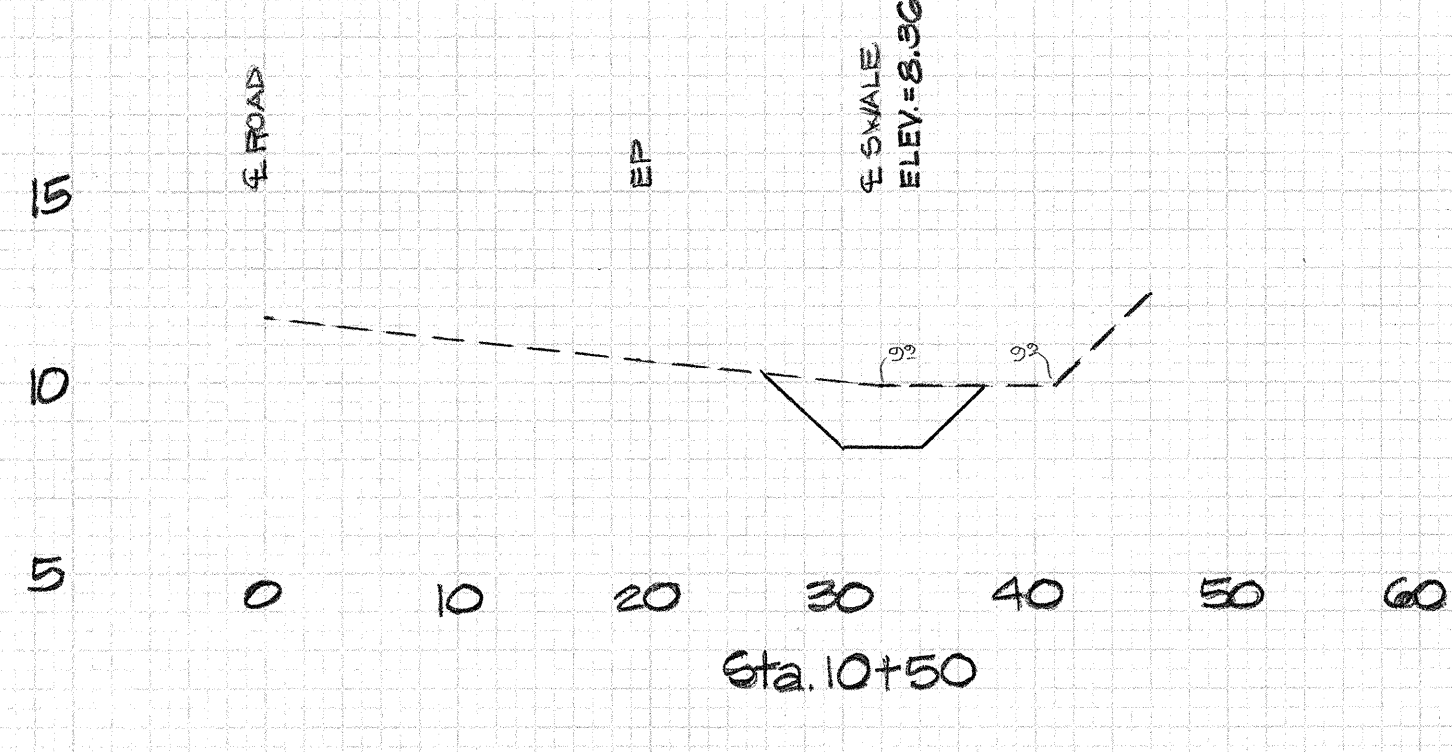
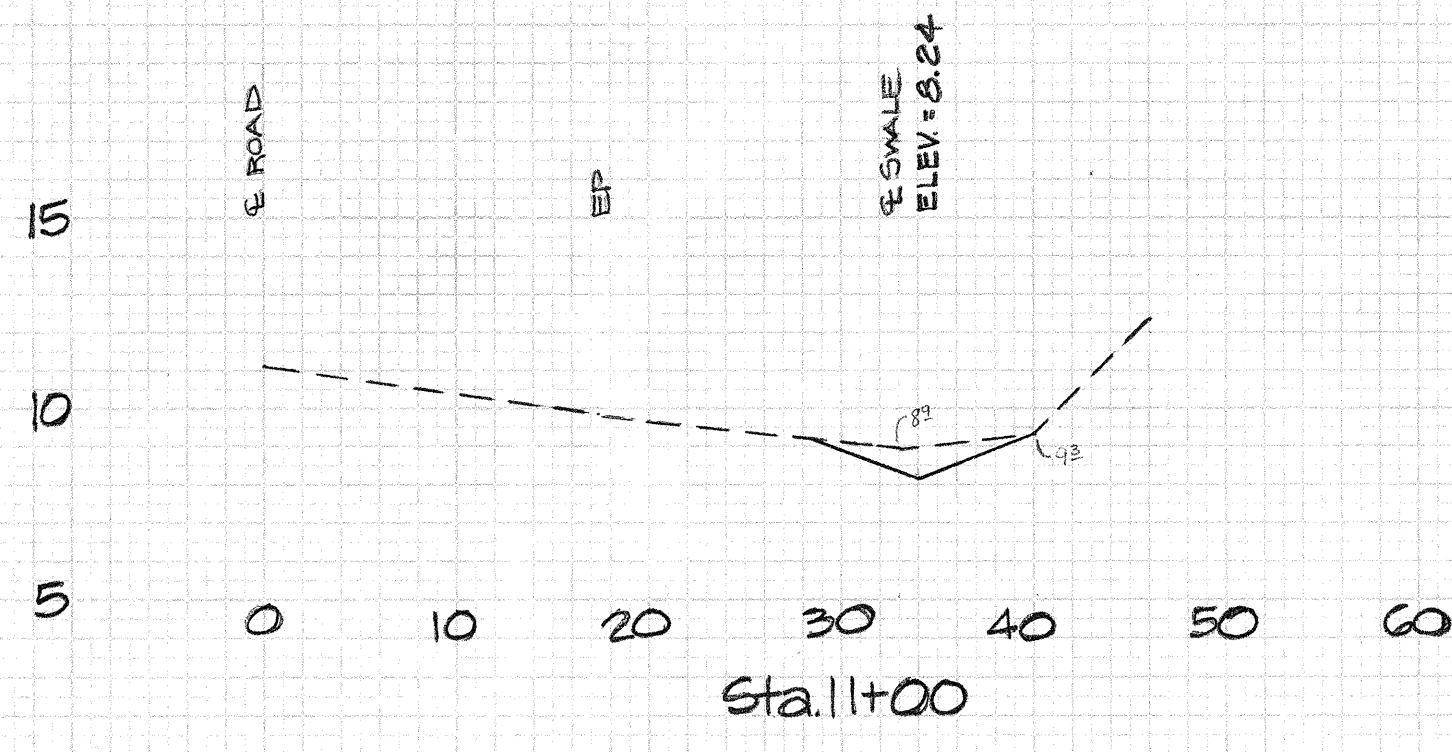


| FED. ROAD DIST. NO. | STATE | FED. AID PROJ. NO. | FISCAL YEAR | SHEET NO. | TOTAL SHEETS |
|---------------------|-------|--------------------|-------------|-----------|--------------|
| HAWAII              | HAW.  | M-3400(3)          | 1969        | 8         | 9            |

| DATE | BY | CHKD. |
|------|----|-------|
|      |    |       |

| DATE | BY | CHKD. |
|------|----|-------|
|      |    |       |

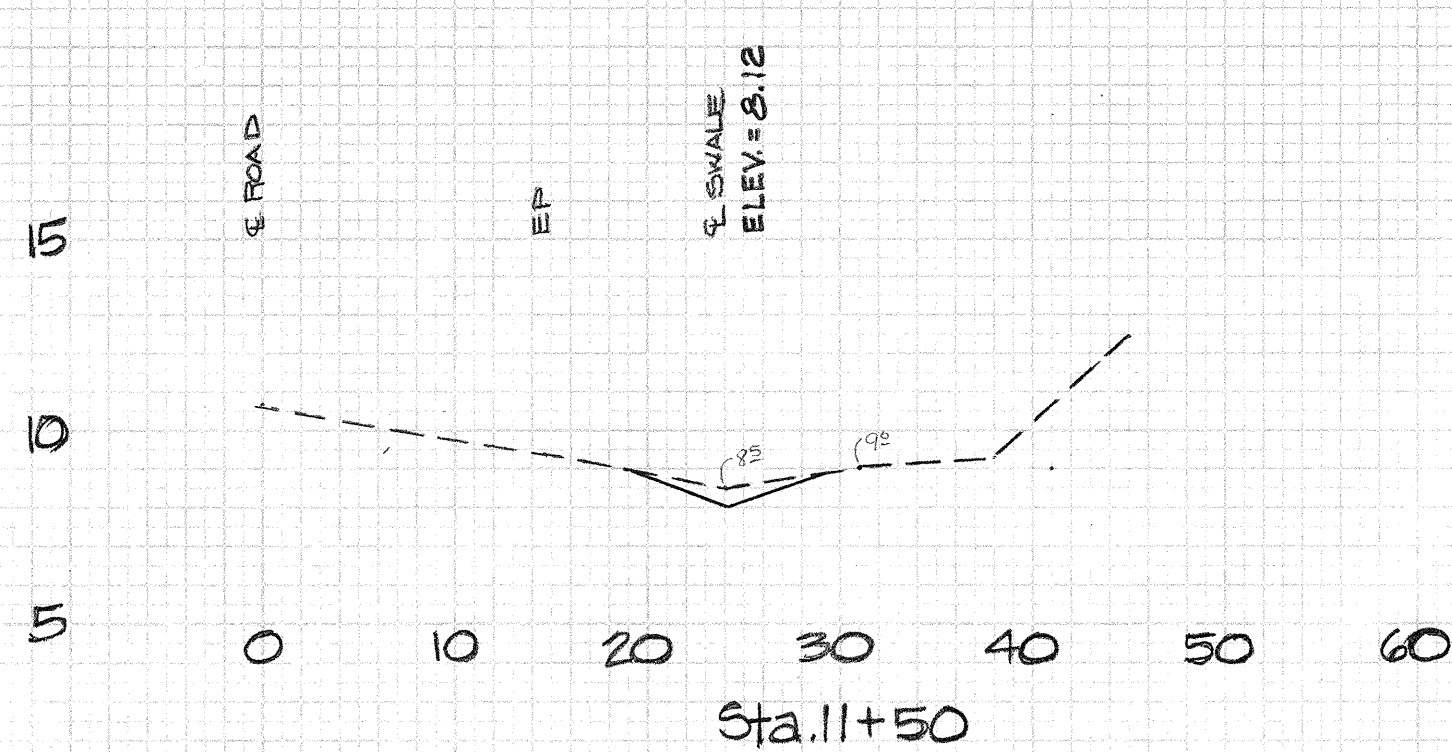

SHEET 1 of 1  
 SCALE: HOR : 1" = 10'-0"  
 VERT : 1" = 5'-0"