



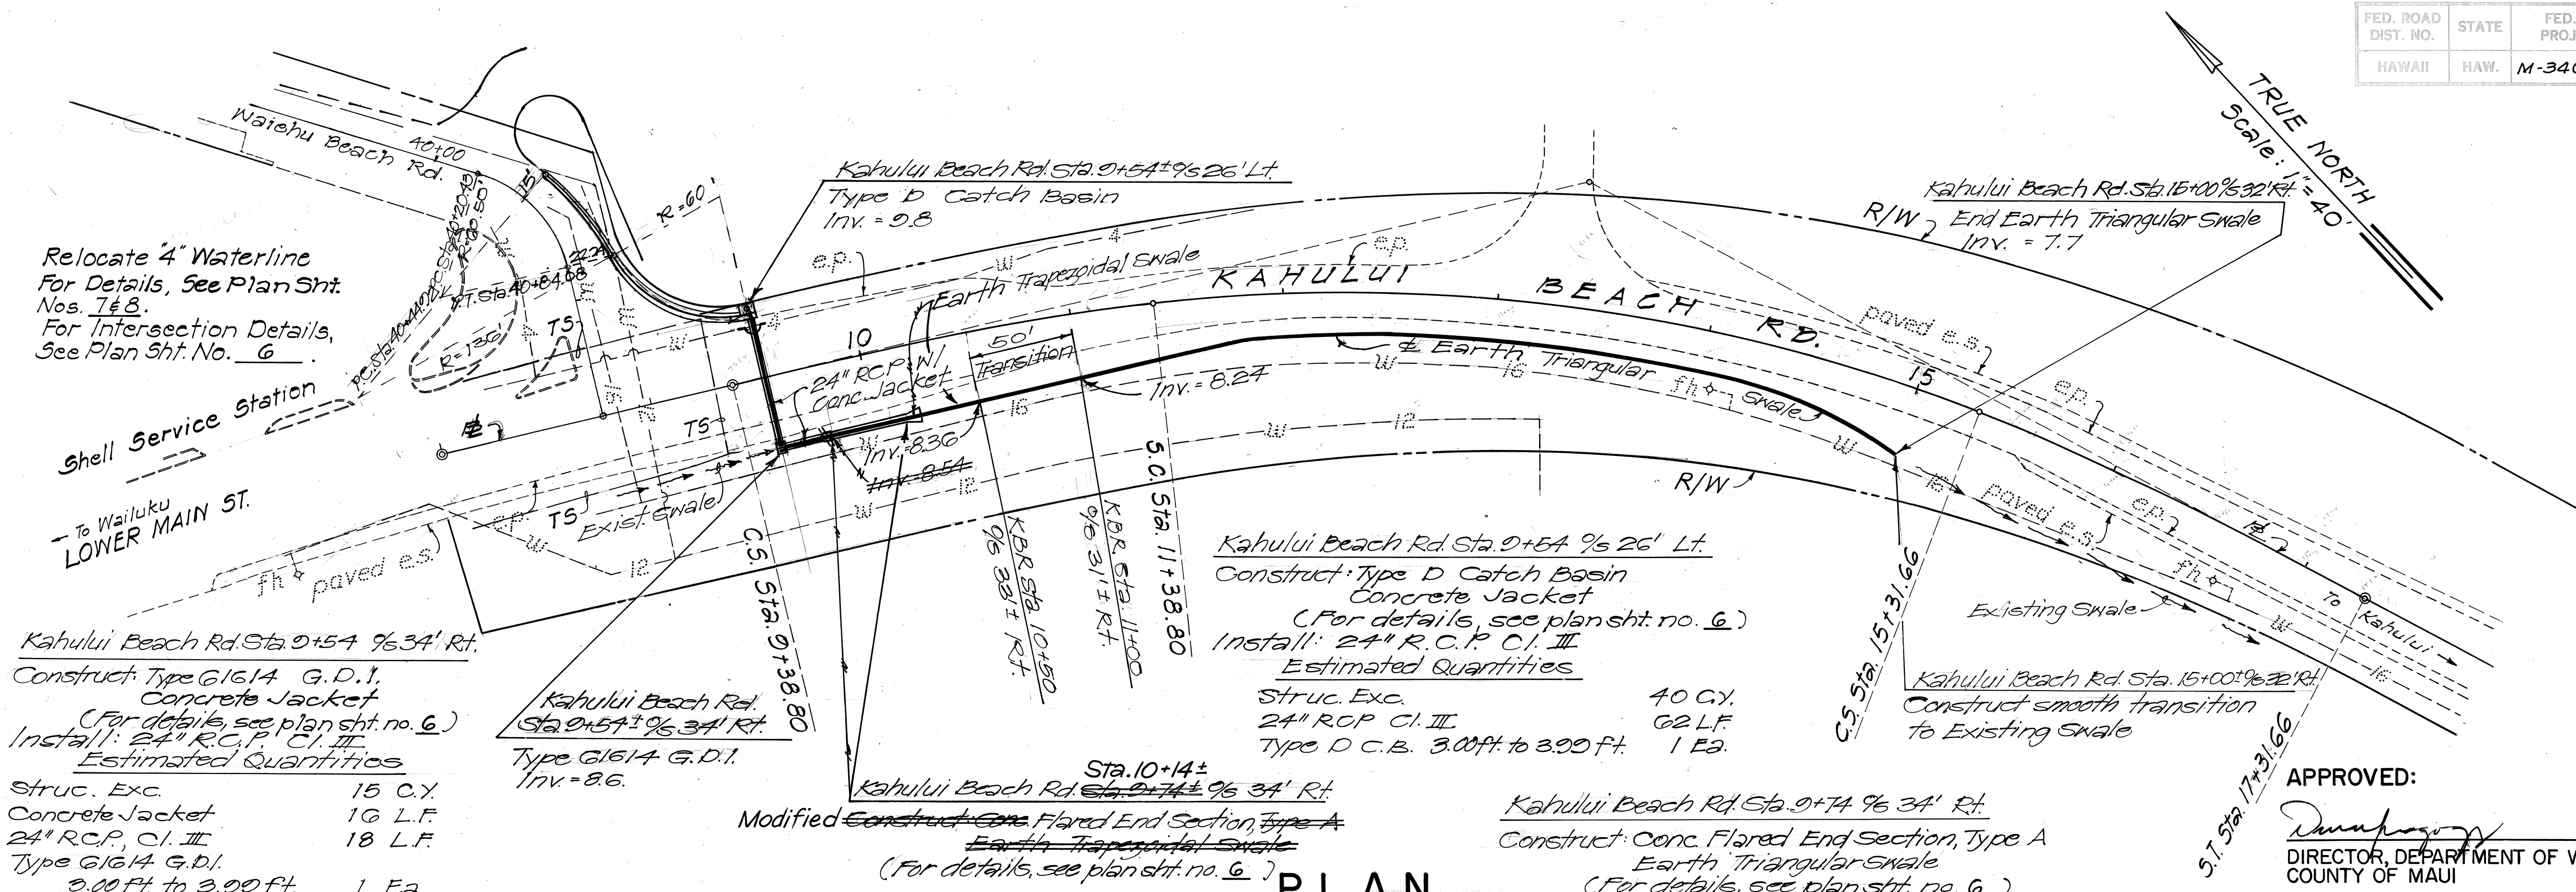

APPROVED:
[Signature]
DIRECTOR, DEPARTMENT OF WATER SUPPLY
COUNTY OF MAUI

3/9/89
DATE

CONSTRUCTION SIGN LOCATION	
ROAD CONSTRUCTION AHEAD W/E POSTS (CW 20-1d)	END CONSTRUCTION W/E POSTS (CS 20-E)
Lower Main St. Sta. 3+75 ± Rt.	Lower Main St. Sta. 3+75 ± Lt.
KBR Sta. 20+00 ± Lt.	KBR Sta. 20+00 ± Rt.
WBR Sta. 35+55 ± Rt.	WBR Sta. 35+55 ± Lt.

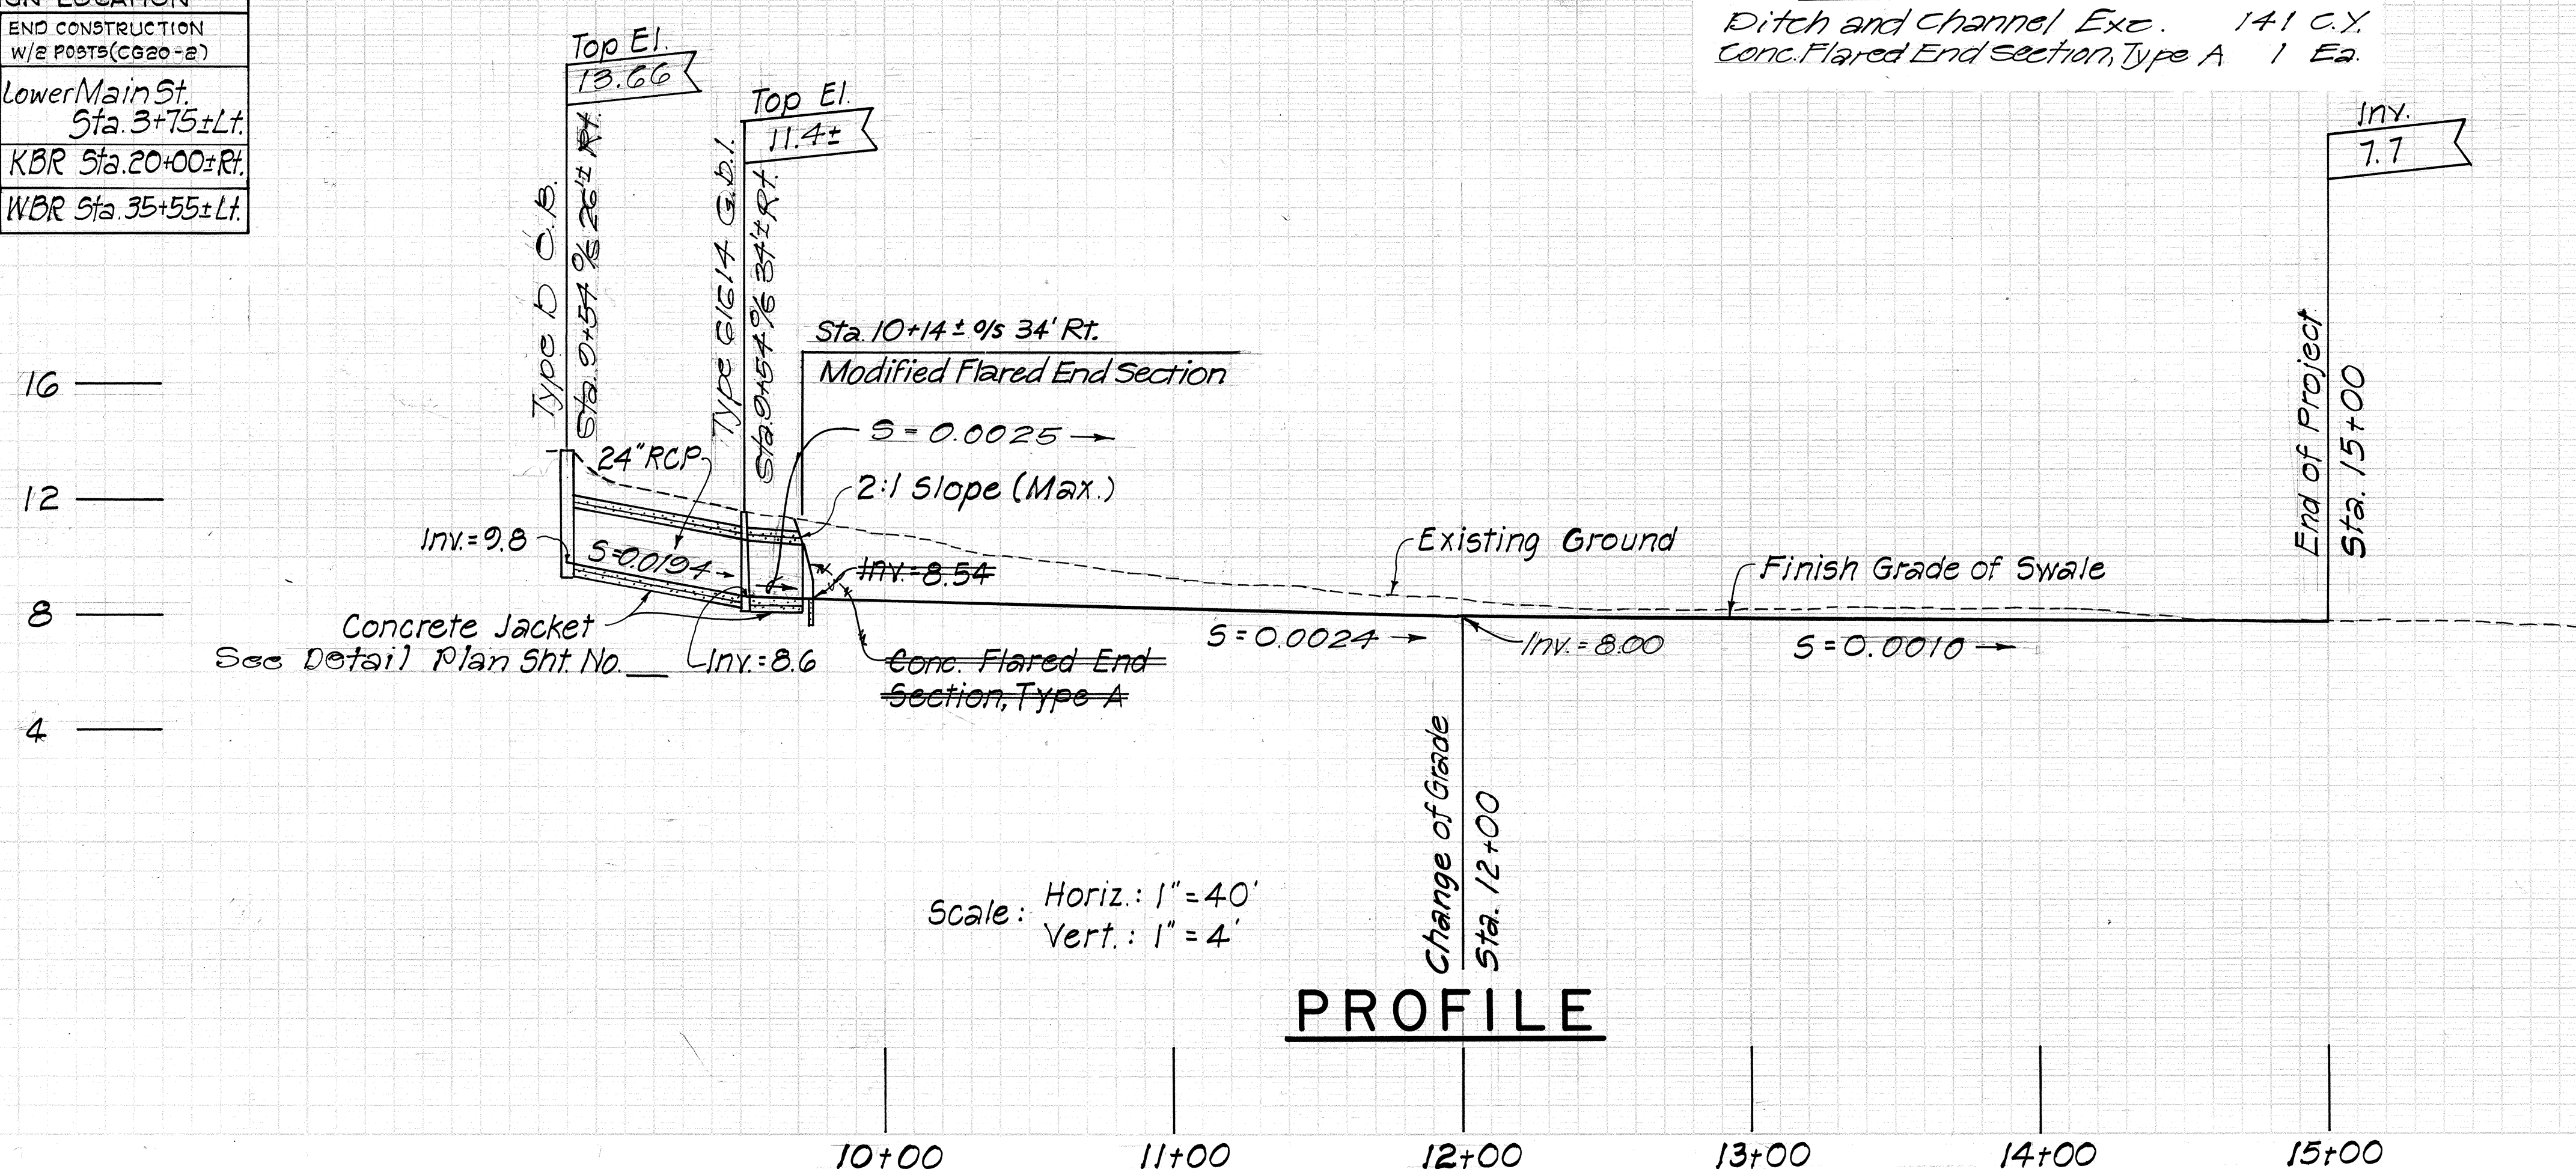

PROFILE

"AS-BUILT"