

INDEX TO DRAWINGS	
SHEET NO.	DESCRIPTION
1	TITLE SHEET
2	STANDARD PLANS SUMMARY
3	GENERAL NOTES & LEGEND
① 4	TYPICAL SECTIONS
5-6	TYPICAL DETAILS
7	UTILITY NOTES & SUMMARIES-MON., WATER VALVES & MANHOLES
8-12	PLANS
13-14	GUARDRAIL CONNECTION & CONCRETE RAMP DETAILS
15	MISCELLANEOUS SUMMARIES
ADD.16-ADD.22	TRAFFIC PLANS

Plan Sht. No. ① 4 S-I is a supplementary sheet to this project.  
TOTAL SHEET COUNT after "AS BUILT" posting, 16 Sheets.

STATE OF HAWAII

DEPARTMENT OF TRANSPORTATION

HIGHWAYS DIVISION

HONOLULU, HAWAII

"AS-BUILT"

PLANS FOR

KAHULUI BEACH ROAD AND WAIEHU BEACH


ROAD IMPROVEMENTS

KEALII DRIVE TO KAAHUMANU AVENUE

PROJECT NO. 3400AB-02-90


DISTRICT OF WAILUKU

ISLAND OF MAUI

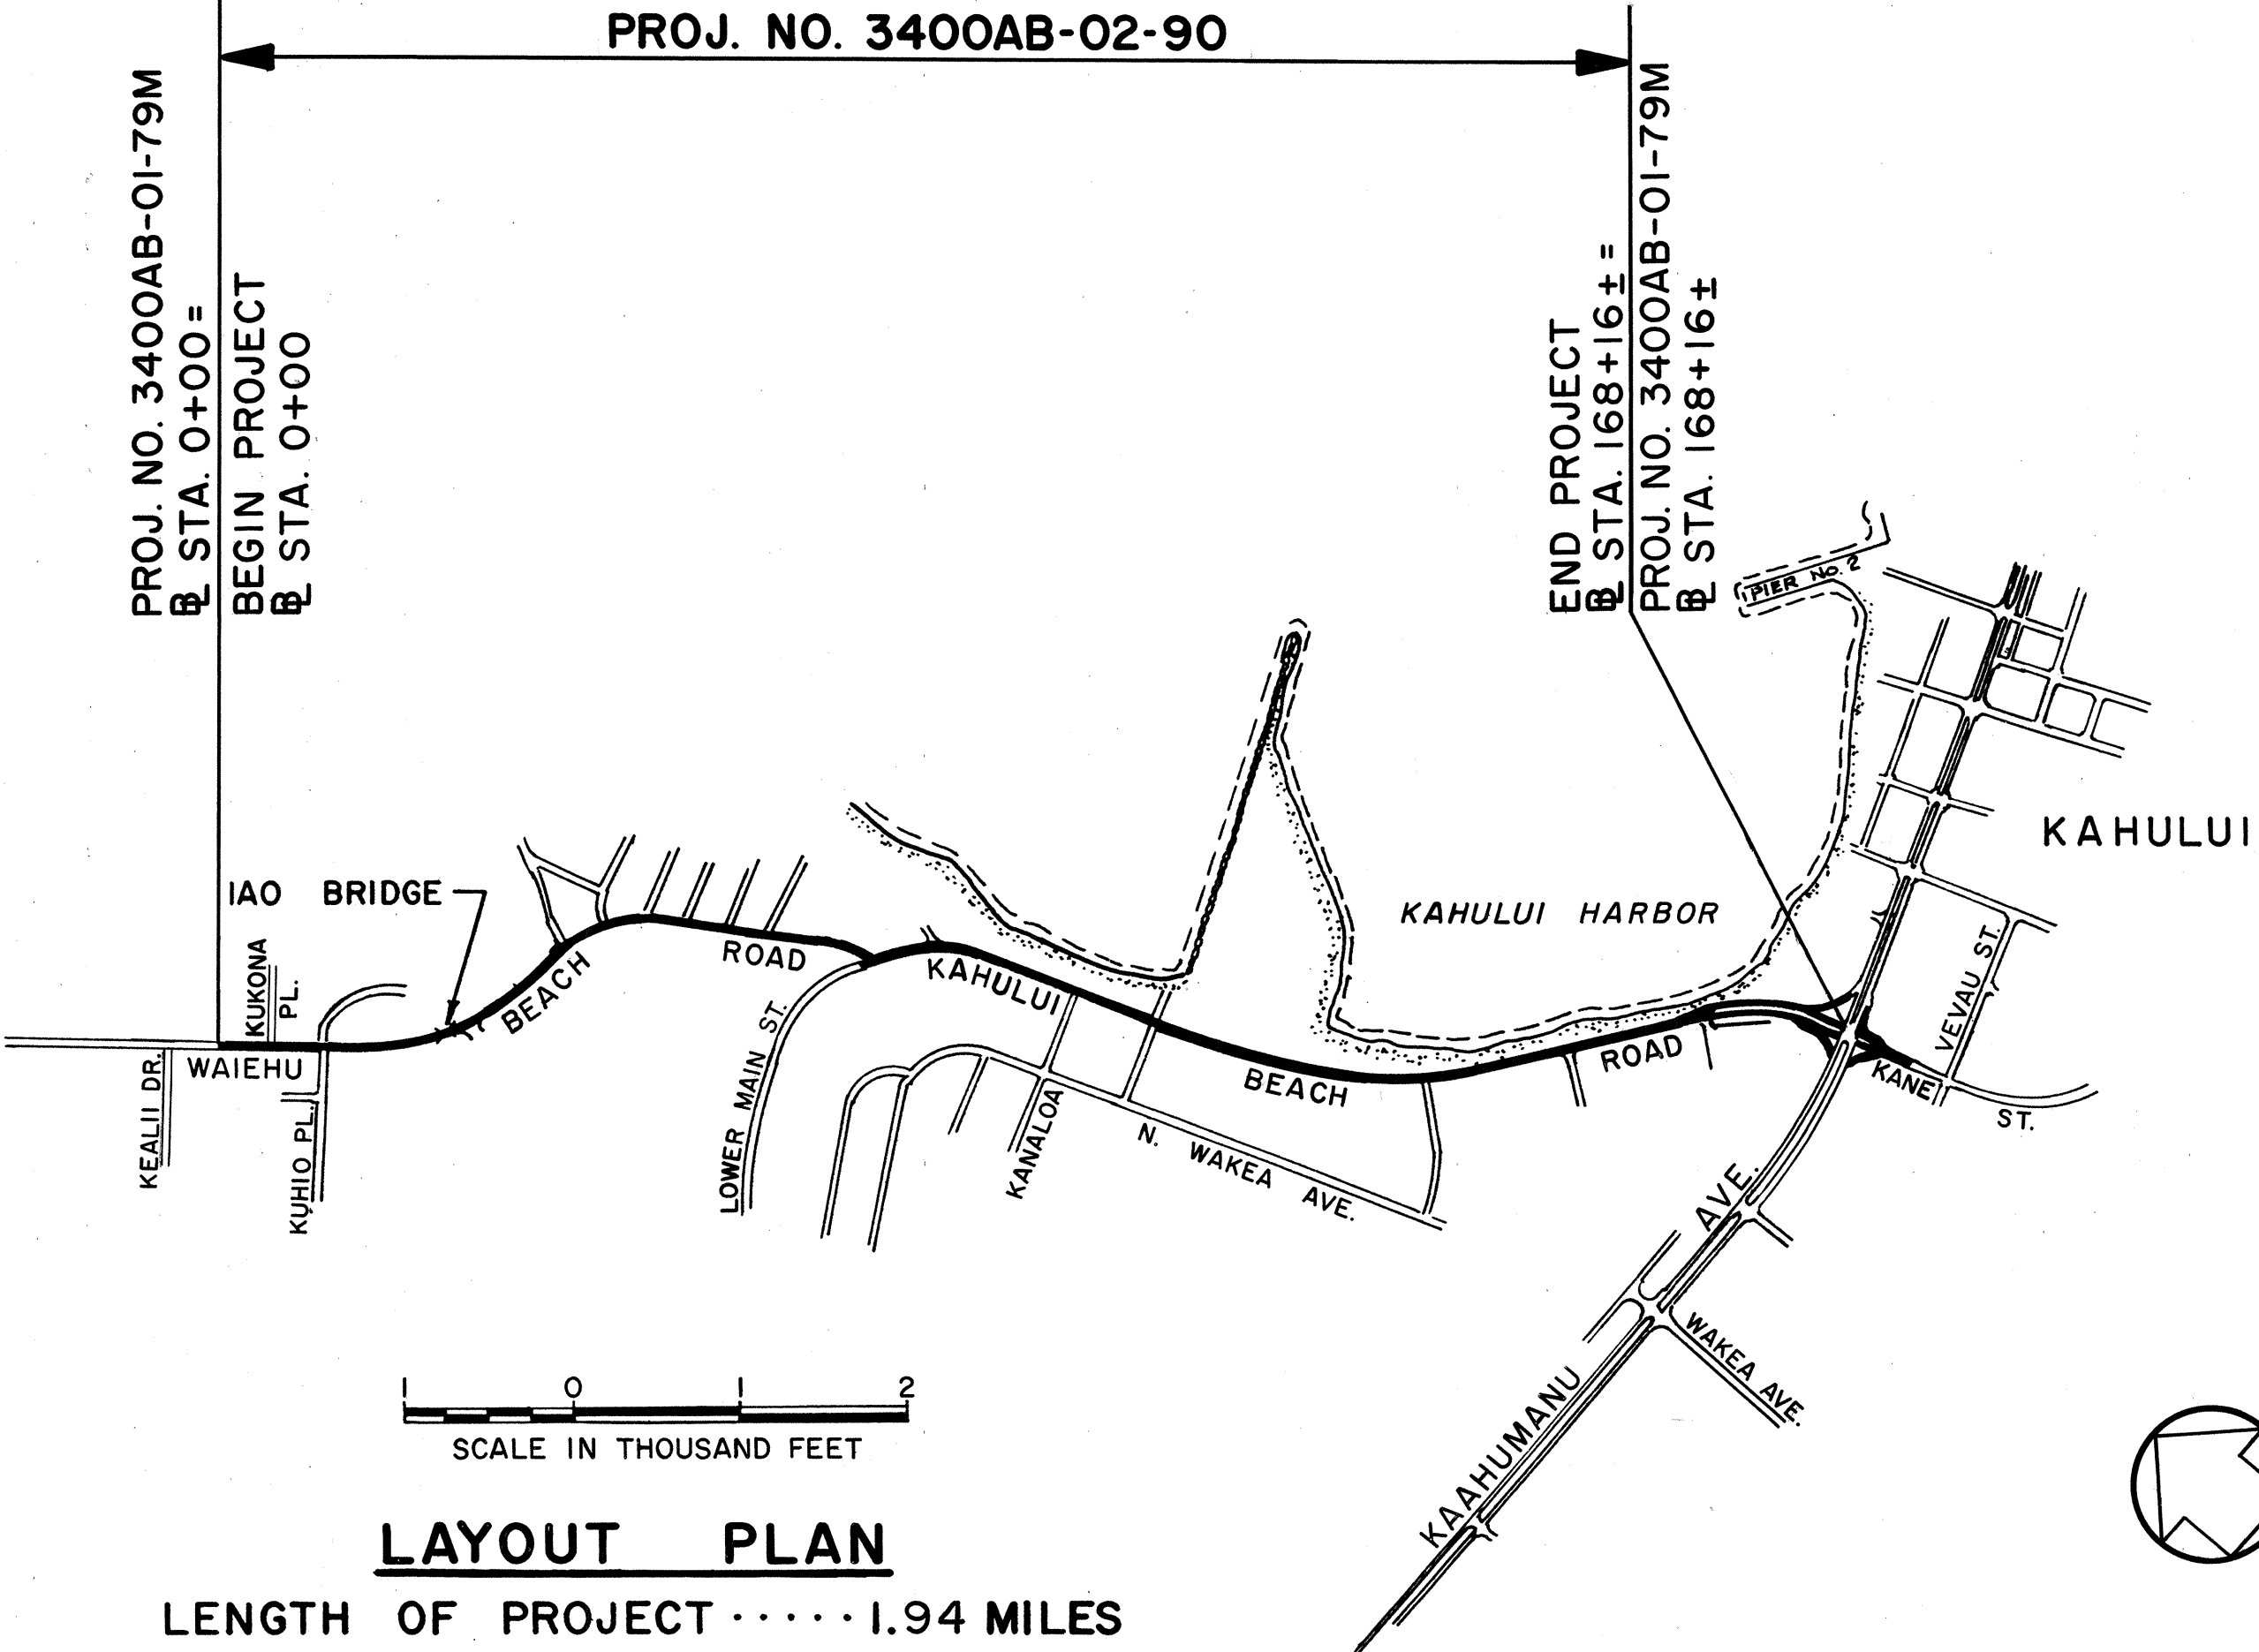

LAYOUT PLAN  
LENGTH OF PROJECT .....1.94 MILES

FED. ROAD DIST. NO.	STATE	PROJ. NO.	FISCAL YEAR	SHEET NO.	TOTAL SHEETS
HAWAII	HAW.	3400AB-02-90	1990	1	15

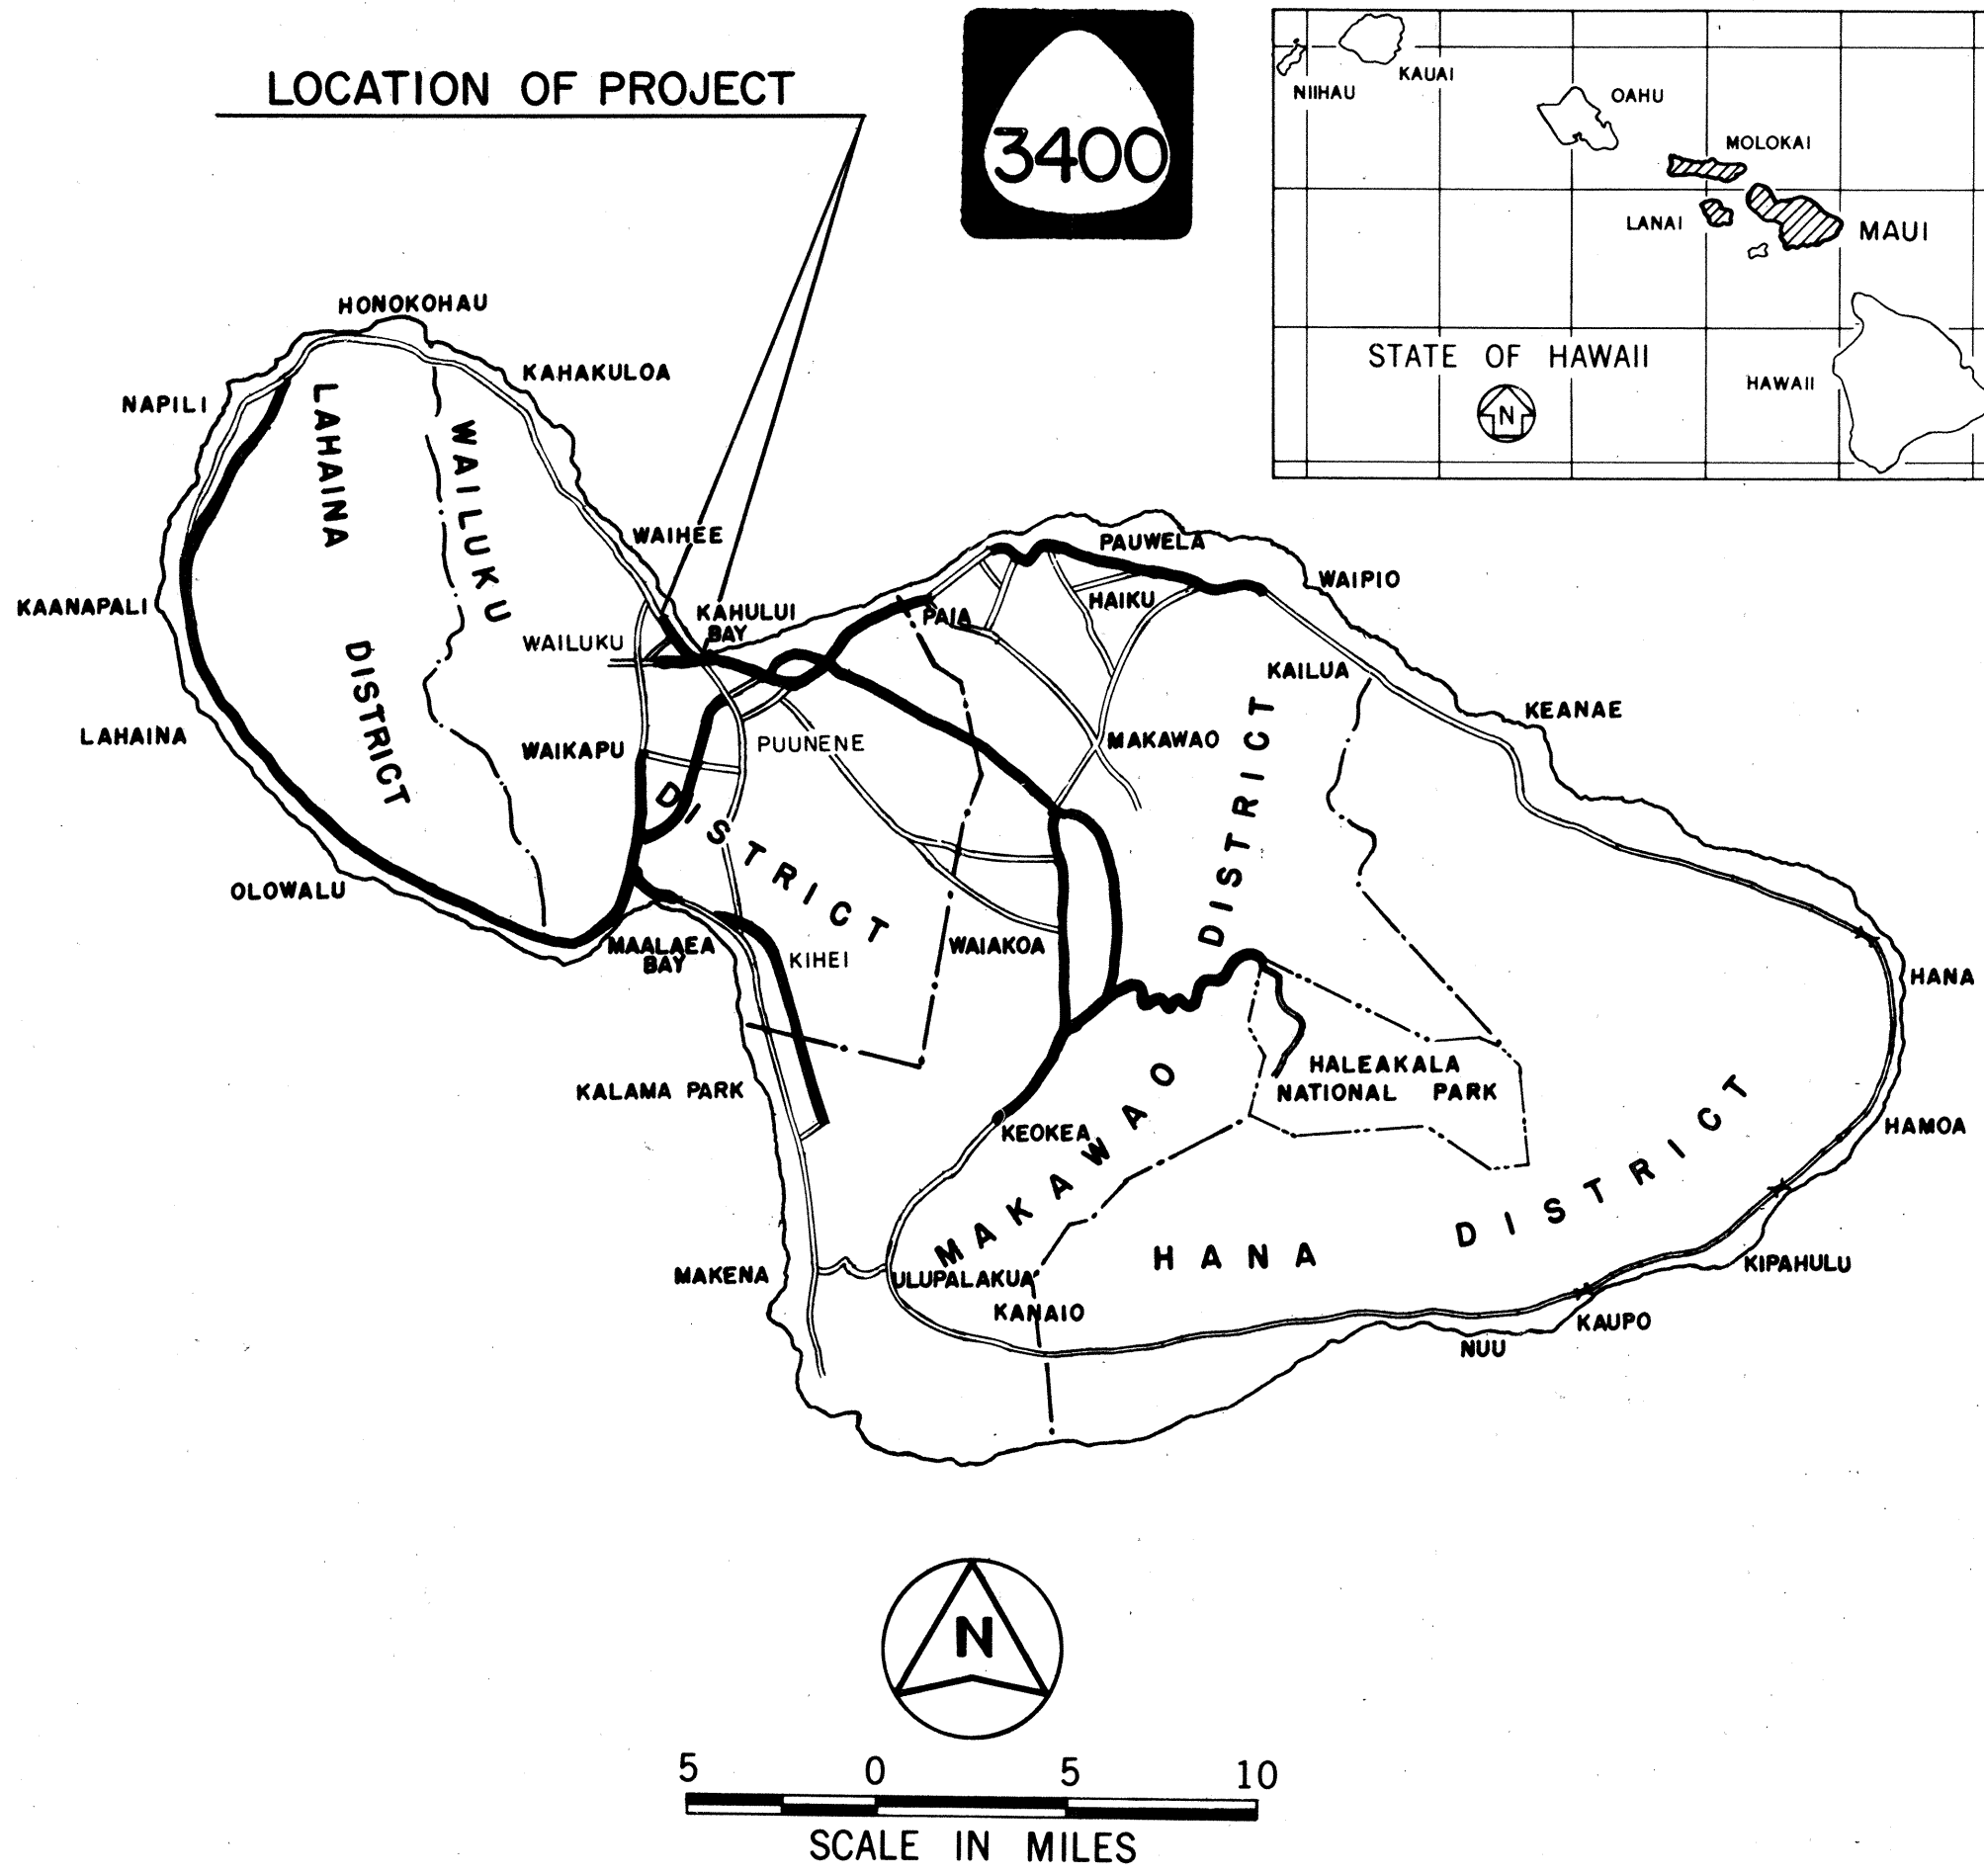

FEDERAL AID PROJECTS PREVIOUSLY CONSTRUCTED OR UNDER CONSTRUCTION  
MILE POST 0.00 TO MILE POST 1.94

CHANGES MADE DURING CONSTRUCTION HAVE BEEN INCORPORATED ON THESE PLANS EXCEPT CHANGES IN THE ORIGINAL THEORETICAL QUANTITIES. FOR ACTUAL QUANTITIES, REFER TO PROJECT LEDGER AND/OR COMPUTATION BOOK.  
*Michael Downing* 11-12-93  
RESIDENT ENGINEER DATE

6/14/90	Added Plan Sht. Nos. ADD.16 thru ADD.22 as per Addendum No. 1.
DATE	REVISION

DEPARTMENT OF TRANSPORTATION STATE OF HAWAII	
APPROVED:	
<i>Edmund Jones</i>	5/5/90
DIR. OF TRANSPORTATION	DATE

HWY-DD UNIT "D" DESIGNED BY ALLAN NISHIMURA 548-7490 MAY 21, 1990  
P. S. & E. BY PHONE DATE