




FED. ROAD DIST. NO.	STATE	PROJ. NO.	FISCAL YEAR	SHEET NO.	TOTAL SHEETS
HAWAII	HAW.	3400A-01-97	1997	ADD.4	10

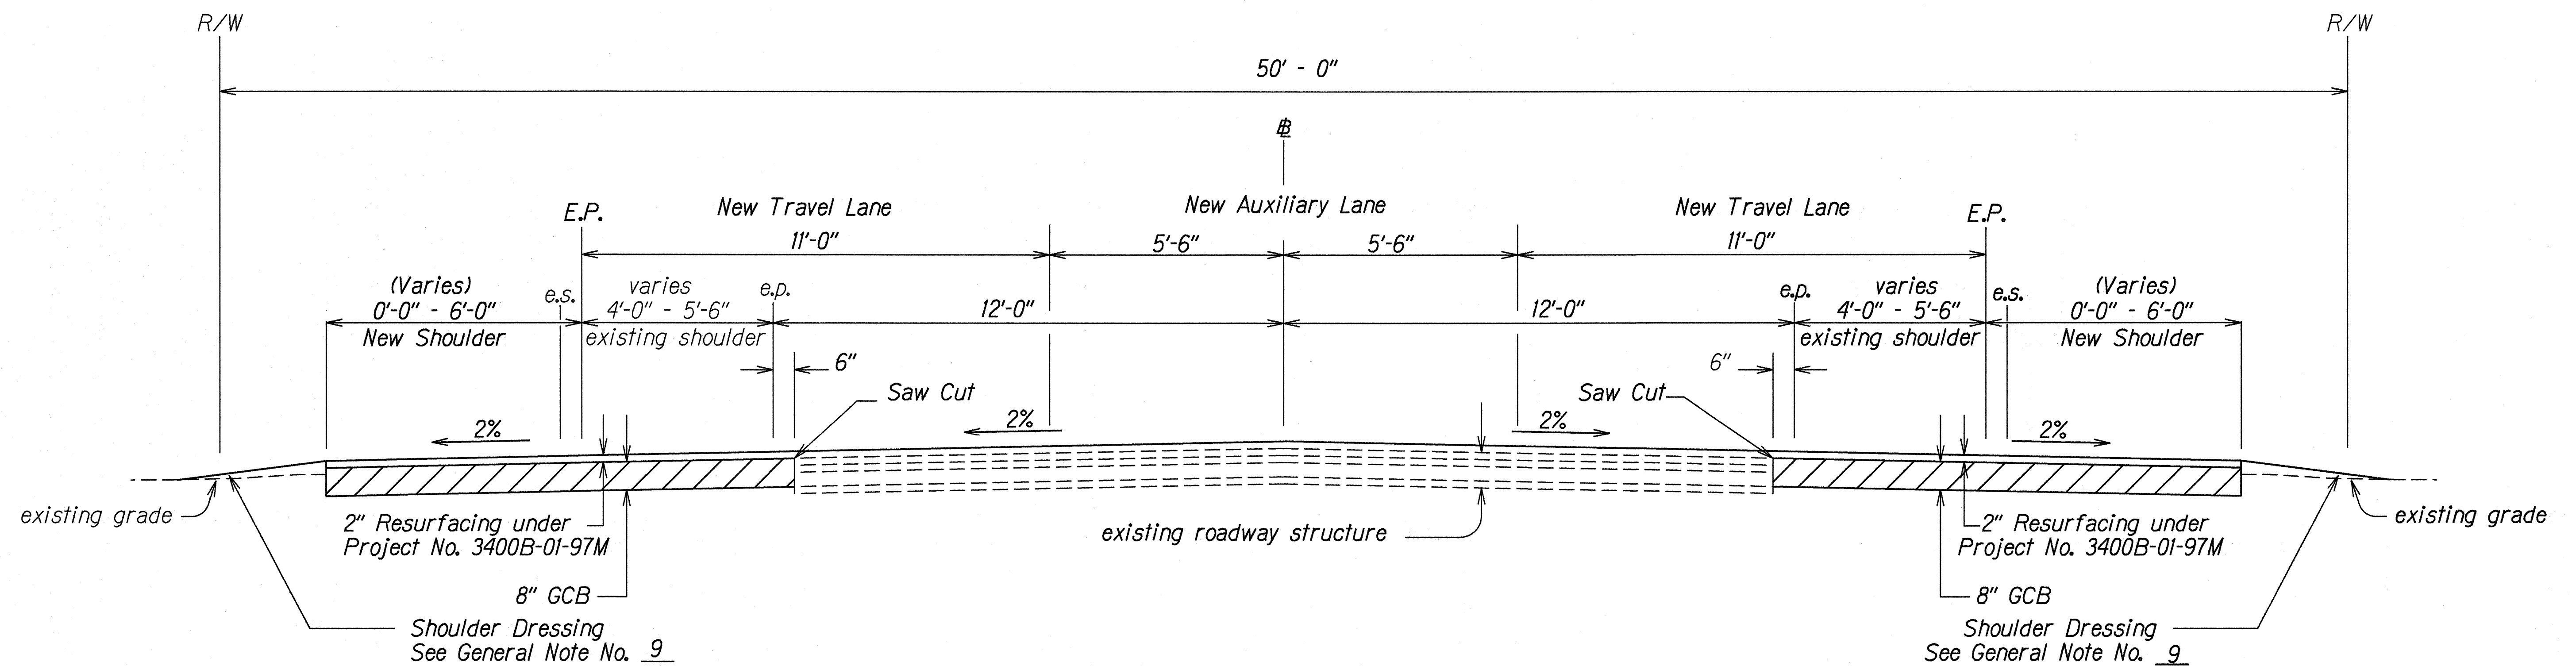


TYPICAL SECTION FOR WIDENING
Scale: 1" = 2'-0"

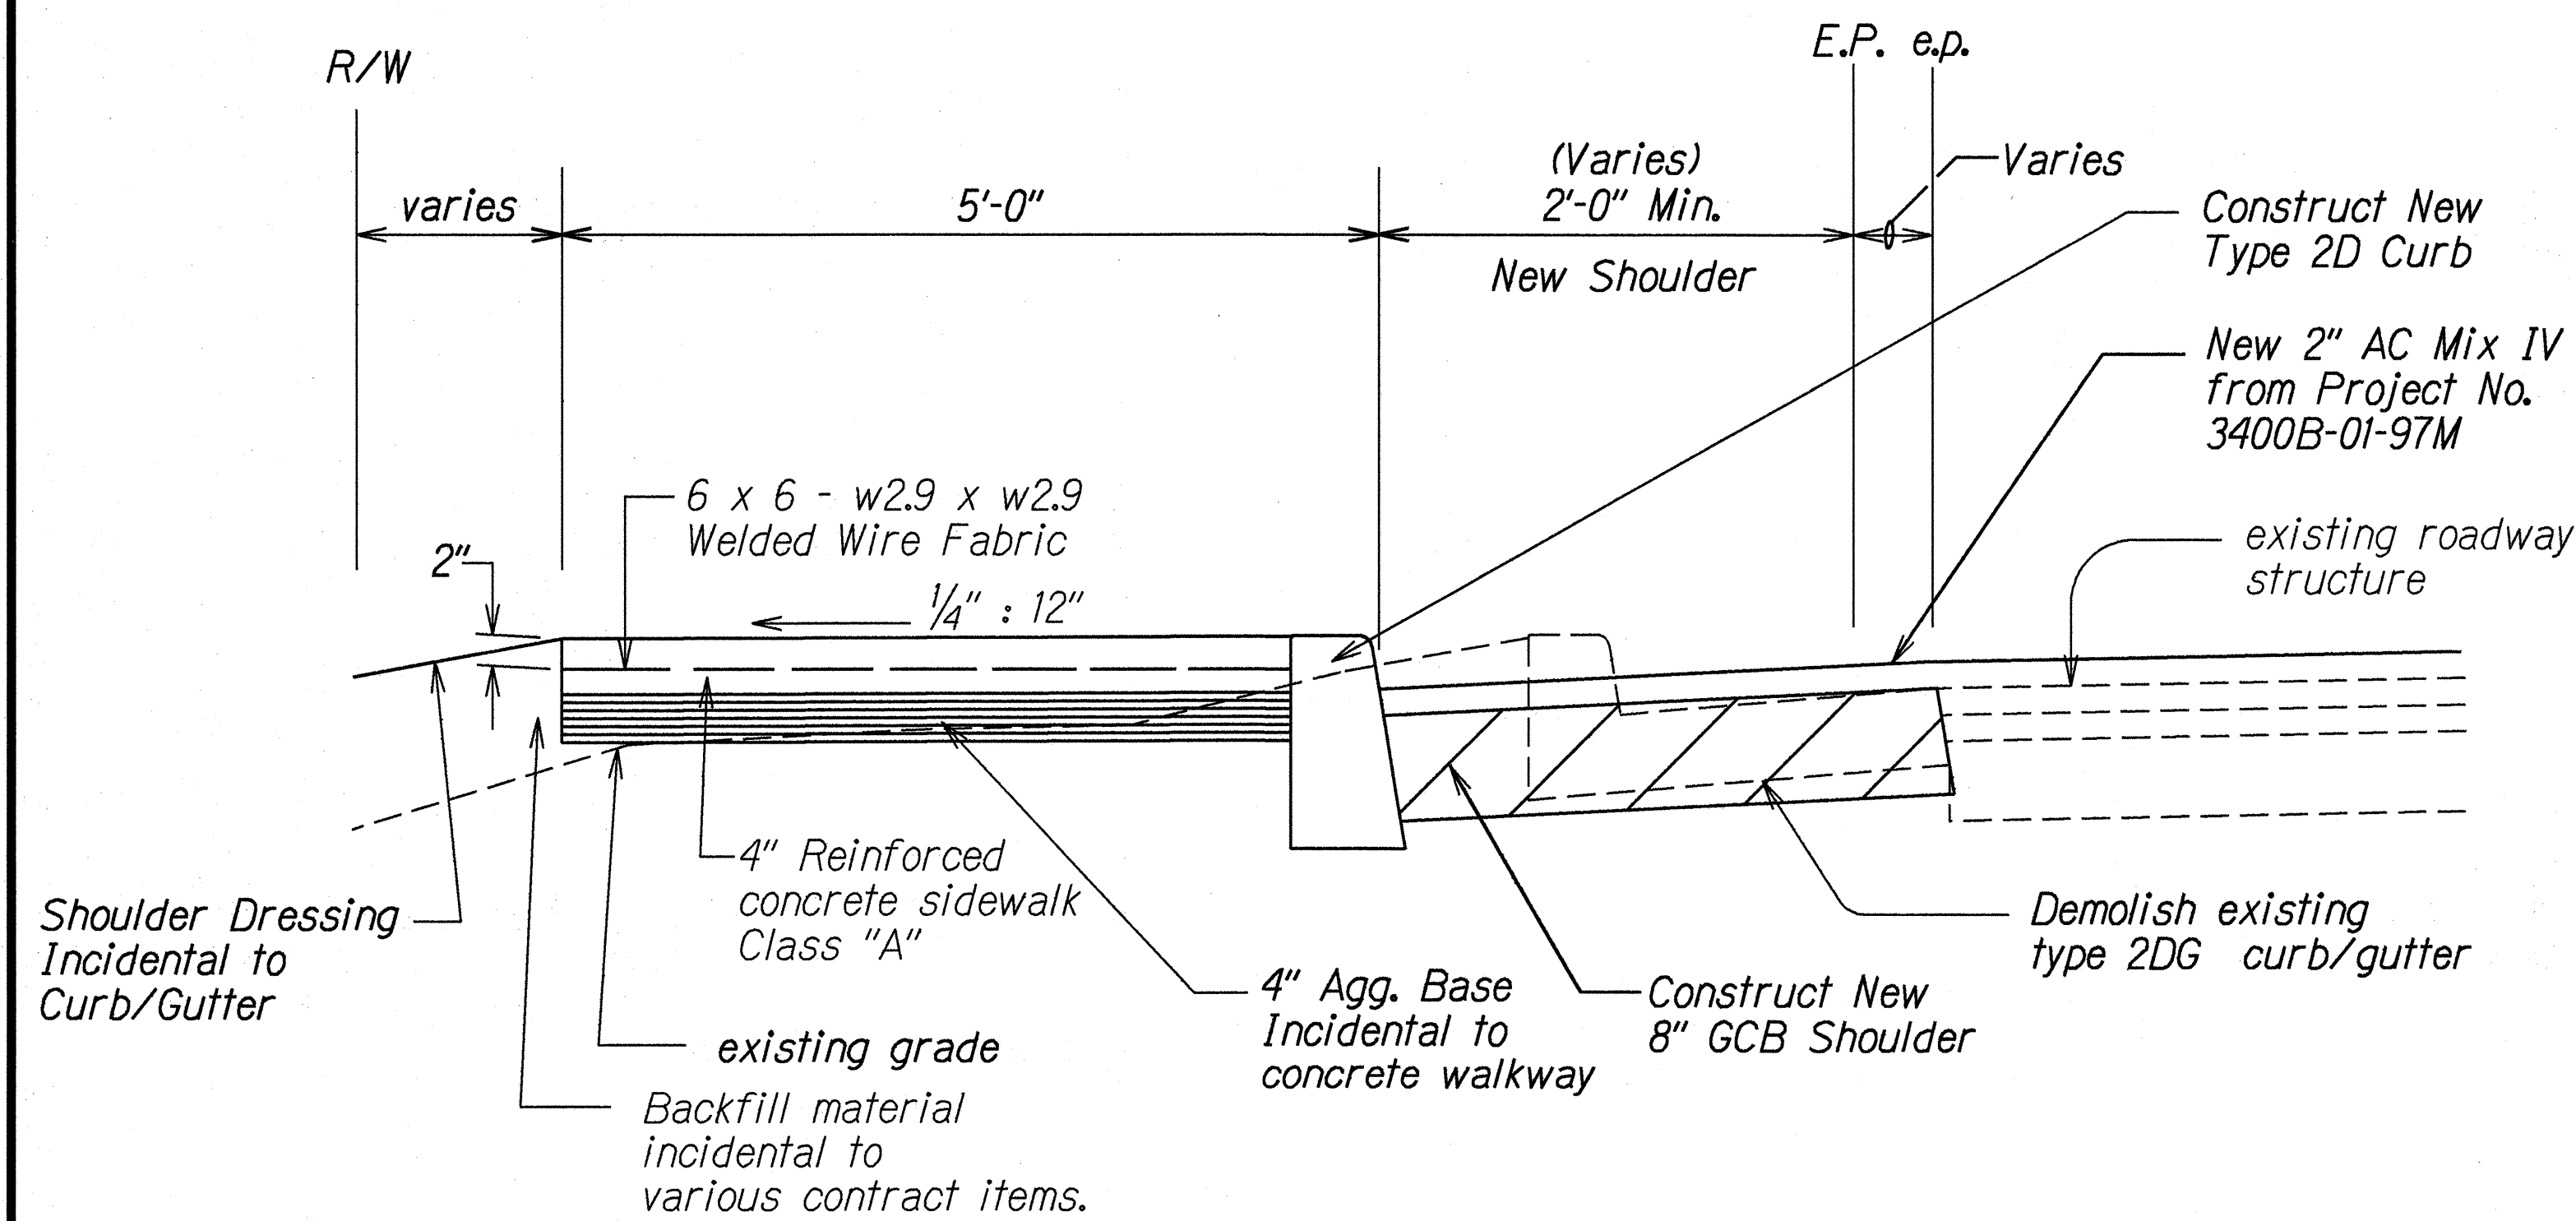

TYPICAL DETAIL OF WIDENING AT CURB AREA
Scale: Not to Scale

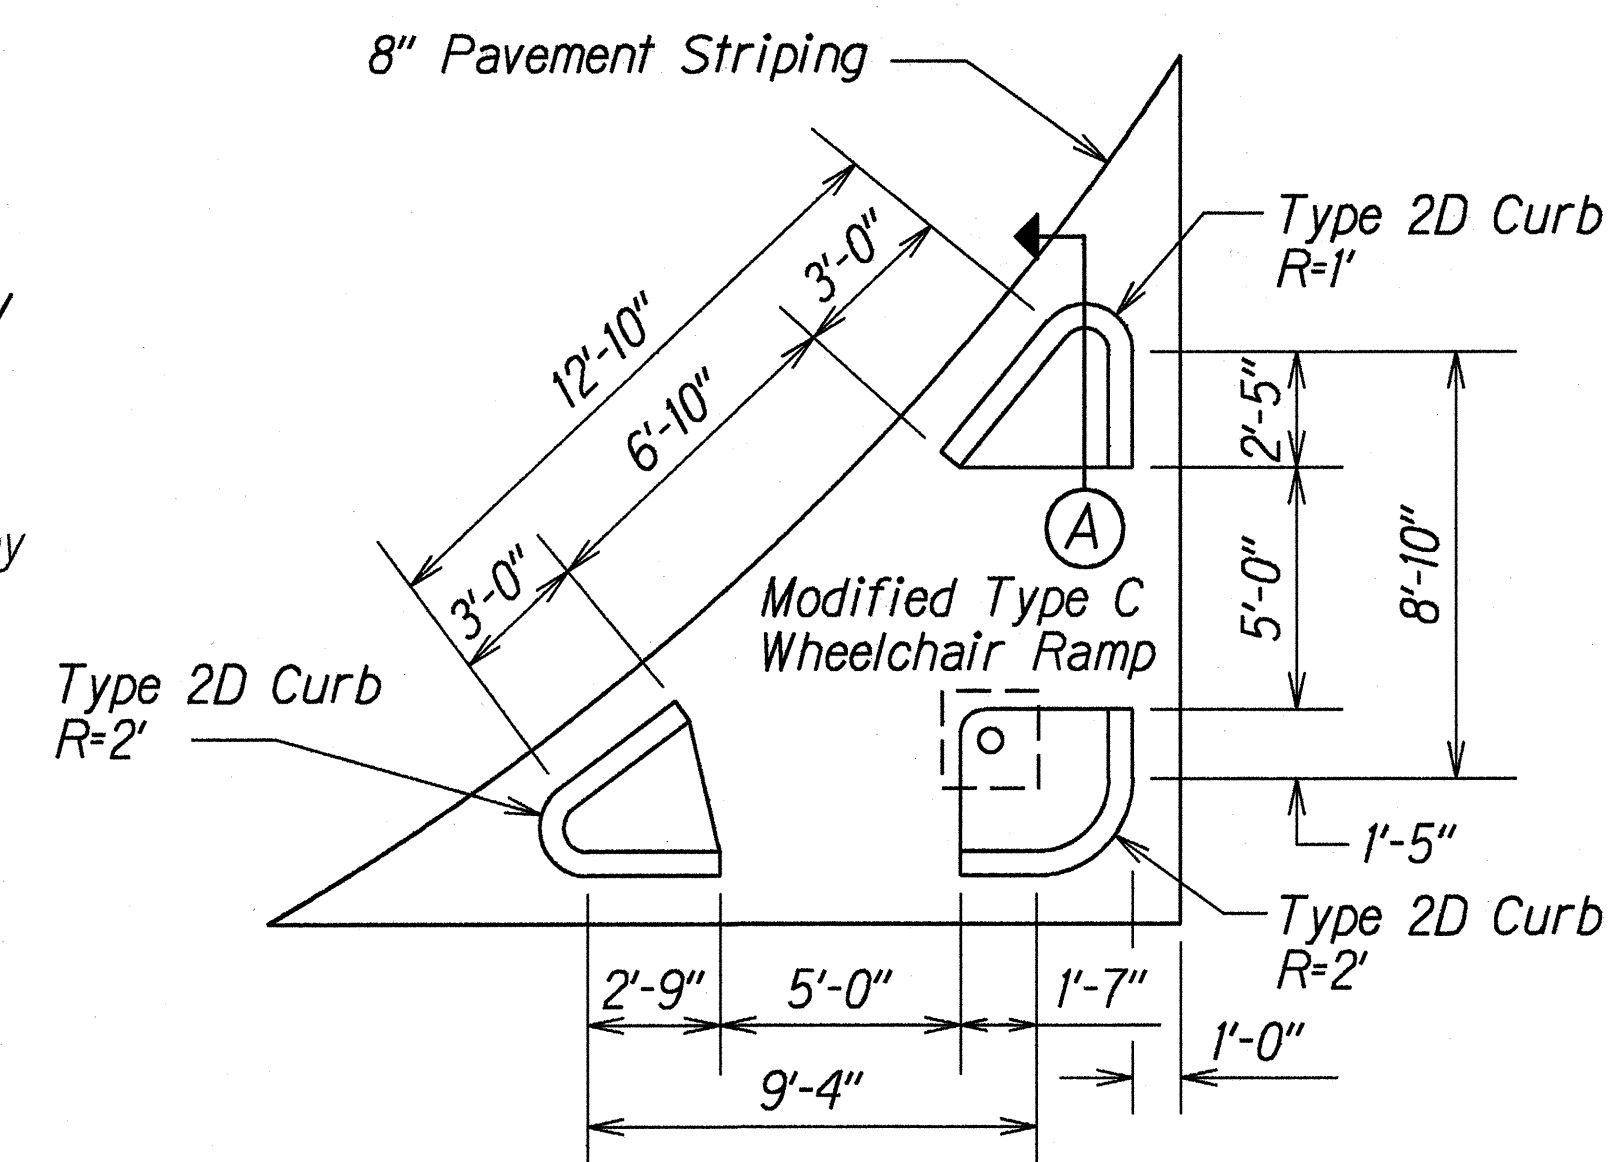

TYPICAL DETAIL OF CHANNELIZING ISLAND
Not to Scale

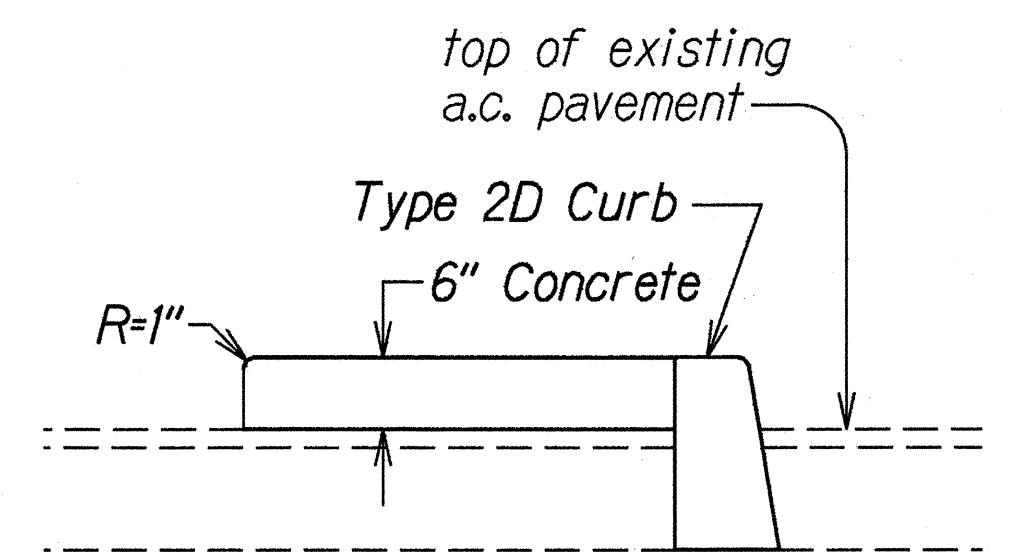

TYPICAL SECTION RAISED ISLAND (A)
Not to Scale

DATE	REVISION
5-30-97	Revised shoulder slopes. Removed type 2DG curb/gutter. Add type 2D curb and Reinforced Concrete Sidewalk per Addendum No. 2.

DATE	REVISION
5-30-97	Revised shoulder slopes. Removed type 2DG curb/gutter. Add type 2D curb and Reinforced Concrete Sidewalk per Addendum No. 2.
STATE OF HAWAII DEPARTMENT OF TRANSPORTATION HIGHWAYS DIVISION TYPICAL SECTIONS WAIIEHU BEACH ROAD Double Left Turn into Kahului Beach Road Project No. 3400A-01-97 Scale: As Shown Date: April 1997 SHEET No. 1 OF 1 SHEETS	

DATE	5-12-97
SURVEY PLOTTED BY	W. M. Wang
DESIGNED BY	T. M. Wang
NOTED BY	T. M. Wang
CHECKED BY	T. M. Wang