

FED. ROAD DIST. NO.	STATE	PROJ. NO.	FISCAL YEAR	SHEET NO.	TOTAL SHEETS
HAWAII	HAW.	3400B-01-97M	1997	8	22

BEGIN PROJECT
Project No. 3400B-01-97M
Sta. -4+00±

STA. -4+00± LT./RT. - STA. 12+50± LT./RT.
Construct New 6' Shoulder

TRUE NORTH
SCALE: 1" = 40'

KAHEKILI # STA. 7+00± LT. - WAIEHU # STA. 8+90± LT.

Remove 670 L.F. Existing Guardrail w/Concrete Post.
Install 620 L.F. New Guardrail Type-3 Single w/6' Steel Post.
Approach End - Type "C"
Trailing End - SRT-350

KAHEKILI # STA. 10+15± LT. - WAIEHU # STA. 8+20± RT.

Remove 480' Existing Guardrail w/Concrete Post.
Install 430 L.F. New Guardrail, Type-3 Single w/6' Steel Post.
Approach & Trailing Ends - SRT-350 (2 ea.)

STA. 7+00± RT. - # STA. 10+20± RT.

Construct 320 Lin Ft. New Type 6 A.C. Curbing on New Shoulder. See Detail on Plan Sht. No. 5

STA. 5+50± RT. - # STA. 10+00± RT.

Remove 285 L.F. Existing Guardrail w/Concrete Post. Install 350 L.F. New Guardrail Type-3 Single w/Steel Post.
Approach & Trailing Ends - SRT-350 (2 ea.)

STATE OF HAWAII
DEPARTMENT OF TRANSPORTATION
HIGHWAYS DIVISION

ROADWAY PLAN


WAIEHU BEACH ROAD RESURFACING
Kahekili Highway to Kahului Beach Road
Project No. 3400B-01-97M

Scale: 1" = 40' Date: April 1997

SHEET No. 1 OF 5 SHEETS

DESIGNED BY	DATE
DRAWN BY	4/10/97
CHECKED BY	Mar. 1997
APPROVED BY	
NOTED BY	
QUANTITIES BY	
REVISIONS BY	

FED. ROAD DIST. NO.	STATE	PROJ. NO.	FISCAL YEAR	SHEET NO.	TOTAL SHEETS
HAWAII	HAW.	3400B-01-97M	1997	ADD.9	22

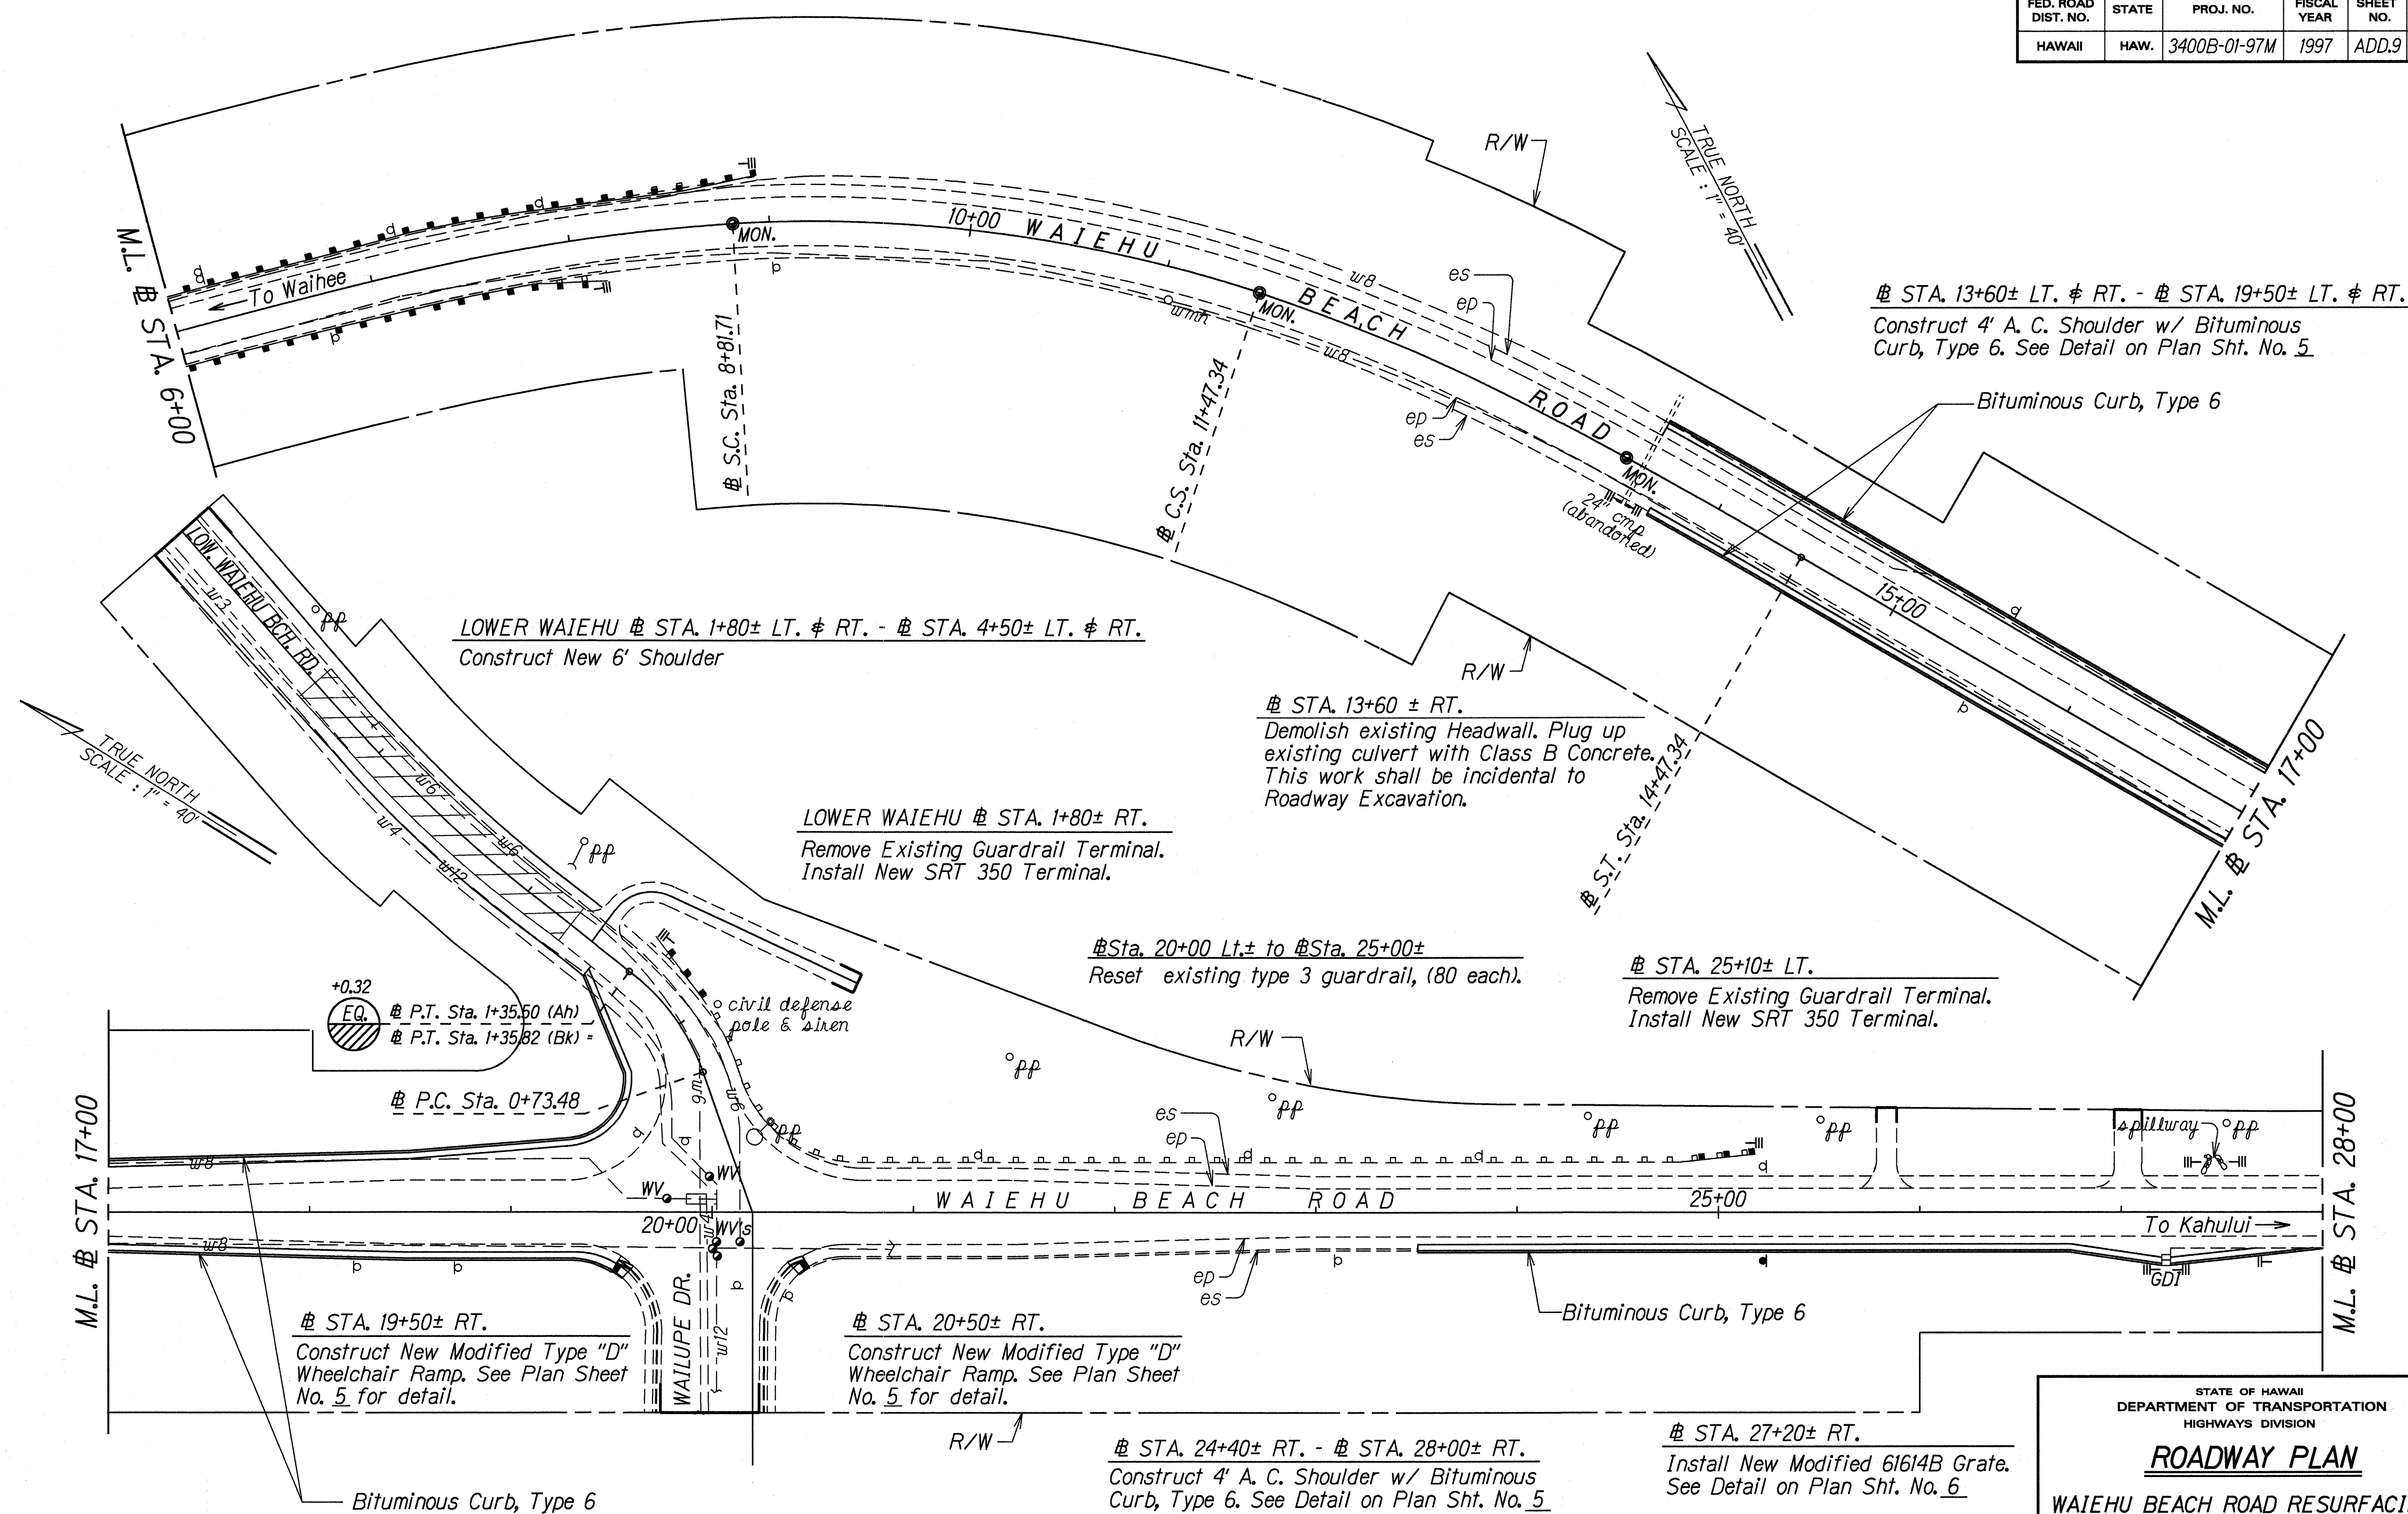

6-10-97	Revised "Modified Type 'E' " to "Modified Type 'D' " Wheelchair Ramp per Addendum No. 2.
5-21-97	Added notes for resetting guardrail per Addendum No. 2.
DATE	REVISION

STATE OF HAWAII
DEPARTMENT OF TRANSPORTATION
HIGHWAYS DIVISION


ROADWAY PLAN

WAIIEHU BEACH ROAD RESURFACING
Kahekili Highway to Kahului Beach Road
Project No. 3400B-01-97M

Scale: 1" = 40' Date: April 1997

SHEET No. 1 OF 1 SHEETS

FED. ROAD DIST. NO.	STATE	PROJ. NO.	FISCAL YEAR	SHEET NO.	TOTAL SHEETS
HAWAII	HAW.	3400B-01-97M	1997	10	22

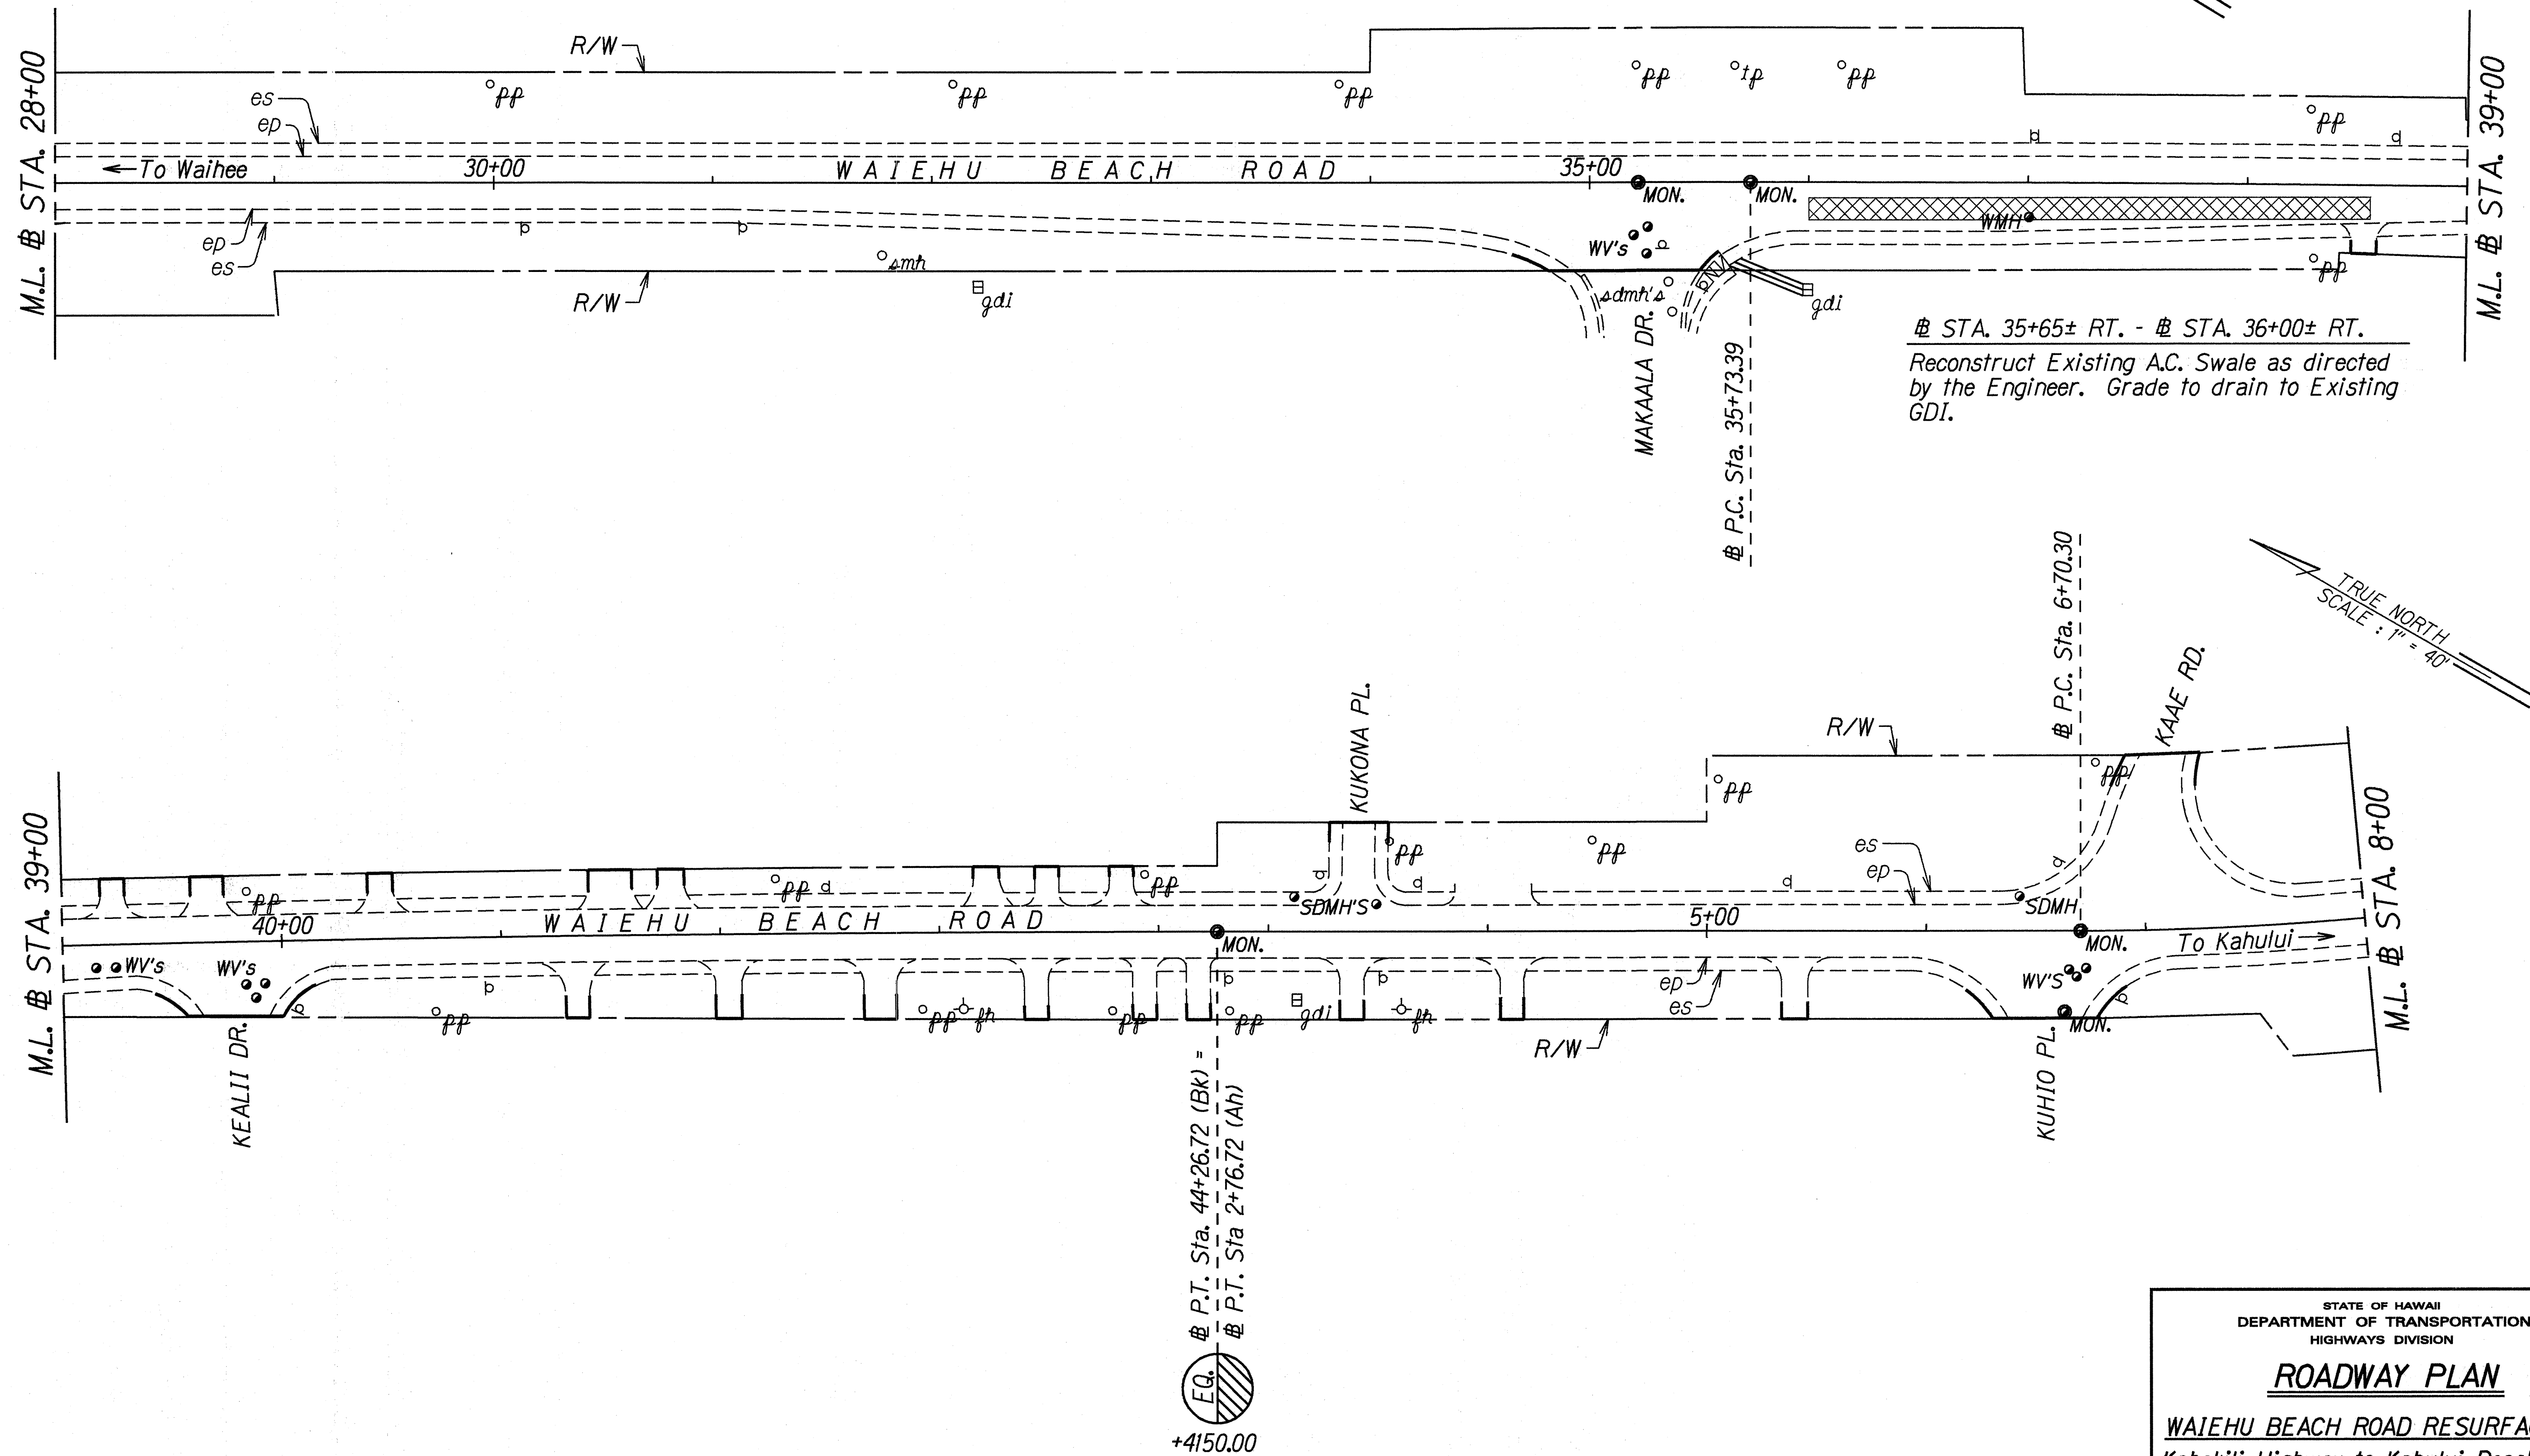

ORIGINAL PLAN	DATE
DESIGNED BY	4/10/97
DRAWN BY	ML
CHECKED BY	ML
NOTED BY	ML
QUANTITIES BY	ML
REVISIONS BY	ML

STATE OF HAWAII
DEPARTMENT OF TRANSPORTATION
HIGHWAYS DIVISION


ROADWAY PLAN

WAIEHU BEACH ROAD RESURFACING
Kahekili Highway to Kahului Beach Road
Project No. 3400B-01-97M

Scale: 1" = 40' Date: April 1997

SHEET No. 3 OF 5 SHEETS

FED. ROAD DIST. NO.	STATE	PROJ. NO.	FISCAL YEAR	SHEET NO.	TOTAL SHEETS
HAWAII	HAW.	3400B-01-97M	1997	C.O. 11	22

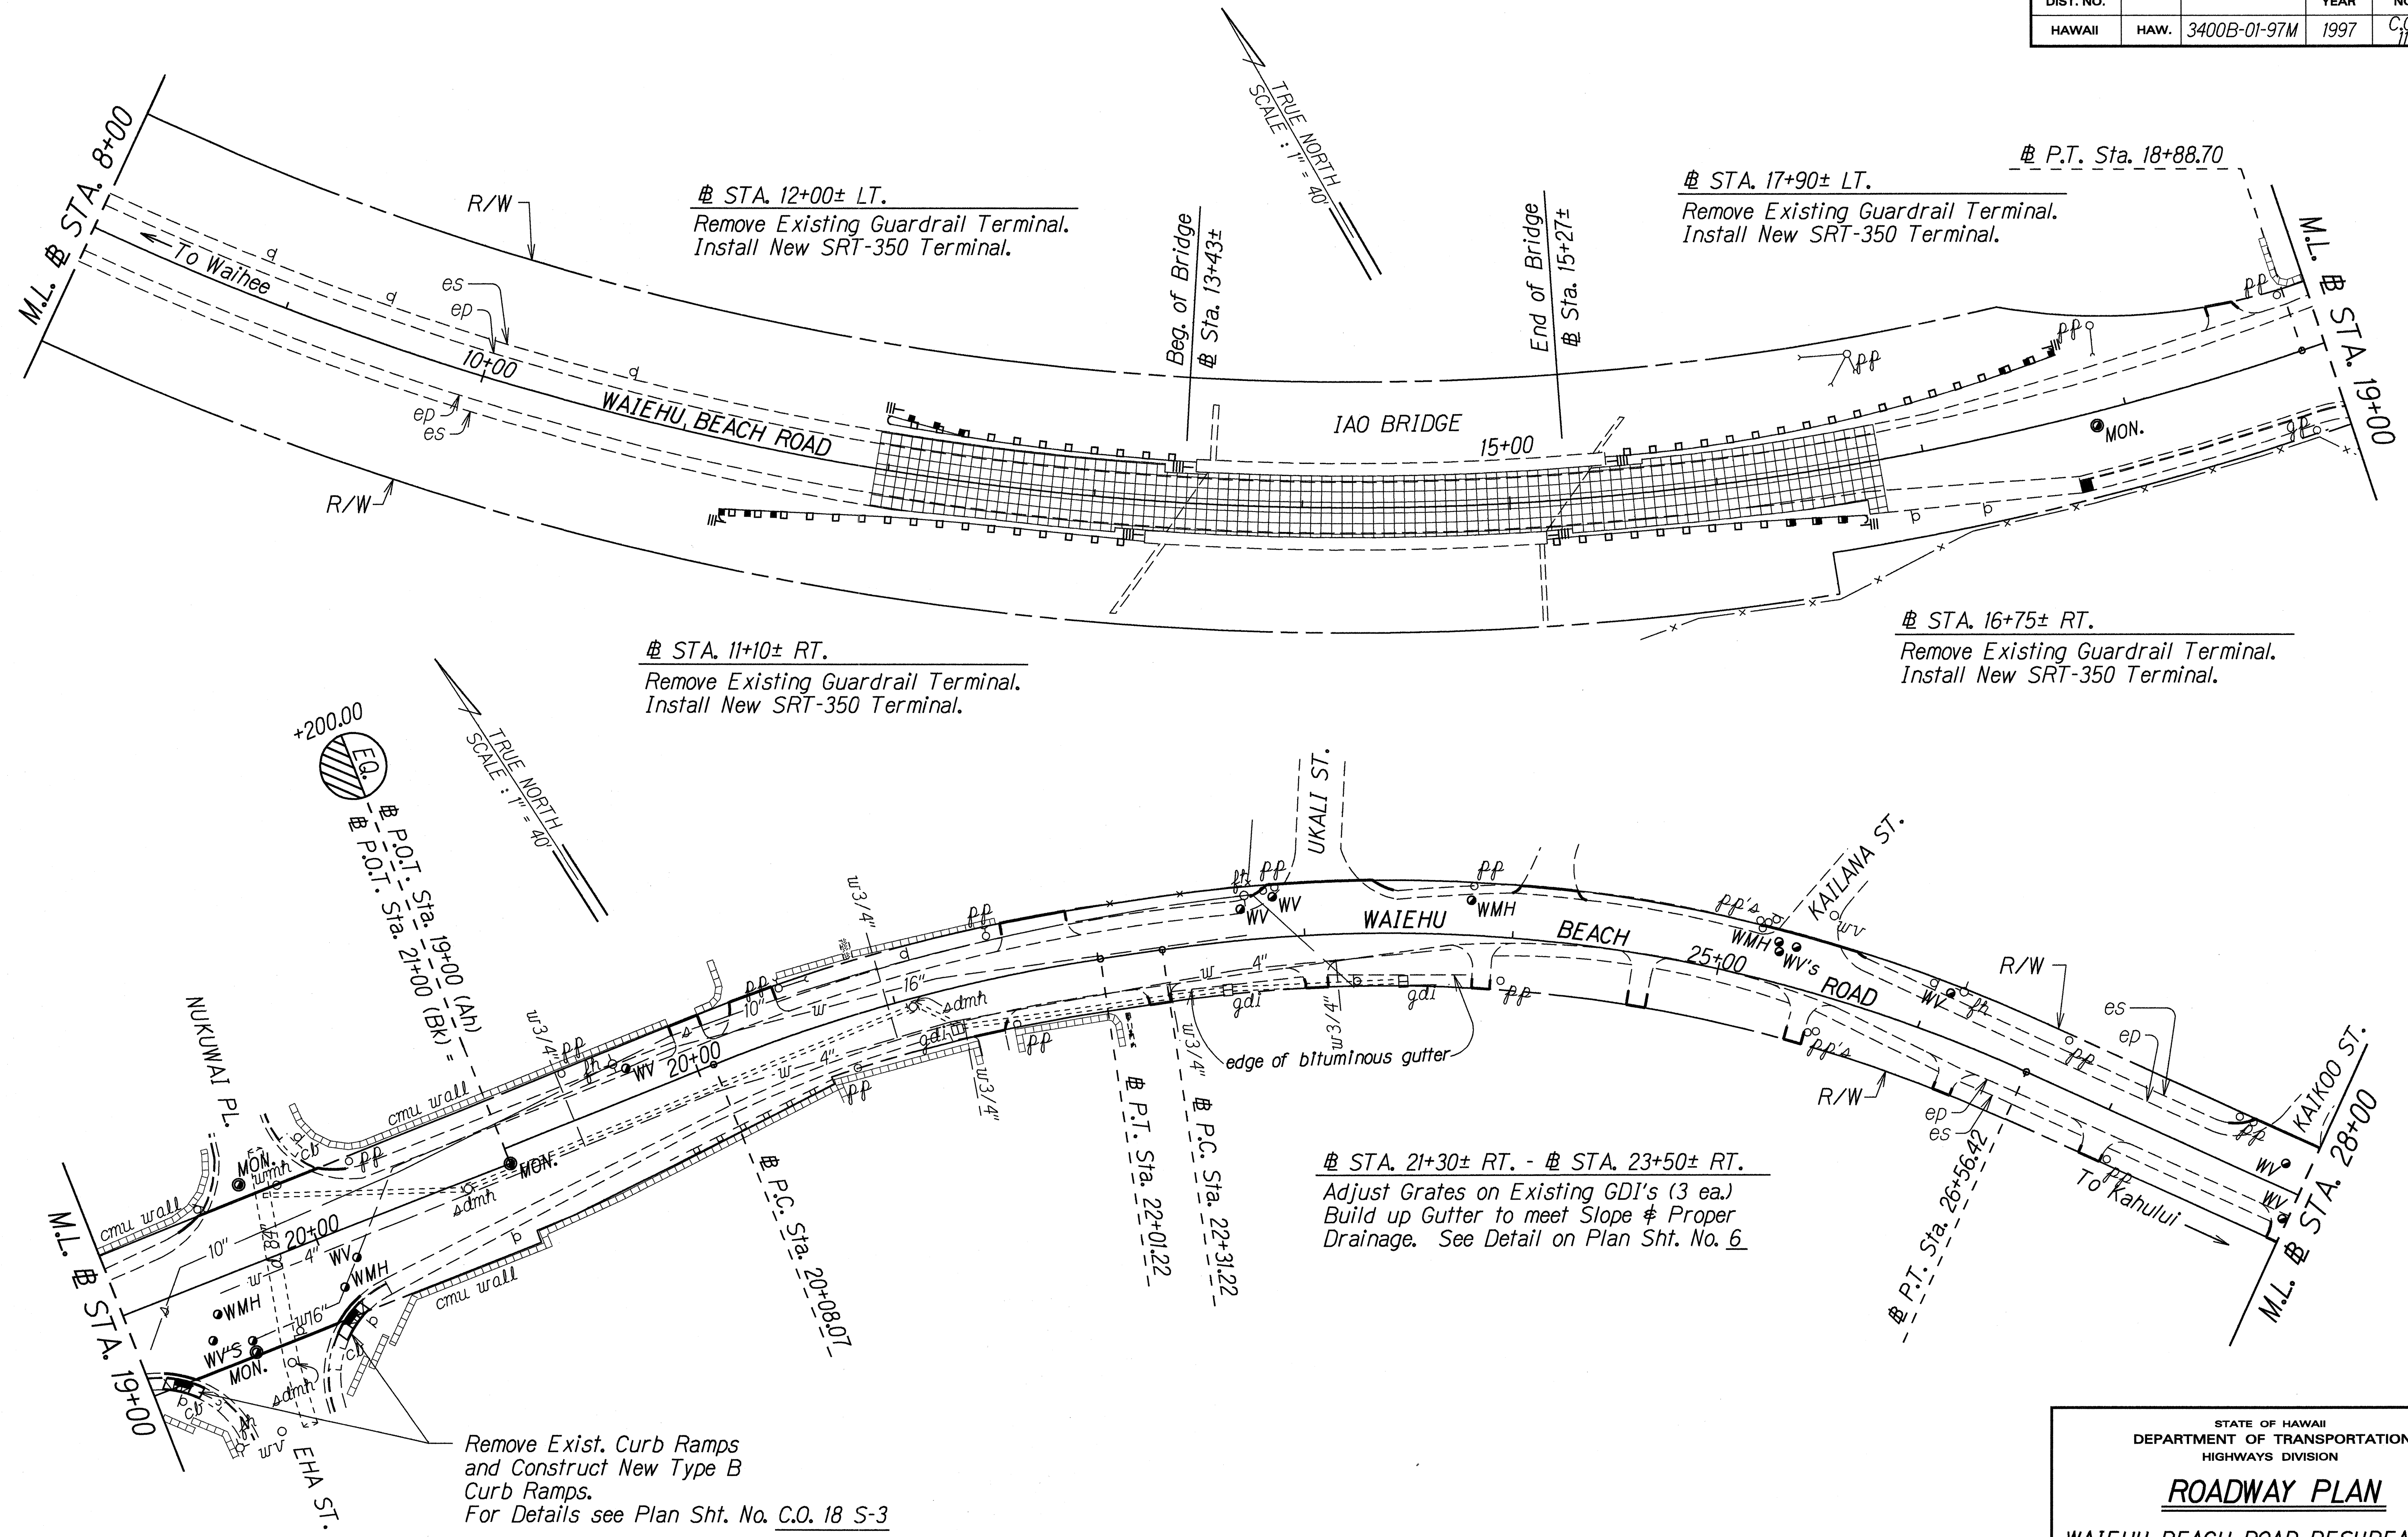

DESIGNED BY	DATE
TRACED BY	4-10-97
NOTED BY	3-97
QUANTITIES BY	5-97
CHECKED BY	

4/3/98	Remove Exist. Curb Ramps & Install New Type B Curb Ramp
DATE	REVISION

STATE OF HAWAII
DEPARTMENT OF TRANSPORTATION
HIGHWAYS DIVISION

ROADWAY PLAN

WAIIEHU BEACH ROAD RESURFACING
Kahekili Highway to Kahului Beach Road
Project No. 3400B-01-97M

Scale: 1" = 40' Date: April 1997

SHEET No. 4 OF 5 SHEETS

