


FED. ROAD DIST. NO.	STATE	PROJ. NO.	FISCAL YEAR	SHEET NO.	TOTAL SHEETS
HAWAII	HAW.	3400B-01-97M	1997	15	22

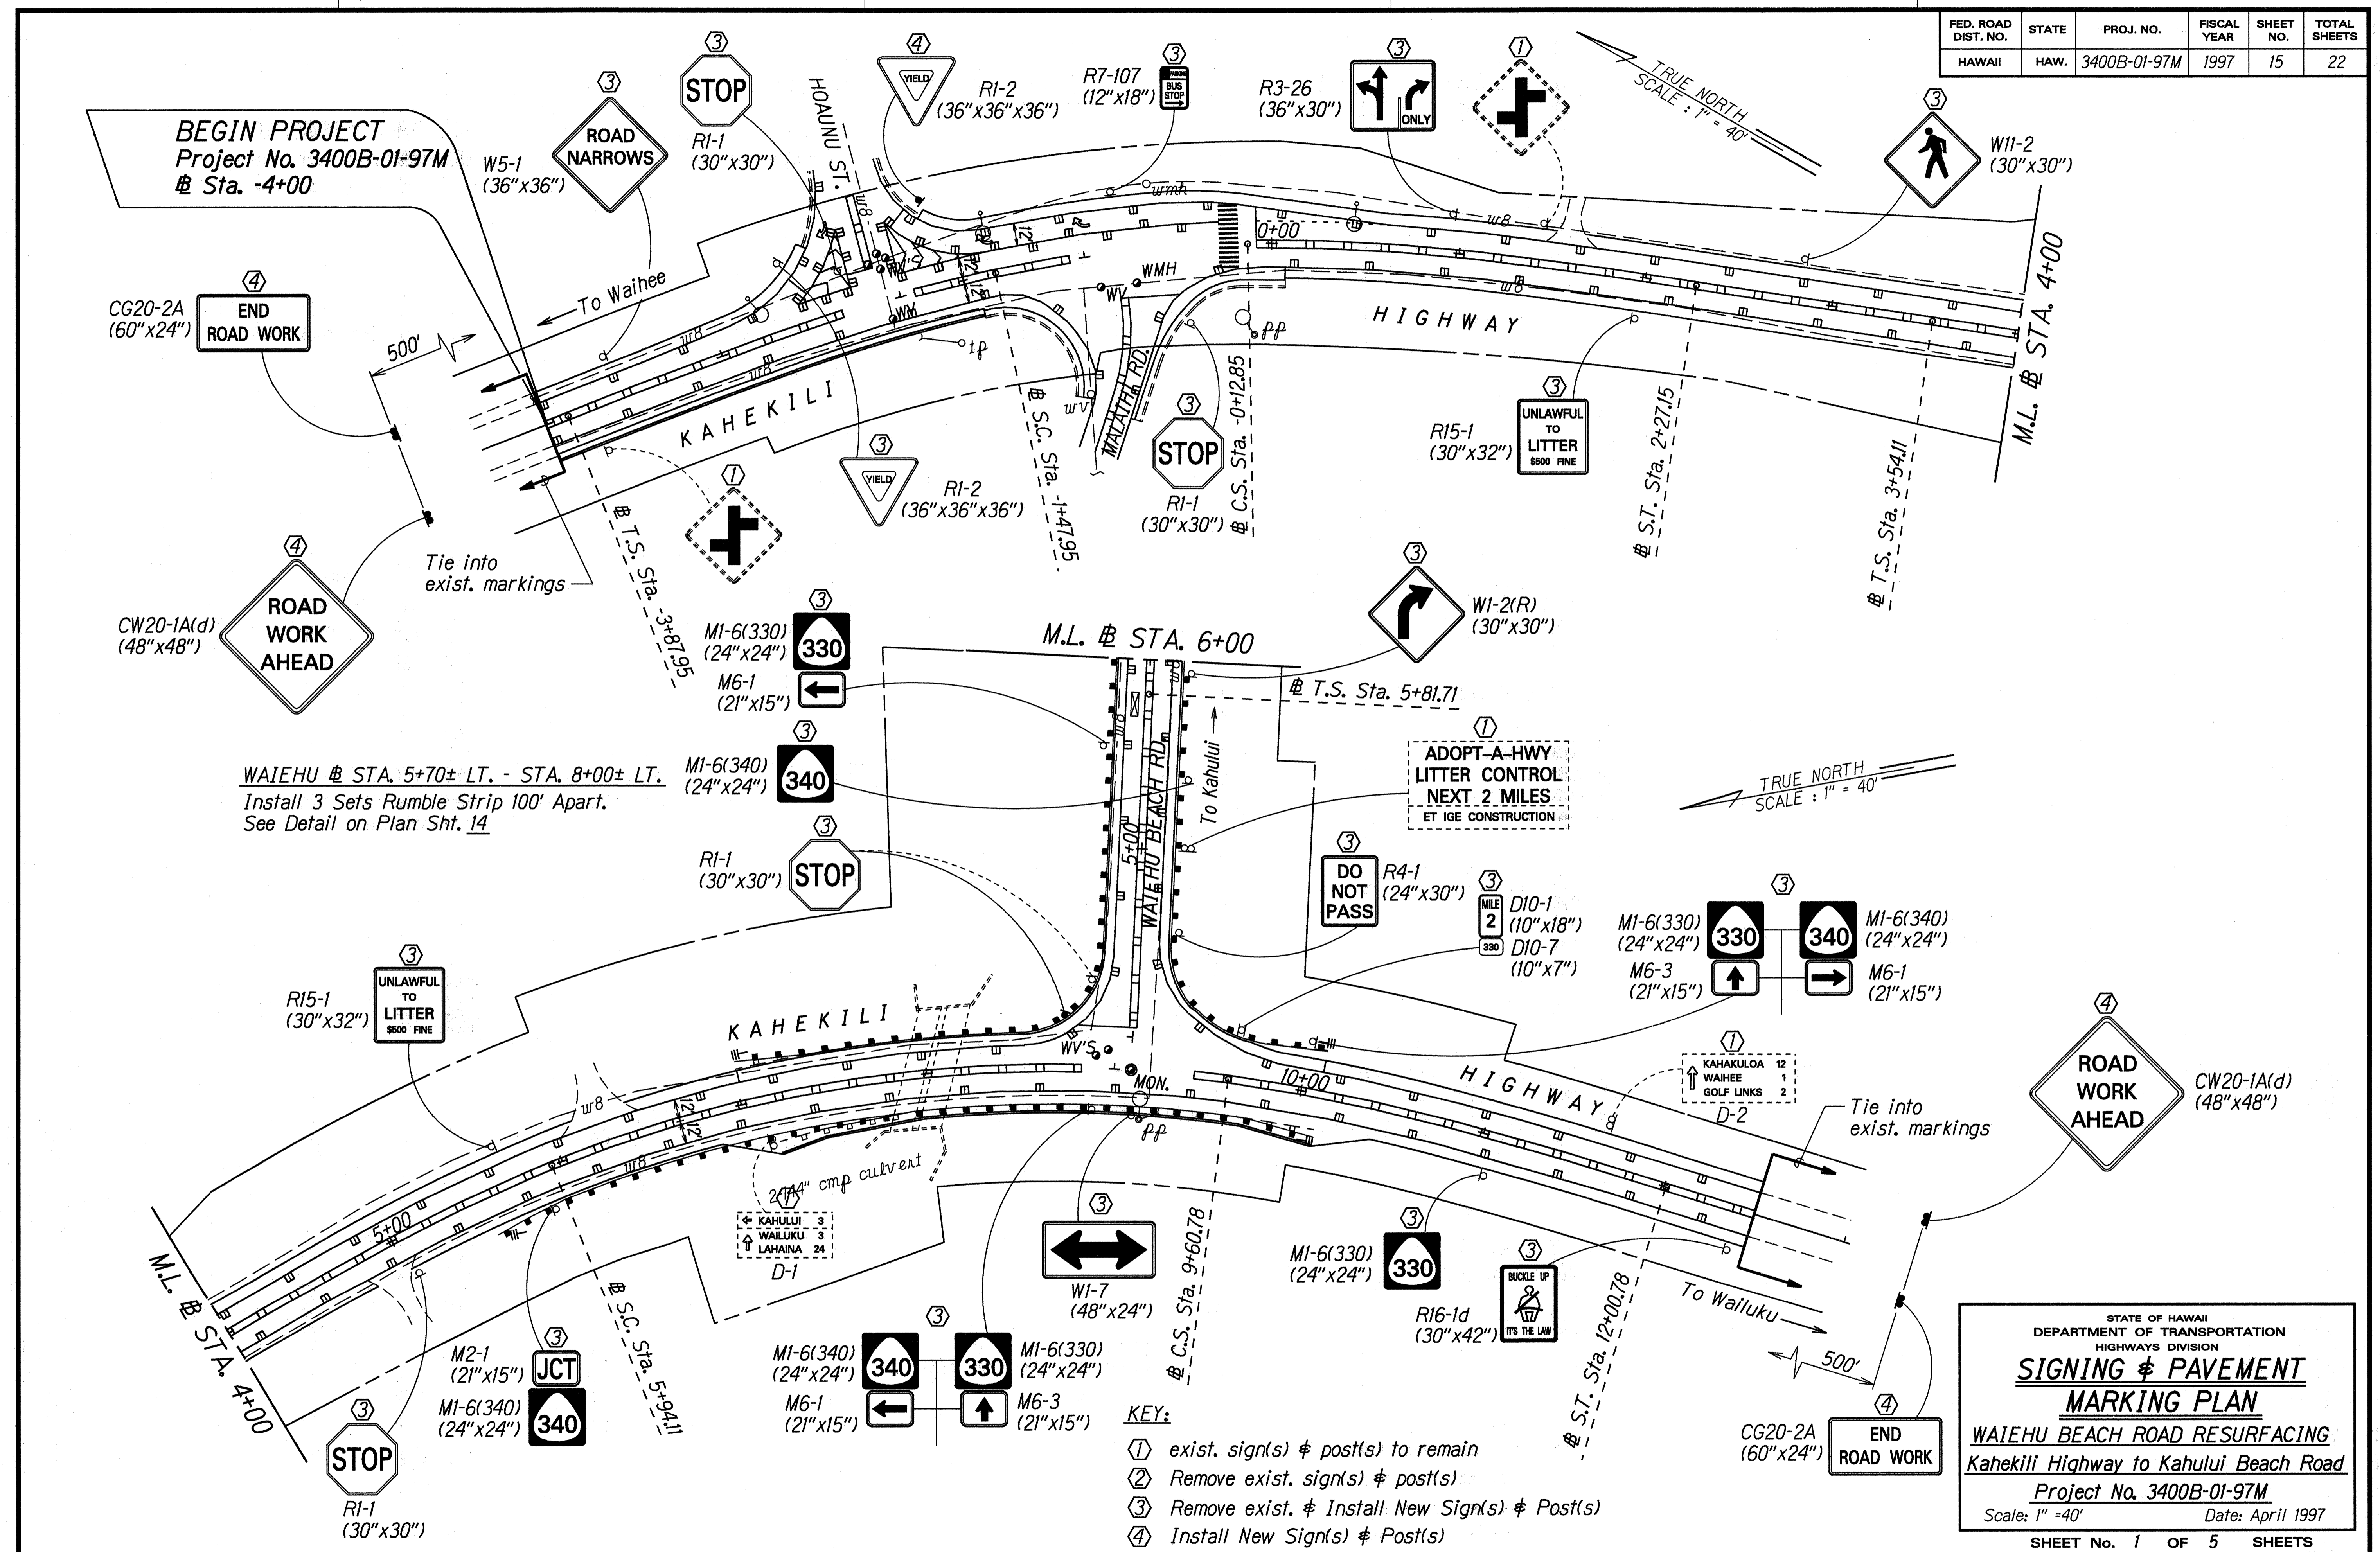

BEGIN PROJECT
Project No. 3400B-01-97M
@ Sta. -4+00

CG20-2A
(60"x24")

CW20-1A(d)
(48"x48")

ROAD WORK AHEAD

WAIEHU @ STA. 5+70± LT. - STA. 8+00± LT.
Install 3 Sets Rumble Strip 100' Apart.
See Detail on Plan Sht. 14

TRUE NORTH
SCALE: 1" = 40'

TRUE NORTH
SCALE: 1" = 40'

CW20-1A(d)
(48"x48")

ROAD WORK AHEAD

DATE	4-10-97
DESIGNED BY	W. J. ...
DRAWN BY	...
CHECKED BY	...
APPROVED BY	...

- KEY:**
- ① exist. sign(s) & post(s) to remain
 - ② Remove exist. sign(s) & post(s)
 - ③ Remove exist. & Install New Sign(s) & Post(s)
 - ④ Install New Sign(s) & Post(s)


STATE OF HAWAII
DEPARTMENT OF TRANSPORTATION
HIGHWAYS DIVISION

SIGNING & PAVEMENT MARKING PLAN

WAIEHU BEACH ROAD RESURFACING
Kahekili Highway to Kahului Beach Road
Project No. 3400B-01-97M
Scale: 1" = 40' Date: April 1997

SHEET No. 1 OF 5 SHEETS

FED. ROAD DIST. NO.	STATE	PROJ. NO.	FISCAL YEAR	SHEET NO.	TOTAL SHEETS
HAWAII	HAW.	3400B-01-97M	1997	17	22

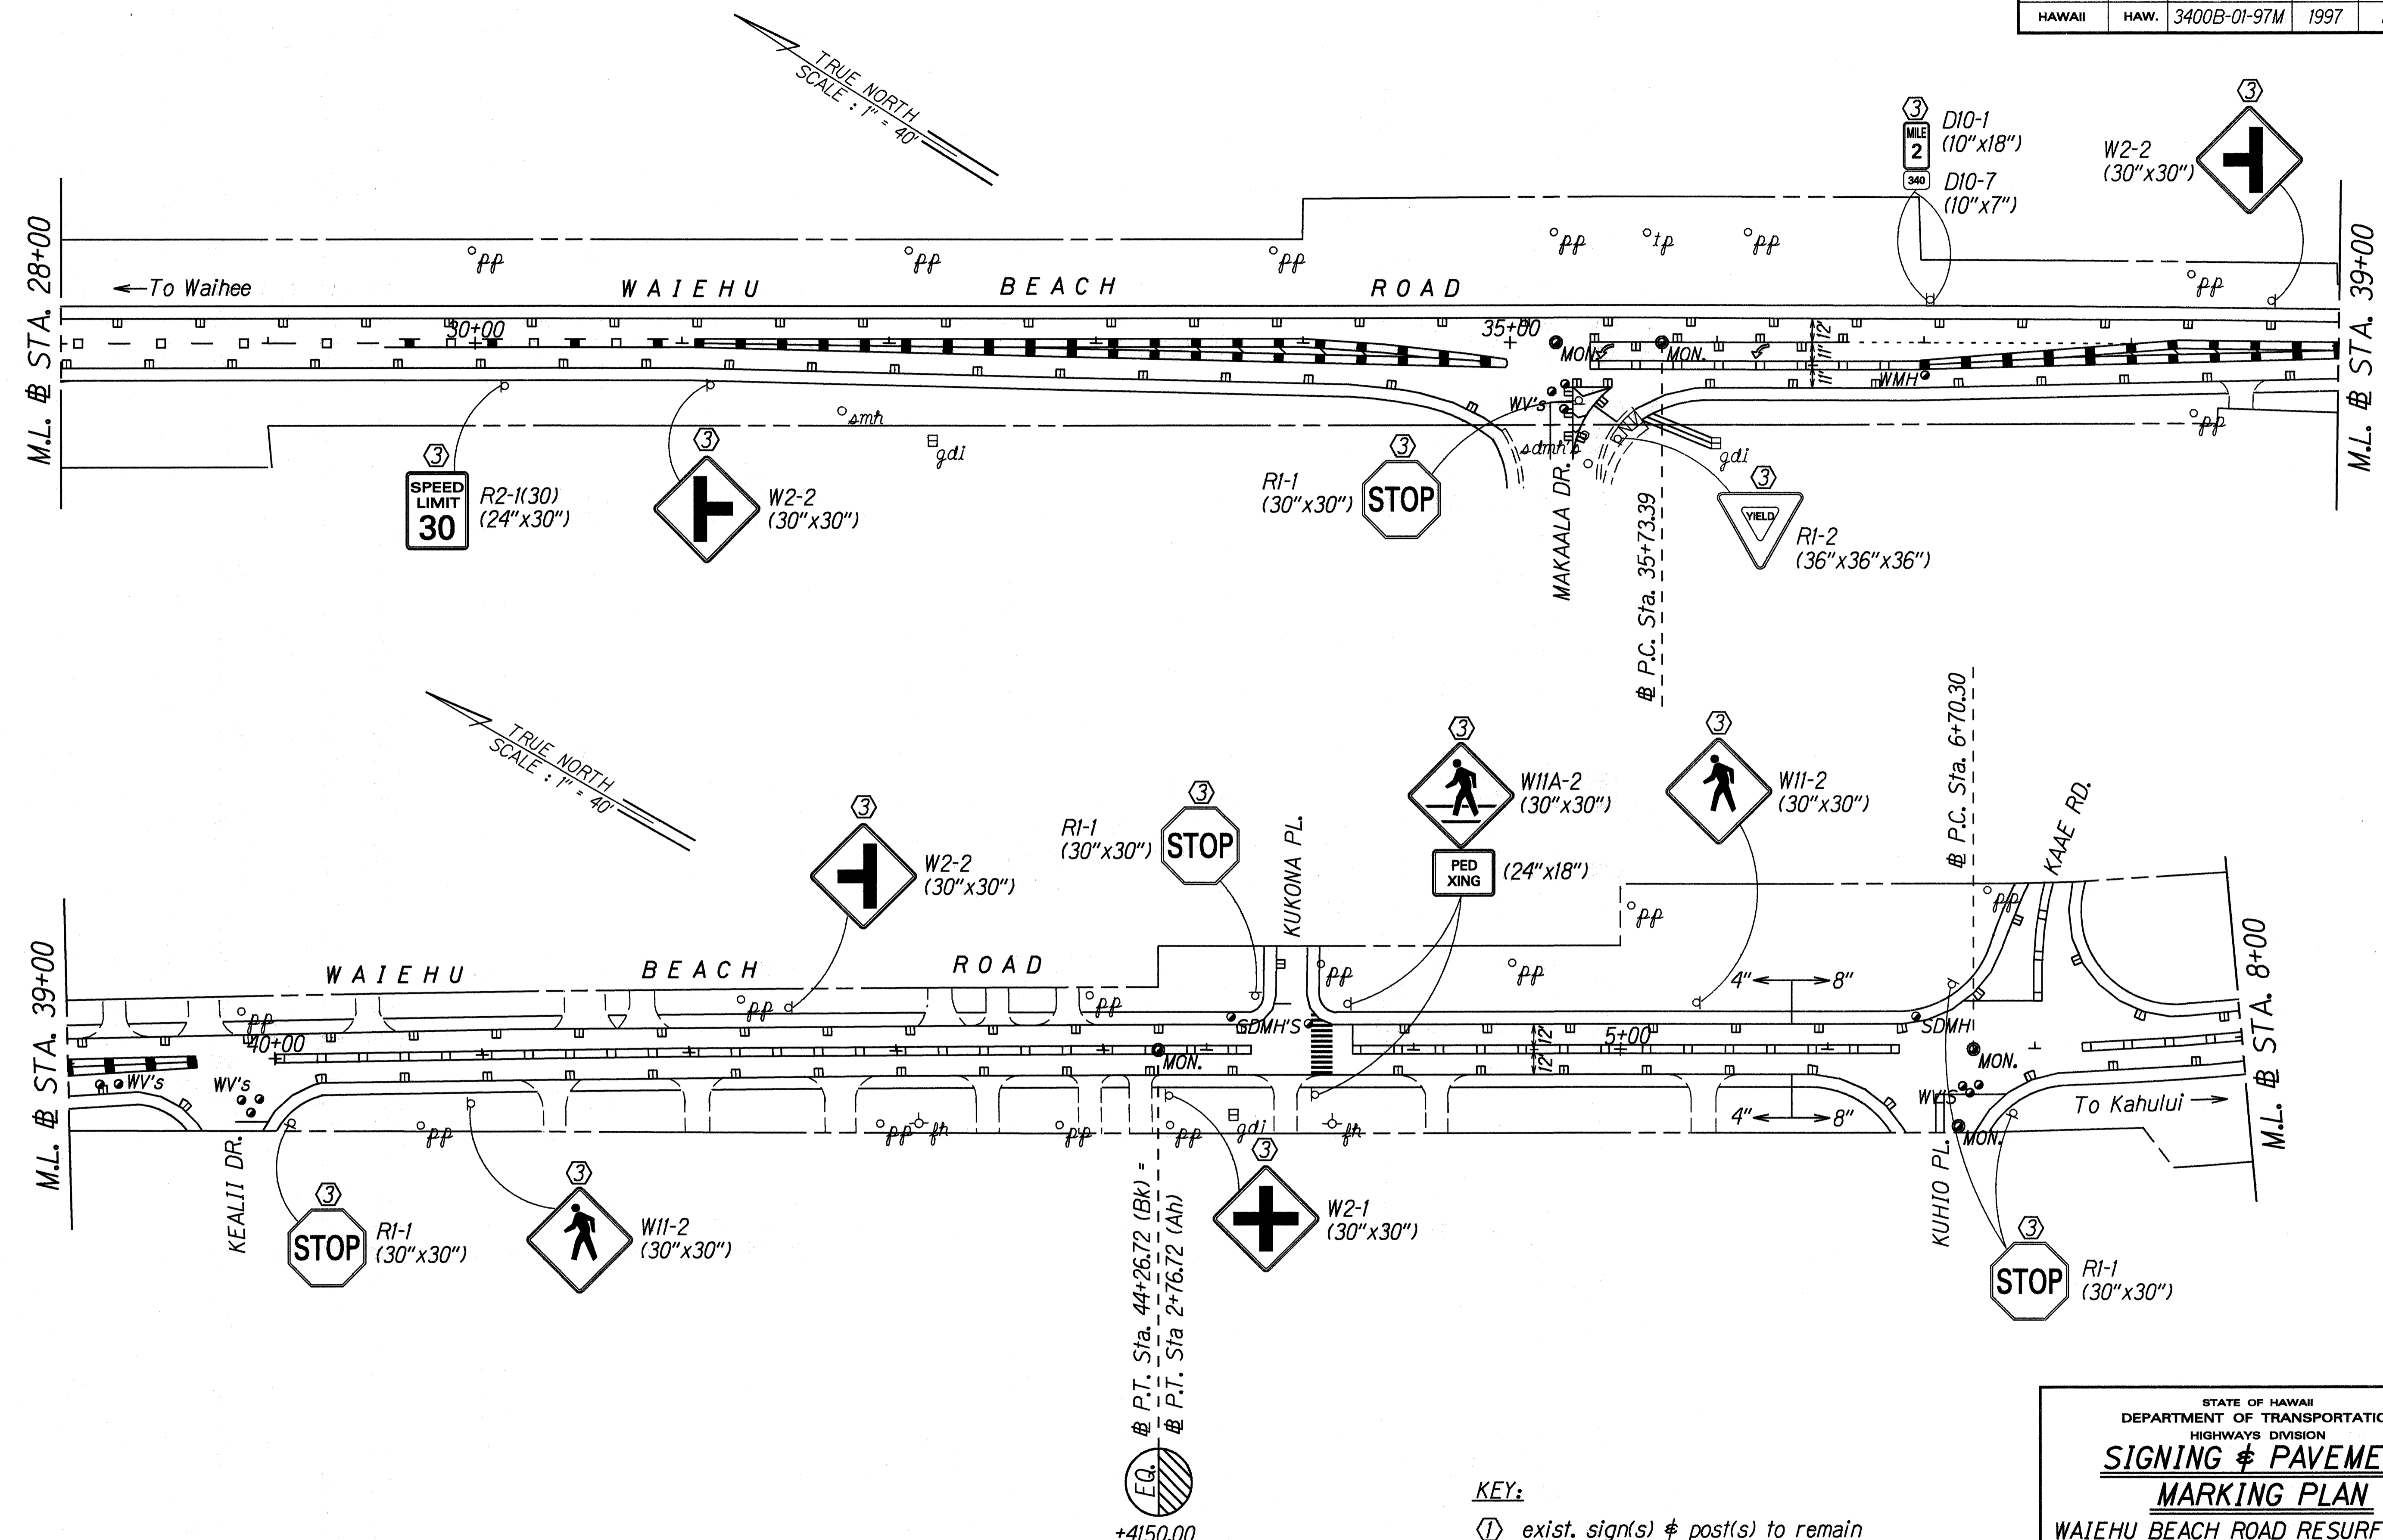


ORIGINAL PLAN	DATE
DESIGNED BY	4-10-97
TRACED BY	
QUANTITIES BY	
CHECKED BY	

EQ. # P.T. Sta. 44+26.72 (Bk) = +4150.00
 # P.T. Sta 2+76.72 (Ah)

- KEY:**
- ① exist. sign(s) & post(s) to remain
 - ② Remove exist. sign(s) & post(s)
 - ③ Remove exist. & Install New Sign(s) & Post(s)
 - ④ Install New Sign(s) & Post(s)

STATE OF HAWAII
 DEPARTMENT OF TRANSPORTATION
 HIGHWAYS DIVISION
SIGNING & PAVEMENT MARKING PLAN
 WAIEHU BEACH ROAD RESURFACING
 Kahekili Highway to Kahului Beach Road
 Project No. 3400B-01-97M
 Scale: 1" = 40' Date: April 1997
 SHEET No. 3 OF 5 SHEETS

FED. ROAD DIST. NO.	STATE	PROJ. NO.	FISCAL YEAR	SHEET NO.	TOTAL SHEETS
HAWAII	HAW.	3400B-01-97M	1997	C.O. 18	22

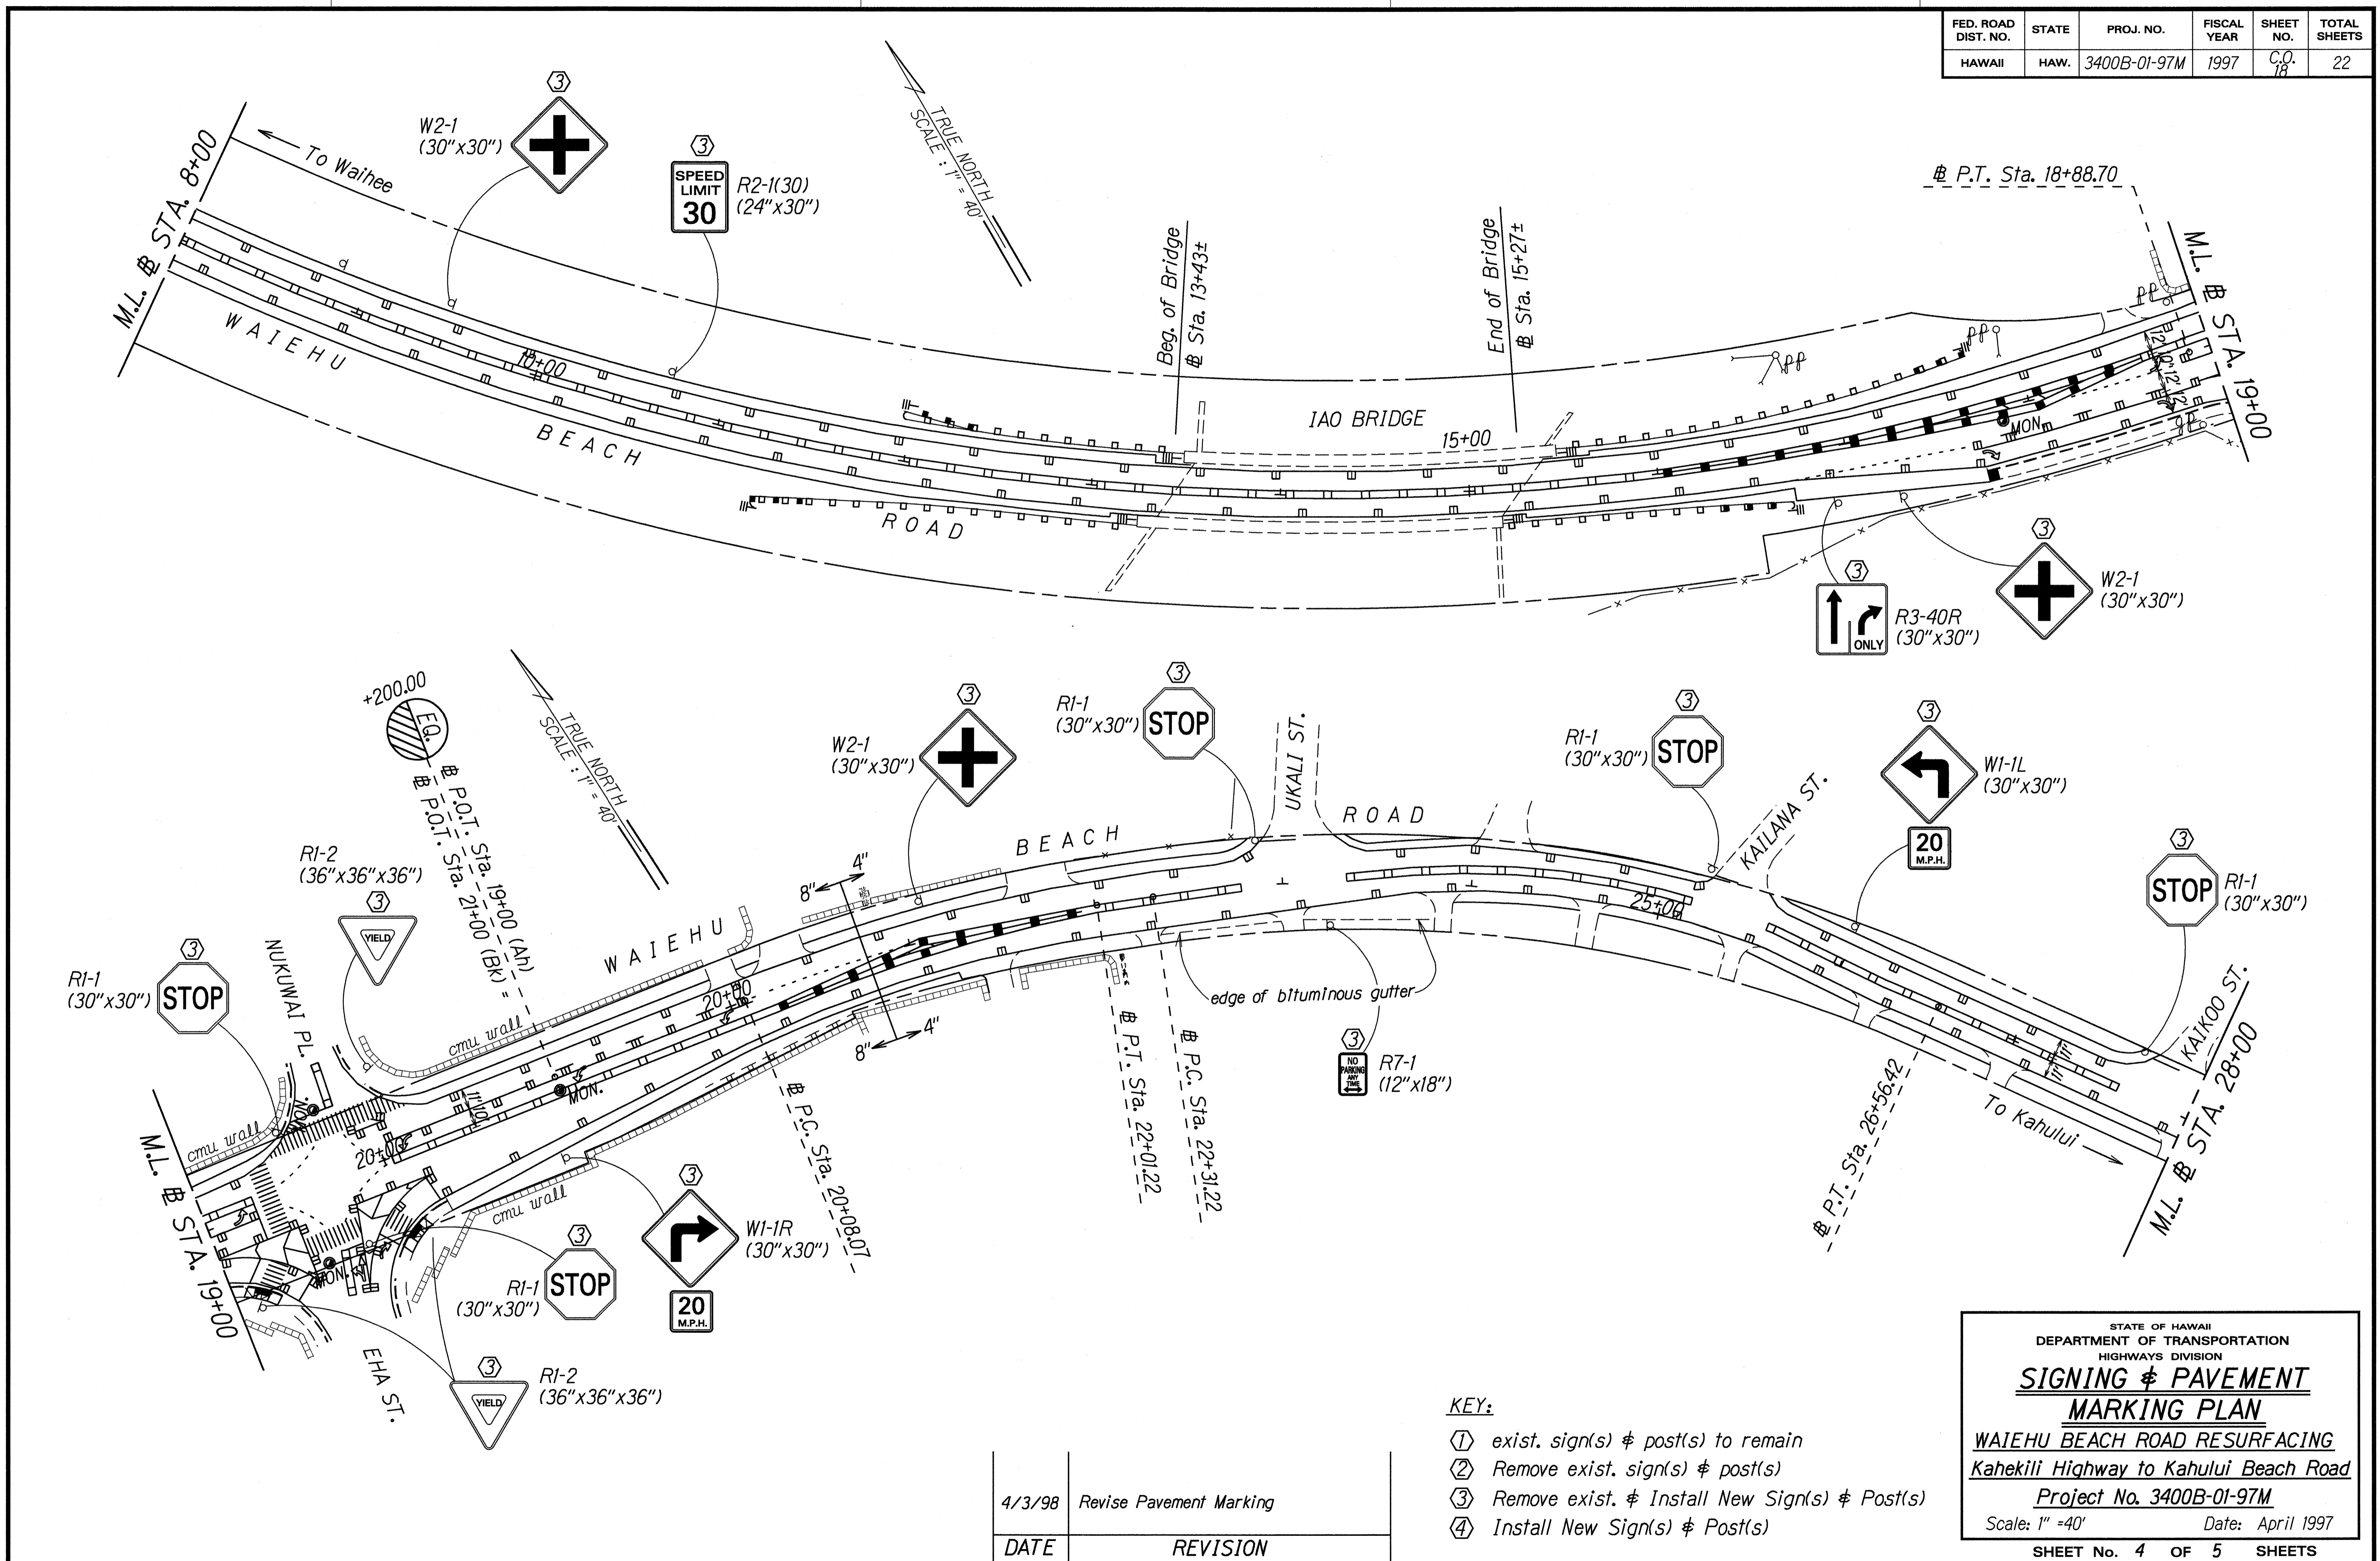

DATE	4-8-97
DESIGNED BY	M. C. Abe (Geo.)
TRACED BY	M. C. Abe (Geo.)
NOTED BY	M. C. Abe (Geo.)
QUANTITIES BY	M. C. Abe (Geo.)
CHECKED BY	M. C. Abe (Geo.)

DATE	REVISION
4/3/98	Revise Pavement Marking

- KEY:**
- ① exist. sign(s) & post(s) to remain
 - ② Remove exist. sign(s) & post(s)
 - ③ Remove exist. & Install New Sign(s) & Post(s)
 - ④ Install New Sign(s) & Post(s)

STATE OF HAWAII
DEPARTMENT OF TRANSPORTATION
HIGHWAYS DIVISION

**SIGNING & PAVEMENT
MARKING PLAN**


**WAIEHU BEACH ROAD RESURFACING
Kahekili Highway to Kahului Beach Road**

Project No. 3400B-01-97M

Scale: 1" = 40' Date: April 1997

SHEET No. 4 OF 5 SHEETS

FED. ROAD DIST. NO.	STATE	FED. AID PROJ. NO.	FISCAL YEAR	SHEET NO.	TOTAL SHEETS
HAWAII	HAW.	3400B-01-97M	1997	19	22

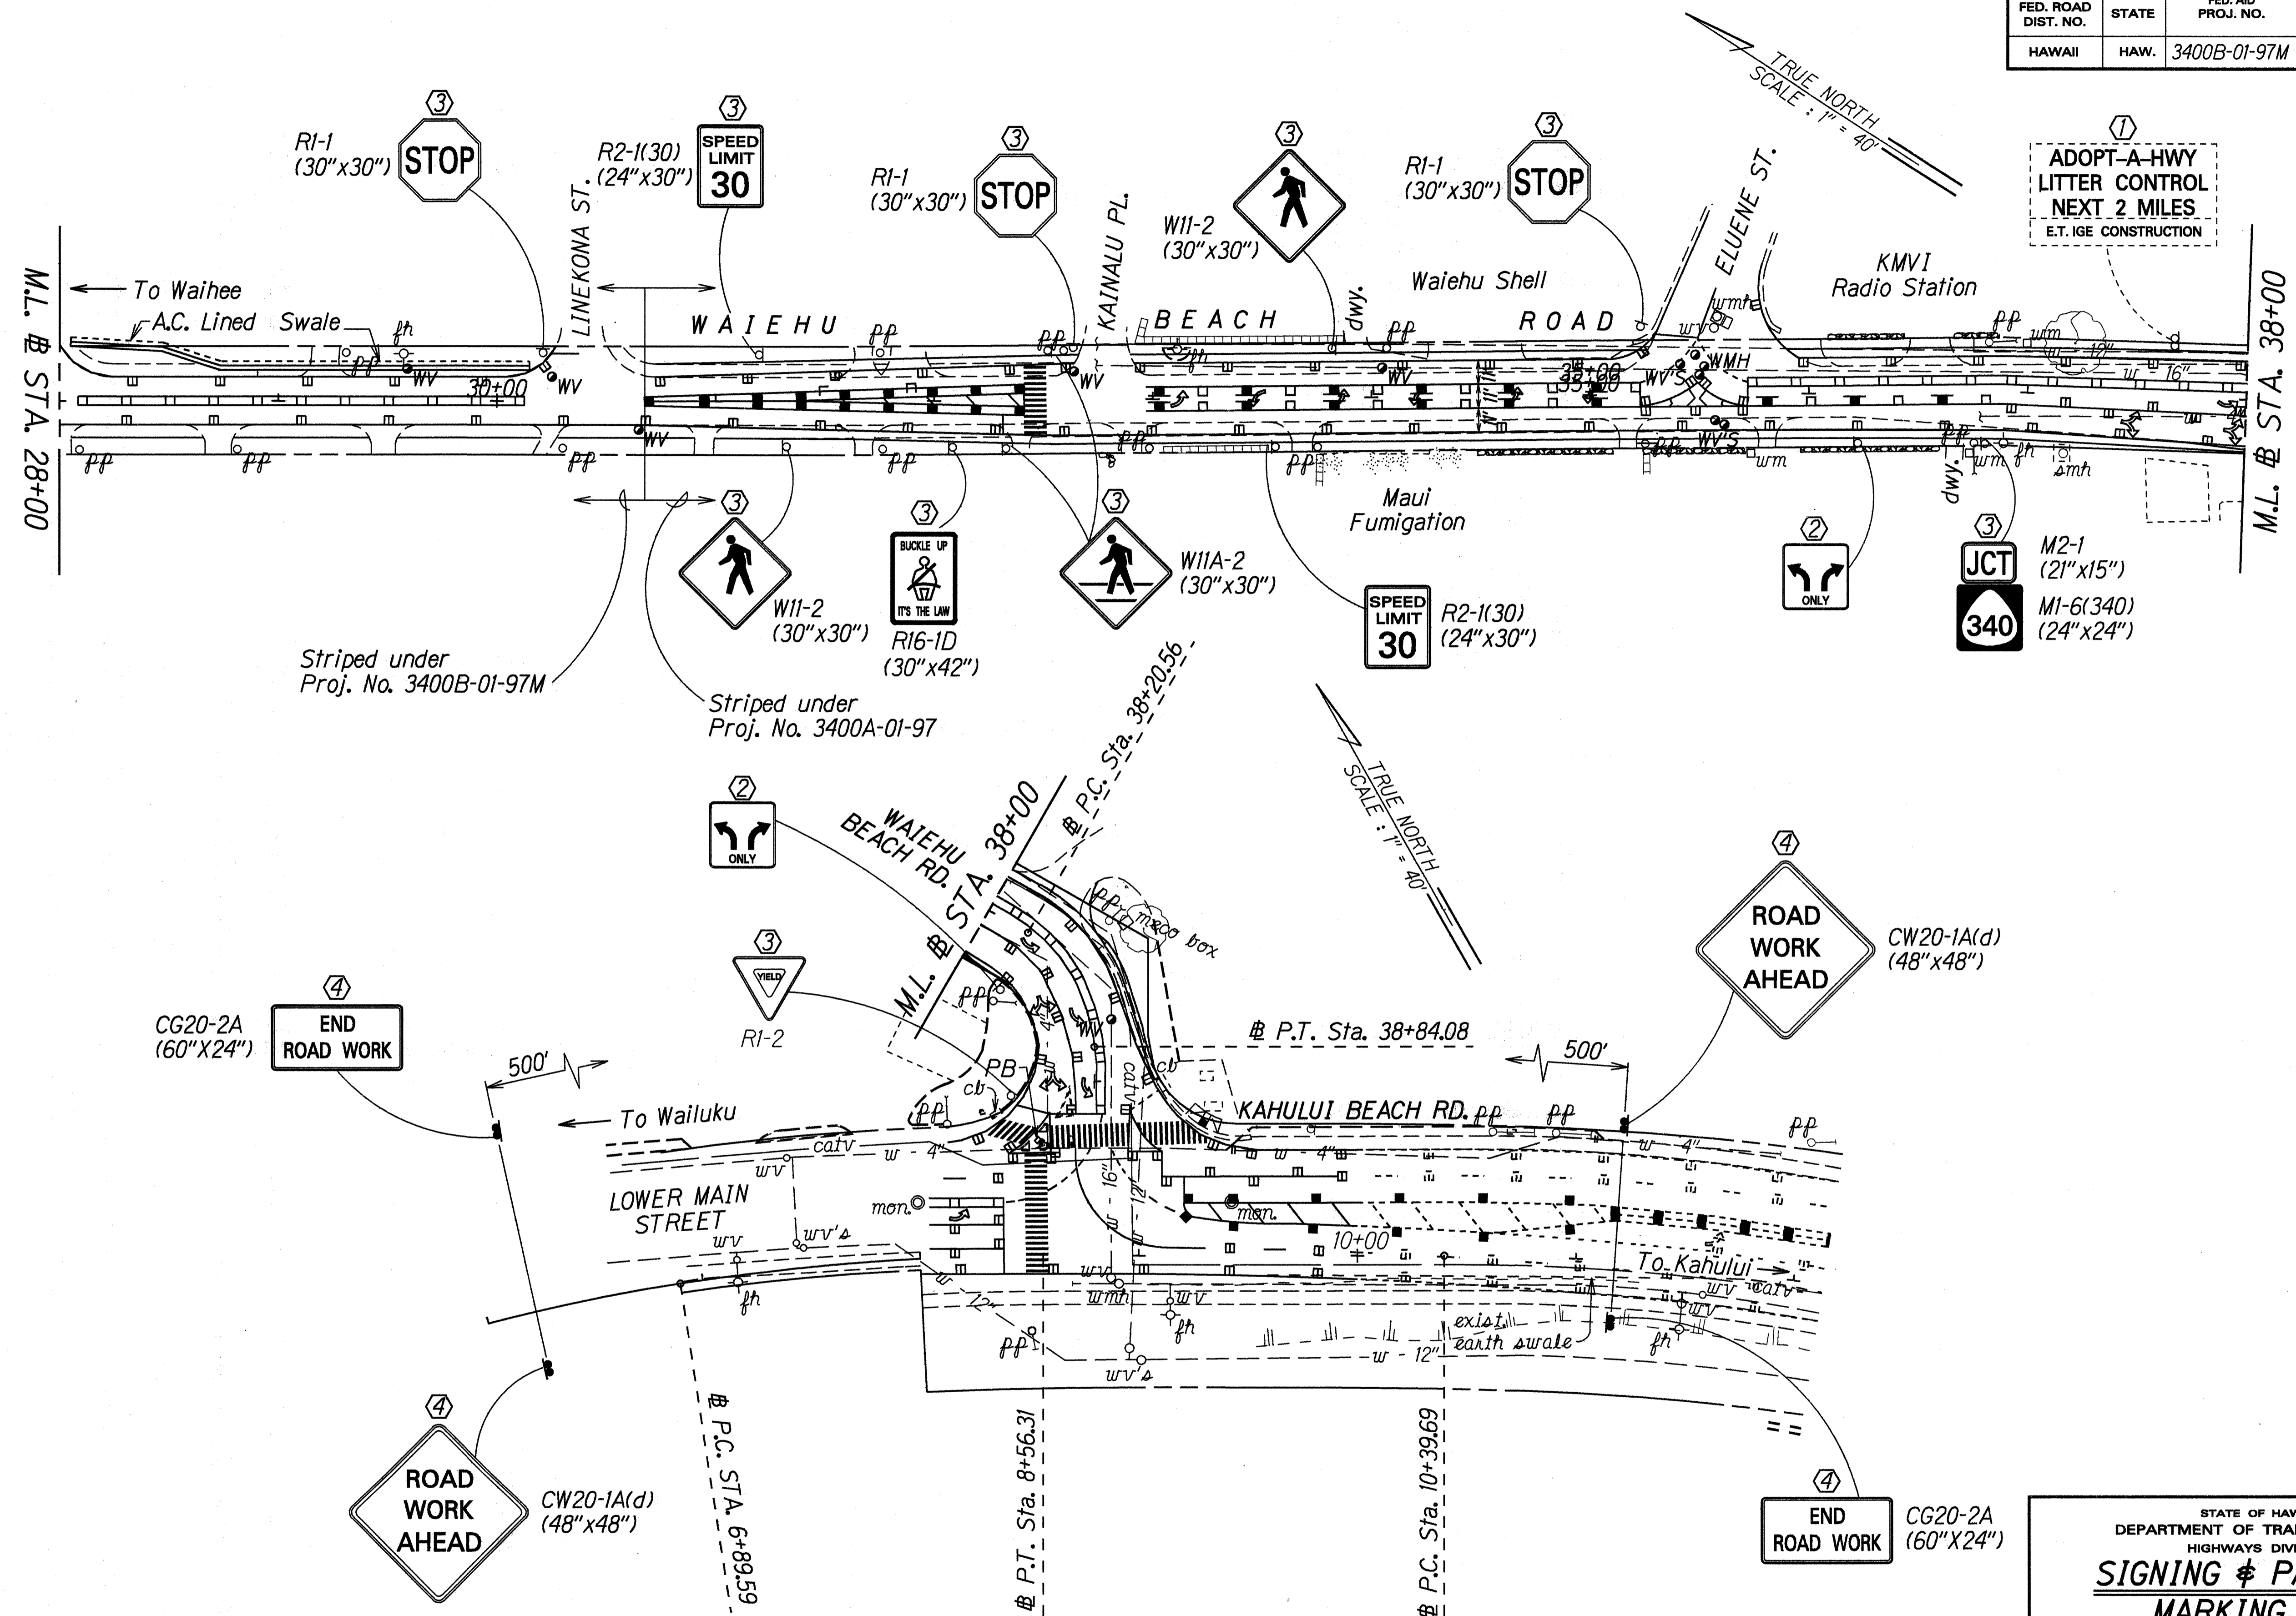

- KEY:**
- ① exist. sign(s) & post(s) to remain
 - ② Remove exist. sign(s) & post(s)
 - ③ Remove exist. & Install New Sign(s) & Post(s)
 - ④ Install New Sign(s) & Post(s)

DESIGNED BY	DATE
TRACED BY	4/10/97
QUANTITIES BY	
CHECKED BY	

STATE OF HAWAII
DEPARTMENT OF TRANSPORTATION
HIGHWAYS DIVISION

**SIGNING & PAVEMENT
MARKING PLAN**

**WAIIEHU BEACH ROAD RESURFACING
Kahekili Highway to Kahului Beach Road**

Project No. 3400B-01-97M

Scale: 1" = 40' Date: April 1997

SHEET No. 5 OF 5 SHEETS