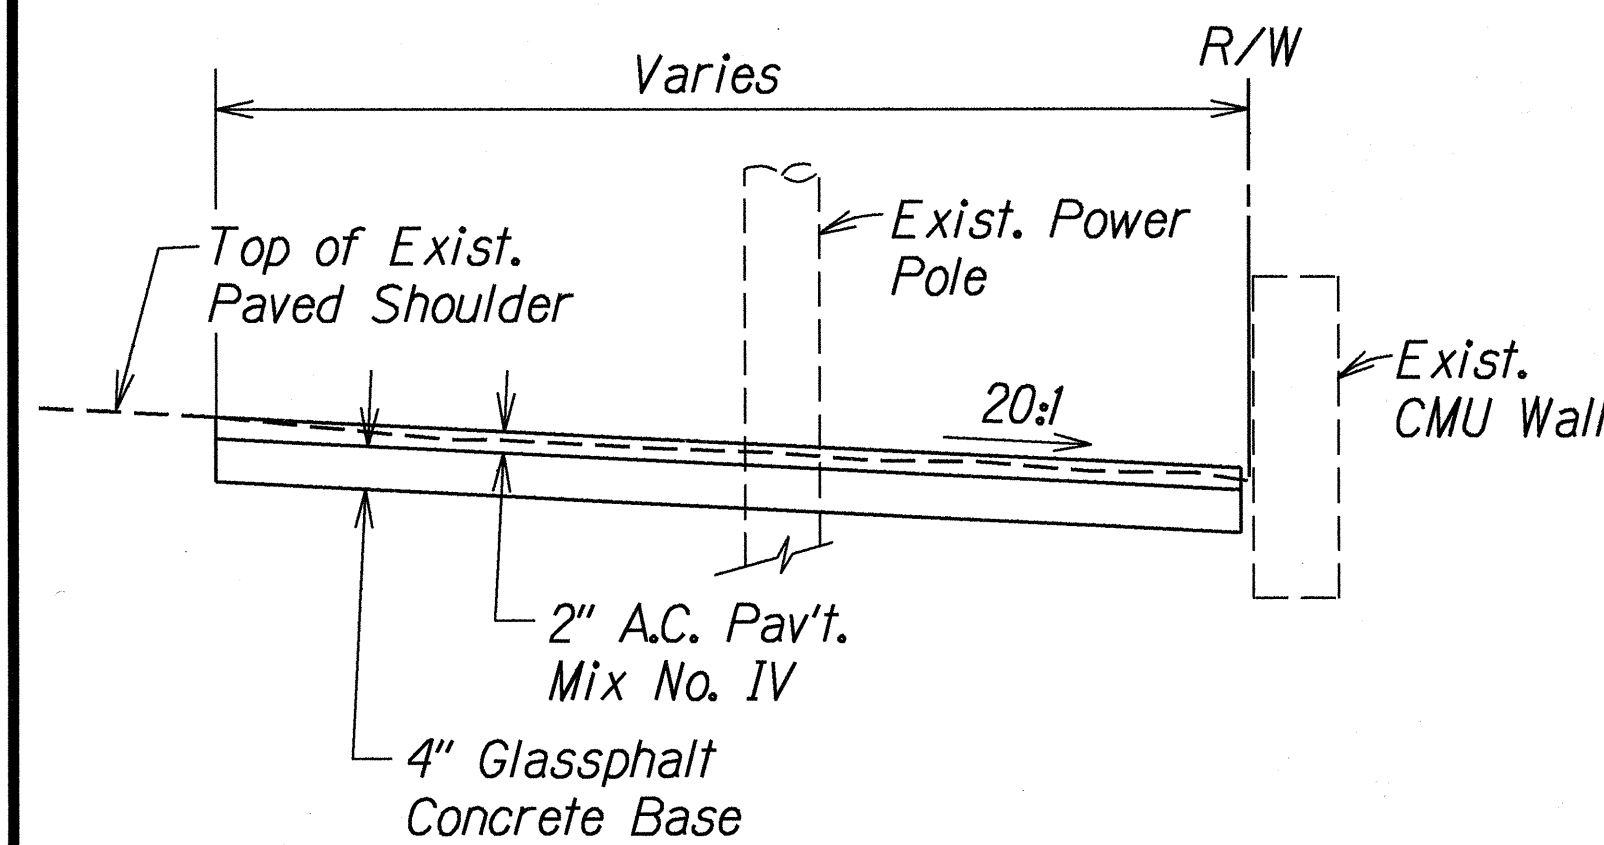
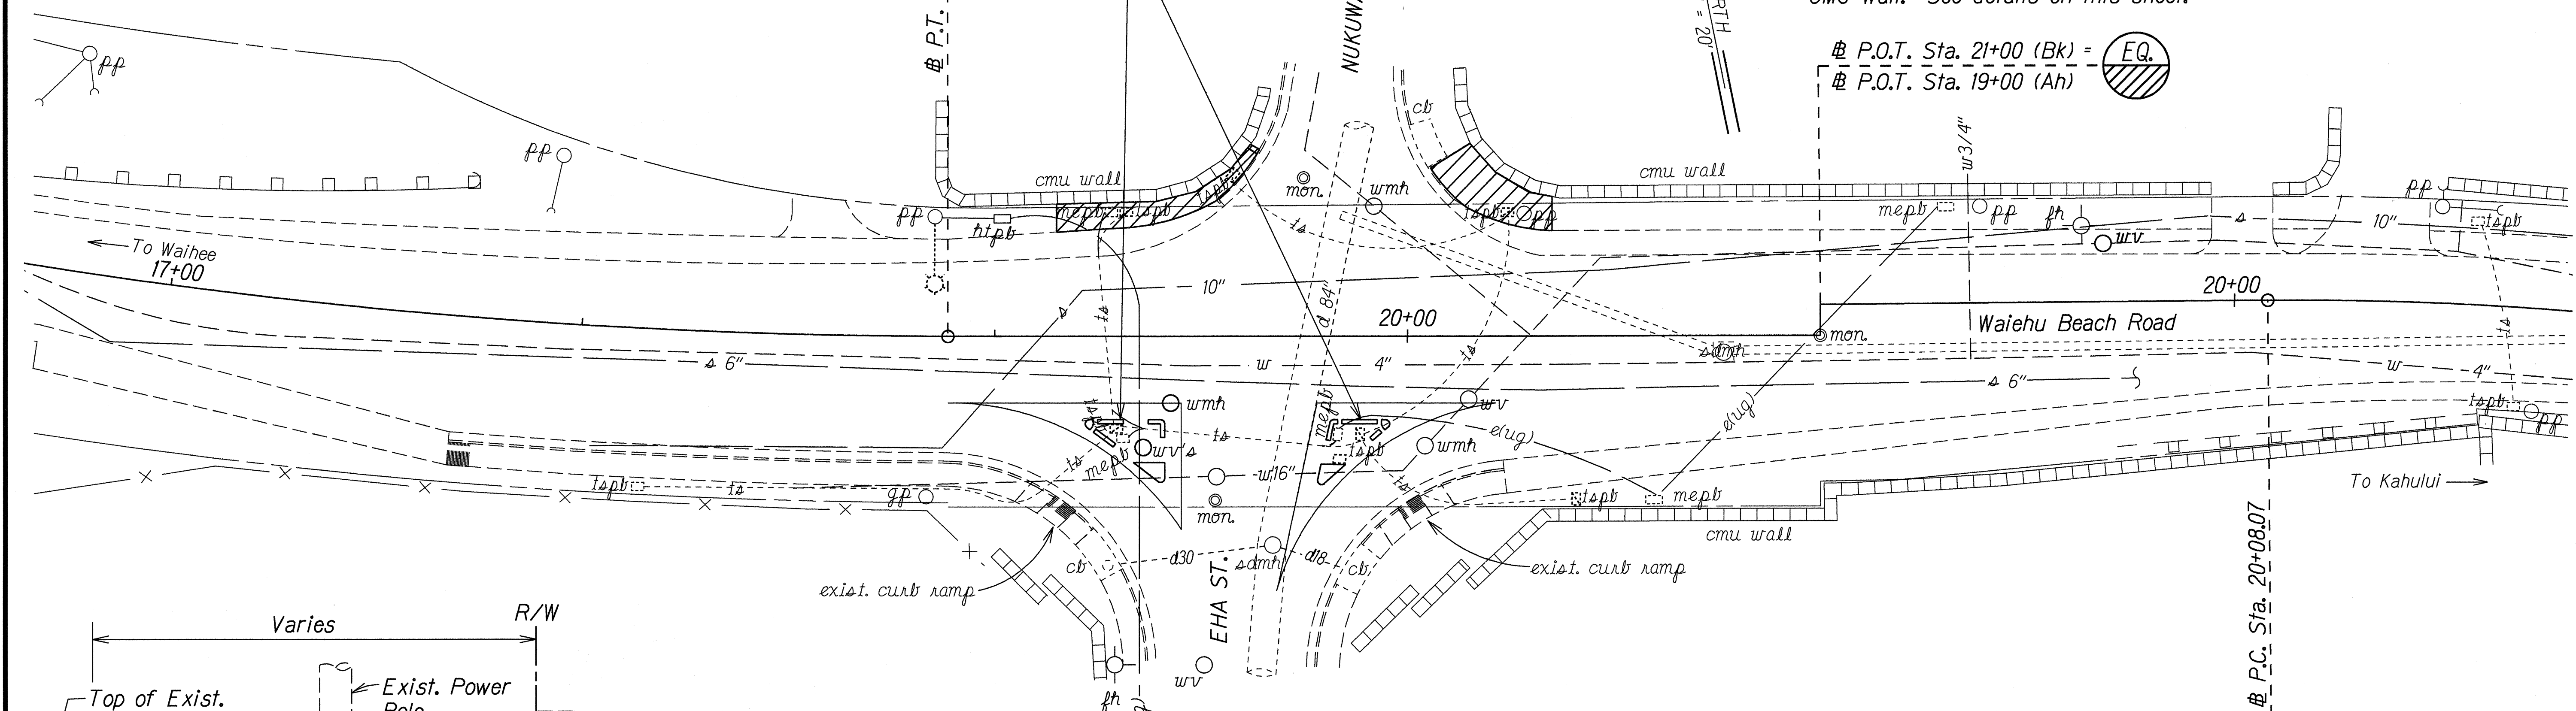


FED. ROAD DIST. NO.	STATE	PROJ. NO.	FISCAL YEAR	SHEET NO.	TOTAL SHEETS
HAWAII	HAW.	3400B-01-98	1998	C.O. 4	16

Sta. 19+15± Lt. to # Sta. 19+65± Lt.
Construct New A.C. Shoulder from Existing
Paved Shoulder or Concrete Curb to Existing
CMU Wall. See details on this sheet.


Construct New Bituminous Curb,
Type 6 (typical)
For Details, See Standard
Plan D-04

Sta. 20+05± Lt. to # Sta. 20+35± Lt.
Construct New A.C. Shoulder from Existing
Paved Shoulder or Concrete Curb to Existing
CMU Wall. See details on this sheet.

$$\frac{\$ \text{ P.O.T. Sta. 21+00 (Bk)}}{\$ \text{ P.O.T. Sta. 19+00 (Ah)}} = \text{EQ.}$$


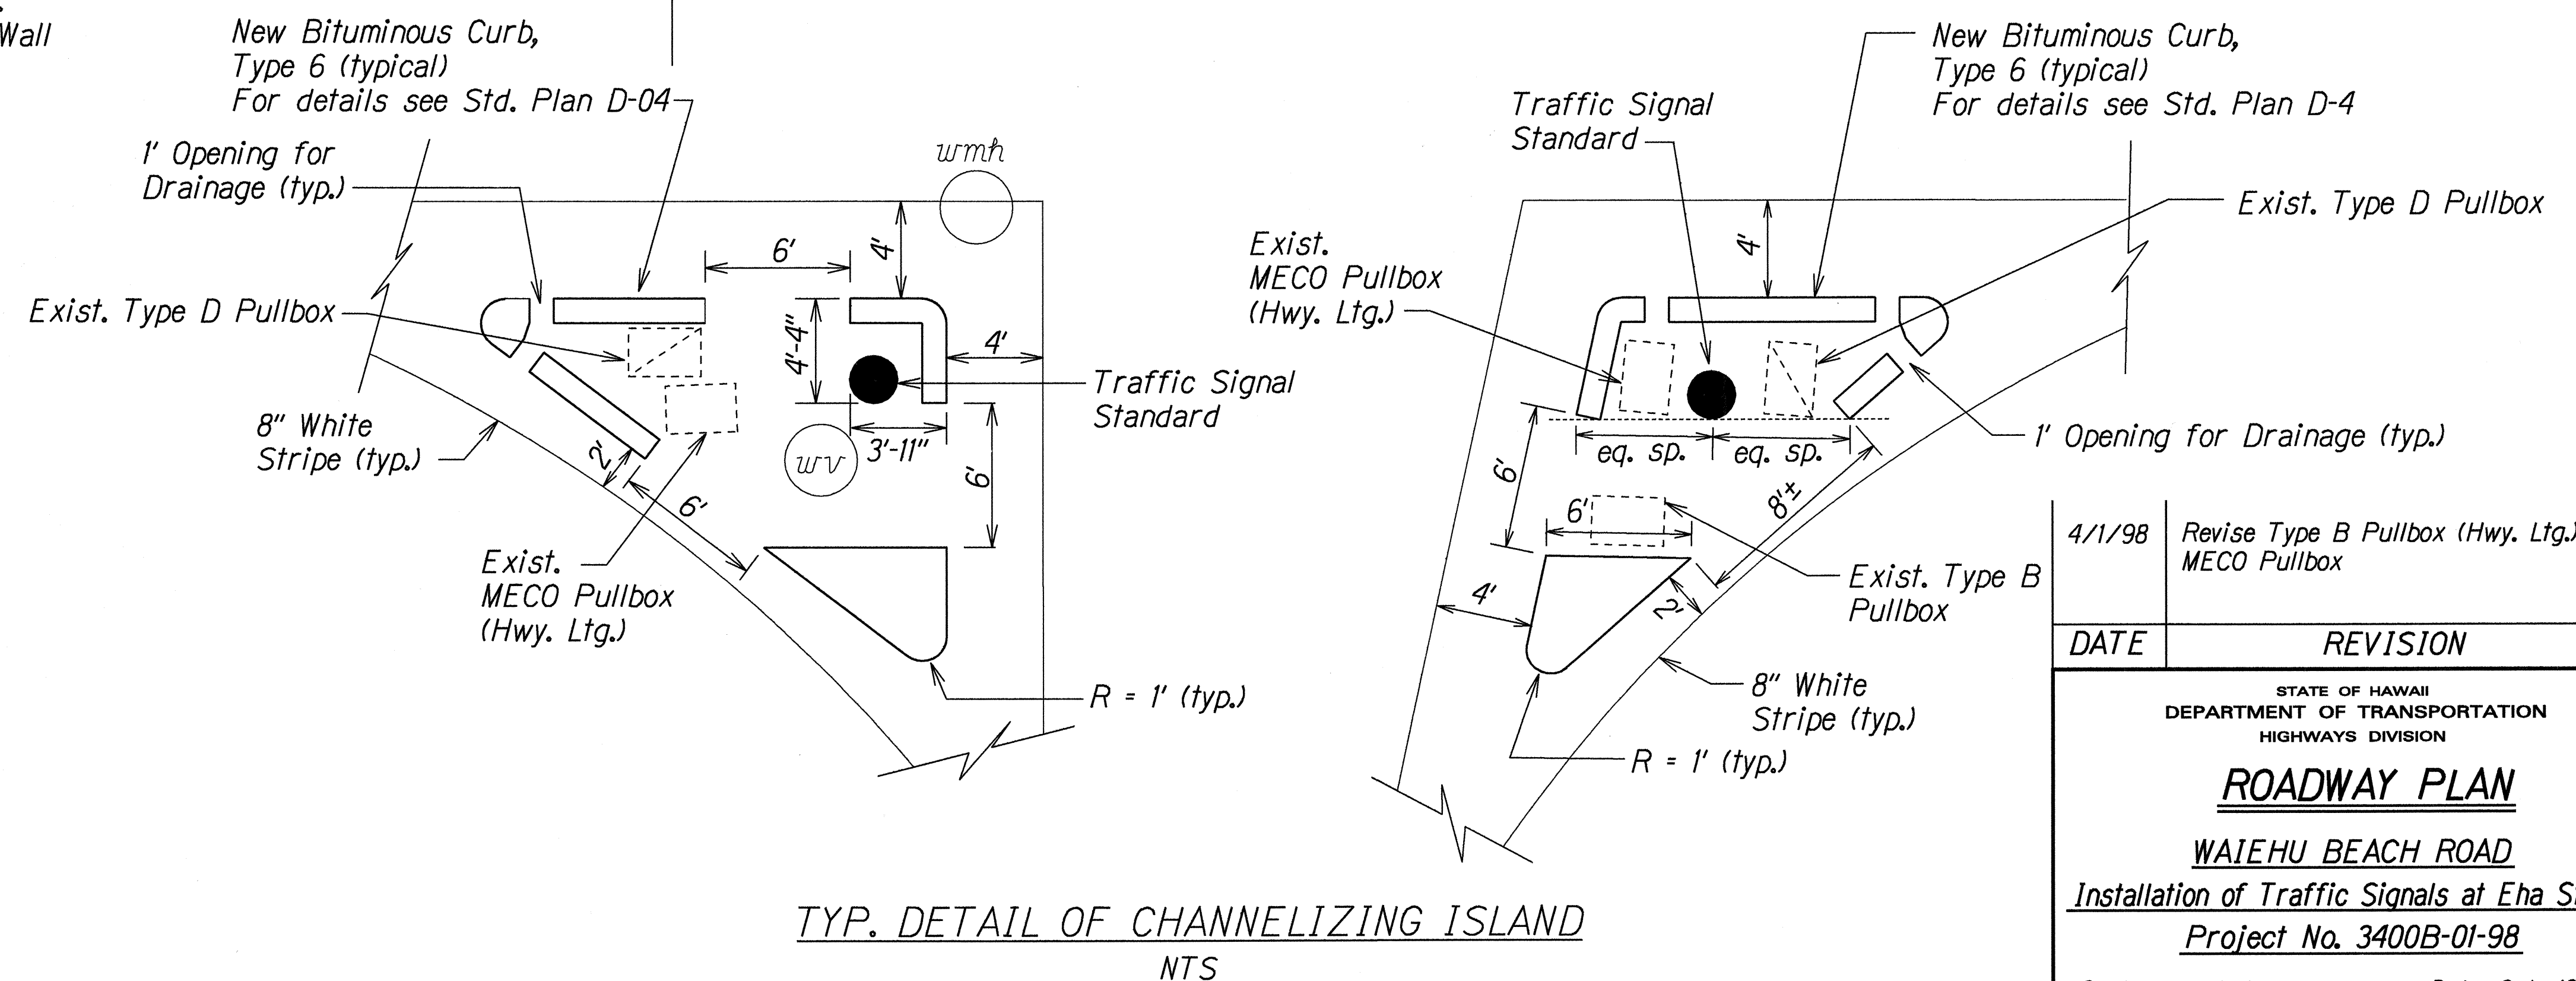
NEW A.C. SHOULDER DETAIL

NTS

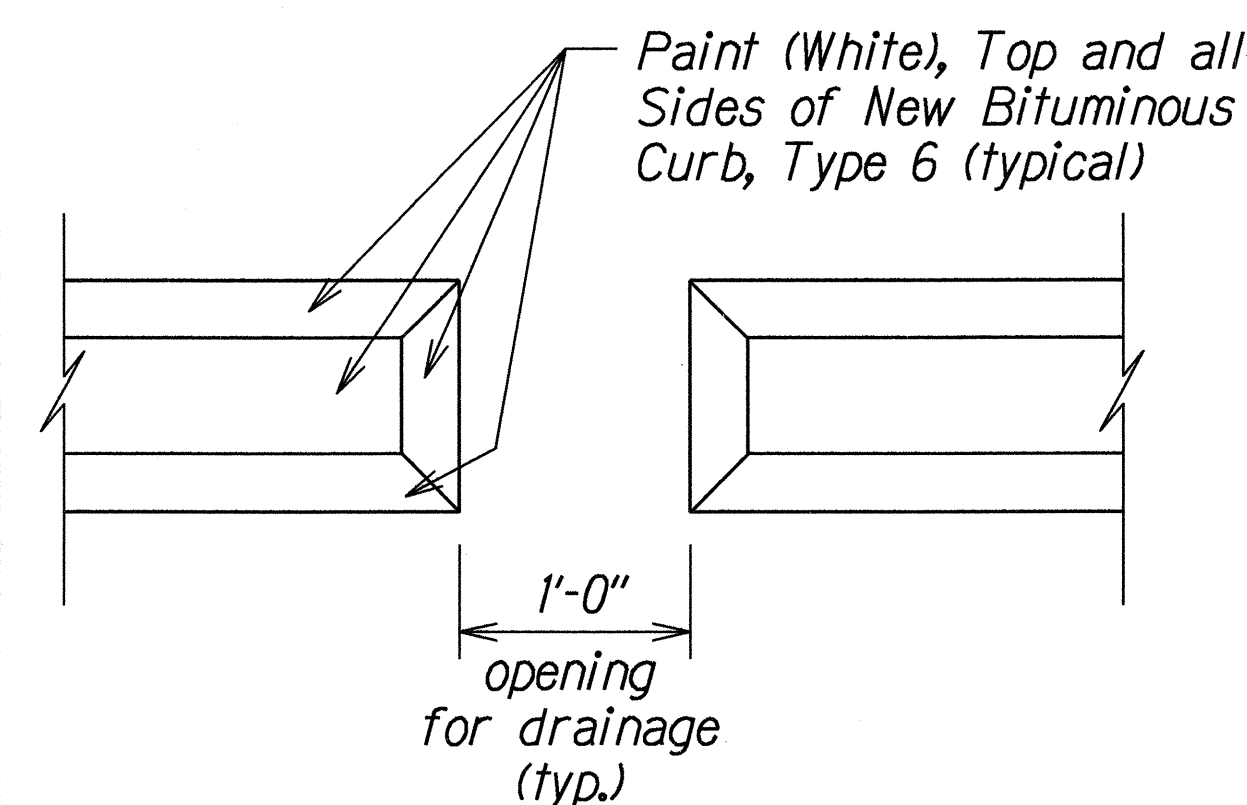

PAINT BITUMINOUS CURB

NTS



TYP. DETAIL OF CHANNELIZING ISLAND

NTS

4/1/98	Revise Type B Pullbox (Hwy. Ltg.) to MECO Pullbox
--------	--

<i>DATE</i>	<i>REVISION</i>
-------------	-----------------

STATE OF HAWAII
DEPARTMENT OF TRANSPORTATION
HIGHWAYS DIVISION

ROADWAY PLAN

WAIEHU BEACH ROAD

Installation of Traffic Signals at Eha Street
Project No. 3400B-01-98

Scale as noted Date: Oct., 1997

SHEET No. 1 OF 1 SHEETS

C.O. 4

ORIGINAL PLAN	SURVEY PLOTTED BY _____	DATE _____
NOTE BOOK	DRAWN BY <i>R. Acl</i>	_____
<i>4waifao</i>	TRACED BY _____	_____
	DESIGNED BY <i>C. Abe</i>	_____
	QUANTITIES BY <i>Idi/ruby</i>	_____
	CHECKED BY _____	_____
	_____	_____
	_____	_____
	_____	_____