


FED. ROAD DIST. NO.	STATE	PROJ. NO.	FISCAL YEAR	SHEET NO.	TOTAL SHEETS
HAWAII	HAW.	3400AB-01-03	2004	8	15

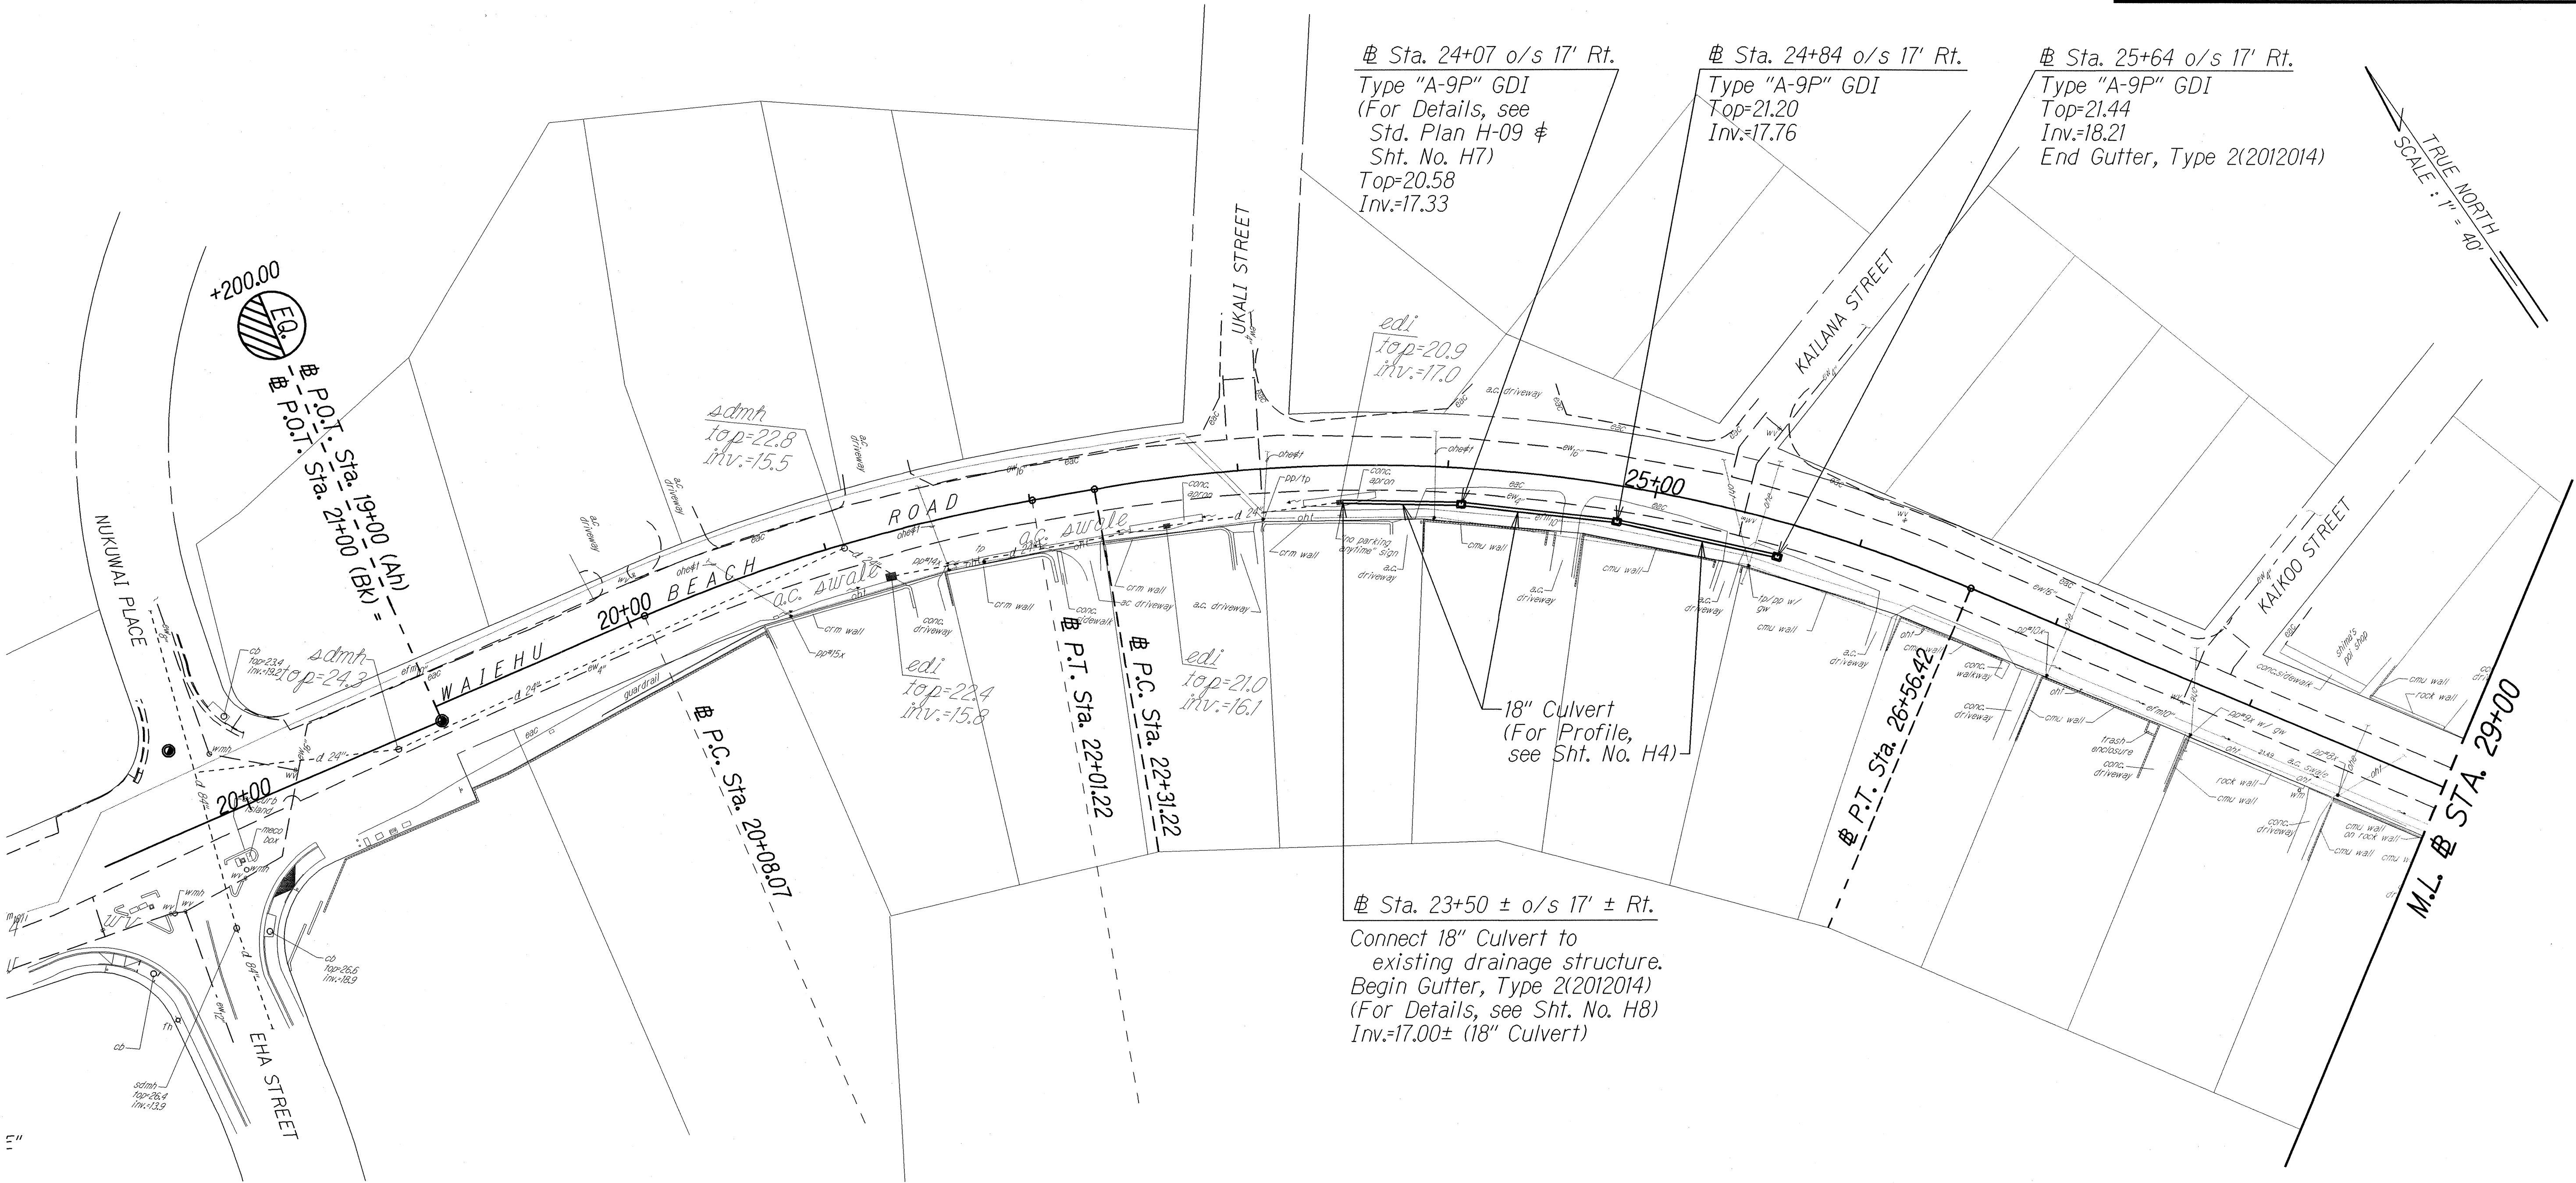

ORIGINAL PLAN	SURVEY PLOTTED BY	DATE
NOTE BOOK	DESIGNED BY	
QUANTITIES BY	CHECKED BY	

STATE OF HAWAII
DEPARTMENT OF TRANSPORTATION
HIGHWAYS DIVISION


DRAINAGE PLAN

WAIIEHU BEACH ROAD MISC. DRAINAGE IMPROVEMENTS
Vicinity of Lower Main Street to Eha Street
Project No. 3400AB-01-03

Scale: 1"=40' Date: November, 2003

SHEET No. H2 OF 8 SHEETS

FED. ROAD DIST. NO.	STATE	PROJ. NO.	FISCAL YEAR	SHEET NO.	TOTAL SHEETS
HAWAII	HAW.	3400AB-01-03	2004	9	15

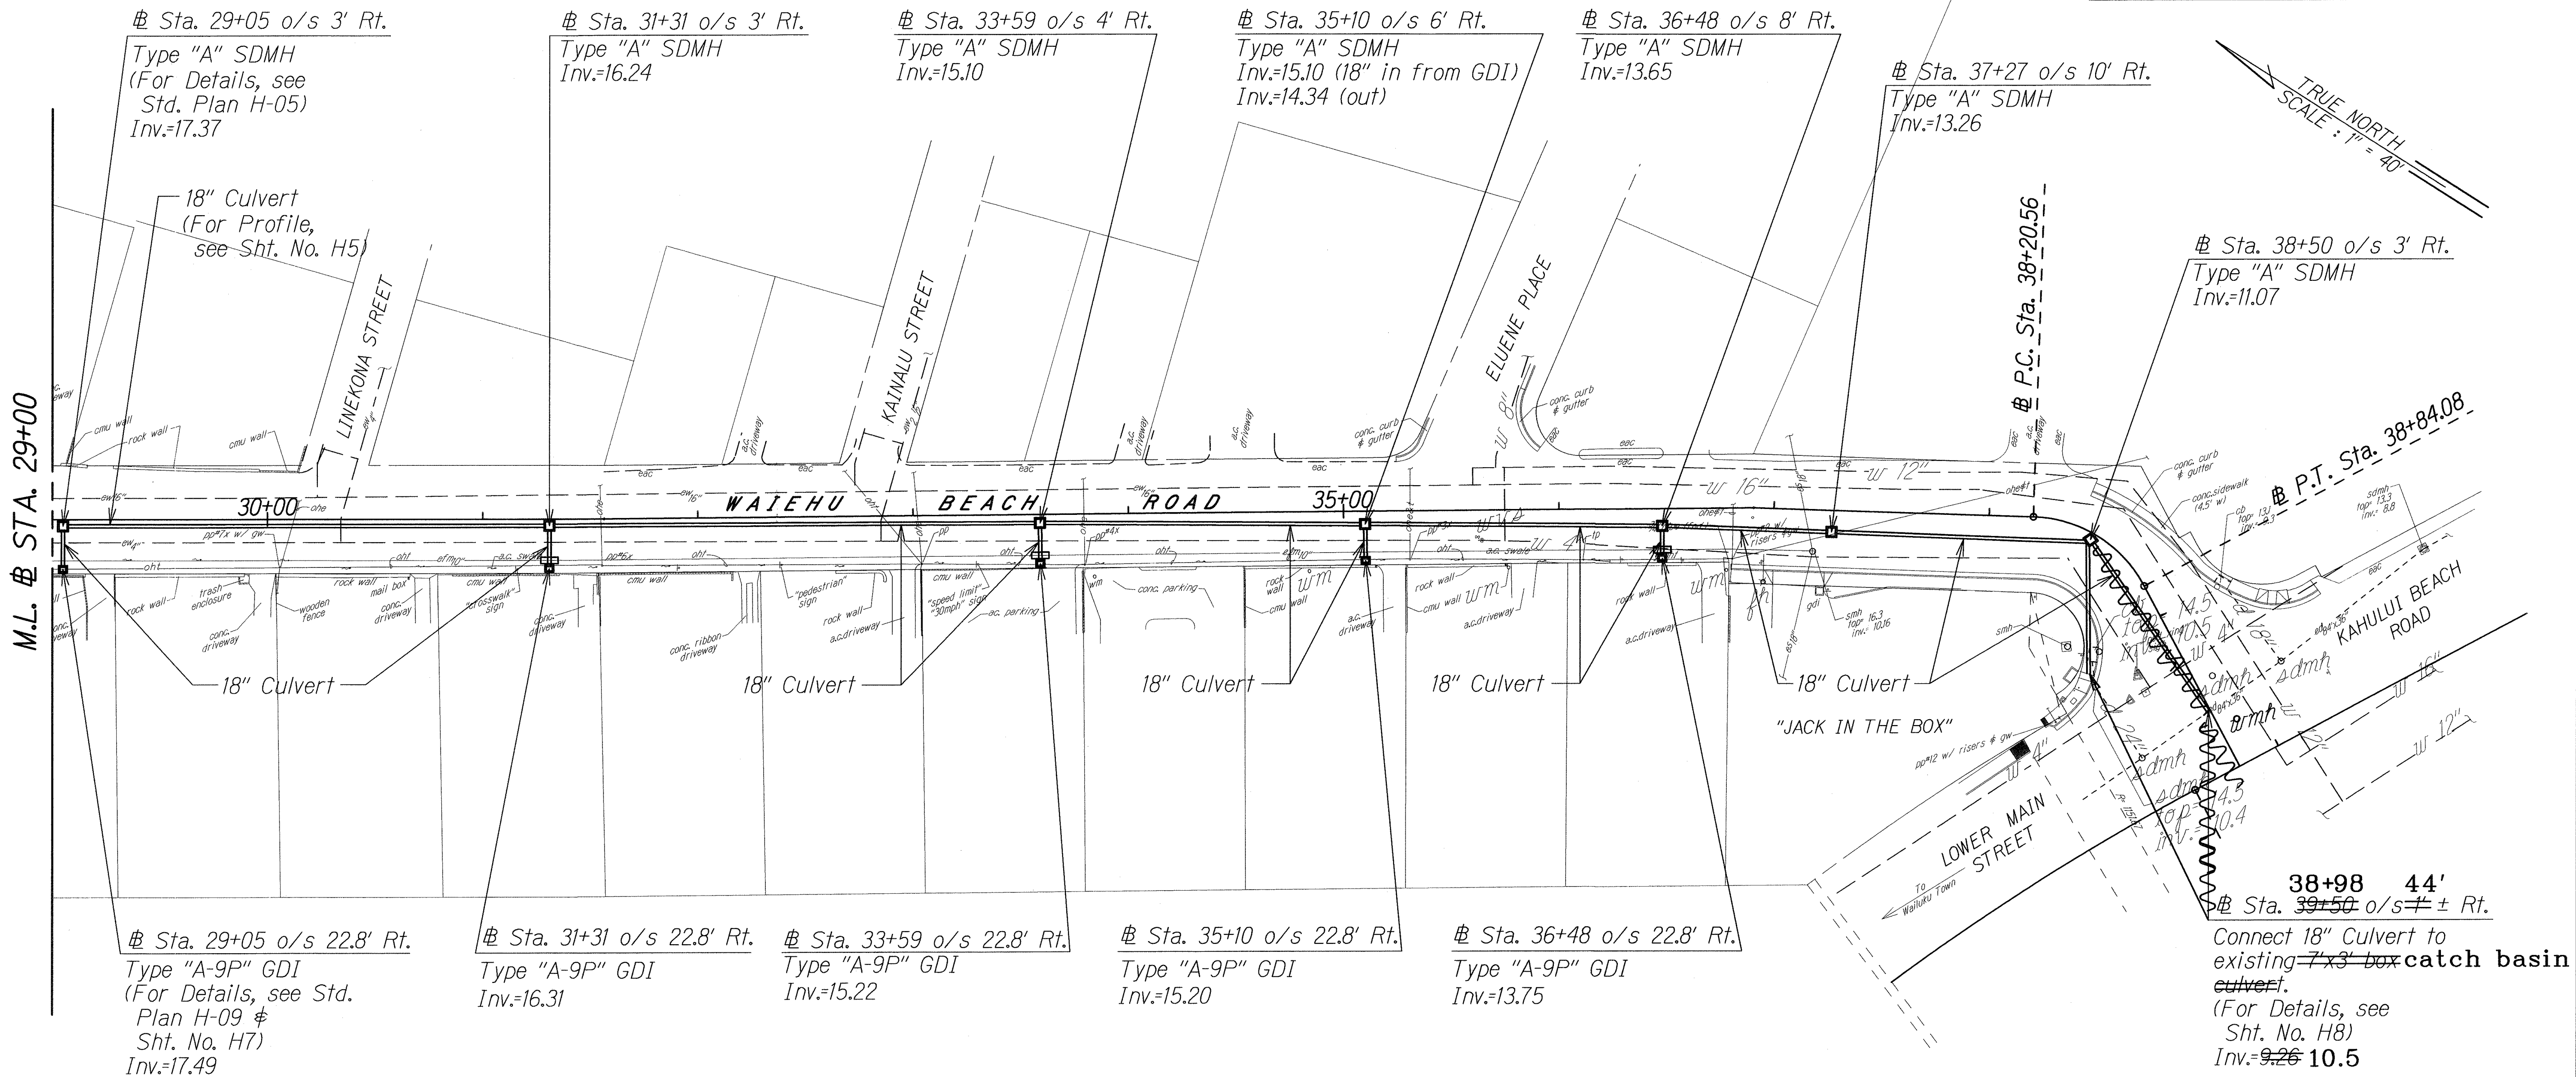

WATERLINE REALIGNMENT

For waterline realignment at the following locations:

- Sta. 29+05 o/s 10' Rt.
- Sta. 30+34 o/s 4' Rt.
- Sta. 31+31 o/s 10' Rt.
- Sta. 32+88 o/s 4' Rt.
- Sta. 33+59 o/s 12' Rt.
- Sta. 35+10 o/s 14' Rt.
- Sta. 35+74 o/s 8' Rt.
- Sta. 36+48 o/s 18' Rt.
- Sta. 39+26 o/s 4' Rt.

see profiles on Sht Nos. H5 & H6
see details on Plan Sht No. 15.

APPROVED:

DIRECTOR, DEPARTMENT OF WATER SUPPLY
COUNTY OF MAUI
(Approval is limited to the Water System Improvements which will be dedicated to the Department of Water Supply)

DATE

ORIGINAL PLAN	DATE
DESIGNED BY	10/23/03
QUANTITIES BY	
CHECKED BY	
NOTE BOOK	
DESIGNED BY	
QUANTITIES BY	
CHECKED BY	

LEGEND FOR AS-BUILT POSTINGS	
	Squiggly line for as-built deletion
	Double line for as-built deletion
Roadway	Text for as-built posting

STATE OF HAWAII
DEPARTMENT OF TRANSPORTATION
HIGHWAYS DIVISION

DRAINAGE PLAN
WAIEHU BEACH ROAD MISC. DRAINAGE IMPROVEMENTS
Vicinity of Lower Main Street to Eha Street
Project No. 3400AB-01-03
Scale: 1"=40' Date: November, 2003
SHEET No. H3 OF 8 SHEETS