


FED. ROAD DIST. NO.	STATE	PROJ. NO.	FISCAL YEAR	SHEET NO.	TOTAL SHEETS
HAWAII	HAW.	3400AB-01-03	2004	10	15

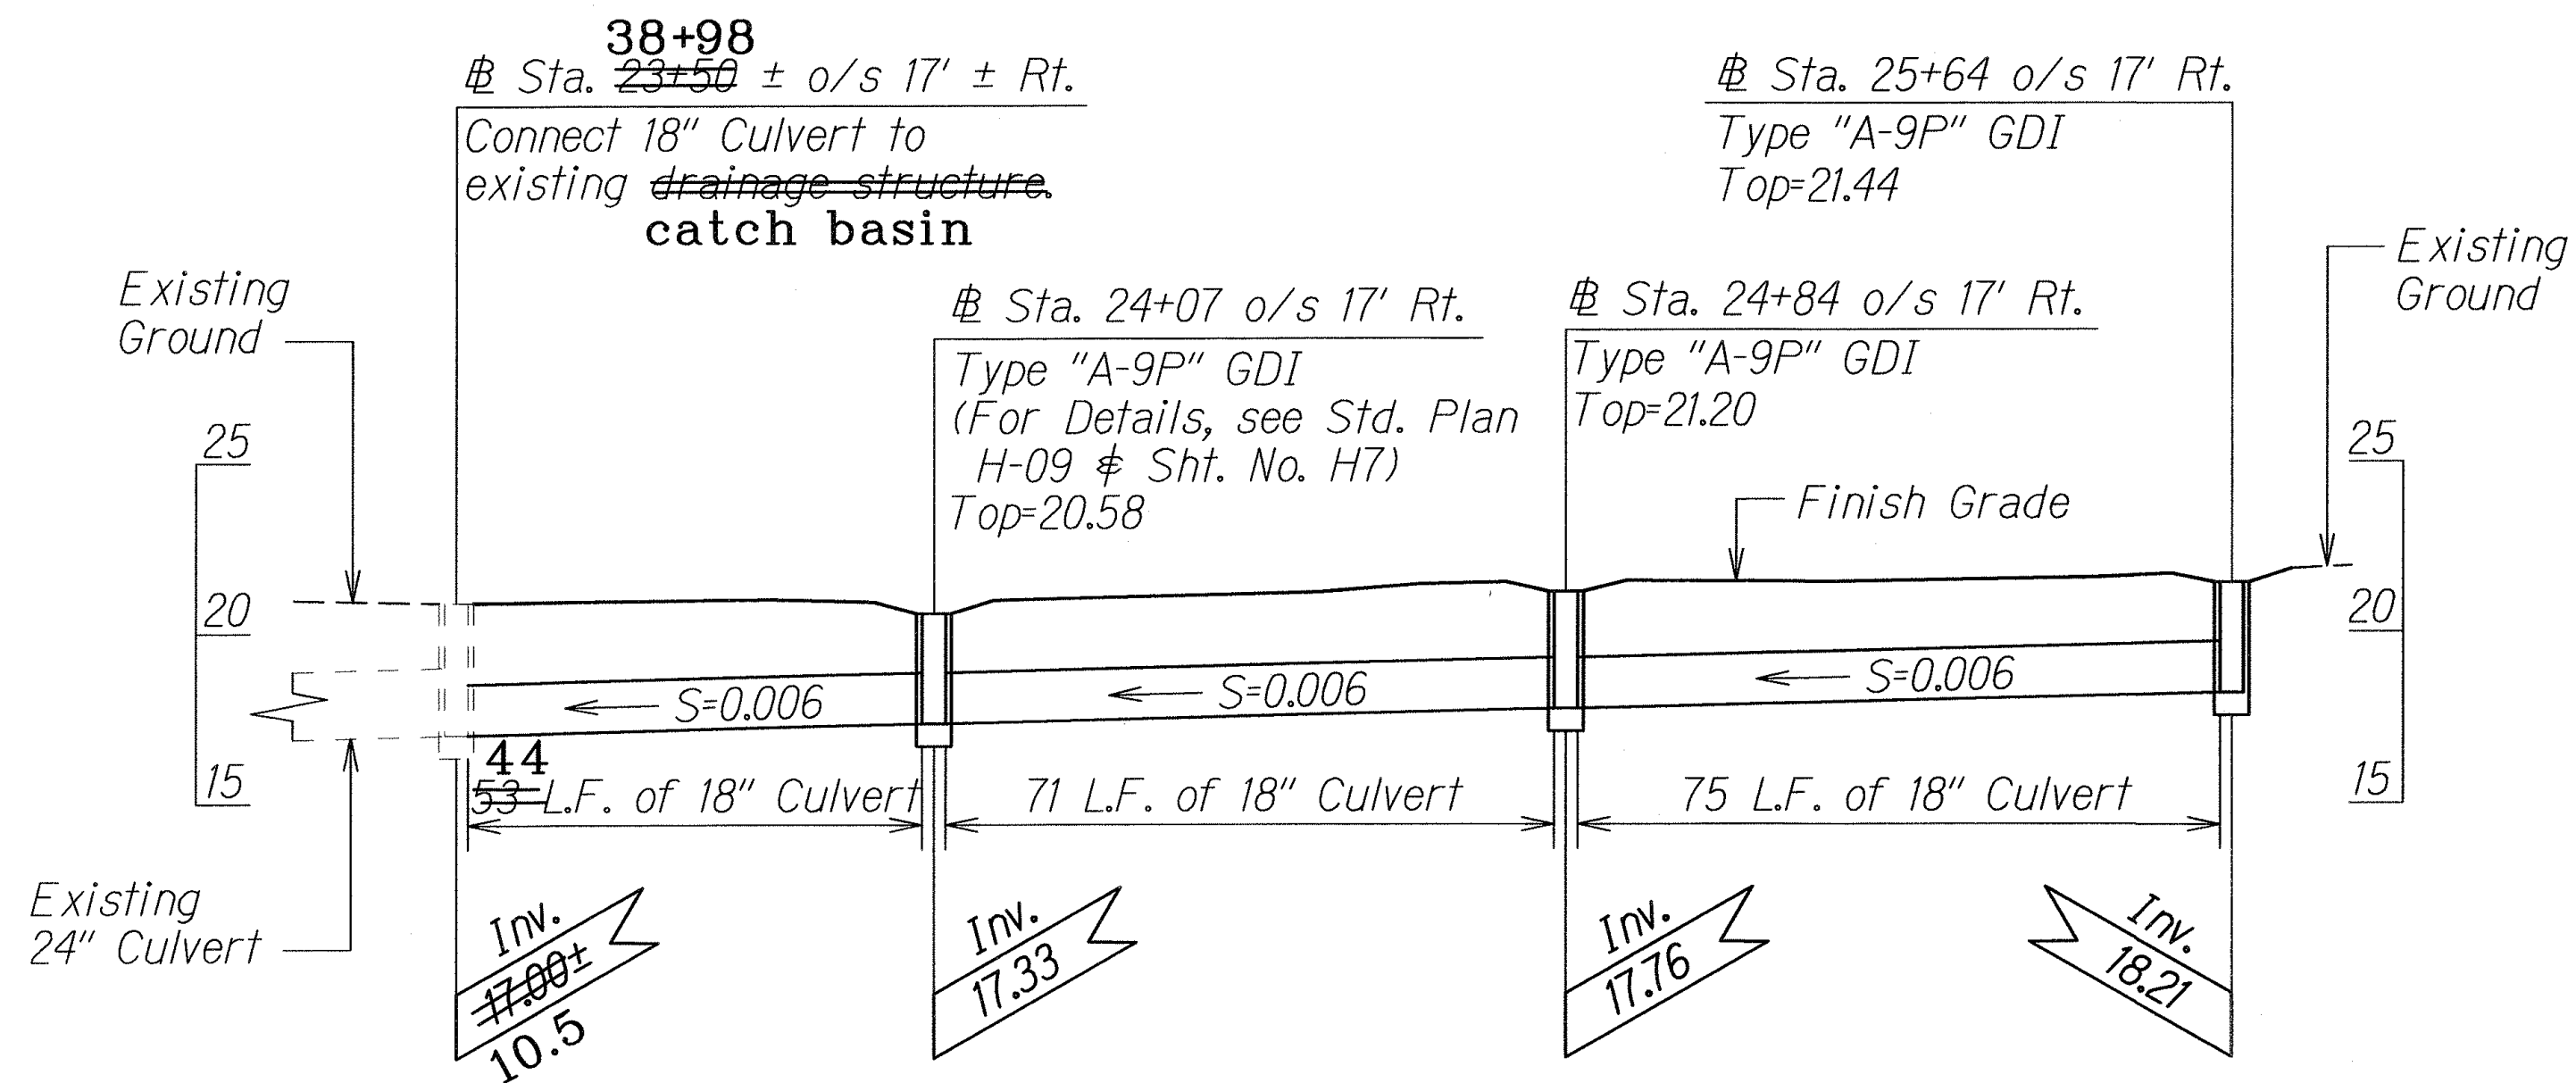

PROFILE - Sta. 23+50 ± o/s 17' ± RT.
Sta. 25+64 o/s 17' RT.
 Scale: Horiz. 1"=20'
 Vert. 1"=5'

LEGEND FOR AS-BUILT POSTINGS	
	Squiggly line for as-built deletion
	Double line for as-built deletion
Roadway	Text for as-built posting

STATE OF HAWAII
DEPARTMENT OF TRANSPORTATION
HIGHWAYS DIVISION

DRAINAGE PROFILE
WAIIEHU BEACH ROAD.
MISC. DRAINAGE IMPROVEMENTS
Vicinity of Lower Main Street
to Eha Street
Project No. 3400AB-01-03
Scale: As Shown Date: November, 2003

SHEET No. **H4** OF **8** SHEETS

ORIGINAL PLAN	SURVEY PLOTTED BY	DATE
NOTE BOOK	DRAWN BY	07/22/03
DESIGNED BY	DESIGNED BY	
CHECKED BY	CHECKED BY	

"AS-BUILT"

FED. ROAD DIST. NO.	STATE	PROJ. NO.	FISCAL YEAR	SHEET NO.	TOTAL SHEETS
HAWAII	HAW.	3400AB-01-03	2004	11	15

APPROVED:

DIRECTOR, DEPARTMENT OF WATER SUPPLY
COUNTY OF MAUI
(Approval is limited to the Water System
Improvements which will be dedicated
to the Department of Water Supply)

**PROFILE - STA. 29+05 o/s 3' RT. TO
STA. 39+50 o/s 1' ± RT.**

Scale: Horiz. 1"=20'
Vert. 1"=5'






LEGEND FOR AS-BUILT POSTINGS	
	Squiggly line for as-built deletion
	Double line for as-built deletion
Roadway	Text for as-built posting

STATE OF HAWAII DEPARTMENT OF TRANSPORTATION HIGHWAYS DIVISION DRAINAGE PROFILE WAIEHU BEACH ROAD, MISC. DRAINAGE IMPROVEMENTS Vicinity of Lower Main Street to Eha Street Project No. 3400AB-01-03 Scale: As Shown Date: November, 2003	DATE
---	------

SHEET No. H5 OF 8 SHEETS

11

FED. ROAD DIST. NO.	STATE	PROJ. NO.	FISCAL YEAR	SHEET NO.	TOTAL SHEETS
HAWAII	HAW.	3400AB-01-03	2004	12	15

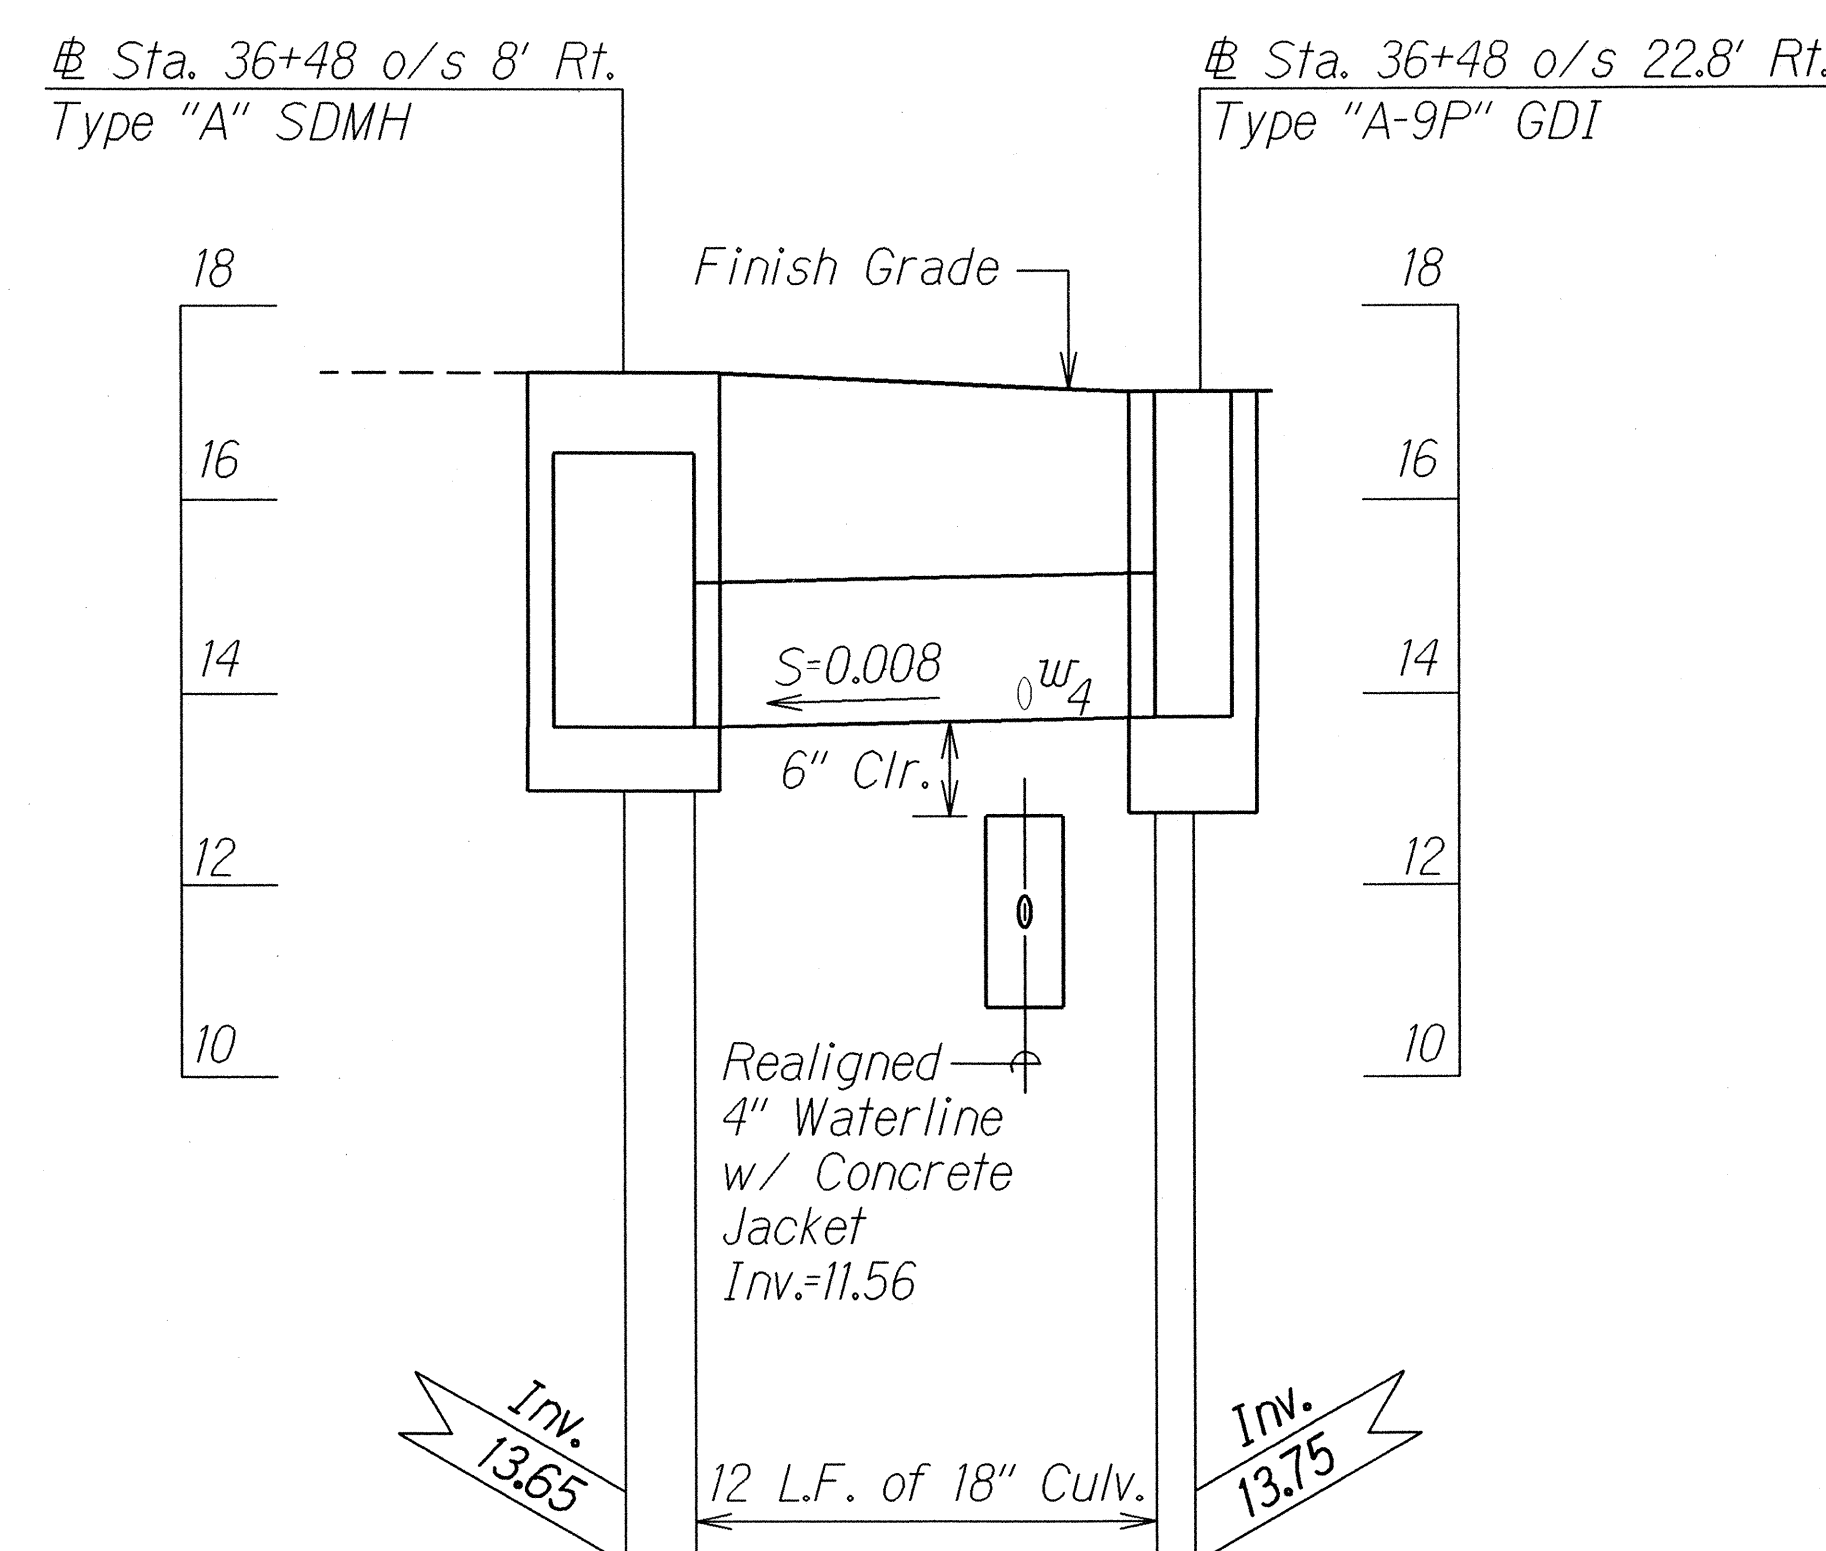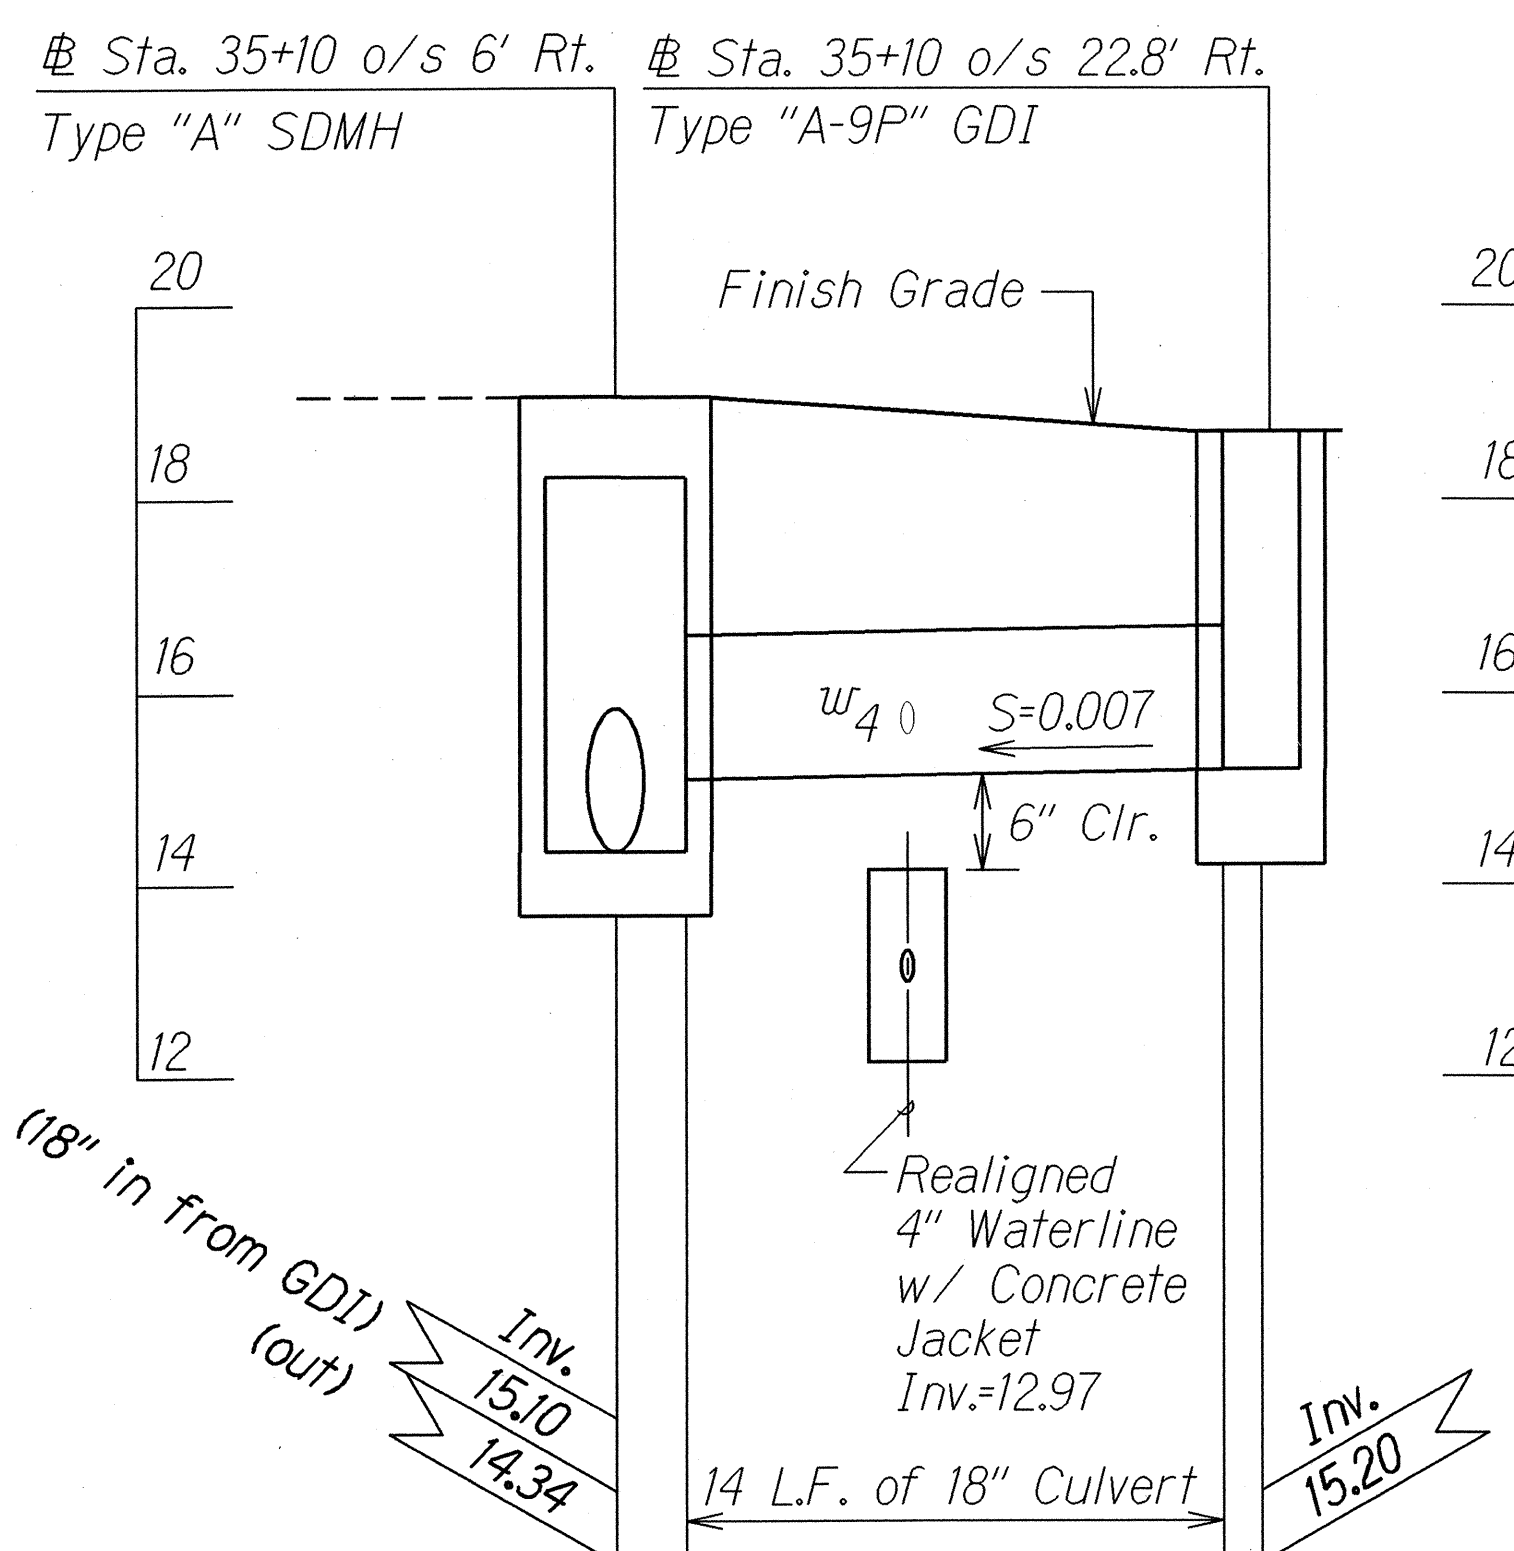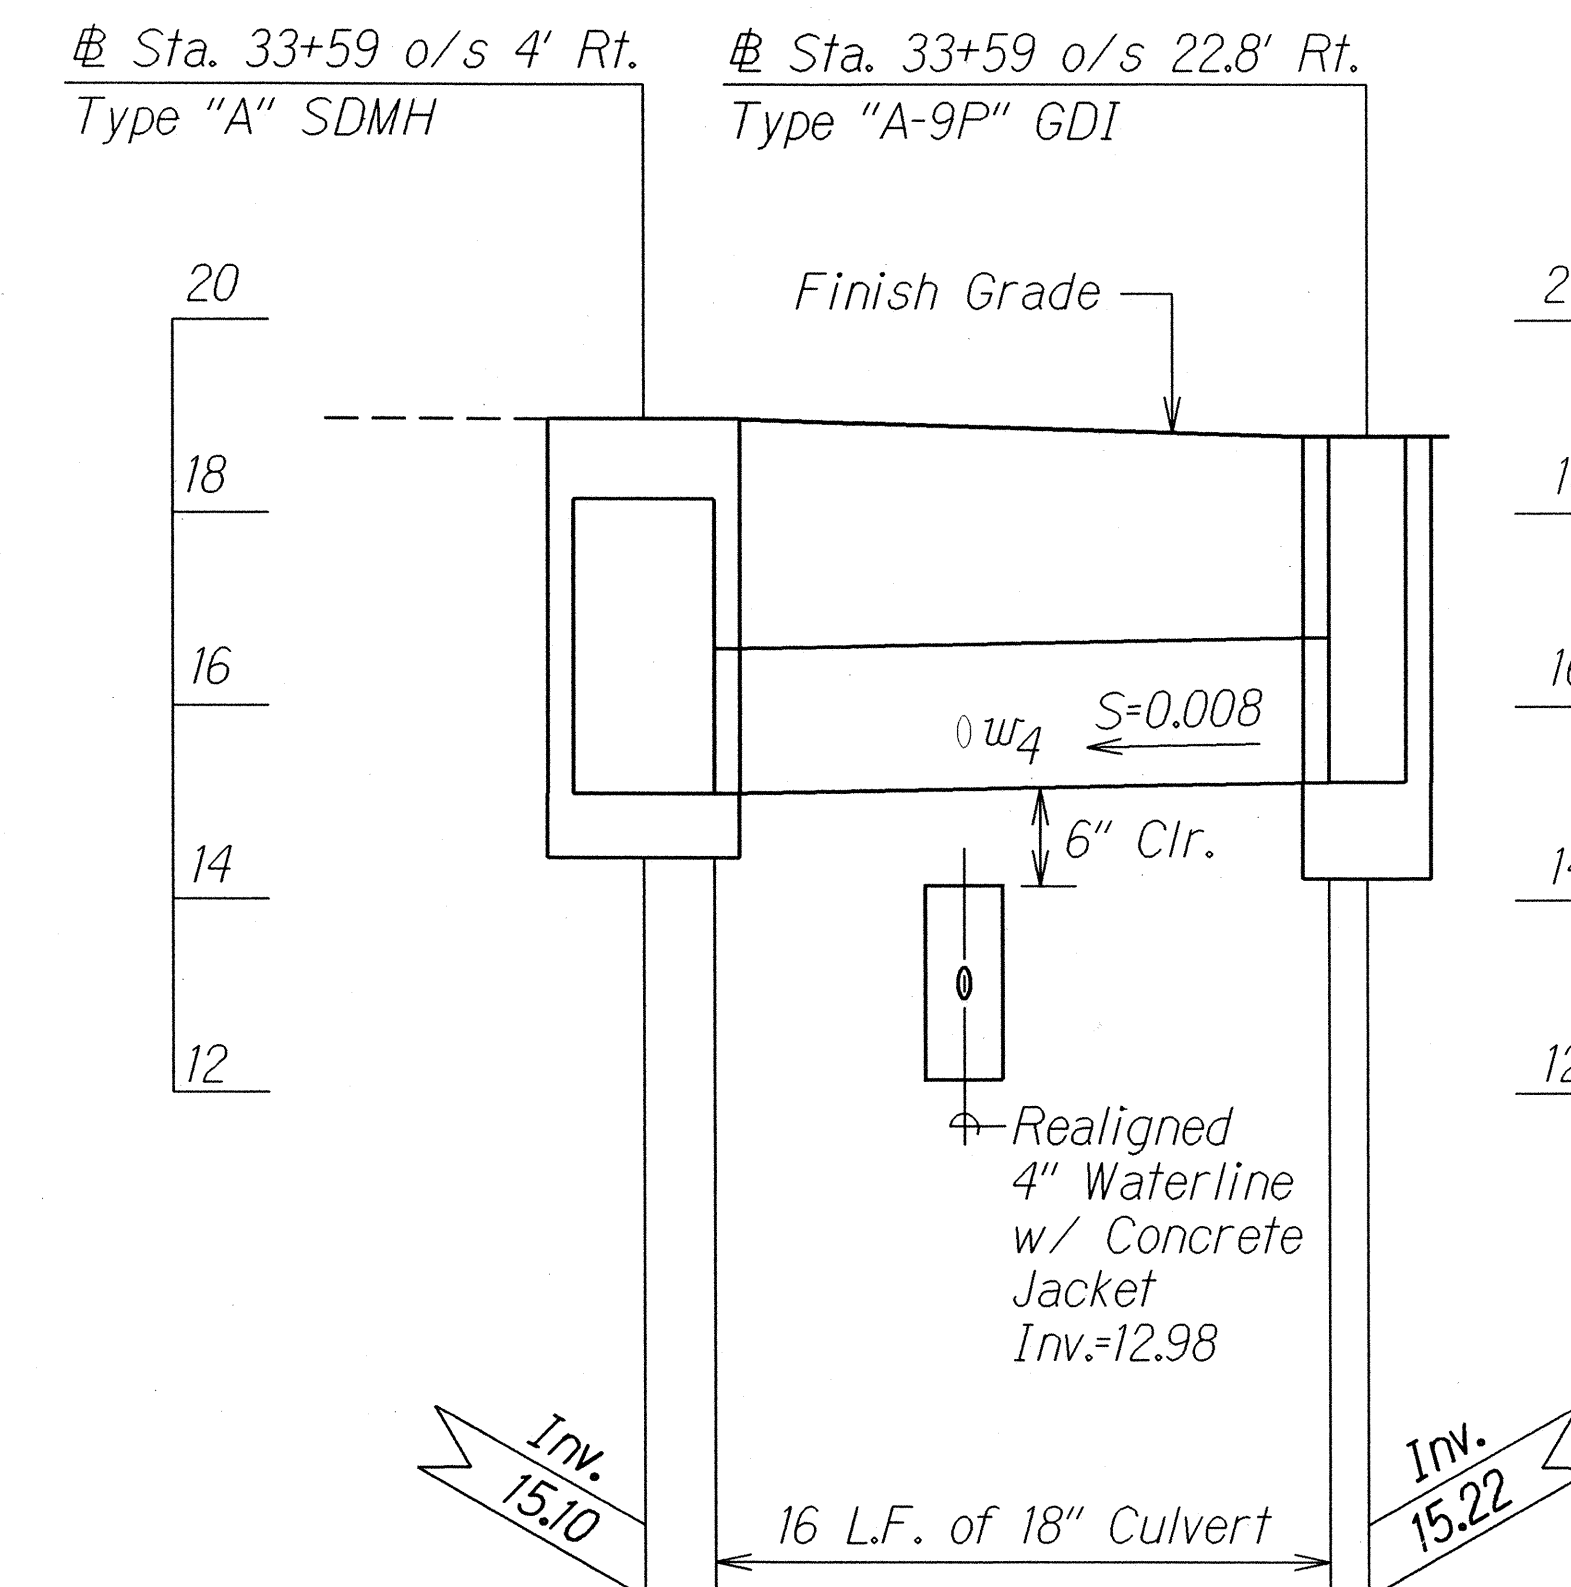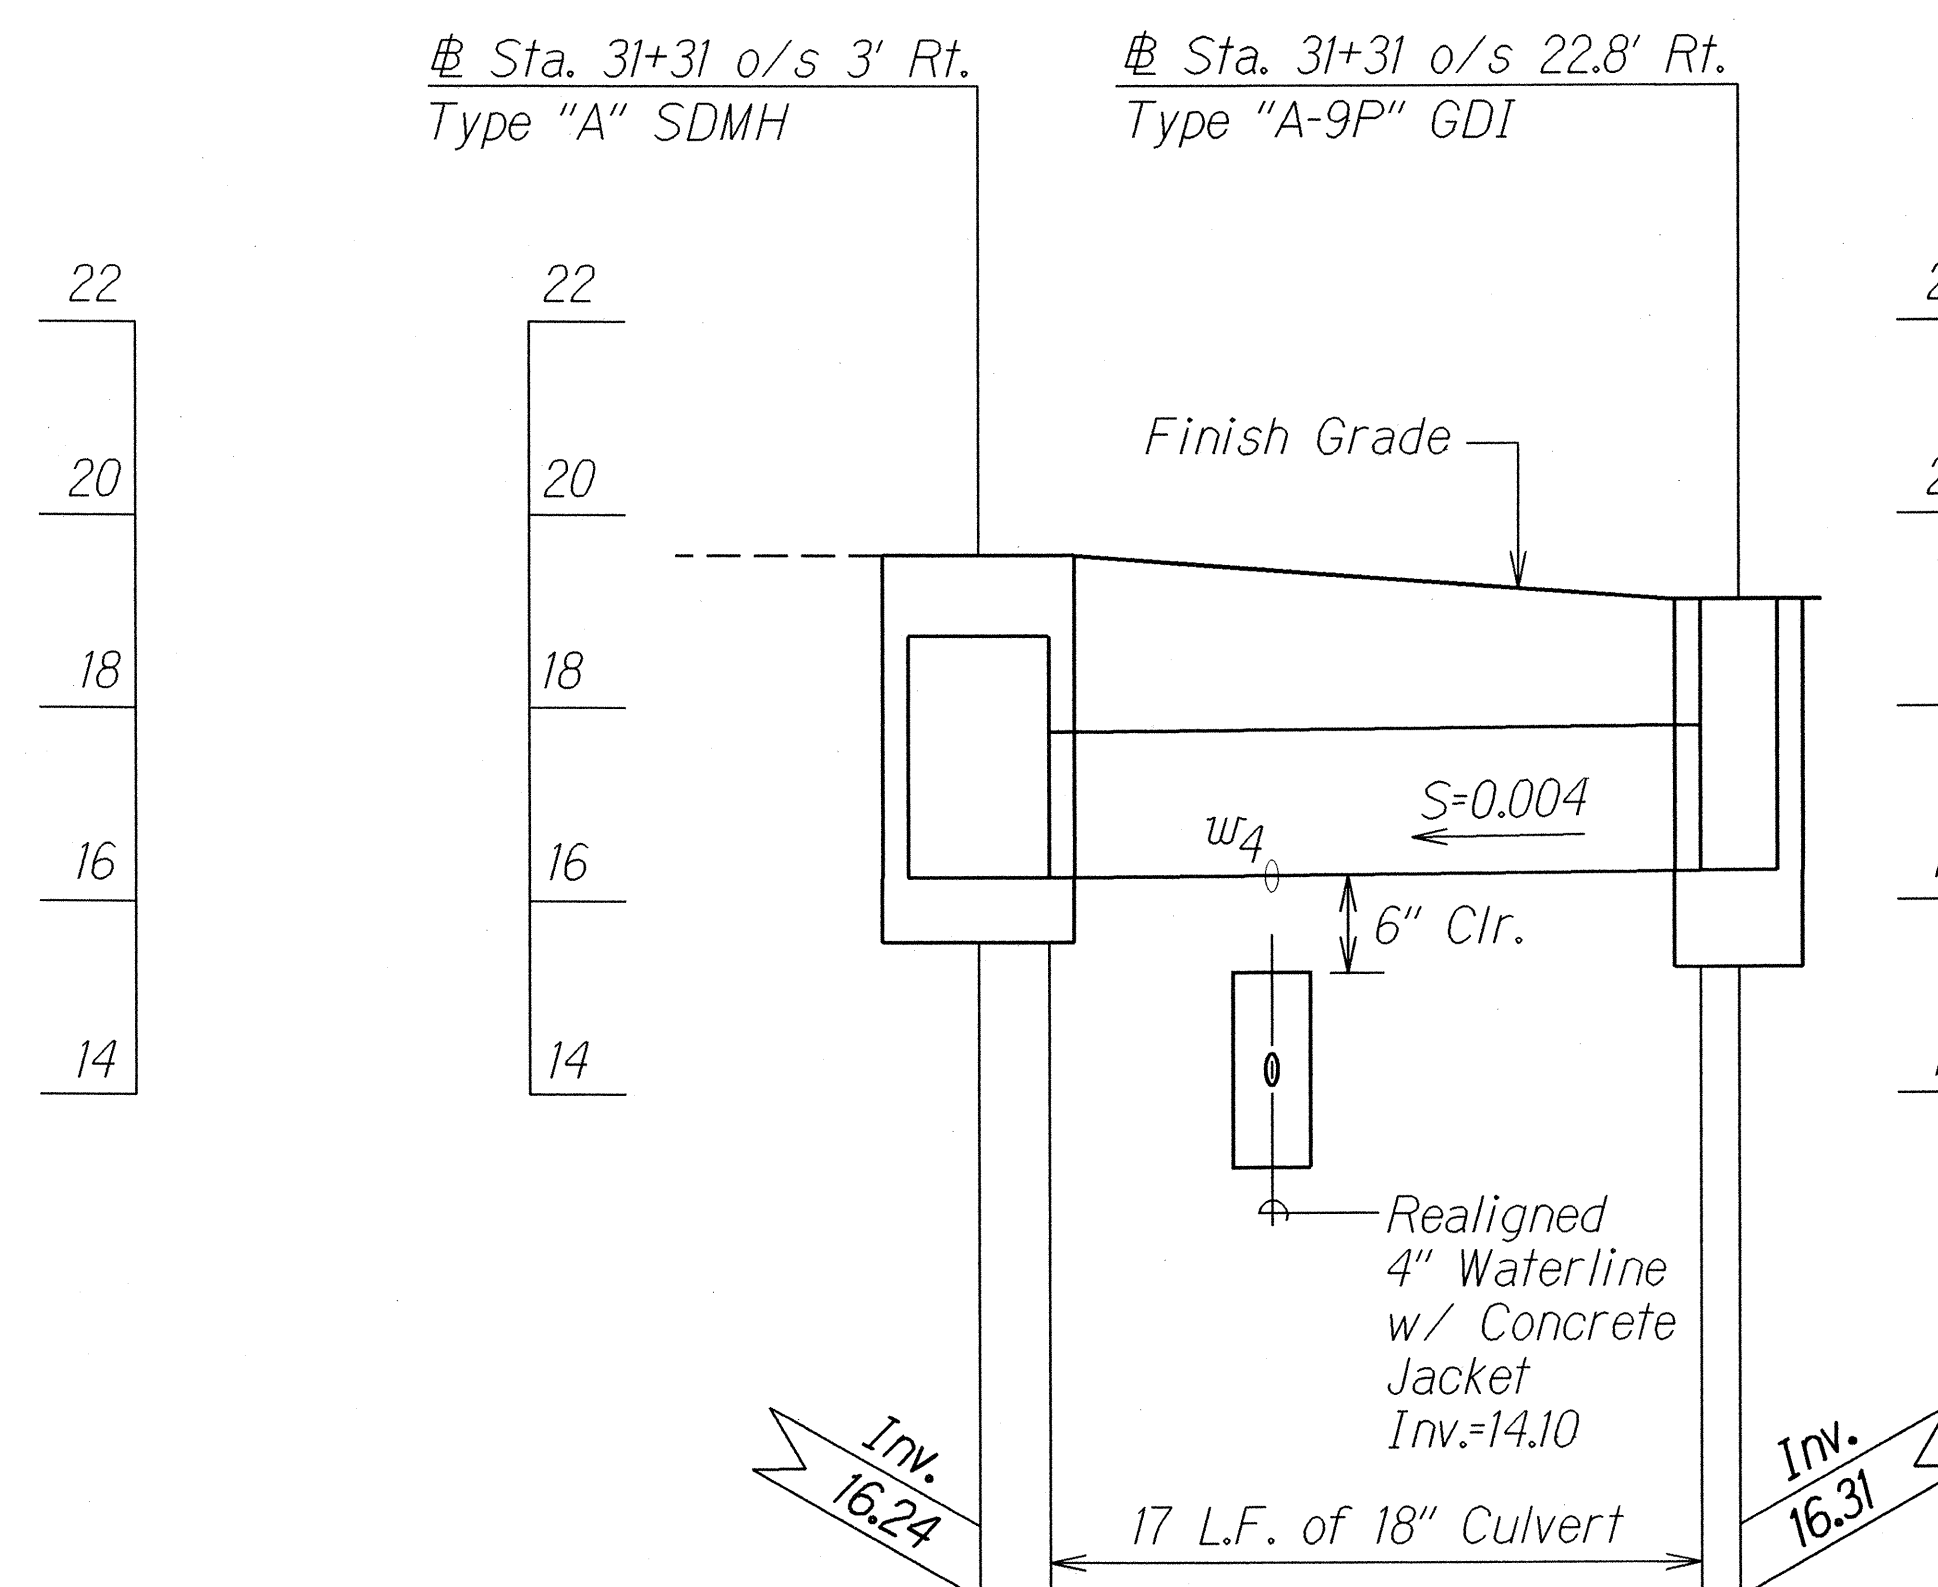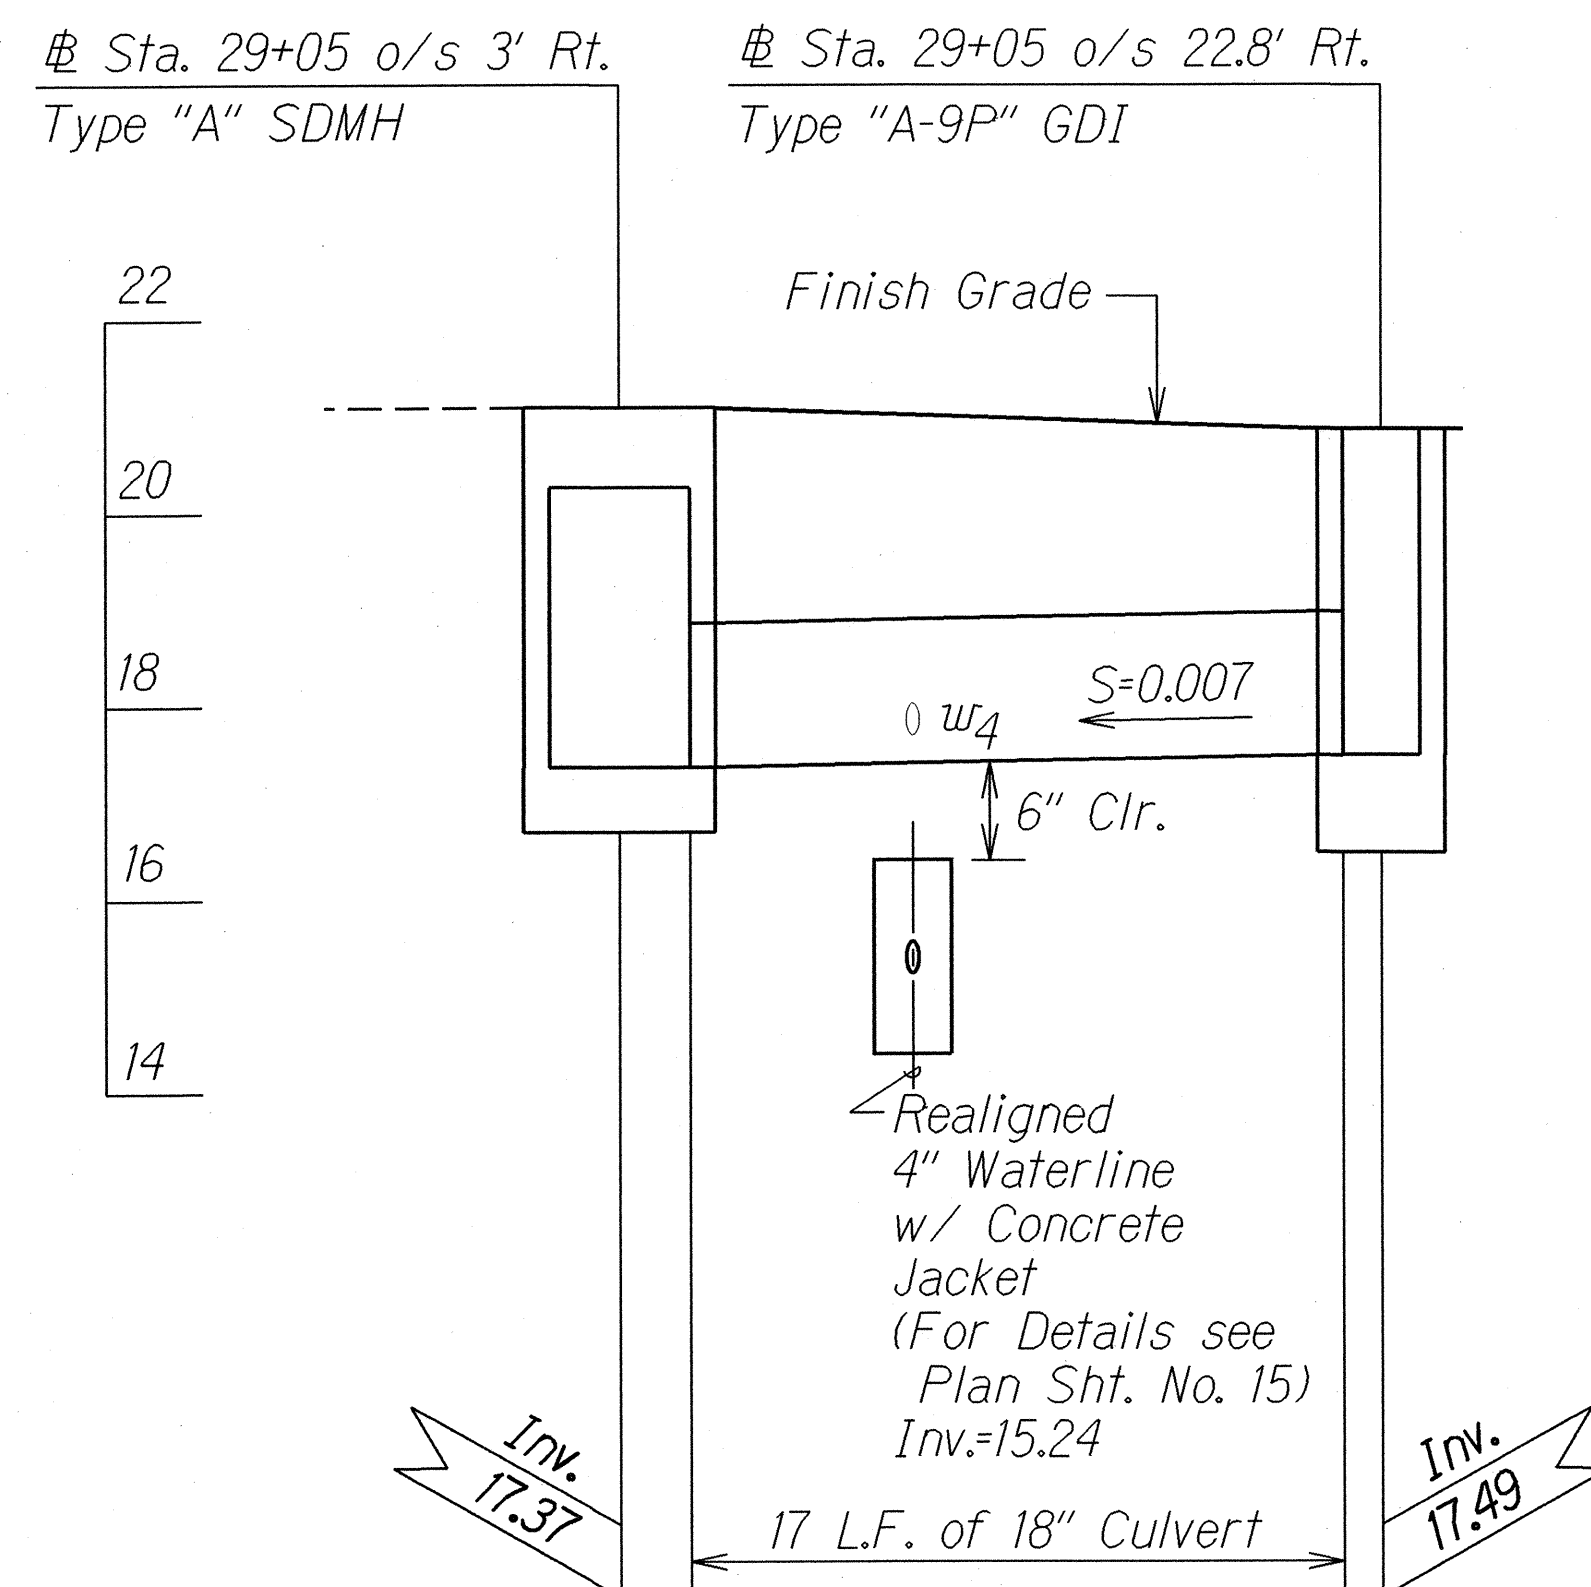

DRAIN LINE PROFILES

Scale: Horizontal 1" = 5'
Vertical 1" = 2'

APPROVED:

[Signature] 11/2/03
DIRECTOR, DEPARTMENT OF WATER SUPPLY
COUNTY OF MAUI
(Approval is limited to the Water System
Improvements which will be dedicated
to the Department of Water Supply)

STATE OF HAWAII
DEPARTMENT OF TRANSPORTATION
HIGHWAYS DIVISION
DRAINAGE PROFILE
WAIHEHU BEACH ROAD,
MISC. DRAINAGE IMPROVEMENTS
Vicinity of Lower Main Street
to Eha Street
Project No. 3400AB-01-03
Scale: As Shown Date: November, 2003
SHEET No. H6 OF 8 SHEETS