
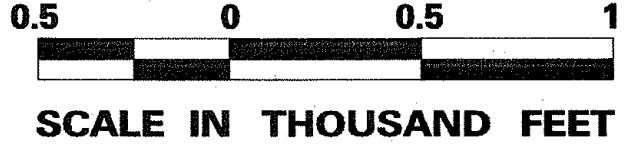
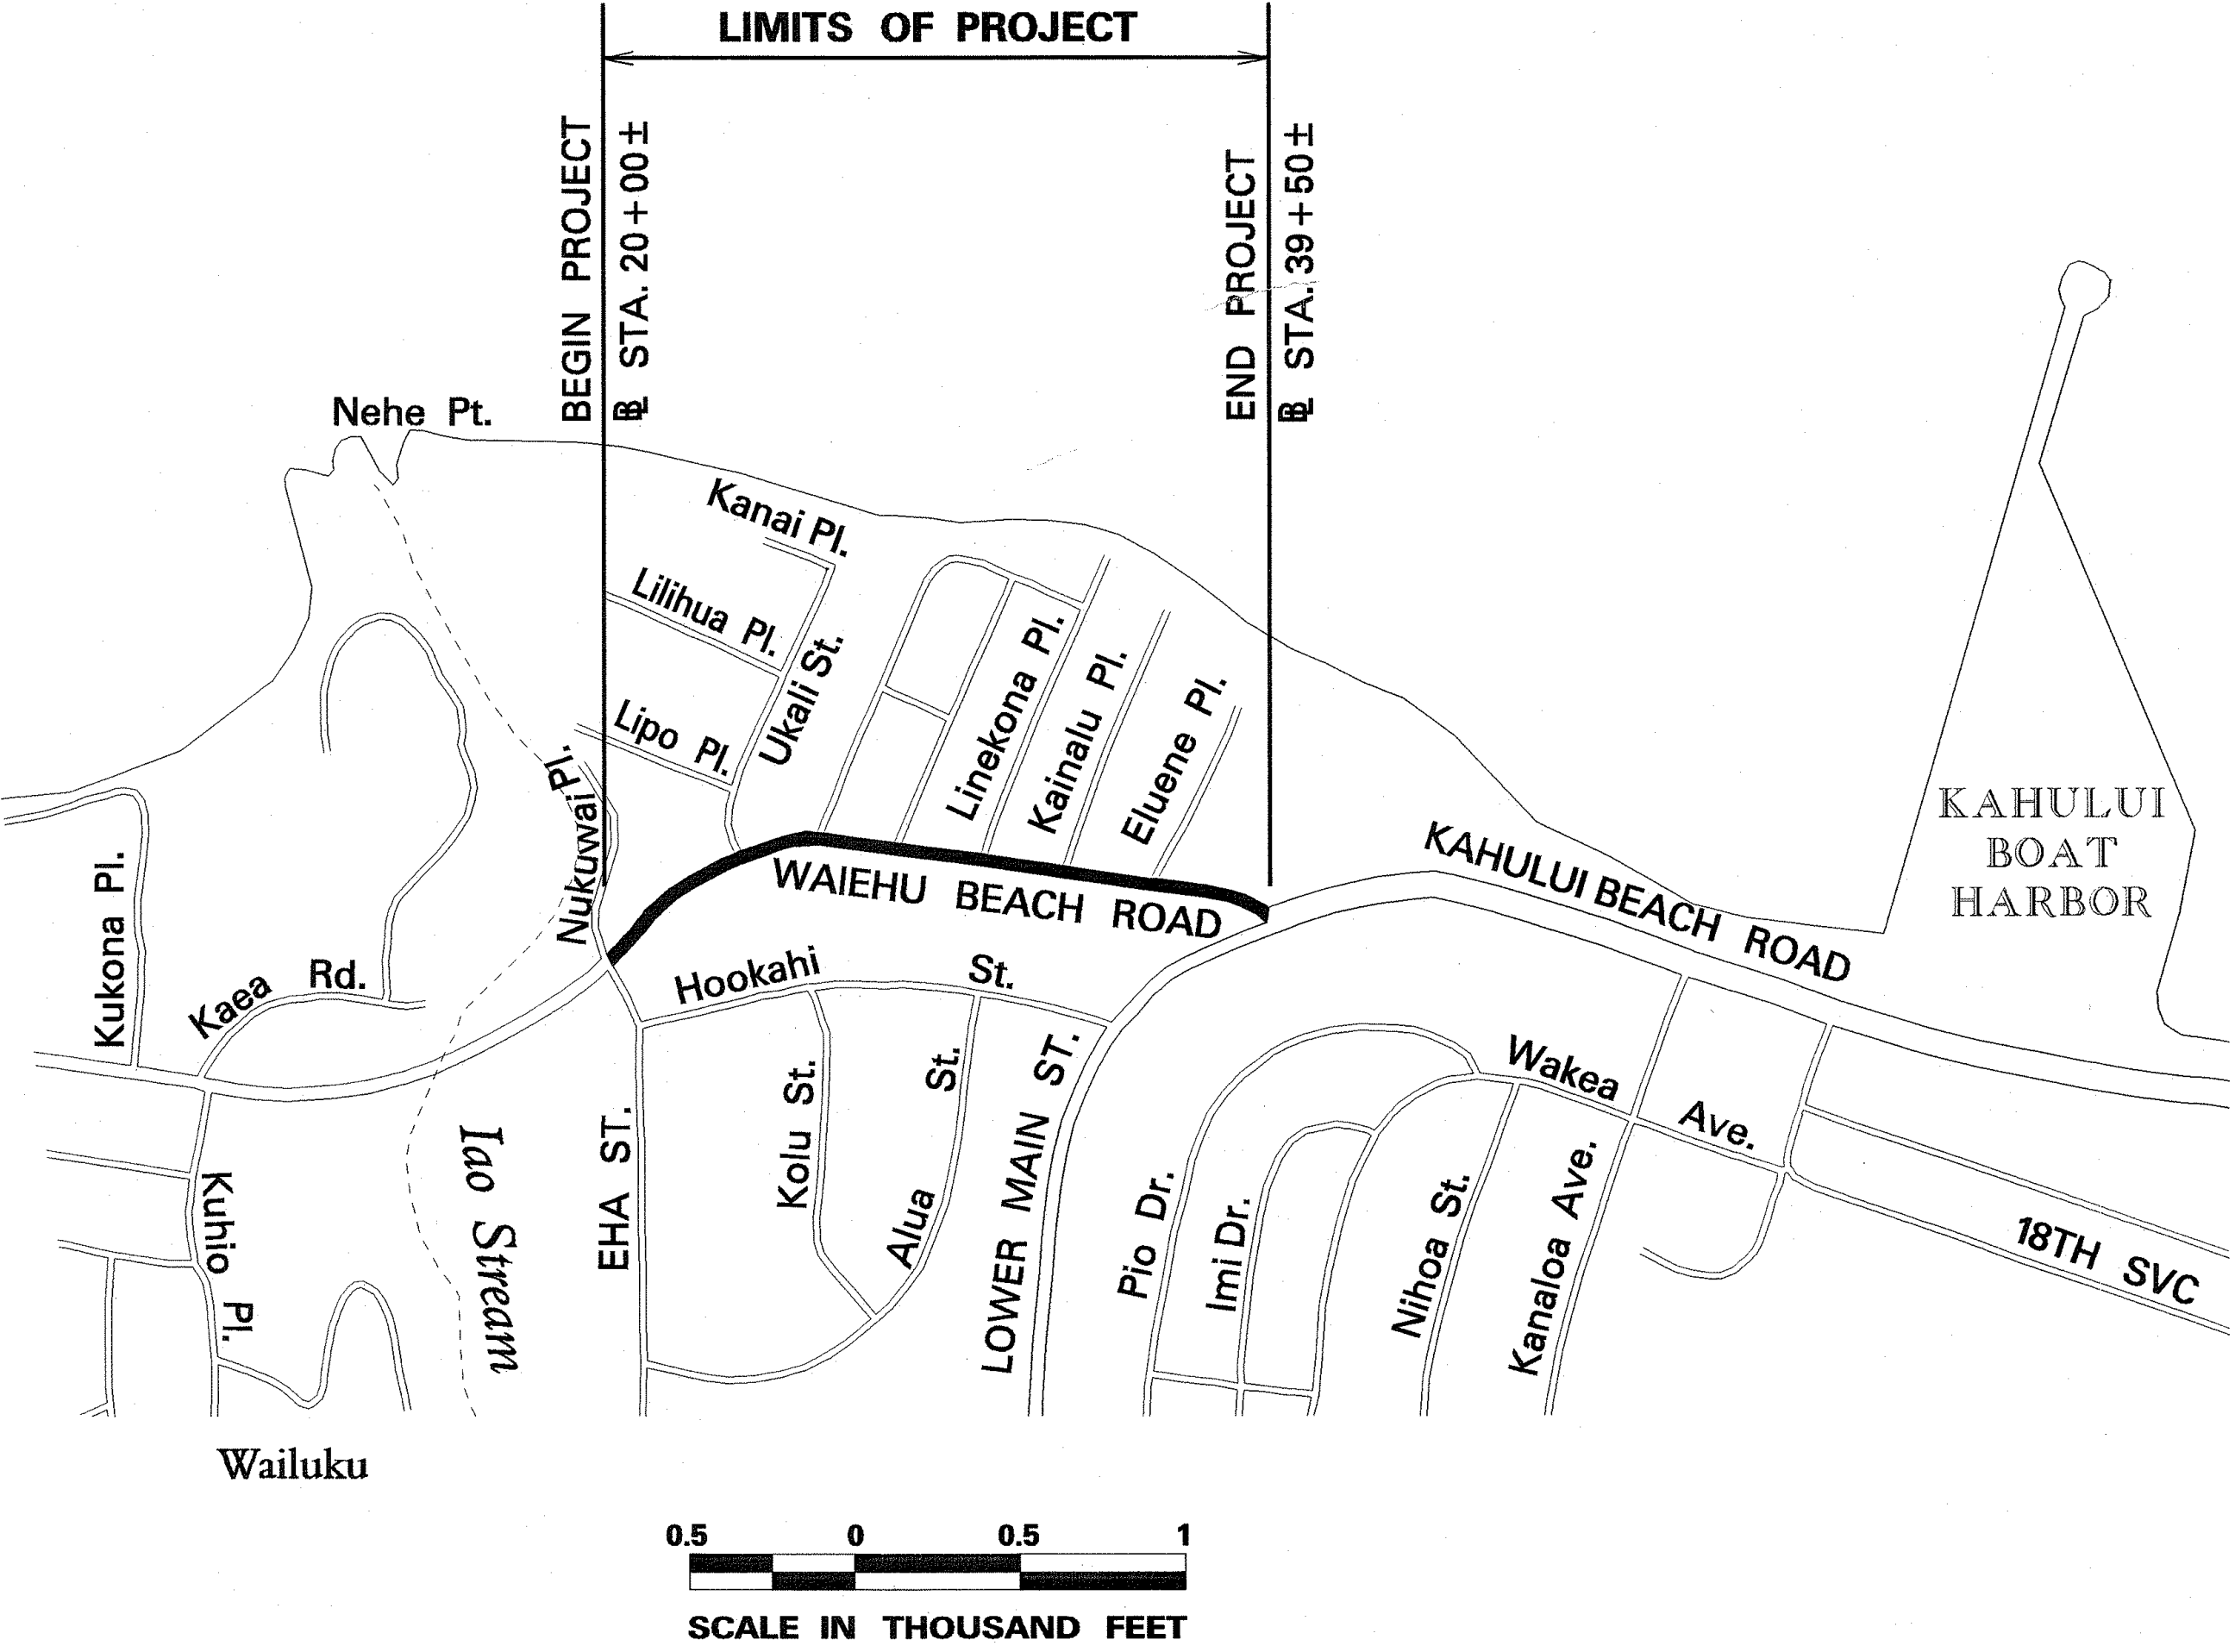
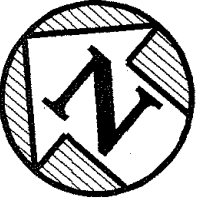
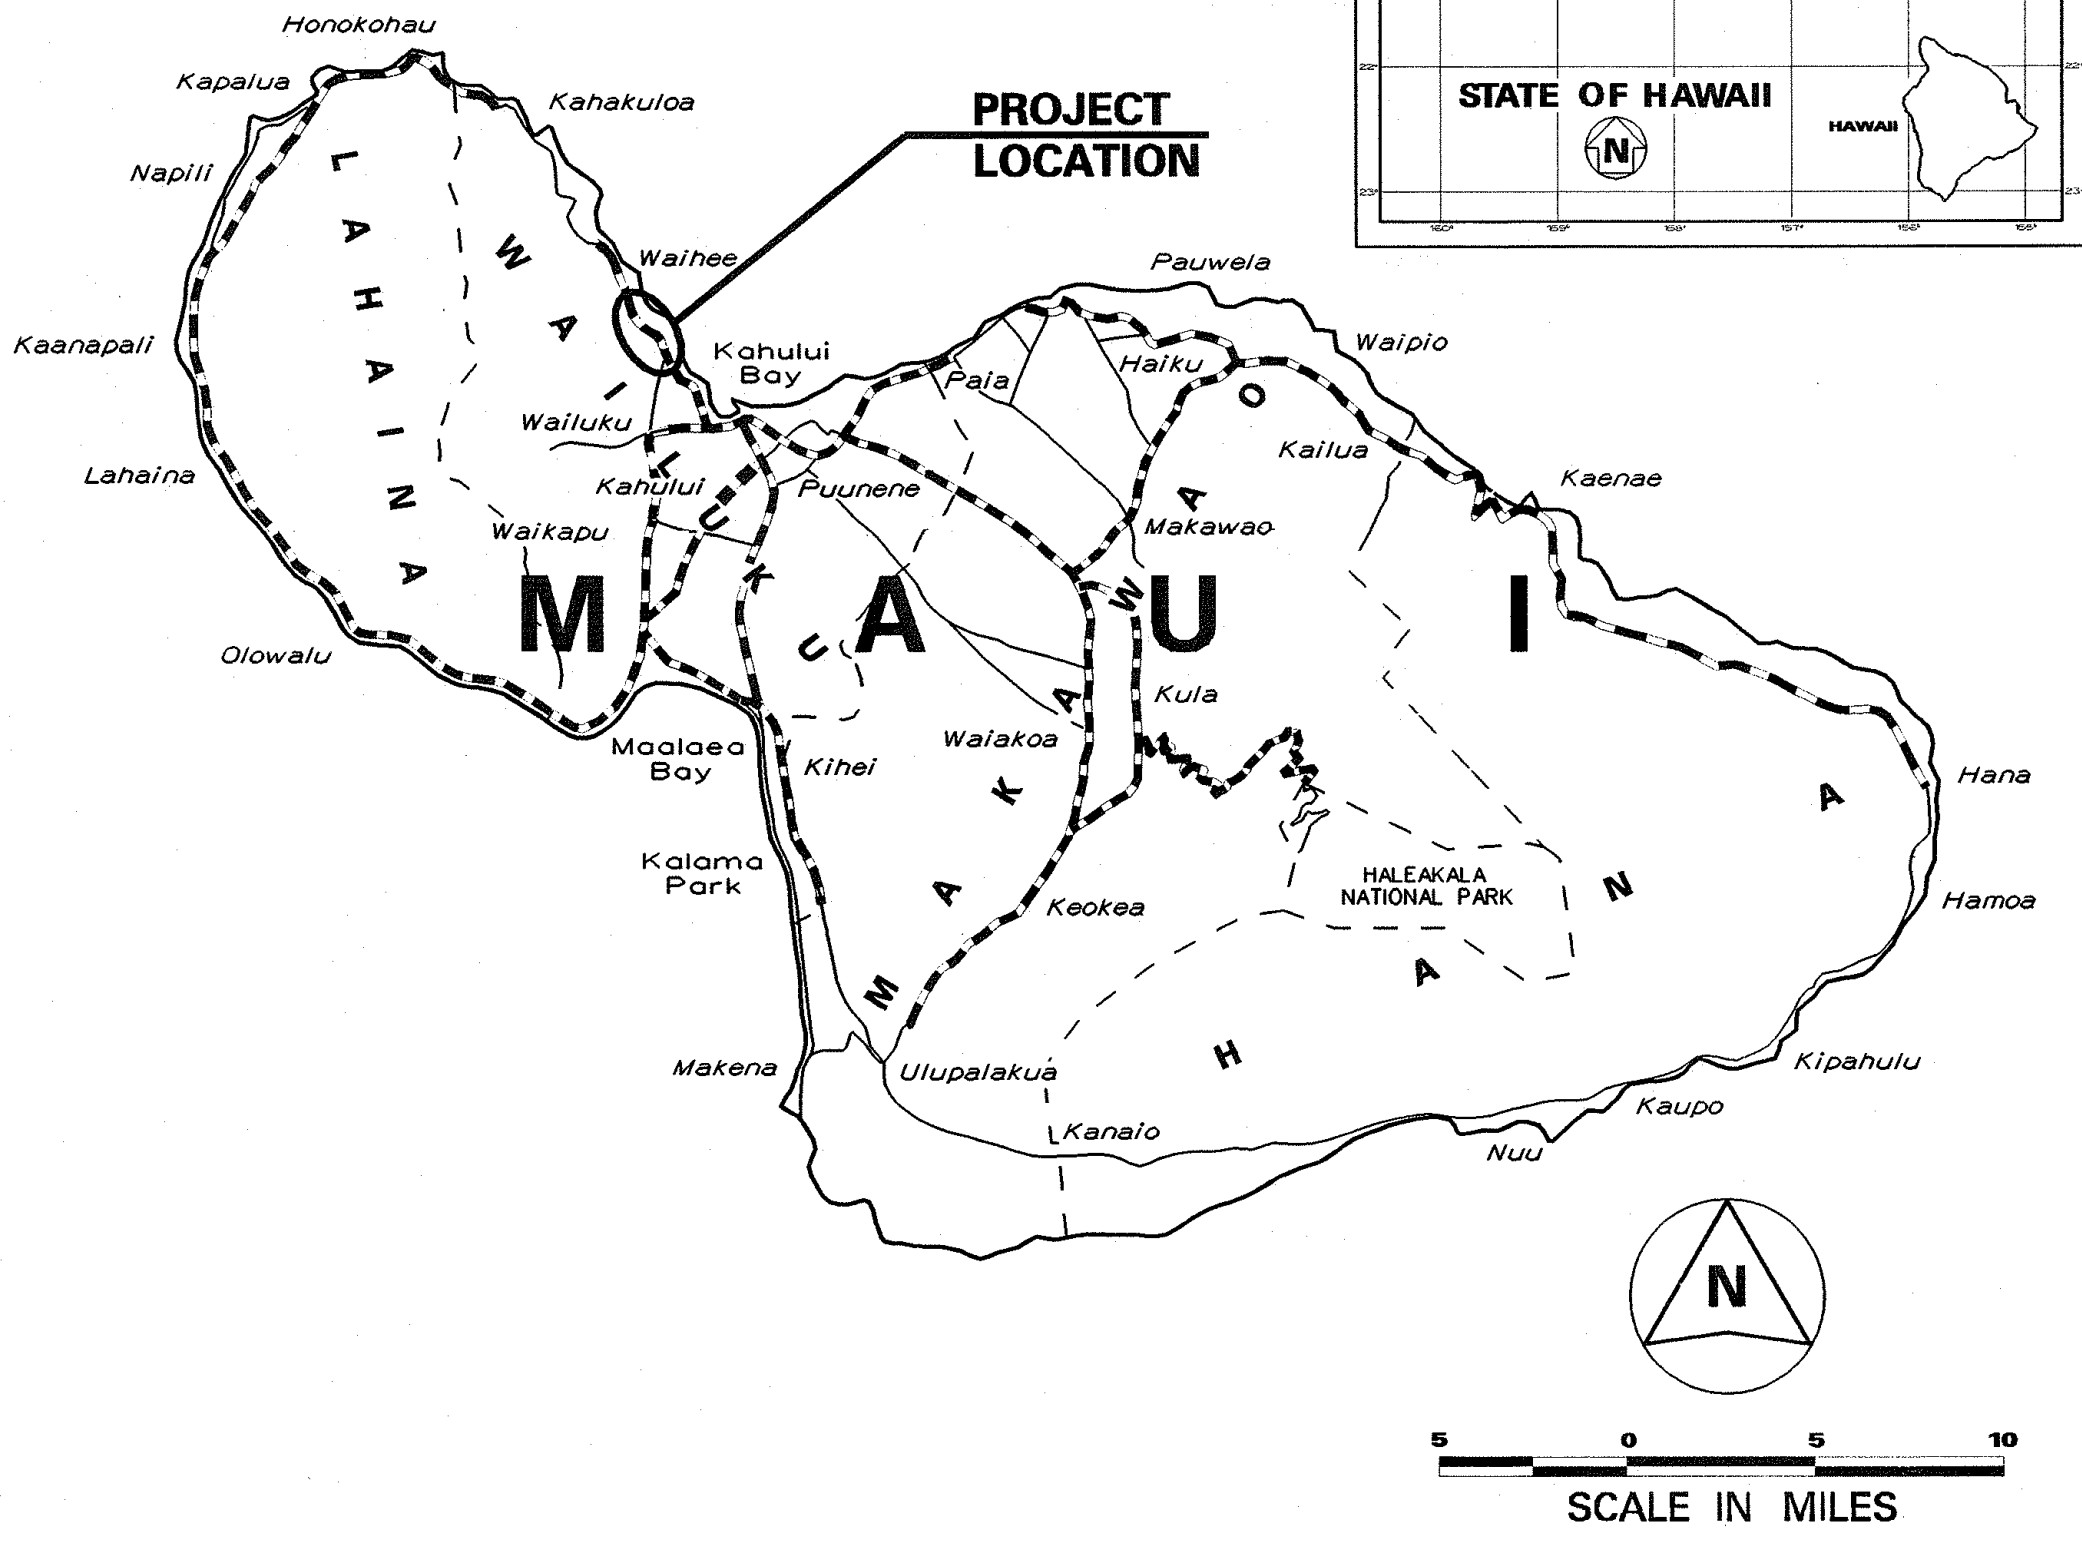
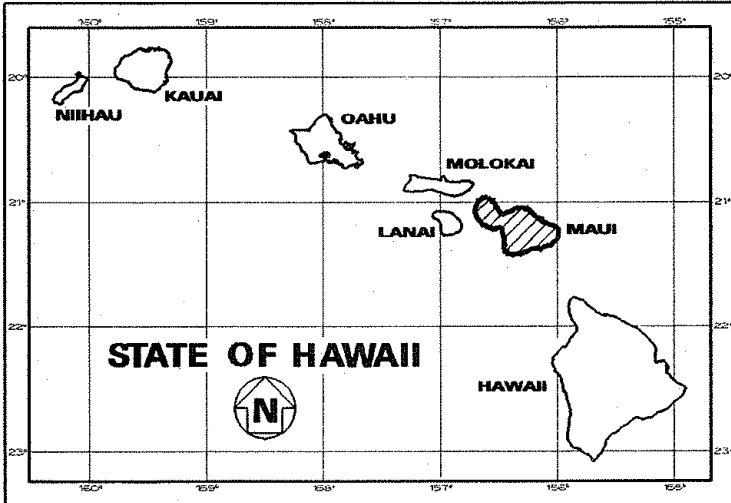


INDEX TO DRAWINGS	
SHEET NO.	DESCRIPTION
1	TITLE SHEET
2	STANDARD PLANS SUMMARY
3	NOTES
4 - 5	WATER POLLUTION & EROSION CONTROL NOTES
6	WATERLINE CONSTRUCTION NOTES
7	DRAINAGE SUMMARY
8 - 9	DRAINAGE PLANS
10 - 12	DRAINAGE PROFILES
13 - 14	DRAINAGE DETAILS
15	MISCELLANEOUS DETAILS

STATE OF HAWAII  
DEPARTMENT OF TRANSPORTATION  
HIGHWAYS DIVISION  
HONOLULU, HAWAII  
**"AS-BUILT"**  
PLANS FOR  
**WAIEHU BEACH ROAD**  
**MISCELLANEOUS DRAINAGE IMPROVEMENTS**  
VICINITY OF LOWER MAIN STREET TO EHA STREET  
**PROJECT NO. 3400AB-01-03**  
DISTRICT OF WAILUKU  
ISLAND OF MAUI

FED. ROAD DIST. NO.	STATE	PROJ. NO.	FISCAL YEAR	SHEET NO.	TOTAL SHEETS
HAWAII	HAW.	3400AB-01-03	2004	1	15

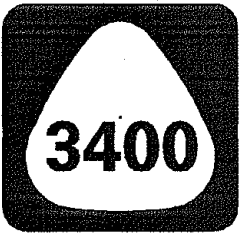

**LAYOUT PLAN**  
GROSS LENGTH OF PROJECT.....0.41 MILES

----- FEDERAL AID PROJECTS PREVIOUSLY CONSTRUCTED OR UNDER CONSTRUCTION

MILE POST 1.13 TO MILE POST 1.54

CHANGES MADE DURING CONSTRUCTION HAVE BEEN INCORPORATED ON THESE PLANS EXCEPT CHANGES IN THE ORIGINAL THEORETICAL QUANTITIES. FOR ACTUAL QUANTITIES, REFER TO PROJECT LEDGER AND/OR COMPUTATION BOOK.

*Charles D. ...* 8/1/09  
for RESIDENT ENGINEER DATE

DEPARTMENT OF TRANSPORTATION  
STATE OF HAWAII  
APPROVED:  
*Debra M. ...* 11/13/03  
for DIR. OF TRANSPORTATION DATE

Swahitshidgn/rendy