


FED. ROAD DIST. NO.	STATE	PROJ. NO.	FISCAL YEAR	SHEET NO.	TOTAL SHEETS
HAWAII	HAW.	3400AB-01-03	2004	15	16

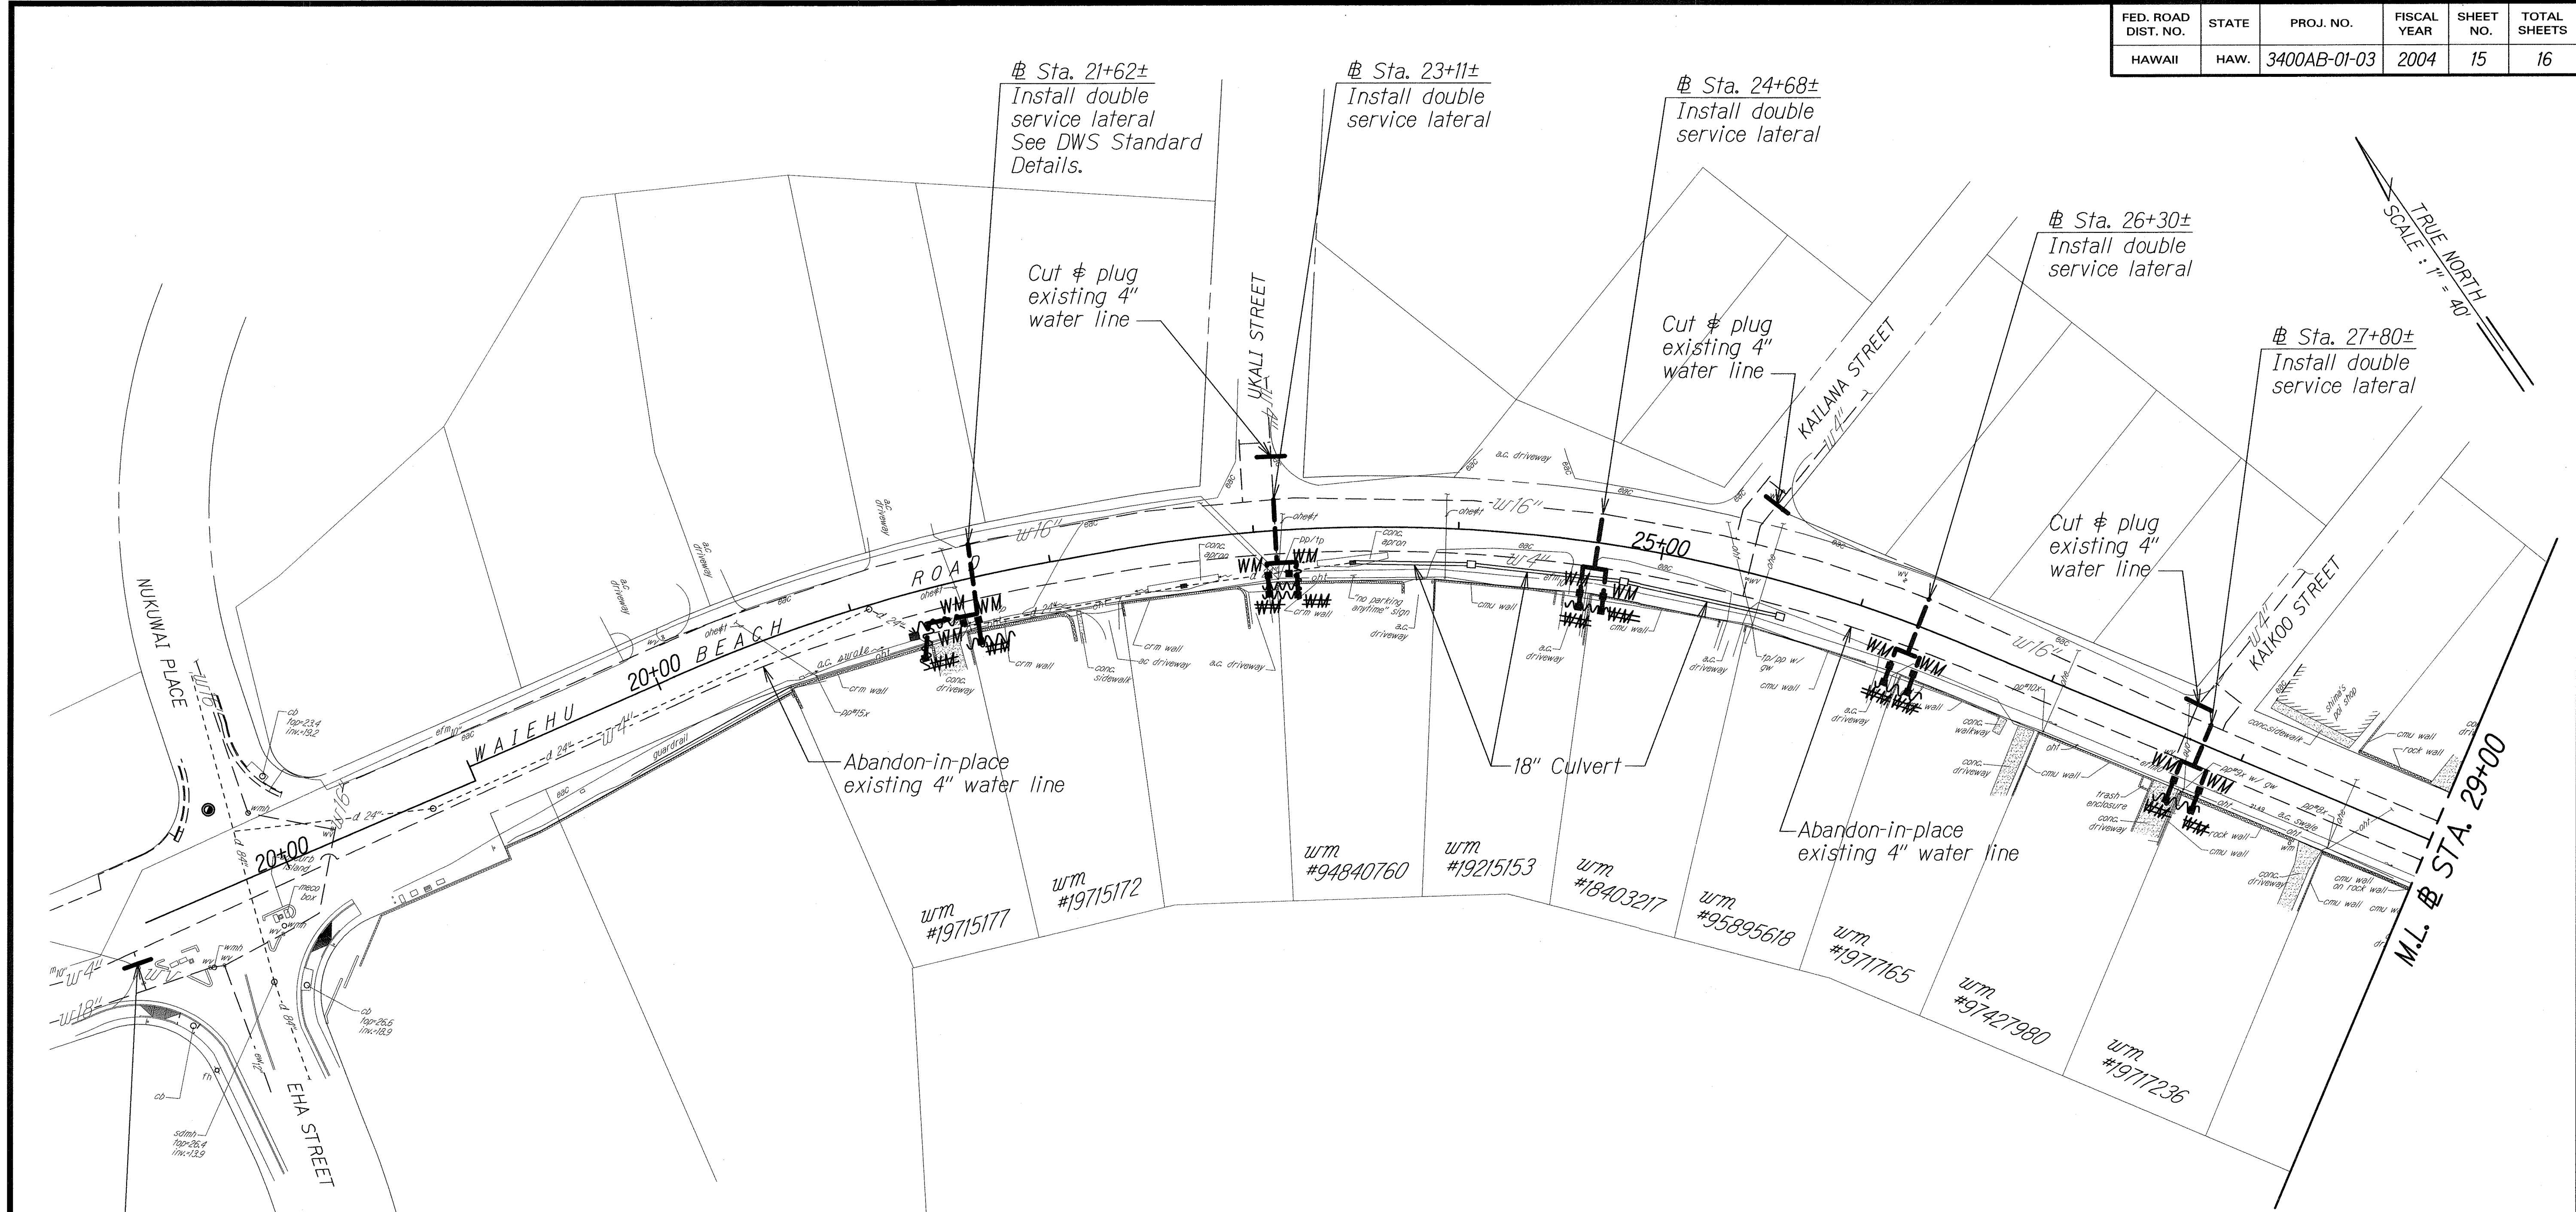

TRUE NORTH
SCALE: 1" = 40'

SURVEY PLOTTED BY	DATE
DRAWN BY	01/05/04
TRACED BY	
CHECKED BY	
QUANTITIES BY	
NOTED BY	
ORIGINAL PLAN	

LEGEND:

WM Relocated water meter

----- New water service lateral

LEGEND FOR AS-BUILT POSTINGS	
	Squiggly line for as-built deletion
	Double line for as-built deletion
Roadway	Text for as-built posting

APPROVED:

DIRECTOR, DEPARTMENT OF WATER SUPPLY DATE


COUNTY OF MAUI

(Approval is limited to the Water System Improvements which will be dedicated to the Department of Water Supply)

STATE OF HAWAII
DEPARTMENT OF TRANSPORTATION
HIGHWAYS DIVISION

WATER LATERAL PLAN
WAIEHU BEACH ROAD MISC. DRAINAGE IMPROVEMENTS
Vicinity of Lower Main Street to Eha Street
Project No. 3400AB-01-03
Scale: 1"=40' Date: January, 2004
SHEET No. 1 OF 2 SHEETS

FED. ROAD DIST. NO.	STATE	PROJ. NO.	FISCAL YEAR	SHEET NO.	TOTAL SHEETS
HAWAII	HAW.	3400AB-01-03	2004	16	16

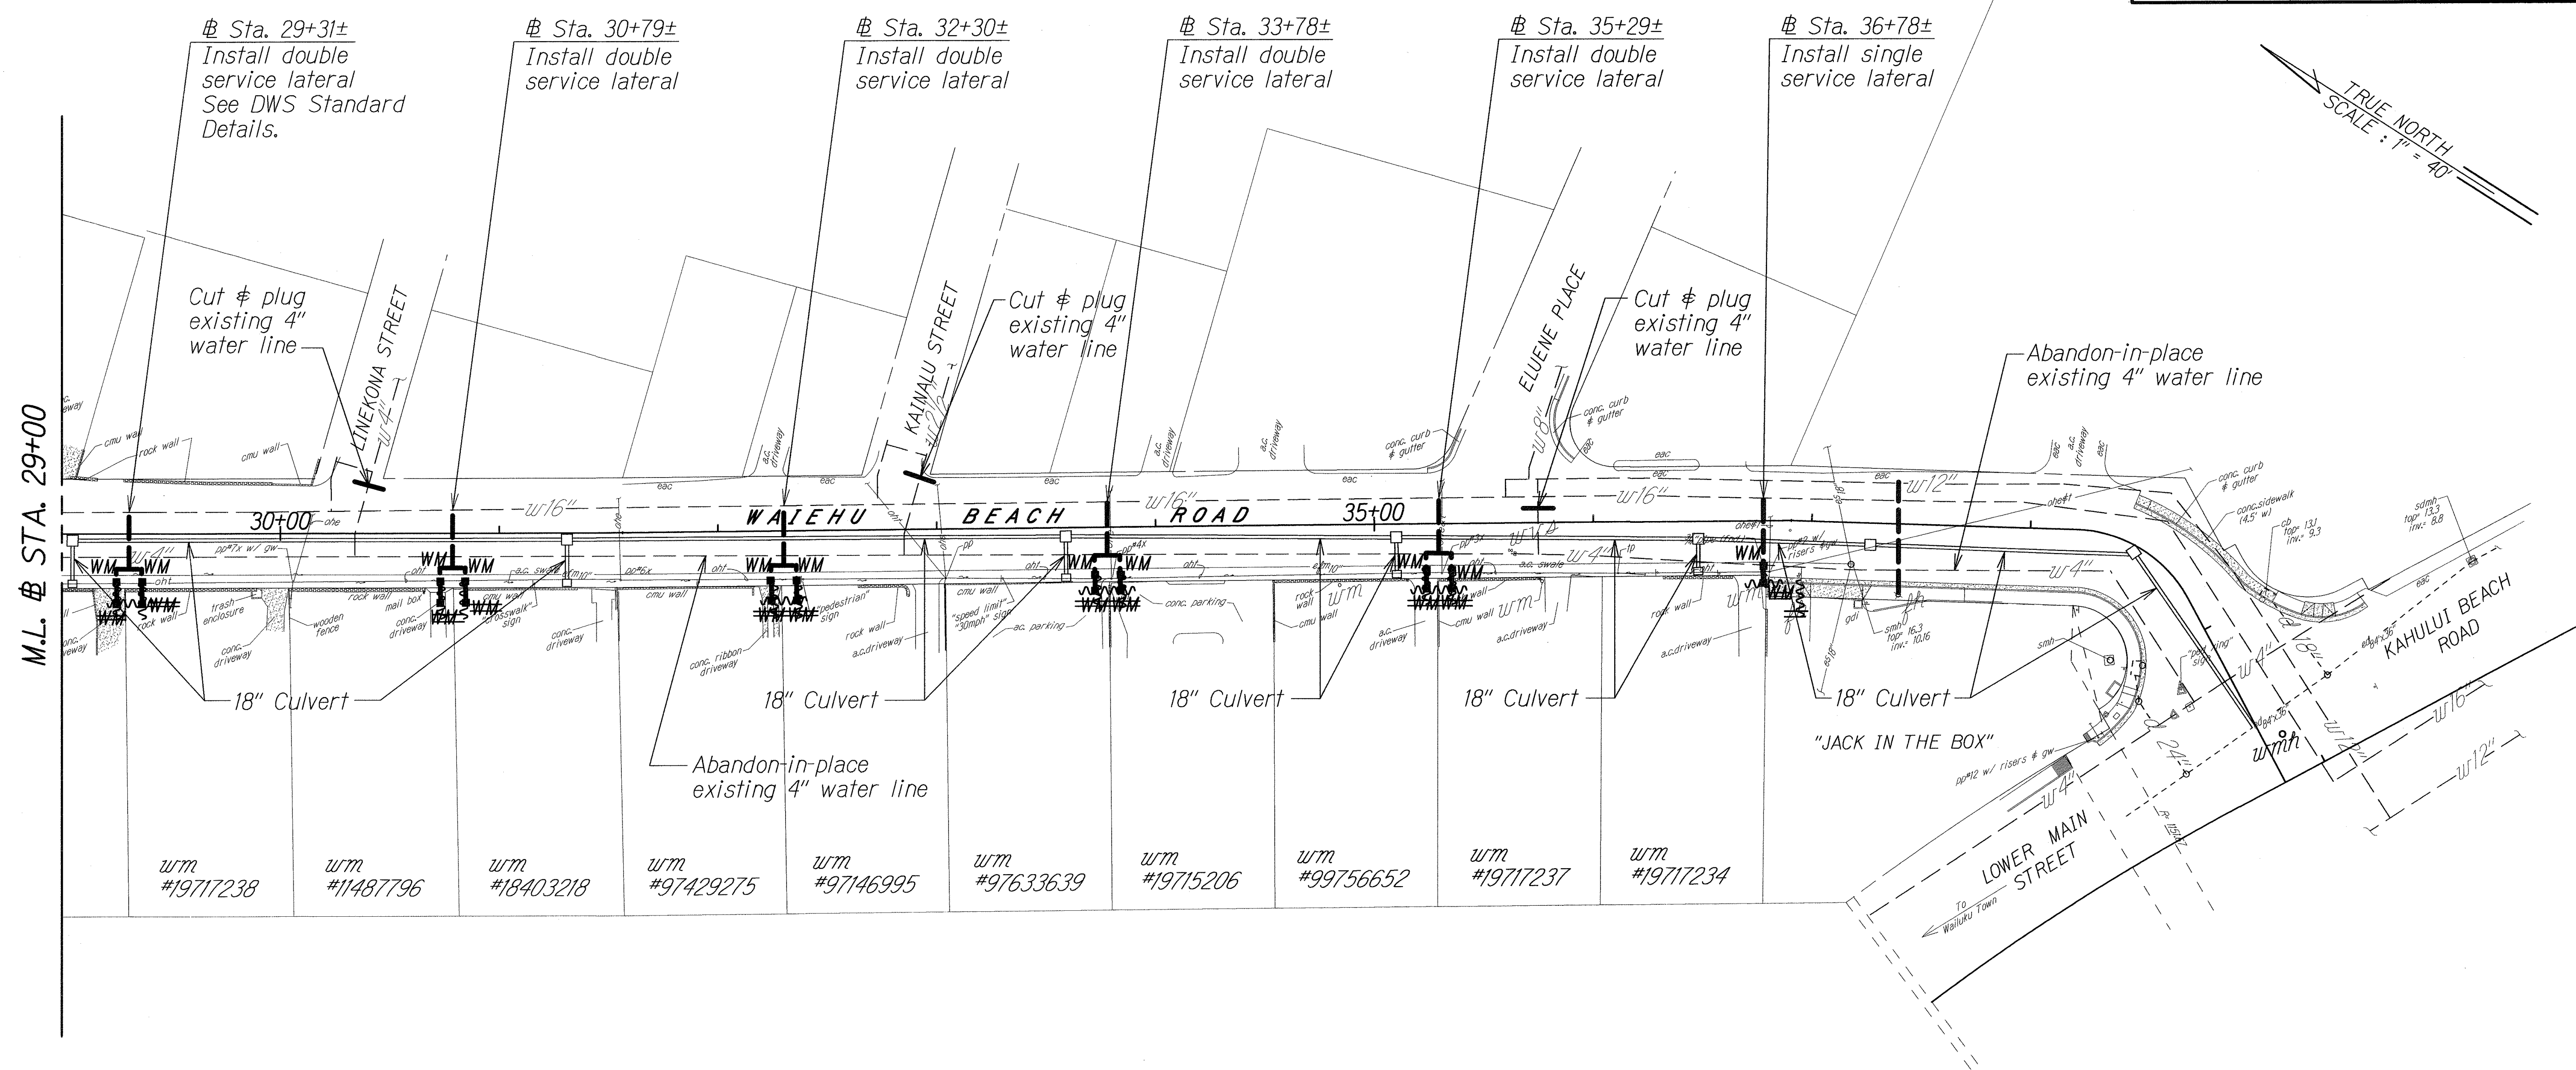

M.L. STA. 29+00

LEGEND:

- WM Relocated water meter
- New water service lateral

LEGEND FOR AS-BUILT POSTINGS

- Squiggly line for as-built deletion
- Double line for as-built deletion
- Roadway Text for as-built posting

APPROVED:

DIRECTOR, DEPARTMENT OF WATER SUPPLY
COUNTY OF MAUI
(Approval is limited to the Water System
Improvements which will be dedicated
to the Department of Water Supply)

DATE

STATE OF HAWAII
DEPARTMENT OF TRANSPORTATION
HIGHWAYS DIVISION

WATER LATERAL PLAN

WAEHU BEACH ROAD MISC. DRAINAGE IMPROVEMENTS
Vicinity of Lower Main Street to Eha Street
Project No. 3400AB-01-03

Scale: 1"=40' Date: January, 2004

SHEET No. 2 OF 2 SHEETS

"AS-BUILT"