
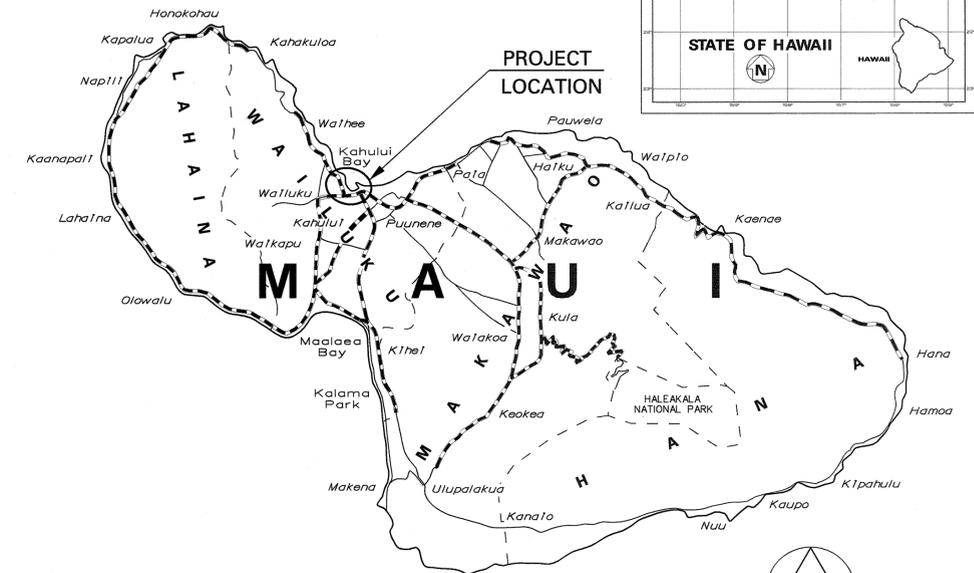


INDEX TO DRAWINGS	
SHEET NO.	DESCRIPTION
1	TITLE SHEET
2	STANDARD PLANS SUMMARY
3	GENERAL NOTES & LEGEND
4 - 5	WATER POLLUTION & EROSION CONTROL NOTES
6 - 8	TYPICAL SECTIONS & DETAILS
9 - 11	ROADWAY PLANS
12 - 13	PAVEMENT MARKING LEGEND, DETAILS & NOTES
14	WORK ZONE SIGNING PLAN, NOTES & DETAILS
15 - 17	SIGNING & PAVEMENT MARKING PLANS
18 - 19	TRAFFIC SIGNAL PLANS
20	SIGN PANEL LAYOUTS

STATE OF HAWAII  
DEPARTMENT OF TRANSPORTATION  
HIGHWAYS DIVISION  
HONOLULU, HAWAII  
**"AS-BUILT"**  
**PLANS FOR**  
**KAHULUI BEACH ROAD RESURFACING**  
**WAIIEHU BEACH ROAD TO KAAHUMANU AVENUE**  
**PROJECT NO. 3400A-01-07M**  
DISTRICT OF WAILUKU  
ISLAND OF MAUI

FED. ROAD DIST. NO.	STATE	PROJ. NO.	FISCAL YEAR	SHEET NO.	TOTAL SHEETS
HAWAII	HAW.	3400A-01-07M	2007	1	20

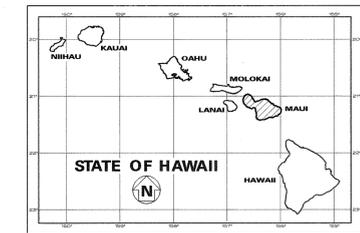


SCALE IN MILES

--- FEDERAL AID PROJECTS PREVIOUSLY CONSTRUCTED OR UNDER CONSTRUCTION

MILE POST 1.13 TO MILE POST 0.00

DESIGNED BY HWY-M  
MANAGED BY PAUL CHUNG  
PHONE 873-3535  
DATE OCT., 2006

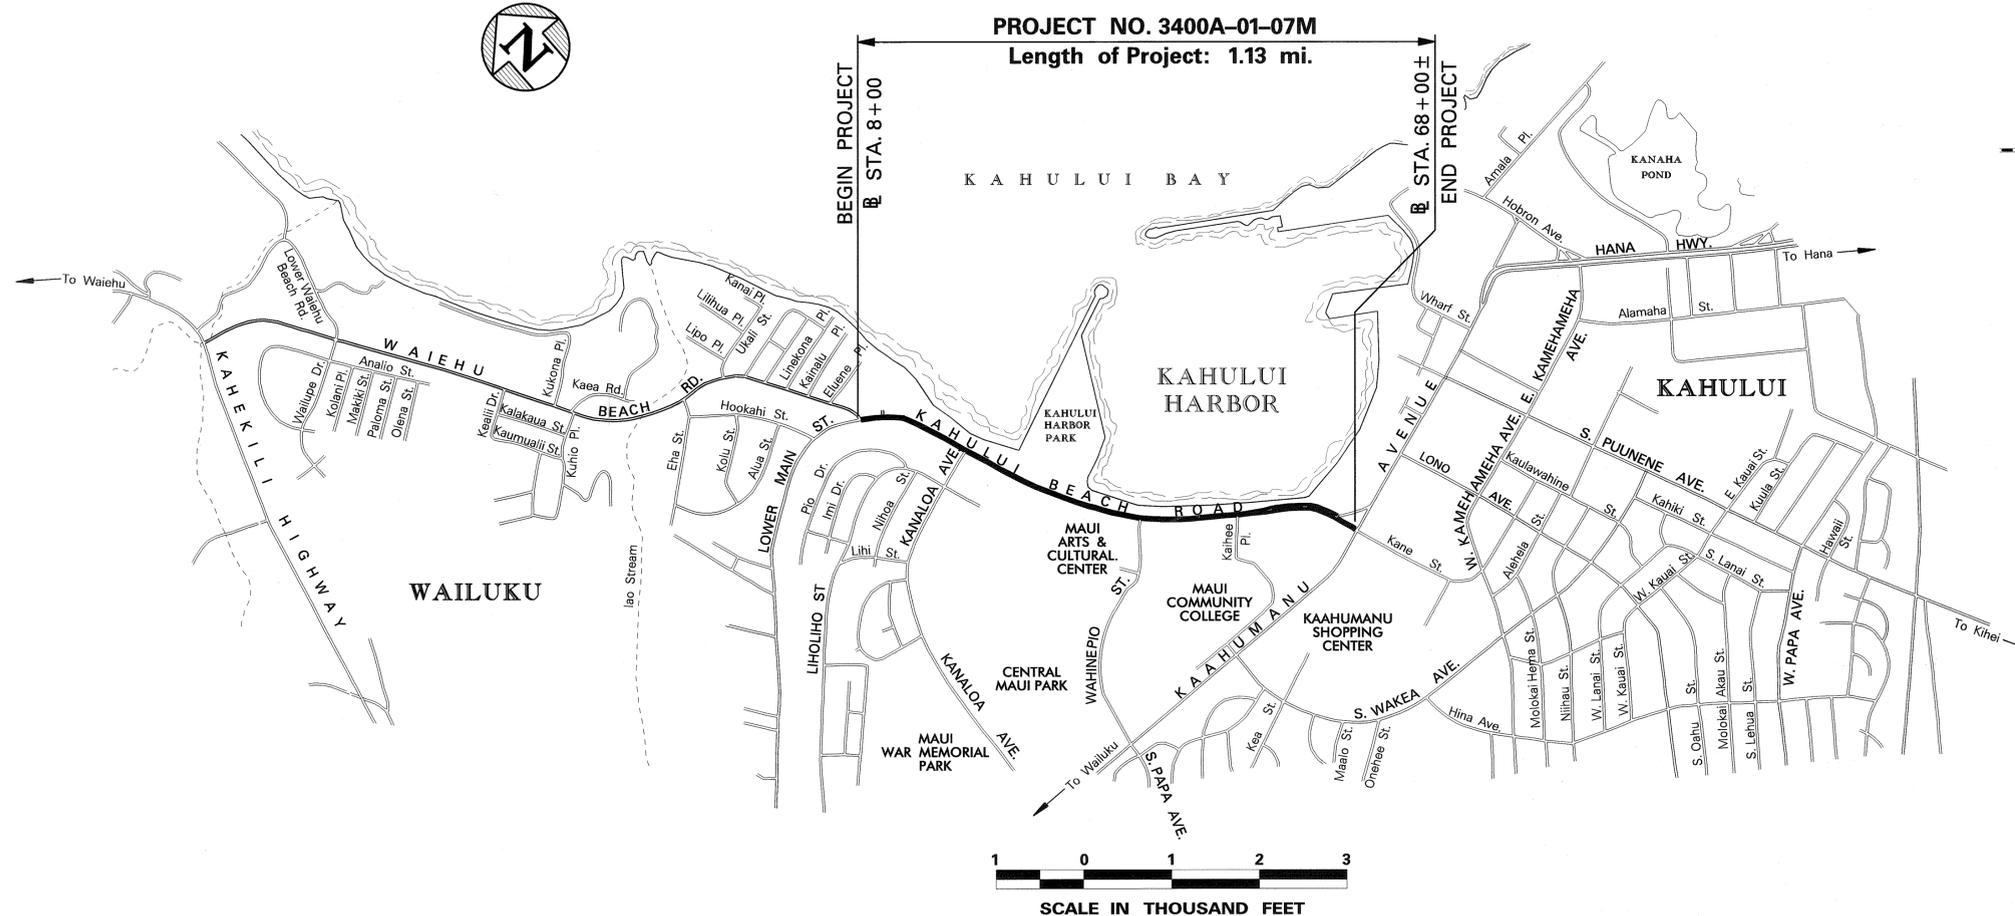

CHANGES MADE DURING CONSTRUCTION HAVE BEEN INCORPORATED ON THESE PLANS EXCEPT CHANGES IN THE ORIGINAL THEORETICAL QUANTITIES. FOR ACTUAL QUANTITIES, REFER TO PROJECT LEDGER AND/OR COMPUTATION BOOK.  
*[Signature]* 12-2-11  
RESIDENT ENGINEER DATE

DEPARTMENT OF TRANSPORTATION  
STATE OF HAWAII  
APPROVED:  
*[Signature]* 2-8-07  
DIR. OF TRANSPORTATION DATE