



FED. ROAD DIST. NO.	STATE	PROJ. NO.	FISCAL YEAR	SHEET NO.	TOTAL SHEETS
HAWAII	HAW.	3400A-01-07M	2007	ADD.18A	20


LEGEND FOR
AS-BUILT POSTINGS

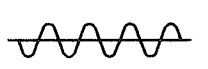

Squiggly line for as-built deletion

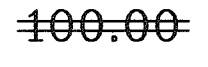






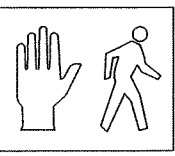
Double line for as-built deletion

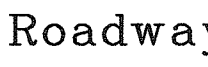

Text for as-built posting

TRAFFIC SIGNAL SYSTEM CONDUIT AND CABLE SCHEDULE										
	DELTA ITEM NO. (Δ)									
	Δ1	Δ2	Δ3	Δ4	Δ5	Δ6	Δ7	Δ8	Δ9	Δ10
QUANTITY OF 2" C, SEE NOTE NO. 1	2	1	1	3	2	1	3	4	6	6
SPARE	1			1	1		1	1	1	1
QUANTITY OF 26/C #14 CONTROL CABLE	1			1	1		1	1	2	2
QUANTITY OF 2/C #14 SHIELDED LOOP DETECTOR AND PEDESTRIAN PB CABLE		4	1	4		1	4	6	11	11
NOTE: 1. ALL CONDUITS SHALL BE SCHEDULE 80 PVC, UNLESS OTHERWISE NOTED.										

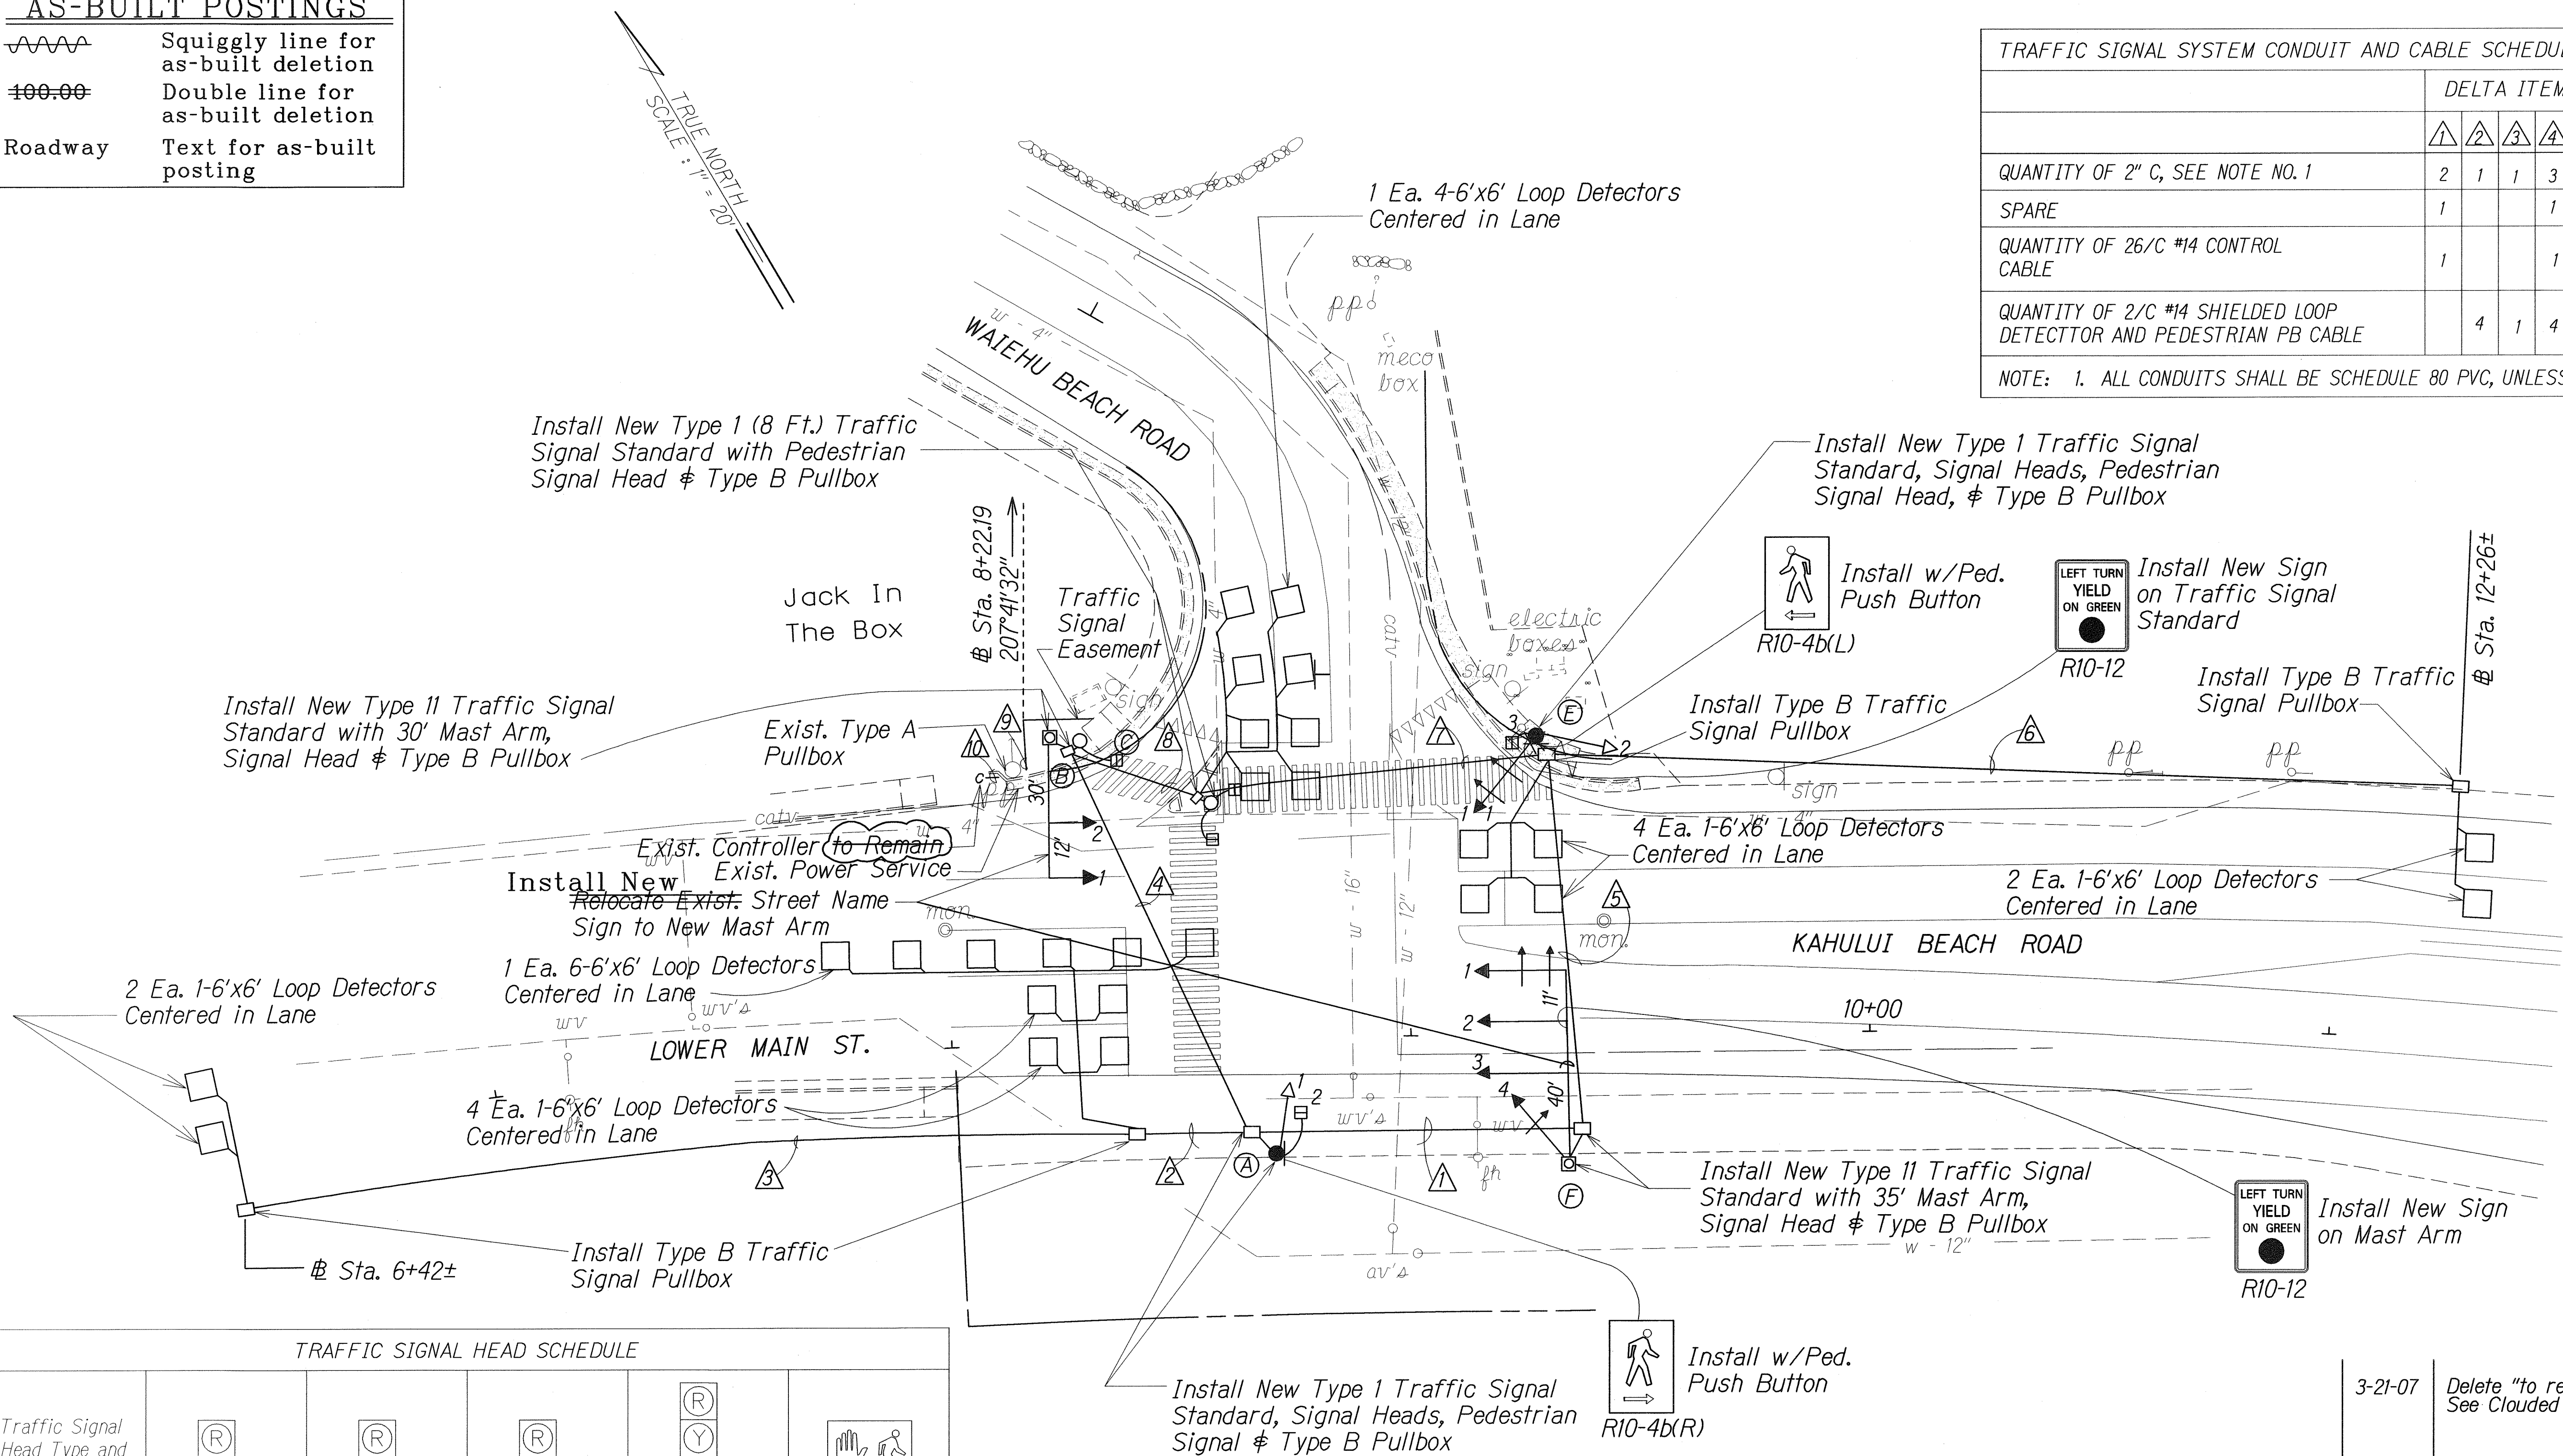

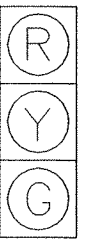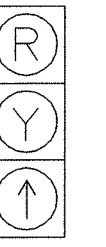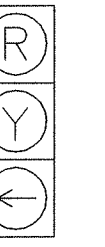TRAFFIC SIGNAL HEAD SCHEDULE					
Traffic Signal Head Type and Description					
	12" RYG Traffic Signal Head	12" RY↑ Traffic Signal Head	12" RY← Traffic Signal Head	12" RYG & Traffic Signal Head	Pedestrian Signal Head
Pole Letter	A-1	B-1	F-4	E-1	A-2
Signal Head Number	B-2 E-2	F-2 F-3		F-1	C-1 D-1 D-2 E-3

- NOTE:
- All Exist. Traffic Signal Standards, Mast Arms, Signal Heads and Appurtenances, Conductors & Loop Lead Cables, Controller and Cabinet shall be replaced. All work shall be Incidental to the Various Traffic Items.
 - The footings on Type II Traffic Signal Standard (B) shall be replaced. Footing and Signal Standard shall conform to current AASHTO 2005 Standards.

3-21-07	Delete "to remain". See Clouded Area & added Note #2.
---------	---

DATE	REVISION
------	----------

STATE OF HAWAII
DEPARTMENT OF TRANSPORTATION
HIGHWAYS DIVISION

TRAFFIC SIGNAL PLAN

AT WAIEHU BEACH ROAD

KAHULUI BEACH ROAD RESURFACING

Waiehu Beach Road to Kaahumanu Avenue

Project No. 3400A-01-07M

Scale: 1" = 20' Date: October, 2006


SHEET No. 1 OF 2 SHEETS

FED. ROAD DIST. NO.	STATE	PROJ. NO.	FISCAL YEAR	SHEET NO.	TOTAL SHEETS
HAWAII	HAW.	3400A-01-07M	2007	ADD.19A	20

TRAFFIC SIGNAL SYSTEM CONDUIT AND CABLE SCHEDULE												
	DELTA ITEM NO. (△)											
	△1	△2	△3	△4	△5	△6	△7	△8	△9	△10	△11	△12
QUANTITY OF 2" C, SEE NOTE NO. 1	1	1	1	2	3	3	4	5	1	6	1	Exist.
SPARE				1	1	1	1	1		1		
QUANTITY OF 26/C #14 CONTROL CABLE			1	1	1	1	1	2		2		
QUANTITY OF 2/C #14 SHIELDED LOOP DETECTOR AND PEDESTRIAN PB CABLE	1	3			4	4	7	8	2	10		
QUANTITY OF 3C #6											1	Exist.
NOTE: 1. ALL CONDUITS SHALL BE SCHEDULE 80 PVC, UNLESS OTHERWISE NOTED.												

Additional Note:
The footings on Type I Traffic Signal Stds. (C) and (E) and on Type II Traffic Signal Stds. (B) and (D) shall be replaced. Footings and Signal Stds. shall conform to current AASHTO 2005 Stds.

LEGEND FOR AS-BUILT POSTINGS	
	Squiggly line for as-built deletion
	Double line for as-built deletion
Roadway	Text for as-built posting

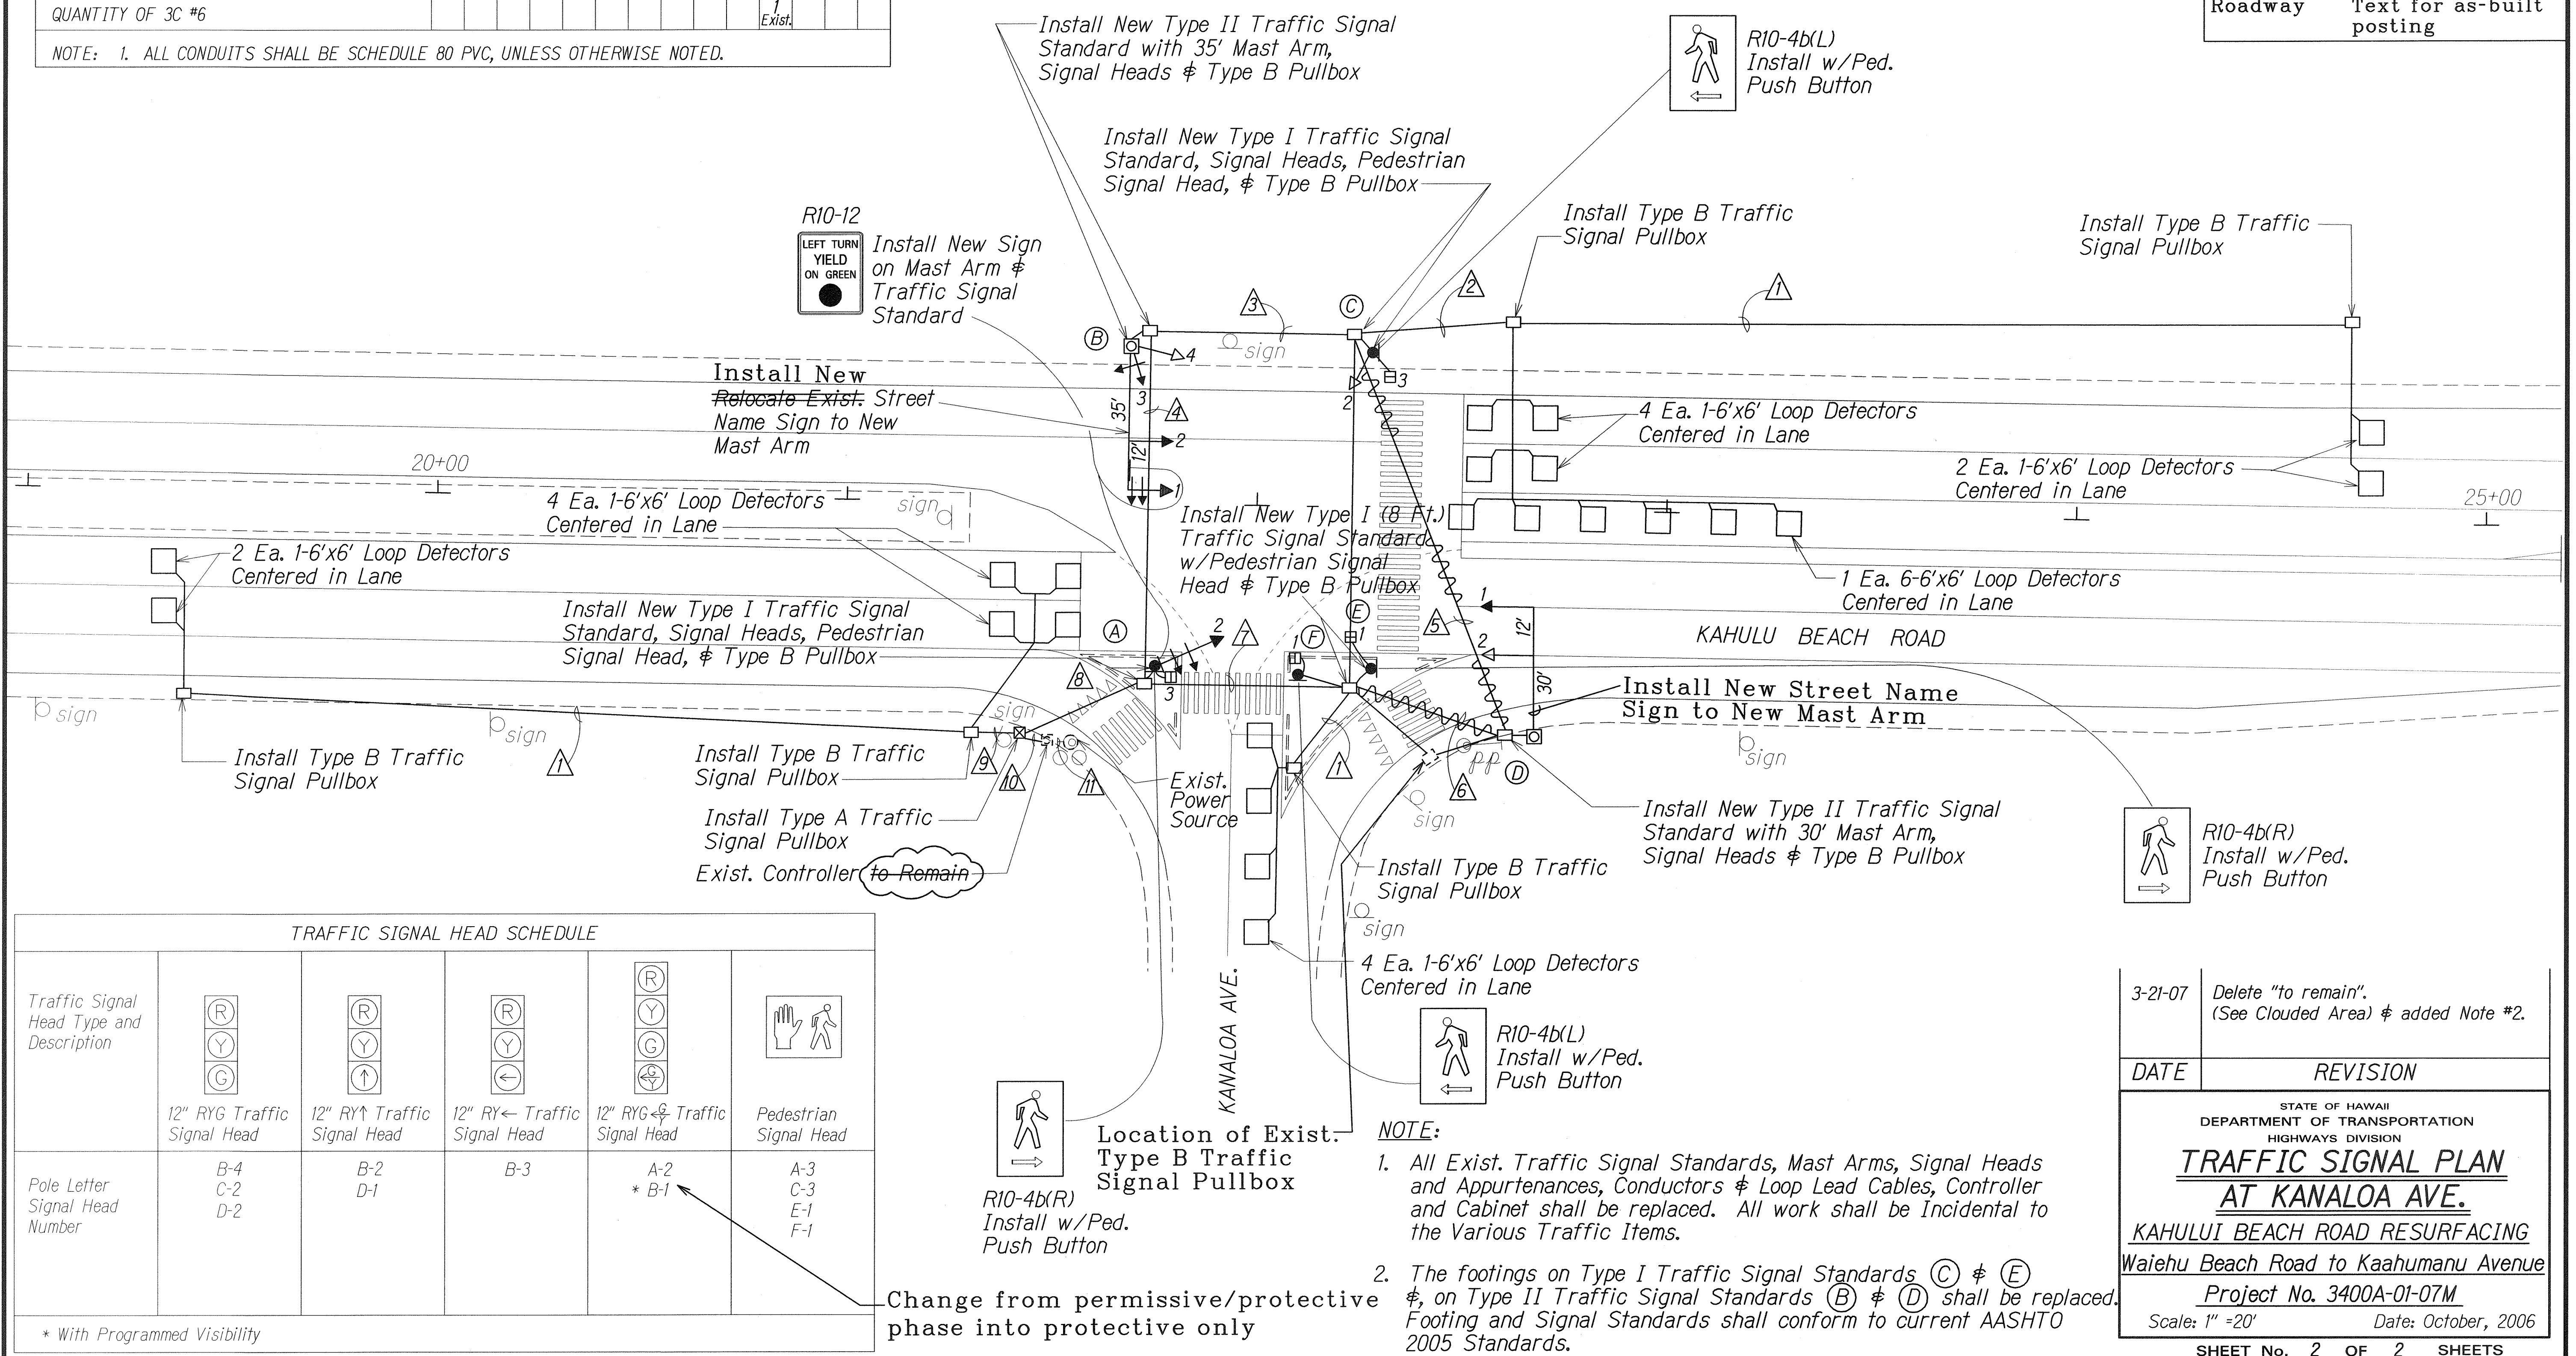

TRAFFIC SIGNAL HEAD SCHEDULE					
Traffic Signal Head Type and Description					
Pole Letter Signal Head Number	B-4 C-2 D-2	B-2 D-1	B-3	A-2 * B-1	A-3 C-3 E-1 F-1
* With Programmed Visibility					

3-21-07	Delete "to remain". (See Clouded Area) & added Note #2.
DATE	REVISION
STATE OF HAWAII DEPARTMENT OF TRANSPORTATION HIGHWAYS DIVISION TRAFFIC SIGNAL PLAN AT KAWALO AVE. KAHULUI BEACH ROAD RESURFACING Waiehu Beach Road to Kaahumanu Avenue Project No. 3400A-01-07M Scale: 1" = 20' Date: October, 2006 SHEET No. 2 OF 2 SHEETS	

DESIGNED BY: T. J. J. J.	DATE: 10/24/06
NOTED BY: T. J. J. J.	
CHECKED BY: T. J. J. J.	
ORIGINAL PLAN	