



FED. ROAD DIST. NO.	STATE	FED. AID PROJ. NO.	FISCAL YEAR	SHEET NO.	TOTAL SHEETS
HAWAII	HAW.	BR-STP-3400(5)	2012	42	108

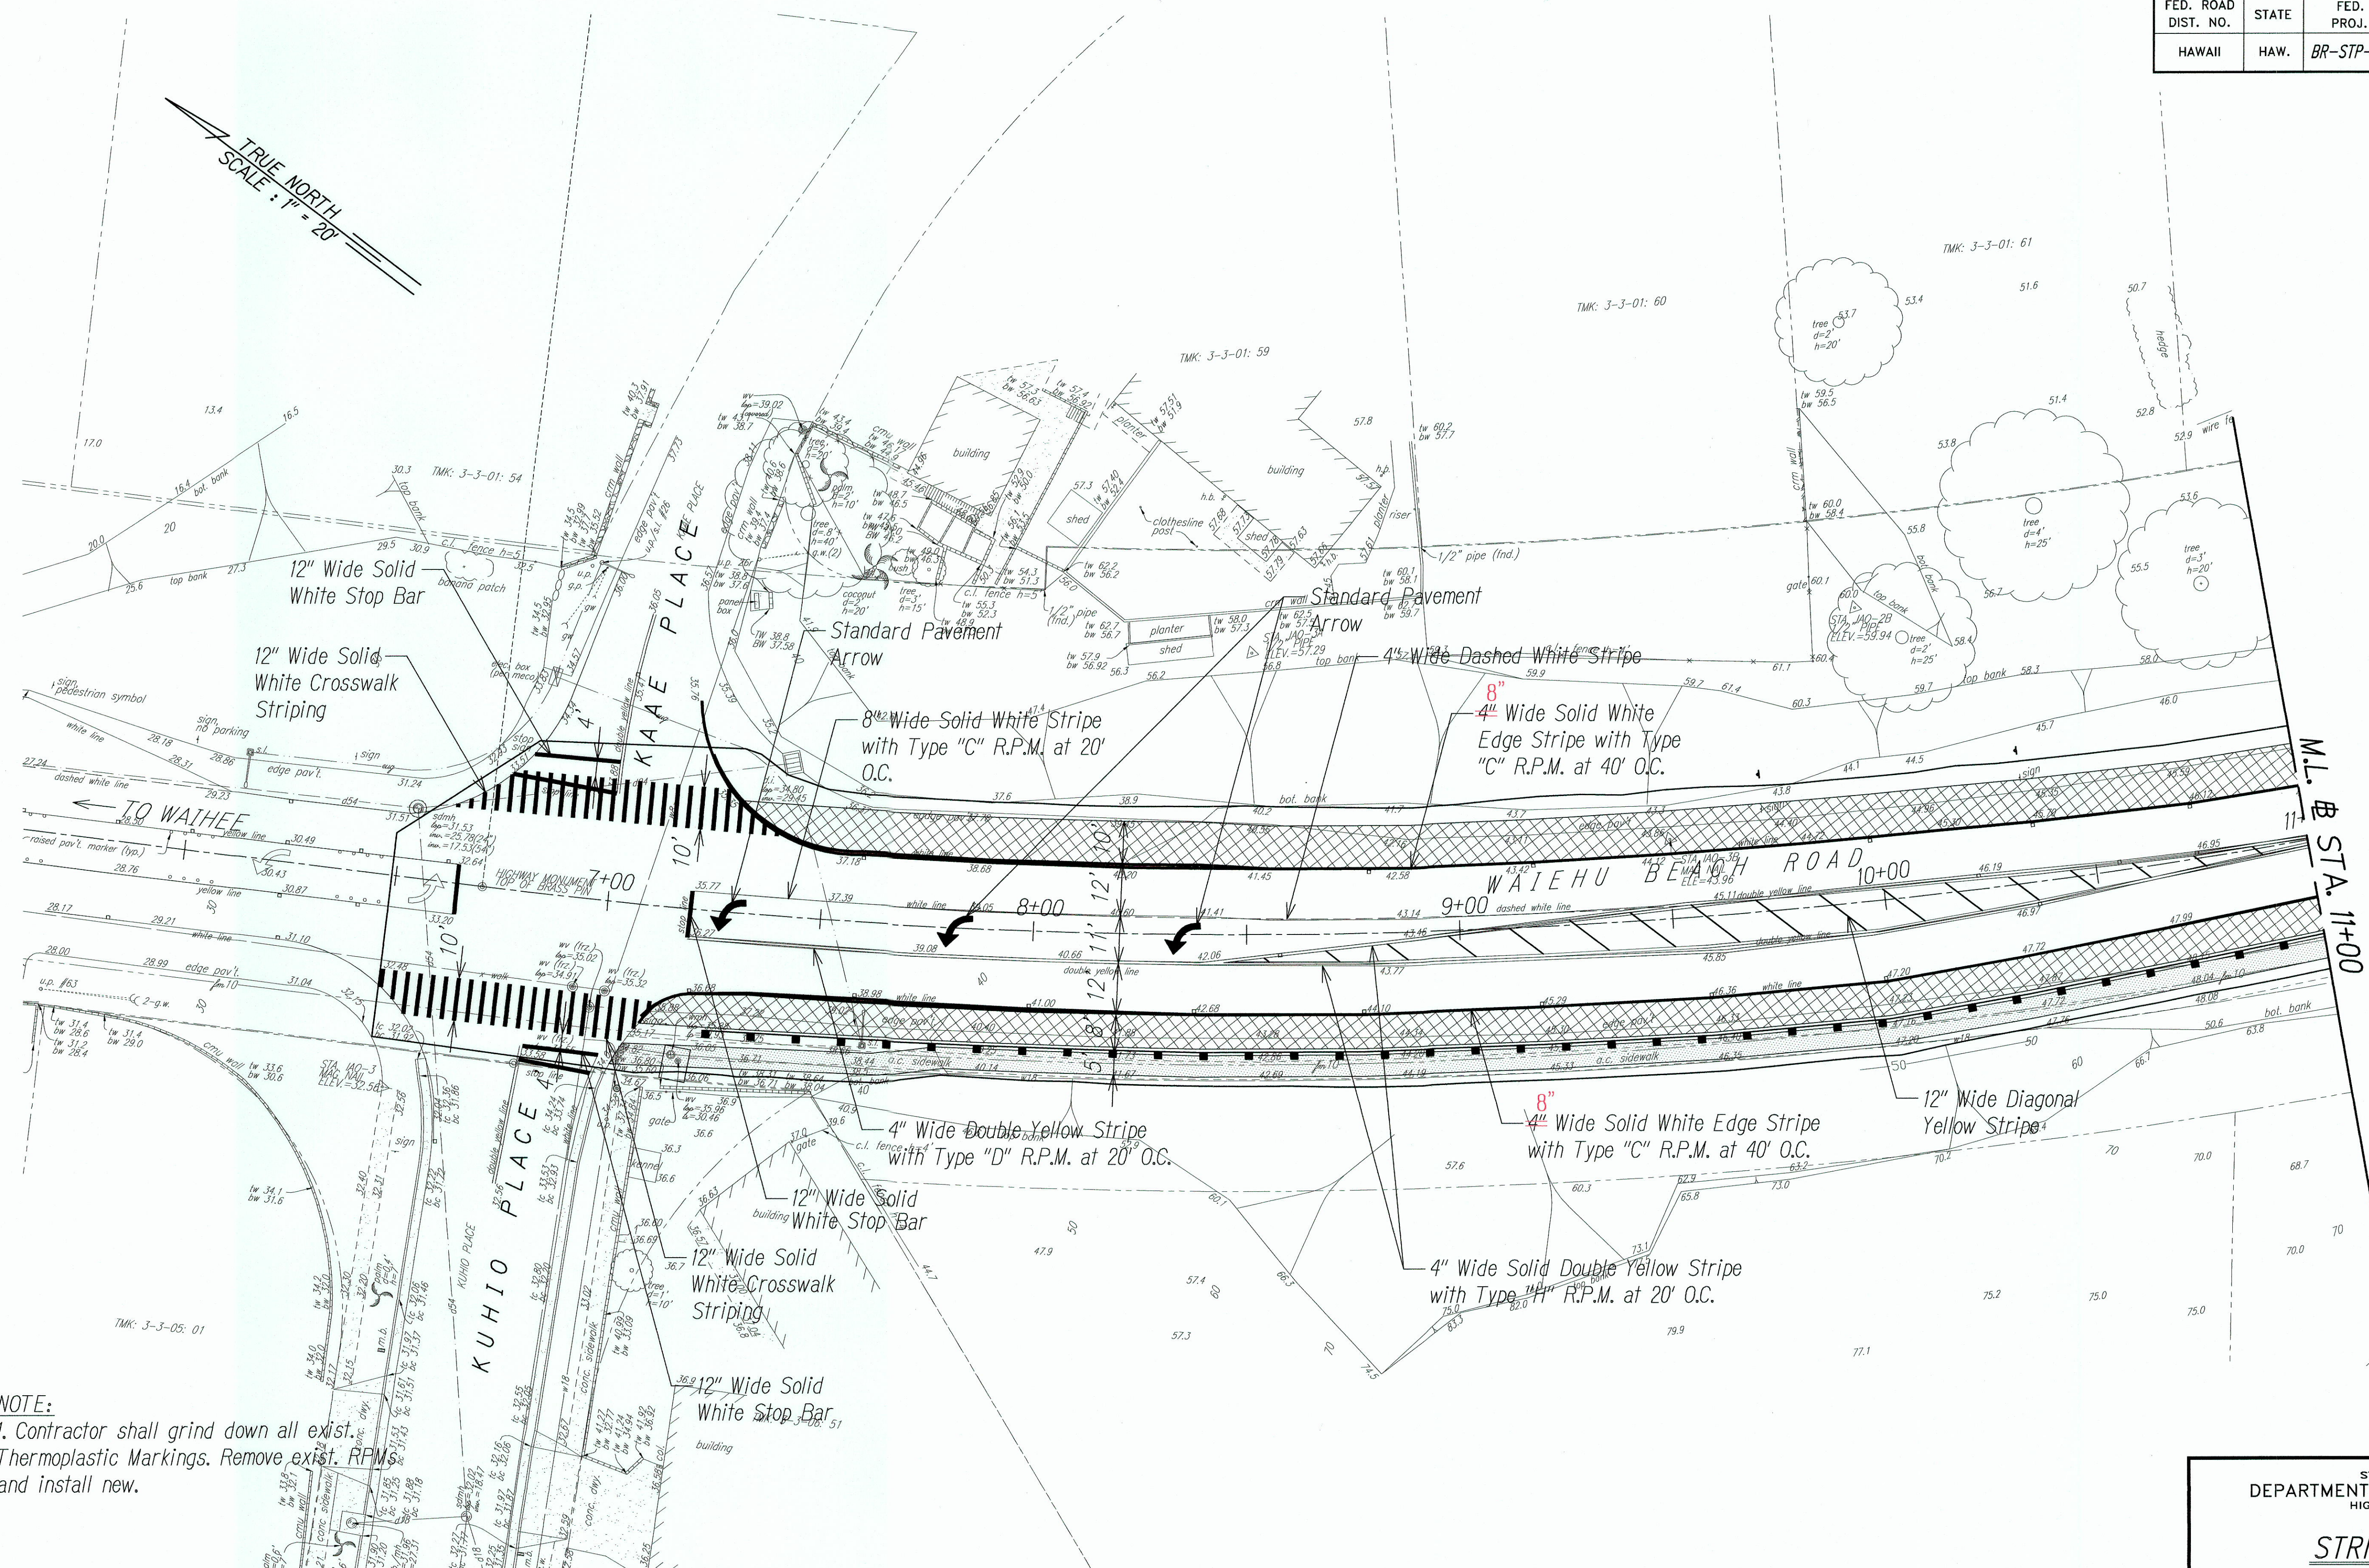

NOTE:
1. Contractor shall grind down all exist. Thermoplastic Markings. Remove exist. R.P.M.s and install new.

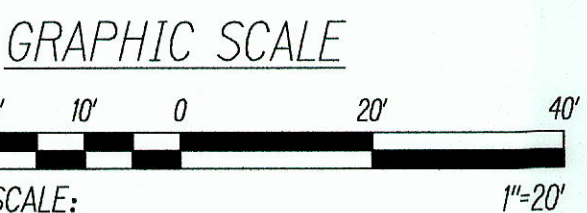

ROADWAY STRIPING PLAN
SCALE: 1"=20'

DATE	_____
SURVEY PLOTTED BY	_____
DESIGNED BY	_____
NOTED BY	_____
CHECKED BY	_____



THIS WORK WAS PREPARED BY ME OR UNDER MY SUPERVISION.
Richard T. Harada
WILSON OKAMOTO CORPORATION LIC. EXP. DATE

STATE OF HAWAII
DEPARTMENT OF TRANSPORTATION
HIGHWAYS DIVISION

STRIPING PLAN


WAEIHU BEACH ROAD
REHABILITATION OF IAO STREAM BRIDGE
Federal Aid Project No. BR-STP-3400(5)

Date: October 2012


SHEET No. RS1 OF 3 SHEETS

"AS-BUILT"

FED. ROAD DIST. NO.	STATE	FED. AID PROJ. NO.	FISCAL YEAR	SHEET NO.	TOTAL SHEETS
HAWAII	HAW.	BR-STP-3400(5)	2012	43	108

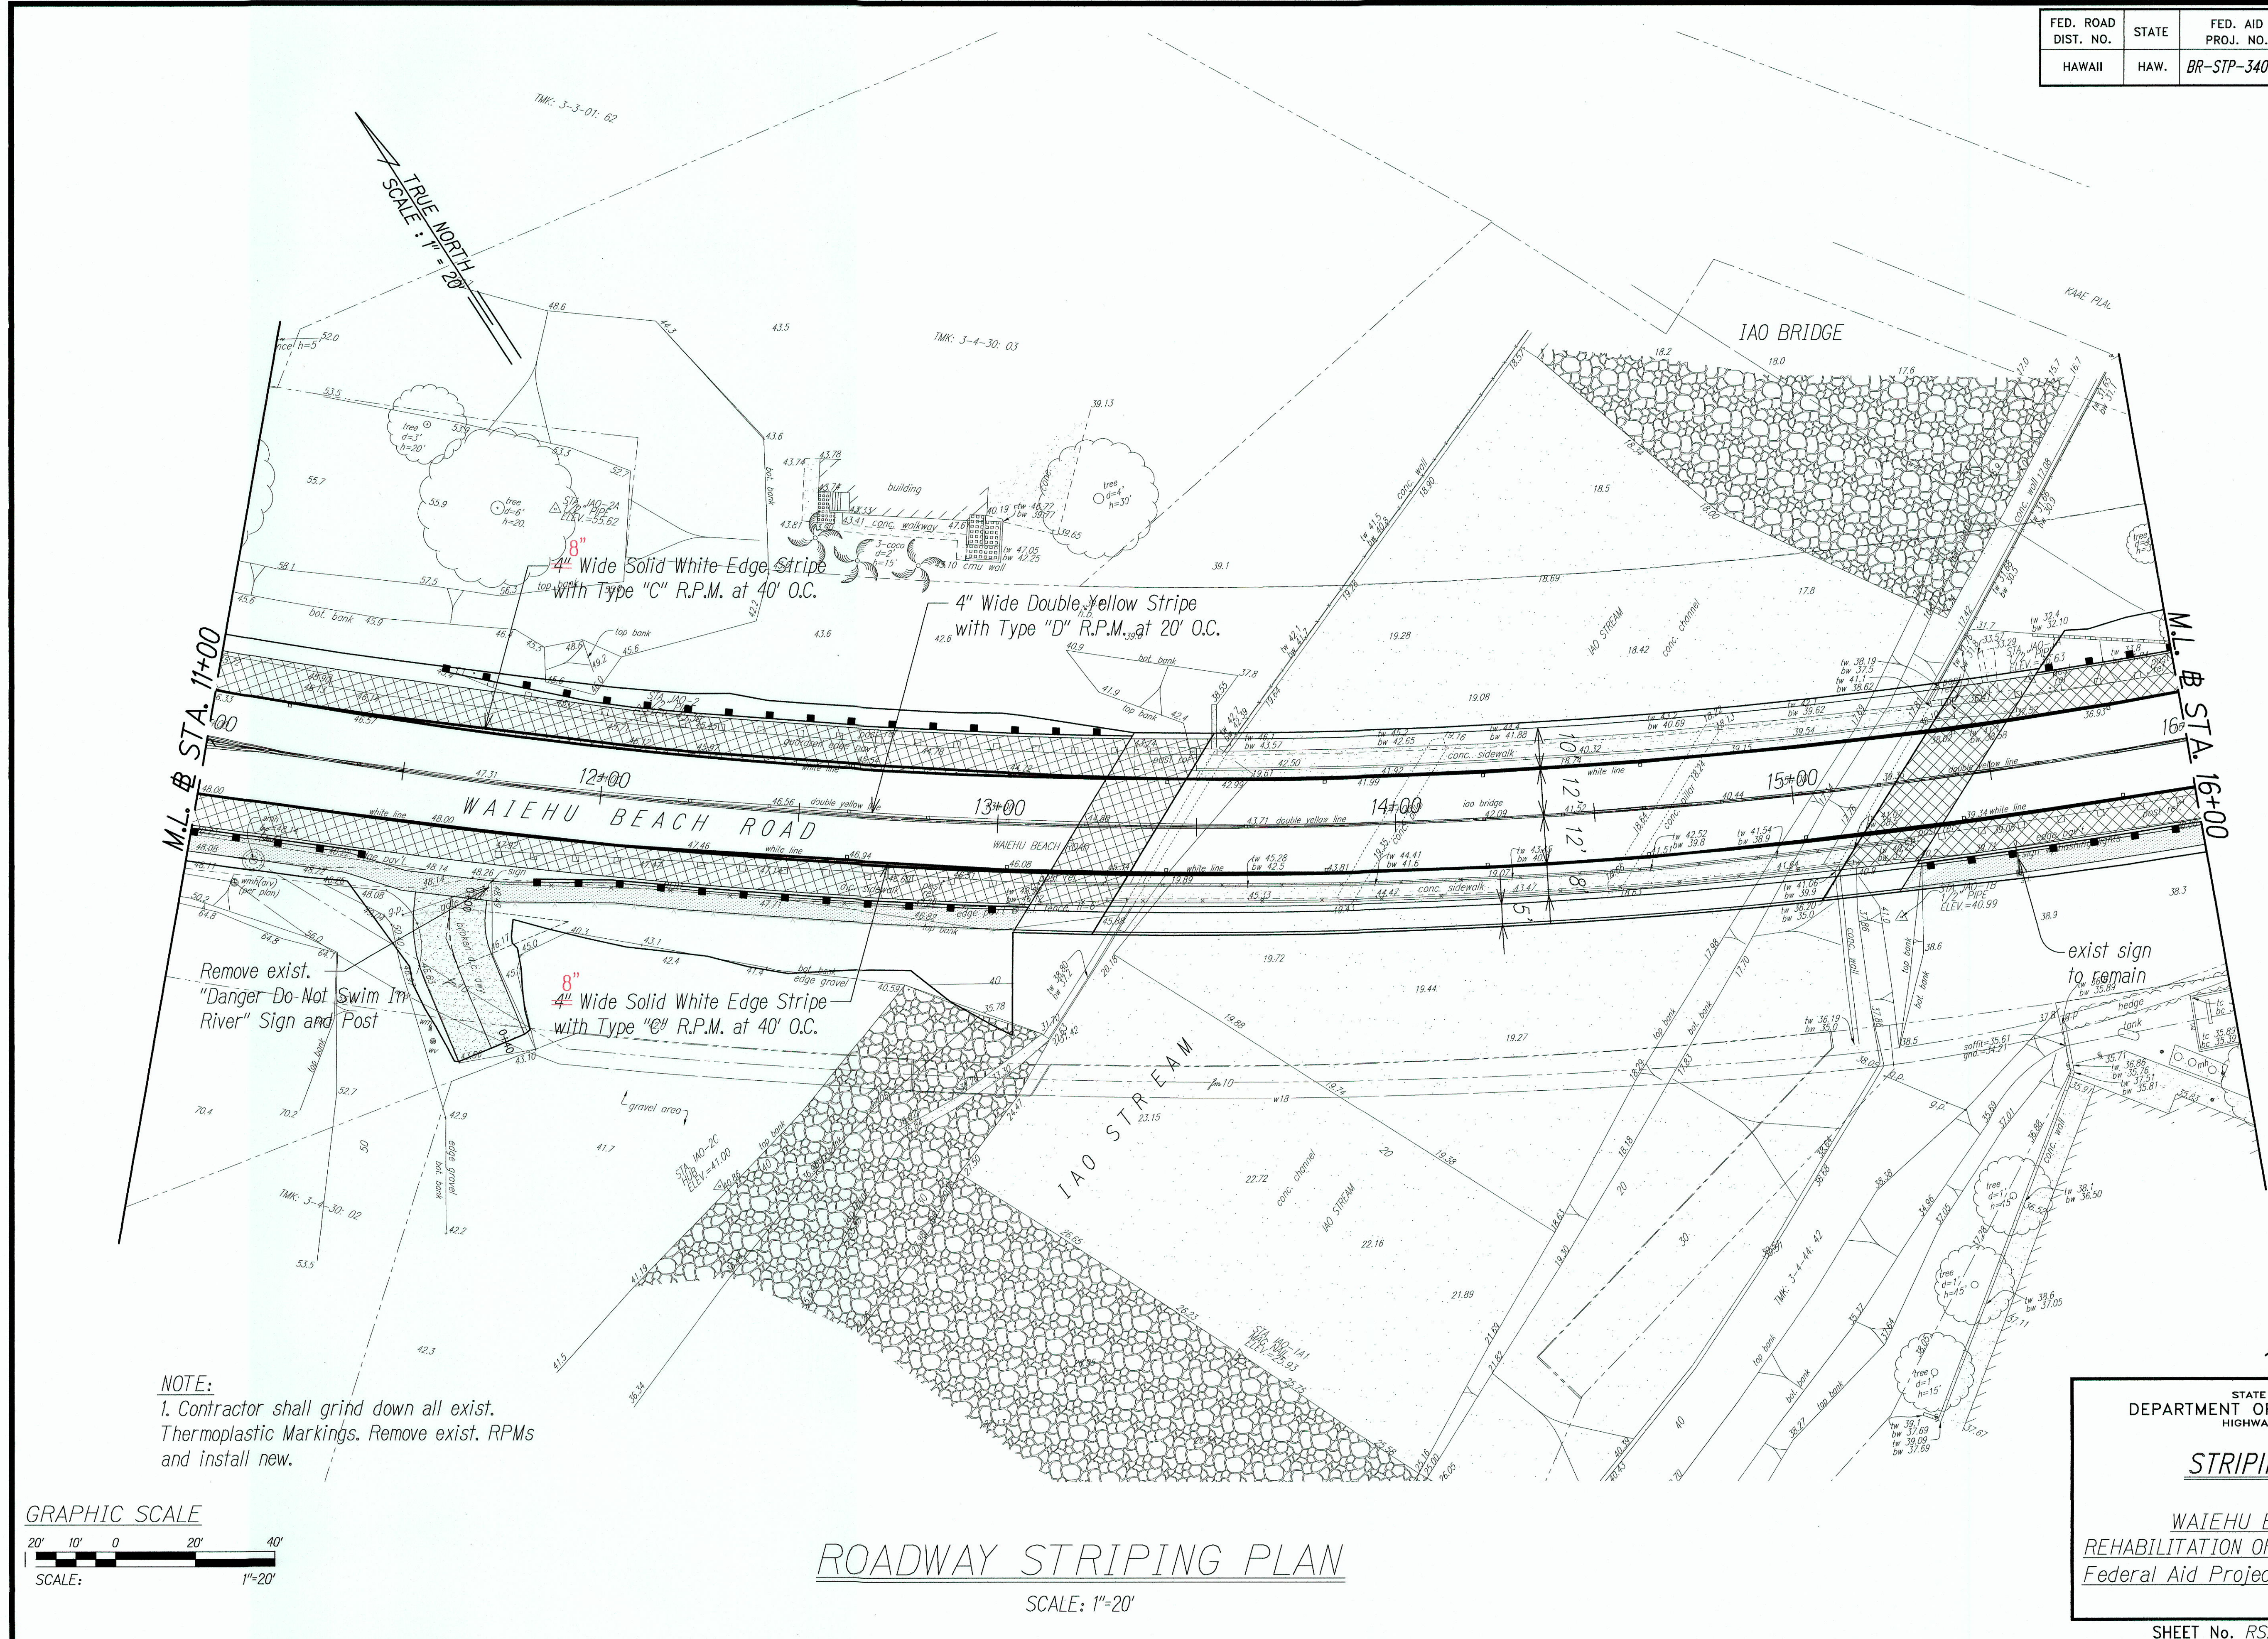


ORIGINAL PLAN	SURVEY PLOTTED BY _____ DATE _____	
	DRAWN BY _____	
	DESIGNED BY _____	
	CHECKED BY _____	
NOTE BOOK	QUANTITIES BY _____	
	No. _____	

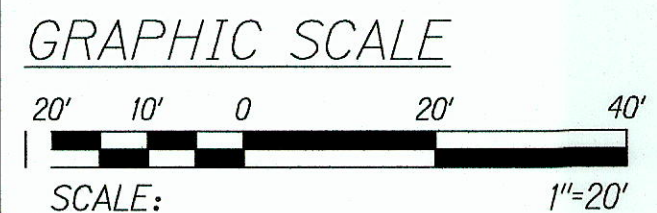

NOTE:
1. Contractor shall grind down all exist. Thermoplastic Markings. Remove exist. RPMs and install new.

ROADWAY STRIPING PLAN

SCALE: 1"=20'

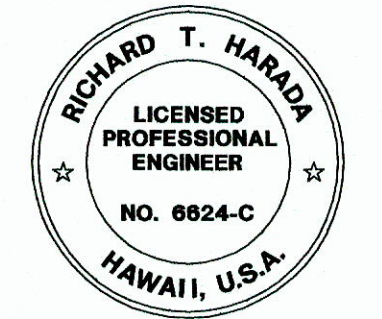

THIS WORK WAS PREPARED BY ME OR UNDER MY SUPERVISION.
Richard T. Harada
WILSON OKAMOTO CORPORATION LIC. EXP. DATE

STATE OF HAWAII
DEPARTMENT OF TRANSPORTATION
HIGHWAYS DIVISION

STRIPING PLAN

WAIIEHU BEACH ROAD
REHABILITATION OF IAO STREAM BRIDGE
Federal Aid Project No. BR-STP-3400(5)

Date: October 2012

SHEET No. RS2 OF 3 SHEETS

"AS-BUILT"

