

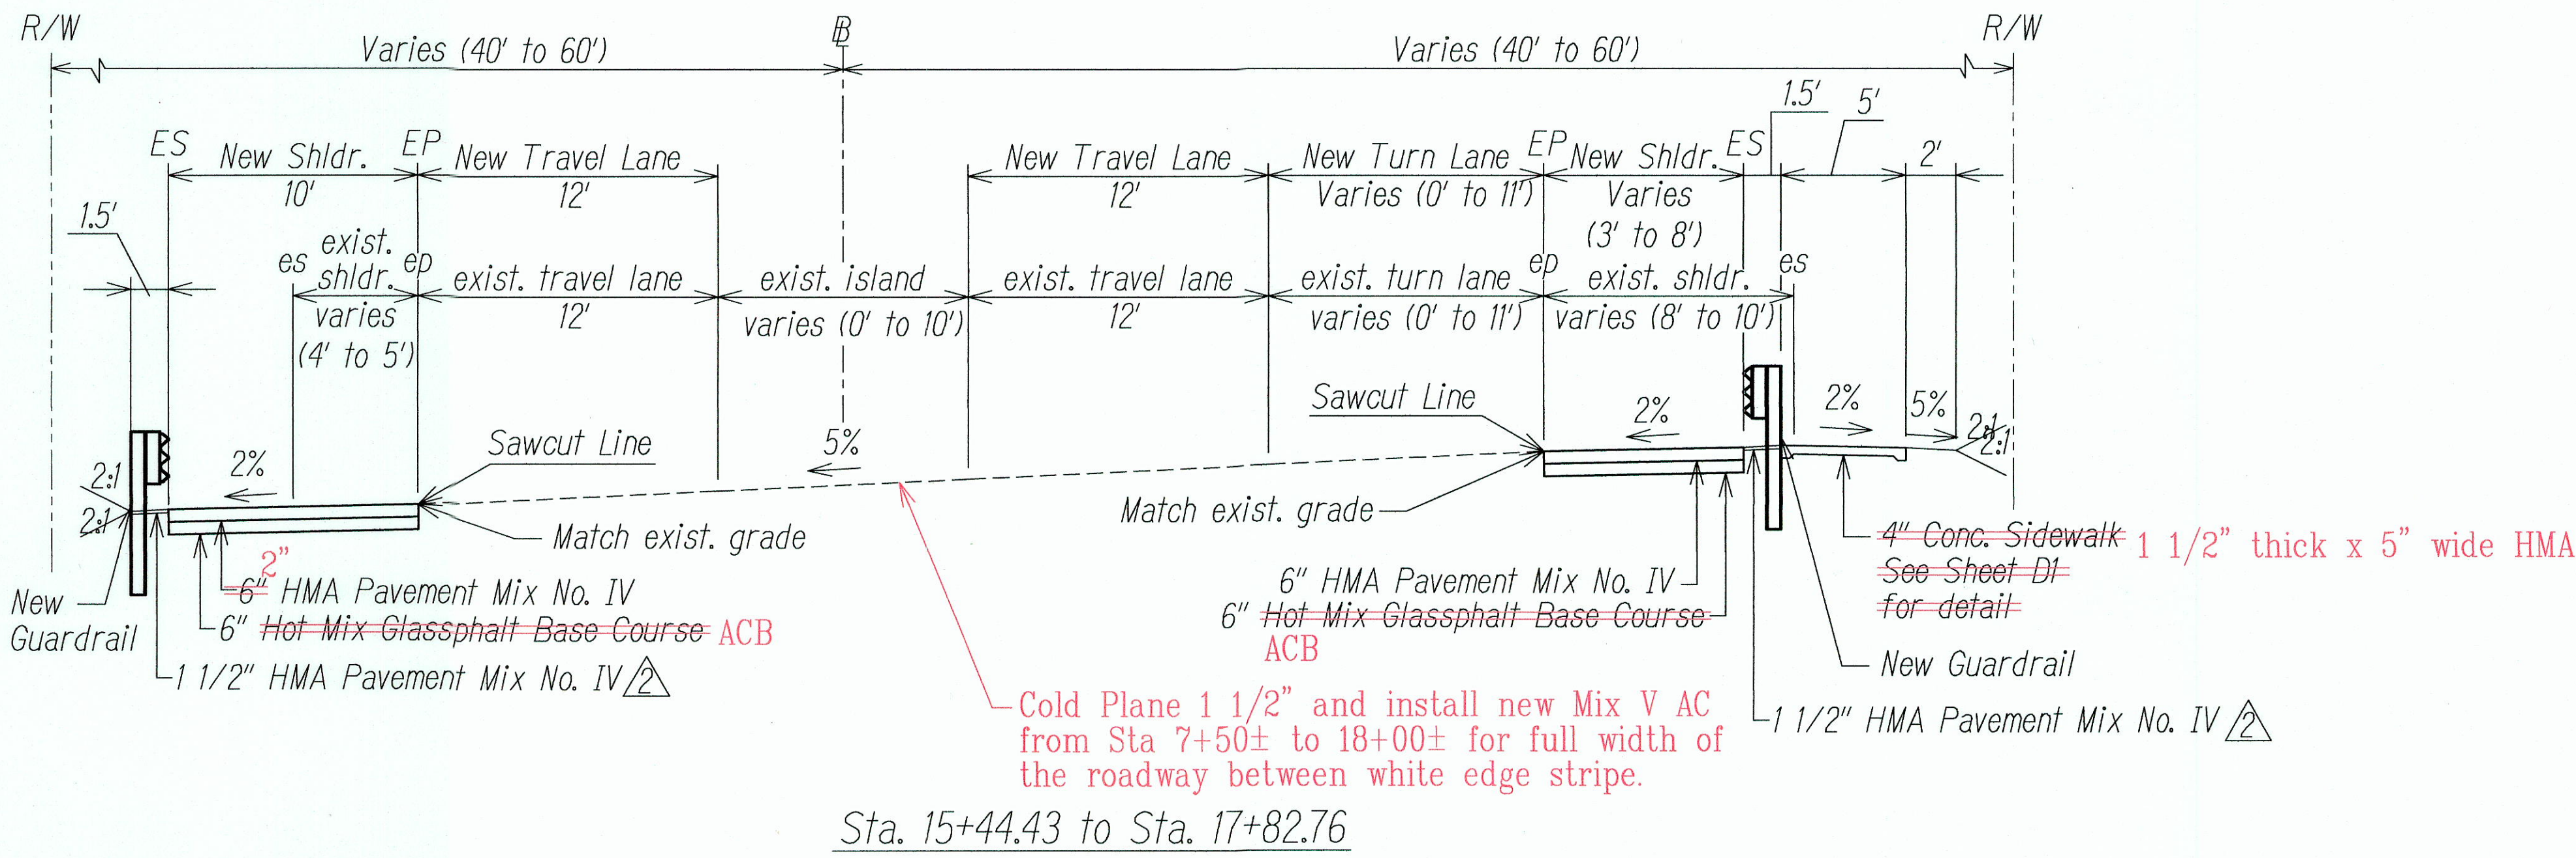


FED. ROAD DIST. NO.	STATE	FED. AID PROJ. NO.	FISCAL YEAR	SHEET NO.	TOTAL SHEETS
HAWAII	HAW.	BR-STP-3400(5)	2012	ADD.8	108

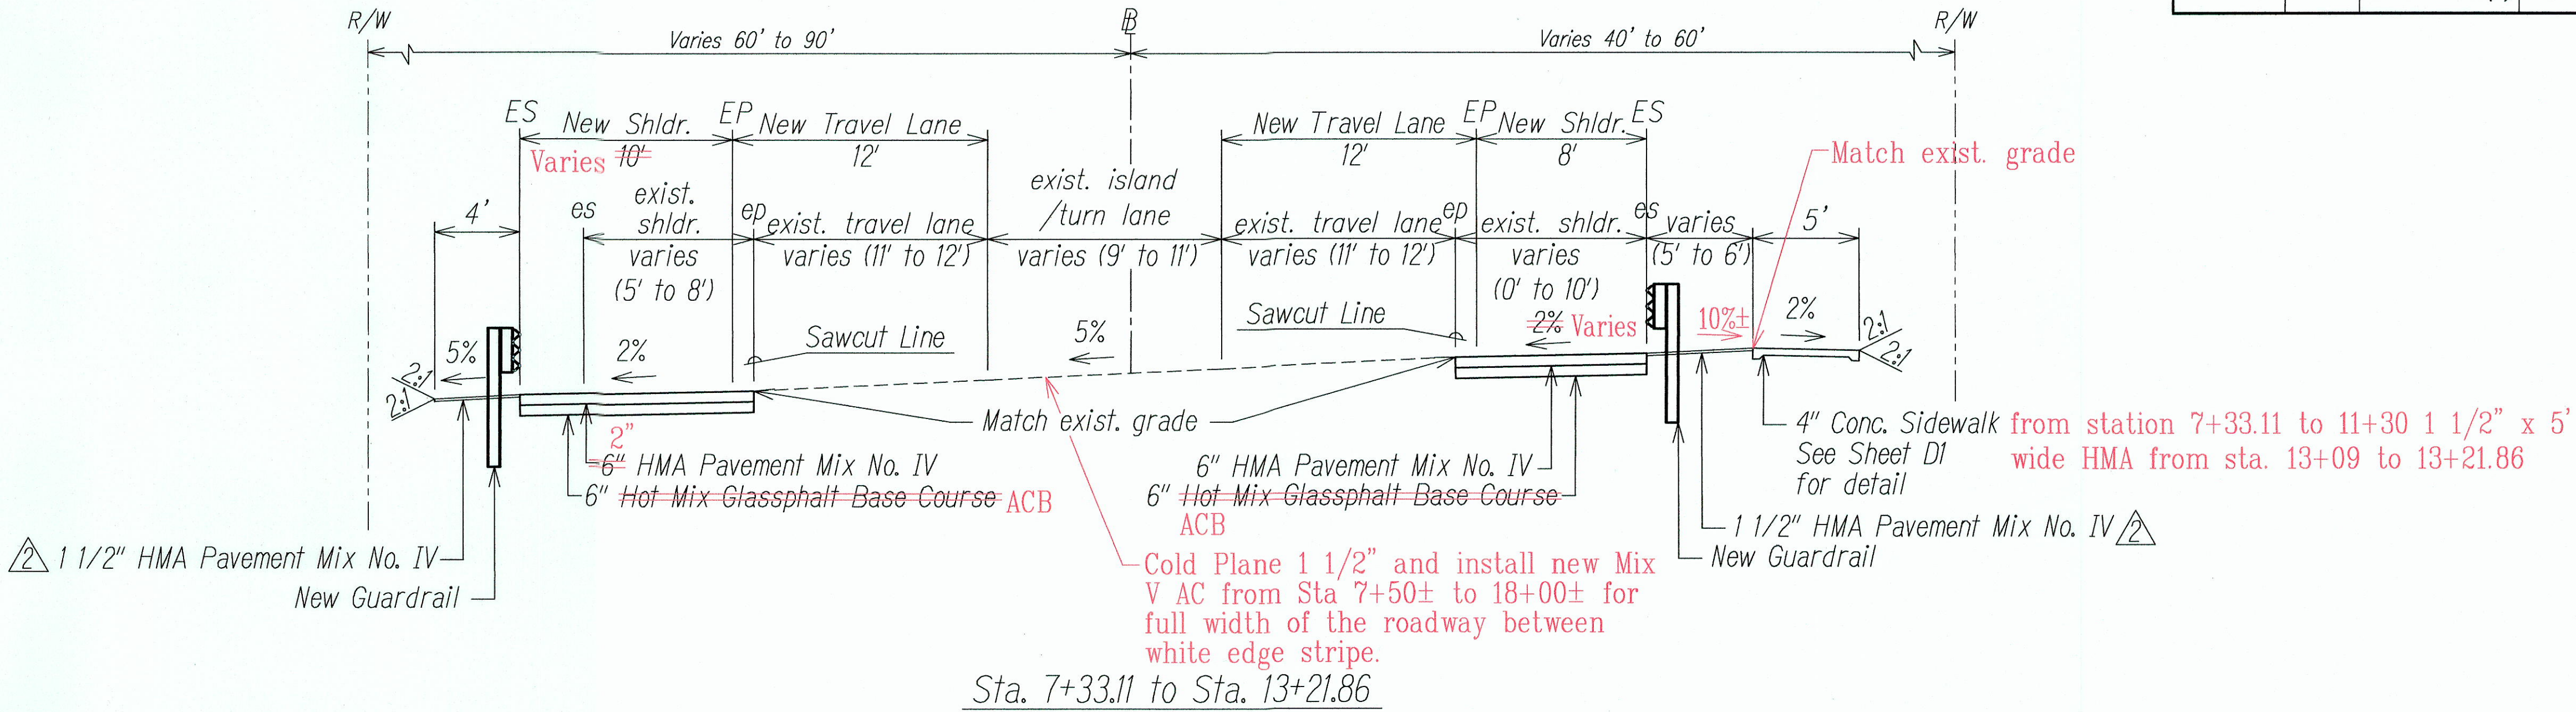

NOTE:
1. For location of new guardrail, see roadway plan sheet RPI to RP3.

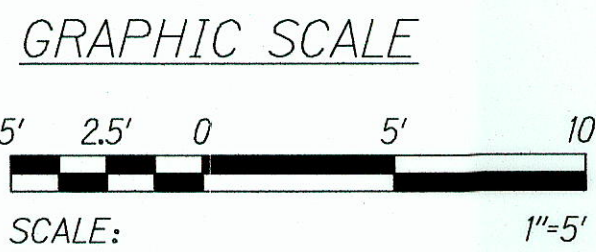

TYPICAL ROADWAY SECTIONS
Scale: 1"=5'

1/30/13	Revise pavement thickness at guardrail.
DATE	REVISION

STATE OF HAWAII

DEPARTMENT OF TRANSPORTATION

HIGHWAYS DIVISION

TYPICAL ROADWAY SECTIONS

WAIEHU BEACH ROAD

REHABILITATION OF IAO STREAM BRIDGE

Federal Aid Project No. BR-STP-3400(5)

Date: October 2012

SHEET No. TS1 OF 3 SHEETS

ADD. 8

"AS-BUILT"

