


| FED. ROAD DIST. NO. | STATE | FED. AID PROJ. NO. | FISCAL YEAR | SHEET NO. | TOTAL SHEETS |
|---------------------|-------|--------------------|-------------|-----------|--------------|
| HAWAII              | HAW.  | 3400B-01-04        | 2007        | 5         | 8            |

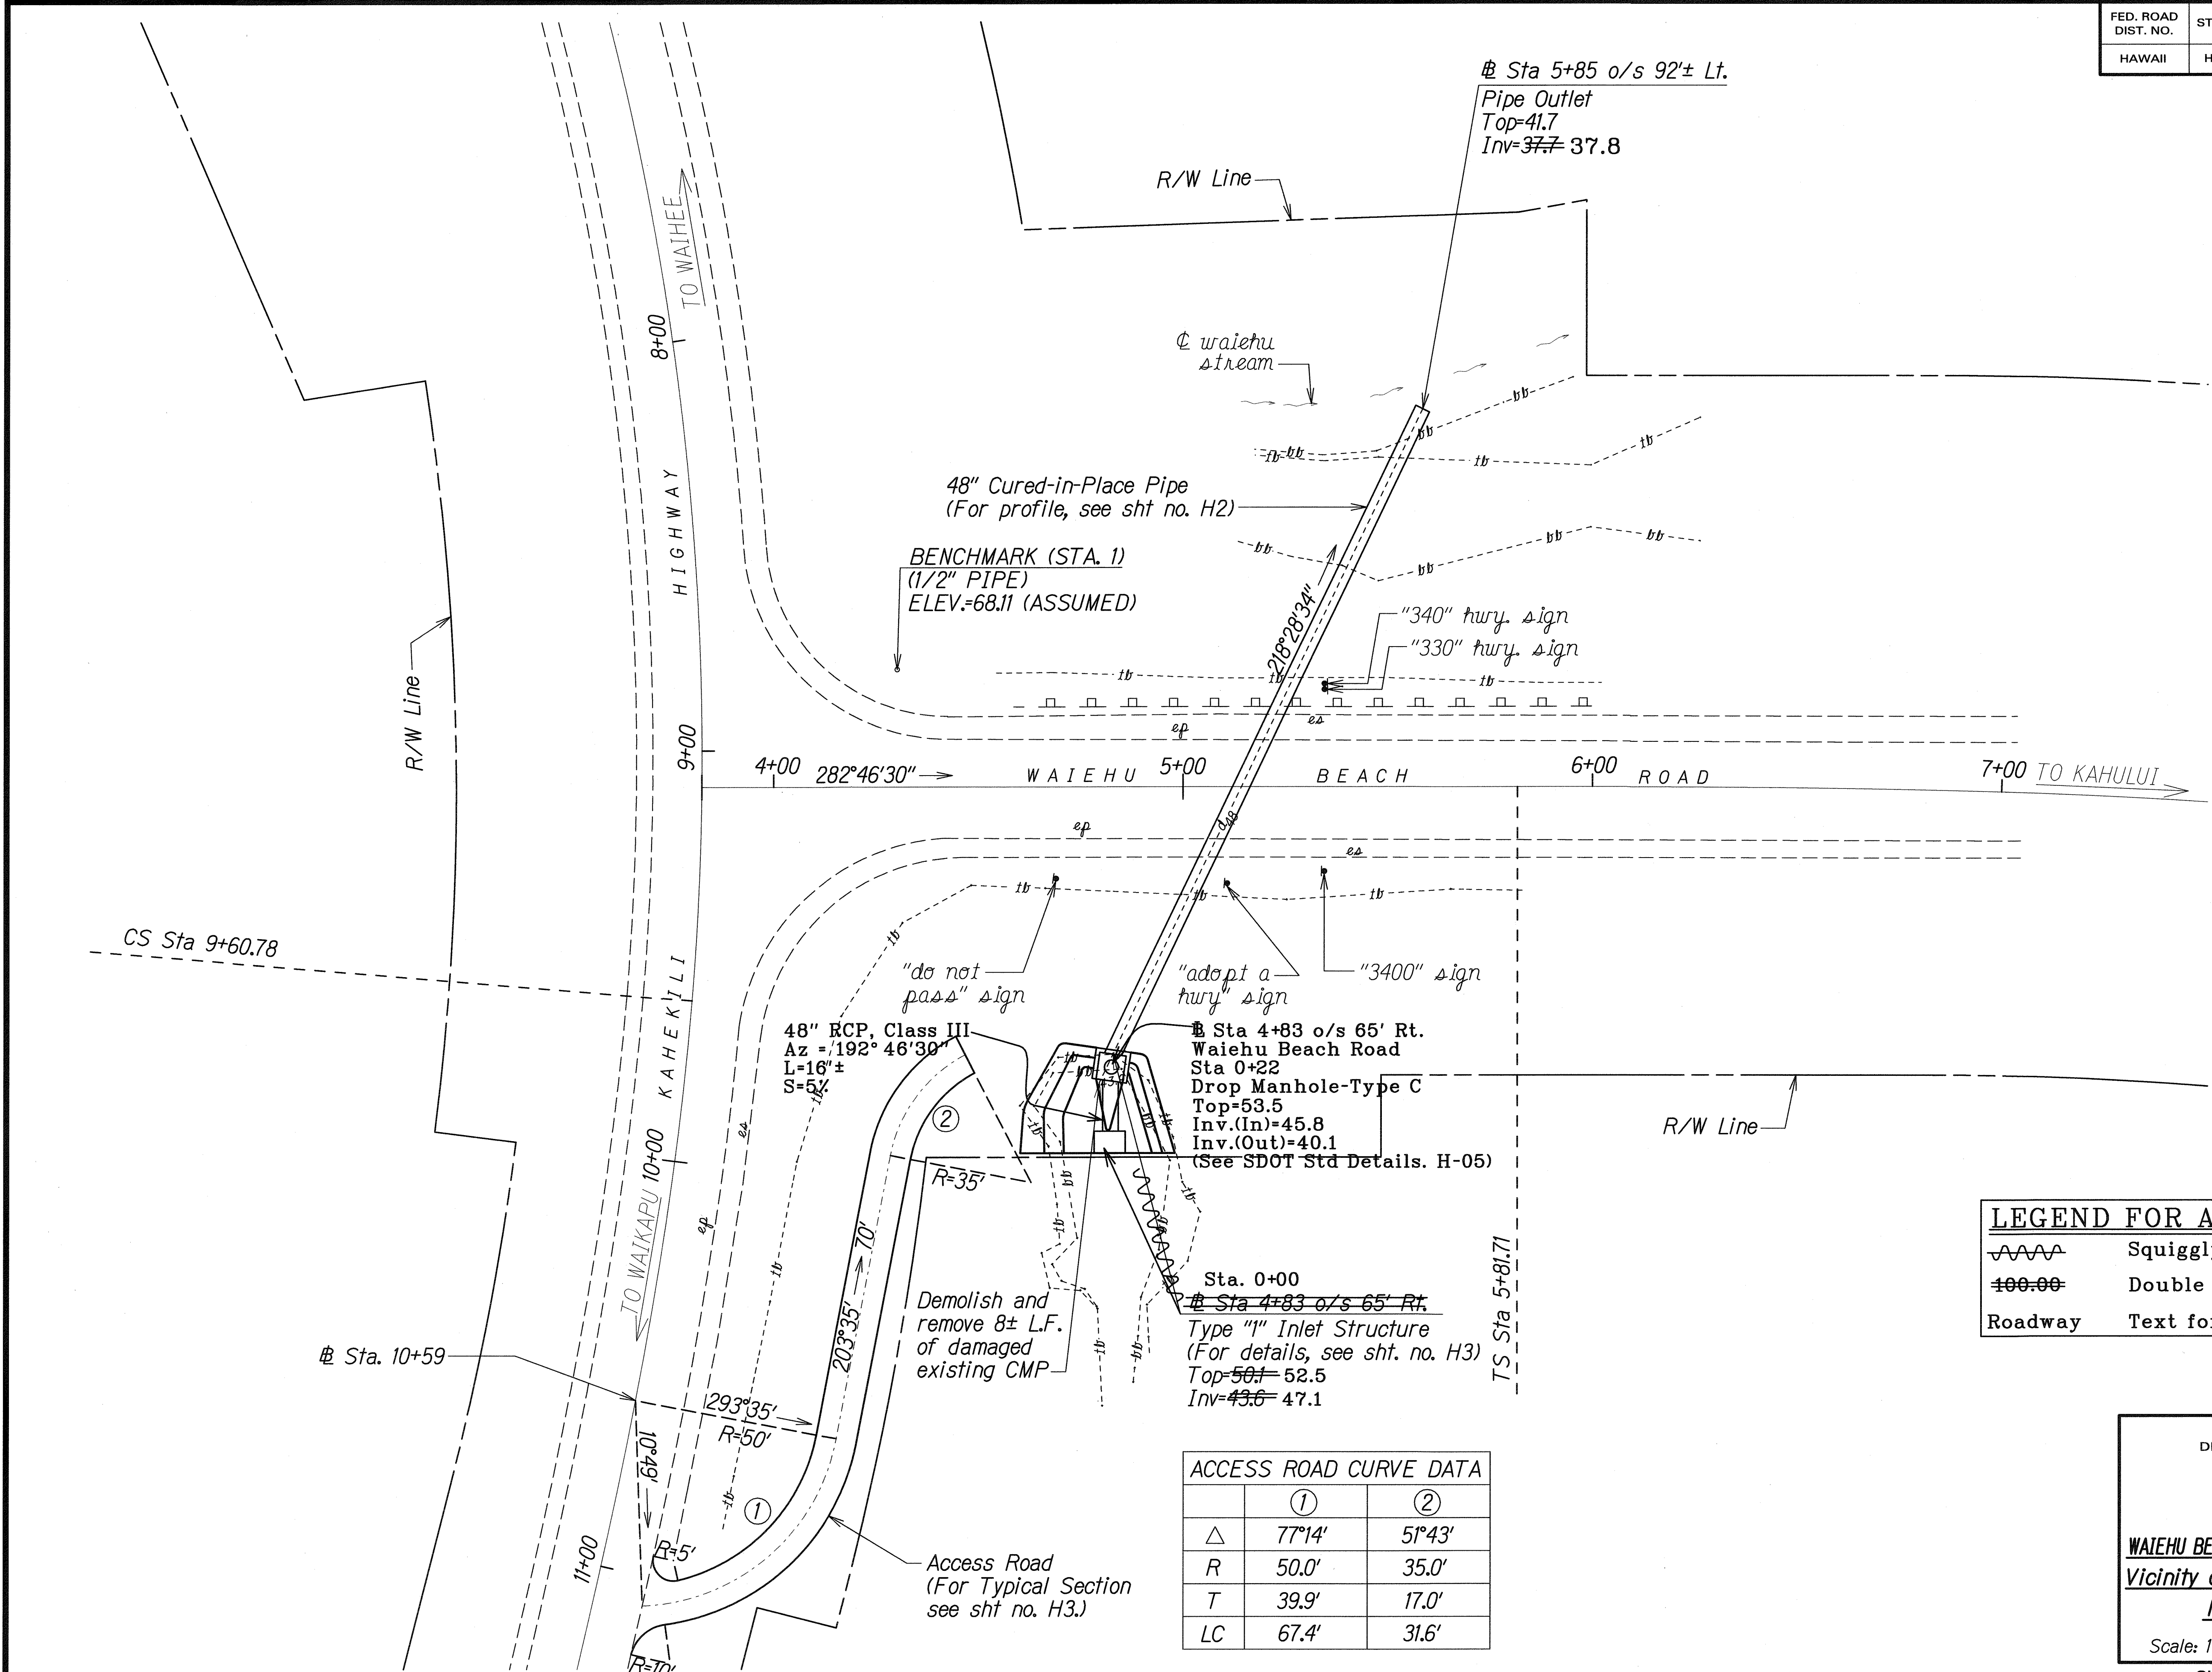

|               |                   |         |
|---------------|-------------------|---------|
| ORIGINAL PLAN | SURVEY PLOTTED BY | DATE    |
| NOTED WORK    | DRAWN BY          | 7/24/03 |
| DESIGNED BY   | TRACED BY         |         |
| CHECKED BY    | CHECKED BY        |         |

| LEGEND FOR AS-BUILT POSTINGS |                                     |
|------------------------------|-------------------------------------|
|                              | Squiggly line for as-built deletion |
|                              | Double line for as-built deletion   |
| Roadway                      | Text for as-built posting           |

STATE OF HAWAII  
DEPARTMENT OF TRANSPORTATION  
HIGHWAYS DIVISION

### DRAINAGE PLAN

WAIEHU BEACH ROAD MISC. DRAINAGE IMPROVEMENTS  
Vicinity of Kahakuli Highway Intersection  
Project No. 3400B-01-04

Scale: 1"=20'      Date: September 2006

SHEET No. **HI** OF **4** SHEETS

"AS-BUILT"