


FED. ROAD DIST. NO.	STATE	PROJ. NO.	FISCAL YEAR	SHEET NO.	TOTAL SHEETS
HAWAII	HAW.	3400B-01-04	2007	6	8

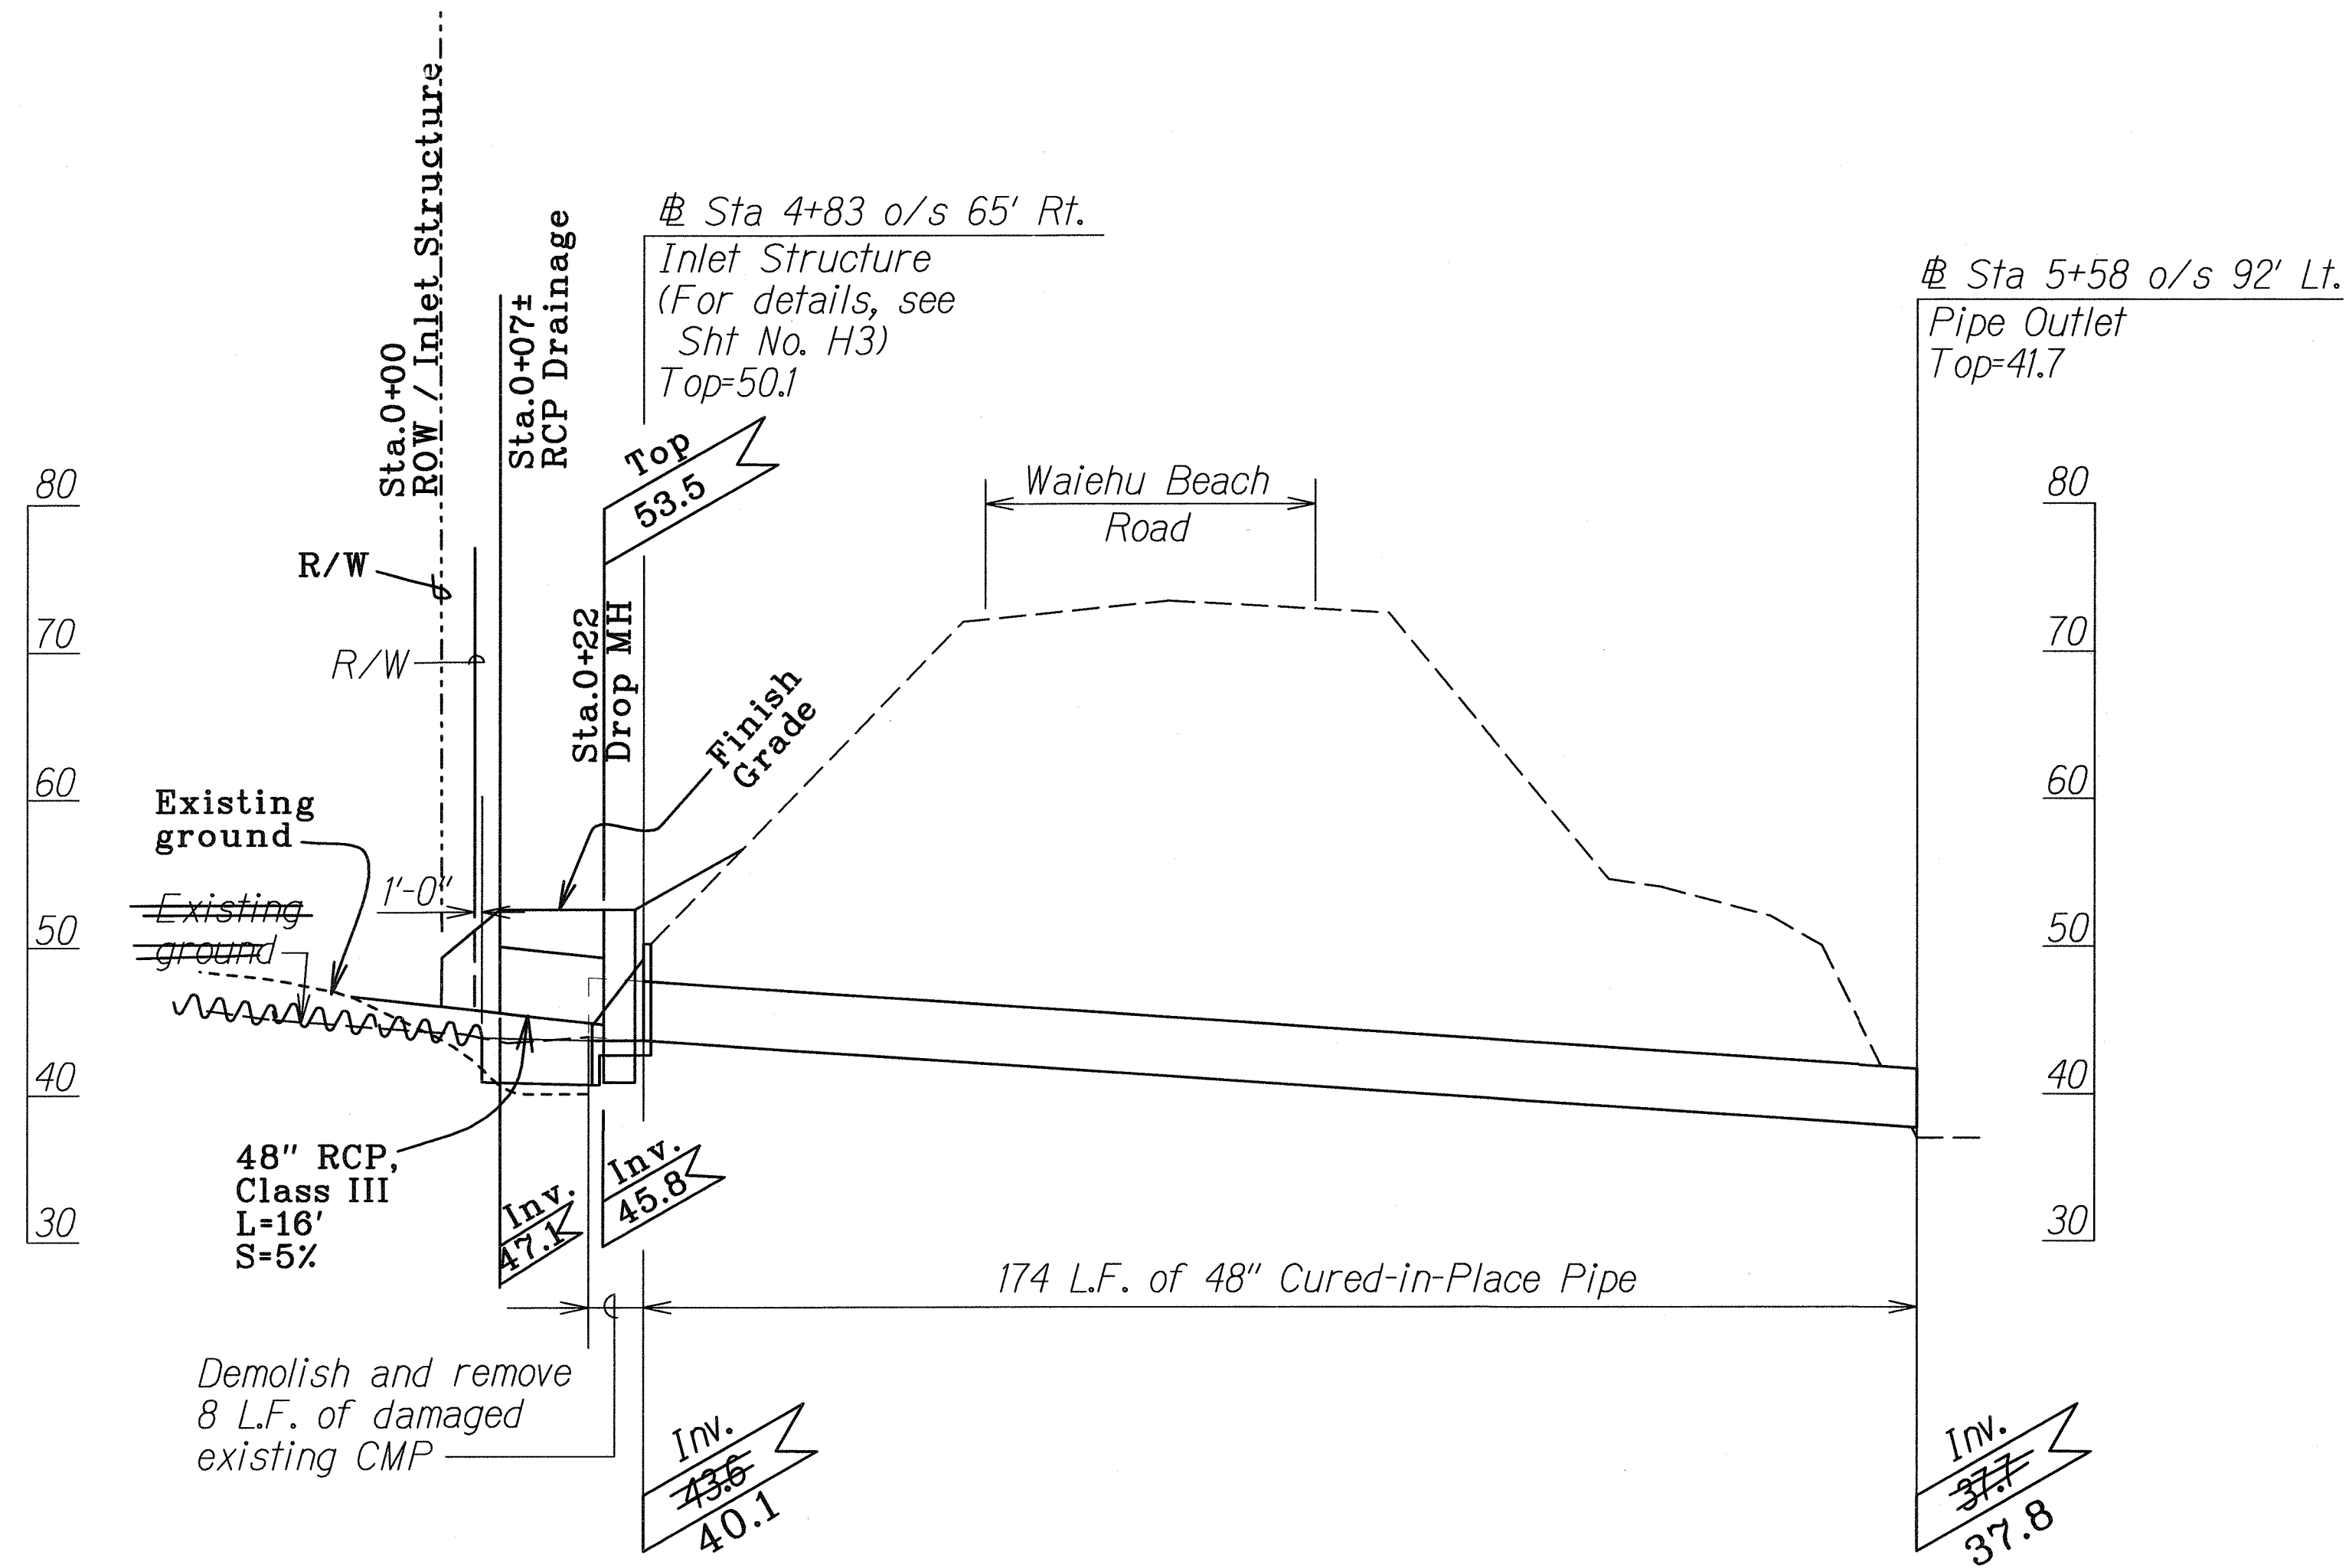

PROFILE - 48" CURED-IN-PLACE PIPE

Scale: Horizontal: 1"= 20'
Vertical: 1"= 10'

LEGEND FOR AS-BUILT POSTINGS	
	Squiggly line for as-built deletion
	Double line for as-built deletion
Roadway	Text for as-built posting

STATE OF HAWAII
DEPARTMENT OF TRANSPORTATION
HIGHWAYS DIVISION

DRAINAGE PROFILE

WAIEHU BEACH ROAD MISC. DRAINAGE IMPROVEMENTS
Vicinity of Kahekili Highway Intersection
Project No. 3400B-01-04

Scale: As Shown Date: September 2006

ORIGINAL PLAN	SURVEY PLOTTED BY	DATE
NOTE BOOK	DRAWN BY	
1/2" Journal	TRACED BY	
1/4" Journal	CHECKED BY	
1/8" Journal		