

INDEX TO DRAWINGS	
SHEET NO.	DESCRIPTION
1	TITLE SHEET
2	NOTES
3 - 4	WATER POLLUTION & EROSION CONTROL NOTES
5	DRAINAGE PLAN
6	DRAINAGE PROFILE
7 - 8	DRAINAGE DETAILS

STATE OF HAWAII

DEPARTMENT OF TRANSPORTATION

HIGHWAYS DIVISION

HONOLULU, HAWAII

"AS-BUILT"

PLANS FOR

WAIEHU BEACH ROAD

MISCELLANEOUS DRAINAGE IMPROVEMENTS




VICINITY OF KAHEKILI HIGHWAY

PROJECT NO. 3400B-01-04

DISTRICT OF WAILUKU

ISLAND OF MAUI


FED. ROAD DIST. NO.	STATE	PROJ. NO.	FISCAL YEAR	SHEET NO.	TOTAL SHEETS
HAWAII	HAW.	3400B-01-04	2007	1	8

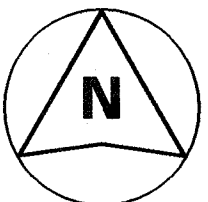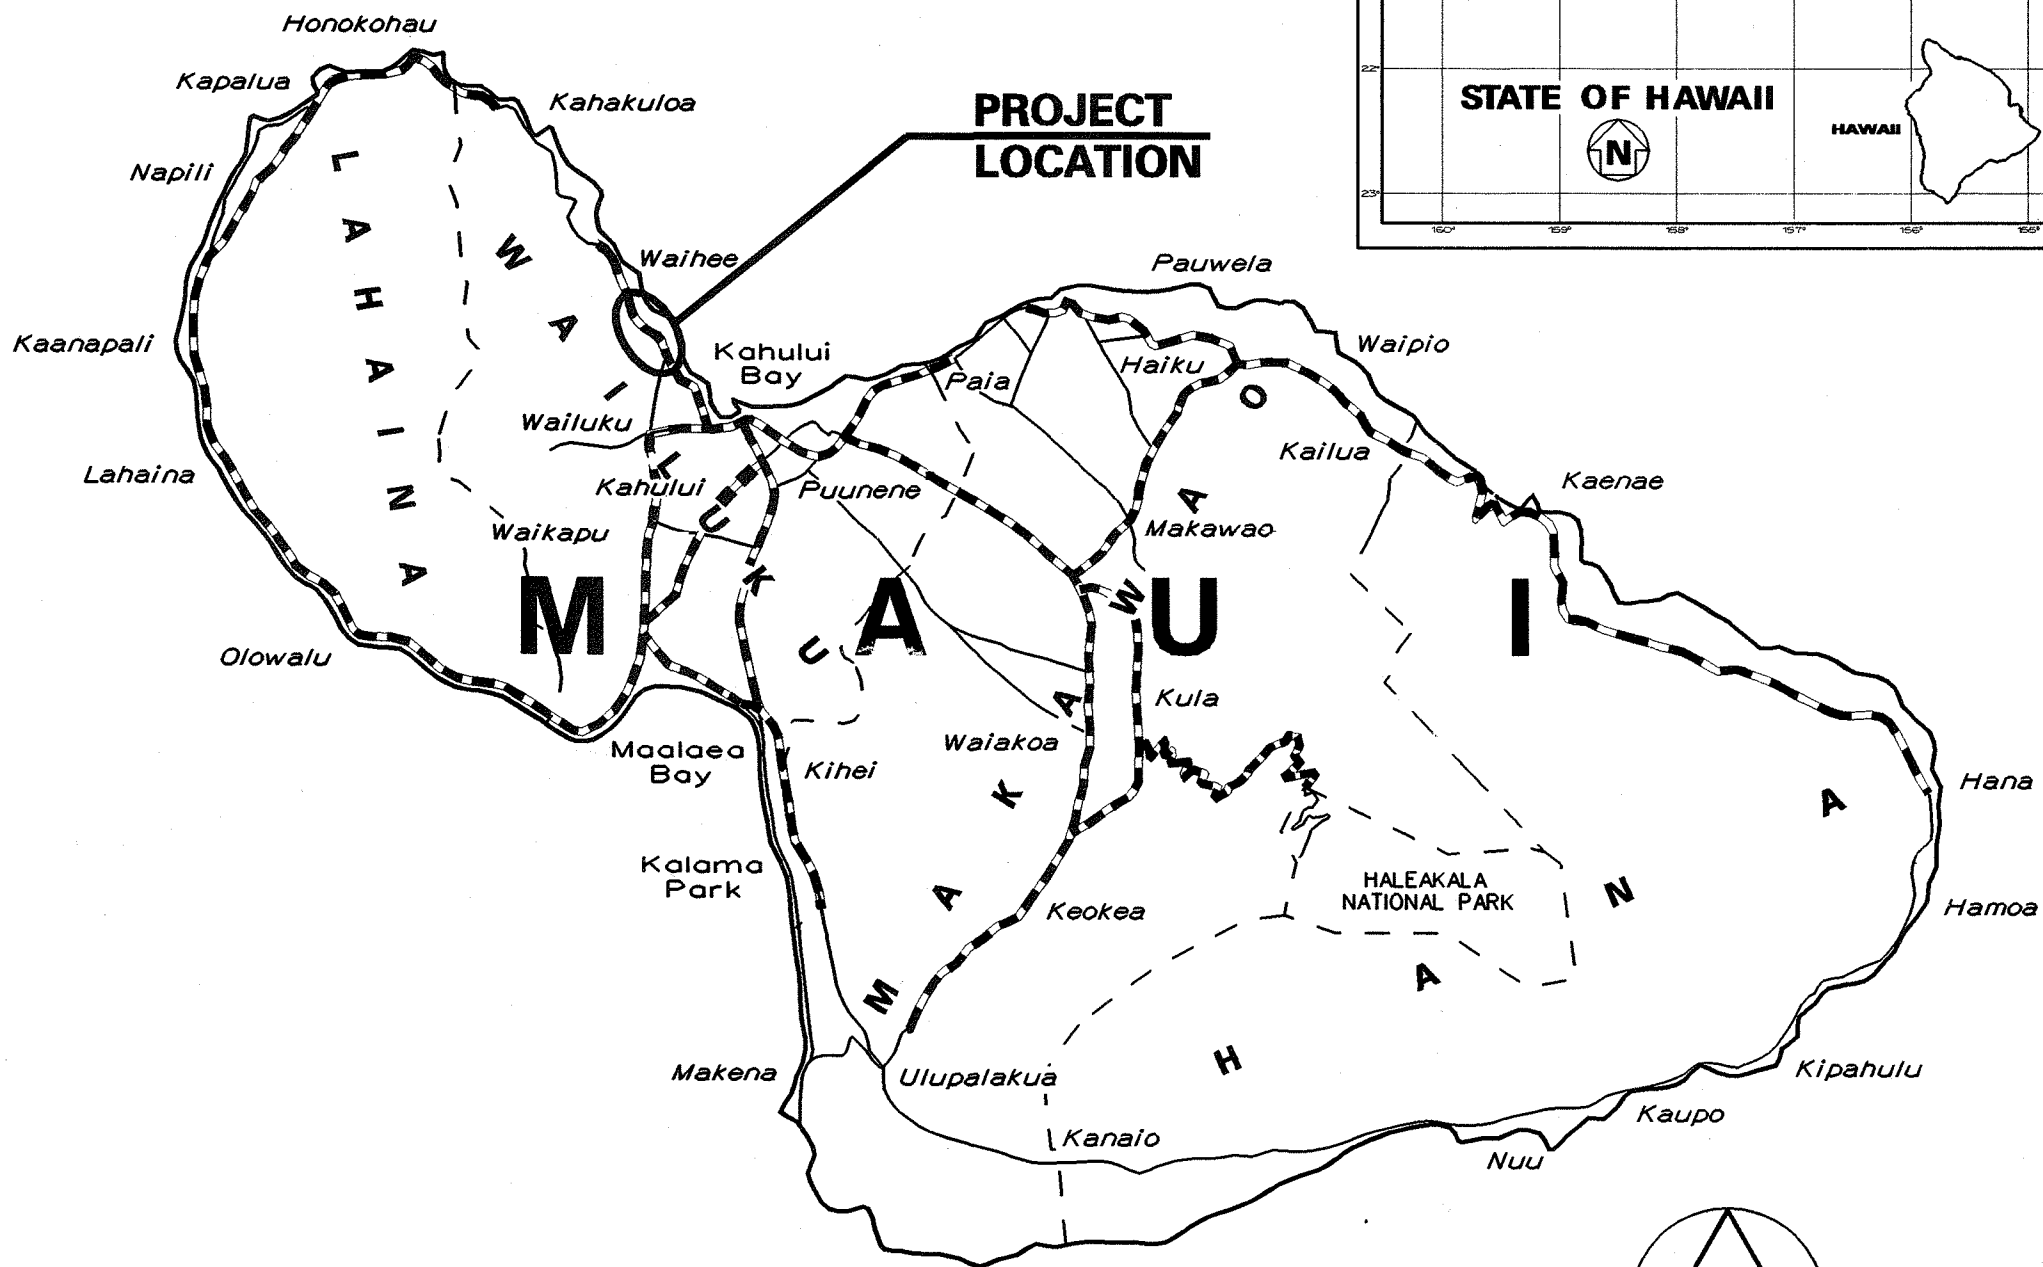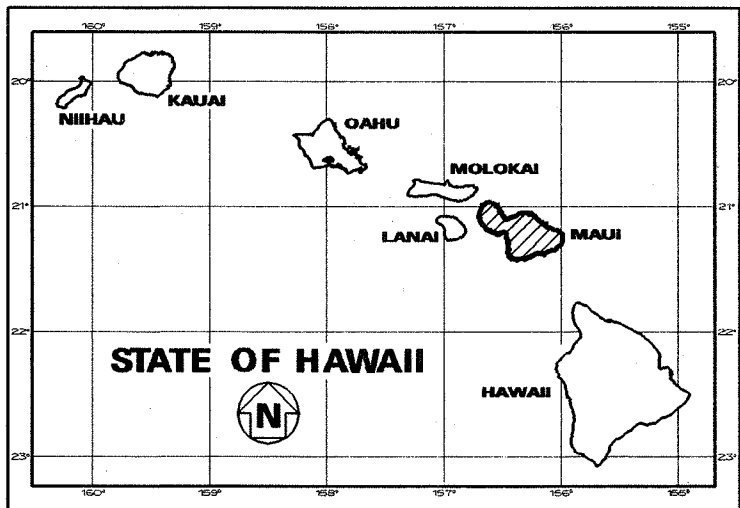

5 0 5 10
SCALE IN MILES

----- FEDERAL AID PROJECTS PREVIOUSLY CONSTRUCTED OR UNDER CONSTRUCTION

MILE POST 2.60 TO MILE POST 2.61

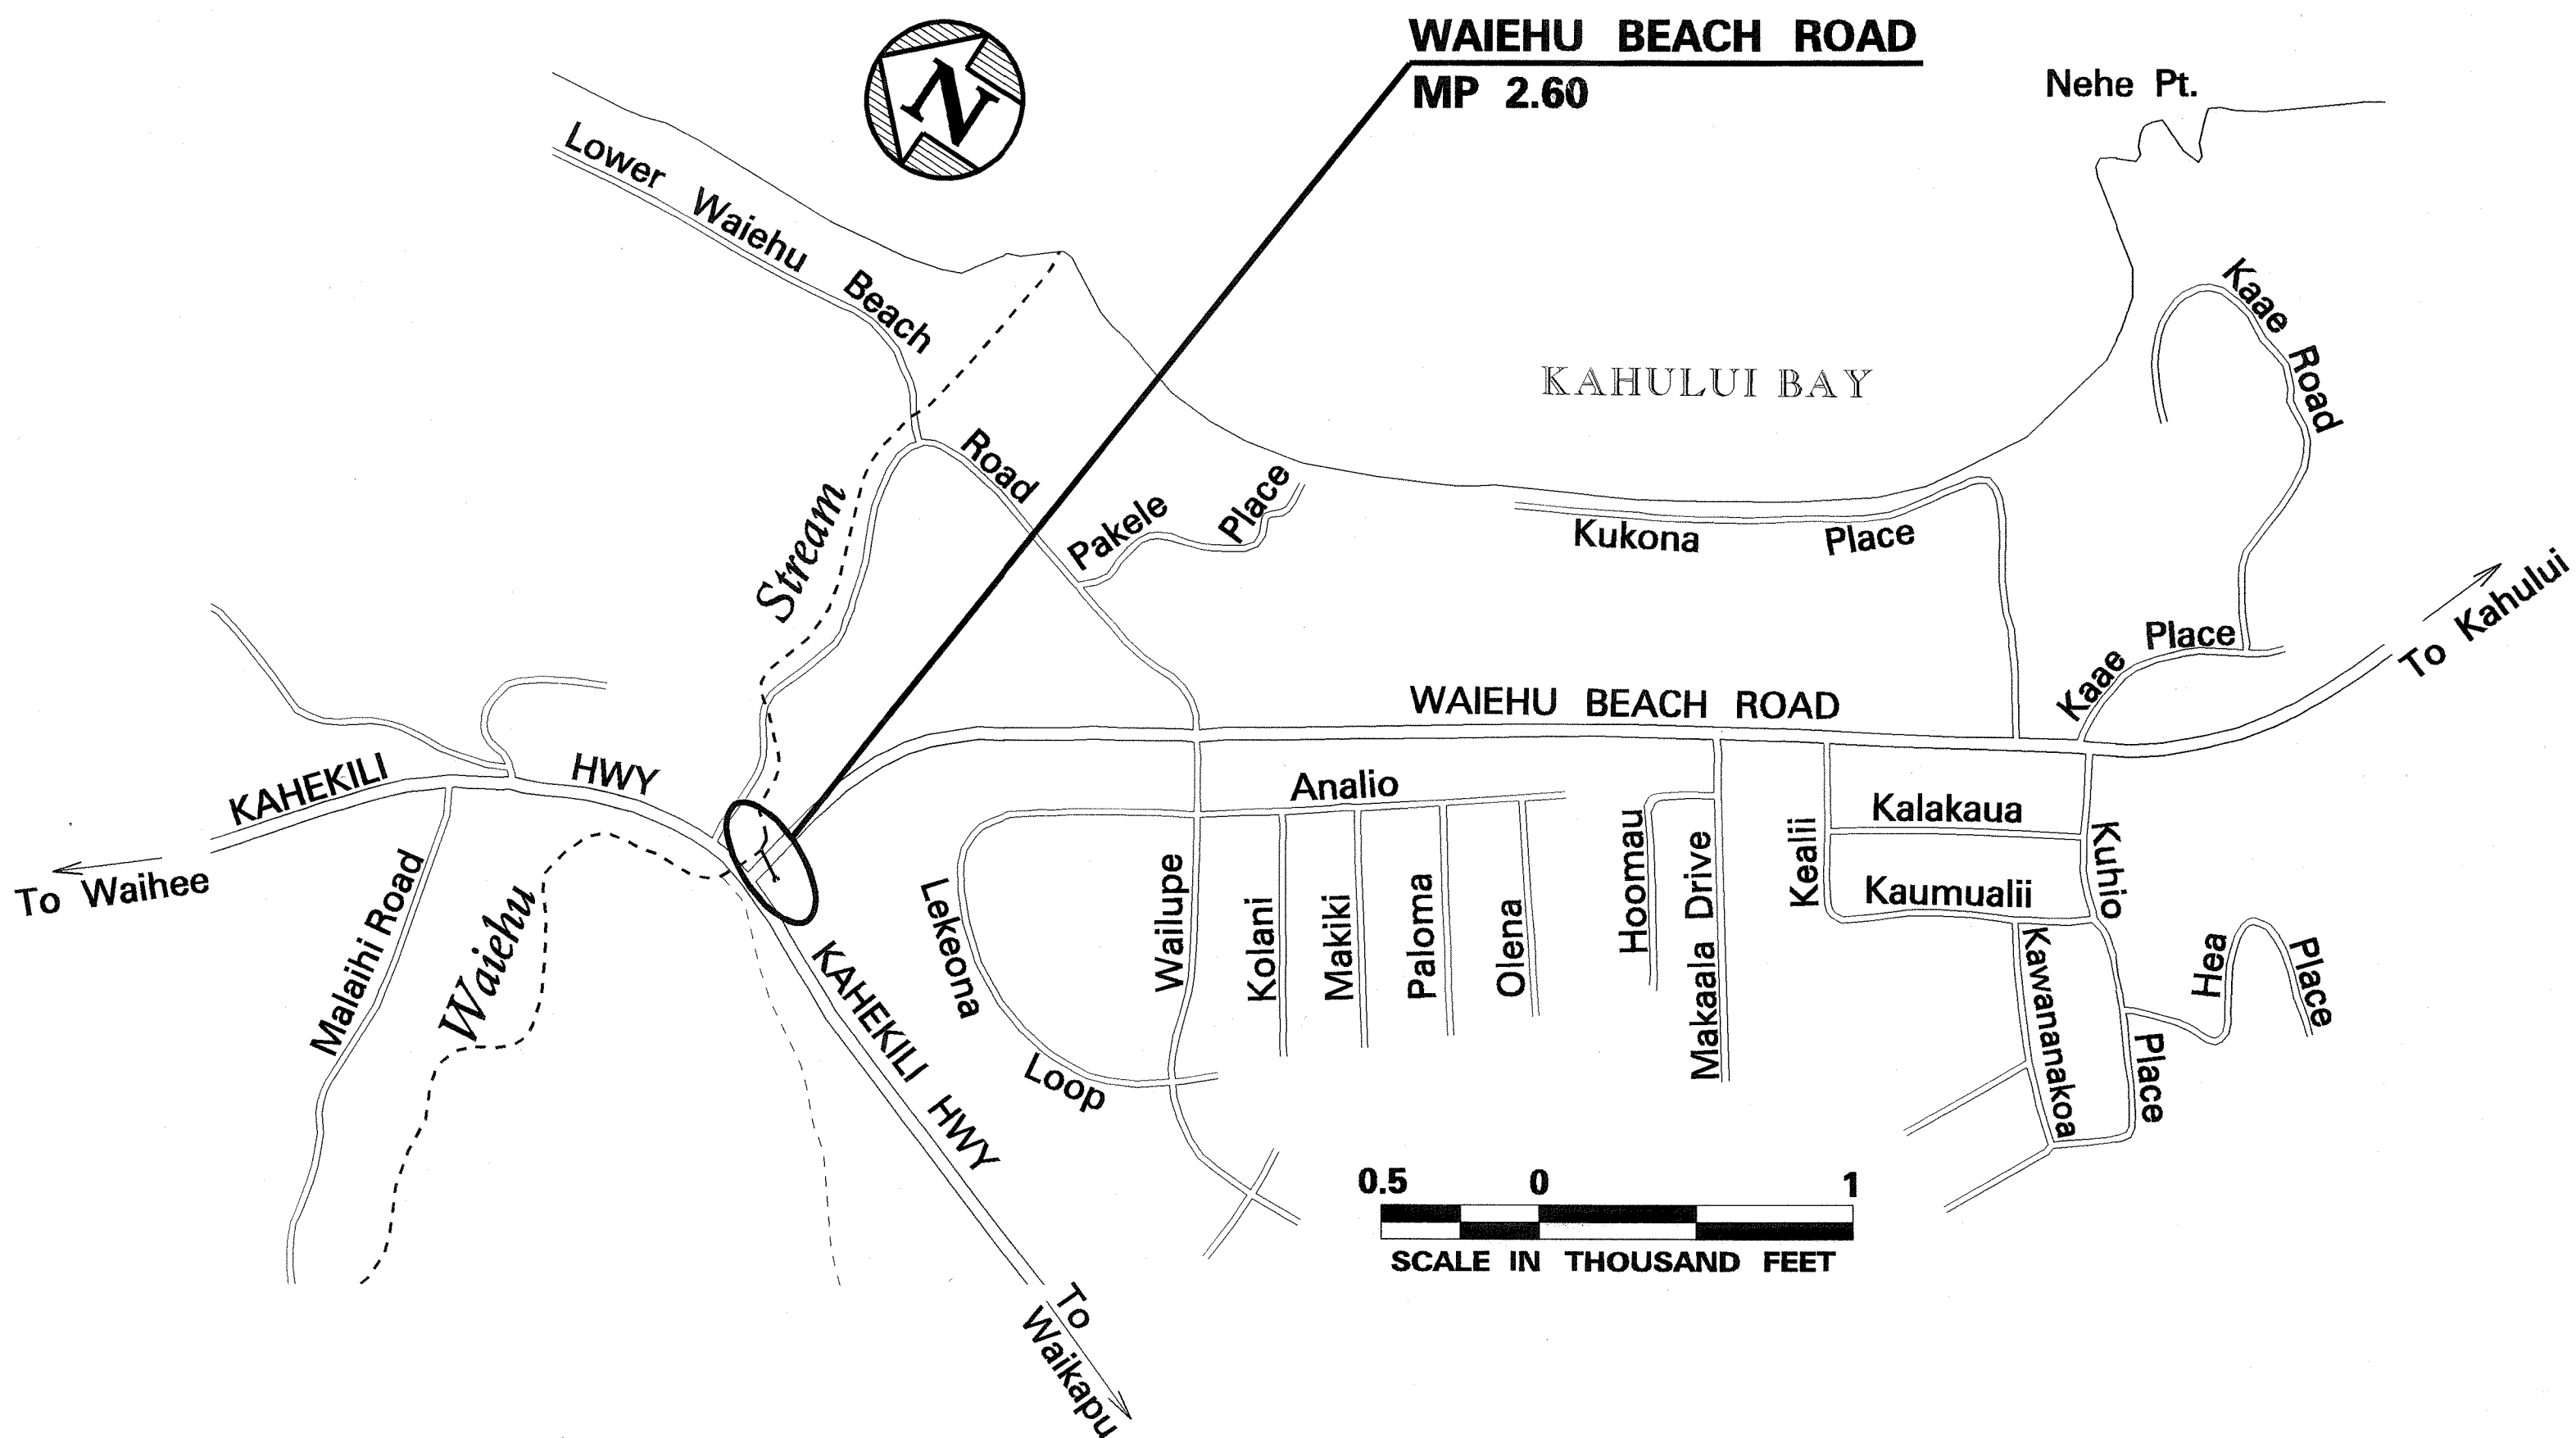

0.5 0 1
SCALE IN THOUSAND FEET

LAYOUT PLAN

GROSS LENGTH OF PROJECT.....0.01 MILES

CHANGES MADE DURING CONSTRUCTION HAVE BEEN INCORPORATED ON THESE PLANS EXCEPT CHANGES IN THE ORIGINAL THEORETICAL QUANTITIES. FOR ACTUAL QUANTITIES, REFER TO PROJECT LEDGER AND/OR COMPUTATION BOOK.

[Signature] 6/5/09
RESIDENT ENGINEER DATE

DEPARTMENT OF TRANSPORTATION STATE OF HAWAII	
APPROVED:	
<i>[Signature]</i> DIR. OF TRANSPORTATION	8-21-06 DATE

APR. 2006 DATE
692-7561 PHONE
HWY-DH P. S. & E. BY
DESIGNED BY

6wahtshidgry/jon