

INDEX TO DRAWINGS	
SHEET NO	DESCRIPTION
1	TITLE SHEET
2	SIGNING & PAVEMENT MARKING PLANS
3	TRAFFIC SIGNAL SYSTEM PLAN
4 - 6	MISCELLANEOUS & TYPICAL DETAILS
7 - 9	STANDARD DETAILS

STATE OF HAWAII

DEPARTMENT OF TRANSPORTATION

HIGHWAYS DIVISION

HONOLULU, HAWAII

"AS BUILT"

PLANS FOR

CONSTRUCTION OF

TRAFFIC SIGNAL IMPROVEMENTS


AT

Kuihelani Highway and Puunene Avenue


FEDERAL AID SECONDARY PROJECT NO.RS-0380(7)

DISTRICT OF WAILUKU


ISLAND OF MAUI

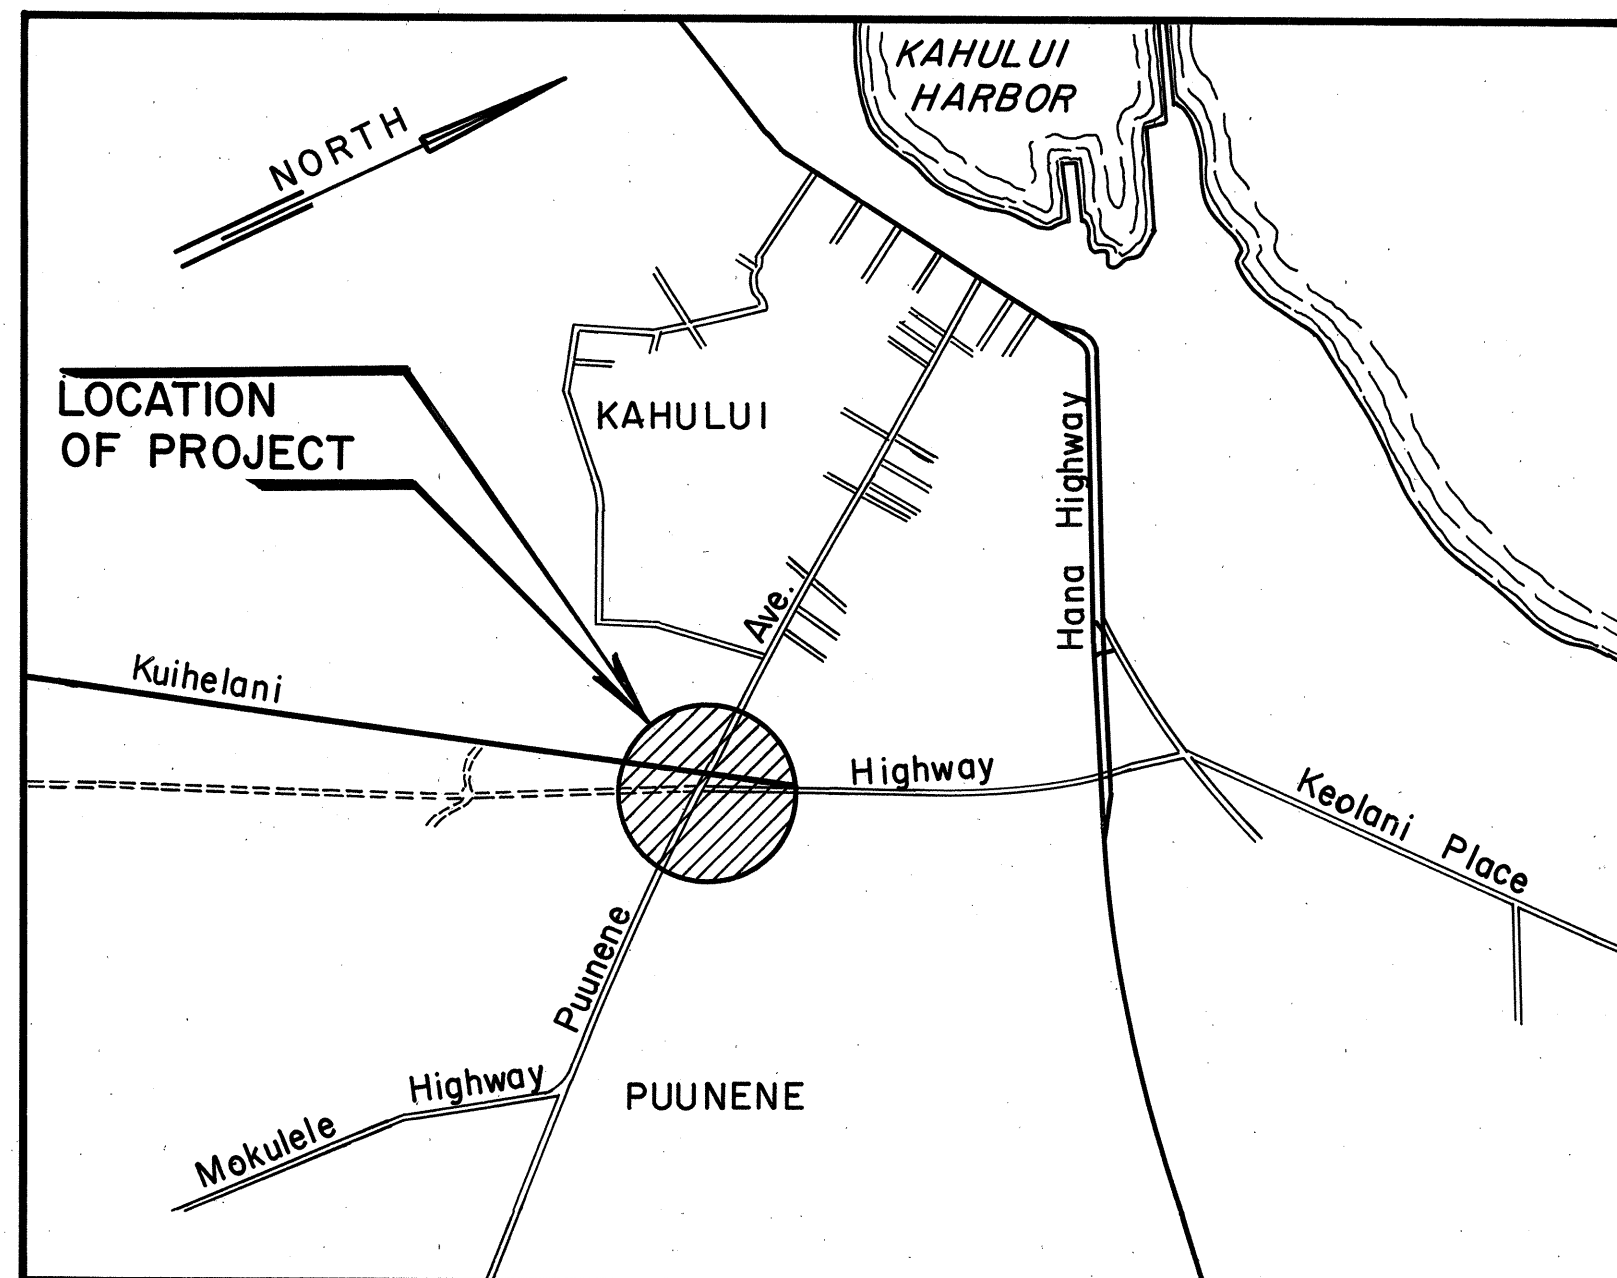

GENERAL LAYOUT PLAN

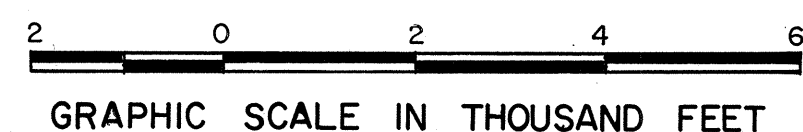

FED. ROAD DIST. NO.	STATE	FED. AID PROJ. NO.	FISCAL YEAR	SHEET NO.	TOTAL SHEETS
HAWAII	HAW.	S-0380(7)	1975	1	9

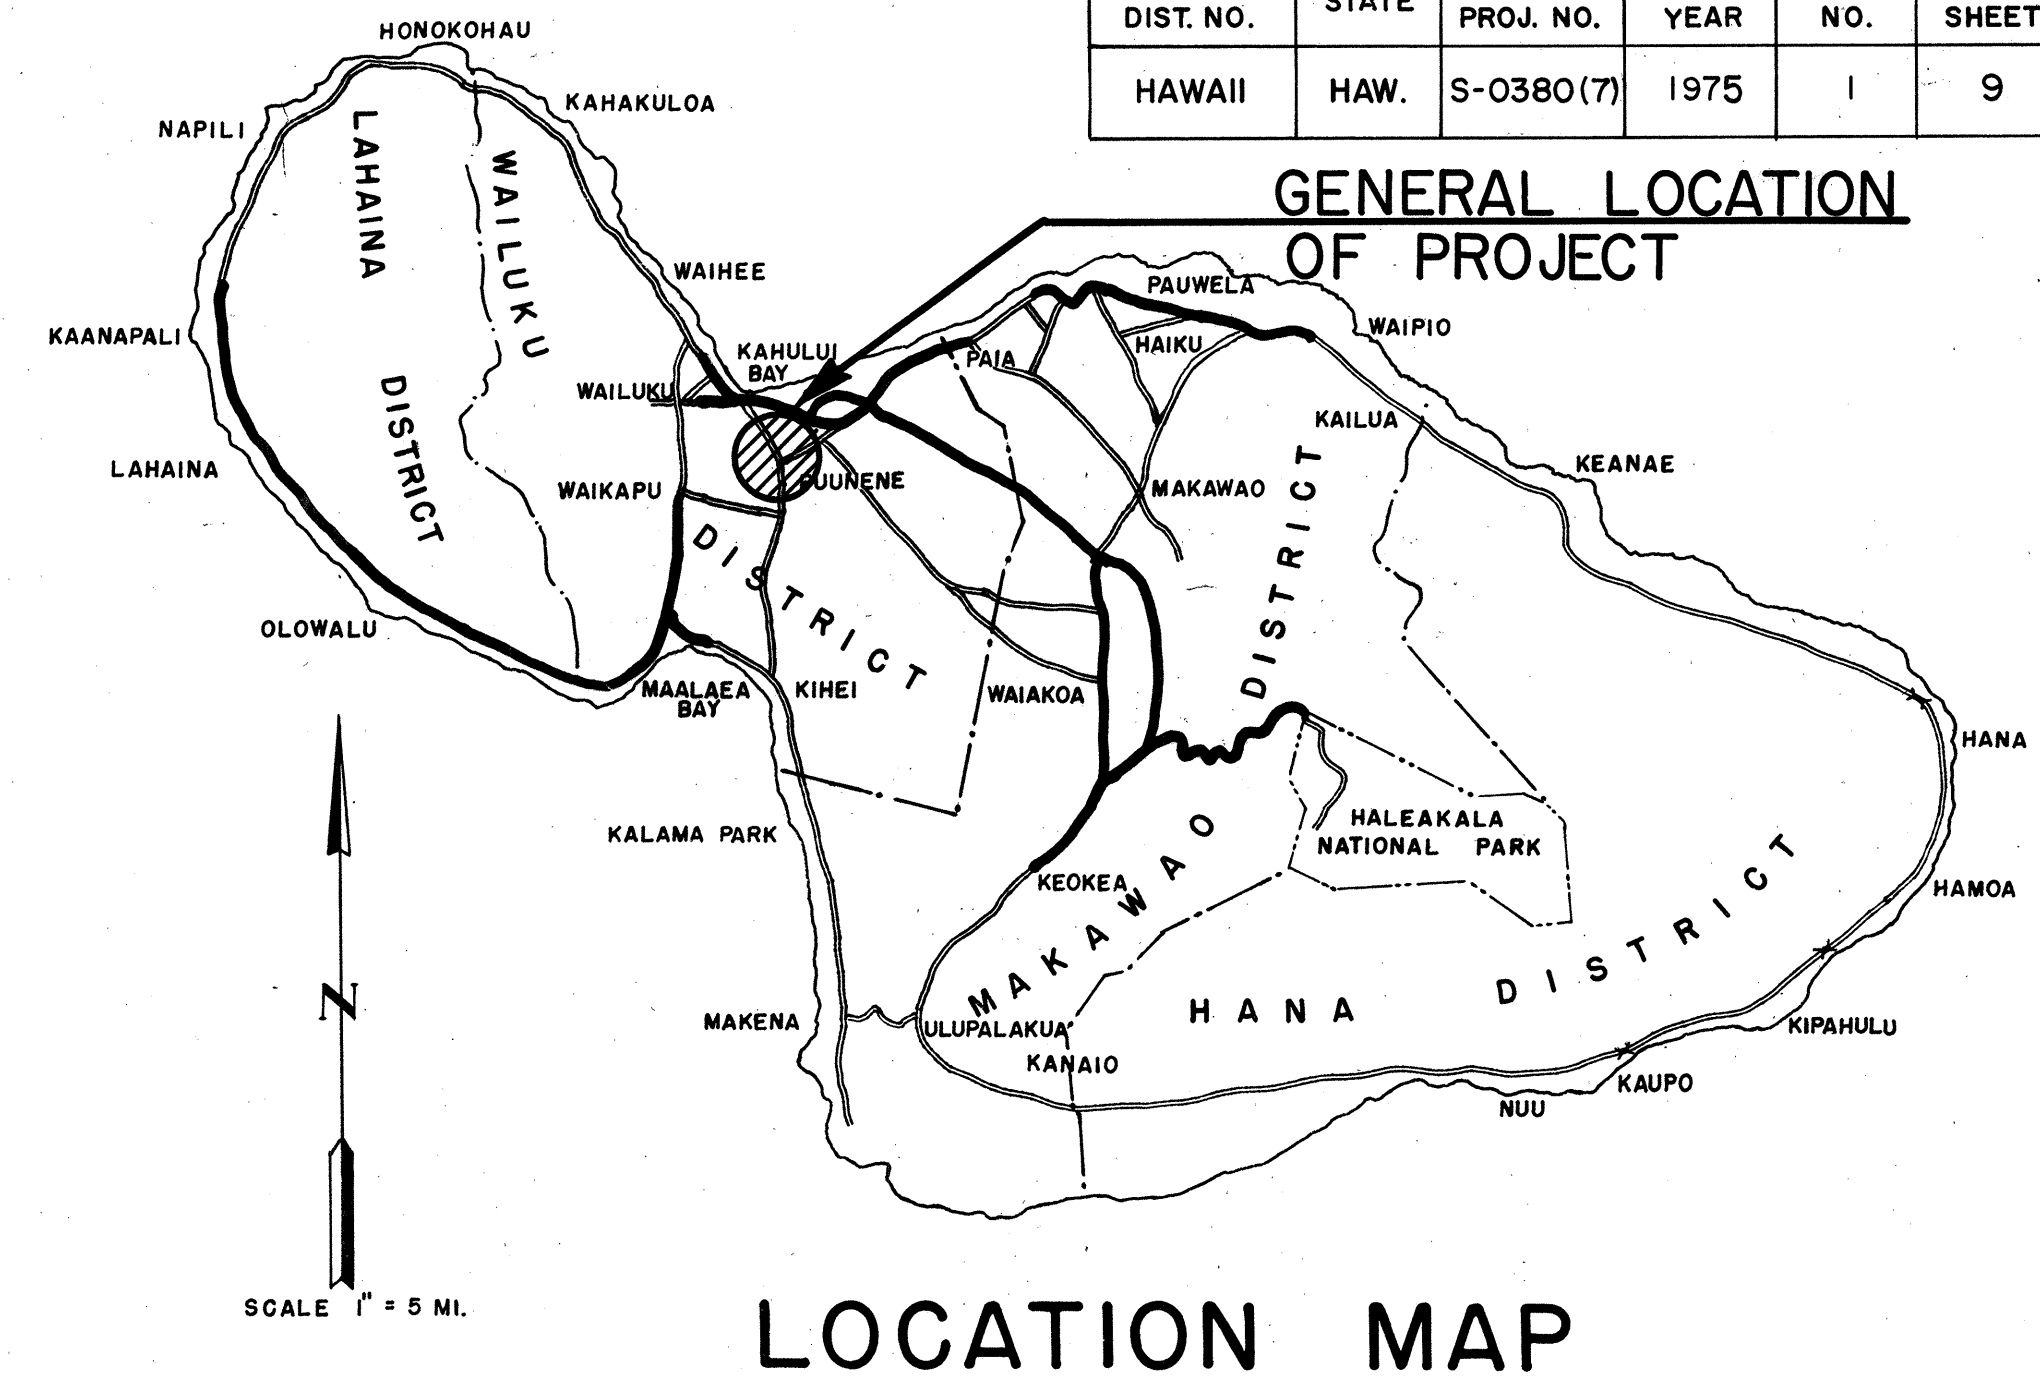

LOCATION MAP

FEDERAL AID PROJECTS PREVIOUSLY CONSTRUCTED OR UNDER CONSTRUCTION

DESIGN CLASSIFICATION

CURRENT ADT (1972)	2,535
DESIGN ADT (1995)	6,200
DHV	9 %
D	55/45
T	9 %
T24	10.5%
V	60 M.P.H.

All changes made during Construction are shown in Red on these plans.

Manuel P. Silva 30 JAN. 1976

Resident Engineer Date

DEPARTMENT OF TRANSPORTATION STATE OF HAWAII	
APPROVED:	
<i>E. Avery Wright</i>	4/16/75
DIR. OF TRANSPORTATION	DATE

DESIGNED BY

Herbert Tao 548-6932 Apr. 1975

P.S. & E BY PHONE DATE

HWY-DT