

INDEX TO DRAWINGS	
SHEET NO	DESCRIPTION
1	TITLE SHEET, PLAN & TYPICAL SECTION
2-3	PAVEMENT MARKING DETAILS

STATE OF HAWAII  
DEPARTMENT OF TRANSPORTATION  
HIGHWAYS DIVISION  
HONOLULU, HAWAII

PLANS FOR  
PUUNENE AVENUE IMPROVEMENTS  
PHASE I - RESURFACING  
KAAHUMANU AVENUE TO KUIHELANI HIGHWAY  
PROJECT NO. 350A-01-72

GENERAL NOTES :


- Prior to filling or resurfacing, the existing surface shall be cleaned as described in Section 310 of the Standard Specifications. Payment incidental to Item No. 401.05
- All holes, cracks and large depressions shall be filled and compacted with A.C. Mix  $\text{Y}$  prior to resurfacing. Payment incidental to A.C. Pavement Mix  $\text{Y}$ .
- In general, the A.C. pavement overlay thickness shall be  $1\frac{1}{2}$  inches unless otherwise directed by the Engineer.
- Smooth riding connection shall be constructed at the beginning and the end of the project and all connecting approaches and at extra widenings, as required by the Engineer.
- Dressing of shoulders after paving will be done by State Forces
- All Manhole and Valve Box Frames and Covers affected by the resurfacing shall be "Ringed" and marked as directed by the Engineer to provide future accessibility. This work will be considered incidental to Item 401.05

DISTRICT OF WAILUKU  
COUNTY OF MAUI  
ISLAND OF MAUI

SCALES

PLAN		1 IN. =	FT.
PROFILE	HOR.	1 IN. =	FT.
	VER.	1 IN. =	FT.
X-SECTIONS	HOR.	1 IN. =	FT.
	VER.	1 IN. =	FT.


4.0' Feathering with A.C.  
Mix  $\text{Y}$  at Extra Widenings,  
Approaches and Driveways

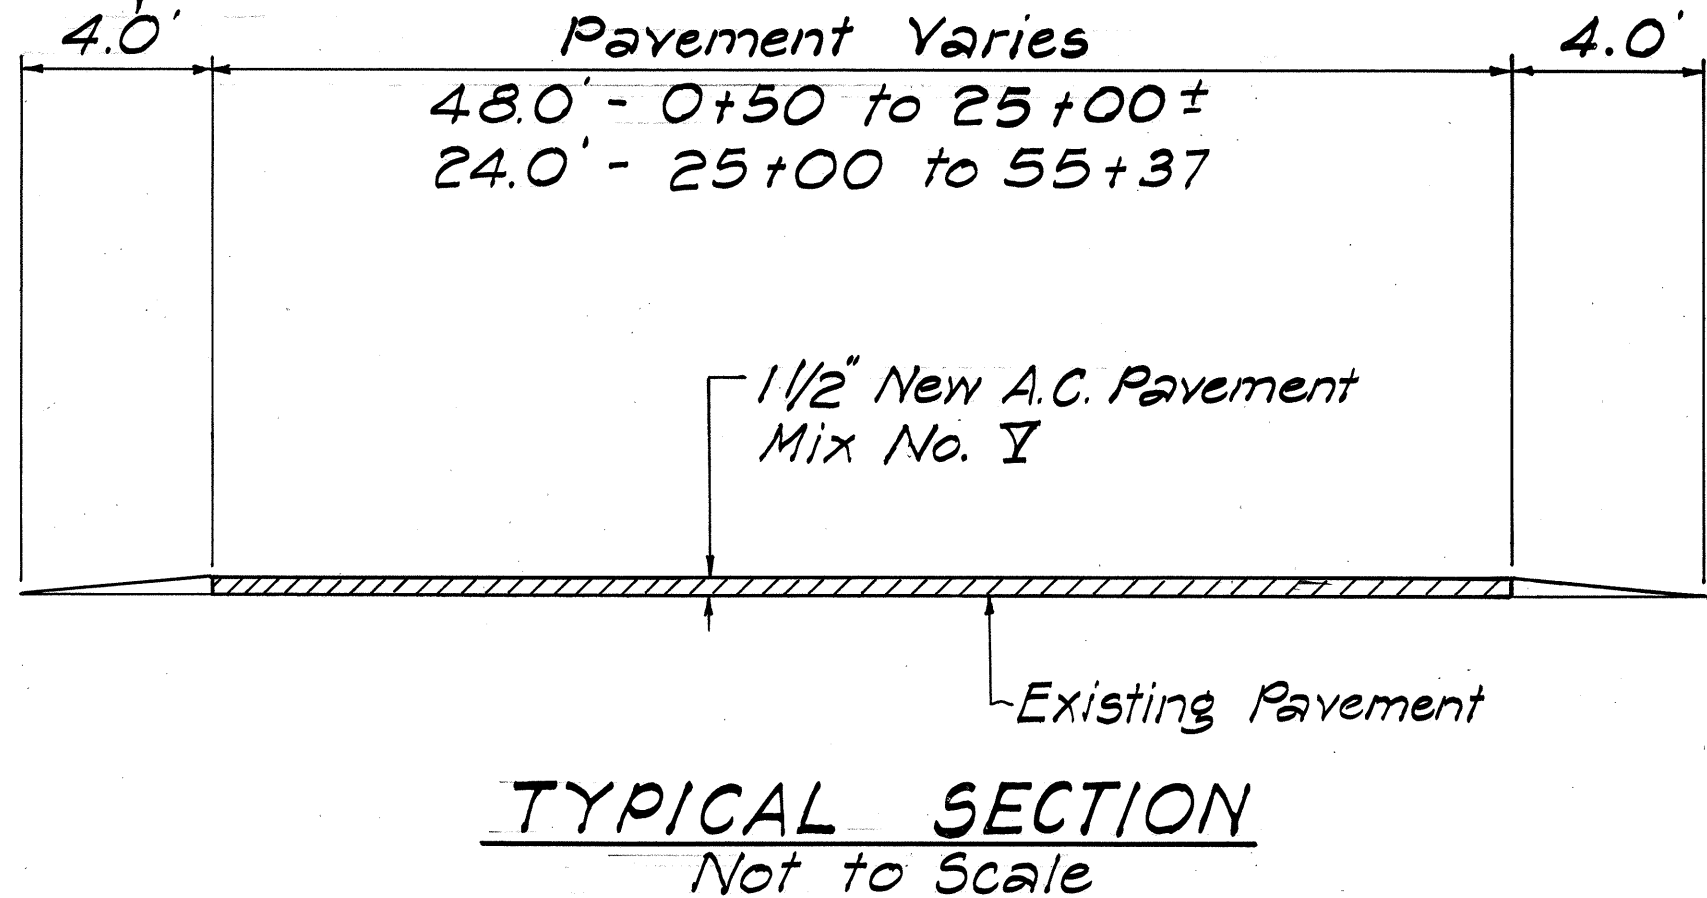

NO "AS BUILT" CHANGES

LAYOUT OF PROJECT

LENGTH OF PROJECT 1.040 MI. (1.673 KM)

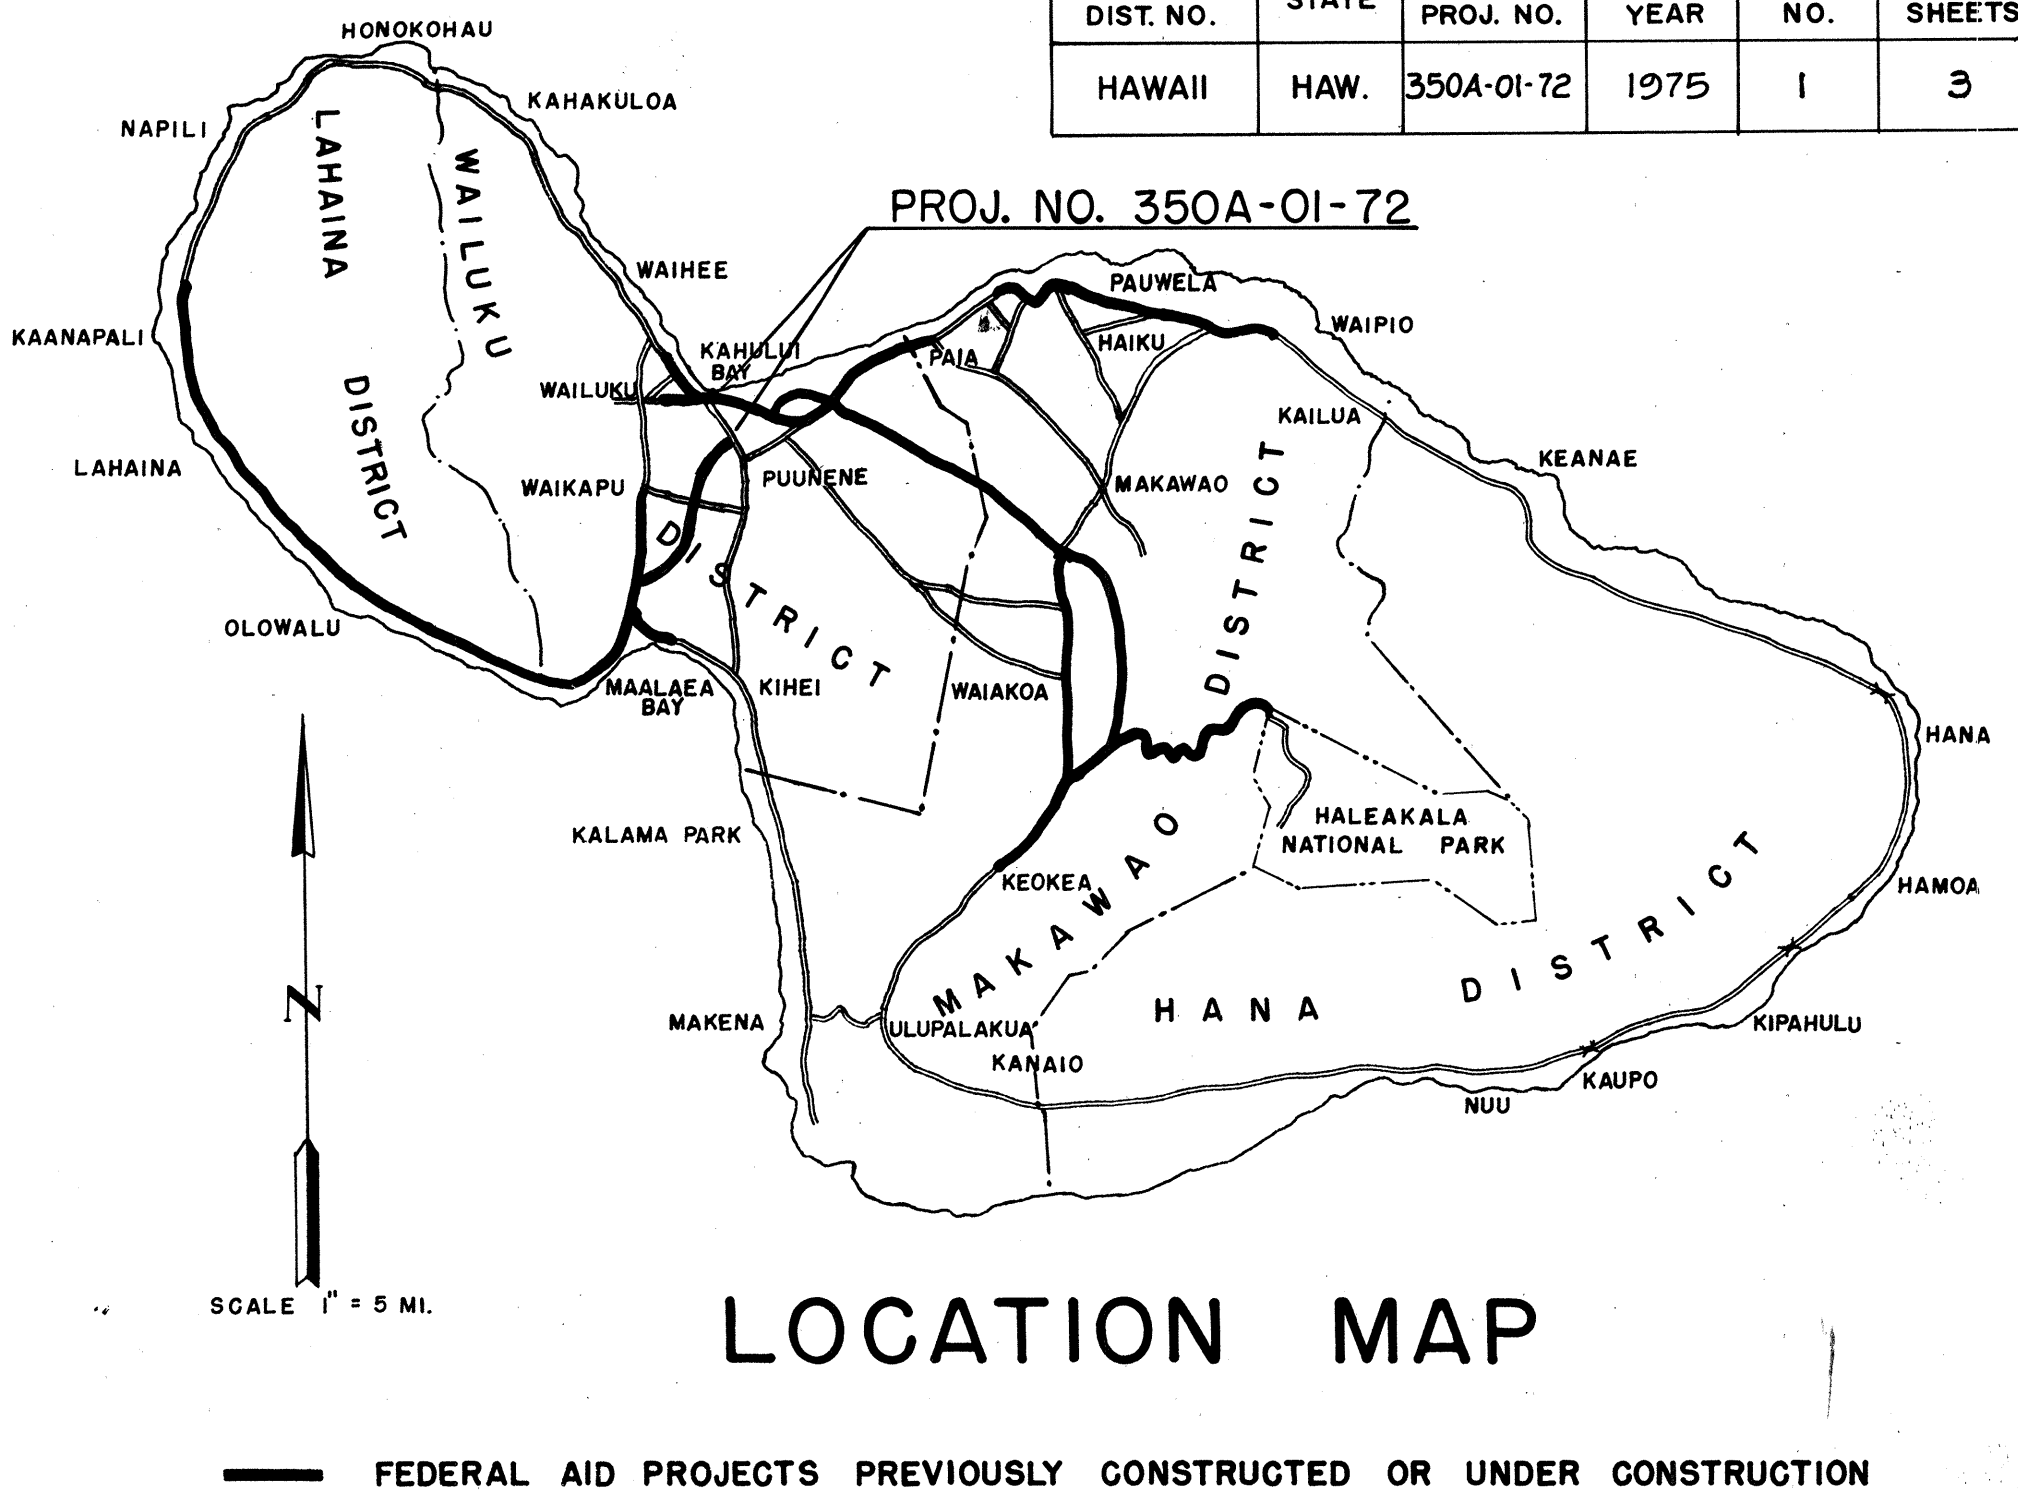

DESIGNED BY: MAUI DISTRICT OFFICE  
STATE HWYS. DIVISION

DATE: OCT. 1975

PS & E BY: R. TSUZUKI  
PHONE: 548-2456

APPROVED: DATE 1-12-76

for R. Higashionna  
DIRECTOR OF TRANSPORTATION